






ALL DESIGN, CONSTRUCTION, AND/OR ANALYSIS OF THIS PROJECT IS THE PROPERTY OF VERDE DESIGN, INC. AND IS NOT TO BE REPRODUCED, COPIED, OR DISCLOSED TO ANY PERSON, FIRM, OR ORGANIZATION FOR ANY PURPOSES WITHOUT WRITTEN PERMISSION OF VERDE DESIGN, INC.

DRAWING NAME: Y:\Projects-FO\2019\1910900 - Chavez Restort\CAD\\_ACC- Athletics.dwg  
PLOT DATE: 03-30-20 PLOTTED BY: station40

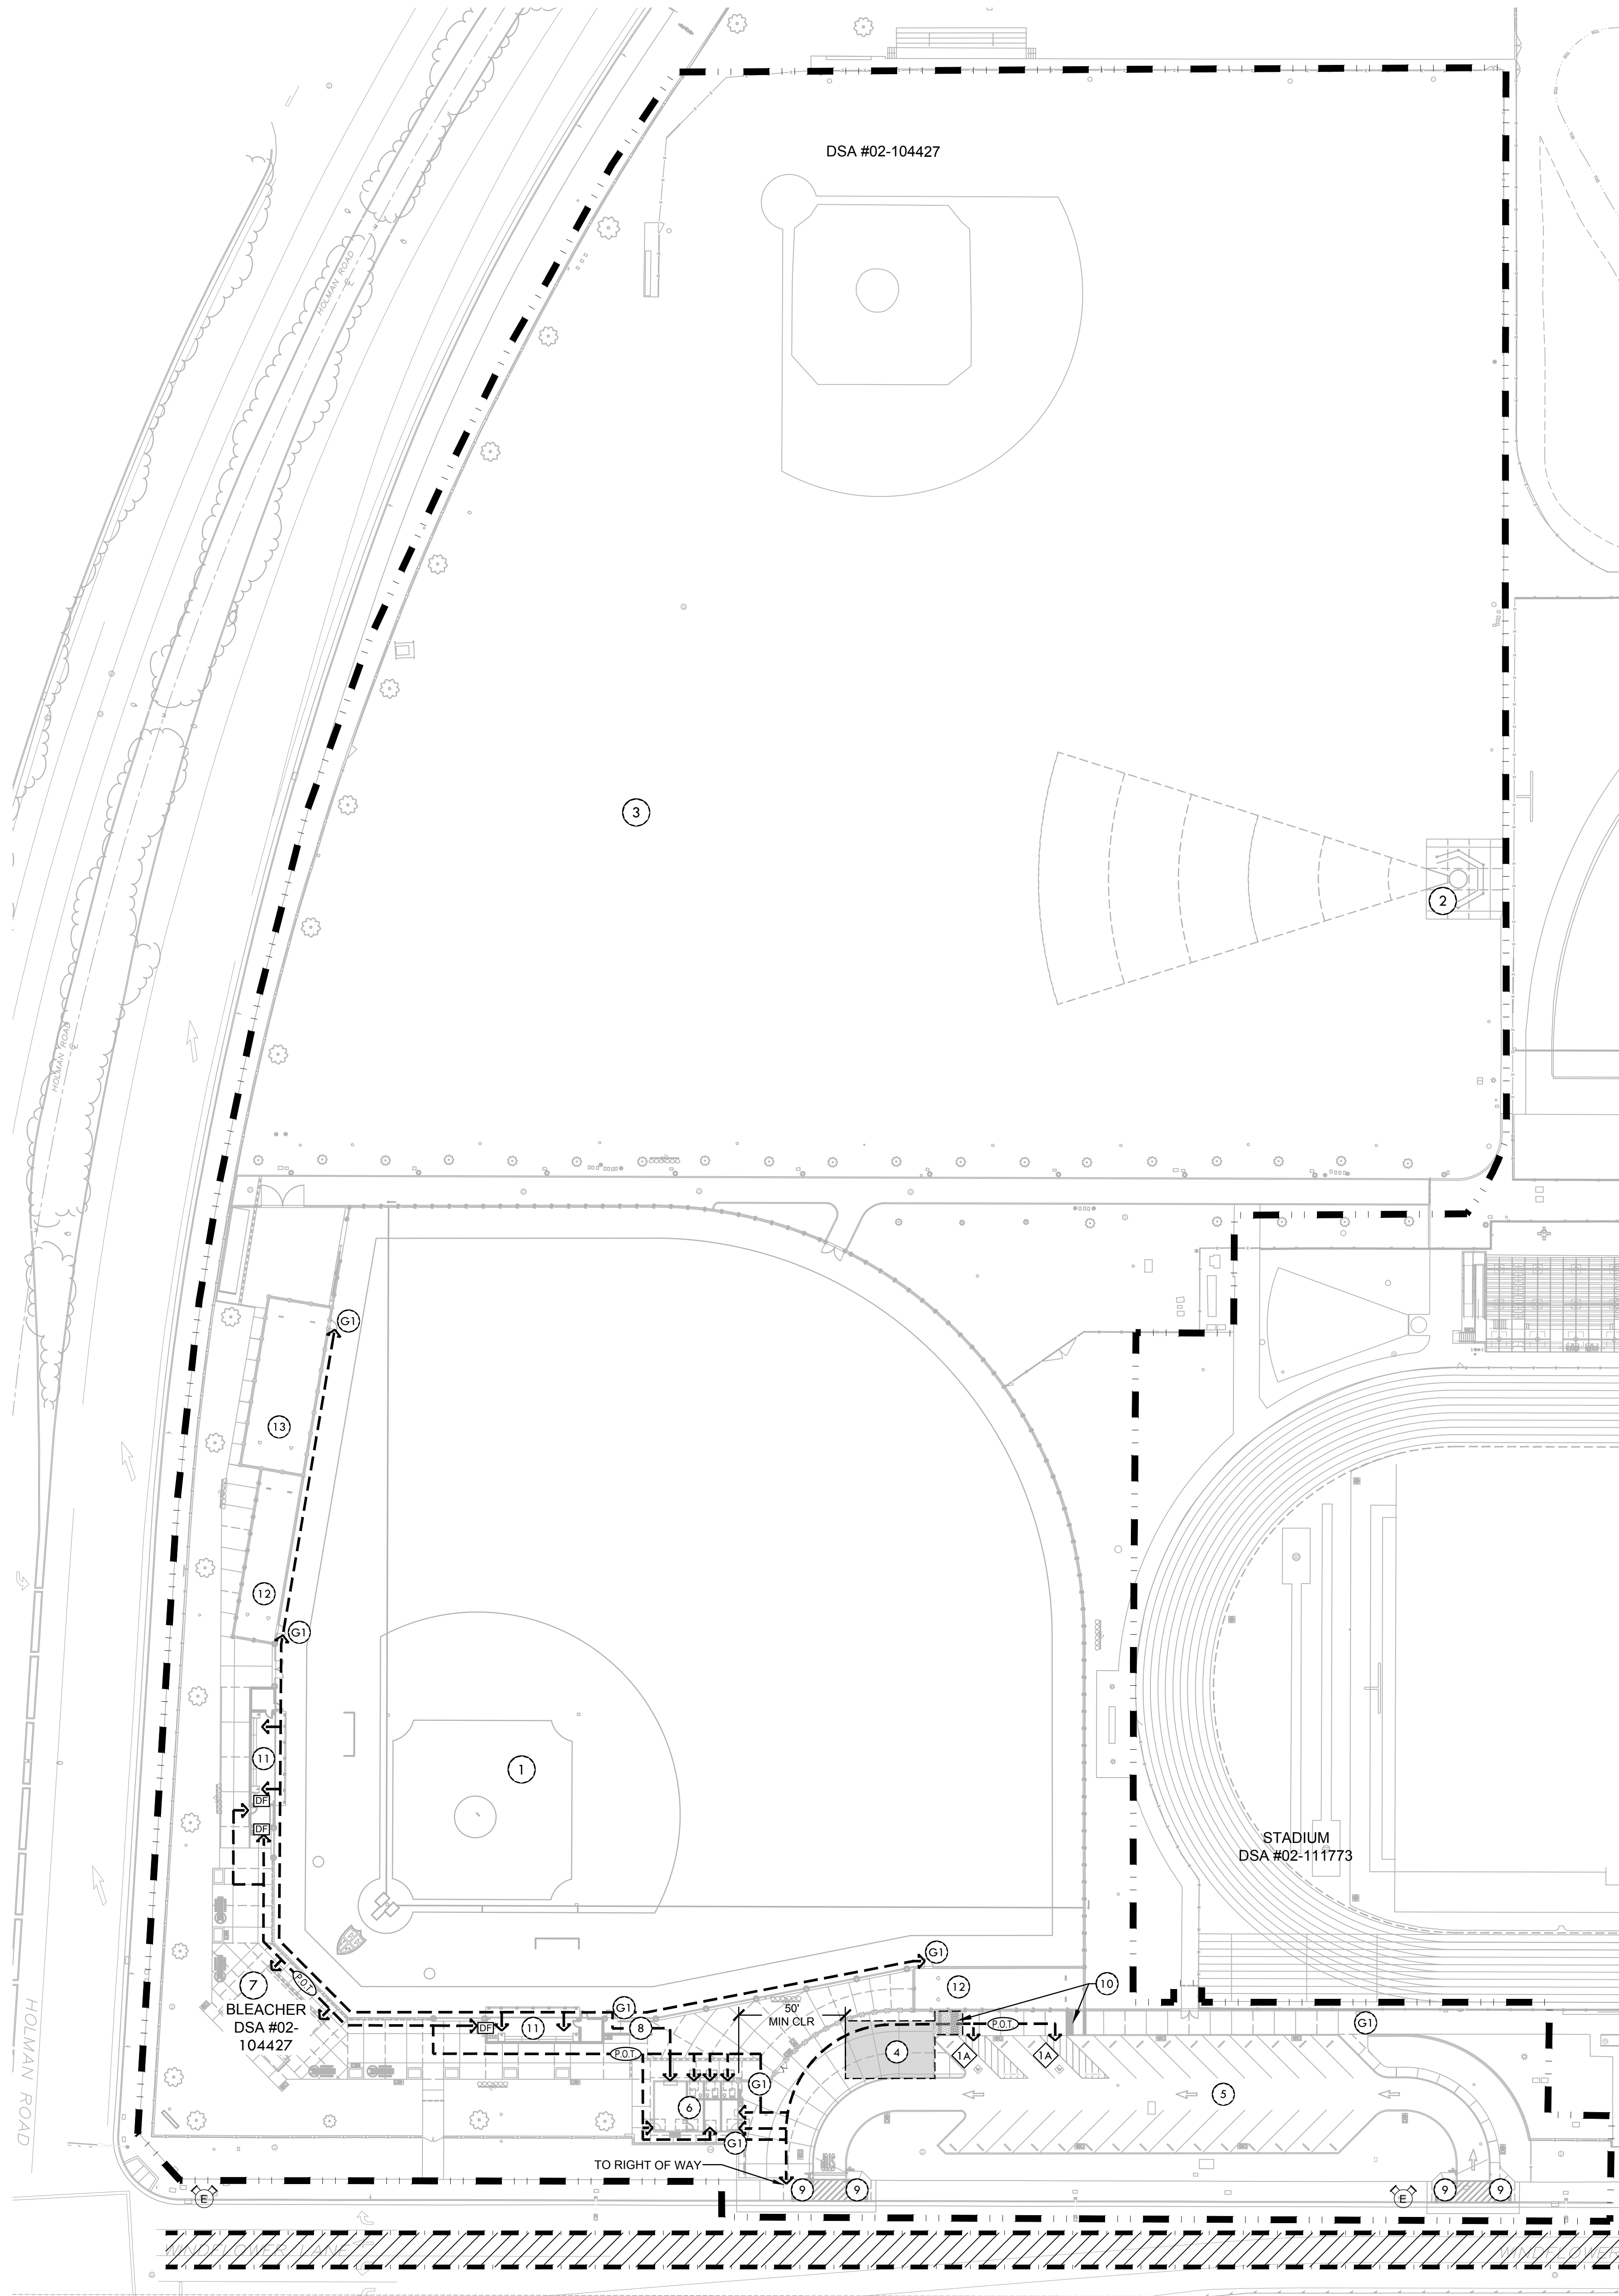

| ACCESSIBILITY LEGEND |  |              |
|----------------------|--|--------------|
| SYM                  | DESCRIPTION  | DTL REF      |
|                      | PROJECT LIMIT OF WORK  |              |
|                      | ACCESSIBLE PATH OF TRAVEL  |              |
|                      | FIRE DEPARTMENT ACCESS (20' WIDE & RATED 96,000 LBS)                                 |              |
|                      | PEDESTRIAN ACCESS  |              |
|                      | NEW ACCESSIBLE DRINKING FOUNTAINS  | (H/1)        |
|                      | EXISTING FIRE HYDRANT  | (D1.1)       |
|                      | NUMBER OF PARKING STALLS   | (A)          |
|                      | NUMBER OF ACCESSIBLE PARKING STALLS  | (A D3.0)     |
|                      | PROPOSED ACCESSIBLE GATE- 4' WIDE  | (A,B,C D4.1) |
|                      | PROPOSED BASEBALL FIELD (SYNTHETIC TURF)   |              |
|                      | PROPOSED DISCUS  |              |
|                      | PROPOSED MULTIUSE FIELD RENOVATION (NATURAL GRASS)                                   |              |
|                      | SAFE DISPERSAL AREA ( 27'x42' + 11'x13' = 1277 SF)                                   |              |
|                      | PROPOSED PARKING LOT (28 TOTAL STALLS)   |              |
|                      | PROPOSED ACCESSIBLE RESTROOMS/CONCESSION/TICKET BUILDING (REFER TO ENVIROPLEX PLANS) |              |
|                      | EXISTING BLEACHERS   | (A/B D3.0)   |
|                      | PROPOSED RAMP @ DUGOUT   | (L D3.0)     |
|                      | PROPOSED RAMP @ CROSSWALK  | (L D3.0)     |
|                      | PROPOSED CURB RAMP (PARKING LOT)   | (A D3.0)     |
|                      | PROPOSED DUGOUTS (REFER TO A8.0 AND A8.1)  |              |
|                      | PROPOSED BULLPENS  | (A/B D5.1)   |
|                      | PROPOSED BATTING CAGE  | (E D5.1)     |

### ACCESSIBILITY PLAN NOTES

1. ACCESSIBLE PATH OF TRAVEL AS INDICATED ON PLAN IS A BARRIER FREE ACCESS ROUTE WITHOUT ANY ABRUPT LEVEL CHANGES EXCEEDING 1/2" BEVELED AT 1:2 MAX. SLOPE, OR VERTICAL LEVEL CHANGES EXCEEDING 1/2" MAX. AND A LEAST 48" WIDE. SURFACE IS SLIP RESISTANT, STABLE, FIRM, AND SMOOTH. CROSS SLOPE DOES NOT EXCEED 2% AND SLOPE IN THE DIRECTION OF TRAVEL IS LESS THAN 5% UNLESS OTHERWISE INDICATED. GRATING WHICH OCCUR WITHIN THE P.O.T. SHALL HAVE GRID OPENINGS AT 1/2" MAXIMUM IN THE DIRECTION OF TRAFFIC FLOW PER CBC SECTION 11B-302.5.

2. ACCESSIBLE PATH OF TRAVEL SHALL BE MAINTAINED FREE OF OVERHANGING OBSTRUCTIONS TO 80" MINIMUM AND PROTRUDING OBJECTS GREATER THAN 4" PROJECTED FROM WALL AND ABOVE 27" AND LESS THAN 80". ARCHITECT SHALL VERIFY THAT THERE ARE NO BARRIERS IN THE PATH OF TRAVEL.

3. "PASSING SPACES (11B-403.5.3) OF 60"x60" MIN. ARE LOCATED NOT MORE THAN 200' APART. WALKS WITH CONTINUOUS GRADIENTS HAVE 60" IN LENGTH OF LEVEL AREAS (11B-403.7) NOT MORE THAN 400' APART. OBJECTS PROTRUDING INTO THE P.O.T. SHALL NOT REDUCE THE CLEAR WIDTH OR MANEUVERING SPACE REQUIRED FOR ACCESSIBLE ROUTES(11B-307.5). THERE IS NO DROP-OFF OVER 4" AT THE EDGE OF WALK OR LANDING UNLESS IDENTIFIED BY A GUARD, A HANDRAIL, OR A WARNING CURB AT LEAST 6" IN HEIGHT ABOVE THE WALK(11B-303.5)."

4. ACCESSIBLE PARKING  
SIGNAGE REQUIREMENTS: THE AMENDED REGULATIONS INDICATE THAT THE SIGNAGE AT ACCESSIBLE PARKING SPACES SHALL INCLUDE "MINIMUM FINE \$250" BELOW THE INTERNATIONAL SYMBOL OF ACCESSIBILITY AS EITHER AN ADDITIONAL SIGN OR ADDITIONAL LANGUAGE. THIS FINE POSTING REQUIREMENT IS IN ADDITION TO OTHER SIGNAGE REGULATIONS CONTAINED IN THE CALIFORNIA BUILDING CODE FOR ACCESSIBLE PARKING SPACES.

STRIPING REQUIREMENTS: THE REVISED REGULATIONS INDICATE THAT THE ACCESSIBLE PARKING SPACE STRIPING SHALL BE AS FOLLOWS. THE BORDER (PERIMETER) SHALL BE PAINTED BLUE. THE HATCHING WITHIN THE LOADING AND UNLOADING ACCESS AISLE SHALL BE PAINTED A SUITABLE CONTRASTING COLOR TO THE PARKING SPACE AT 3'-0" MAXIMUM ON CENTER. BLUE OR WHITE PAINT IS PREFERRED.

CBC 11B 208.2  
DESIGN PROFESSIONAL IN GENERAL RESPONSIBLE CHARGE STATEMENT:  
THE POT IDENTIFIED IN THESE CONSTRUCTION DOCUMENTS IS COMPLIANT WITH CURRENT APPLICABLE CALIFORNIA BUILDING CODE ACCESSIBILITY PROVISIONS FOR PATH OF TRAVEL REQUIREMENTS AND STRUCTURAL REPAIRS. AS PART OF THE DESIGN OF THIS PROJECT, THE POT WAS EXAMINED AND ANY ELEMENTS, COMPONENTS OR PORTION OF THE POT THAT WERE DETERMINED TO BE NONCOMPLIANT 1) HAVE BEEN IDENTIFIED AND 2) THE CORRECTIVE WORK NECESSARY TO BRING THEM INTO COMPLIANCE HAS BEEN INCLUDED WITHIN THE SCOPE OF THIS PROJECT'S WORK THROUGH DETAILS, DRAWINGS AND SPECIFICATIONS INCORPORATED INTO THESE CONSTRUCTION DOCUMENTS. ANY NONCOMPLIANT ELEMENTS, COMPONENTS OR PORTION OF THE POT THAT WILL NOT BE CORRECTED BY THIS PROJECT BASED ON VALUATION THRESHOLD LIMITATIONS OR A FINDING OF UNREASONABLE HARDSHIP ARE SO INDICATED IN THESE CONSTRUCTION DOCUMENTS.  
DURING CONSTRUCTION, IF POT ITEMS WITHIN THE SCOPE OF THE PROJECT REPRESENTED AS CODE COMPLIANT ARE FOUND TO BE NONCONFORMING BEYOND REASONABLE CONSTRUCTION TOLERANCES, THEY SHALL BE BROUGHT INTO COMPLIANCE WITH THE CBC AS PART OF THIS PROJECT BY MEANS OF A "CONSTRUCTION CHANGE DOCUMENT" (FORM DSA 140).

### SAFE DISPERSAL AREA

| AREA                        | OCCUPANCY            | CALCULATIONS (PER CBC 1004.2.1)  |
|-----------------------------|----------------------|--|
| EXISTING BASEBALL BLEACHERS | 208 (INCLUDES 2 ADA) | TOTAL OCCUPANCY LOAD = 208 PEOPLE<br>REQUIRED SAFE DISPERSAL AREA: 208 X 5 SQ FT. = 1040 SQ FT.<br>PROVIDED AREA = 1040 SQ FT. |
| BASEBALL FIELD & DUGOUTS    | 42                   | TOTAL OCCUPANCY LOAD = 42 PEOPLE<br>REQUIRED SAFE DISPERSAL AREA: 42 X 5 SQ FT. = 210 SQ FT.<br>PROVIDED AREA = 210 SQ FT.     |
| CONCESSION/ TICKET          | 5                    | TOTAL OCCUPANCY LOAD = 5 PEOPLE<br>REQUIRED SAFE DISPERSAL AREA: 5 X 5 SQ FT. = 25 SQ FT.<br>PROVIDED AREA = 25 SQ FT.         |

### PARKING COUNTS

| TOTAL (e) | (e) STANDARD | (e) | (e) | REQUIRED ADA STALLS | REQUIRED | TOTAL NEW PARKING REQUIRED |
|-----------|--------------|-----|-----|---------------------|----------|----------------------------|
| 0         | 0            | 0   | 0   | 0                   | 0        | 0                          |

PROPOSED PARKING

| STANDARD |   |   | TOTAL |
|----------|---|---|-------|
| 26       | 1 | 1 | 28    |



810

### FIRE & LIFE SAFETY SITE CONDITIONS SUBMITTAL

To facilitate the Division of the State Architect's (DSA) fire and life safety plan review of project site conditions, DSA requires the design professional to provide the following information at time of project submittal for projects consisting of construction of a new campus, construction of new building(s), additions to existing buildings, and for site alternate design means for fire department emergency vehicle access, and fire suppression water supply.

Information associated with compliance items 1-3 below is to be provided for all project types indicated above. Information associated with items 4-7 is to be completed when an alternate means is utilized. Acknowledgement by the school district and signature from the local fire authority (LFA) is only required when an alternate design means is being requested.

Page 1 of the completed form must be imaged onto the fire access site plan. When an alternate design/means is proposed, completed pages 1 and 2 are to be imaged on the fire access site plan.

For additional information refer to the instructions at the end of this form and [DSA Policy 08-01](#).

|  |                                     |  |  |
|--|-------------------------------------|--|--|
| <b>PROJECT INFORMATION</b>   |                                     |  |  |
| School District/Owner: Stockton Unified School District <i>LFA: STOCKTON FIRE DEPT.</i>  |                                     |  |  |
| Project Name/School: Chavez High School <i>Phil Simon, Assistant Fire Marshal</i>  |                                     |  |  |
| Project Address: 2929 Windflower Lane, Stockton, CA 95212 <i>2929 10/29/19</i>   |                                     |  |  |
| <b>FIRE &amp; LIFE SAFETY INFORMATION</b>  |                                     |  |  |
| 1. Has a fire hydrant flow test been performed within the past 12 months?<br>(If yes, provide a copy of the test data.)  | Yes <input type="checkbox"/>        | No <input checked="" type="checkbox"/> |  |
| 2. Was the fire hydrant water flow test performed as part of this LFA review?  | Yes <input type="checkbox"/>        | No <input checked="" type="checkbox"/> |  |
| 3. Is the project located within a designated fire hazard severity zone as established by Cal-Fire? (If yes, indicate fire hazard zone classification below)   | Yes <input type="checkbox"/>        | No <input checked="" type="checkbox"/> |  |
| Refer to the following for fire hazard zone locations:<br><a href="http://www.fire.ca.gov/lfa_prevention_fire_suppression_wildland_zones_maps">www.fire.ca.gov/lfa_prevention_fire_suppression_wildland_zones_maps</a> |                                     |  | Moderate <input type="checkbox"/> High <input type="checkbox"/> Very High <input type="checkbox"/> |
| Wildland Interface Area (WIFA) (If any designations are checked, project design must meet the requirements of CBC Chapter 7A.)   |                                     |  | WIFA <input type="checkbox"/>  |
| <b>CONDITION MEANS AND METHODS RESOLUTION</b>  |                                     |  |  |
|  | Yes                                 | No                                     | N/A N/R  |
| 4. Emergency vehicle access roadways do not meet CFC requirements.   |                                     | <input checked="" type="checkbox"/>    |  |
| 4a. Acceptable Alternate: Emergency vehicle and personnel access as proposed by the project architect is acceptable for providing fire suppression and protection of life and property.                                | <input checked="" type="checkbox"/> |  |  |
| 5. Fire Hydrants: Number and spacing does not meet CFC requirements.   |                                     | <input checked="" type="checkbox"/>    |  |
| 5a. Acceptable Alternate: Number of fire hydrants and spacing as proposed by the project architect is acceptable for fire suppression and protection of life and property.   | <input checked="" type="checkbox"/> |  |  |
| 6. Fire Hydrants: Water flow and pressure are less than CFC minimum.   |                                     | <input checked="" type="checkbox"/>    |  |
| 6a. Acceptable Alternate: The available flow and pressure is acceptable for providing fire suppression and protection of life and property.  |                                     | <input checked="" type="checkbox"/>    |  |
| 7. Location of fire department connection(s) serving fire sprinkler systems or standpipe systems does not meet CFC requirements.   |                                     | <input checked="" type="checkbox"/>    |  |
| 7a. Acceptable Alternate: The location of fire department connection serving the fire sprinkler system and/or standpipe system is acceptable for providing fire suppression and protection of life and property.       |                                     | <input checked="" type="checkbox"/>    |  |

DSA 810 (rev 10-22-18) DIVISION OF THE STATE ARCHITECT DEPARTMENT OF GENERAL SERVICES STATE OF CALIFORNIA Page 1 of 4

### DSA 810 FIRE & LIFE SAFETY SITE CONDITIONS SUBMITTAL

School District Acceptance of Acceptable Design Alternates  
By signing this form, the school district acknowledges and accepts the proposed design as an alternative to California Building Code (CBC) and California Fire Code (CFC) minimum requirements, as indicated by one or more of the conditions indicated at items 4a, 5a, 6a or 7a, for providing fire and life safety protection of life and property.

Accepted by: STEVE L. BRECKFIELD Title: DIRECTOR  
Signature: [Signature] Date: 12/20/19

|   |  |
|---|--|
| <b>LOCAL FIRE AUTHORITY (LFA) INFORMATION</b> |  |
| LFA Agency Name: Stockton Fire Department     |  |
| LFA Review Official: Phil Simon               |  |
| Title: Assistant Fire Marshal                 |  |
| Work E-mail: philsimon@stocktonca.gov         |  |

|   |  |
|---|--|
| IDENTIFICATION STAMP<br>DIV. OF THE STATE ARCHITECT<br>APP. 02-118017 INC.<br>REVIEWED FOR<br>SS <input type="checkbox"/> FLS <input type="checkbox"/> ACS <input type="checkbox"/><br>DATE: 04/10/2020 |  |
|---|--|

**VERDE DESIGN**  
LANDSCAPE ARCHITECTURE  
CIVIL ENGINEERING  
SPORT PLANNING & DESIGN  
1843 Iron Point Rd #140  
Folsom, CA 95630  
tel: 916.415.6554  
fax: 408.985.7260  
www.VerdeDesign.com



STAMP

CONSULTANT

KEYMAP

SHEET TITLE

### ACCESSIBILITY PLAN

PROJECT NAME

CHAVEZ HIGH SCHOOL  
STOCKTON USD  
ATHLETIC FACILITY  
IMPROVEMENTS

PROJECT ADDRESS

2929 WINDFLOWER LN  
STOCKTON, CA 95212

| SUBMITTAL               | DATE     |
|-------------------------|----------|
| DD/50% SUBMITTAL        | 10/25/19 |
| DSA SUBMITTAL           | 12/20/19 |
| DSA BACKCHECK SUBMITTAL | 03/27/20 |


| NO. | REVISIONS | DATE |
|-----|-----------|------|
| △   |           |      |
| △   |           |      |
|                         |                    |
|-------------------------|--------------------|
| DRAWN BY: HM            | CHECKED BY: CS     |
| DATE ISSUED: 03/27/20   | SCALE: 1" = 40'-0" |
| PROJ. NO.: 1910900-1211 |                    |

SHEET NO. **L1.0** 2 OF 122  
ACCESSIBILITY PLAN



ALL DESIGN, ENGINEERING, AND ARCHITECTURAL SERVICES ARE THE PROPERTY OF VERDE DESIGN, INC. AND WILL BE PROVIDED TO ANY PERSON, FIRM, OR CORPORATION FOR ANY PURPOSE WITHOUT LIMITATION OF TIME OR WITHOUT THE NEED FOR ANY FURTHER AGREEMENT OR PERMISSION. NO PART OF THIS DOCUMENT SHALL BE REPRODUCED, COPIED, OR TRANSMITTED IN ANY FORM OR BY ANY MEANS, ELECTRONIC OR MECHANICAL, INCLUDING PHOTOCOPYING, RECORDING, OR BY ANY INFORMATION STORAGE AND RETRIEVAL SYSTEM, WITHOUT THE WRITTEN PERMISSION OF VERDE DESIGN, INC. VERDE DESIGN, INC. IS NOT RESPONSIBLE FOR ANY ERRORS OR OMISSIONS IN THIS DOCUMENT. VERDE DESIGN, INC. IS NOT RESPONSIBLE FOR ANY ERRORS OR OMISSIONS IN THIS DOCUMENT. VERDE DESIGN, INC. IS NOT RESPONSIBLE FOR ANY ERRORS OR OMISSIONS IN THIS DOCUMENT.

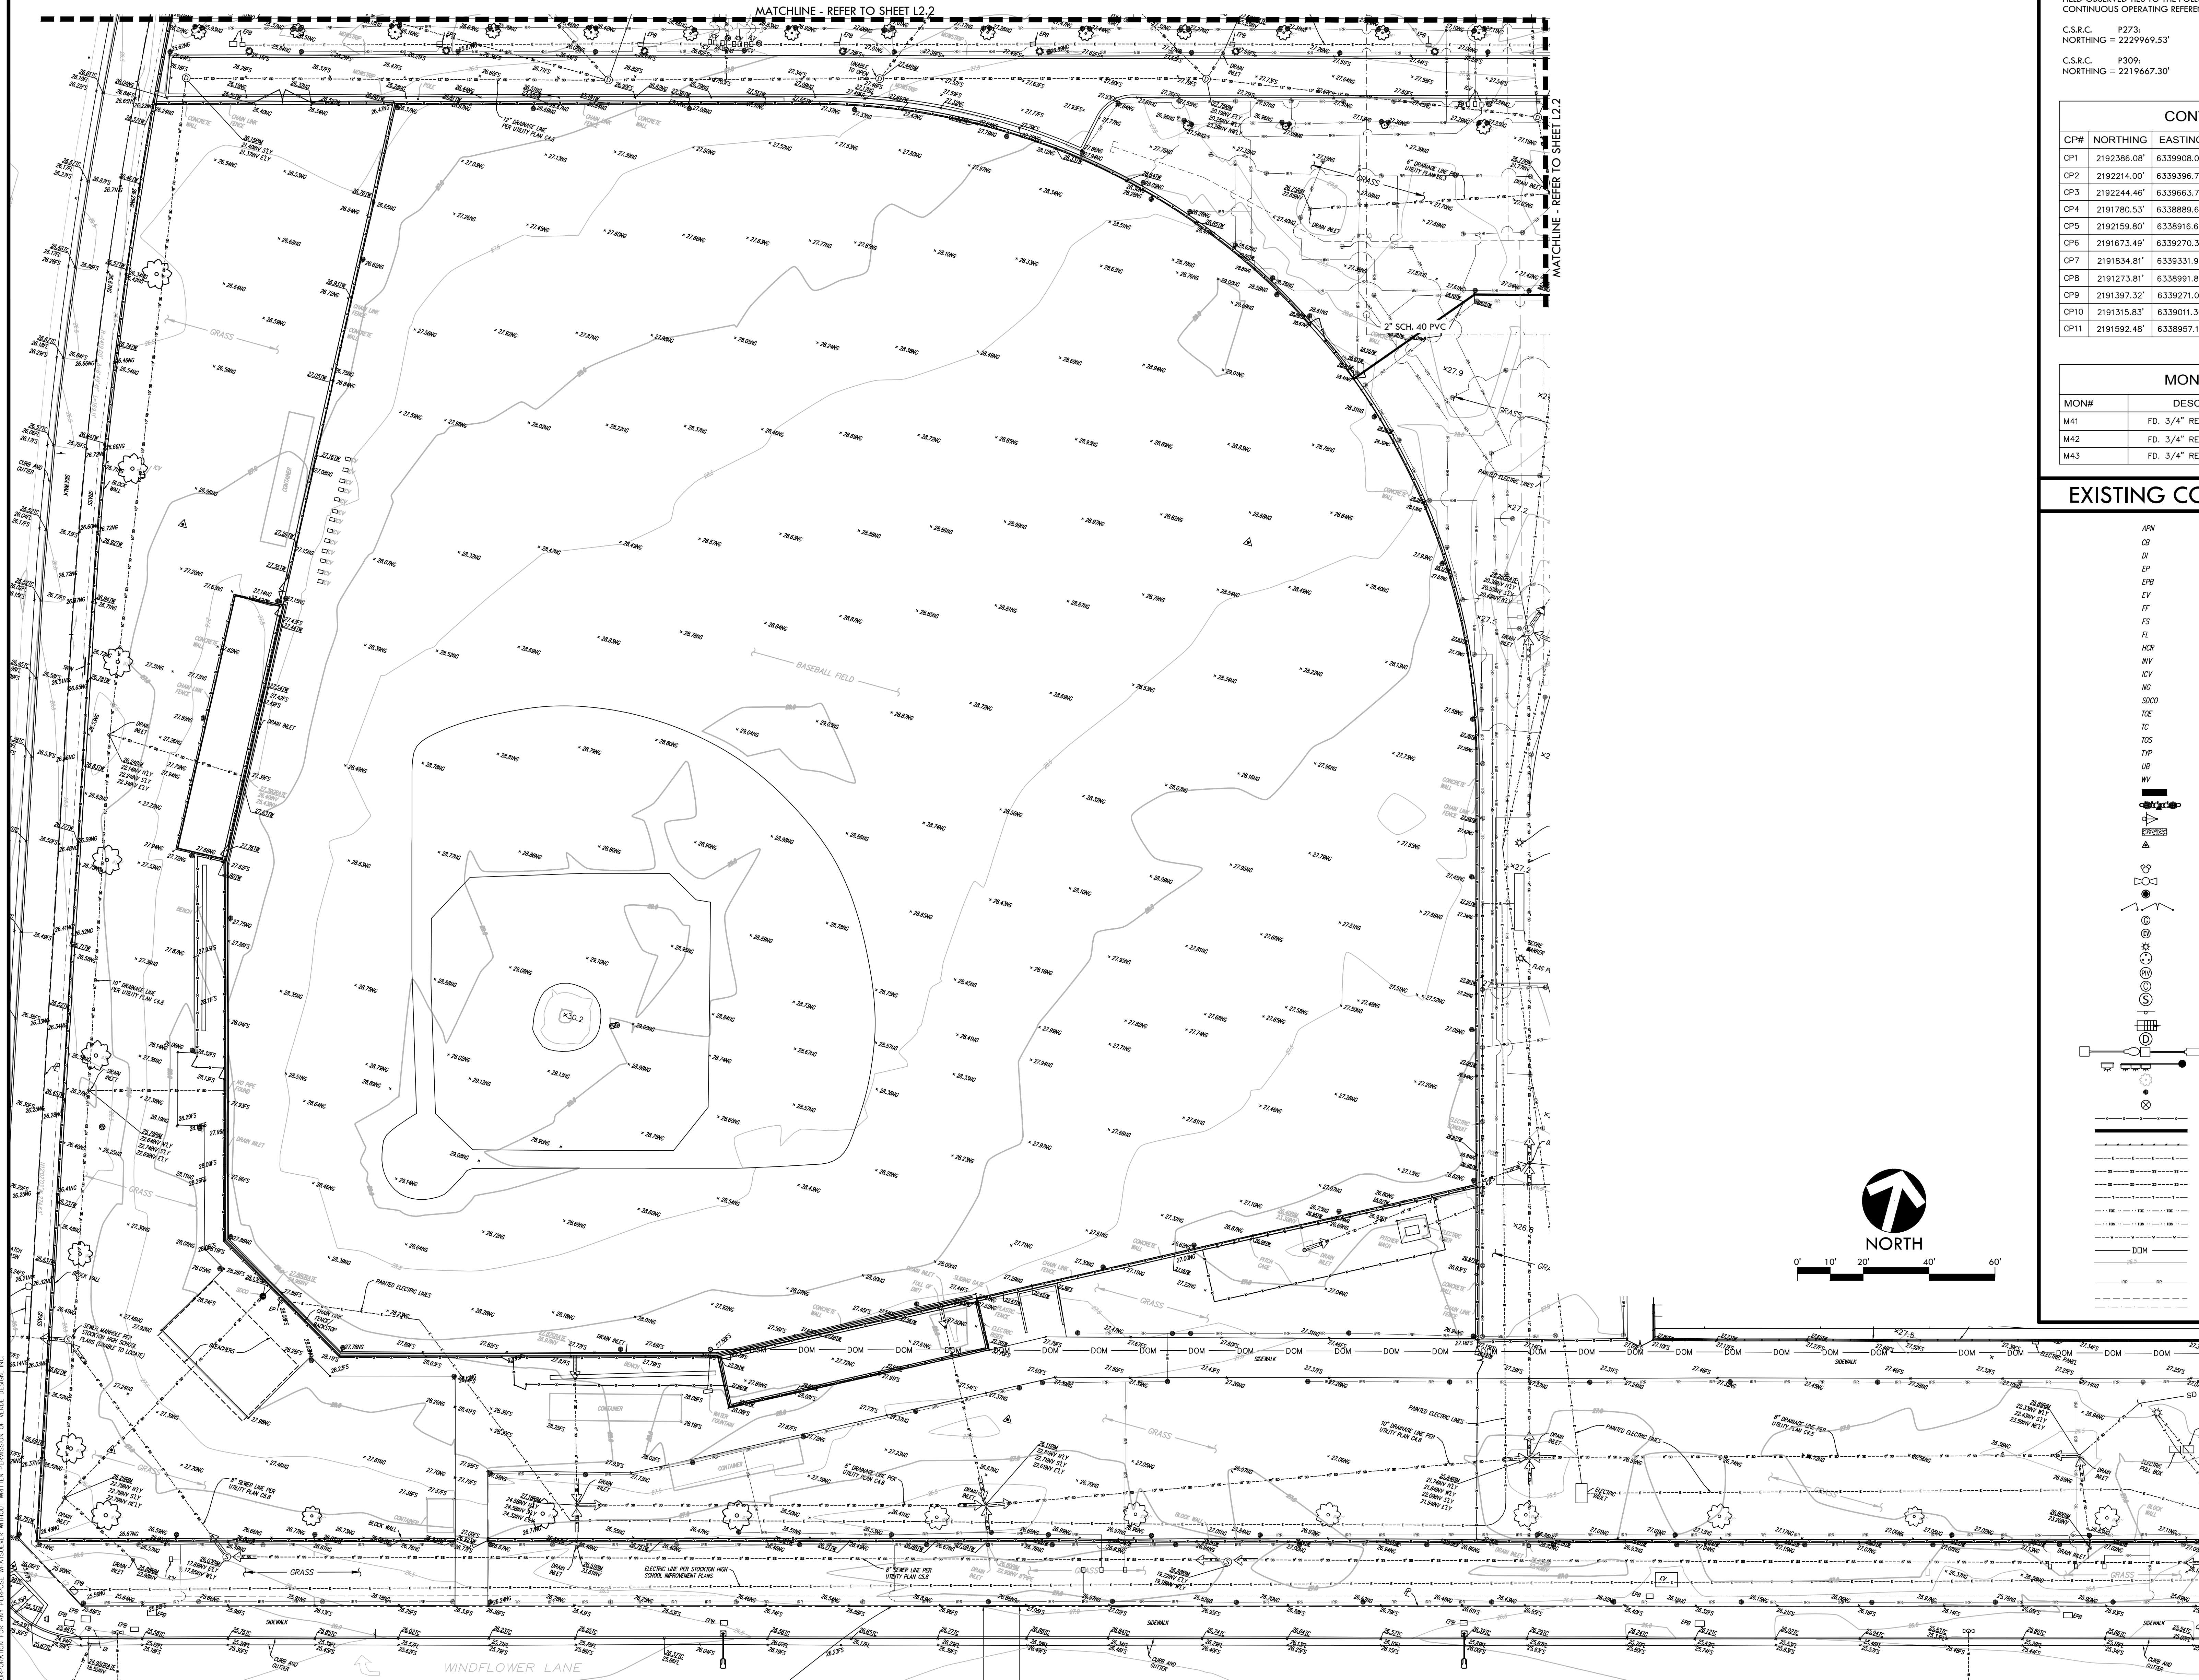

## EXISTING CONDITIONS NOTES

- SURVEY PROVIDED BY: CAL VADA SURVEYING, INC.
  - ASSESSOR'S PARCEL NO.: 130-040-03
  - ELEVATIONS SHOWN HEREON ARE BASED UPON STOCKTON CITY BENCHMARK 341, ELEVATION 28.83 FEET (NAVD 83).
  - 5/8" ALUMINUM ROD DRIVEN TO REFUSAL WITH 2-1/2" DIAMETER ALUMINUM CAP STAMPED "WELL 26, L.S. 4334" IN AN ALUMINUM MONUMENT WELL WITH SCREW LOCKING COVER; BENCH MARK IN LOCATED WITHIN THE LOCKED CITY OF STOCKTON WELL SITE NO. 26, ON SOUTH SIDE OF HAMMER LN, ON THE WEST SIDE OF THE EBMUD RIGHT-OF-WAY. THE POINT LIES IN CENTER OF PAVED AREA EAST OF WELL BUILDING. CONTACT THE CITY OF STOCKTON SURVEYS SECTION FOR ACCESS.
  - FIELD COMPLETION DATE: 08/07/19
  - FINAL SURVEY ISSUED: 10/15/19, UPDATED 11/26/19
  - THE BEARINGS SHOWN HEREON ARE BASED UPON THE CALIFORNIA COORDINATE SYSTEM OF 1983, CC83, ZONE 3, (2017.50) IN ACCORDANCE TO THE CALIFORNIA PUBLIC RESOURCES CODE SECTIONS 8801-8819, SAID BEARINGS ARE DETERMINED LOCALLY UPON FIELD-OBSERVED TIES TO THE FOLLOWING CALIFORNIA SPATIAL REFERENCE NETWORK CONTINUOUS OPERATING REFERENCE STATIONS (CORS).
- C.S.R.C. P273: NORTHING = 2229969.53' EASTING = 6306178.61'  
C.S.R.C. P309: NORTHING = 2219667.30' EASTING = 6431806.86'

## CONTROL POINTS

| CP#  | NORTHING    | EASTING     | ELEVATION | DESCRIPTION              |
|------|-------------|-------------|-----------|--------------------------|
| CP1  | 2192386.08' | 6339908.09' | 28.42'    | SET MAGNETIC NAIL/SHINER |
| CP2  | 2192214.00' | 6339396.78' | 25.56'    | SET CHISELED "X"         |
| CP3  | 2192244.46' | 6339663.76' | 25.62'    | SET 60DN                 |
| CP4  | 2191780.53' | 6338889.60' | 26.17'    | SET CHISELED "X"         |
| CP5  | 2192159.80' | 6338916.65' | 26.98'    | SET CHISELED "X"         |
| CP6  | 2191673.49' | 6339270.32' | 28.61'    | SET 1X2 WOOD HUB & TAG   |
| CP7  | 2191834.81' | 6339331.96' | 27.54'    | SET MAGNETIC NAIL/SHINER |
| CP8  | 2191273.81' | 6338991.86' | 26.07'    | SET CHISELED "X"         |
| CP9  | 2191397.32' | 6339271.01' | 27.39'    | SET WOOD 1X2 HUB & TAG   |
| CP10 | 2191315.83' | 6339011.30' | 27.00'    | SET WOOD 1X2 HUB & TAG   |
| CP11 | 2191592.48' | 6338957.11' | 26.84'    | SET WOOD 1X2 HUB & TAG   |

## MONUMENT NOTES



| MON# | DESCRIPTION                                     |
|------|---|
| M41  | FD. 3/4" REBAR WITH PLASTIC PLUG TAGGED LS 7520 |
| M42  | FD. 3/4" REBAR WITH PLASTIC PLUG TAGGED LS 7520 |
| M43  | FD. 3/4" REBAR WITH PLASTIC PLUG TAGGED LS 7520 |

## EXISTING CONDITIONS LEGEND

- APN ASSESSOR'S PARCEL NUMBER  
CB CATCH BASIN  
DI DRAIN INLET  
EP ELECTRIC PANEL  
EPB ELECTRIC PULL BOX  
EV ELECTRIC VAULT  
FF FINISH FLOOR  
FS FINISH SURFACE  
FL FLOW LINE  
HOP HANDICAP RAMP  
INW INVERT  
ICV IRRIGATION CONTROL VALVE  
NG NATURAL GROUND  
SDOQ STORM DRAIN CLEAN OUT  
TOE TOE OF SLOPE  
TIC TOP OF CURB  
TOS TOP OF SLOPE  
TYP TYPICAL  
UB UTILITY BOX  
WV WATER VAULT  
ASPH ASPHALT PAVEMENT  
BKF BACK-FLOW VALVE  
BKT BASKETBALL  
CONC CONCRETE PAVEMENT  
CP CONTROL POINT  
FDC FIRE DEPARTMENT CONNECTION  
FH FIRE HYDRANT  
FM FOUND MONUMENT AS NOTED  
GATE  
GE GROUND ELECTRIC  
IG IRRIGATION CONTROL VALVE  
LS LIGHT STANDARD  
MANH MANHOLE  
PIV POST INDICATOR VALVE  
SCV SEWER CLEAN OUT  
SMV SEWER MANHOLE  
SIGN  
SDS STAIRS SHOWING DOWNWARD DIRECTION  
SDM STORM DRAIN MANHOLE  
SL STREET LIGHT  
TL TRAFFIC LIGHT  
TR TREE (TYPICAL)  
WS WATER SPOONER  
WV WATER VALVE  
WLF WATER LINE FENCE  
WLF CONCRETE/RETAINING WALL  
EOP EDGE OF PAVEMENT  
EL ELECTRIC LINE  
SL SANITARY SEWER LINE  
SDM STORM DRAIN LINE  
TEL TELECOM LINE  
TOS TOE OF SLOPE  
TOS TOE OF SLOPE  
WL WATER LINE  
DWL DOMESTIC WATER LINE  
CONTOUR  
EIR EXISTING IRRIGATION LATERAL LINE PER DISTRICT PROVIDED AS-BUILT DRAWINGS  
EIR EXISTING IRRIGATION MAINLINE OR QUICK COOLER MAINLINE PER DISTRICT PROVIDED AS-BUILT DRAWINGS



0' 10' 20' 40' 60'

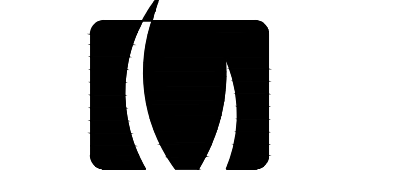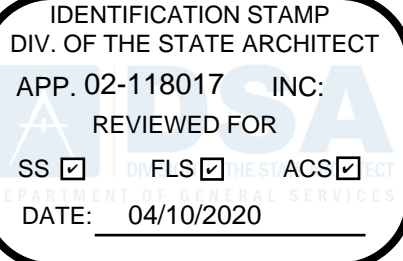


VERDE DESIGN  
LANDSCAPE ARCHITECTURE  
CIVIL ENGINEERING  
SPORT PLANNING & DESIGN  
1843 Iron Point Rd #140  
Folsom, CA 95630  
tel: 916.415.6554  
fax: 408.985.7260  
www.VerdeDesignInc.com



Armando D. DuPont  
Registration No. 7780

CONSULTANT

CAL VADA SURVEYING, INC.  
411 Jinks Cir., Suite 205, Corona, CA 92680  
Phone: 951-280-9980 Fax: 951-280-9746  
Toll Free: 800-CALVADA www.calvada.com  
EST. 1989 JOB NO. 19396

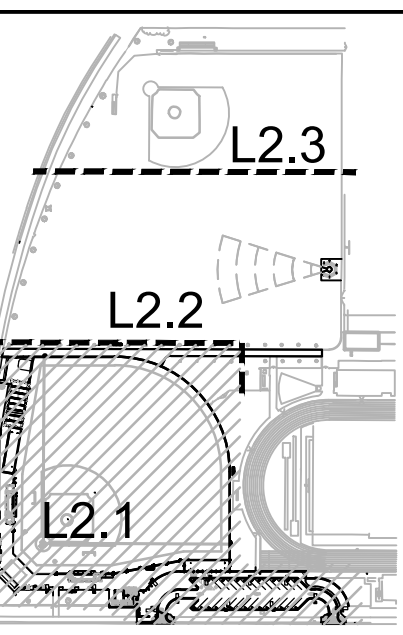

## EXISTING CONDITIONS PLAN - BASEBALL FIELD

PROJECT NAME  
CHAVEZ HIGH SCHOOL  
STOCKTON USD  
ATHLETIC FACILITY  
IMPROVEMENTS

PROJECT ADDRESS  
2929 WINDFLOWER LN  
STOCKTON, CA 95212

| SUBMITTAL               | DATE     |
|-------------------------|----------|
| DD/50% SUBMITTAL        | 10/25/19 |
| DSA SUBMITTAL           | 12/20/19 |
| DSA BACKCHECK SUBMITTAL | 03/27/20 |

| NO. | REVISIONS | DATE |
|-----|-----------|------|
| 1   |           |      |
| 2   |           |      |
| 3   |           |      |
| 4   |           |      |


DRAWN BY: AC CHECKED BY: CS  
DATE ISSUED: 03/27/20 SCALE: 1" = 20'-0"  
PROJ. NO.: 1910900-1211  
SHEET NO.: L2.1 3 OF 122

## EXISTING CONDITIONS PLAN - BASEBALL FIELD



ALL DESIGN, DRAWING, AND/OR CONSTRUCTION INFORMATION IS THE PROPERTY OF VERDE DESIGN, INC. AND IS NOT TO BE REPRODUCED, COPIED, OR USED IN ANY MANNER WITHOUT THE WRITTEN PERMISSION OF VERDE DESIGN, INC. VERDE DESIGN, INC. IS NOT RESPONSIBLE FOR ANY DAMAGE TO ANY PERSON, FIRM, OR ORGANIZATION FOR ANY REASON.

DRAWING NAME: Y:\Projects-FO\2019\1910900 - Chavez Restor\CAD\_EXC - Athletics.dwg  
PLOT DATE: 03-30-20 PLOTTED BY: station40

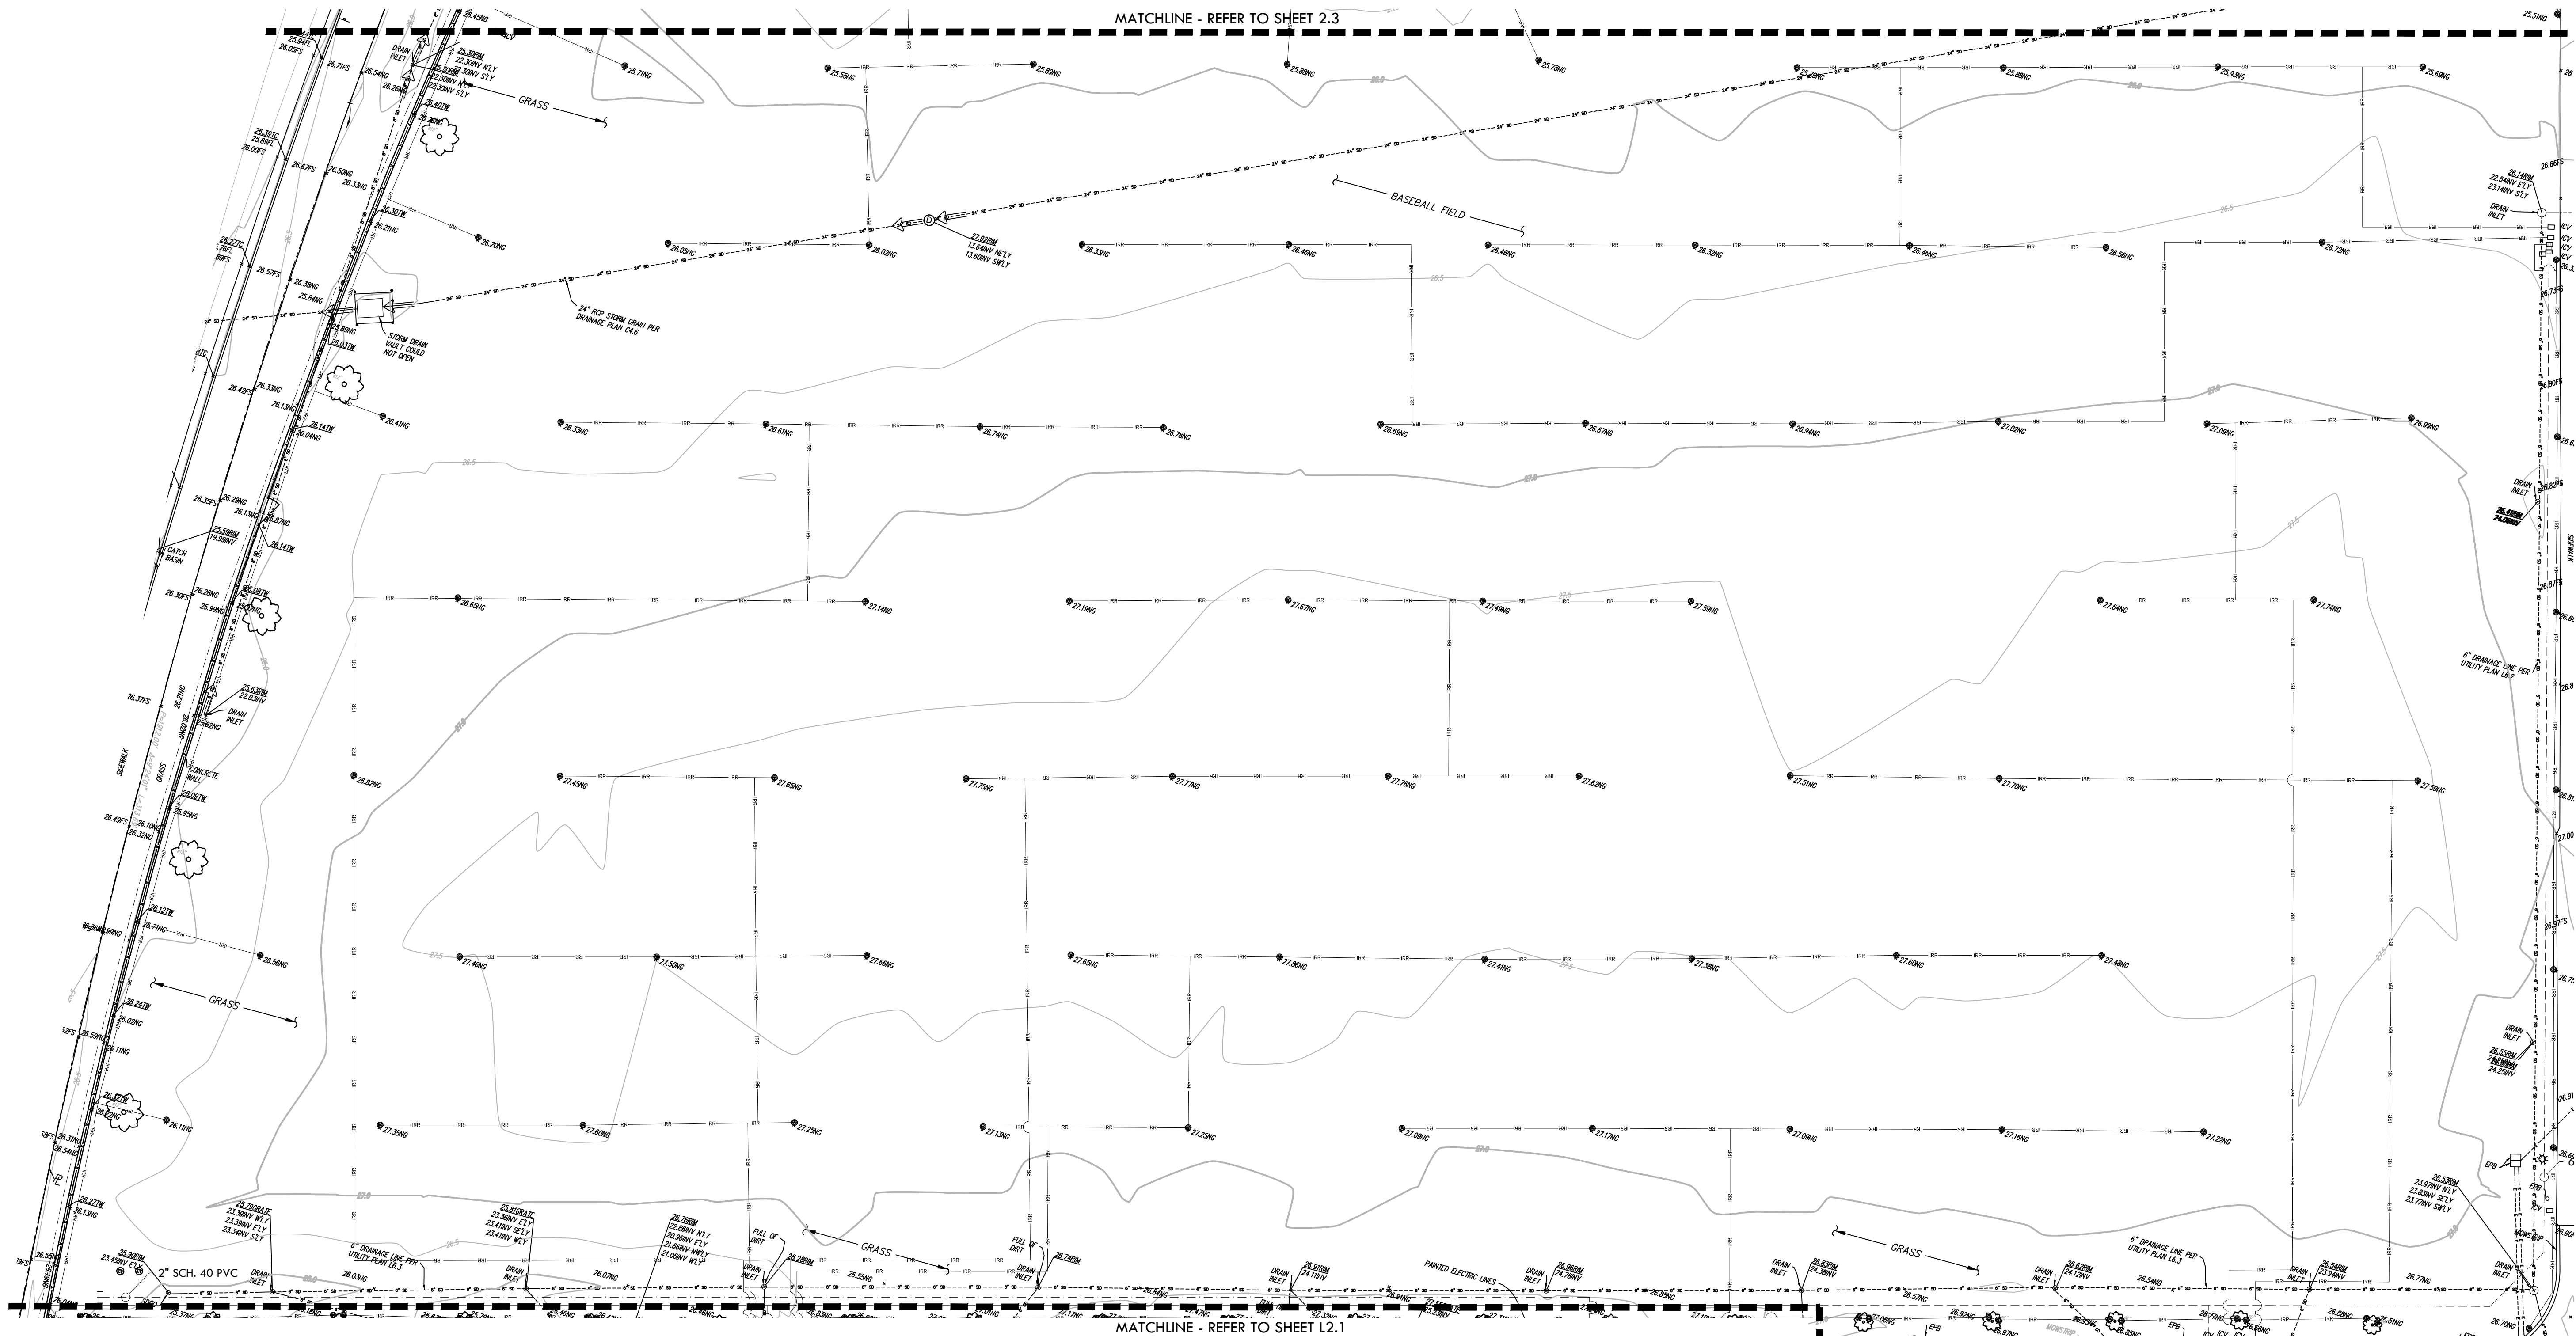

## EXISTING CONDITIONS NOTES

- SURVEY PROVIDED BY: CAL VADA SURVEYING, INC.
- ASSESSOR'S PARCEL NO.: 130-040-03
- ELEVATIONS SHOWN HEREON ARE BASED UPON STOCKTON CITY BENCHMARK 341, ELEVATION 28.83 FEET (NAVD 88).  
5/8" ALUMINUM ROD DRIVEN TO REFUSAL WITH 2-1/2" DIAMETER ALUMINUM CAP STAMPED "WELL 26, L.S. 4334," IN AN ALUMINUM MONUMENT WELL WITH SCREW LOCKING COVER; BENCH MARK IN LOCATED WITHIN THE LOCKED CITY OF STOCKTON WELL SITE NO. 26, ON SOUTH SIDE OF HAMMER LN, ON THE WEST SIDE OF THE EBMUD RIGHT-OF-WAY. THE POINT LIES IN CENTER OF PAVED AREA EAST OF WELL BUILDING. CONTACT THE CITY OF STOCKTON SURVEYS SECTION FOR ACCESS.
- FIELD COMPLETION DATE: 08/07/19
- FINAL SURVEY ISSUED: 10/15/19, UPDATED 11/26/19
- THE BEARINGS SHOWN HEREON ARE BASED UPON THE CALIFORNIA COORDINATE SYSTEM OF 1983, CC583, ZONE 3, (2017.50) IN ACCORDANCE TO THE CALIFORNIA PUBLIC RESOURCES CODE SECTIONS 8801-8819, SAID BEARINGS ARE DETERMINED LOCALLY UPON FIELD-OBSERVED TIES TO THE FOLLOWING CALIFORNIA SPATIAL REFERENCE NETWORK CONTINUOUS OPERATING REFERENCE STATIONS (C.O.R.S.):  
  
C.S.R.C. P273:  
NORTHING = 2229969.53' EASTING = 6306178.61'  
  
C.S.R.C. P309:  
NORTHING = 2219667.30' EASTING = 6431806.86'



 

 

 










 



 




 

 
 





 

 
## CONTROL POINTS



| CP#  | NORTHING    | EASTING     | ELEVATION | DESCRIPTION              |
|------|-------------|-------------|-----------|--------------------------|
| CP1  | 2192386.08' | 6339908.09' | 28.42'    | SET MAGNETIC NAIL/SHINER |
| CP2  | 2192214.00' | 6339396.78' | 25.56'    | SET CHISELED "X"         |
| CP3  | 2192244.46' | 6339663.76' | 25.62'    | SET 60DN                 |
| CP4  | 2191780.53' | 6338889.60' | 26.17'    | SET CHISELED "X"         |
| CP5  | 2192159.80' | 6338916.65' | 26.98'    | SET CHISELED "X"         |
| CP6  | 2191673.49' | 6339270.32' | 28.61'    | SET 1X2 WOOD HUB & TAG   |
| CP7  | 2191834.81' | 6339331.96' | 27.54'    | SET MAGNETIC NAIL/SHINER |
| CP8  | 2191273.81' | 6338991.86' | 26.07'    | SET CHISELED "X"         |
| CP9  | 2191397.32' | 6339271.01' | 27.39'    | SET WOOD 1X2 HUB & TAG   |
| CP10 | 2191315.83' | 6339011.30' | 27.00'    | SET WOOD 1X2 HUB & TAG   |
| CP11 | 2191592.48' | 6338957.11' | 26.84'    | SET WOOD 1X2 HUB & TAG   |

## MONUMENT NOTES

| MON# | DESCRIPTION                                     |
|------|---|
| M41  | FD. 3/4" REBAR WITH PLASTIC PLUG TAGGED LS 7520 |
| M42  | FD. 3/4" REBAR WITH PLASTIC PLUG TAGGED LS 7520 |
| M43  | FD. 3/4" REBAR WITH PLASTIC PLUG TAGGED LS 7520 |


## EXISTING CONDITIONS LEGEND

|   |   |
|---|---|
| APN   | ASSESSOR'S PARCEL NUMBER  |
| CB  | CATCH BASIN   |
| DI  | DRAIN INLET   |
| EP  | ELECTRIC PANEL  |
| EPB   | ELECTRIC PULL BOX   |
| EV  | ELECTRIC VAULT  |
| FF  | FINISH FLOOR  |
| FS  | FINISH SURFACE  |
| FL  | FLOW LINE   |
| HOR   | HANDICAP RAMP   |
| INVT  | INVERT  |
| ICV   | IRRIGATION CONTROL VALVE  |
| NG  | NATURAL GROUND  |
| SDCO  | STORM DRAIN CLEAN OUT   |
| TOE   | TOE OF SLOPE  |
| TC  | TOP OF CURB   |
| TOS   | TOP OF SLOPE  |
| TYP   | TYPICAL   |
| UB  | UTILITY BOX   |
| WV  | WATER VAULT   |
|  | ASPHALT PAVEMENT  |
|  | BACK-FLOW VALVE   |
|  | BASKETBALL  |
|  | CONCRETE PAVEMENT   |
|  | CONTROL POINT   |
|  | FIRE DEPARTMENT CONNECTION  |
|  | FIRE HYDRANT  |
|  | FOUND MONUMENT AS NOTED   |
|  | GATE  |
|  | GROUND ELECTRIC   |
|  | IRRIGATION CONTROL VALVE  |
|  | LIGHT STANDARD  |
|  | MANHOLE   |
|  | POST INDICATOR VALVE  |
|  | SEWER CLEAN OUT   |
|  | SEWER MANHOLE   |
|  | SIGN  |
|  | STARS SHOWING DOWNWARD DIRECTION  |
|  | STORM DRAIN MANHOLE   |
|  | STREET LIGHT  |
|  | TRAFFIC LIGHT   |
|  | TREE (TYPICAL)  |
|  | WATER SPRINKLER   |
|  | WATER VALVE   |
|  | CHAIN LINK FENCE  |
|  | CONCRETE/RETAINING WALL   |
|  | EDGE OF PAVEMENT  |
|  | ELECTRIC LINE   |
|  | SANITARY SEWER LINE   |
|  | STORM DRAIN LINE  |
|  | TELECOM LINE  |
|  | TOE OF SLOPE  |
|  | TOP OF SLOPE  |
|  | WATER LINE  |
|  | DOMESTIC WATER LINE   |
|  | CONTOUR   |
|  | EXISTING IRRIGATION LATERAL LINE PER DISTRICT PROVIDED AS-BUILT DRAWINGS                      |
|  | EXISTING IRRIGATION MAINLINE OR QUICK COOLER MAINLINE PER DISTRICT PROVIDED AS-BUILT DRAWINGS |

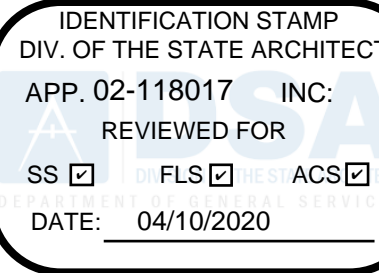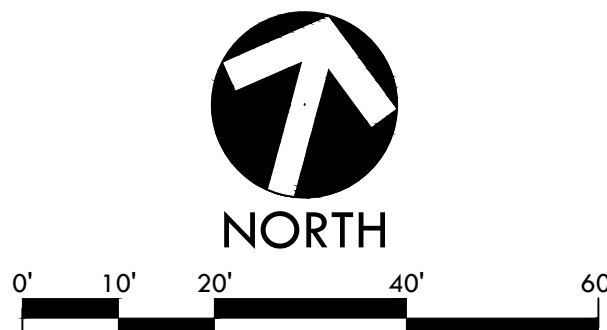

**VERDE DESIGN**  
LANDSCAPE ARCHITECTURE  
CIVIL ENGINEERING  
SPORT PLANNING & DESIGN  
1843 Iron Point Rd #140  
Folsom, CA 95630  
tel: 916.415.6554  
fax: 408.985.7260  
www.VerdeDesignInc.com


STAMP

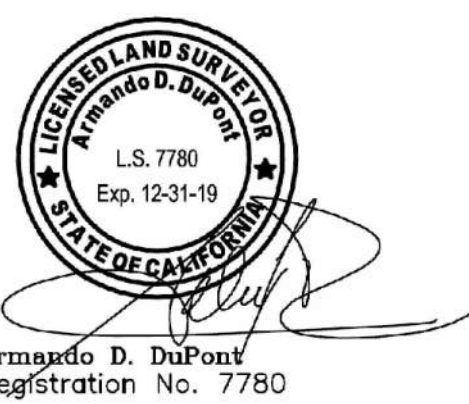

CONSULTANT

**CAL VADA SURVEYING, INC.**  
411 Janks Cir., Suite 205, Corona, CA 92680  
Phone: 951-280-9960 Fax: 951-280-9746  
Toll Free: 800-CALVADA www.calvada.com  
EST. 1989

KEYMAP

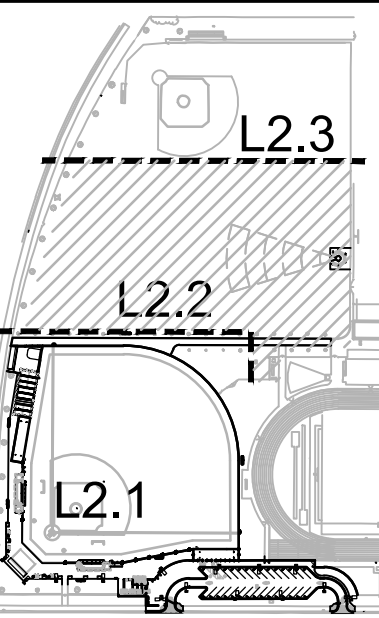

SHEET TITLE

**EXISTING  
CONDITIONS PLAN -  
MULTI-USE SOUTH**

PROJECT NAME

**CHAVEZ HIGH SCHOOL  
STOCKTON USD  
ATHLETIC FACILITY  
IMPROVEMENTS**

PROJECT ADDRESS

**2929 WINDFLOWER LN  
STOCKTON, CA 95212**

| SUBMITTAL               | DATE     |
|-------------------------|----------|
| DO/50% SUBMITTAL        | 10/25/19 |
| DSA SUBMITTAL           | 12/20/19 |
| DSA BACKCHECK SUBMITTAL | 03/27/20 |

| NO. | REVISIONS | DATE |
|-----|-----------|------|
| 1   |           |      |
| 2   |           |      |
| 3   |           |      |
| 4   |           |      |

|             |              |            |             |
|-------------|--------------|------------|-------------|
| DRAWN BY    | AC           | CHECKED BY | CS          |
| DATE ISSUED | 03/27/20     | SCALE      | 1" = 20'-0" |
| PROJ. NO.   | 1910900-1211 |            |             |


SHEET NO. **L2.2** 4 OF 122

EXISTING CONDITIONS PLAN - MULTI-USE SOUTH



ALL DESIGN, CONSTRUCTION, AND/OR PROJECTS OF ARCHITECTS, ENGINEERS, LANDSCAPE ARCHITECTS, AND/OR OTHERS ARE THE PROPERTY OF VERDE DESIGN, INC. AND WERE CREATED, DEVELOPED, AND COMPLETED FOR USE ON AND IN CONNECTION WITH THE SPECIFIED PROJECT. NONE OF SUCH IDEAS, DESIGNS, ARRANGEMENTS OR PLANS SHALL BE USED, REPRODUCED, OR PUBLISHED BY ANY METHOD, IN WHOLE OR IN PART, OR DISCLOSED TO ANY PERSON, FIRM, OR CORPORATION FOR ANY PURPOSES WITHOUT THE WRITTEN PERMISSION OF VERDE DESIGN, INC.

DRAWING NAME: Y:\Projects\FO\2019\1910900 - Chavez Restor\CAD\EXC- Athletics.dwg  
PLOT DATE: 03-30-20 PLOTTED BY: station40

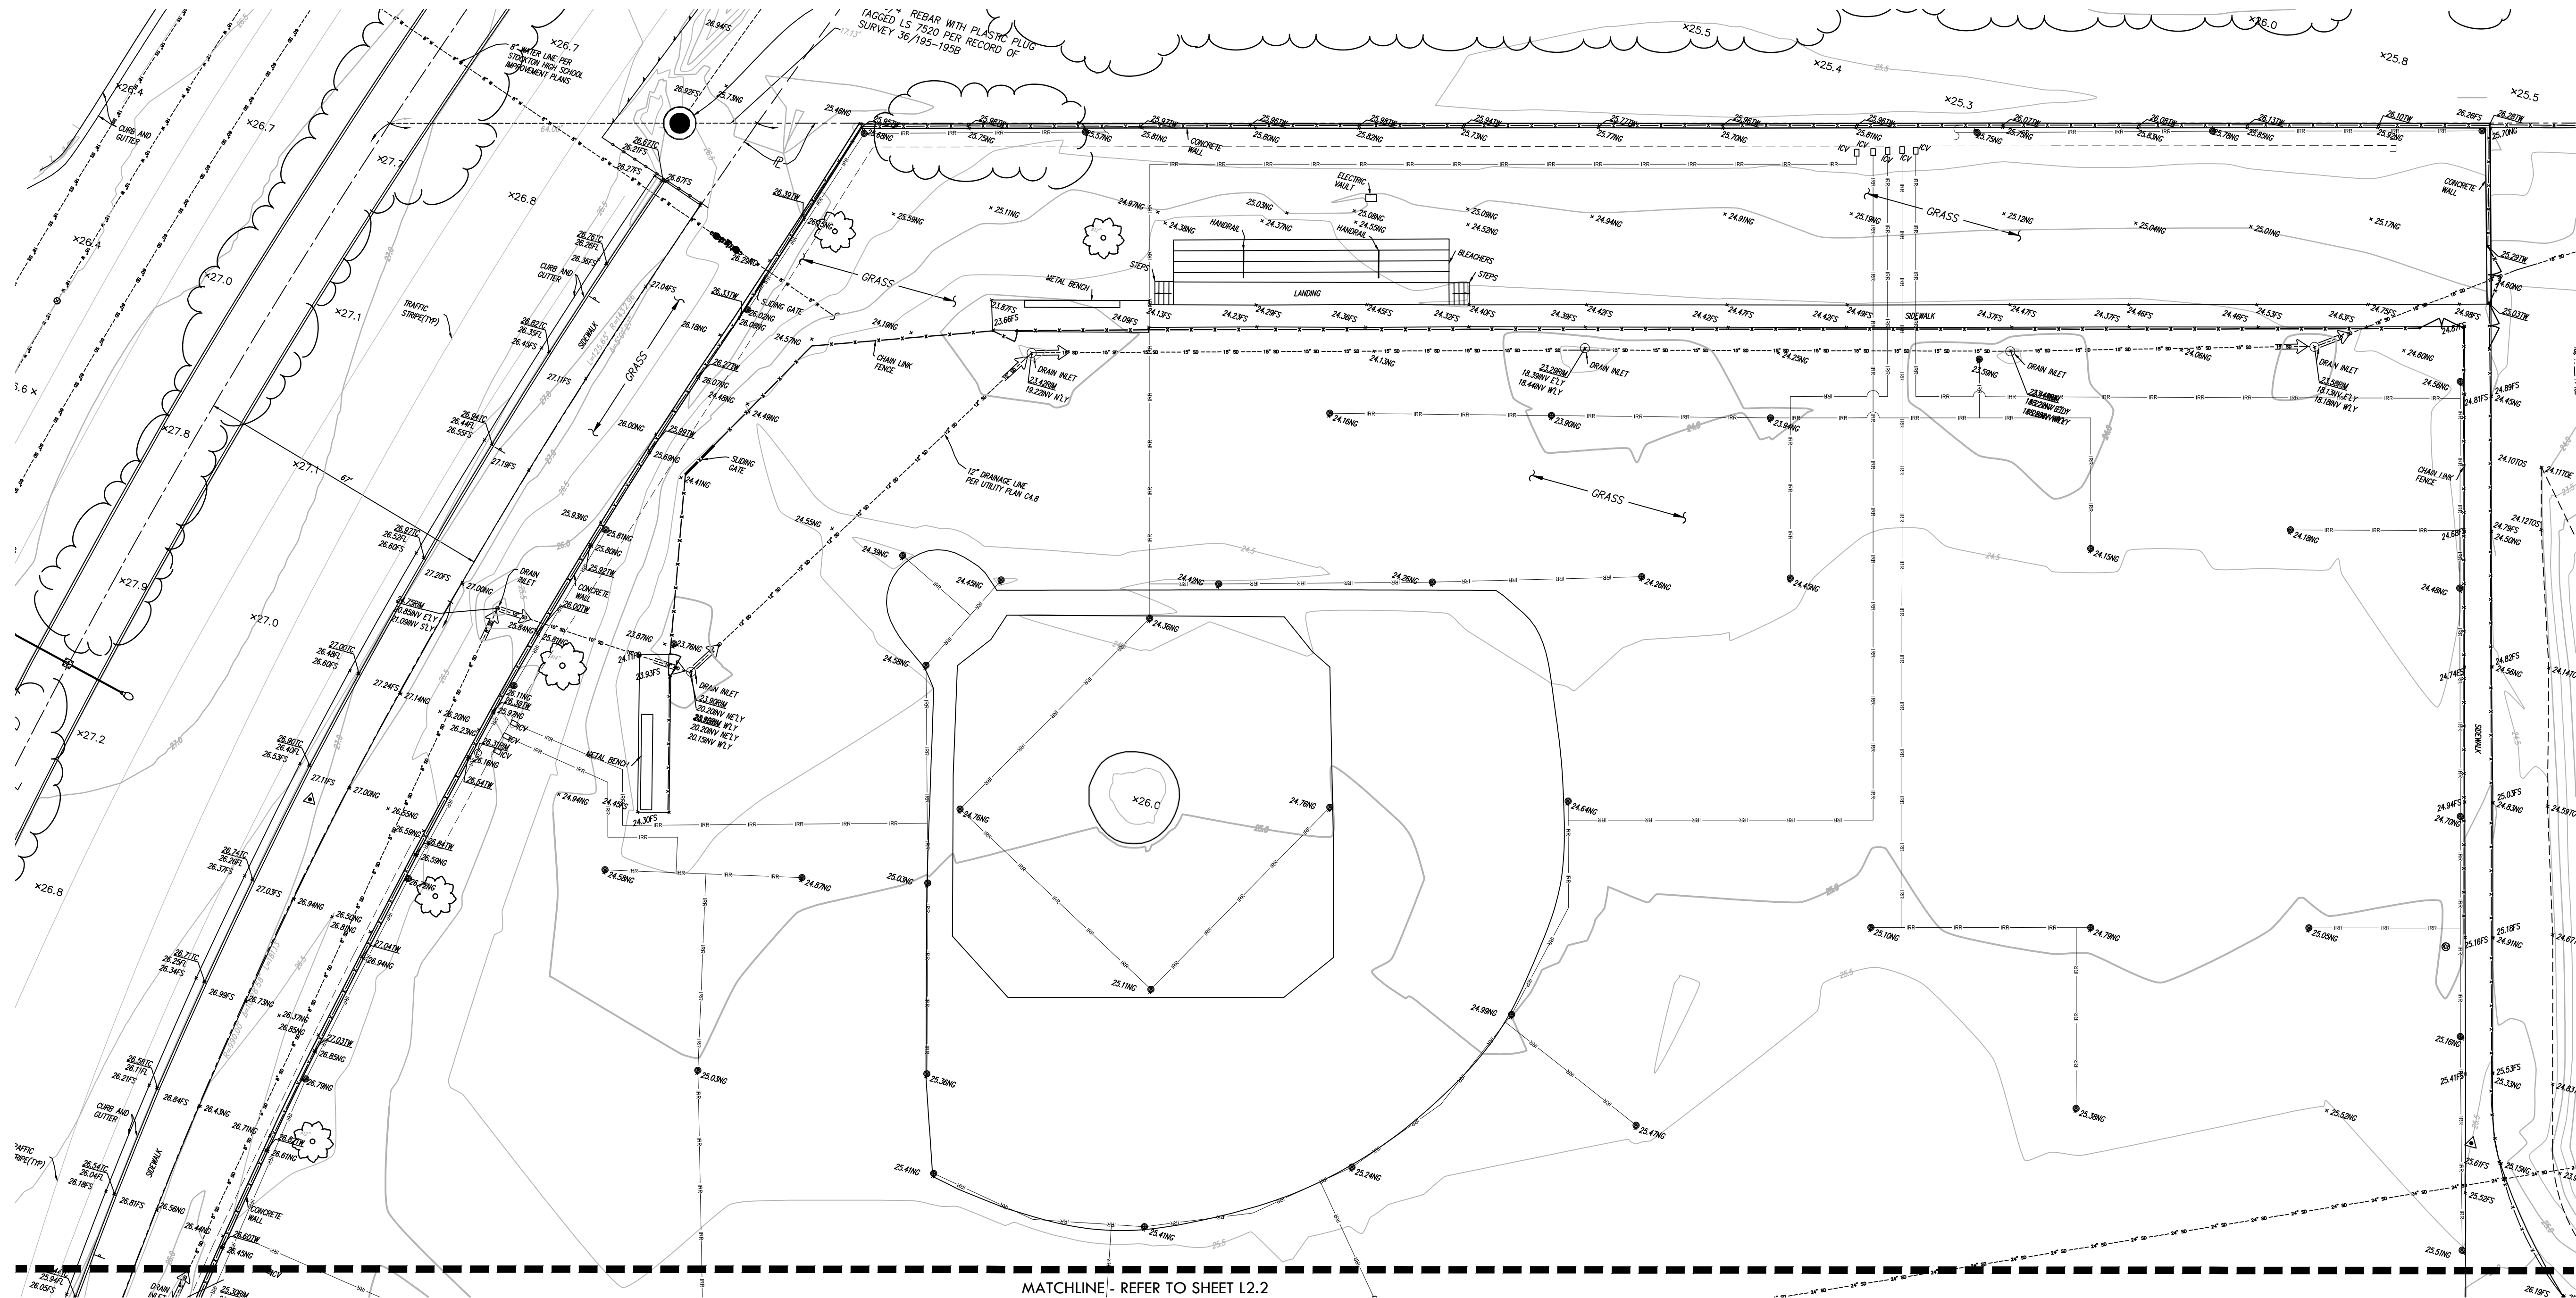

## EXISTING CONDITIONS NOTES

1. SURVEY PROVIDED BY: CAL VADA SURVEYING, INC.
2. ASSESSOR'S PARCEL NO.: 130-040-03
3. ELEVATIONS SHOWN HEREON ARE BASED UPON STOCKTON CITY BENCHMARK 341, ELEVATION 28.83 FEET (NAVD 88).  
5/8" ALUMINUM ROD DRIVEN TO REFUSAL WITH 2-1/2" DIAMETER ALUMINUM CAP STAMPED "WELL 26, L.S. 4334," IN AN ALUMINUM MONUMENT WELL WITH SCREW LOCKING COVER; BENCH MARK IN LOCATED WITHIN THE LOCKED CITY OF STOCKTON WELL SITE NO. 26, ON SOUTH SIDE OF HAMMER LN, ON THE WEST SIDE OF THE EBMUD RIGHT-OF-WAY. THE POINT LIES IN CENTER OF PAVED AREA EAST OF WELL BUILDING. CONTACT THE CITY OF STOCKTON SURVEYS SECTION FOR ACCESS.
4. FIELD COMPLETION DATE: 08/07/19
5. FINAL SURVEY ISSUED: 10/15/19, UPDATED 11/26/19
6. THE BEARINGS SHOWN HEREON ARE BASED UPON THE CALIFORNIA COORDINATE SYSTEM OF 1983, CC583, ZONE 3, (2017.50) IN ACCORDANCE TO THE CALIFORNIA PUBLIC RESOURCES CODE SECTIONS 8801-8819; SAID BEARINGS ARE DETERMINED LOCALLY UPON FIELD-OBSERVED TIES TO THE FOLLOWING CALIFORNIA SPATIAL REFERENCE NETWORK CONTINUOUS OPERATING REFERENCE STATIONS (C.O.R.S.):

C.S.R.C. P273:  
NORTHING = 2229969.53' EASTING = 6306178.61'  
C.S.R.C. P309:  
NORTHING = 2219667.30' EASTING = 6431806.86'

## CONTROL POINTS


| CP#  | NORTHING    | EASTING     | ELEVATION | DESCRIPTION               |
|------|-------------|-------------|-----------|---------------------------|
| CP1  | 2192386.08' | 6339908.09' | 28.42'    | SET MAGNETIC NAIL/SHINNER |
| CP2  | 2192214.00' | 6339396.78' | 25.56'    | SET CHISELED "X"          |
| CP3  | 2192244.46' | 6339663.76' | 25.62'    | SET 60DN                  |
| CP4  | 2191780.53' | 6338889.60' | 26.17'    | SET CHISELED "X"          |
| CP5  | 2192159.80' | 6338916.65' | 26.98'    | SET CHISELED "X"          |
| CP6  | 2191673.49' | 6339270.32' | 28.61'    | SET 1X2 WOOD HUB & TAG    |
| CP7  | 2191834.81' | 6339331.96' | 27.54'    | SET MAGNETIC NAIL/SHINNER |
| CP8  | 2191273.81' | 6338991.86' | 26.07'    | SET CHISELED "X"          |
| CP9  | 2191397.32' | 6339271.01' | 27.39'    | SET WOOD 1X2 HUB & TAG    |
| CP10 | 2191315.83' | 6339011.30' | 27.00'    | SET WOOD 1X2 HUB & TAG    |
| CP11 | 2191592.48' | 6338957.11' | 26.84'    | SET WOOD 1X2 HUB & TAG    |

## MONUMENT NOTES



| MON# | DESCRIPTION                                     |
|------|---|
| M41  | FD. 3/4" REBAR WITH PLASTIC PLUG TAGGED LS 7520 |
| M42  | FD. 3/4" REBAR WITH PLASTIC PLUG TAGGED LS 7520 |
| M43  | FD. 3/4" REBAR WITH PLASTIC PLUG TAGGED LS 7520 |

## EXISTING CONDITIONS LEGEND

| APN  | ASSESSOR'S PARCEL NUMBER   |
|------|--|
| CB   | COTEN BASIN  |
| DI   | DRAIN INLET  |
| EP   | ELECTRIC PANEL   |
| EPB  | ELECTRIC PULL BOX  |
| EV   | ELECTRIC VAULT   |
| FF   | FINISH FLOOR   |
| FS   | FINISH SURFACE   |
| FL   | FLOW LINE  |
| HOP  | HANDICAP RAMP  |
| INVT | INVERT   |
| ICV  | IRRIGATION CONTROL VALVE   |
| NG   | NATURAL GROUND   |
| SDOQ | STORM DRAIN CLEAN OUT  |
| TOE  | TOE OF SLOPE   |
| TC   | TOP OF CURB  |
| TOS  | TOP OF SLOPE   |
| TYP  | TYPICAL  |
| UB   | UTILITY BOX  |
| WV   | WATER VAULT  |
|      | ASPHALT PAVEMENT   |
|      | BACK-FLOW VALVE  |
|      | BASKETBALL   |
|      | CONCRETE PAVEMENT  |
|      | CONTROL POINT  |
|      | FIRE DEPARTMENT CONNECTION   |
|      | FIRE HYDRANT   |
|      | FOUND MONUMENT AS NOTED  |
|      | GATE   |
|      | GROUND ELECTRIC  |
|      | IRRIGATION CONTROL VALVE   |
|      | LIGHT STANDARD   |
|      | MANHOLE  |
|      | POST INDICATOR VALVE   |
|      | SEWER CLEAN OUT  |
|      | SEWER MANHOLE  |
|      | SIGN   |
|      | STAIRS SHOWING DOWNWARD DIRECTION  |
|      | STORM DRAIN MANHOLE  |
|      | STREET LIGHT   |
|      | TRAFFIC LIGHT  |
|      | TREE (TYPICAL)   |
|      | WATER SPROINKLER   |
|      | WATER VALVE  |
|      | CHAIN LINK FENCE   |
|      | CONCRETE/RETAINING WALL  |
|      | EDGE OF PAVEMENT   |
|      | ELECTRIC LINE  |
|      | SEWAGE SOWER LINE  |
|      | STORM DRAIN LINE   |
|      | TELECOM LINE   |
|      | TOE OF SLOPE   |
|      | TOP OF SLOPE   |
|      | WATER LINE   |
|      | DOMESTIC WATER LINE  |
|      | CONTOUR  |
|      | EXISTING IRRIGATION LATERAL LINE PER DISTRICT PROVIDED AS-BUILT DRAWINGS                       |
|      | EXISTING IRRIGATION MAINLINE OR QUICK CLOSURE MAINLINE FOR DISTRICT PROVIDED AS-BUILT DRAWINGS |

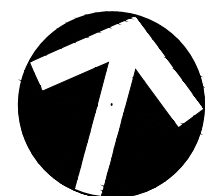


0' 10' 20' 40' 60'

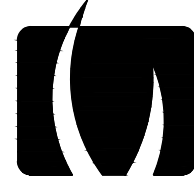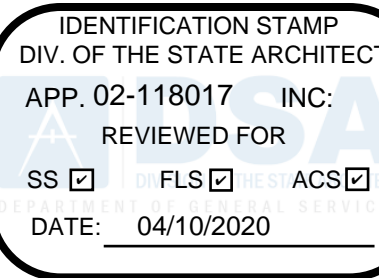

**VERDE DESIGN**  
LANDSCAPE ARCHITECTURE  
CIVIL ENGINEERING  
SPORT PLANNING & DESIGN  
1843 Iron Point Rd #140  
Folsom, CA 95630  
tel: 916.415.6554  
fax: 916.985.7260  
www.VerdeDesignInc.com


STAMP

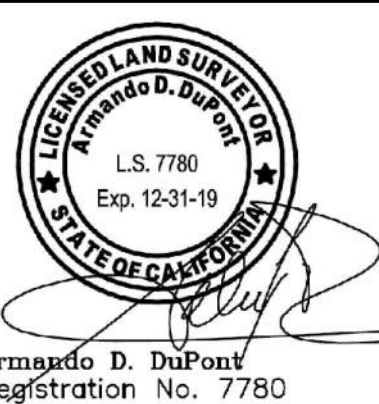

CONSULTANT

**CAL VADA SURVEYING, INC.**  
411 Links Cir., Suite 205, Corona, CA 92680  
Phone: 951-280-9960 Fax: 951-280-9746  
Toll Free: 800-CALVADA www.calvada.com  
EST. 1989 JOB NO. 19396

KEYMAP

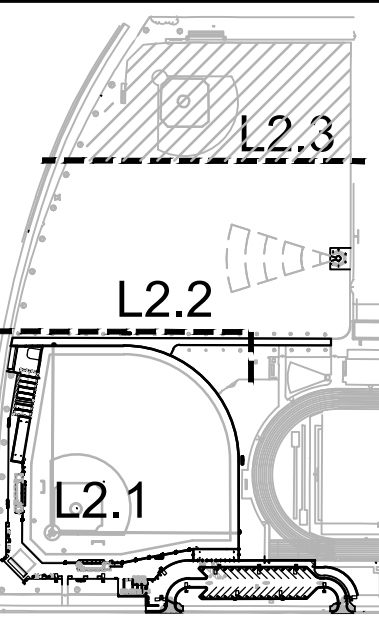

SHEET TITLE

**EXISTING  
CONDITIONS PLAN -  
MULTI-USE NORTH**

PROJECT NAME

**CHAVEZ HIGH SCHOOL  
STOCKTON USD  
ATHLETIC FACILITY  
IMPROVEMENTS**

PROJECT ADDRESS

**2929 WINDFLOWER LN  
STOCKTON, CA 95212**


| SUBMITTAL               | DATE     |
|-------------------------|----------|
| DD/50% SUBMITTAL        | 10/25/19 |
| DSA SUBMITTAL           | 12/20/19 |
| DSA BACKCHECK SUBMITTAL | 03/27/20 |

| NO. | REVISIONS | DATE |
|-----|-----------|------|
| 1   |           |      |
| 2   |           |      |
| 3   |           |      |
| 4   |           |      |
| 5   |           |      |




|                         |                    |
|-------------------------|--------------------|
| DRAWN BY: AC            | CHECKED BY: CS     |
| DATE ISSUED: 03/27/20   | SCALE: 1" = 20'-0" |
| PROJ. NO.: 1910900-1211 |                    |
| SHEET NO.: L2.3         | 5 OF 122           |

EXISTING CONDITIONS PLAN - MULTI-USE NORTH



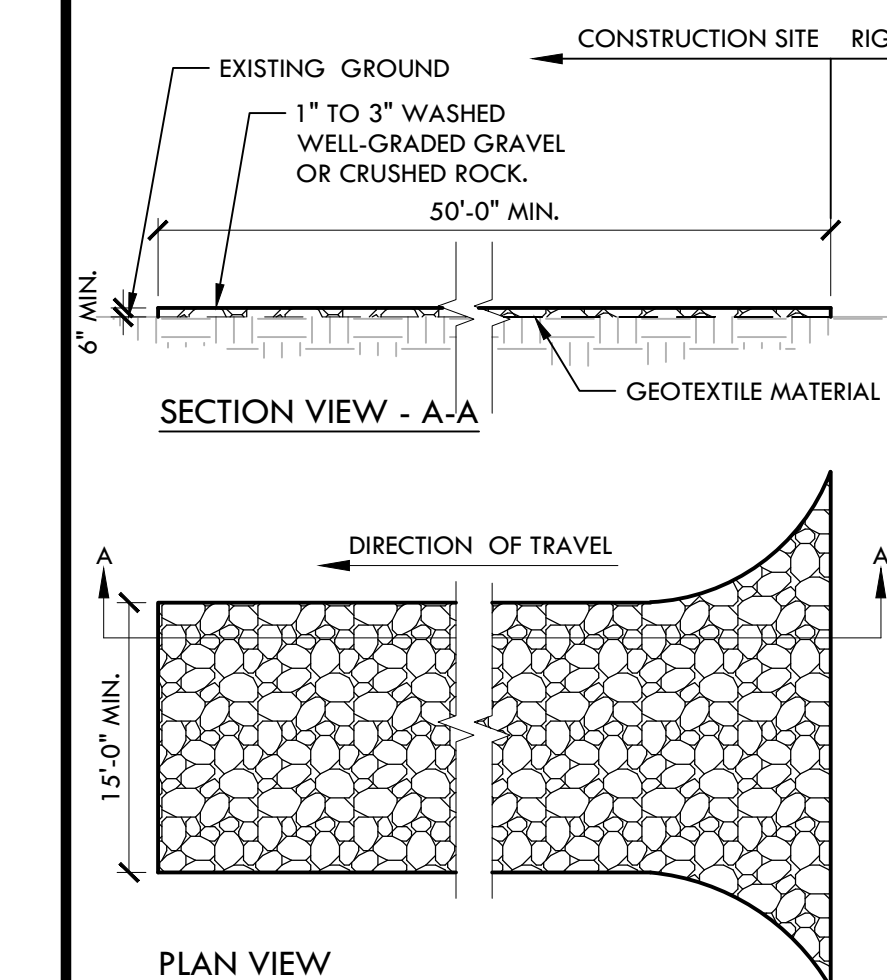

NOTES:  
1. CONSTRUCTION SITE ACCESS SHALL BE CONSTRUCTED OF 1" TO 3" WASHED, WELL-GRADED GRAVEL OR CRUSHED ROCK. MATERIAL SHALL BE PLACED TO A MINIMUM THICKNESS OF 6".  
2. LENGTH OF ENTRANCE SHALL BE A MINIMUM OF 50 FEET. WIDTH SHALL BE A MIN. OF 15' OR GREATER IF NECESSARY TO COVER ALL VEHICULAR INGRESS AND EGRESS. PROVIDE AMPLE TURNING RADII.  
3. THE ENTRANCE SHALL BE KEPT IN GOOD CONDITION BY OCCASIONAL TOP DRESSING WITH MATERIAL AS SPECIFIED IN NOTE 1.  
4. ACCESSES SHALL BE INSPECTED WEEKLY DURING PERIODS OF HEAVY USAGE, MONTHLY DURING NORMAL USAGE, AND AFTER EACH RAINFALL WITH MAINTENANCE PROVIDED AS NECESSARY. PERIODIC TOP DRESSING SHALL BE DONE AS NEEDED.  
5. TEMPORARY ACCESS ROAD SHALL BE REMOVED AT THE END OF THE PROJECT. AFFECTED AREA SHALL BE RETURNED TO AS WAS OR BETTER CONDITION.

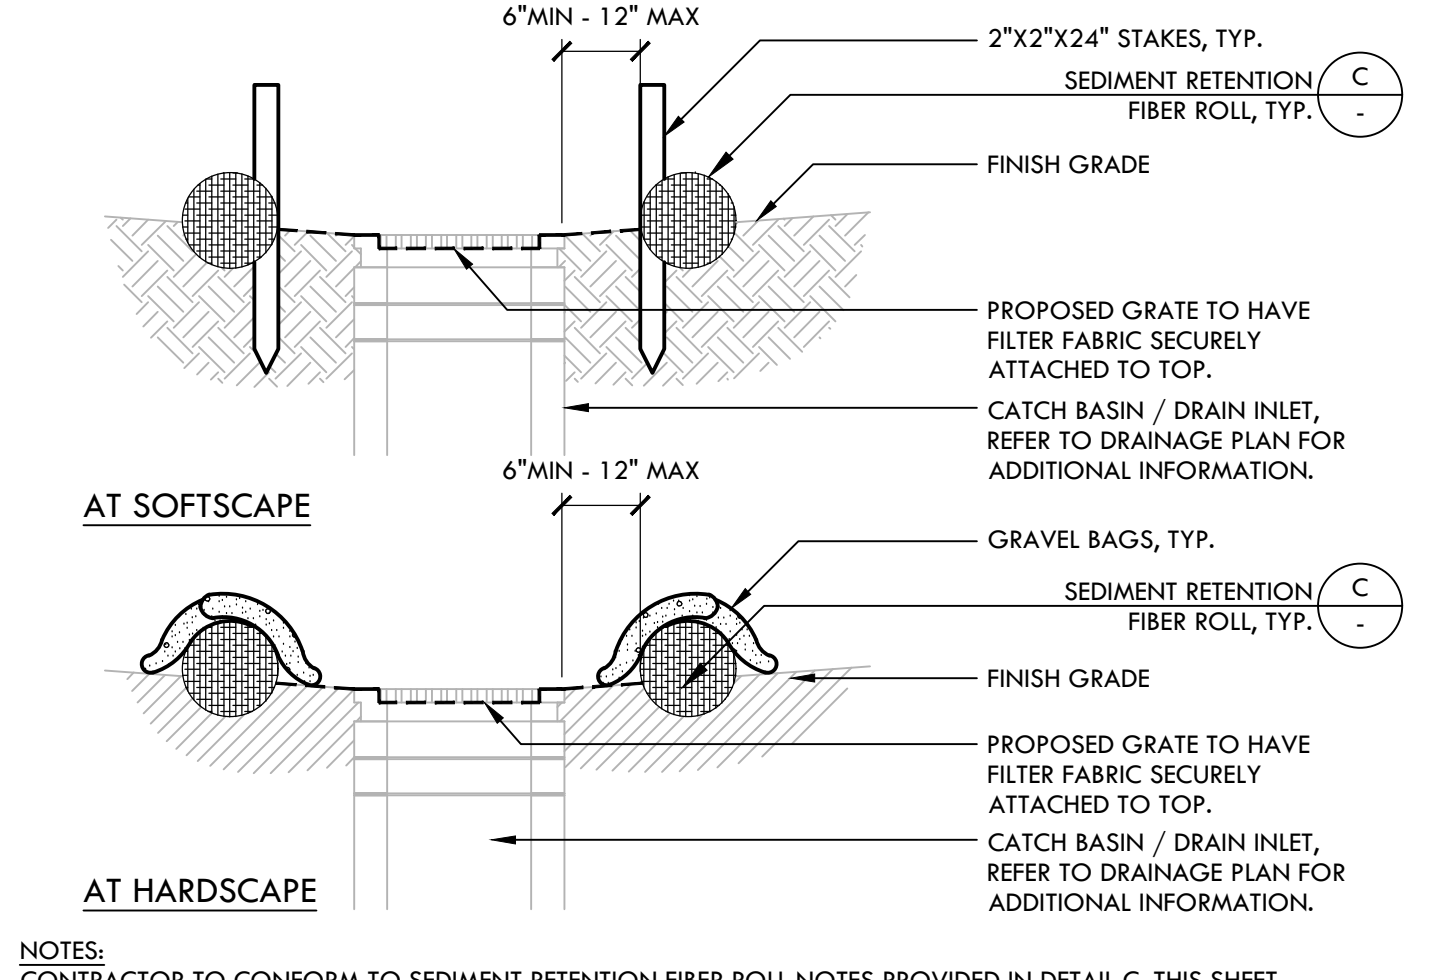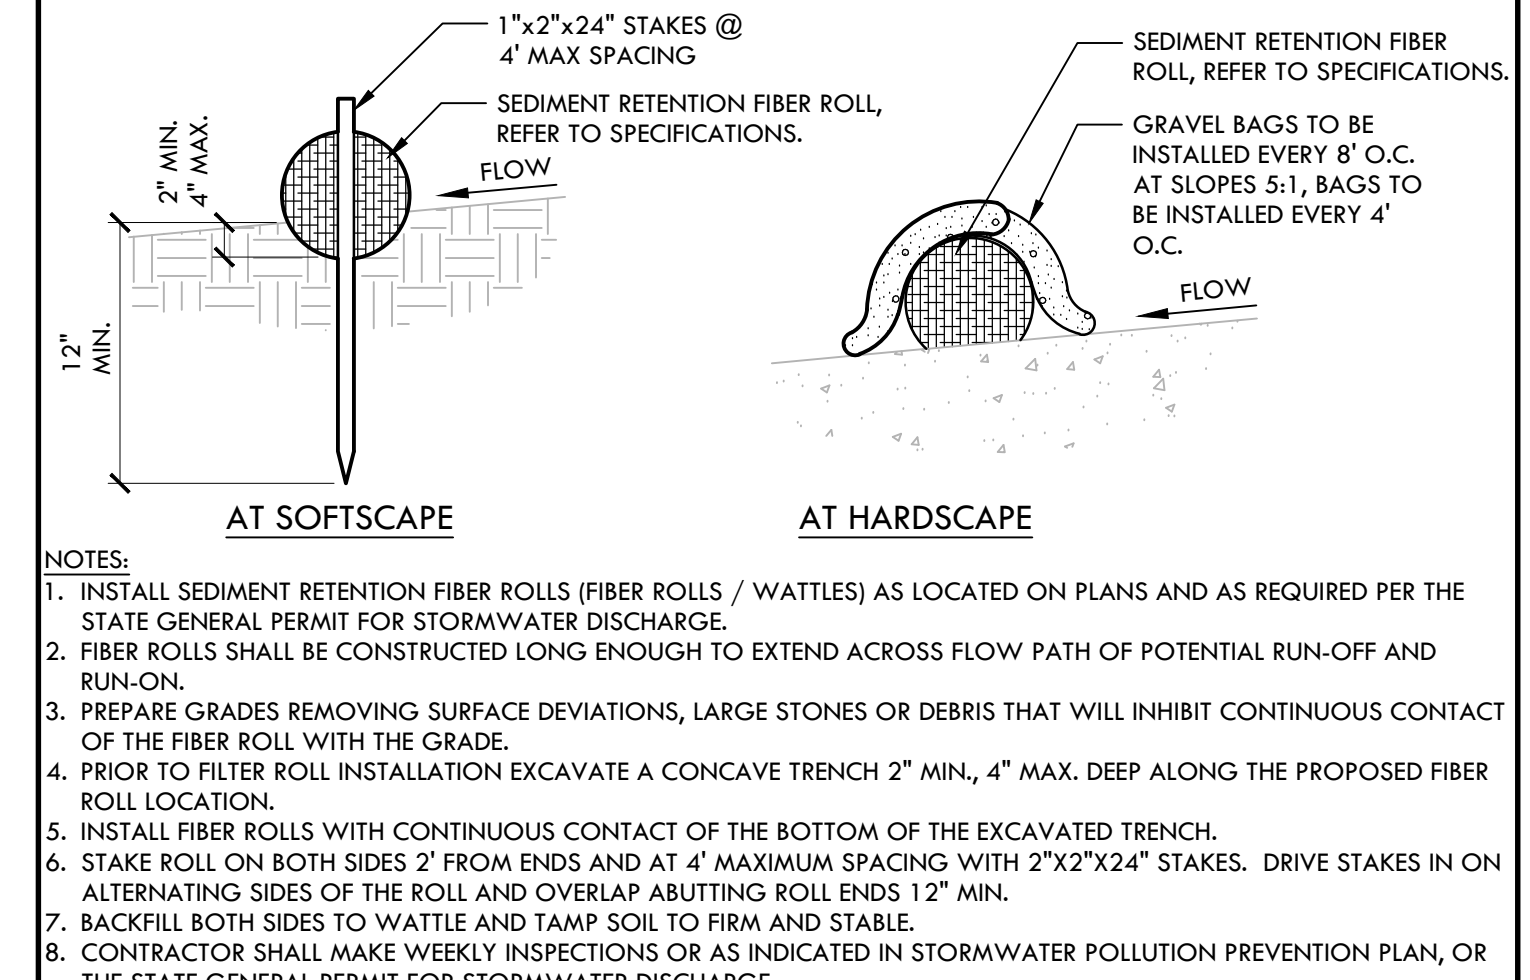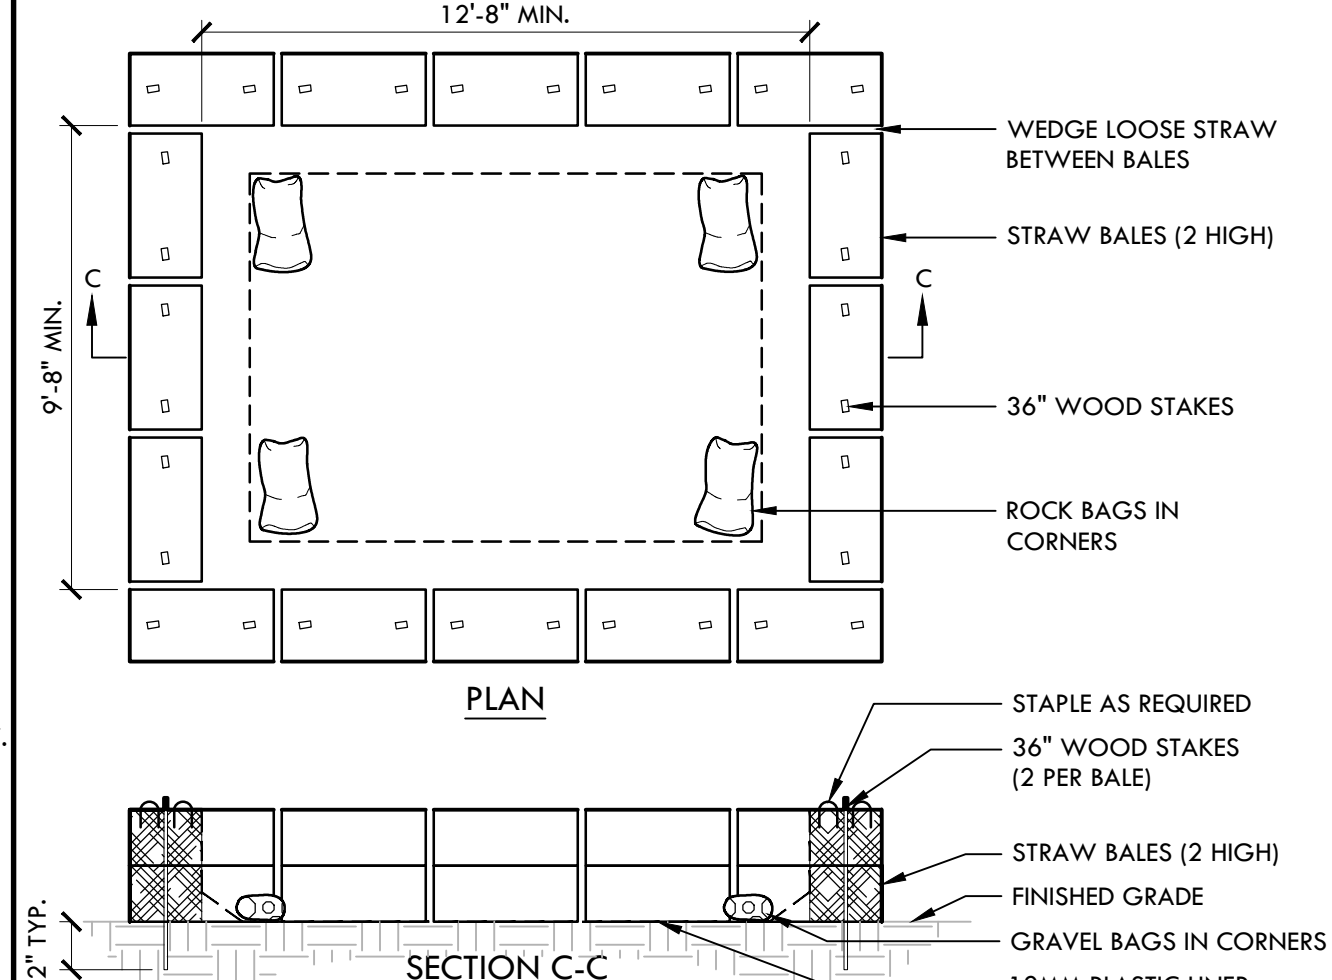

| EROSION/SEDIMENTATION CONTROL NOTES   |   |         |
|---|---|---------|
| 1. EROSION/SEDIMENTATION CONTROL PLAN SHALL BE CONSTRUCTED DURING FIRST WEEK OF CONSTRUCTION.   |   |         |
| 2. EROSION/SEDIMENTATION CONTROL PLAN SHALL REMAIN THROUGHOUT CONSTRUCTION AND DISPOSED DURING MAINTENANCE PERIOD.                    |   |         |
| 3. EROSION/SEDIMENTATION CONTROL PLAN MAY BE ADJUSTED THROUGH CONSTRUCTION WITH APPROVAL OR AS DIRECTED BY DISTRICT'S REPRESENTATIVE. |   |         |
| 4. CONTRACTOR SHALL SWEEP STREETS AND PARKING AREAS AFFECTED BY CONSTRUCTION WEEKLY WITH STREET SWEEPER.                              |   |         |
| EROSION/SEDIMENTATION CONTROL LEGEND  |   |         |
| SYM   | DESCRIPTION   | DTL REF |
| 1   | LIMIT OF WORK   |         |
| 1   | STORM DRAIN INLET FILTER. FILTER FABRIC TO BE SECURELY ATTACHED TO DRAINAGE STRUCTURE TOP AND PERIMETER WADDLE          | D       |
| 1   | SEDIMENT RETENTION FIBER ROLL   | C       |
|   | SLOPE DIRECTION   |         |
|   | TEMPORARY CONCRETE WASHOUT FACILITY - PROVIDE A WASHOUT BIN FOR CONSTRUCTION WASHOUT AND REMOVE AT END OF CONSTRUCTION. | B       |
|   | CONSTRUCTION STAGING AREA   |         |
|   | STABILIZED CONSTRUCTION ENTRY   | A       |
|   | PROJECT ACCESS ROAD   |         |
|   | ANTICIPATED DISCHARGE LOCATION, VISUAL MONITORING LOCATION, AND SAMPLING LOCATION                                       |         |
| NV-X  | NON-VISIBLE POLLUTANT SAMPLING LOCATION   |         |

IDENTIFICATION STAMP  
DIV. OF THE STATE ARCHITECT  
APP. 02-118017 INC.  
REVIEWED FOR  
SS ☐ FLS ☐ ACS ☐  
DATE: 04/10/2020

VERDE DESIGN

LANDSCAPE ARCHITECTURE  
CIVIL ENGINEERING  
SPORT PLANNING & DESIGN

1843 Iron Point Rd #140  
Folsom, CA 95630  
tel: 916.415.6554  
fax: 916.985.7260  
www.VerdeDesignInc.com

STAMP

REGISTERED LANDSCAPE ARCHITECT  
MARK S. BARNES  
No. 409  
EXPIRATION DATE: JULY 2021  
STATE OF CALIFORNIA

CONSULTANT

KEYMAP

SHEET TITLE  
EROSION CONTROL PLAN

PROJECT NAME  
CHAVEZ HIGH SCHOOL  
STOCKTON USD  
ATHLETIC FACILITY  
IMPROVEMENTS

PROJECT ADDRESS  
2929 WINDFLOWER LN  
STOCKTON, CA 95212

| SUBMITTAL               | DATE     |
|-------------------------|----------|
| DD/50% SUBMITTAL        | 10/25/19 |
| DSA SUBMITTAL           | 12/20/19 |
| DSA BACKCHECK SUBMITTAL | 03/27/20 |

| NO. | REVISIONS | DATE |
|-----|-----------|------|
| 1   |           |      |
| 2   |           |      |
| 3   |           |      |
| 4   |           |      |
| 5   |           |      |
| 6   |           |      |

DRAWN BY  
HM

CHECKED BY  
CS

DATE ISSUED  
03/27/20

SCALE  
1" = 50'-0"

PROJ. NO.  
1910900-1211

SHEET NO.  
L3.0


6 OF 122

EROSION CONTROL PLAN

DRAWING NAME: Y:\Projects\FO\2019\1910900 - Chavez Restor\CAD\_EDP-- Athletics.dwg  
PLOT DATE: 03-30-20 PLOTTED BY: station40



ALL LANDSCAPE ARCHITECTURE PLANS, SPECIFICATIONS, AND REPORTS OF VERDE DESIGN, INC. ARE THE PROPERTY OF VERDE DESIGN, INC. AND ARE NOT TO BE REPRODUCED, COPIED, OR IN ANY MANNER DISCLOSED TO ANY OTHER PERSON OR ENTITY WITHOUT THE WRITTEN PERMISSION OF VERDE DESIGN, INC. VERDE DESIGN, INC. IS NOT RESPONSIBLE FOR ANY DAMAGE TO OR LOSS OF ANY PROPERTY OR PERSONS ARISING FROM THE USE OF ANY OF THE INFORMATION CONTAINED HEREIN. VERDE DESIGN, INC. IS NOT RESPONSIBLE FOR ANY DAMAGE TO OR LOSS OF ANY PROPERTY OR PERSONS ARISING FROM THE USE OF ANY OF THE INFORMATION CONTAINED HEREIN.

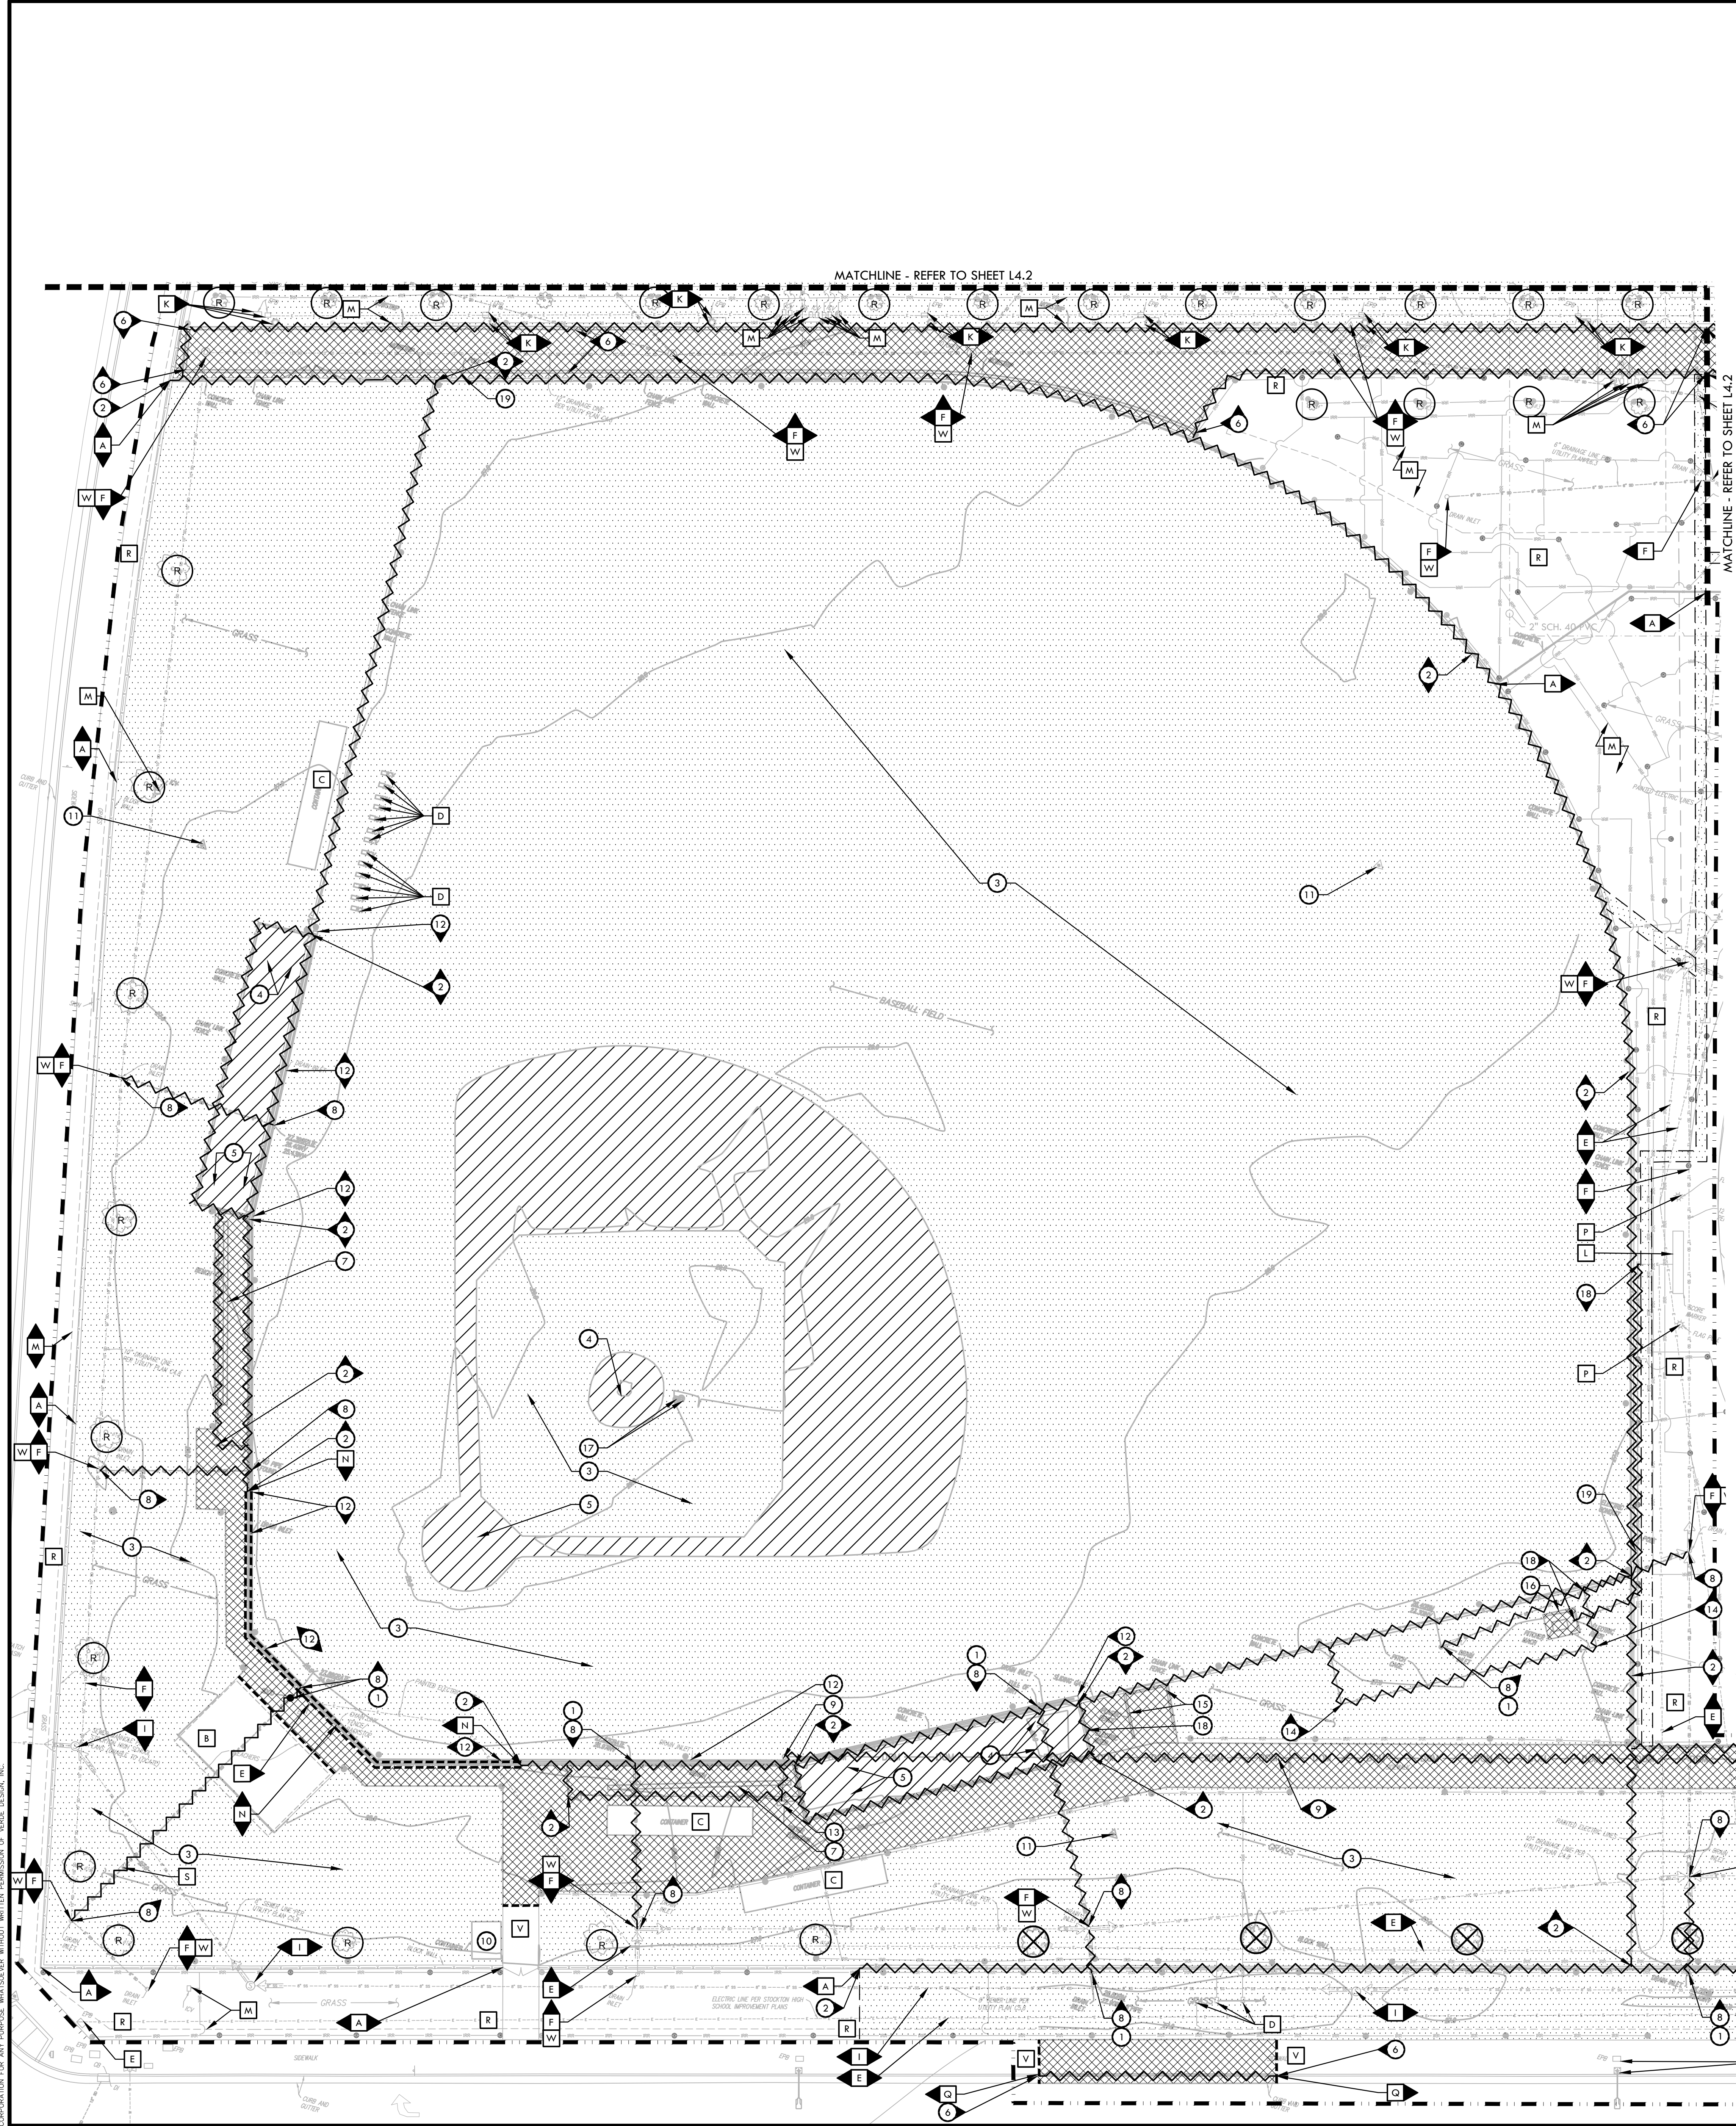

- ITEMS TO BE PROTECTED**
- R** SOFTSCAPE TO REMAIN AND BE PROTECTED. IRRIGATION WITHIN THIS AREA TO REMAIN OPERABLE DURING CONSTRUCTION. ADJUST AS REQUIRED TO ENSURE FULL COVERAGE AFTER CONSTRUCTION.
  - S** BENCHMARK TO REMAIN AND BE PROTECTED.
  - I** FLOAT VALVE ASSEMBLY AND ASSOCIATED ITEMS TO REMAIN AND BE PROTECTED.
  - U** BALLFIELD PINES, INFIELD, AND ALL ASSOCIATED ITEMS TO REMAIN AND BE PROTECTED.
  - V** HARDSCAPE / WALK TO REMAIN AND BE PROTECTED.
  - W** DRAINAGE STRUCTURE REMAIN AND BE PROTECTED. CONTRACTOR TO ADJUST LID AND PROTECT PIPES AS REQUIRED. REFER TO DRAINAGE PLANS.
  - X** ELECTRICAL VAULT BOX TO REMAIN AND BE PROTECTED. CONTRACTOR TO POT HOLE TO VERIFY DEPTH PRIOR TO CHEMICAL TREATMENT.
- ITEMS TO BE DEMOLISHED**
- 1** DRAIN STRUCTURE TO BE DEMOLISHED AND REMOVED.
  - 2** EDGE BAND, CURB AND/OR FENCING TO BE DEMOLISHED AND REMOVED. FENCE FOOTINGS TO BE DEMOLISHED AND REMOVED.
  - 3** IRRIGATION VALVES AND ASSOCIATED LATERAL LINES TO BE DEMOLISHED AND REMOVED. CONTROL WIRES SHALL BE PROTECTED WITHIN A NEW VALVE BOX LOCATED IN LANDSCAPE AREA.
  - 4** PITCHER'S PLATE TO BE REMOVED AND TURNED OVER TO DISTRICT.
  - 5** HOME PLATE TO BE REMOVED AND TURNED OVER TO DISTRICT.
  - 6** SAWCUT EXISTING CURB/EDGE BAND AND/OR GUTTER AT NEAREST JOINT TO ALLOW FOR NEW CURB
  - 7** BENCH TO BE DEMOLISHED AND REMOVED AND TURNED OVER TO DISTRICT.
  - 8** DRAIN LINES TO BE CAPPED, SLURRY FILLED AND ABANDONED IF NOT OBSTRUCTING FUTURE IMPROVEMENTS.
  - 9** UTILITY TO BE DEMOLISHED AND REMOVED.
  - 10** TICKET BOOTH TO BE DEMOLISHED AND REMOVED.
  - 11** BENCHMARK TO BE DEMOLISHED AND REMOVED.
  - 12** CONTRACTOR TO REMOVE TRENCH DRAIN AND CAP STORM DRAIN LINE AT NEAREST BASIN. WHERE TRENCH DRAIN IS ADJACENT TO REMAINING BACKSTOP CONTRACTOR SHALL SAWCUT AND REMOVE TRENCH DRAIN. CONCRETE EDGE BAND UNDER BACKSTOP TO REMAIN AND BE PROTECTED. DEMOLISH AND REMOVED ALL BASEBOARDS.
  - 13** DRINKING FOUNTAIN TO BE DEMOLISHED AND REMOVED.
  - 14** BATTING CAGE POLES AND NETTING TO BE DEMOLISHED AND REMOVED.
  - 15** 2' TALL PLASTIC STORAGE BIN TO BE DEMOLISHED AND REMOVED.
  - 16** CONCRETE PAD TO BE DEMOLISHED AND REMOVED.
  - 17** QUICK COUPLERS TO BE DEMOLISHED AND REMOVED. LINE TO REMAIN ACTIVE AND TIE INTO NEW LOCATIONS PER IRRIGATION PLAN.
  - 18** ELECTRICAL TO BE ADJUSTED AND/OR DEMOLISHED AND REMOVED. REFER TO ELECTRICAL PLANS.
  - 19** FOUL POLES AND FOOTINGS TO BE DEMOLISHED AND REMOVED.

- DEMOLITION LEGEND**
- | SYM      | DESCRIPTION  |
|----------|--|
| [Symbol] | LIMIT OF WORK  |
| [Symbol] | KEY LEGEND CALLOUT - ITEMS TO BE DEMOLISHED AND REMOVED  |
| [Symbol] | KEY LEGEND CALLOUT - ITEMS TO REMAIN AND BE PROTECTED  |
| [Symbol] | SURFACE VEGETATION TO BE REMOVED PER SPECIFICATIONS. REMOVE EXCESS SOIL FROM SITE AND DISPOSED IN LEGAL MANNER. REFER TO EARTHWORK SPECIFICATIONS FOR INFORMATION. |
| [Symbol] | DEMOLISH AND REMOVE HARDSCAPE PAVING INCLUDING BASE MATERIAL.  |
| [Symbol] | INFIELD PINES TO BE STOCKPILED AND USED FOR TOPDRESS AT NORTHERN BALLFIELD (SEE L8.1). REMAINING PINES TO BE DEMOLISHED AND REMOVED.                               |
| [Symbol] | DEMOLISH AND REMOVE CURB, UTILITY LINE, AND/OR FENCE, INCLUDING POSTS, FABRIC, CURBS, EDGE BANDS AND FOOTINGS  |
| [Symbol] | SAWCUT   |
| [Symbol] | LIMIT OF CLEAR AND GRUB. CONTRACTOR SHALL CONFIRM WITH GRADING, UTILITIES AND SPECIFICATIONS.  |
| [Symbol] | TREE SHALL BE DEMOLISHED AND REMOVED, REFER TO SPECIFICATIONS  |
| [Symbol] | TREE TO REMAIN AND BE PROTECTED, REFER TO SPECIFICATIONS   |
- ITEMS TO BE PROTECTED**
- A** CHAIN LINK FENCE / GATE TO REMAIN AND BE PROTECTED. INCLUDES POSTS, FABRIC, CURBS, EDGE BANDS AND FOOTINGS.
  - B** BLEACHERS TO BE REMAIN AND BE PROTECTED, INCLUDING HARDSCAPE.
  - C** STORAGE CONTAINERS TO BE RELOCATED. (2) TO BE RELOCATED ONSITE PER L8.1 AND (1) SHALL BE RELOCATED TO STAGG HS. COORDINATE WITH DISTRICT.
  - D** APPROXIMATE LOCATION OF IRRIGATION REMOTE CONTROL VALVES, WIRES TO BE SALVAGED AND REUSED FOR NEW VALVES. CONTRACTOR TO DEMOLISH BOXES & VALVES. CONTRACTOR TO VERIFY IRRIGATION CONTROLLER OPERATING THE VALVES PRIOR TO DEMOLITION. REFER TO IRRIGATION PLAN FOR PROPOSED LOCATION.
  - E** ELECTRICAL, COMMUNICATION, DATA LINES AND COMPONENTS. REFER TO ELECTRICAL PLANS FOR INFORMATION. CONTRACTOR TO POT HOLE DEPTHS PRIOR TO CHEMICAL TREATMENT.
  - F** DRAINAGE LINES TO REMAIN AND BE PROTECTED. CONTRACTOR TO POT HOLE DEPTHS PRIOR TO CHEMICAL TREATMENT.REFER TO DRAINAGE PLANS.
  - G** WATER LINE AND ASSOCIATED ITEMS TO REMAIN AND BE PROTECTED. CONTRACTOR TO POT HOLE DEPTHS PRIOR TO CHEMICAL TREATMENT.
  - H** FURNISHINGS TO REMAIN AND BE PROTECTED.
  - I** SANITARY SEWER AND PIPES TO REMAIN AND BE PROTECTED. CONTRACTOR TO POT HOLE DEPTHS PRIOR TO CHEMICAL TREATMENT.
  - J** FIRE HYDRANT AND ASSOCIATED ITEMS TO REMAIN AND BE PROTECTED.
  - K** PEDESTRIAN LIGHT AND ASSOCIATED ITEMS TO REMAIN AND BE PROTECTED.
  - L** SCOREBOARD AND FOOTINGS TO REMAIN AND BE PROTECTED.
  - M** IRRIGATION EQUIPMENT, INCLUDING BUT NOT LIMITED TO VALVES, ROTORS, SPRAY HEADS, LATERAL LINES & MAINLINES TO REMAIN AND BE PROTECTED. REFER TO SHEETS L9.1-L9.3 FOR ADDITIONAL INFORMATION.
  - N** BACKSTOP TO REMAIN AND BE PROTECTED, INCLUDING FENCING AND CONCRETE EDGE BAND. BASEBOARDS TO BE REMOVED.
  - O** SPORTFIELD LIGHT, LINES AND BOXES TO REMAIN AND BE PROTECTED.
  - P** FLAG POLE TO REMAIN AND BE PROTECTED.
  - Q** EDGE BAND, CURB AND/OR GUTTER TO REMAIN AND BE PROTECTED.

## DEMOLITION NOTES

- THE CONTRACTOR SHALL PERFORM ALL CLEARING, DEMOLITION, REMOVAL OF OBSTRUCTIONS AND SITE PREPARATIONS NECESSARY FOR THE PROPER EXECUTION OF ALL WORK CONTAINED IN THE CONTRACT DOCUMENTS.
- CONTRACTOR SHALL VERIFY LOCATION OF ALL EXISTING UTILITIES AND PROVIDE THE REQUIRED COORDINATION FOR THEIR TEMPORARY DISCONNECTION, PROTECTION, REMOVAL AND/OR STORAGE AS MAY BE REQUIRED DURING CONSTRUCTION. CONTRACTOR SHALL COORDINATE WITH THE DISTRICT TO DETERMINE WHETHER TEMPORARY SERVICES ARE NECESSARY.
- THE CONTRACTOR SHALL VISIT THE SITE TO DETERMINE THE EXACT EXTENT AND DEPTH OF SITE DEMOLITION REQUIRED AND VERIFY COMPLIANCE WITH DRAWINGS. THE DISTRICT SHALL BE NOTIFIED IMMEDIATELY OF ANY DISCREPANCIES.
- THE CONTRACTOR SHALL VERIFY THE LOCATIONS OF ALL EXISTING UTILITIES, STRUCTURES AND SERVICES BEFORE COMMENCING WORK. THE LOCATIONS OF UTILITIES, STRUCTURES AND SERVICES SHOWN IN THE CONTRACT DOCUMENTS SHALL BE DEEMED TO BE APPROXIMATIONS ONLY. ALL DISCREPANCIES BETWEEN WHAT IS SHOWN AND THE ACTUAL FIELD CONDITIONS SHALL BE REPORTED TO THE DISTRICT'S REPRESENTATIVE. THE CONTRACTOR SHALL CONTACT UNDERGROUND SERVICE ALERT (USA) AT (800) 227-2600 PRIOR TO ANY DEMOLITION OR EXCAVATION. UPON COMPLETION OF USA MARKING OPERATIONS, CONTRACTOR SHALL VERIFY ALL UTILITY MARKINGS ON A SEPARATE SET OF DRAWINGS. THIS SET SHALL BE KEPT ON-SITE FOR REFERENCE FOR DURATION OF CONTRACT. NOTIFY THE DISTRICT'S REPRESENTATIVE IMMEDIATELY SHOULD CONFLICTS ARISE AND REDIRECT WORK TO AVOID DELAY.
- ALL EXISTING ITEMS ARE TO REMAIN UNLESS OTHERWISE NOTED. THE CONTRACTOR SHALL BE RESPONSIBLE FOR REPAIRING OR REPLACING, AT CONTRACTOR'S EXPENSE, ANY EXISTING ITEM DAMAGED OR DESTROYED BY CONSTRUCTION OPERATIONS. CONTRACTOR SHALL ALSO BE RESPONSIBLE FOR REPAIRING OR REPLACING ANY AND ALL DAMAGES TO ADJACENT PROPERTIES. THE DAMAGED ITEMS SHALL BE RESTORED TO AN "AS-WAS" OR BETTER CONDITION OR REPLACED PER THE DISCRETION OF THE DISTRICT'S REPRESENTATIVE.
- PRIOR TO ANY DEMOLITION WORK, CONTRACTOR SHALL INSTALL SELF-SUPPORTING INTERLOCKING CHAIN-LINK TEMPORARY CONSTRUCTION FENCING TO ENCLOSE AND SECURE THE PROJECT AREA LIMIT OF WORK. THE FENCING SHALL CONTAIN PEDESTRIAN AND/OR VEHICULAR ACCESS GATES AS NECESSARY AND SHALL BE MINIMUM 6 FEET HIGH WITH A TOP AND BOTTOM RAIL WITH KNUCKLED TOP AND BOTTOM SEVILLE (NO BARBED WIRE PERMITTED). SHALL INCLUDE FULL HEIGHT GREEN SHADE CLOTH COVERING. THE CONSTRUCTION FENCING WORK SHALL BE SUBJECT TO THE DISCRETION OF THE DISTRICT'S REPRESENTATIVE.
- PRIOR TO ANY DEMOLITION WORK, CONTRACTOR SHALL PROTECT ALL EXISTING PLANT MATERIAL NOT SCHEDULED FOR REMOVAL BY INSTALLING TEMPORARY 4 FOOT HIGH "BLAZE ORANGE" CONSTRUCTION SAFETY FENCING AT THE DRIPLINE OR PERIMETER. THE FENCING SHALL BE SECURED WITH DRIVEN METAL STAKES. ALL TREE PROTECTION WORK SHALL BE SUBJECT TO THE DISCRETION OF THE DISTRICT'S REPRESENTATIVE.
- REFER TO SPECIFICATIONS FOR ADDITIONAL CLEARING, GRUBBING, TOPSOIL STOCKPILING AND OTHER PERTINENT INFORMATION.


## DEMOLITION LEGEND

| SYM      | DESCRIPTION  |
|----------|--|
| [Symbol] | LIMIT OF WORK  |
| [Symbol] | KEY LEGEND CALLOUT - ITEMS TO BE DEMOLISHED AND REMOVED  |
| [Symbol] | KEY LEGEND CALLOUT - ITEMS TO REMAIN AND BE PROTECTED  |
| [Symbol] | SURFACE VEGETATION TO BE REMOVED PER SPECIFICATIONS. REMOVE EXCESS SOIL FROM SITE AND DISPOSED IN LEGAL MANNER. REFER TO EARTHWORK SPECIFICATIONS FOR INFORMATION. |
| [Symbol] | DEMOLISH AND REMOVE HARDSCAPE PAVING INCLUDING BASE MATERIAL.  |
| [Symbol] | INFIELD PINES TO BE STOCKPILED AND USED FOR TOPDRESS AT NORTHERN BALLFIELD (SEE L8.1). REMAINING PINES TO BE DEMOLISHED AND REMOVED.                               |
| [Symbol] | DEMOLISH AND REMOVE CURB, UTILITY LINE, AND/OR FENCE, INCLUDING POSTS, FABRIC, CURBS, EDGE BANDS AND FOOTINGS  |
| [Symbol] | SAWCUT   |
| [Symbol] | LIMIT OF CLEAR AND GRUB. CONTRACTOR SHALL CONFIRM WITH GRADING, UTILITIES AND SPECIFICATIONS.  |
| [Symbol] | TREE SHALL BE DEMOLISHED AND REMOVED, REFER TO SPECIFICATIONS  |
| [Symbol] | TREE TO REMAIN AND BE PROTECTED, REFER TO SPECIFICATIONS   |

- ITEMS TO BE PROTECTED**
- A** CHAIN LINK FENCE / GATE TO REMAIN AND BE PROTECTED. INCLUDES POSTS, FABRIC, CURBS, EDGE BANDS AND FOOTINGS.
  - B** BLEACHERS TO BE REMAIN AND BE PROTECTED, INCLUDING HARDSCAPE.
  - C** STORAGE CONTAINERS TO BE RELOCATED. (2) TO BE RELOCATED ONSITE PER L8.1 AND (1) SHALL BE RELOCATED TO STAGG HS. COORDINATE WITH DISTRICT.
  - D** APPROXIMATE LOCATION OF IRRIGATION REMOTE CONTROL VALVES, WIRES TO BE SALVAGED AND REUSED FOR NEW VALVES. CONTRACTOR TO DEMOLISH BOXES & VALVES. CONTRACTOR TO VERIFY IRRIGATION CONTROLLER OPERATING THE VALVES PRIOR TO DEMOLITION. REFER TO IRRIGATION PLAN FOR PROPOSED LOCATION.
  - E** ELECTRICAL, COMMUNICATION, DATA LINES AND COMPONENTS. REFER TO ELECTRICAL PLANS FOR INFORMATION. CONTRACTOR TO POT HOLE DEPTHS PRIOR TO CHEMICAL TREATMENT.
  - F** DRAINAGE LINES TO REMAIN AND BE PROTECTED. CONTRACTOR TO POT HOLE DEPTHS PRIOR TO CHEMICAL TREATMENT.REFER TO DRAINAGE PLANS.
  - G** WATER LINE AND ASSOCIATED ITEMS TO REMAIN AND BE PROTECTED. CONTRACTOR TO POT HOLE DEPTHS PRIOR TO CHEMICAL TREATMENT.
  - H** FURNISHINGS TO REMAIN AND BE PROTECTED.
  - I** SANITARY SEWER AND PIPES TO REMAIN AND BE PROTECTED. CONTRACTOR TO POT HOLE DEPTHS PRIOR TO CHEMICAL TREATMENT.
  - J** FIRE HYDRANT AND ASSOCIATED ITEMS TO REMAIN AND BE PROTECTED.
  - K** PEDESTRIAN LIGHT AND ASSOCIATED ITEMS TO REMAIN AND BE PROTECTED.
  - L** SCOREBOARD AND FOOTINGS TO REMAIN AND BE PROTECTED.
  - M** IRRIGATION EQUIPMENT, INCLUDING BUT NOT LIMITED TO VALVES, ROTORS, SPRAY HEADS, LATERAL LINES & MAINLINES TO REMAIN AND BE PROTECTED. REFER TO SHEETS L9.1-L9.3 FOR ADDITIONAL INFORMATION.
  - N** BACKSTOP TO REMAIN AND BE PROTECTED, INCLUDING FENCING AND CONCRETE EDGE BAND. BASEBOARDS TO BE REMOVED.
  - O** SPORTFIELD LIGHT, LINES AND BOXES TO REMAIN AND BE PROTECTED.
  - P** FLAG POLE TO REMAIN AND BE PROTECTED.
  - Q** EDGE BAND, CURB AND/OR GUTTER TO REMAIN AND BE PROTECTED.

IDENTIFICATION STAMP  
DIV. OF THE STATE ARCHITECT  
APP. 02-118017 INC.  
REVIEWED FOR  
SS ☐ FLS ☐ ACS ☐  
DATE: 04/10/2020


**VERDE DESIGN**  
LANDSCAPE ARCHITECTURE  
CIVIL ENGINEERING  
SPORT PLANNING & DESIGN  
1843 Iron Point Rd #140  
Folsom, CA 95630  
tel: 916.415.6554  
fax: 408.985.7260  
www.VerdeDesign.com

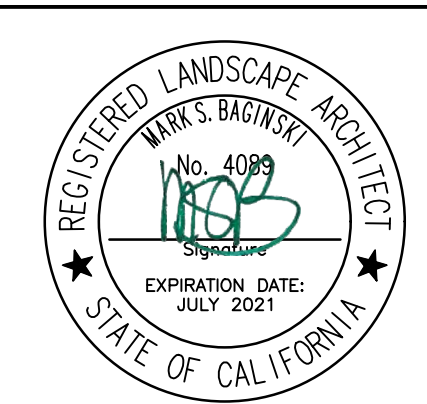

STAMP

CONSULTANT

KEYMAP

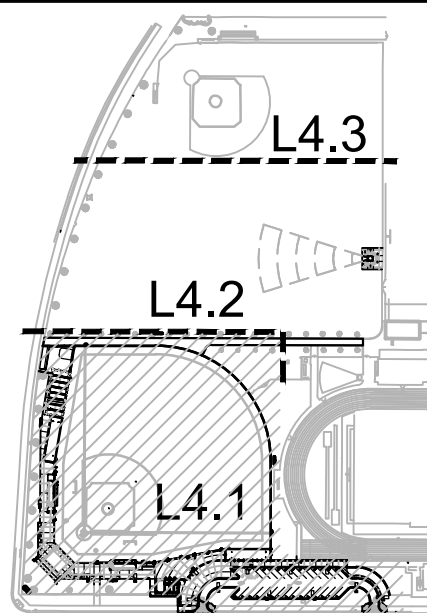

SHEET TITLE  
**DEMOLITION PLAN -  
BASEBALL FIELD**

PROJECT NAME  
**CHAVEZ HIGH SCHOOL  
STOCKTON USD  
ATHLETIC FACILITY  
IMPROVEMENTS**

PROJECT ADDRESS  
**2929 WINDFLOWER LN  
STOCKTON, CA 95212**

| SUBMITTAL               | DATE     |
|-------------------------|----------|
| DD/50% SUBMITTAL        | 10/25/19 |
| DSA SUBMITTAL           | 12/20/19 |
| DSA BACKCHECK SUBMITTAL | 03/27/20 |

| NO. | REVISIONS | DATE |
|-----|-----------|------|
| 1   |           |      |
| 2   |           |      |
| 3   |           |      |
| 4   |           |      |
| 5   |           |      |

DRAWN BY: HM  
CHECKED BY: CS  
DATE ISSUED: 03/27/20  
SCALE: 1" = 20'-0"  
PROJ. NO.: 1910900-1211  
SHEET NO.: L4.1  
7 OF 122

DEMOLITION PLAN - BASEBALL FIELD



ALL DESIGN, CONSTRUCTION, AND/OR REMEDIATION OF THIS PROJECT IS THE PROPERTY OF VERDE DESIGN, INC. AND WILL BE USED, REPRODUCED, OR PUBLISHED IN WHOLE OR IN PART, OR DISCLOSED TO ANY PERSON, FIRM, OR CORPORATION FOR ANY PURPOSE WITHOUT WRITTEN PERMISSION OF VERDE DESIGN, INC. NO PART OF THIS PROJECT IS TO BE USED, REPRODUCED, OR PUBLISHED IN WHOLE OR IN PART, OR DISCLOSED TO ANY PERSON, FIRM, OR CORPORATION FOR ANY PURPOSE WITHOUT WRITTEN PERMISSION OF VERDE DESIGN, INC.

- ITEMS TO BE DEMOLISHED
1. DRAIN STRUCTURE TO BE DEMOLISHED AND REMOVED.
  2. EDGE BAND, CURB AND/OR FENCING TO BE DEMOLISHED AND REMOVED. FENCE FOOTINGS TO BE DEMOLISHED AND REMOVED.
  3. IRRIGATION VALVES AND ASSOCIATED LATERAL LINES TO BE DEMOLISHED AND REMOVED. CONTROL WIRES SHALL BE PROTECTED WITHIN A NEW VALVE BOX LOCATED IN LANDSCAPE AREA.
  4. PITCHER'S PLATE TO BE REMOVED AND TURNED OVER TO DISTRICT.
  5. HOME PLATE TO BE REMOVED AND TURNED OVER TO DISTRICT.
  6. SAWCUT EXISTING CURB/EDGE BAND AND/OR GUTTER AT NEAREST JOINT TO ALLOW FOR NEW CURB
  7. BENCH TO BE DEMOLISHED AND REMOVED AND TURNED OVER TO DISTRICT.
  8. DRAIN LINES TO BE CAPPED, SLURRY FILLED AND ABANDONED IF NOT OBSTRUCTING FUTURE IMPROVEMENTS.
  9. UTILITY TO BE DEMOLISHED AND REMOVED.
  10. TICKET BOOTH TO BE DEMOLISHED AND REMOVED.
  11. BENCHMARK TO BE DEMOLISHED AND REMOVED.
  12. CONTRACTOR TO REMOVE TRENCH DRAIN AND CAP STORM DRAIN LINE AT NEAREST BASIN. WHERE TRENCH DRAIN IS ADJACENT TO REMAINING BACKSTOP CONTRACTOR SHALL SAWCUT AND REMOVE TRENCH DRAIN. CONCRETE EDGE BAND UNDER BACKSTOP TO REMAIN AND BE PROTECTED. DEMOLISH AND REMOVED ALL BASEBOARDS.
  13. DRINKING FOUNTAIN TO BE DEMOLISHED AND REMOVED.
  14. BATTING CAGE POLES AND NETTING TO BE DEMOLISHED AND REMOVED.
  15. 2' TALL PLASTIC STORAGE BIN TO BE DEMOLISHED AND REMOVED.
  16. CONCRETE PAD TO BE DEMOLISHED AND REMOVED.
  17. QUICK COUPLERS TO BE DEMOLISHED AND REMOVED. LINE TO REMAIN ACTIVE AND TIE INTO NEW LOCATIONS PER IRRIGATION PLAN.
  18. ELECTRICAL TO BE ADJUSTED AND/OR DEMOLISHED AND REMOVED. REFER TO ELECTRICAL PLANS.
  19. FOUL POLES AND FOOTINGS TO BE DEMOLISHED AND REMOVED.

## DEMOLITION NOTES

1. THE CONTRACTOR SHALL PERFORM ALL CLEARING, DEMOLITION, REMOVAL OF OBSTRUCTIONS AND SITE PREPARATIONS NECESSARY FOR THE PROPER EXECUTION OF ALL WORK CONTAINED IN THE CONTRACT DOCUMENTS.
2. CONTRACTOR SHALL VERIFY LOCATION OF ALL EXISTING UTILITIES AND PROVIDE THE REQUIRED COORDINATION FOR THEIR TEMPORARY DISCONNECTION, PROTECTION, REMOVAL AND/OR STORAGE AS MAY BE REQUIRED DURING CONSTRUCTION. CONTRACTOR SHALL COORDINATE WITH THE DISTRICT TO DETERMINE WHETHER TEMPORARY SERVICES ARE NECESSARY.
3. THE CONTRACTOR SHALL VISIT THE SITE TO DETERMINE THE EXACT EXTENT AND DEPTH OF SITE DEMOLITION REQUIRED AND VERIFY COMPLIANCE WITH DRAWINGS. THE DISTRICT SHALL BE NOTIFIED IMMEDIATELY OF ANY DISCREPANCIES.
4. THE CONTRACTOR SHALL VERIFY THE LOCATIONS OF ALL EXISTING UTILITIES, STRUCTURES AND SERVICES BEFORE COMMENCING WORK. THE LOCATIONS OF UTILITIES, STRUCTURES AND SERVICES SHOWN IN THE CONTRACT DOCUMENTS SHALL BE DEEMED TO BE APPROXIMATIONS ONLY. ALL DISCREPANCIES BETWEEN WHAT IS SHOWN AND THE ACTUAL FIELD CONDITIONS SHALL BE REPORTED TO THE DISTRICT'S REPRESENTATIVE. THE CONTRACTOR SHALL CONTACT UNDERGROUND SERVICE ALERT (USA) AT (800) 227-2600 PRIOR TO ANY DEMOLITION OR EXCAVATION. UPON COMPLETION OF USA MARKING OPERATIONS, CONTRACTOR SHALL RECORD ALL UTILITY MARKINGS ON A SEPARATE SET OF DRAWINGS. THIS SET SHALL BE KEPT ON-SITE FOR REFERENCE FOR DURATION OF CONTRACT. NOTIFY THE DISTRICT'S REPRESENTATIVE IMMEDIATELY SHOULD CONFLICTS ARISE AND REDIRECT WORK TO AVOID DELAY.
5. ALL EXISTING ITEMS ARE TO REMAIN UNLESS OTHERWISE NOTED. THE CONTRACTOR SHALL BE RESPONSIBLE FOR REPAIRING OR REPLACING, AT CONTRACTOR'S EXPENSE, ANY EXISTING ITEM DAMAGED OR DESTROYED BY CONSTRUCTION OPERATIONS. CONTRACTOR SHALL ALSO BE RESPONSIBLE FOR REPAIRING OR REPLACING ANY AND ALL DAMAGES TO ADJACENT PROPERTIES. THE DAMAGED ITEMS SHALL BE RESTORED TO AN "AS-WAS" OR BETTER CONDITION OR REPLACED PER THE DISCRETION OF THE DISTRICT'S REPRESENTATIVE.
6. PRIOR TO ANY DEMOLITION WORK, CONTRACTOR SHALL INSTALL SELF-SUPPORTING INTERLOCKING CHAIN-LINK TEMPORARY CONSTRUCTION FENCING TO ENCLOSE AND SECURE THE PROJECT AREA LIMIT OF WORK. THE FENCING SHALL CONTAIN PEDESTRIAN AND/OR VEHICULAR ACCESS GATES AS NECESSARY AND SHALL BE MINIMUM 6 FEET HIGH WITH A TOP AND BOTTOM RAIL WITH KNUCKLED TOP AND BOTTOM SEWAGE (NO BARBED WIRE PERMITTED). SHALL INCLUDE FULL HEIGHT GREEN SHADE CLOTH COVERING. THE CONSTRUCTION FENCING WORK SHALL BE SUBJECT TO THE DISCRETION OF THE DISTRICT'S REPRESENTATIVE.
7. PRIOR TO ANY DEMOLITION WORK, CONTRACTOR SHALL PROTECT ALL EXISTING PLANT MATERIAL NOT SCHEDULED FOR REMOVAL BY INSTALLING TEMPORARY 4 FOOT HIGH "BLAZE ORANGE" CONSTRUCTION SAFETY FENCING AT THE DRIPLINE OR PERIMETER. THE FENCING SHALL BE SECURED WITH DRIVEN METAL STAKES. ALL TREE PROTECTION WORK SHALL BE SUBJECT TO THE DISCRETION OF THE DISTRICT'S REPRESENTATIVE.
8. REFER TO SPECIFICATIONS FOR ADDITIONAL CLEARING, GRUBBING, TOPSOIL STOCKPILING AND OTHER PERTINENT INFORMATION.

## DEMOLITION LEGEND

| SYM | DESCRIPTION  |
|-----|--|
|     | LIMIT OF WORK  |
|     | KEY LEGEND CALLOUT - ITEMS TO BE DEMOLISHED AND REMOVED  |
|     | KEY LEGEND CALLOUT - ITEMS TO REMAIN AND BE PROTECTED  |
|     | SURFACE VEGETATION TO BE REMOVED PER SPECIFICATIONS. REMOVE EXCESS SOIL FROM SITE AND DISPOSED IN LEGAL MANNER. REFER TO EARTHWORK SPECIFICATIONS FOR INFORMATION. |
|     | DEMOLISH AND REMOVE HARDSCAPE PAVING INCLUDING BASE MATERIAL.  |
|     | INFILL FINES TO BE STOCKPILED AND USED FOR TOPDRESS AT NORTHERN BALLFIELD (SEE L8.1). REMAINING FINES TO BE DEMOLISHED AND REMOVED.                                |
|     | DEMOLISH AND REMOVE CURB, UTILITY LINE, AND/OR FENCE, INCLUDING POSTS, FABRIC, CURBS, EDGE BANDS AND FOOTINGS  |
|     | SAWCUT   |
|     | LIMIT OF CLEAR AND GRUB. CONTRACTOR SHALL CONFIRM WITH GRADING, UTILITIES AND SPECIFICATIONS.  |
|     | TREE SHALL BE DEMOLISHED AND REMOVED, REFER TO SPECIFICATIONS  |
|     | TREE TO REMAIN AND BE PROTECTED, REFER TO SPECIFICATIONS   |

- ITEMS TO BE PROTECTED
- A. CHAIN LINK FENCE / GATE TO REMAIN AND BE PROTECTED. INCLUDES POSTS, FABRIC, CURBS, EDGE BANDS AND FOOTINGS.
  - B. BLEACHERS TO BE REMAIN AND BE PROTECTED, INCLUDING HARDSCAPE.
  - C. STORAGE CONTAINERS TO BE RELOCATED. (2) TO BE RELOCATED ONSITE PER LB.1 AND (1) SHALL BE RELOCATED TO STAGG HS. COORDINATE WITH DISTRICT.
  - D. APPROXIMATE LOCATION OF IRRIGATION REMOTE CONTROL VALVES, WIRES TO BE SALVAGED AND REUSED FOR NEW VALVES. CONTRACTOR TO DEMOLISH BOXES & VALVES. CONTRACTOR TO VERIFY IRRIGATION CONTROLLER OPERATING THE VALVES PRIOR TO DEMOLITION. REFER TO IRRIGATION PLAN FOR PROPOSED LOCATION.
  - E. ELECTRICAL, COMMUNICATION, DATA LINES AND COMPONENTS. REFER TO ELECTRICAL PLANS FOR INFORMATION. CONTRACTOR TO POTHOLE DEPTHS PRIOR TO CHEMICAL TREATMENT.
  - F. DRAINAGE LINES TO REMAIN AND BE PROTECTED. CONTRACTOR TO POTHOLE DEPTHS PRIOR TO CHEMICAL TREATMENT.REFER TO DRAINAGE PLANS.
  - G. WATER LINE AND ASSOCIATED ITEMS TO REMAIN AND BE PROTECTED. CONTRACTOR TO POTHOLE DEPTHS PRIOR TO CHEMICAL TREATMENT.
  - H. FURNISHINGS TO REMAIN AND BE PROTECTED.
  - I. SANITARY SEWER AND PIPES TO REMAIN AND BE PROTECTED. CONTRACTOR TO POTHOLE DEPTHS PRIOR TO CHEMICAL TREATMENT.
  - J. FIRE HYDRANT AND ASSOCIATED ITEMS TO REMAIN AND BE PROTECTED.
  - K. PEDESTRIAN LIGHT AND ASSOCIATED ITEMS TO REMAIN AND BE PROTECTED.
  - L. SCOREBOARD AND FOOTINGS TO REMAIN AND BE PROTECTED.
  - M. IRRIGATION EQUIPMENT, INCLUDING BUT NOT LIMITED TO VALVES, ROTORS, SPRAY HEADS, LATERAL LINES AND MAINLINES TO REMAIN AND BE PROTECTED. REFER TO SHEETS L9.1-L9.3 FOR ADDITIONAL INFORMATION.
  - N. BACKSTOP TO REMAIN AND BE PROTECTED, INCLUDING FENCING AND CONCRETE EDGE BAND. BASEBOARDS TO BE REMOVED.
  - O. SPORTFIELD LIGHT, LINES AND BOXES TO REMAIN AND BE PROTECTED.
  - P. FLAG POLE TO REMAIN AND BE PROTECTED.
  - Q. EDGE BAND, CURB AND/OR GUTTER TO REMAIN AND BE PROTECTED.
  - R. SOFTSCAPE TO REMAIN AND BE PROTECTED. IRRIGATION WITHIN THIS AREA TO REMAIN OPERABLE DURING CONSTRUCTION. ADJUST AS REQUIRED TO ENSURE FULL COVERAGE AFTER CONSTRUCTION.
  - S. BENCHMARK TO REMAIN AND BE PROTECTED.
  - T. FLOAT VALVE ASSEMBLY AND ASSOCIATED ITEMS TO REMAIN AND BE PROTECTED.
  - U. BALLFIELD FINES, INFILL, AND ALL ASSOCIATED ITEMS TO REMAIN AND BE PROTECTED.
  - V. HARDSCAPE/ WALK TO REMAIN AND BE PROTECTED.
  - W. DRAINAGE STRUCTURE REMAIN AND BE PROTECTED. CONTRACTOR TO ADJUST LID AND PROTECT PIPES AS REQUIRED. REFER TO DRAINAGE PLANS.
  - X. ELECTRICAL VAULT BOX TO REMAIN AND BE PROTECTED, CONTRACTOR TO POTHOLE TO VERIFY DEPTH PRIOR TO CHEMICAL TREATMENT.



0' 10' 20' 40' 60'

IDENTIFICATION STAMP  
DIV. OF THE STATE ARCHITECT  
APP. 02-118017 INC.  
REVIEWED FOR  
SS ☐ FLS ☐ ACS ☐  
DATE: 04/10/2020


**VERDE DESIGN**  
LANDSCAPE ARCHITECTURE  
CIVIL ENGINEERING  
SPORT PLANNING & DESIGN  
1843 Iron Point Rd #140  
Folsom, CA 95630  
tel: 916.415.6554  
fax: 916.985.7260  
www.VerdeDesignInc.com



STAMP

CONSULTANT

KEYMAP

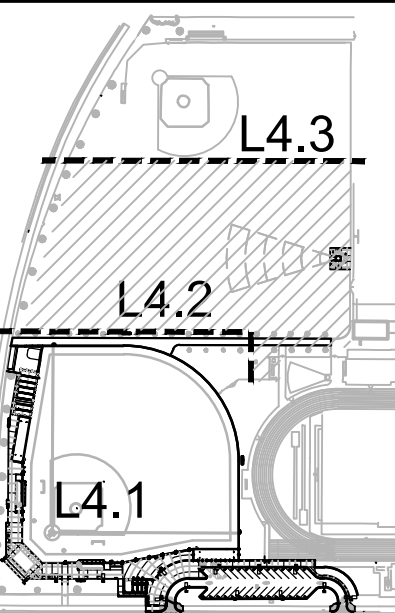

SHEET TITLE

**DEMOLITION PLAN -  
MULTI-USE SOUTH**

PROJECT NAME

**CHAVEZ HIGH SCHOOL  
STOCKTON USD  
ATHLETIC FACILITY  
IMPROVEMENTS**

PROJECT ADDRESS

**2929 WINDFLOWER LN  
STOCKTON, CA 95212**

| SUBMITTAL               | DATE     |
|-------------------------|----------|
| DD/50% SUBMITTAL        | 10/25/19 |
| DSA SUBMITTAL           | 12/20/19 |
| DSA BACKCHECK SUBMITTAL | 03/27/20 |

| NO. | REVISIONS | DATE |
|-----|-----------|------|
| 1   |           |      |
| 2   |           |      |
| 3   |           |      |
| 4   |           |      |
| 5   |           |      |

|                           |                      |
|---------------------------|----------------------|
| DRAWN BY<br>HM            | CHECKED BY<br>CS     |
| DATE ISSUED<br>03/27/20   | SCALE<br>1" = 20'-0" |
| PROJ. NO.<br>1910900-1211 |                      |
| SHEET NO.<br>L4.2         | 8 OF 122             |

DEMOLITION PLAN - MULTI-USE SOUTH



ALL LINES, DESIGNATIONS, DIMENSIONS, AND/OR LOCATIONS OF EXISTING UTILITIES, STRUCTURES, AND SERVICES SHOWN ON THIS PLAN ARE THE PROPERTY OF VERDE DESIGN, INC. AND WERE CREATED, EVALUATED, AND DEVELOPED FOR USE ON AND IN CONNECTION WITH THE SPECIFIED PROJECT. NONE OF SUCH IDEAS, DESIGNS, ARRANGEMENTS OR PLANS SHALL BE USED, REPRODUCED, OR PUBLISHED BY ANY METHOD, IN WHOLE OR IN PART, OR DISCLOSED TO ANY PERSON, FIRM, OR CORPORATION FOR ANY PURPOSES WHATSOEVER WITHOUT THE WRITTEN PERMISSION OF VERDE DESIGN, INC.

- ITEMS TO BE PROTECTED**
- R** SOFTSCAPE TO REMAIN AND BE PROTECTED. IRRIGATION WITHIN THIS AREA TO REMAIN OPERABLE DURING CONSTRUCTION. ADJUST AS REQUIRED TO ENSURE FULL COVERAGE AFTER CONSTRUCTION.
  - S** BENCHMARK TO REMAIN AND BE PROTECTED.
  - T** FLOAT VALVE ASSEMBLY AND ASSOCIATED ITEMS TO REMAIN AND BE PROTECTED.
  - U** BALLFIELD PINES, INFIELD, AND ALL ASSOCIATED ITEMS TO REMAIN AND BE PROTECTED.
  - V** HARDSCAPE / WALK TO REMAIN AND BE PROTECTED.
  - W** DRAINAGE STRUCTURE REMAIN AND BE PROTECTED. CONTRACTOR TO ADJUST LID AND PROTECT PIPES AS REQUIRED. REFER TO DRAINAGE PLANS.
  - X** ELECTRICAL VAULT BOX TO REMAIN AND BE PROTECTED, CONTRACTOR TO POTHOLE TO VERIFY DEPTH PRIOR TO CHEMICAL TREATMENT.
- ITEMS TO BE DEMOLISHED**
- 1** DRAIN STRUCTURE TO BE DEMOLISHED AND REMOVED.
  - 2** EDGE BAND, CURB AND/OR FENCING TO BE DEMOLISHED AND REMOVED. FENCE FOOTINGS TO BE DEMOLISHED AND REMOVED.
  - 3** IRRIGATION VALVES AND ASSOCIATED LATERAL LINES TO BE DEMOLISHED AND REMOVED. CONTROL WIRES SHALL BE PROTECTED WITHIN A NEW VALVE BOX LOCATED IN LANDSCAPE AREA.
  - 4** PITCHER'S PLATE TO BE REMOVED AND TURNED OVER TO DISTRICT.
  - 5** HOMEPLATE TO BE REMOVED AND TURNED OVER TO DISTRICT.
  - 6** SAWCUT EXISTING CURB/EDGE BAND AND/OR GUTTER AT NEAREST JOINT TO ALLOW FOR NEW CURB
  - 7** BENCH TO BE DEMOLISHED AND REMOVED AND TURNED OVER TO DISTRICT.
  - 8** DRAIN LINES TO BE CAPPED, SLURRY FILLED AND ABANDONED IF NOT OBSTRUCTING FUTURE IMPROVEMENTS.
  - 9** UTILITY TO BE DEMOLISHED AND REMOVED.
  - 10** TICKET BOOTH TO BE DEMOLISHED AND REMOVED.
  - 11** BENCHMARK TO BE DEMOLISHED AND REMOVED.
  - 12** CONTRACTOR TO REMOVE TRENCH DRAIN AND CAP STORM DRAIN LINE AT NEAREST BASIN. WHERE TRENCH DRAIN IS ADJACENT TO REMAINING BACKSTOP CONTRACTOR SHALL SAWCUT AND REMOVE TRENCH DRAIN. CONCRETE EDGE BAND UNDER BACKSTOP TO REMAIN AND BE PROTECTED. DEMOLISH AND REMOVED ALL BASEBOARDS.
  - 13** DRINKING FOUNTAIN TO BE DEMOLISHED AND REMOVED.
  - 14** BATTING CAGE POLES AND NETTING TO BE DEMOLISHED AND REMOVED.
  - 15** 2' TALL PLASTIC STORAGE BIN TO BE DEMOLISHED AND REMOVED.
  - 16** CONCRETE PAD TO BE DEMOLISHED AND REMOVED.
  - 17** QUICK COUPLERS TO BE DEMOLISHED AND REMOVED. LINE TO REMAIN ACTIVE AND TIE INTO NEW LOCATIONS PER IRRIGATION PLAN.
  - 18** ELECTRICAL TO BE ADJUSTED AND/OR DEMOLISHED AND REMOVED. REFER TO ELECTRICAL PLANS.
  - 19** FOUL POLES AND FOOTINGS TO BE DEMOLISHED AND REMOVED.


## DEMOLITION NOTES

- THE CONTRACTOR SHALL PERFORM ALL CLEARING, DEMOLITION, REMOVAL OF OBSTRUCTIONS AND SITE PREPARATIONS NECESSARY FOR THE PROPER EXECUTION OF ALL WORK CONTAINED IN THE CONTRACT DOCUMENTS.
- CONTRACTOR SHALL VERIFY LOCATION OF ALL EXISTING UTILITIES AND PROVIDE THE REQUIRED COORDINATION FOR THEIR TEMPORARY DISCONNECTION, PROTECTION, REMOVAL AND/OR STORAGE AS MAY BE REQUIRED DURING CONSTRUCTION. CONTRACTOR SHALL COORDINATE WITH THE DISTRICT TO DETERMINE WHETHER TEMPORARY SERVICES ARE NECESSARY.
- THE CONTRACTOR SHALL VISIT THE SITE TO DETERMINE THE EXACT EXTENT AND DEPTH OF SITE DEMOLITION REQUIRED AND VERIFY COMPLIANCE WITH DRAWINGS. THE DISTRICT SHALL BE NOTIFIED IMMEDIATELY OF ANY DISCREPANCIES.
- THE CONTRACTOR SHALL VERIFY THE LOCATIONS OF ALL EXISTING UTILITIES, STRUCTURES AND SERVICES BEFORE COMMENCING WORK. THE LOCATIONS OF UTILITIES, STRUCTURES AND SERVICES SHOWN IN THE CONTRACT DOCUMENTS SHALL BE DEEMED TO BE APPROXIMATIONS ONLY. ALL DISCREPANCIES BETWEEN WHAT IS SHOWN AND THE ACTUAL FIELD CONDITIONS SHALL BE REPORTED TO THE DISTRICT'S REPRESENTATIVE. THE CONTRACTOR SHALL CONTACT UNDERGROUND SERVICE ALERT (USA) AT (800) 227-2600 PRIOR TO ANY DEMOLITION OR EXCAVATION. UPON COMPLETION OF USA MARKING OPERATIONS, CONTRACTOR SHALL RECORD ALL UTILITY MARKINGS ON A SEPARATE SET OF DRAWINGS. THIS SET SHALL BE KEPT ON-SITE FOR REFERENCE FOR DURATION OF CONTRACT. NOTIFY THE DISTRICT'S REPRESENTATIVE IMMEDIATELY SHOULD CONFLICTS ARISE AND REDIRECT WORK TO AVOID DELAY.
- ALL EXISTING ITEMS ARE TO REMAIN UNLESS OTHERWISE NOTED. THE CONTRACTOR SHALL BE RESPONSIBLE FOR REPAIRING OR REPLACING, AT CONTRACTOR'S EXPENSE, ANY EXISTING ITEM DAMAGED OR DESTROYED BY CONSTRUCTION OPERATIONS. CONTRACTOR SHALL ALSO BE RESPONSIBLE FOR REPAIRING OR REPLACING ANY AND ALL DAMAGES TO ADJACENT PROPERTIES. THE DAMAGED ITEMS SHALL BE RESTORED TO AN "AS-WAS" OR BETTER CONDITION OR REPLACED PER THE DISCRETION OF THE DISTRICT'S REPRESENTATIVE.
- PRIOR TO ANY DEMOLITION WORK, CONTRACTOR SHALL INSTALL SELF-SUPPORTING INTERLOCKING CHAIN-LINK TEMPORARY CONSTRUCTION FENCING TO ENCLOSE AND SECURE THE PROJECT AREA LIMIT OF WORK. THE FENCING SHALL CONTAIN PEDESTRIAN AND/OR VEHICULAR ACCESS GATES AS NECESSARY AND SHALL BE MINIMUM 6 FEET HIGH WITH A TOP AND BOTTOM RAIL WITH KNUCKLED TOP AND BOTTOM SEVAGE (NO BARBED WIRE PERMITTED). SHALL INCLUDE FULL HEIGHT GREEN SHADE CLOTH COVERING. THE CONSTRUCTION FENCING WORK SHALL BE SUBJECT TO THE DISCRETION OF THE DISTRICT'S REPRESENTATIVE.
- PRIOR TO ANY DEMOLITION WORK, CONTRACTOR SHALL PROTECT ALL EXISTING PLANT MATERIAL NOT SCHEDULED FOR REMOVAL BY INSTALLING TEMPORARY 4 FOOT HIGH "BLAZE ORANGE" CONSTRUCTION SAFETY FENCING AT THE DRIPLINE OR PERIMETER. THE FENCING SHALL BE SECURED WITH DRIVEN METAL STAKES. ALL TREE PROTECTION WORK SHALL BE SUBJECT TO THE DISCRETION OF THE DISTRICT'S REPRESENTATIVE.
- REFER TO SPECIFICATIONS FOR ADDITIONAL CLEARING, GRUBBING, TOPSOIL STOCKPILING AND OTHER PERTINENT INFORMATION.


## DEMOLITION LEGEND

| SYM | DESCRIPTION  |
|-----|--|
|     | LIMIT OF WORK  |
|     | KEY LEGEND CALLOUT - ITEMS TO BE DEMOLISHED AND REMOVED  |
|     | KEY LEGEND CALLOUT - ITEMS TO REMAIN AND BE PROTECTED  |
|     | SURFACE VEGETATION TO BE REMOVED PER SPECIFICATIONS. REMOVE EXCESS SOIL FROM SITE AND DISPOSED IN LEGAL MANNER. REFER TO EARTHWORK SPECIFICATIONS FOR INFORMATION. |
|     | DEMOLISH AND REMOVE HARDSCAPE PAVING INCLUDING BASE MATERIAL.  |
|     | INFIELD PINES TO BE STOCKPILED AND USED FOR TOPDRESS AT NORTHERN BALLFIELD (SEE L8.1). REMAINING PINES TO BE DEMOLISHED AND REMOVED.                               |
|     | DEMOLISH AND REMOVE CURB, UTILITY LINE, AND/OR FENCE, INCLUDING POSTS, FABRIC, CURBS, EDGE BANDS AND FOOTINGS  |
|     | SAWCUT   |
|     | LIMIT OF CLEAR AND GRUB. CONTRACTOR SHALL CONFIRM WITH GRADING, UTILITIES AND SPECIFICATIONS.  |
|     | TREE SHALL BE DEMOLISHED AND REMOVED, REFER TO SPECIFICATIONS  |
|     | TREE TO REMAIN AND BE PROTECTED, REFER TO SPECIFICATIONS   |

- ITEMS TO BE PROTECTED**
- A** CHAIN LINK FENCE / GATE TO REMAIN AND BE PROTECTED. INCLUDES POSTS, FABRIC, CURBS, EDGE BANDS AND FOOTINGS.
  - B** BLEACHERS TO REMAIN AND BE PROTECTED, INCLUDING HARDSCAPE.
  - C** STORAGE CONTAINERS TO BE RELOCATED. (2) TO BE RELOCATED ONSITE PER L8.1 AND (1) SHALL BE RELOCATED TO STAGG HS. COORDINATE WITH DISTRICT.
  - D** APPROXIMATE LOCATION OF IRRIGATION REMOTE CONTROL VALVES, WIRES TO BE SALVAGED AND REUSED FOR NEW VALVES. CONTRACTOR TO DEMOLISH BOXES & VALVES. CONTRACTOR TO VERIFY IRRIGATION CONTROLLER OPERATING THE VALVES PRIOR TO DEMOLITION. REFER TO IRRIGATION PLAN FOR PROPOSED LOCATION.
  - E** ELECTRICAL, COMMUNICATION, DATA LINES AND COMPONENTS. REFER TO ELECTRICAL PLANS FOR INFORMATION. CONTRACTOR TO POTHOLE DEPTHS PRIOR TO CHEMICAL TREATMENT.
  - F** DRAINAGE LINES TO REMAIN AND BE PROTECTED. CONTRACTOR TO POTHOLE DEPTHS PRIOR TO CHEMICAL TREATMENT.REFER TO DRAINAGE PLANS.
  - G** WATER LINE AND ASSOCIATED ITEMS TO REMAIN AND BE PROTECTED. CONTRACTOR TO POTHOLE DEPTHS PRIOR TO CHEMICAL TREATMENT.
  - H** FURNISHINGS TO REMAIN AND BE PROTECTED.
  - I** SANITARY SEWER AND PIPES TO REMAIN AND BE PROTECTED. CONTRACTOR TO POTHOLE DEPTHS PRIOR TO CHEMICAL TREATMENT.
  - J** FIRE HYDRANT AND ASSOCIATED ITEMS TO REMAIN AND BE PROTECTED.
  - K** PEDESTRIAN LIGHT AND ASSOCIATED ITEMS TO REMAIN AND BE PROTECTED.
  - L** SCOREBOARD AND FOOTINGS TO REMAIN AND BE PROTECTED.
  - M** IRRIGATION EQUIPMENT, INCLUDING BUT NOT LIMITED TO VALVES, ROTORS, SPRAY HEADS, LATERAL LINES AND MAINLINES TO REMAIN AND BE PROTECTED. REFER TO SHEETS L9.1-L9.3 FOR ADDITIONAL INFORMATION.
  - N** BACKSTOP TO REMAIN AND BE PROTECTED, INCLUDING FENCING AND CONCRETE EDGE BAND. BASEBOARDS TO BE REMOVED.
  - O** SPORTFIELD LIGHT, LINES AND BOXES TO REMAIN AND BE PROTECTED.
  - P** FLAG POLE TO REMAIN AND BE PROTECTED.
  - Q** EDGE BAND, CURB AND/OR GUTTER TO REMAIN AND BE PROTECTED.

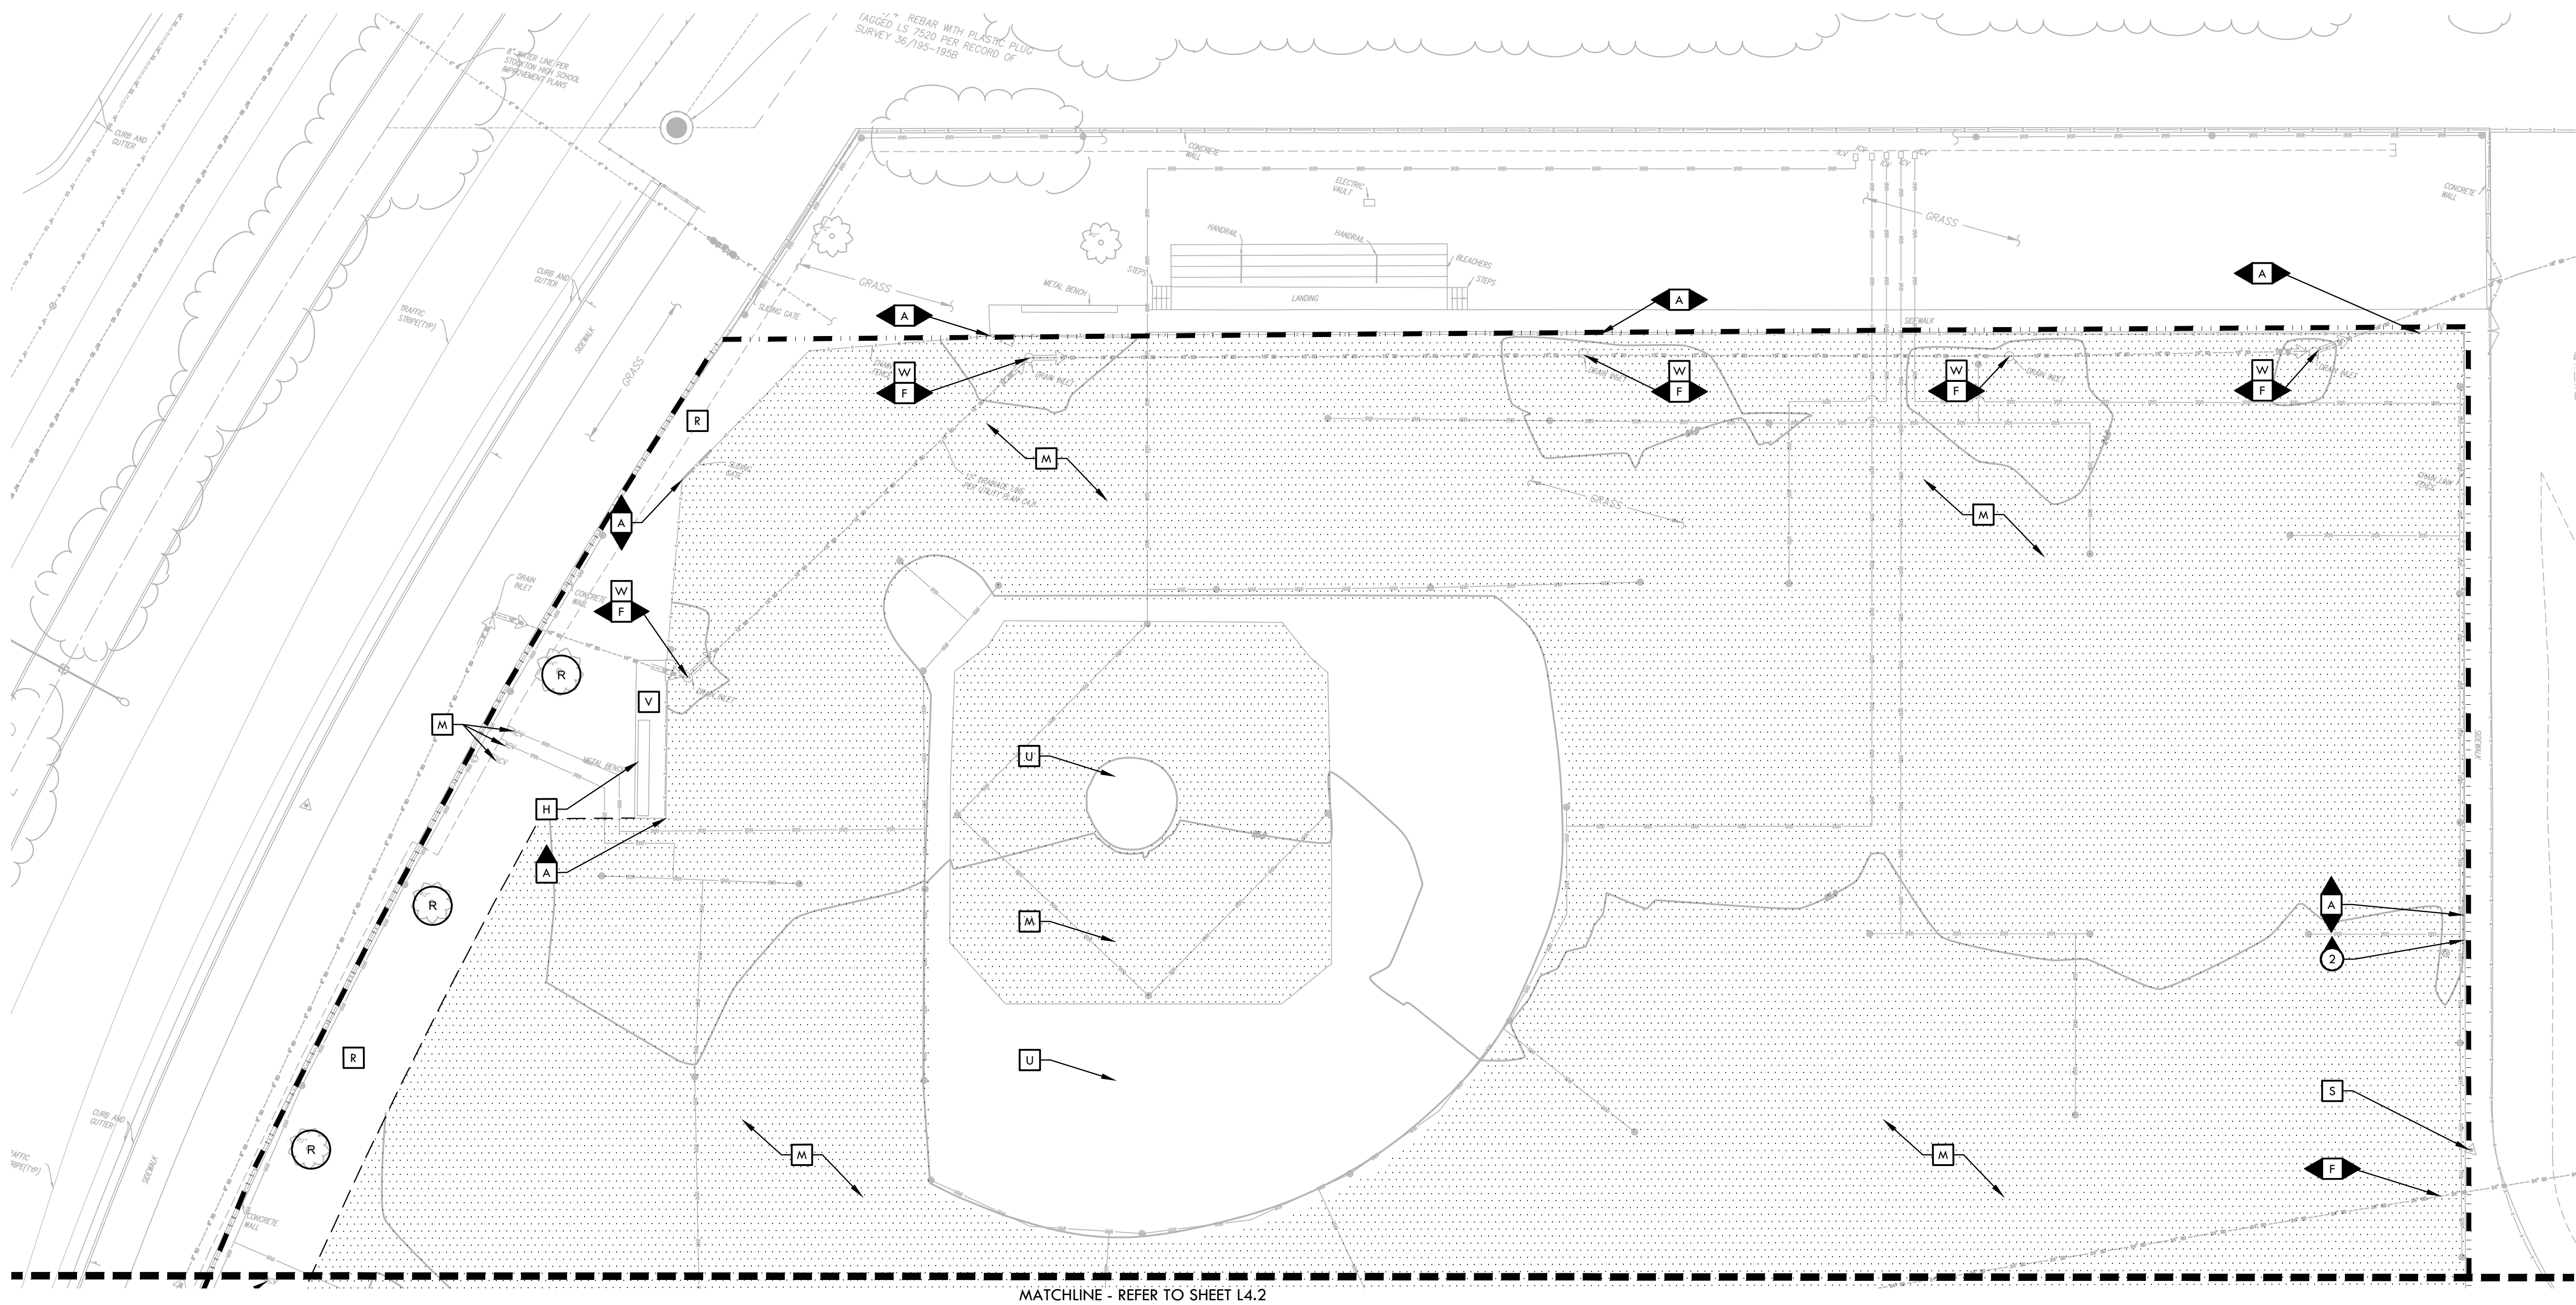

MATCHLINE - REFER TO SHEET L4.2

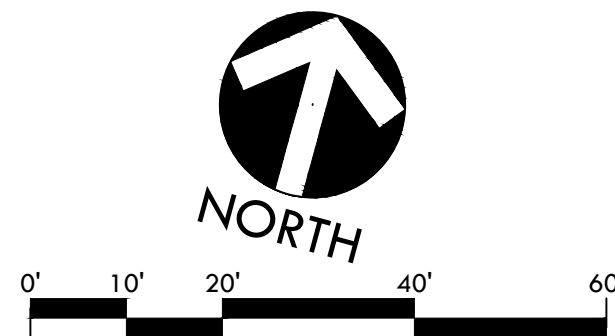

IDENTIFICATION STAMP  
DIV. OF THE STATE ARCHITECT  
APP. 02-118017 INC.  
REVIEWED FOR  
SS ☐ FLS ☐ ACS ☐  
DATE: 04/10/2020


**VERDE DESIGN**  
LANDSCAPE ARCHITECTURE  
CIVIL ENGINEERING  
SPORT PLANNING & DESIGN  
1843 Iron Point Rd #140  
Folsom, CA 95630  
tel: 916.415.6554  
fax: 408.985.7260  
www.VerdeDesigninc.com

STAMP



CONSULTANT

KEYMAP

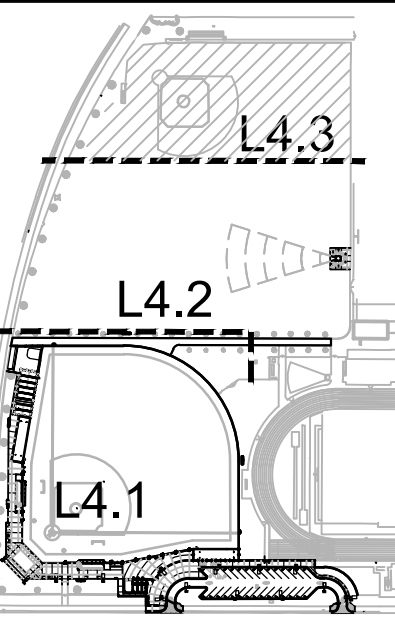

SHEET TITLE

**DEMOLITION PLAN -  
MULTI-USE NORTH**

PROJECT NAME

**CHAVEZ HIGH SCHOOL  
STOCKTON USD  
ATHLETIC FACILITY  
IMPROVEMENTS**

PROJECT ADDRESS

**2929 WINDFLOWER LN  
STOCKTON, CA 95212**

| SUBMITTAL               | DATE     |
|-------------------------|----------|
| DD/50% SUBMITTAL        | 10/25/19 |
| DSA SUBMITTAL           | 12/20/19 |
| DSA BACKCHECK SUBMITTAL | 03/27/20 |

| NO. | REVISIONS | DATE |
|-----|-----------|------|
| 1   |           |      |
| 2   |           |      |
| 3   |           |      |
| 4   |           |      |
| 5   |           |      |
| 6   |           |      |
| 7   |           |      |
| 8   |           |      |
| 9   |           |      |
| 10  |           |      |

|                           |                      |
|---------------------------|----------------------|
| DRAWN BY<br>HM            | CHECKED BY<br>CS     |
| DATE ISSUED<br>03/27/20   | SCALE<br>1" = 20'-0" |
| PROJ. NO.<br>1910900-1211 |                      |
| SHEET NO.<br>L4.3         | 9 OF 122             |

DEMOLITION PLAN - MULTI-USE NORTH




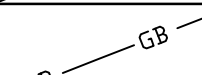
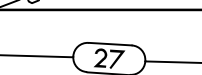

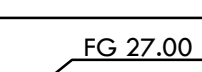
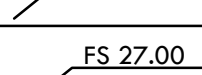
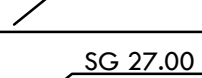
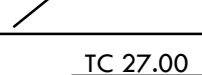
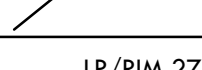
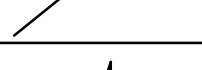








| CUT & FILL VOLUME CALC'S* |                     |                             |
|---------------------------|---------------------|-----------------------------|
| *FOR REFERENCE ONLY       |                     |                             |
| CUT VOLUME                | FILL VOLUME         | NET VOLUME                  |
| 3,610 YD <sup>3</sup>     | 912 YD <sup>3</sup> | 2,698 YD <sup>3</sup> (CUT) |


## GRADING NOTES

1. EXISTING GRADES BASED ON INFORMATION PROVIDED BY; ANDREWS GEOMATICS. CONTRACTOR SHALL VERIFY EXISTING GRADES FOR ACCURACY PRIOR TO THE START OF GRADING, NOTIFY THE OWNER'S REPRESENTATIVE IMMEDIATELY SHOULD CONFLICTS ARISE AND REDIRECT TO THE APPROPRIATE PARTY.
2. THE CONTRACTOR SHALL VERIFY THE LOCATIONS OF ALL EXISTING UTILITIES; STRUCTURES AND SERVICES BEFORE COMMENCING WORK. THE LOCATIONS OF UTILITIES, STRUCTURES AND SERVICES SHOWN IN THE CONTRACT DOCUMENTS SHALL BE DEEMED TO BE APPROXIMATIONS ONLY. ALL DISCREPANCIES BETWEEN WHAT IS SHOWN TO THE ABOVE AND THE ACTUAL FIELD CONDITIONS SHALL BE REPORTED TO THE OWNER'S REPRESENTATIVE. THE CONTRACTOR SHALL CONTACT UNDER GROUND SERVICE ALERT (USA) AT (800) 227-2260 PRIOR TO ANY DEMOLITION OR EXCAVATION. UPON RECEIPT OF USE OF UNDERGROUND UTILITY RECORDS, CONTRACTOR SHALL RECORD ALL UTILITY MARKINGS ON A SEPARATE SET OF DRAWINGS. THIS SET SHALL BE KEPT ON-SITE FOR REFERENCE FOR DURATION OF CONTRACT.
3. PROPOSED GRADES SHALL MEET EXISTING GRADES WITH A SMOOTH AND CONTINUOUS TRANSITION SO AS TO AVOID TRIPPING WATER. CONTRACTOR SHALL PROVIDE OWNER RECORD OF ALL UTILITY RECORDS, STRUCTURES AND SERVICES TO BE AS AVOID DELAY WHILE AWAITING RESPONSE.
4. ALL EXISTING DRAINAGE STRUCTURES, BOXES, UTILITY VAULTS ETC. SHALL BE BROUGHT TO FINAL FINISH GRADE PRIOR TO FINAL SURFACE TREATMENT.
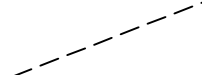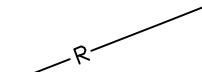
## GRADING LEGEND
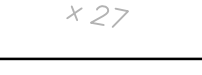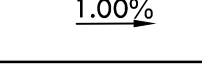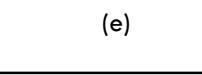
| SYM   | DESCRIPTION  |
|---|--|
|  | LIMIT OF GRADING - CONFORM TO EXISTING GRADES AT THIS LINE |
|  | CROWN OF FIELD, OR RIDGE LINE                              |
|  | SUBGRADE LOW POINT   |
|  | GRADE BREAK  |
|  | PROPOSED FINISH SURFACE /GRADE CONTOUR                     |
|  | PROPOSED SUBGRADE CONTOUR                                  |
|  | PROPOSED FINISH GRADE ELEVATION OF SOFTSCAPE               |
|  | PROPOSED FINISH SURFACE ELEVATION OF HARDSCAPE             |
|  | PROPOSED SUBGRADE ELEVATION                                |
|  | PROPOSED TOP OF CURB ELEVATION                             |
|  | PROPOSED LOW POINT / RIM ELEVATION OF DRAIN                |
|  | CONFORM TO EXISTING GRADE                                  |
|  | EXISTING CONTOUR   |
|  | EXISTING ELEVATION   |
|  | SLOPE AND DIRECTION  |
|  | EXISTING   |
|  | TOP OF ROCK  |
|  | BOTTOM OF BIORETENTION BASIN, REFER TO DRAINAGE PLANS.     |

IDENTIFICATION STAMP  
DIV. OF THE STATE ARCHITECT  
APP. 02-118017 INC:  
REVIEWED FOR  
SS ☒ FLS ☒ ACS ☒  
DATE: 04/10/2020

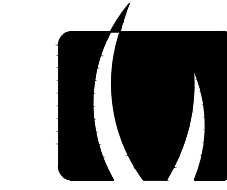


**VERDE DESIGN**  
LANDSCAPE ARCHITECTURE  
CIVIL ENGINEERING  
SPORT PLANNING & DESIGN

1843 Iron Point Rd #140  
Folsom, CA 95630  
tel: 916.415.6554  
fax: 408.985.7260  
[www.VerdeDesignInc.com](http://www.VerdeDesignInc.com)

|       |
|-------|
| STAMP |
|-------|



CONSULTANT

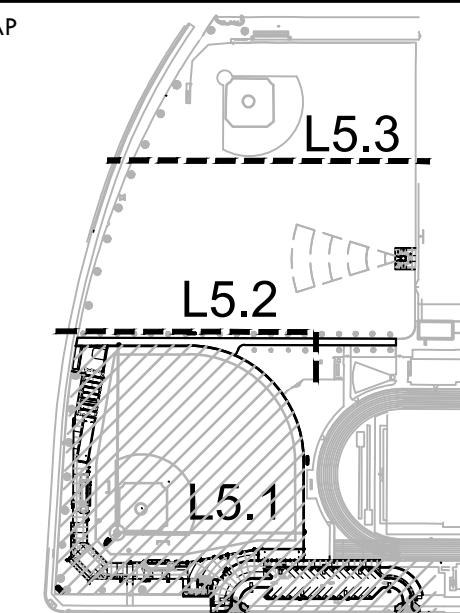

SHEET 1

## GRADING PLAN - BASEBALL FIELD

PROJECT NAME

CHAVEZ HIGH SCHOOL  
STOCKTON USD  
ATHLETIC FACILITY  
IMPROVEMENTS

PROJECT ADDRESS

2929 WINDFLOWER LN  
STOCKTON, CA 95212

| SUBMITTAL               | DATE     |
|-------------------------|----------|
| DD/50% SUBMITTAL        | 10/25/19 |
| DSA SUBMITTAL           | 12/20/19 |
| DSA BACKCHECK SUBMITTAL | 03/27/20 |

[illegible]

|          |  |            |  |
|----------|--|------------|--|
| DRAWN BY |  | CHECKED BY |  |
| QH       |  | CS         |  |

|                         |                      |
|-------------------------|----------------------|
| DATE ISSUED<br>03/27/20 | SCALE<br>1" = 20'-0" |
| PROJ. NO.               |                      |

1910900-1211


SHEET NO.

15.1

05.100

OF 122

GRADING PLAN - BASEBALL FIELD

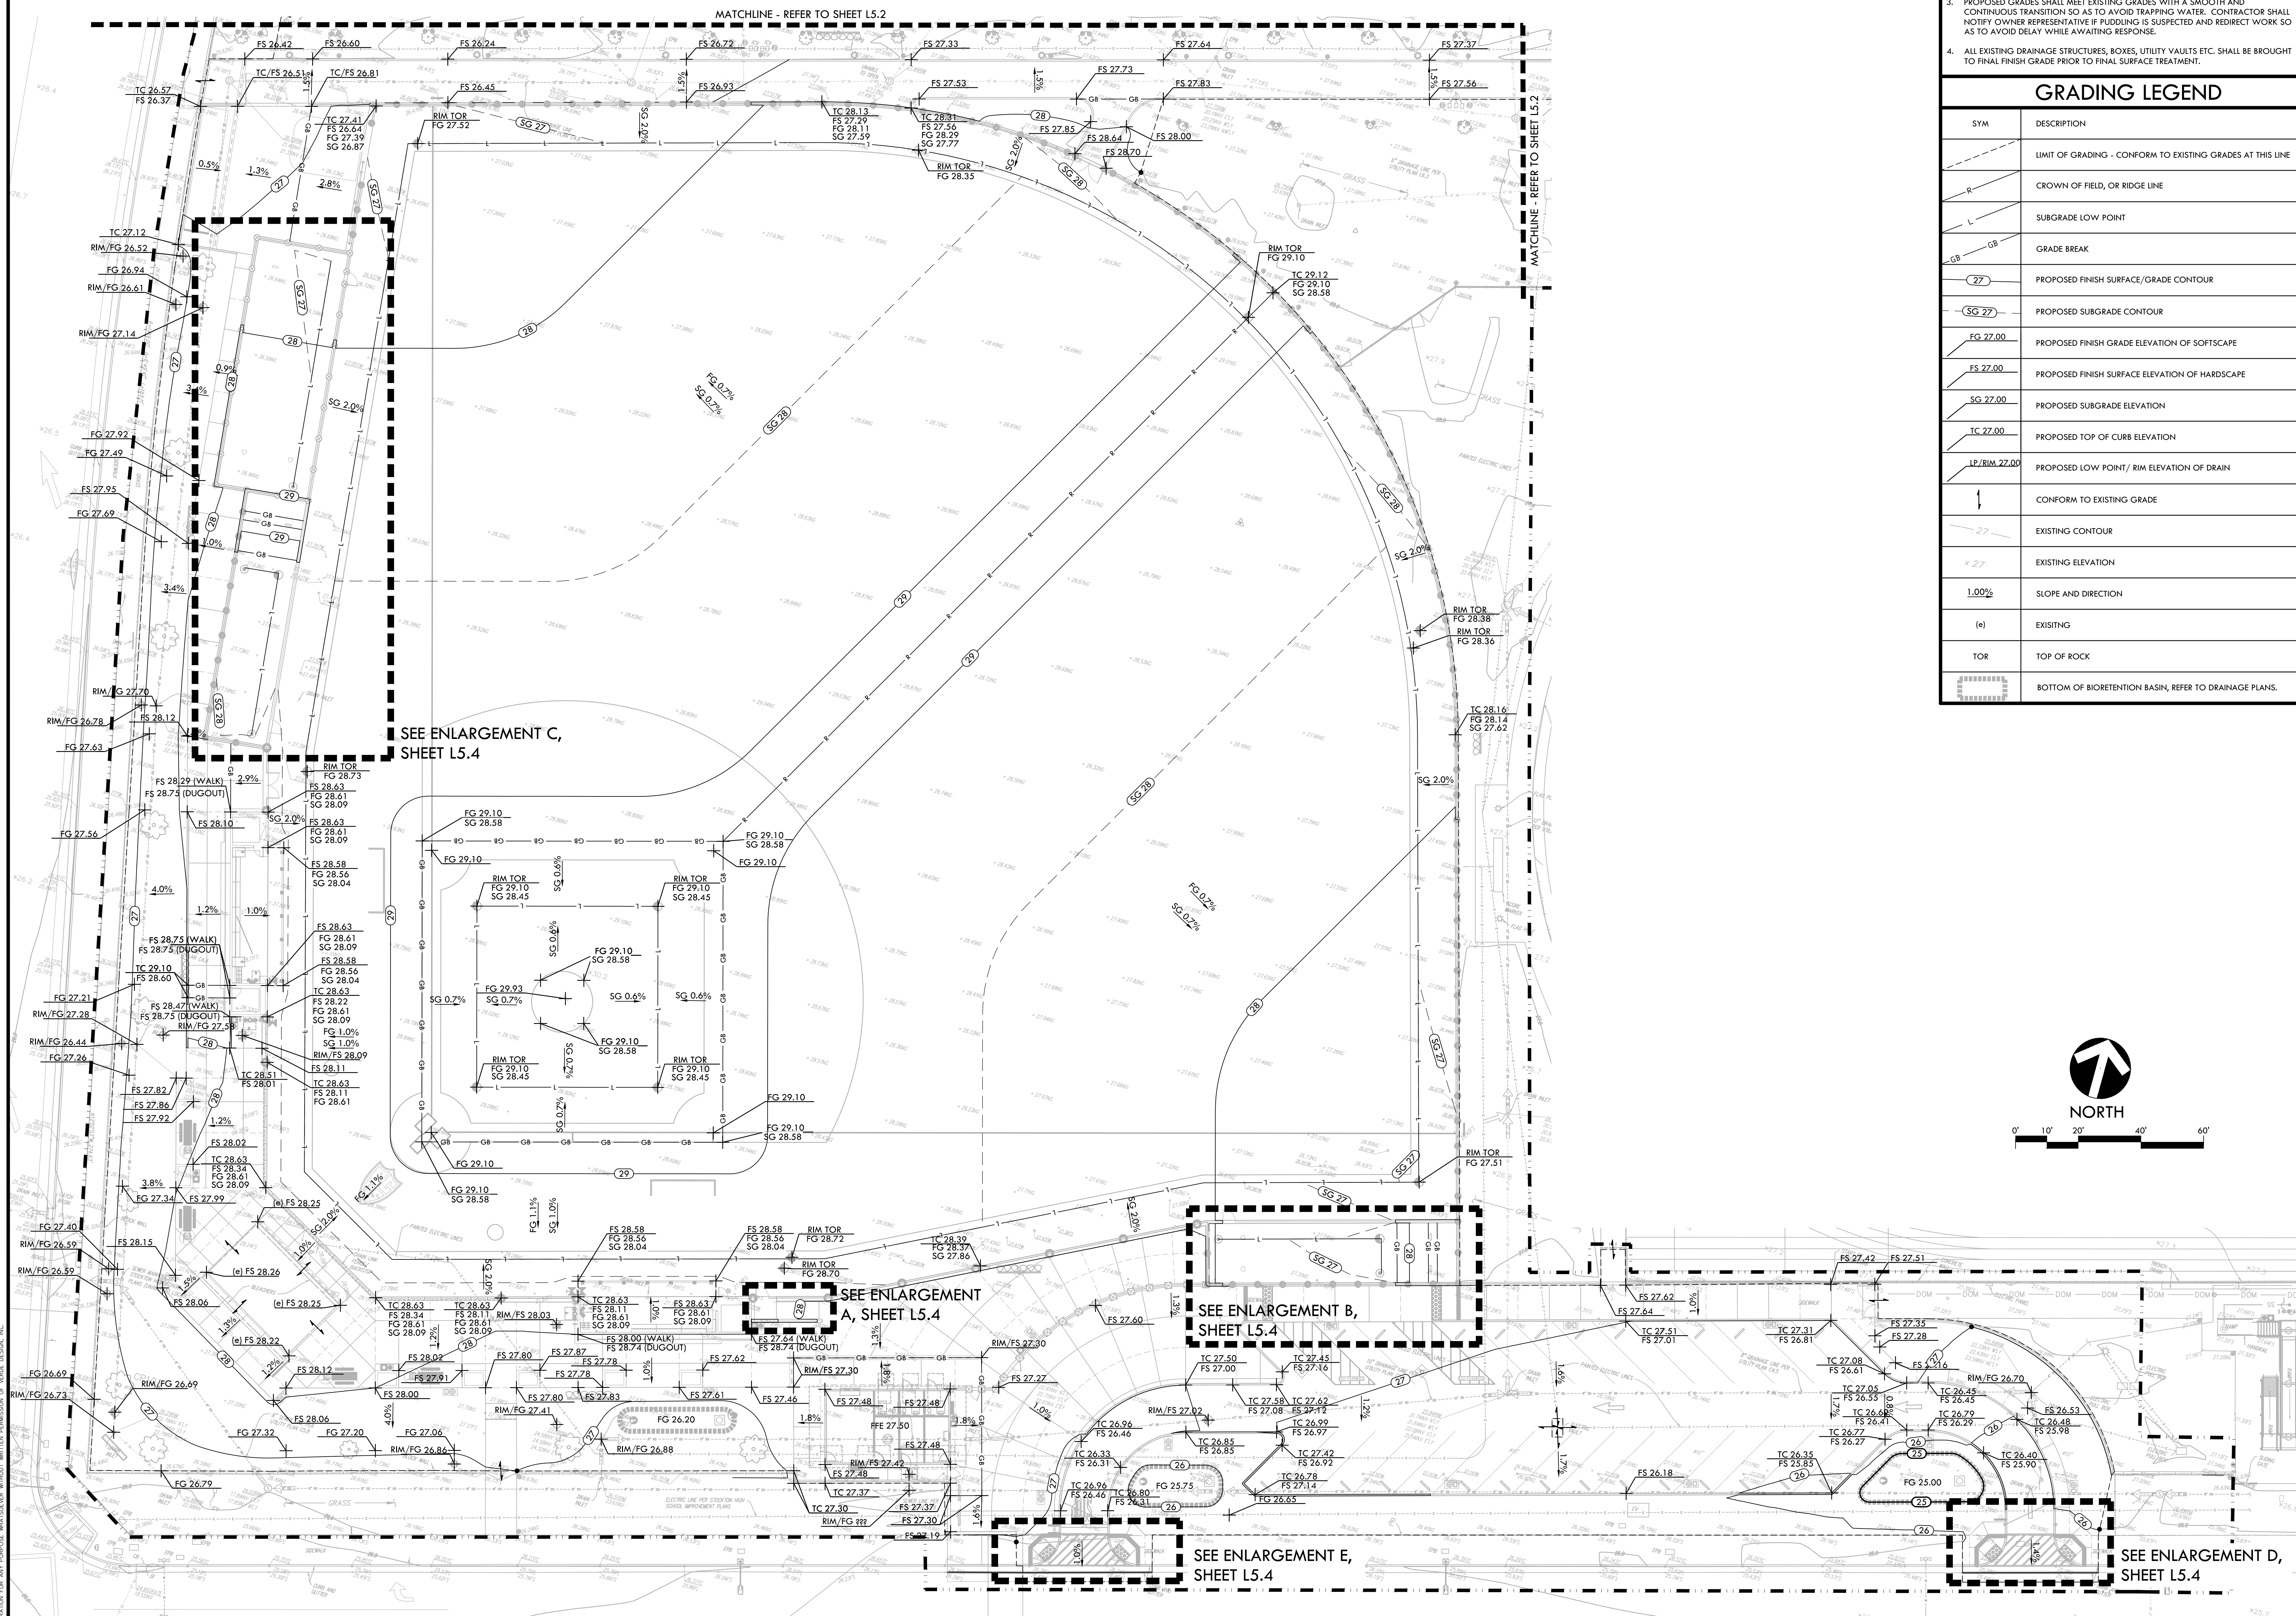

DRAWING NAME: Y:\Projects-FO\2019\1910900 - Chavez Restart\CAD\\_GRD- Athletics-C3D.dwg  
PLOT DATE: 04-02-20 PLOTTED BY: station3

PLOT DATE: 04-02-20 PLOTTED BY: static3







ALL DESIGN, CONSTRUCTION, AND CONSTRUCTION OF THIS PROJECT ARE OWNED BY AND IN CONNECTION WITH THE PROPERTY OF VERDE DESIGN, INC. AND WERE CREATED, DEVELOPED, AND DISCLOSED TO ANY PERSON, FIRM, OR CORPORATION FOR ANY PURPOSE AND SHALL BE KEPT IN CONFIDENCE WITHOUT LIMITATION OF TIME OR TERRITORY. NO PART OF THIS PROJECT SHALL BE REPRODUCED, COPIED, OR DISCLOSED TO ANY PERSON, FIRM, OR CORPORATION WITHOUT THE WRITTEN PERMISSION OF VERDE DESIGN, INC.

| CUT & FILL VOLUME CALC'S* |                     |                             |
|---------------------------|---------------------|-----------------------------|
| *FOR REFERENCE ONLY       |                     |                             |
| CUT VOLUME                | FILL VOLUME         | NET VOLUME                  |
| 3,610 YD <sup>3</sup>     | 912 YD <sup>3</sup> | 2,698 YD <sup>3</sup> (CUT) |

- GRADING NOTES
1. EXISTING GRADES ARE BASED ON INFORMATION PROVIDED BY: ANDREGG GEOMATICS. CONTRACTOR SHALL VERIFY EXISTING GRADES FOR ACCURACY PRIOR TO THE START OF GRADING. NOTIFY THE OWNER'S REPRESENTATIVE IMMEDIATELY SHOULD CONFLICTS ARISE AND REDIRECT WORK TO AVOID DELAY.

2. THE CONTRACTOR SHALL VERIFY THE LOCATIONS OF ALL EXISTING UTILITIES, STRUCTURES AND SERVICES BEFORE COMMENCING WORK. THE LOCATIONS OF UTILITIES, STRUCTURES AND SERVICES SHOWN IN THE CONTRACT DOCUMENTS SHALL BE DEEMED TO BE APPROXIMATIONS ONLY. ALL DISCREPANCIES BETWEEN WHAT IS SHOWN AND THE ACTUAL FIELD CONDITIONS SHALL BE REPORTED TO THE OWNER'S REPRESENTATIVE. THE CONTRACTOR SHALL CONTACT UNDER GROUND SERVICE ALERT (UGSA) AT (800) 227-2600 PRIOR TO ANY DEMOLITION OR EXCAVATION. UPON COMPLETION OF UGA MARKING OPERATIONS, CONTRACTOR SHALL RECORD ALL UTILITY MARKINGS ON A SEPARATE SET OF DRAWINGS. THIS SET SHALL BE KEPT ON-SITE FOR REFERENCE FOR DURATION OF CONTRACT.

3. PROPOSED GRADES SHALL MEET EXISTING GRADES WITH A SMOOTH AND CONTINUOUS TRANSITION SO AS TO AVOID TRAPPING WATER. CONTRACTOR SHALL NOTIFY OWNER REPRESENTATIVE IF PUDDING IS SUSPECTED AND REDIRECT WORK SO AS TO AVOID DELAY WHILE AWAITING RESPONSE.

4. ALL EXISTING DRAINAGE STRUCTURES, BOXES, UTILITY VAULTS ETC. SHALL BE BROUGHT TO FINAL FINISH GRADE PRIOR TO FINAL SURFACE TREATMENT.

| GRADING LEGEND |  |
|----------------|--|
| SYM            | DESCRIPTION  |
|                | LIMIT OF GRADING - CONFORM TO EXISTING GRADES AT THIS LINE |
|                | CROWN OF FIELD, OR RIDGE LINE                              |
|                | SUBGRADE LOW POINT   |
|                | GRADE BREAK  |
|                | PROPOSED FINISH SURFACE/GRADE CONTOUR                      |
|                | PROPOSED SUBGRADE CONTOUR                                  |
|                | PROPOSED FINISH GRADE ELEVATION OF SOFTSCAPE               |
|                | PROPOSED FINISH SURFACE ELEVATION OF HARDSCAPE             |
|                | PROPOSED SUBGRADE ELEVATION                                |
|                | PROPOSED TOP OF CURB ELEVATION                             |
|                | PROPOSED LOW POINT/ RIM ELEVATION OF DRAIN                 |
|                | CONFORM TO EXISTING GRADE                                  |
|                | EXISTING CONTOUR   |
|                | EXISTING ELEVATION   |
|                | SLOPE AND DIRECTION  |
|                | EXISTING   |
|                | TOP OF ROCK  |
|                | BOTTOM OF BIORETENTION BASIN, REFER TO DRAINAGE PLANS.     |

IDENTIFICATION STAMP  
DIV. OF THE STATE ARCHITECT  
APP. 02-118017 INC.  
REVIEWED FOR  
SS ☒ FLS ☒ ACS ☒  
DATE: 04/10/2020

VERDE DESIGN  
LANDSCAPE ARCHITECTURE  
CIVIL ENGINEERING  
SPORT PLANNING & DESIGN  
1843 Iron Point Rd #140  
Folsom, CA 95630  
tel: 916.415.6554  
fax: 408.985.7260  
www.VerdeDesignInc.com

STAMP

CONSULTANT

KEYMAP

SHEET TITLE  
GRADING PLAN -  
MULTI-USE NORTH

PROJECT NAME  
CHAVEZ HIGH SCHOOL  
STOCKTON USD  
ATHLETIC FACILITY  
IMPROVEMENTS

PROJECT ADDRESS  
2929 WINDFLOWER LN  
STOCKTON, CA 95212

| SUBMITTAL               | DATE     |
|-------------------------|----------|
| DD/50% SUBMITTAL        | 10/25/19 |
| DSA SUBMITTAL           | 12/20/19 |
| DSA BACKCHECK SUBMITTAL | 03/27/20 |

| NO. | REVISIONS | DATE |
|-----|-----------|------|
|     |           |      |
|     |           |      |
DRAWN BY  
QH

CHECKED BY  
CS

DATE ISSUED  
03/27/20

SCALE  
1" = 20'-0"

PROJ. NO.  
1910900-1211

SHEET NO.  
L5.3

OF 122

DRAWING NAME: Y:\Projects\FD\2019\1910900 - Chavez Restor\CAD\GRD - Athletics-C3D.dwg  
PLOT DATE: 04-02-20 PLOTTED BY: station3





















| CUT & FILL VOLUME CALC'S* |                     |                             |
|---------------------------|---------------------|-----------------------------|
| *FOR REFERENCE ONLY       |                     |                             |
| CUT VOLUME                | FILL VOLUME         | NET VOLUME                  |
| 3,610 YD <sup>3</sup>     | 912 YD <sup>3</sup> | 2,698 YD <sup>3</sup> [CUT] |


## GRADING NOTES

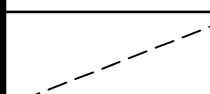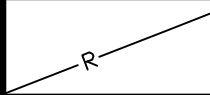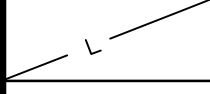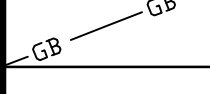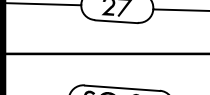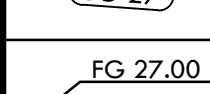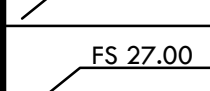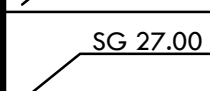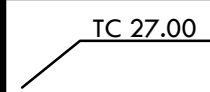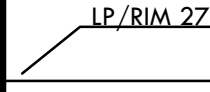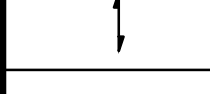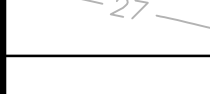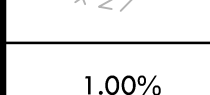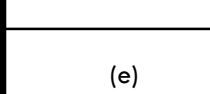1. EXISTING GRADES ARE BASED ON INFORMATION PROVIDED BY: ANDREWS GEOMATICS. CONTRACTOR SHALL VERIFY EXISTING GRADES FOR ACCURACY PRIOR TO THE START OF GRADING, NOTIFY THE OWNER'S REPRESENTATIVE IMMEDIATELY SHOULD CONFLICTS ARISE AND REDIRECT WORK TO AVOID DELAY.
2. THE CONTRACTOR SHALL VERIFY THE LOCATIONS OF ALL EXISTING UTILITIES, MANHOLES AND SET POINTS FOR ALL EXISTING WORK. THE LOCATIONS OF UTILITIES, STRUCTURES AND SERVICES SHOWN IN THE CONTRACT DOCUMENTS SHALL BE DEEMED TO BE APPROXIMATIONS ONLY. ALL DISCREPANCIES BETWEEN WHAT IS SHOWN ON THE ACQUISITION AND THE CONTRACT DOCUMENTS SHALL BE THE OWNER'S REPRESENTATIVE. THE CONTRACTOR SHALL CONTACT UNDER GROUND SERVICE ALERT (USA) AT (800) 227-2600 PRIOR TO ANY DEMOLITION OR EXCAVATION. UPON RECEIPT OF USE OF UTILITY INFORMATION, CONTRACTOR SHALL RECORD ALL UTILITY MARKINGS ON A SEPARATE SET OF DRAWINGS. THIS SET SHALL BE KEPT ON-SITE FOR REFERENCE FOR DURATION OF CONTRACT.
3. PROPOSED GRADES SHALL MEET EXISTING GRADES WITH A SMOOTH AND CONTINUOUS TRANSITION SO AS TO AVOID TRIPPING WATER. CONTRACTOR SHALL NOTIFY THE OWNER REPRESENTATIVE IMMEDIATELY SHOULD CONFLICTS ARISE AS TO AVOID DELAY WHILE AWAITING RESPONSE.
4. ALL EXISTING DRAINAGE STRUCTURES, BOXES, UTILITIES VAULTS ETC. SHALL BE BROUGHT TO FINAL FINISH GRADE PRIOR TO FINAL SURFACE TREATMENT.

## GRADING LEGEND

| SYM   | DESCRIPTION  |
|---|--|
|    | LIMIT OF GRADING - CONFORM TO EXISTING GRADES AT THIS LINE |
|    | CROWN OF FIELD, OR RIDGE LINE                              |
|    | SUBGRADE LOW POINT   |
|    | GRADE BREAK  |
|    | PROPOSED FINISH SURFACE/GRADE CONTOUR                      |
|    | PROPOSED SUBGRADE CONTOUR                                  |
|    | PROPOSED FINISH GRADE ELEVATION OF SOFTSCAPE               |
|    | PROPOSED FINISH SURFACE ELEVATION OF HARDSCAPE             |
|    | PROPOSED SUBGRADE ELEVATION                                |
|    | PROPOSED TOP OF CURB ELEVATION                             |
|    | PROPOSED LOW POINT/ RIM ELEVATION OF DRAIN                 |
|    | CONFORM TO EXISTING GRADE                                  |
|    | EXISTING CONTOUR   |
|    | EXISTING ELEVATION   |
|    | SLOPE AND DIRECTION  |
|   | EXISTING   |
|  | TOP OF ROCK  |
|  | BOTTOM OF BIORETENTION BASIN, REFER TO DRAINAGE PLANS.     |

IDENTIFICATION STAMP  
DIV. OF THE STATE ARCHITECT  
APP. 02-118017 INC.  
REVIEWED FOR  
SS ☒ FLS ☒ ACS ☒  
DATE: 04/10/2020

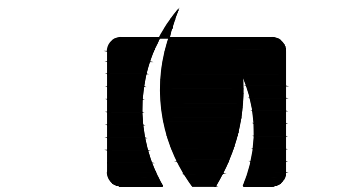

**VERDE DESIGN**  
LANDSCAPE ARCHITECTURE  
CIVIL ENGINEERING  
SPORT PLANNING & DESIGN

---


1843 Iron Point Rd #140  
Folsom, CA 95630  
tel: 916.415.6554  
fax: 408.985.7260  
[www.VerdeDesignInc.com](http://www.VerdeDesignInc.com)

|       |
|-------|
| STAMP |
|-------|



CONSULTANT

KEYMAP

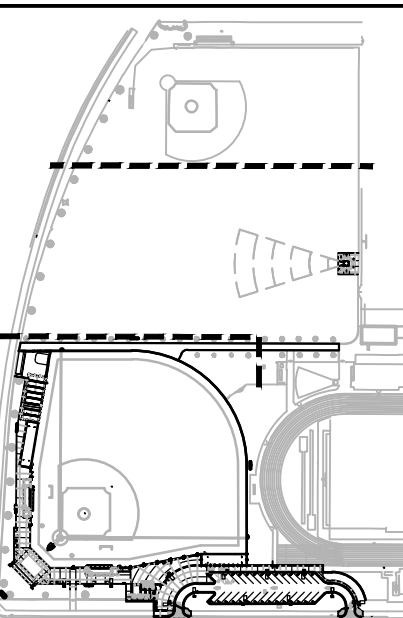

SHEET TITLE

## GRADING PLAN - ENLARGEMENTS

PROJECT NAME

CHAVEZ HIGH SCHOOL  
STOCKTON USD  
ATHLETIC FACILITY  
IMPROVEMENTS

PROJECT ADDRESS

2929 WINDFLOWER LN  
STOCKTON, CA 95212






| SUBMITTAL               | DATE     |
|-------------------------|----------|
| DD/50% SUBMITTAL        | 10/25/19 |
| DSA SUBMITTAL           | 12/20/19 |
| DSA BACKCHECK SUBMITTAL | 03/27/20 |

[illegible]

|                                |                             |
|--------------------------------|-----------------------------|
| DRAWN BY<br><b>QH</b>          | CHECKED BY<br><b>CS</b>     |
| DATE ISSUED<br><b>03/27/20</b> | SCALE<br><b>1" = 20'-0"</b> |
| PROJECT NO.                    |                             |


PROJ. NO. 1910900-1211

SHEET NO. L5.4 OF 122

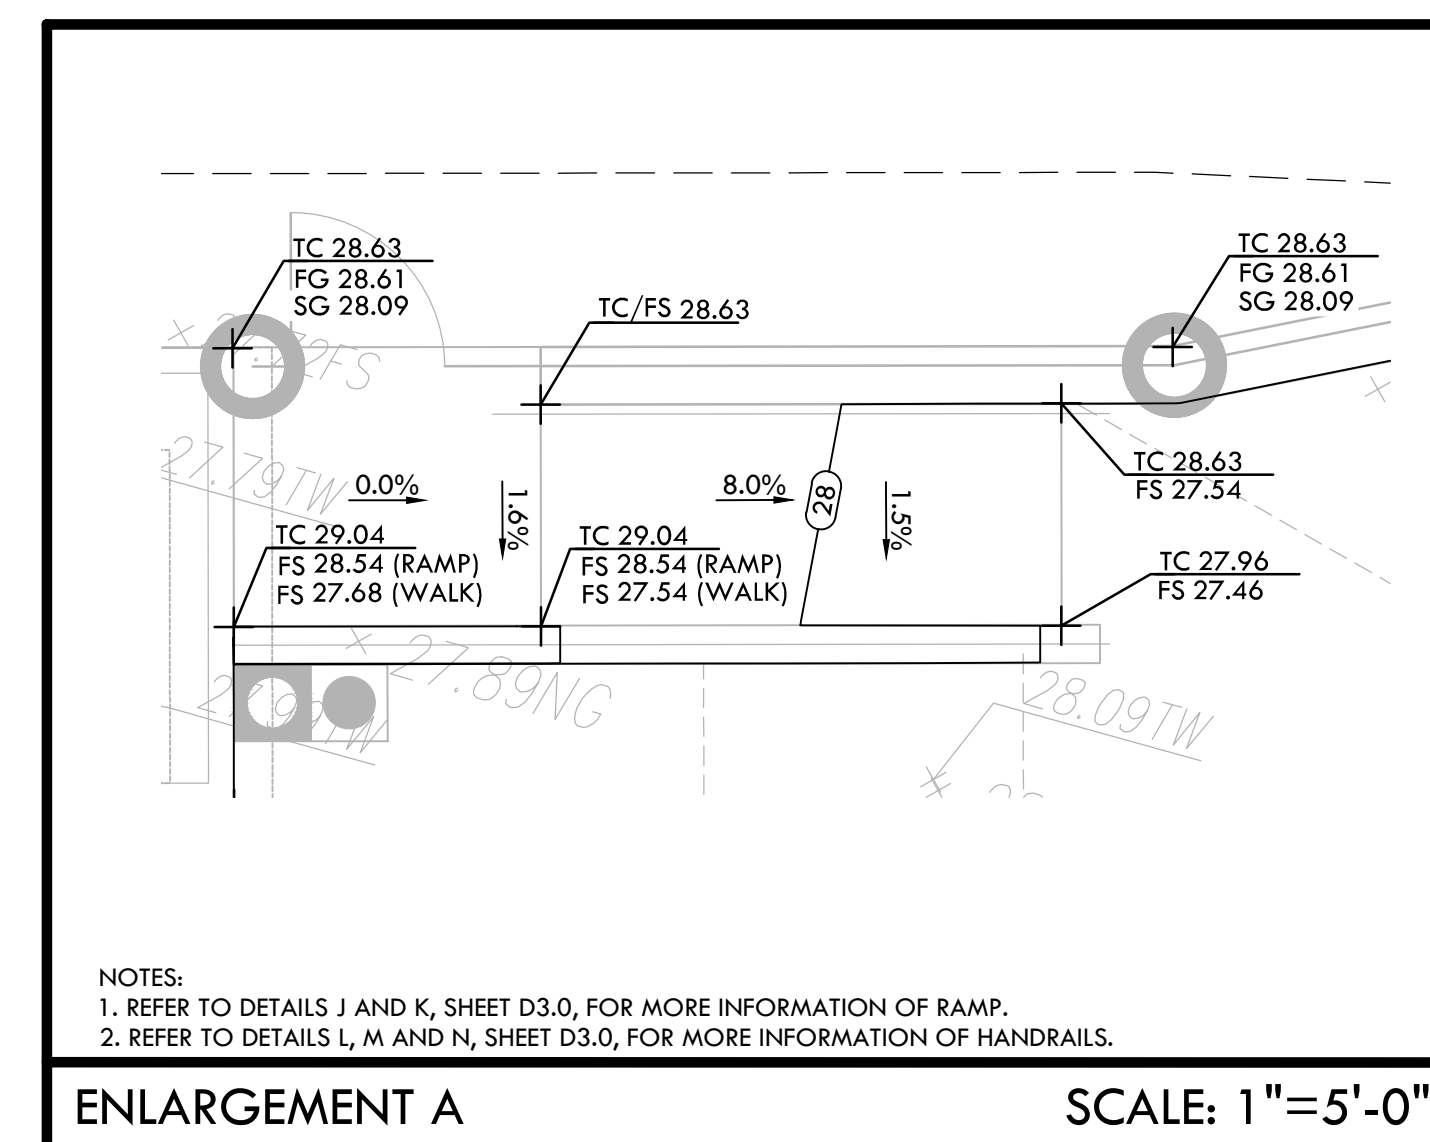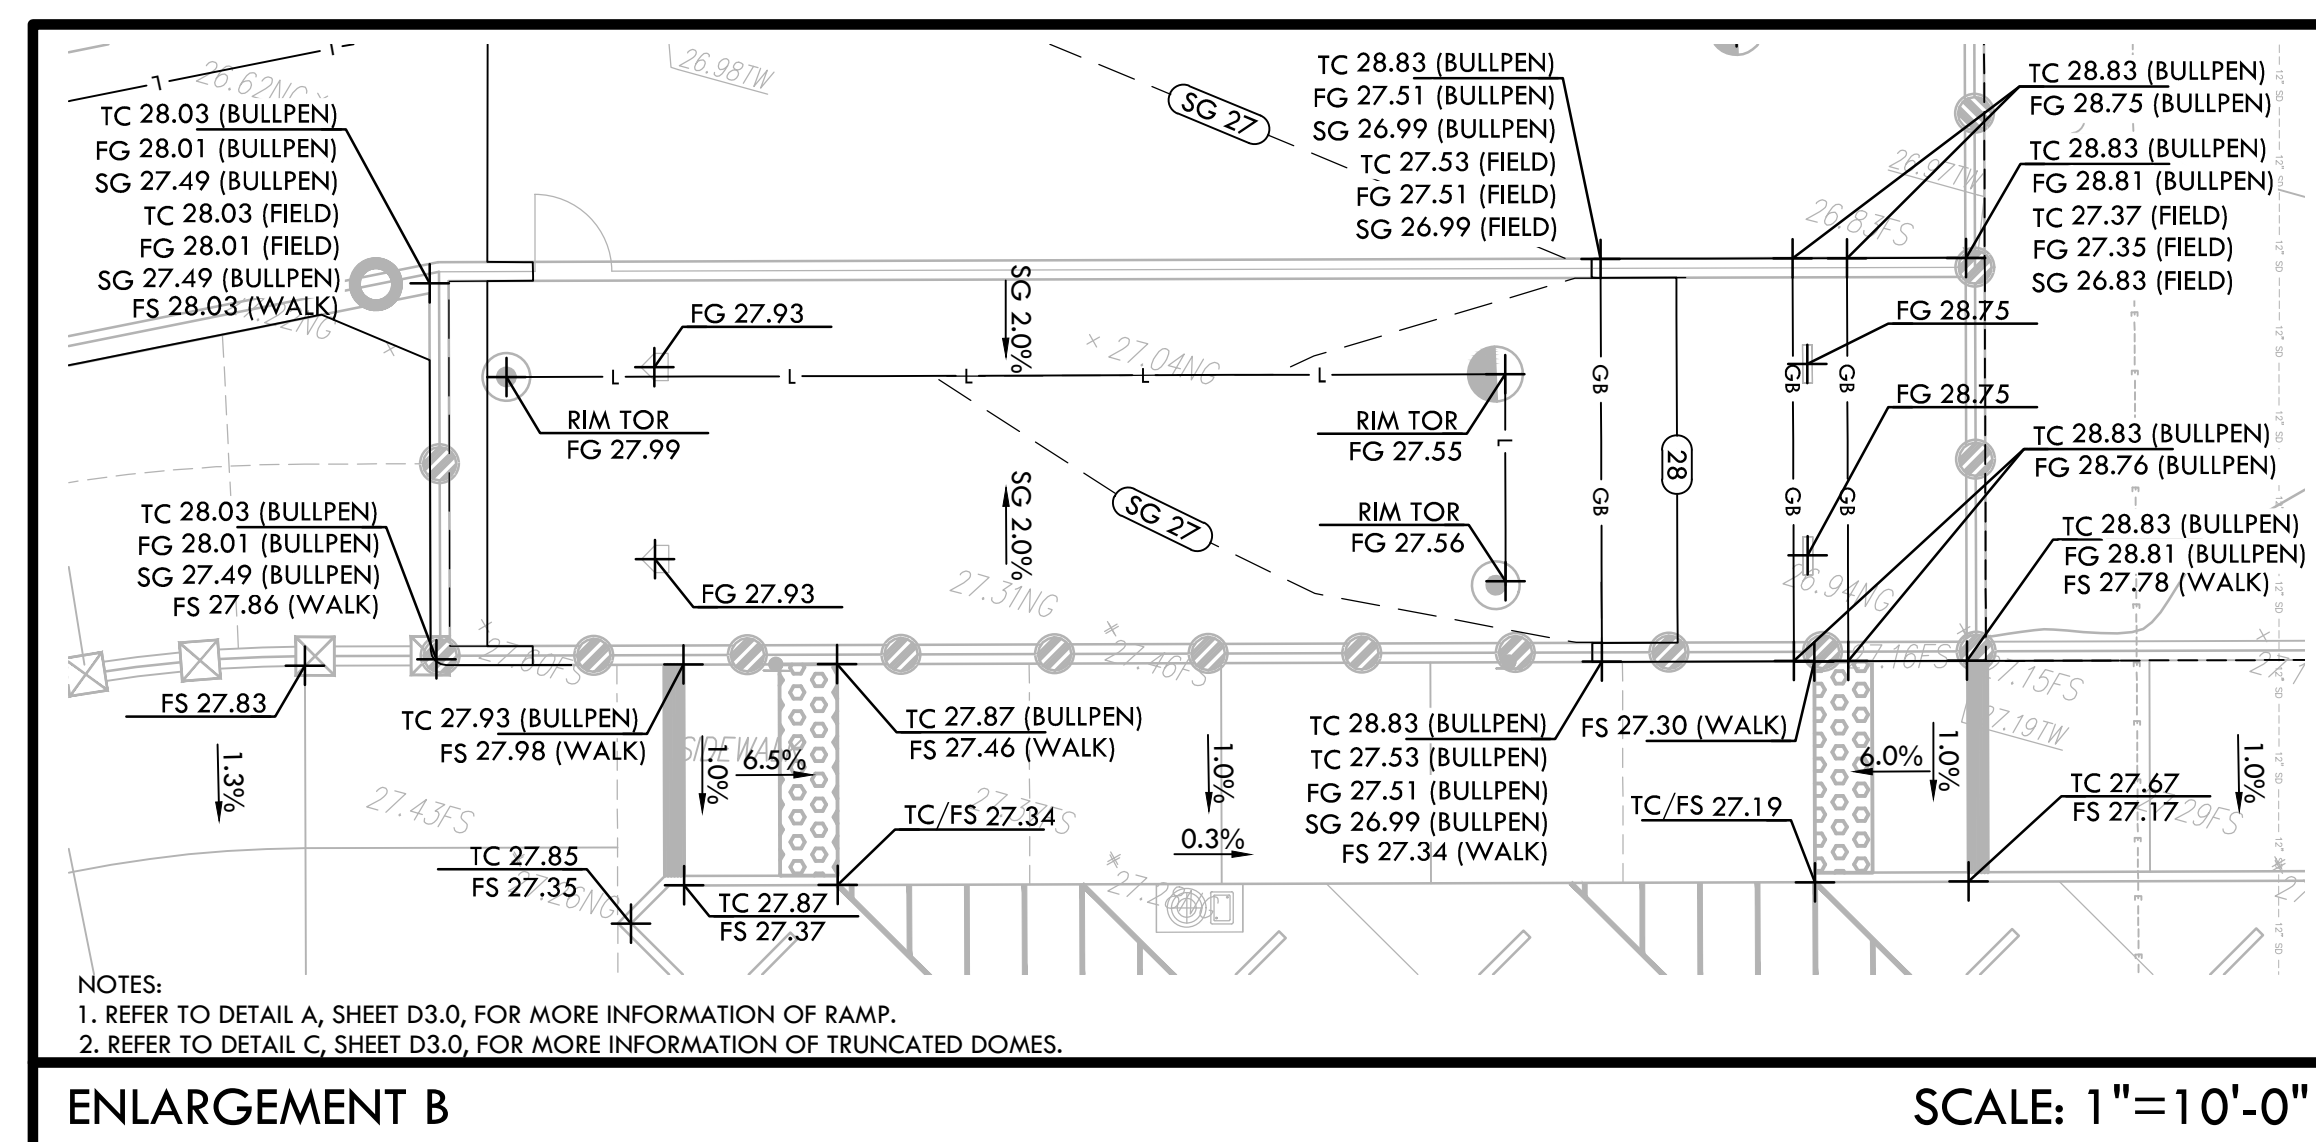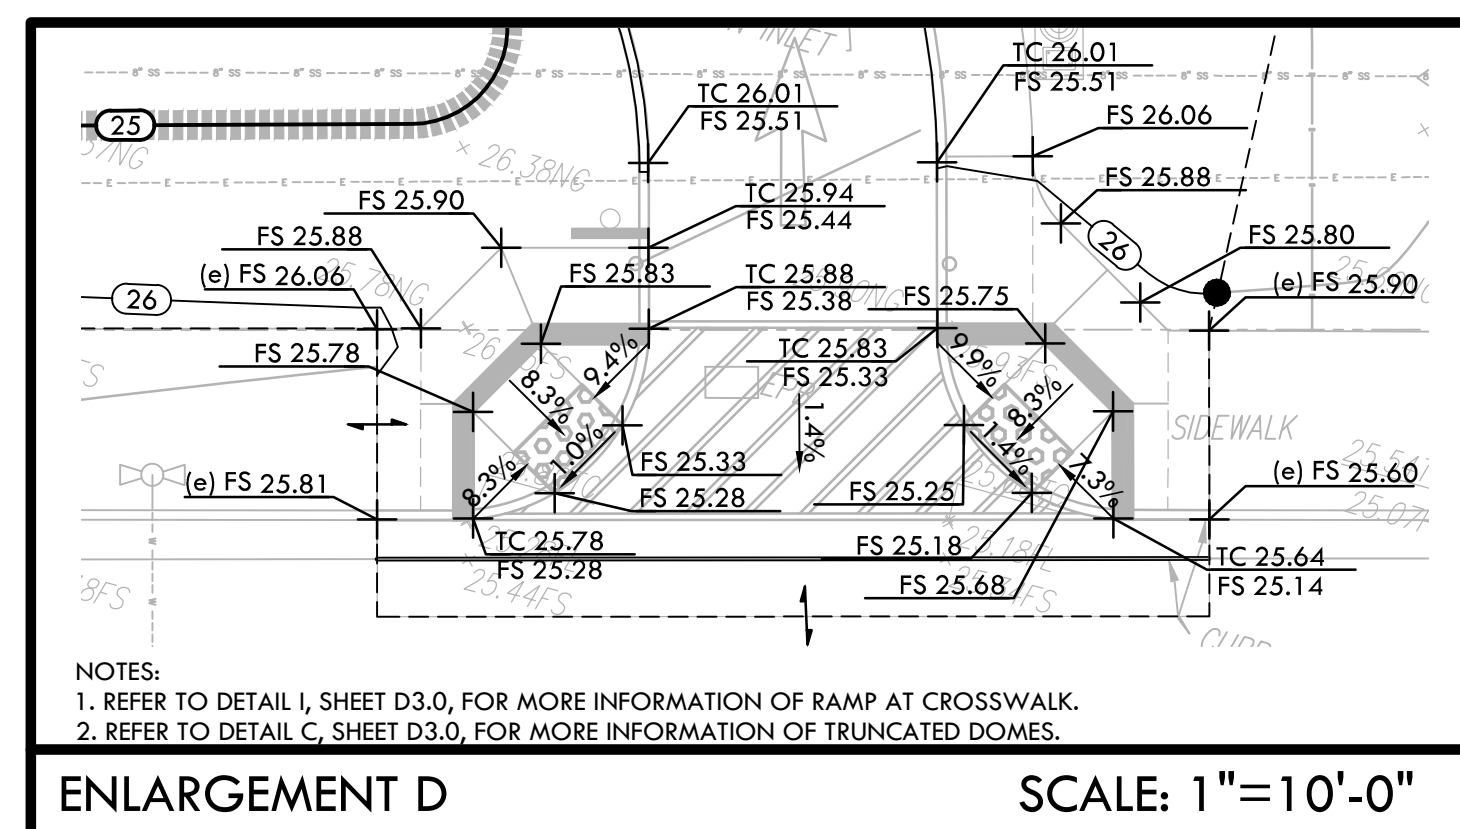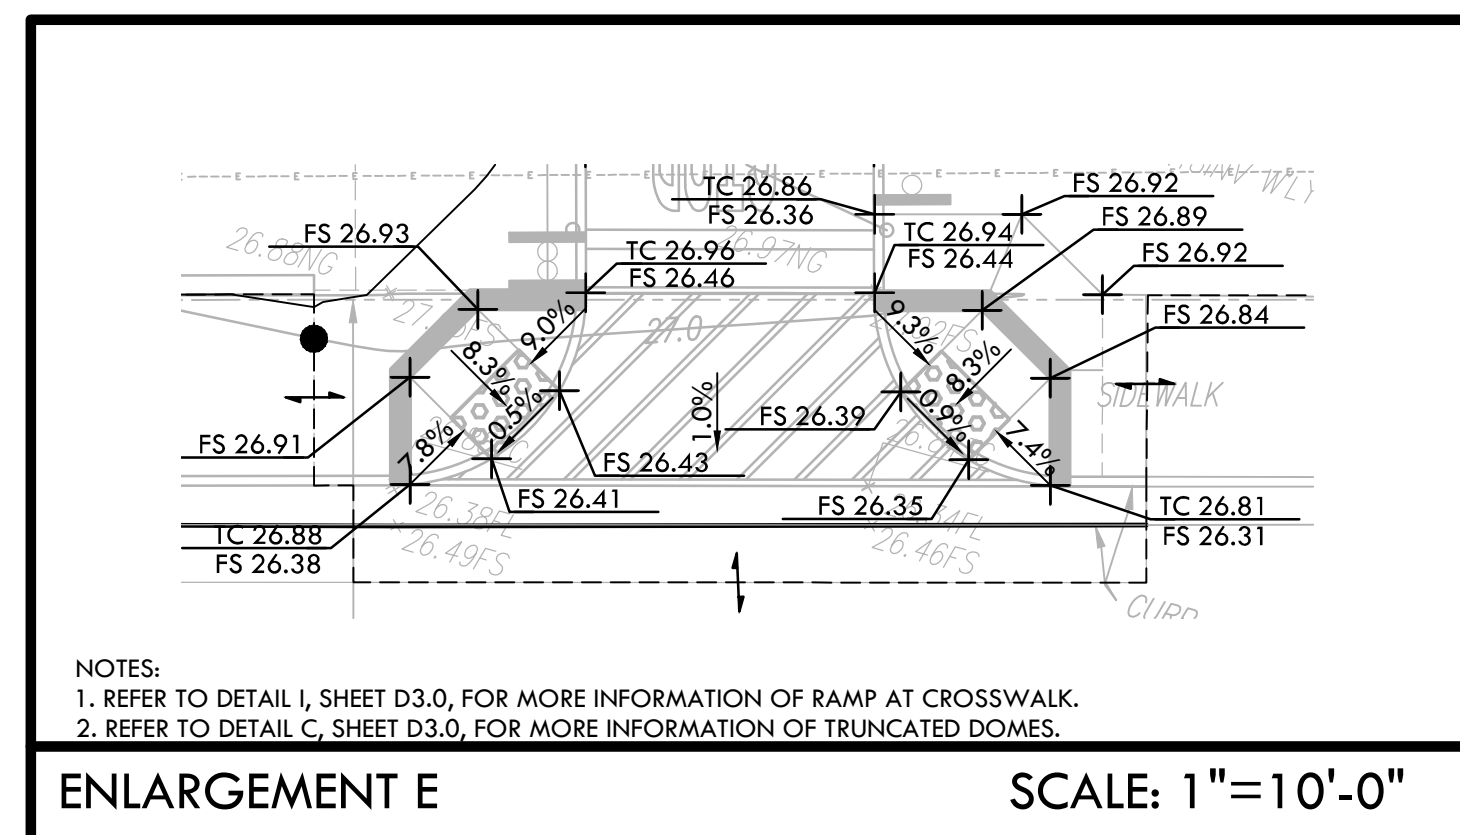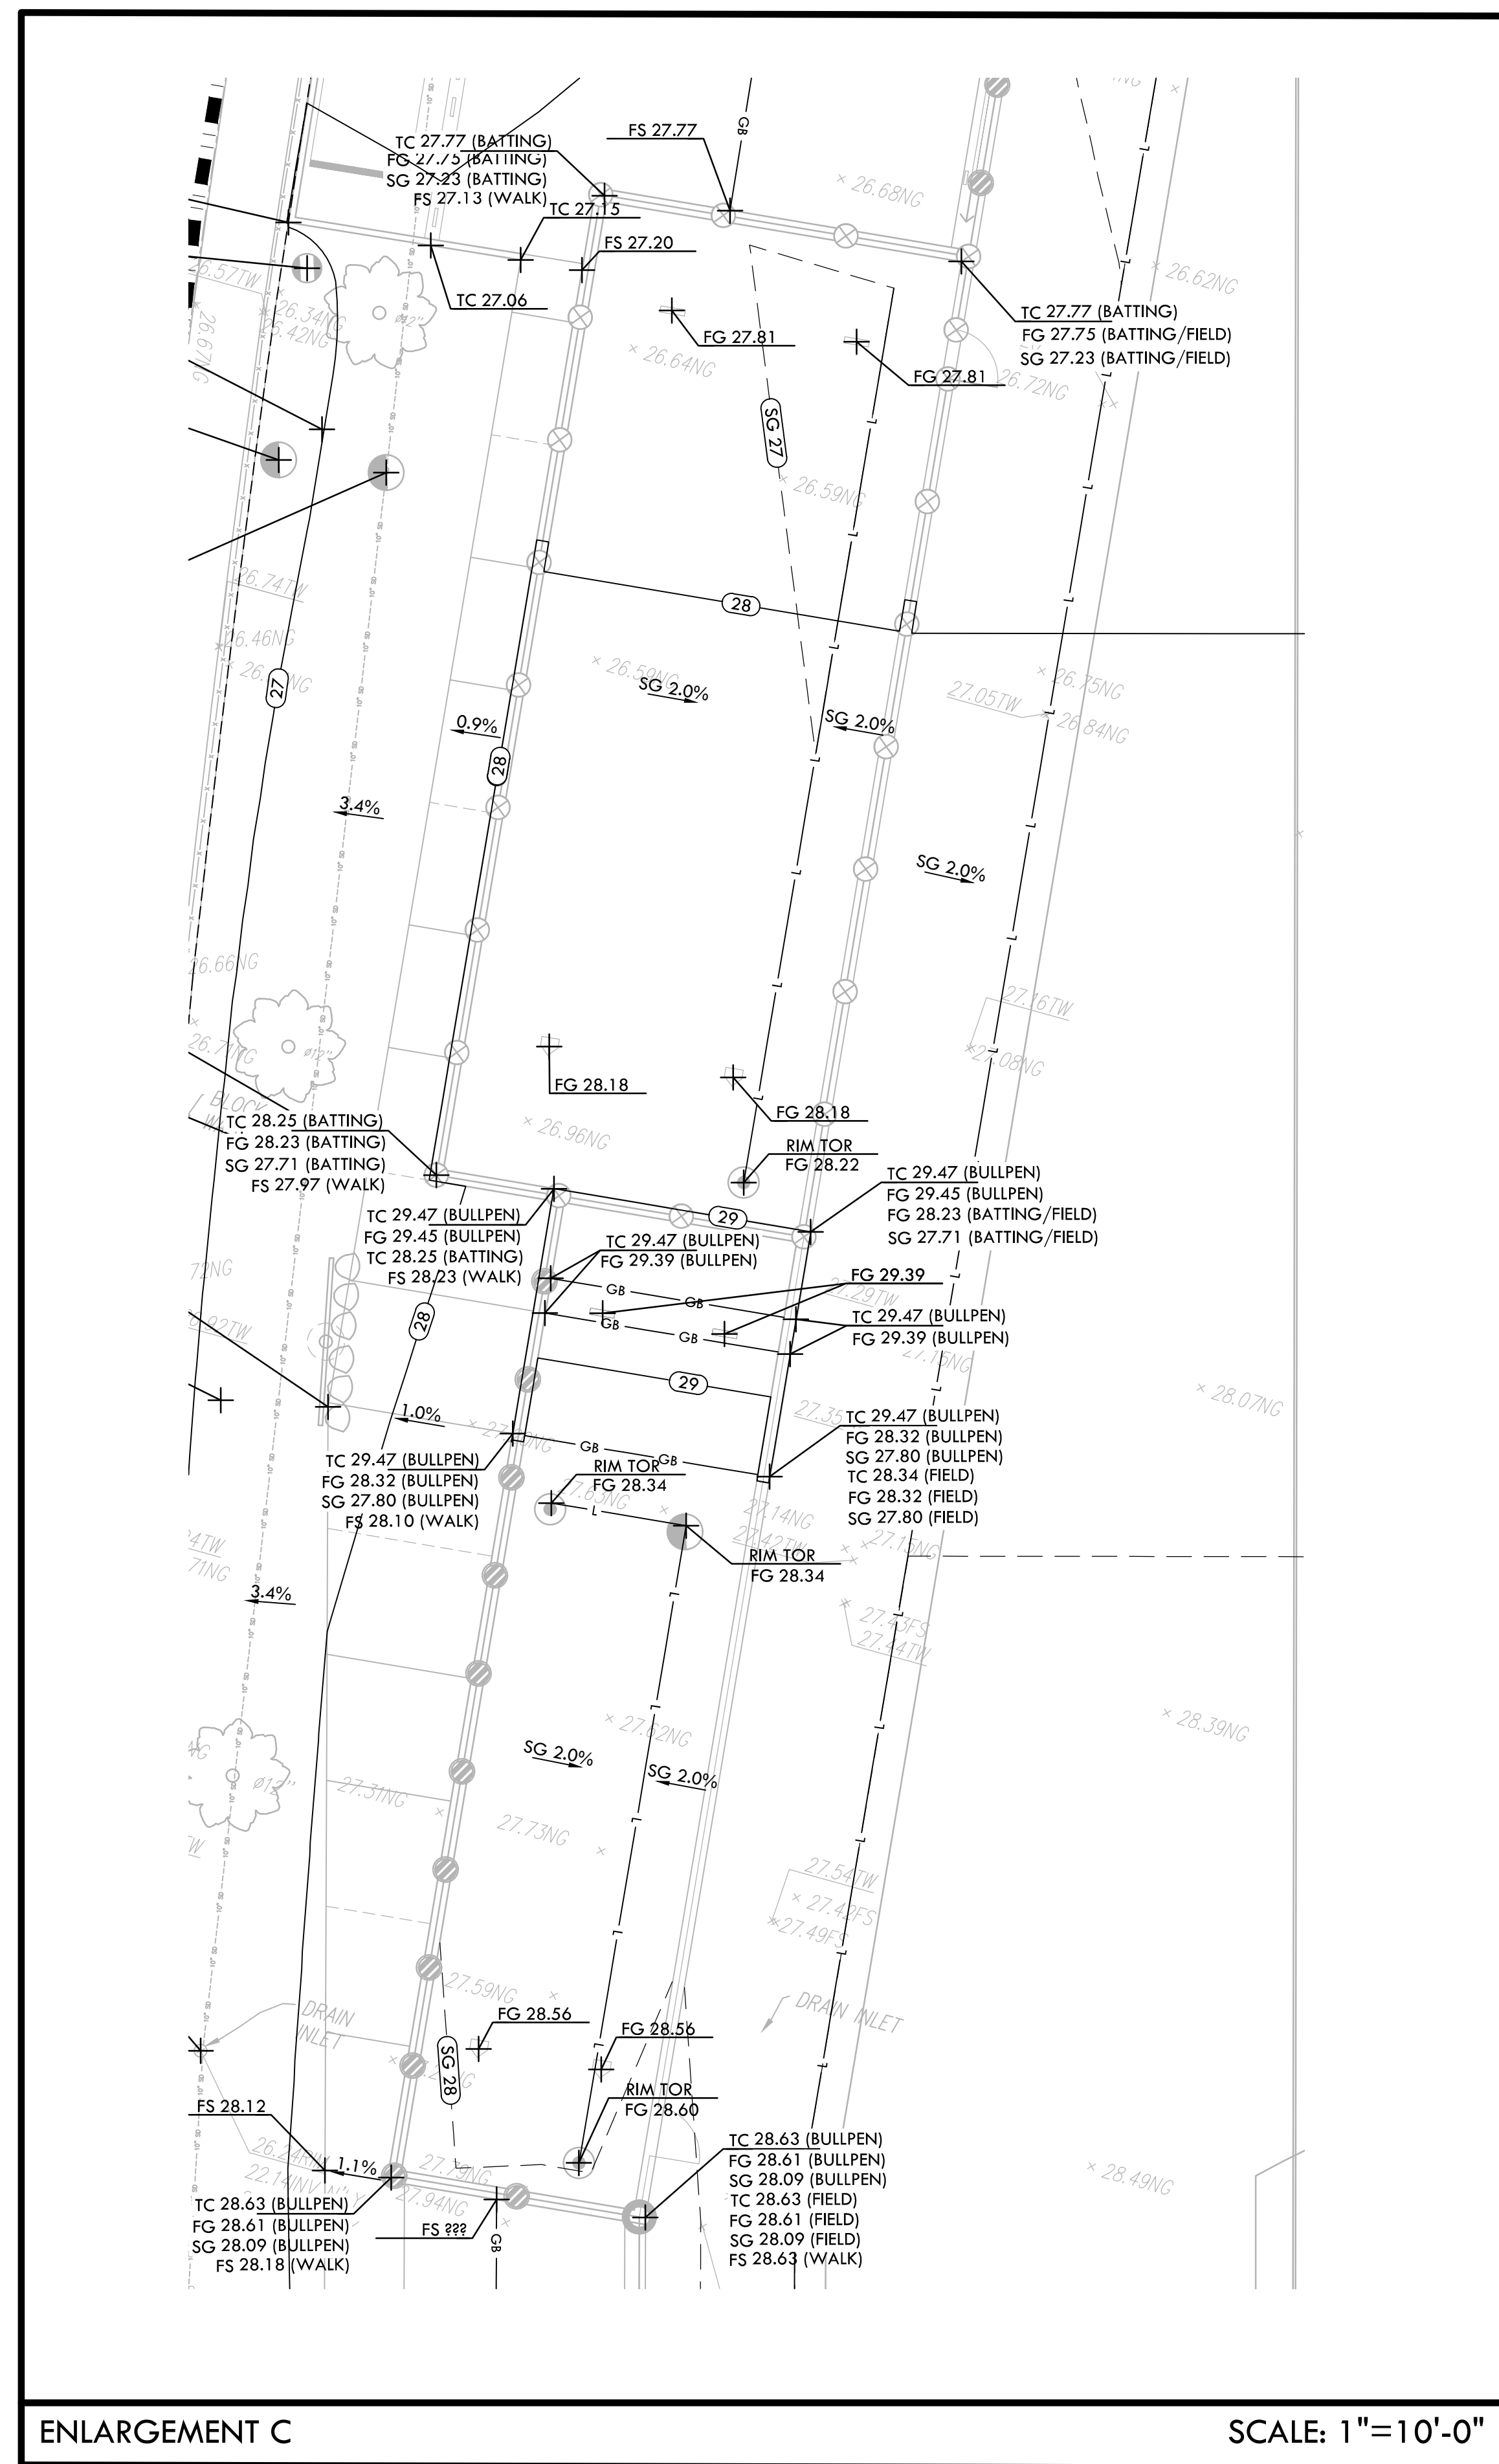




ALL DESIGN CONCEPTS AND ANY PORTION OF REPRESENTATION OF THIS DRAWING ARE OWNED BY AND THE PROPERTY OF VERDE DESIGN, INC. AND WERE CREATED, DEVELOPED, AND DEVELOPED FOR USE ON AND IN CONNECTION WITH THE SPECIFIED PROJECT. NONE OF SUCH IDEAS, DESIGNS, ARRANGEMENTS OR PLANS SHALL BE USED, REPRODUCED, OR PUBLISHED BY ANY METHOD, IN WHOLE OR IN PART, OR DISCLOSED TO ANY PERSON, FIRM, OR CORPORATION FOR ANY PURPOSE WITHOUT THE WRITTEN PERMISSION OF VERDE DESIGN, INC.

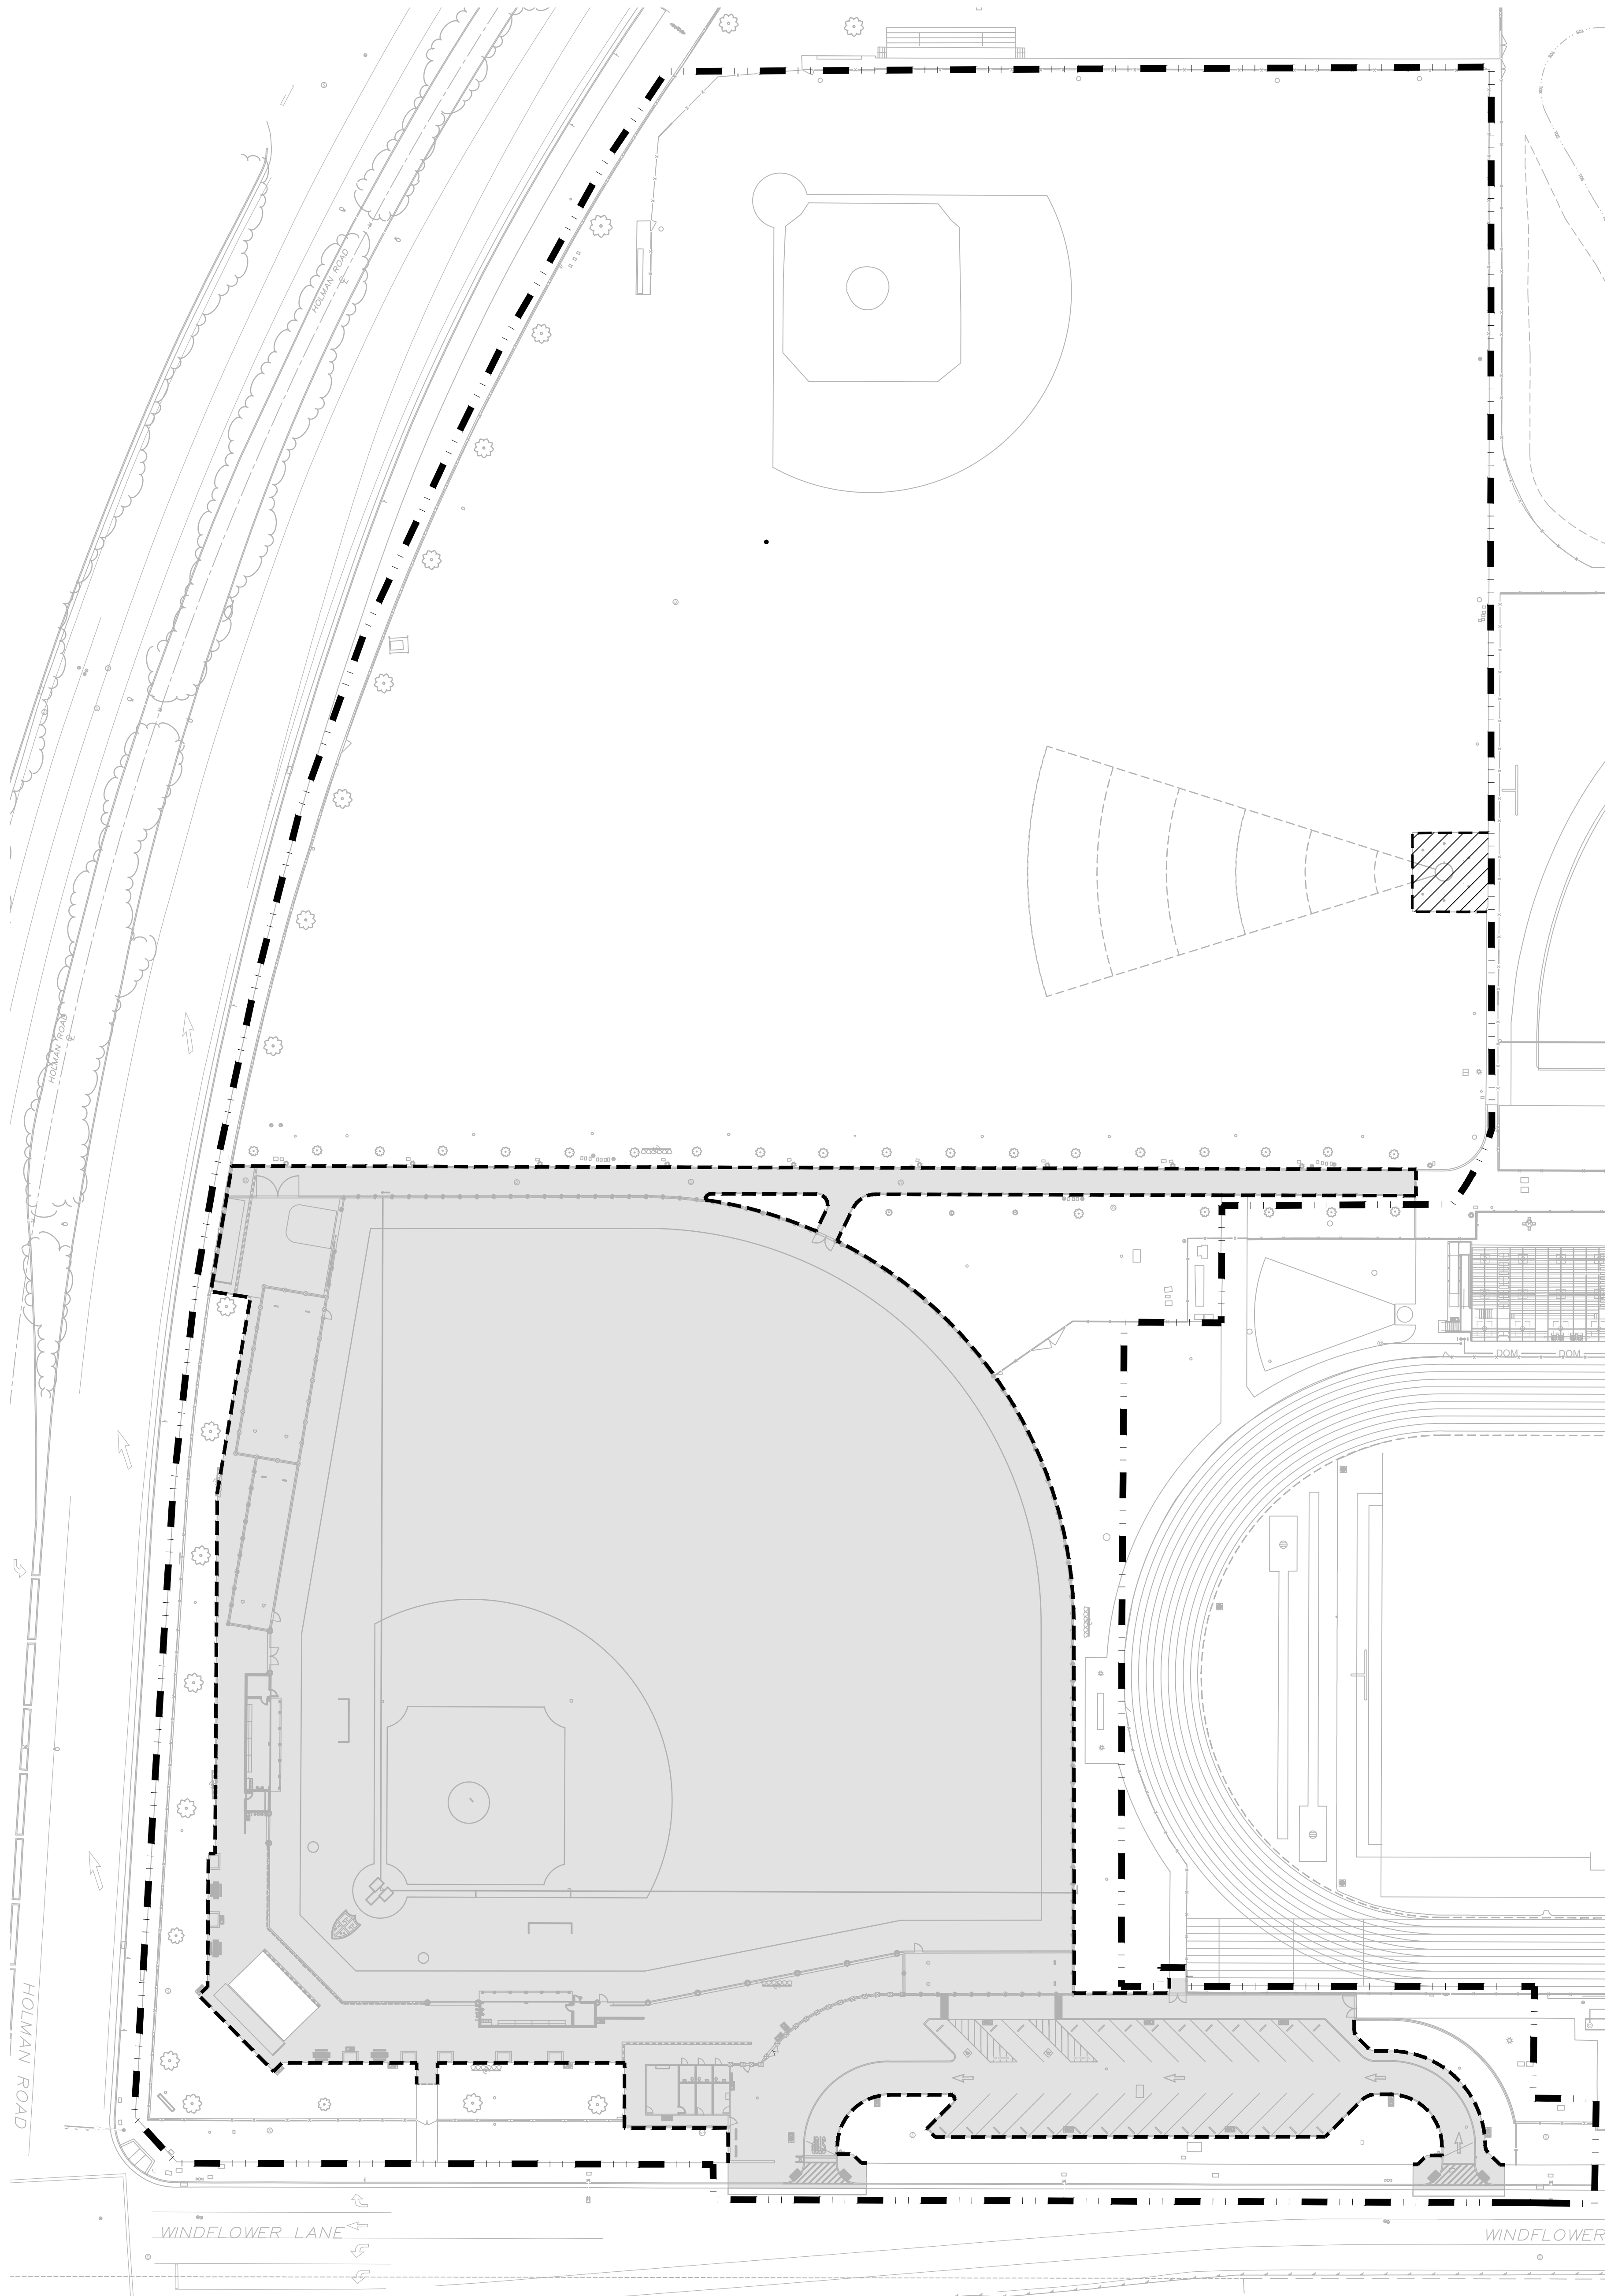

| CHEMICAL TREATMENT LEGEND |   |
|---------------------------|---|
| SYM                       | DESCRIPTION   |
|                           | PROJECT LIMIT OF WORK   |
|                           | LOCATIONS OF DEEP EDGES AT PERIMETER OF CHEMICAL TREATMENT AREAS (REFER TO MATERIALS PLAN AND DETAILS FOR MORE INFORMATION) |
|                           | AREA OF CHEMICAL TREATMENT, REFER TO SPECIFICATIONS REFER TO GEOTECHNICAL REPORT FOR DETAIL                                 |
|                           | AREA OF IMPORTED FILL, REFER TO SPECIFICATIONS  |

IDENTIFICATION STAMP  
DIV. OF THE STATE ARCHITECT  
APP. 02-118017 INC.  
REVIEWED FOR  
SS ☒ FLS ☒ ACS ☒  
DATE: 04/10/2020

  
**VERDE DESIGN**  
LANDSCAPE ARCHITECTURE  
CIVIL ENGINEERING  
SPORT PLANNING & DESIGN  
1843 Iron Point Rd #140  
Folsom, CA 95630  
tel: 916.415.6554  
fax: 408.985.7260  
www.VerdeDesignInc.com

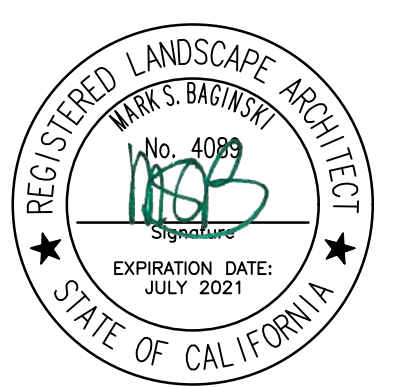STAMP  


CONSULTANT

KEYMAP

SHEET TITLE  
CHEMICAL TREATMENT  
PLAN

PROJECT NAME  
CHAVEZ HIGH SCHOOL  
STOCKTON USD  
ATHLETIC FACILITY  
IMPROVEMENTS


PROJECT ADDRESS  
2929 WINDFLOWER LN  
STOCKTON, CA 95212

| SUBMITTAL               | DATE     |
|-------------------------|----------|
| DD/50% SUBMITTAL        | 10/25/19 |
| DSA SUBMITTAL           | 12/20/19 |
| DSA BACKCHECK SUBMITTAL | 03/27/20 |

| NO. | REVISIONS | DATE |
|-----|-----------|------|
| 1   |           |      |
| 2   |           |      |
| 3   |           |      |
| 4   |           |      |
| 5   |           |      |

|                           |                      |
|---------------------------|----------------------|
| DRAWN BY<br>HM            | CHECKED BY<br>CS     |
| DATE ISSUED<br>03/27/20   | SCALE<br>1" = 40'-0" |
| PROJ. NO.<br>1910900-1211 |                      |
| SHEET NO.<br>L5.5         | OF 122               |



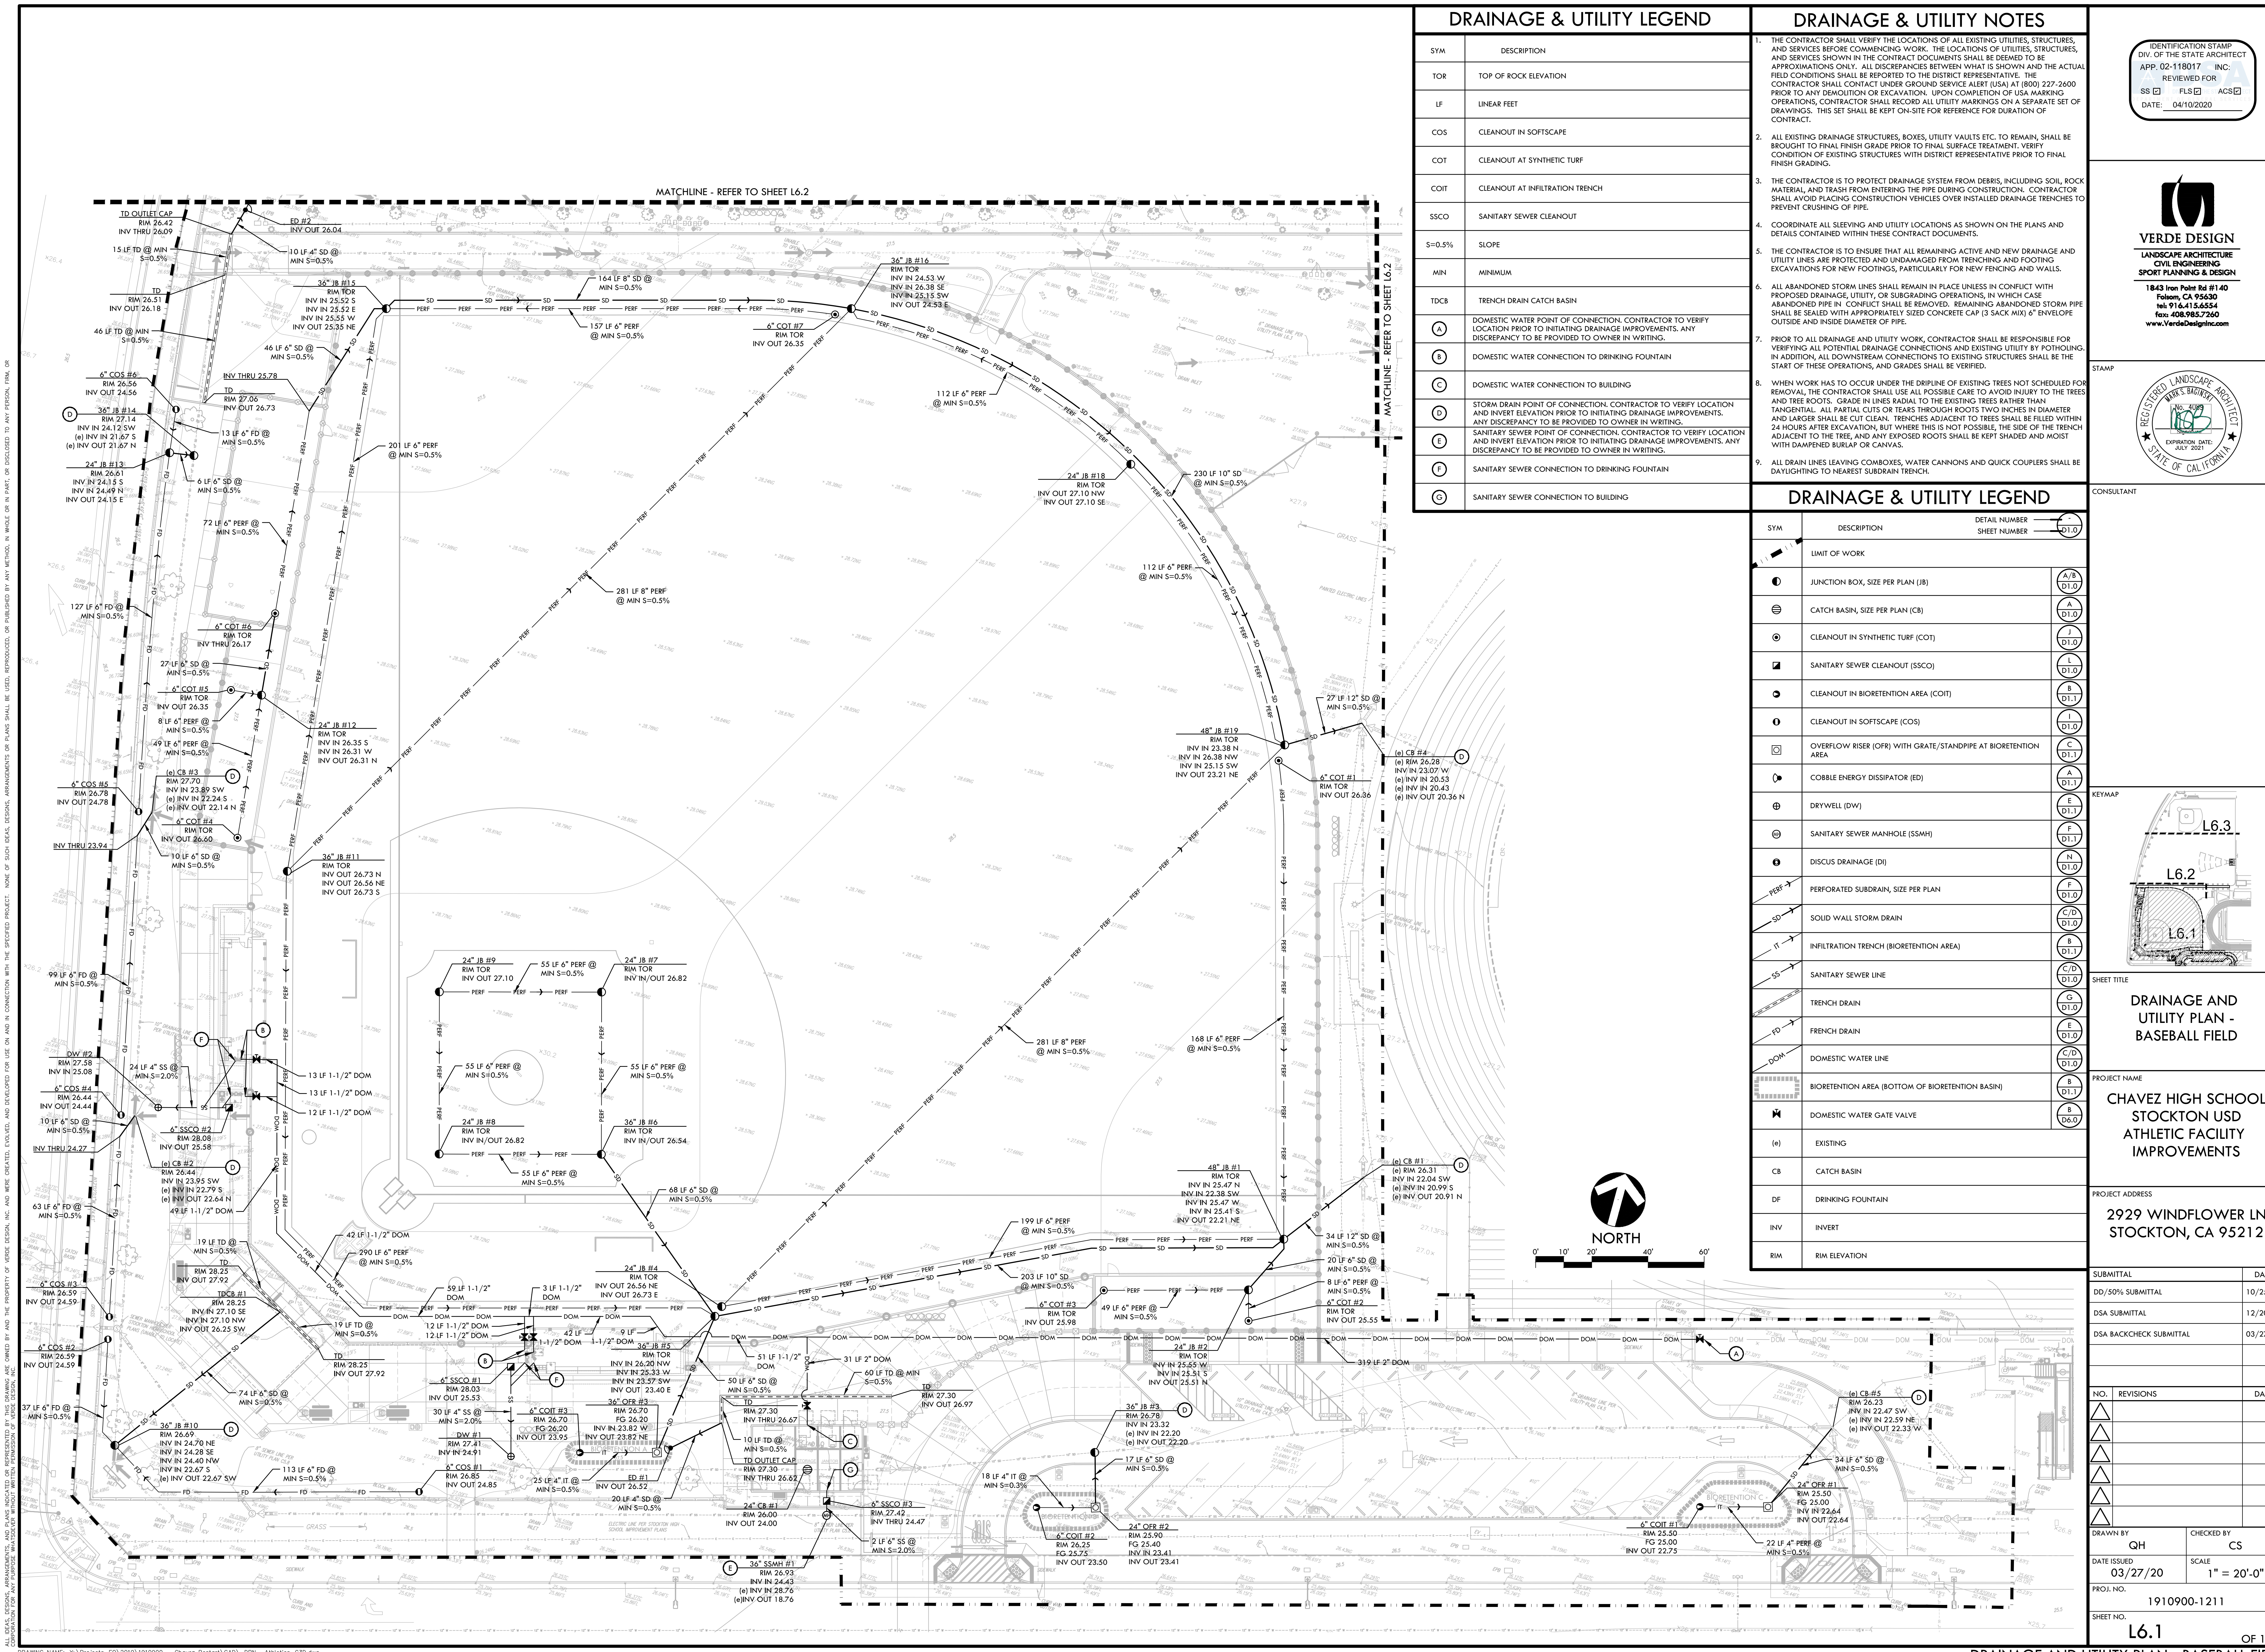

| DRAINAGE & UTILITY LEGEND |   |
|---------------------------|---|
| SYM                       | DESCRIPTION   |
| TOR                       | TOP OF ROCK ELEVATION   |
| LF                        | LINEAR FEET   |
| COS                       | CLEANOUT IN SOFTSCAPE   |
| COT                       | CLEANOUT AT SYNTHETIC TURF  |
| COIT                      | CLEANOUT AT INFILTRATION TRENCH   |
| SSCO                      | SANITARY SEWER CLEANOUT   |
| S=0.5%                    | SLOPE   |
| MIN                       | MINIMUM   |
| TDCB                      | TRENCH DRAIN CATCH BASIN  |
| (A)                       | DOMESTIC WATER POINT OF CONNECTION. CONTRACTOR TO VERIFY LOCATION PRIOR TO INITIATING DRAINAGE IMPROVEMENTS. ANY DISCREPANCY TO BE PROVIDED TO OWNER IN WRITING.                      |
| (B)                       | DOMESTIC WATER CONNECTION TO DRINKING FOUNTAIN  |
| (C)                       | DOMESTIC WATER CONNECTION TO BUILDING   |
| (D)                       | STORM DRAIN POINT OF CONNECTION. CONTRACTOR TO VERIFY LOCATION AND INVERT ELEVATION PRIOR TO INITIATING DRAINAGE IMPROVEMENTS. ANY DISCREPANCY TO BE PROVIDED TO OWNER IN WRITING.    |
| (E)                       | SANITARY SEWER POINT OF CONNECTION. CONTRACTOR TO VERIFY LOCATION AND INVERT ELEVATION PRIOR TO INITIATING DRAINAGE IMPROVEMENTS. ANY DISCREPANCY TO BE PROVIDED TO OWNER IN WRITING. |
| (F)                       | SANITARY SEWER CONNECTION TO DRINKING FOUNTAIN  |
| (G)                       | SANITARY SEWER CONNECTION TO BUILDING   |

| DRAINAGE & UTILITY NOTES |  |
|--------------------------|--|
| 1.                       | THE CONTRACTOR SHALL VERIFY THE LOCATIONS OF ALL EXISTING UTILITIES, STRUCTURES, AND SERVICES SHOWN IN THE CONTRACT DOCUMENTS SHALL BE DEEMED TO BE APPROXIMATIONS ONLY. ALL DISCREPANCIES BETWEEN WHAT IS SHOWN AND THE ACTUAL FIELD CONDITIONS SHALL BE REPORTED TO THE DISTRICT REPRESENTATIVE. THE CONTRACTOR SHALL CONTACT UNDERGROUND SERVICE ALERT (USA) AT (800) 227-2600 PRIOR TO ANY DEMOLITION OR EXCAVATION. UPON COMPLETION OF USA MARKING OPERATIONS, CONTRACTOR SHALL RECORD ALL UTILITY MARKINGS ON A SEPARATE SET OF DRAWINGS. THIS SET SHALL BE KEPT ON-SITE FOR REFERENCE FOR DURATION OF CONTRACT. |
| 2.                       | ALL EXISTING DRAINAGE STRUCTURES, BOXES, UTILITY VAULTS ETC. TO REMAIN, SHALL BE BROUGHT TO FINAL FINISH GRADE PRIOR TO FINAL SURFACE TREATMENT. VERIFY CONDITION OF EXISTING STRUCTURES WITH DISTRICT REPRESENTATIVE PRIOR TO FINAL FINISH GRADING.   |
| 3.                       | THE CONTRACTOR IS TO PROTECT DRAINAGE SYSTEM FROM DEBRIS, INCLUDING SOIL, ROCK MATERIAL, AND TRASH FROM ENTERING THE PIPE DURING CONSTRUCTION. CONTRACTOR SHALL AVOID PLACING CONSTRUCTION VEHICLES OVER INSTALLED DRAINAGE TRENCHES TO PREVENT CRUSHING OF PIPE.  |
| 4.                       | COORDINATE ALL SLEEVING AND UTILITY LOCATIONS AS SHOWN ON THE PLANS AND DETAILS CONTAINED WITHIN THESE CONTRACT DOCUMENTS.   |
| 5.                       | THE CONTRACTOR IS TO ENSURE THAT ALL REMAINING ACTIVE AND NEW DRAINAGE AND UTILITY LINES ARE PROTECTED AND UNDAMAGED FROM TRENCHING AND FOOTING EXCAVATIONS FOR NEW FOOTINGS, PARTICULARLY FOR NEW FENCING AND WALLS.  |
| 6.                       | ALL ABANDONED STORM LINES SHALL REMAIN IN PLACE UNLESS IN CONFLICT WITH PROPOSED DRAINAGE, UTILITY, OR SUBGRADING OPERATIONS, IN WHICH CASE ABANDONED PIPE IN CONFLICT SHALL BE REMOVED. REMAINING ABANDONED STORM PIPE SHALL BE SEALED WITH APPROPRIATELY SIZED CONCRETE CAP (3 SACK MIN) 6" ENVELOPE OUTSIDE AND INSIDE DIAMETER OF PIPE.  |
| 7.                       | PRIOR TO ALL DRAINAGE AND UTILITY WORK, CONTRACTOR SHALL BE RESPONSIBLE FOR VERIFYING ALL POTENTIAL DRAINAGE CONNECTIONS AND EXISTING UTILITY BY POTHOLING. IN ADDITION, ALL DOWNSTREAM CONNECTIONS TO EXISTING STRUCTURES SHALL BE THE START OF THESE OPERATIONS, AND GRADES SHALL BE VERIFIED.   |
| 8.                       | WHEN WORK HAS TO OCCUR UNDER THE DRILLPILE OF EXISTING TREES NOT SCHEDULED FOR REMOVAL, THE CONTRACTOR SHALL USE ALL POSSIBLE CARE TO AVOID INJURY TO THE TREES AND TREE ROOTS. GRADE IN LINES RADIAL TO THE EXISTING TREES RATHER THAN TANGENTIAL. ALL PARTIAL CUTS OR TEARS THROUGH ROOTS TWO INCHES IN DIAMETER AND LARGER SHALL BE CUT CLEAN. TRENCHES ADJACENT TO TREES SHALL BE FILLED WITHIN 24 HOURS AFTER EXCAVATION, BUT WHERE THIS IS NOT POSSIBLE, THE SIDE OF THE TRENCH ADJACENT TO THE TREE, AND ANY EXPOSED ROOTS SHALL BE KEPT SHADED AND MOIST WITH DAMPENED BURLAP OR CANVAS.                       |
| 9.                       | ALL DRAIN LINES LEAVING COMBOS, WATER CANNONS AND QUICK COUPLERS SHALL BE DAYLIGHTING TO NEAREST SUBDRAIN TRENCH.  |

| DRAINAGE & UTILITY LEGEND |   |
|---------------------------|---|
| SYM                       | DESCRIPTION   |
| ---                       | LIMIT OF WORK   |
| JB                        | JUNCTION BOX, SIZE PER PLAN (JB)                              |
| CB                        | CATCH BASIN, SIZE PER PLAN (CB)                               |
| COT                       | CLEANOUT IN SYNTHETIC TURF (COT)                              |
| SSCO                      | SANITARY SEWER CLEANOUT (SSCO)                                |
| COIT                      | CLEANOUT IN BIORETENTION AREA (COIT)                          |
| COS                       | CLEANOUT IN SOFTSCAPE (COS)                                   |
| OR                        | OVERFLOW RISER (OF) WITH GRATE/STANDPIPE AT BIORETENTION AREA |
| ED                        | COBBLE ENERGY DISSIPATOR (ED)                                 |
| DW                        | DRYWELL (DW)  |
| SSMH                      | SANITARY SEWER MANHOLE (SSMH)                                 |
| DI                        | DISCUS DRAINAGE (DI)  |
| PSD                       | PERFORATED SUBDRAIN, SIZE PER PLAN                            |
| SWD                       | SOLID WALL STORM DRAIN  |
| IT                        | INFILTRATION TRENCH (BIORETENTION AREA)                       |
| SSL                       | SANITARY SEWER LINE   |
| TD                        | TRENCH DRAIN  |
| FD                        | FRENCH DRAIN  |
| DWL                       | DOMESTIC WATER LINE   |
| BA                        | BIORETENTION AREA (BOTTOM OF BIORETENTION BASIN)              |
| DWV                       | DOMESTIC WATER GATE VALVE                                     |
| (e)                       | EXISTING  |
| CB                        | CATCH BASIN   |
| DF                        | DRINKING FOUNTAIN   |
| INV                       | INVERT  |
| RIM                       | RIM ELEVATION   |

IDENTIFICATION STAMP  
DIV. OF THE STATE ARCHITECT  
APP. 02-118017 INC.  
REVIEWED FOR  
SS ☐ FLS ☐ ACS ☐  
DATE: 04/10/2020

**VERDE DESIGN**  
LANDSCAPE ARCHITECTURE  
CIVIL ENGINEERING  
SPORT PLANNING & DESIGN  
1843 Iron Point Rd #140  
Folsom, CA 95630  
tel: 916.415.6554  
fax: 408.985.7260  
www.VerdeDesignInc.com

STAMP

CONSULTANT

KEYMAP

SHEET TITLE  
**DRAINAGE AND UTILITY PLAN - BASEBALL FIELD**

PROJECT NAME  
**CHAVEZ HIGH SCHOOL STOCKTON USD ATHLETIC FACILITY IMPROVEMENTS**

PROJECT ADDRESS  
**2929 WINDFLOWER LN STOCKTON, CA 95212**

| SUBMITTAL               | DATE     |
|-------------------------|----------|
| DD/50% SUBMITTAL        | 10/25/19 |
| DSA SUBMITTAL           | 12/20/19 |
| DSA BACKCHECK SUBMITTAL | 03/27/20 |

| NO. | REVISIONS | DATE |
|-----|-----------|------|
| 1   |           |      |
| 2   |           |      |
| 3   |           |      |
| 4   |           |      |
| 5   |           |      |

DRAWN BY  
**QH**

CHECKED BY  
**CS**

DATE ISSUED  
**03/27/20**

SCALE  
**1" = 20'-0"**

PROJ. NO.  
**1910900-1211**


SHEET NO.  
**L6.1**

OF 122



ALL DESIGN, DRAWING, AND CONSTRUCTION INFORMATION IS THE PROPERTY OF VERDE DESIGN, INC. AND IS NOT TO BE REPRODUCED, COPIED, OR TRANSMITTED IN ANY FORM OR BY ANY MEANS, ELECTRONIC OR MECHANICAL, WITHOUT THE WRITTEN PERMISSION OF VERDE DESIGN, INC. ANY UNAUTHORIZED USE OF THIS INFORMATION IS PROHIBITED. VERDE DESIGN, INC. IS NOT RESPONSIBLE FOR ANY ERRORS OR OMISSIONS IN THIS DOCUMENT. VERDE DESIGN, INC. IS NOT RESPONSIBLE FOR ANY CONSTRUCTION DEFECTS OR DAMAGES. VERDE DESIGN, INC. IS NOT RESPONSIBLE FOR ANY CONSTRUCTION DEFECTS OR DAMAGES. VERDE DESIGN, INC. IS NOT RESPONSIBLE FOR ANY CONSTRUCTION DEFECTS OR DAMAGES.

DRAWING NAME: Y:\Projects-FD\2019\1910900 - Chavez Restor\CAD\DRN - Athletics-C3D.dwg  
PLOT DATE: 04-02-20 PLOTTED BY: station3

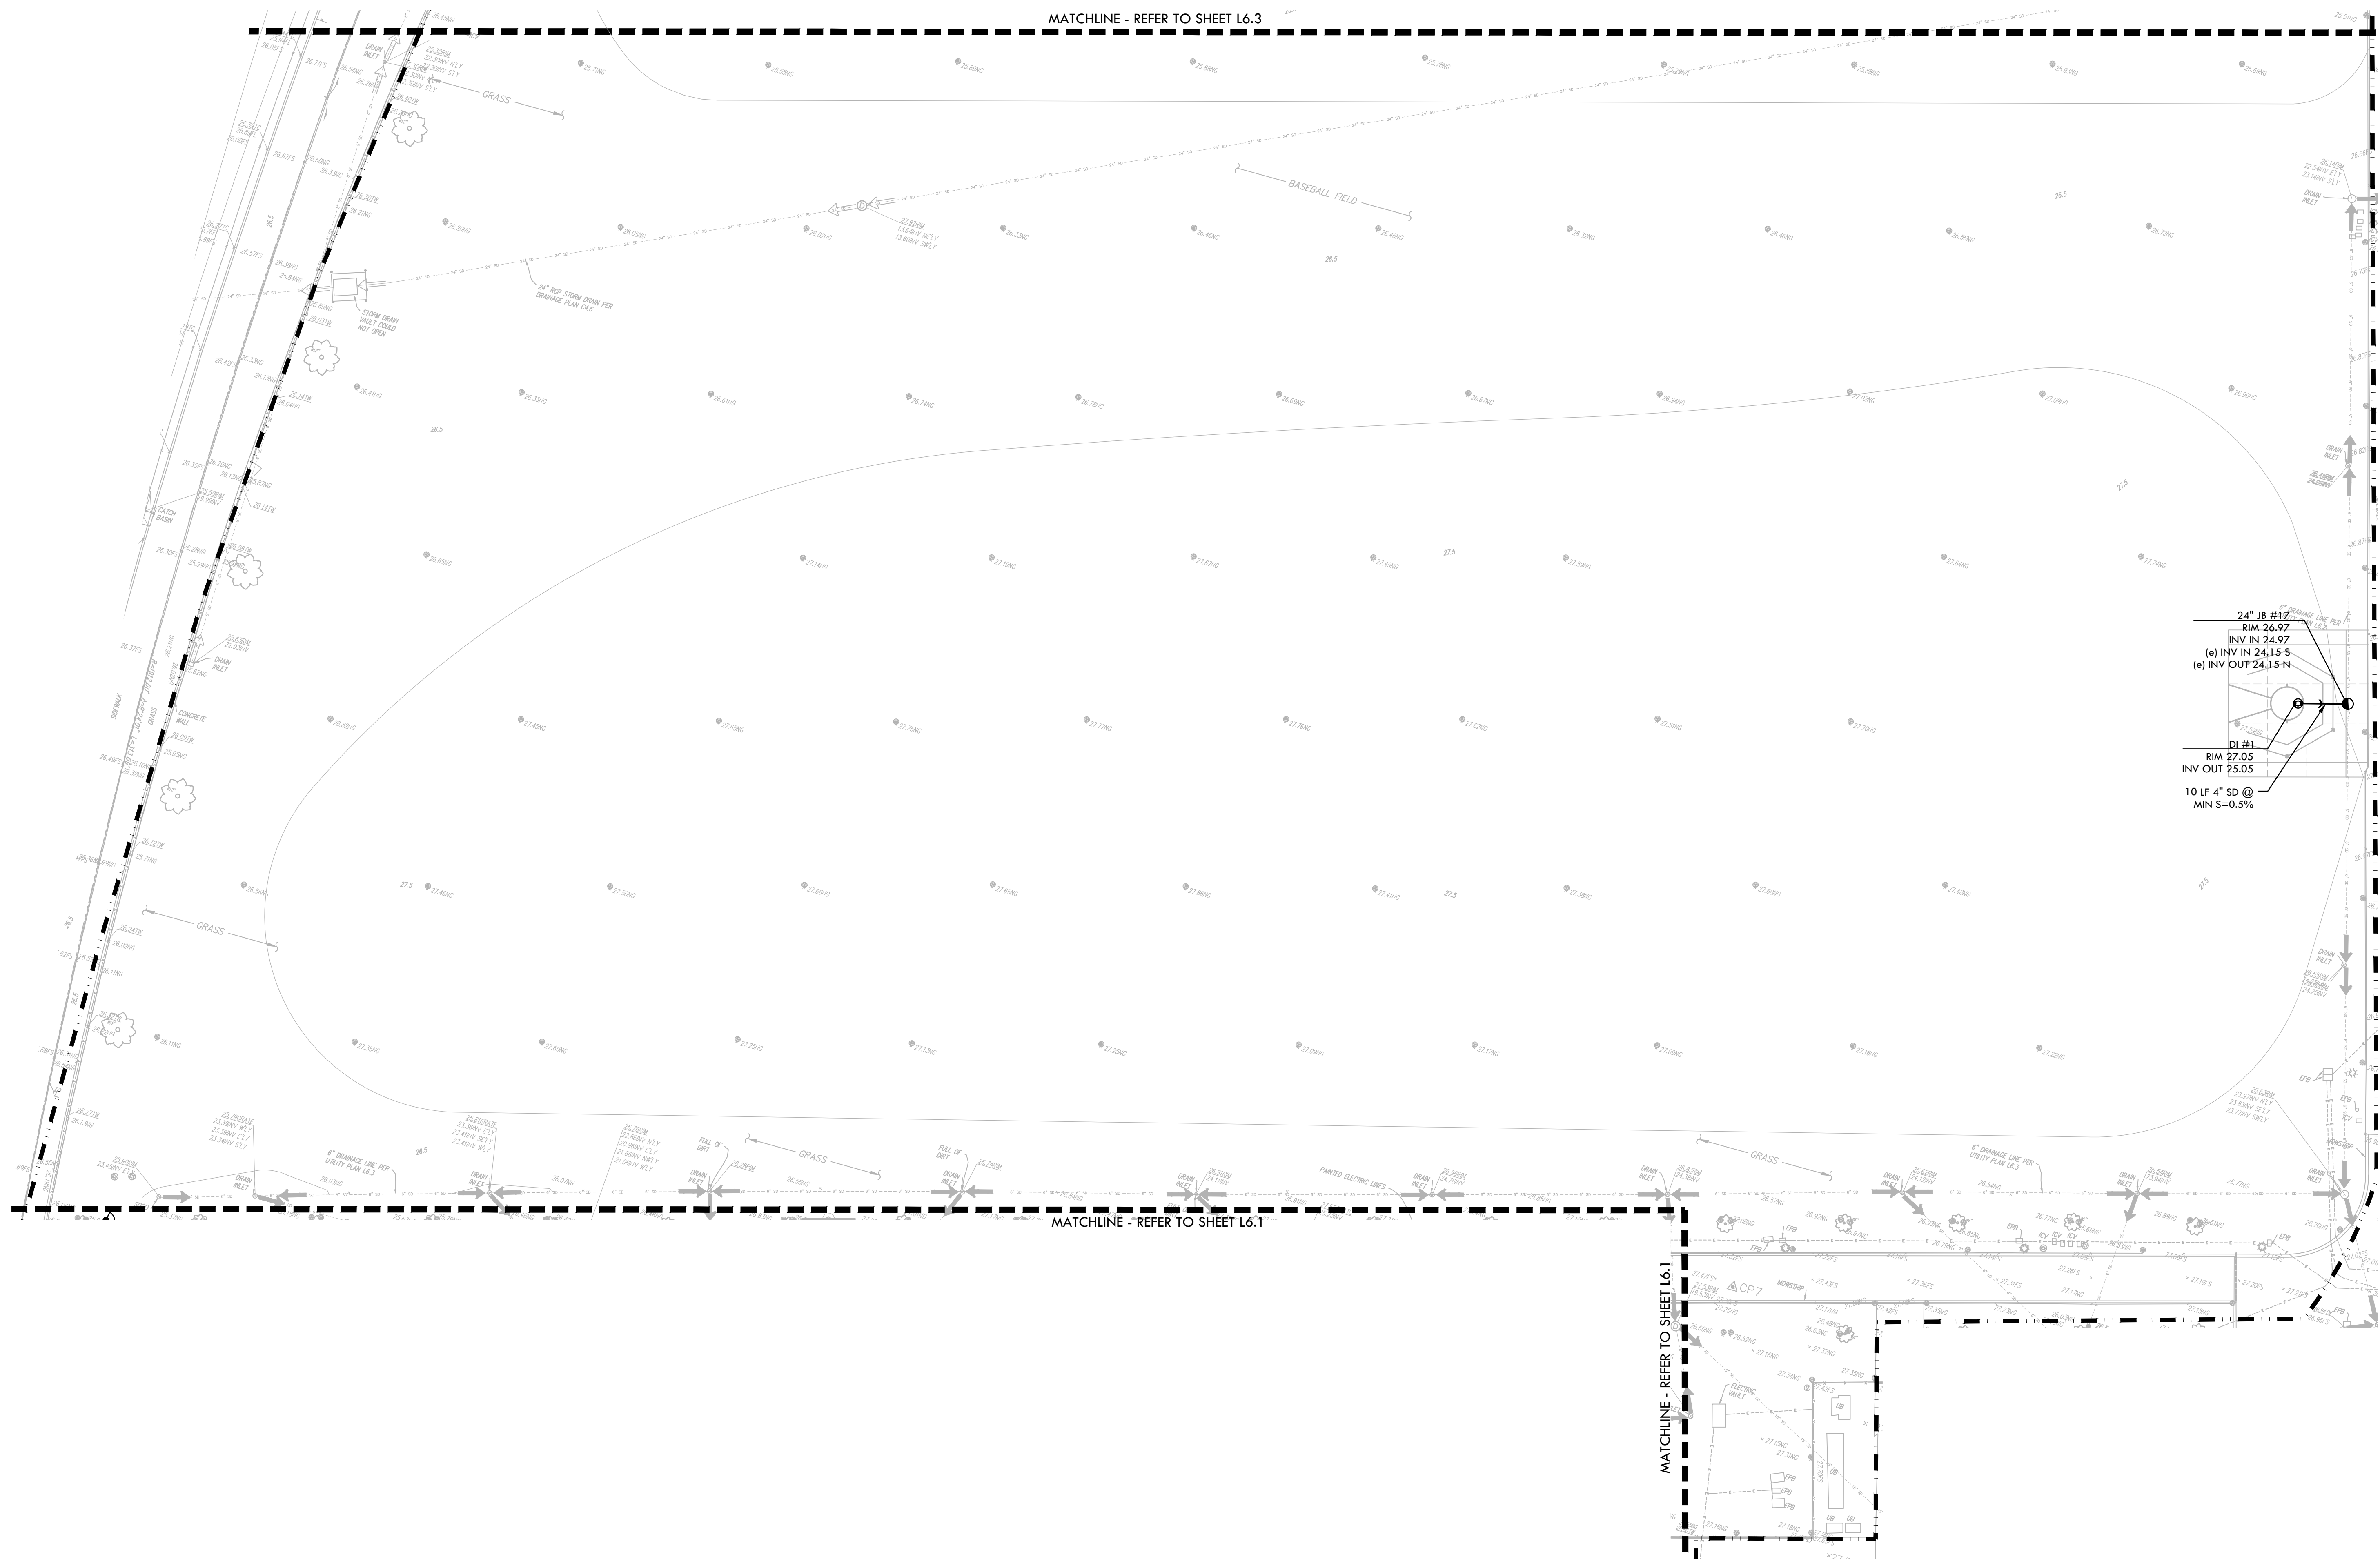

### DRAINAGE & UTILITY LEGEND


| SYM    | DESCRIPTION   |
|--------|---|
| TOR    | TOP OF ROCK ELEVATION   |
| LF     | LINEAR FEET   |
| COS    | CLEANOUT IN SOFTSCAPE   |
| COT    | CLEANOUT AT SYNTHETIC TURF  |
| COIT   | CLEANOUT AT INFILTRATION TRENCH   |
| SSCO   | SANITARY SEWER CLEANOUT   |
| S=0.5% | SLOPE   |
| MIN    | MINIMUM   |
| TDCB   | TRENCH DRAIN CATCH BASIN  |
| (A)    | DOMESTIC WATER POINT OF CONNECTION. CONTRACTOR TO VERIFY LOCATION PRIOR TO INITIATING DRAINAGE IMPROVEMENTS. ANY DISCREPANCY TO BE PROVIDED TO OWNER IN WRITING.                      |
| (B)    | DOMESTIC WATER CONNECTION TO DRINKING FOUNTAIN  |
| (C)    | DOMESTIC WATER CONNECTION TO BUILDING   |
| (D)    | STORM DRAIN POINT OF CONNECTION. CONTRACTOR TO VERIFY LOCATION AND INVERT ELEVATION PRIOR TO INITIATING DRAINAGE IMPROVEMENTS. ANY DISCREPANCY TO BE PROVIDED TO OWNER IN WRITING.    |
| (E)    | SANITARY SEWER POINT OF CONNECTION. CONTRACTOR TO VERIFY LOCATION AND INVERT ELEVATION PRIOR TO INITIATING DRAINAGE IMPROVEMENTS. ANY DISCREPANCY TO BE PROVIDED TO OWNER IN WRITING. |
| (F)    | SANITARY SEWER CONNECTION TO DRINKING FOUNTAIN  |
| (G)    | SANITARY SEWER CONNECTION TO BUILDING   |

### DRAINAGE & UTILITY NOTES


- THE CONTRACTOR SHALL VERIFY THE LOCATIONS OF ALL EXISTING UTILITIES, STRUCTURES, AND SERVICES BEFORE COMMENCING WORK. THE LOCATIONS OF UTILITIES, STRUCTURES, AND SERVICES SHOWN IN THE CONTRACT DOCUMENTS SHALL BE DEEMED TO BE APPROXIMATIONS ONLY. ALL DISCREPANCIES BETWEEN WHAT IS SHOWN AND THE ACTUAL FIELD CONDITIONS SHALL BE REPORTED TO THE DISTRICT REPRESENTATIVE. THE CONTRACTOR SHALL CONTACT UNDER GROUND SERVICE ALERT (UGSA) AT (800) 227-2600 PRIOR TO ANY DEMOLITION OR EXCAVATION. UPON COMPLETION OF UGA MARKING OPERATIONS, CONTRACTOR SHALL RECORD ALL UTILITY MARKINGS ON A SEPARATE SET OF DRAWINGS. THIS SET SHALL BE KEPT ON-SITE FOR REFERENCE FOR DURATION OF CONTRACT.
- ALL EXISTING DRAINAGE STRUCTURES, BOXES, UTILITY VAULTS ETC. TO REMAIN, SHALL BE BROUGHT TO FINAL FINISH GRADE PRIOR TO FINAL SURFACE TREATMENT. VERIFY CONDITION OF EXISTING STRUCTURES WITH DISTRICT REPRESENTATIVE PRIOR TO FINAL FINISH GRADING.
- THE CONTRACTOR IS TO PROTECT DRAINAGE SYSTEM FROM DEBRIS, INCLUDING SOIL, ROCK MATERIAL, AND TRASH FROM ENTERING THE PIPE DURING CONSTRUCTION. CONTRACTOR SHALL AVOID PLACING CONSTRUCTION VEHICLES OVER INSTALLED DRAINAGE TRENCHES TO PREVENT CRUSHING OF PIPE.
- COORDINATE ALL SLEEVING AND UTILITY LOCATIONS AS SHOWN ON THE PLANS AND DETAILS CONTAINED WITHIN THESE CONTRACT DOCUMENTS.
- THE CONTRACTOR IS TO ENSURE THAT ALL REMAINING ACTIVE AND NEW DRAINAGE AND UTILITY LINES ARE PROTECTED AND UNDAMAGED FROM TRENCHING AND FOOTING EXCAVATIONS FOR NEW FOOTINGS, PARTICULARLY FOR NEW FENCING AND WALLS.
- ALL ABANDONED STORM LINES SHALL REMAIN IN PLACE UNLESS IN CONFLICT WITH PROPOSED DRAINAGE, UTILITY, OR SUBGRADING OPERATIONS, IN WHICH CASE ABANDONED PIPE IN CONFLICT SHALL BE REMOVED. REMAINING ABANDONED STORM PIPE SHALL BE SEALED WITH APPROPRIATELY SIZED CONCRETE CAP (3 SACK MIN) 6" ENVELOPE OUTSIDE AND INSIDE DIAMETER OF PIPE.
- PRIOR TO ALL DRAINAGE AND UTILITY WORK, CONTRACTOR SHALL BE RESPONSIBLE FOR VERIFYING ALL POTENTIAL DRAINAGE CONNECTIONS AND EXISTING UTILITY BY POTHOLING. IN ADDITION, ALL DOWNSTREAM CONNECTIONS TO EXISTING STRUCTURES SHALL BE THE START OF THESE OPERATIONS, AND GRADES SHALL BE VERIFIED.
- WHEN WORK HAS TO OCCUR UNDER THE DRIPLINE OF EXISTING TREES NOT SCHEDULED FOR REMOVAL, THE CONTRACTOR SHALL USE ALL POSSIBLE CARE TO AVOID INJURY TO THE TREES AND TREE ROOTS. GRADE IN LINES RADIAL TO THE EXISTING TREES RATHER THAN TANGENTIAL. ALL PARTIAL CUTS OR TEARS THROUGH ROOTS TWO INCHES IN DIAMETER AND LARGER SHALL BE CUT CLEAN. TRENCHES ADJACENT TO TREES SHALL BE FILLED WITHIN 24 HOURS AFTER EXCAVATION, BUT WHERE THIS IS NOT POSSIBLE, THE SIDE OF THE TRENCH ADJACENT TO THE TREE, AND ANY EXPOSED ROOTS SHALL BE KEPT SHADED AND MOIST WITH DAMPENED BURLAP OR CANVAS.
- ALL DRAIN LINES LEAVING COMBOXES, WATER CANNONS AND QUICK COUPLERS SHALL BE DAYLIGHTING TO NEAREST SUBDRAIN TRENCH.

### DRAINAGE & UTILITY LEGEND

| SYM    | DESCRIPTION  | DETAIL NUMBER |
|--------|--|---------------|
|        | LIMIT OF WORK  | (D1.0)        |
| (JB)   | JUNCTION BOX, SIZE PER PLAN (JB)                               | (A/B D1.0)    |
| (CB)   | CATCH BASIN, SIZE PER PLAN (CB)                                | (A D1.0)      |
| (COT)  | CLEANOUT IN SYNTHETIC TURF (COT)                               | (I D1.0)      |
| (SSCO) | SANITARY SEWER CLEANOUT (SSCO)                                 | (I D1.0)      |
| (COIT) | CLEANOUT IN BIORETENTION AREA (COIT)                           | (B D1.1)      |
| (COS)  | CLEANOUT IN SOFTSCAPE (COS)                                    | (I D1.0)      |
| (OFR)  | OVERFLOW RISER (OFR) WITH GRATE/STANDPIPE AT BIORETENTION AREA | (C D1.1)      |
| (ED)   | COBBLE ENERGY DISSIPATOR (ED)                                  | (A D1.1)      |
| (DW)   | DRYWELL (DW)   | (E D1.1)      |
| (SSMH) | SANITARY SEWER MANHOLE (SSMH)                                  | (F D1.1)      |
| (DI)   | DISCUS DRAINAGE (DI)   | (N D1.0)      |
| (PERF) | PERFORATED SUBDRAIN, SIZE PER PLAN                             | (F D1.0)      |
| (SD)   | SOLID WALL STORM DRAIN   | (C/D D1.0)    |
| (IT)   | INFILTRATION TRENCH (BIORETENTION AREA)                        | (B D1.1)      |
| (SSL)  | SANITARY SEWER LINE  | (C/D D1.0)    |
| (TD)   | TRENCH DRAIN   | (G D1.0)      |
| (FD)   | FRENCH DRAIN   | (E D1.0)      |
| (DWL)  | DOMESTIC WATER LINE  | (C/D D1.0)    |
| (BABA) | BIORETENTION AREA (BOTTOM OF BIORETENTION BASIN)               | (B D1.1)      |
| (DWGV) | DOMESTIC WATER GATE VALVE                                      | (B D1.0)      |
| (e)    | EXISTING   |               |
| CB     | CATCH BASIN  |               |
| DF     | DRINKING FOUNTAIN  |               |
| INV    | INVERT   |               |
| RIM    | RIM ELEVATION  |               |

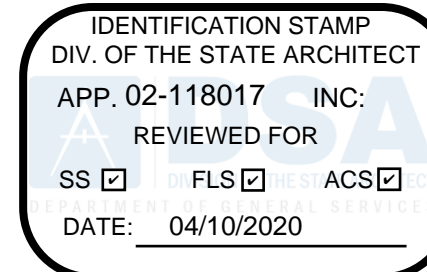

CONSULTANT

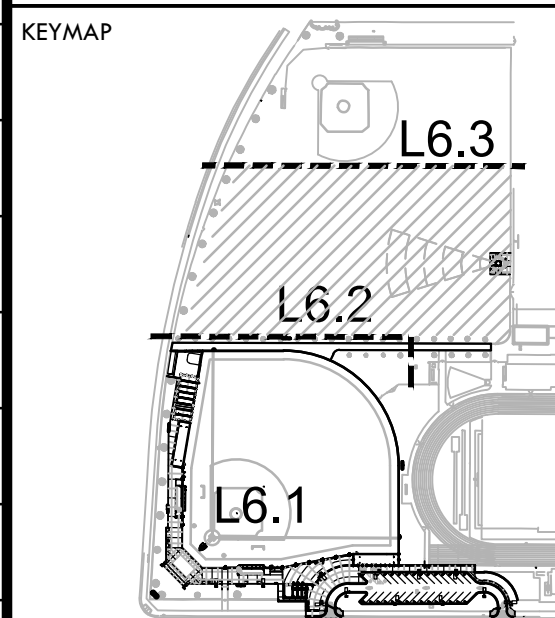

SHEET TITLE  
**DRAINAGE AND UTILITY PLAN - MULTI-USE SOUTH**

PROJECT NAME  
**CHAVEZ HIGH SCHOOL STOCKTON USD ATHLETIC FACILITY IMPROVEMENTS**

PROJECT ADDRESS  
**2929 WINDFLOWER LN STOCKTON, CA 95212**

| SUBMITTAL               | DATE     |
|-------------------------|----------|
| DD/50% SUBMITTAL        | 10/25/19 |
| DSA SUBMITTAL           | 12/20/19 |
| DSA BACKCHECK SUBMITTAL | 03/27/20 |


| NO. | REVISIONS | DATE |
|-----|-----------|------|
| 1   |           |      |
| 2   |           |      |
| 3   |           |      |
| 4   |           |      |
| 5   |           |      |

|                           |                      |
|---------------------------|----------------------|
| DRAWN BY<br>QH            | CHECKED BY<br>CS     |
| DATE ISSUED<br>03/27/20   | SCALE<br>1" = 20'-0" |
| PROJ. NO.<br>1910900-1211 |                      |
| SHEET NO.<br><b>L6.2</b>  | OF 122               |

DRAINAGE AND UTILITY PLAN - MULTI-USE SOUTH



ALL DESIGN, CONSTRUCTION, AND/OR LANDSCAPE ARCHITECTURE SHALL BE THE PROPERTY OF VERDE DESIGN, INC. AND SHALL NOT BE REPRODUCED, COPIED, OR IN ANY MANNER USED FOR ANY OTHER PROJECT WITHOUT THE WRITTEN PERMISSION OF VERDE DESIGN, INC. NO PART OF THIS DRAWING SHALL BE USED, REPRODUCED, OR PUBLISHED BY ANY METHOD, IN WHOLE OR IN PART, OR DISCLOSED TO ANY PERSON, FIRM, OR CORPORATION FOR ANY PURPOSE WITHOUT THE WRITTEN PERMISSION OF VERDE DESIGN, INC.

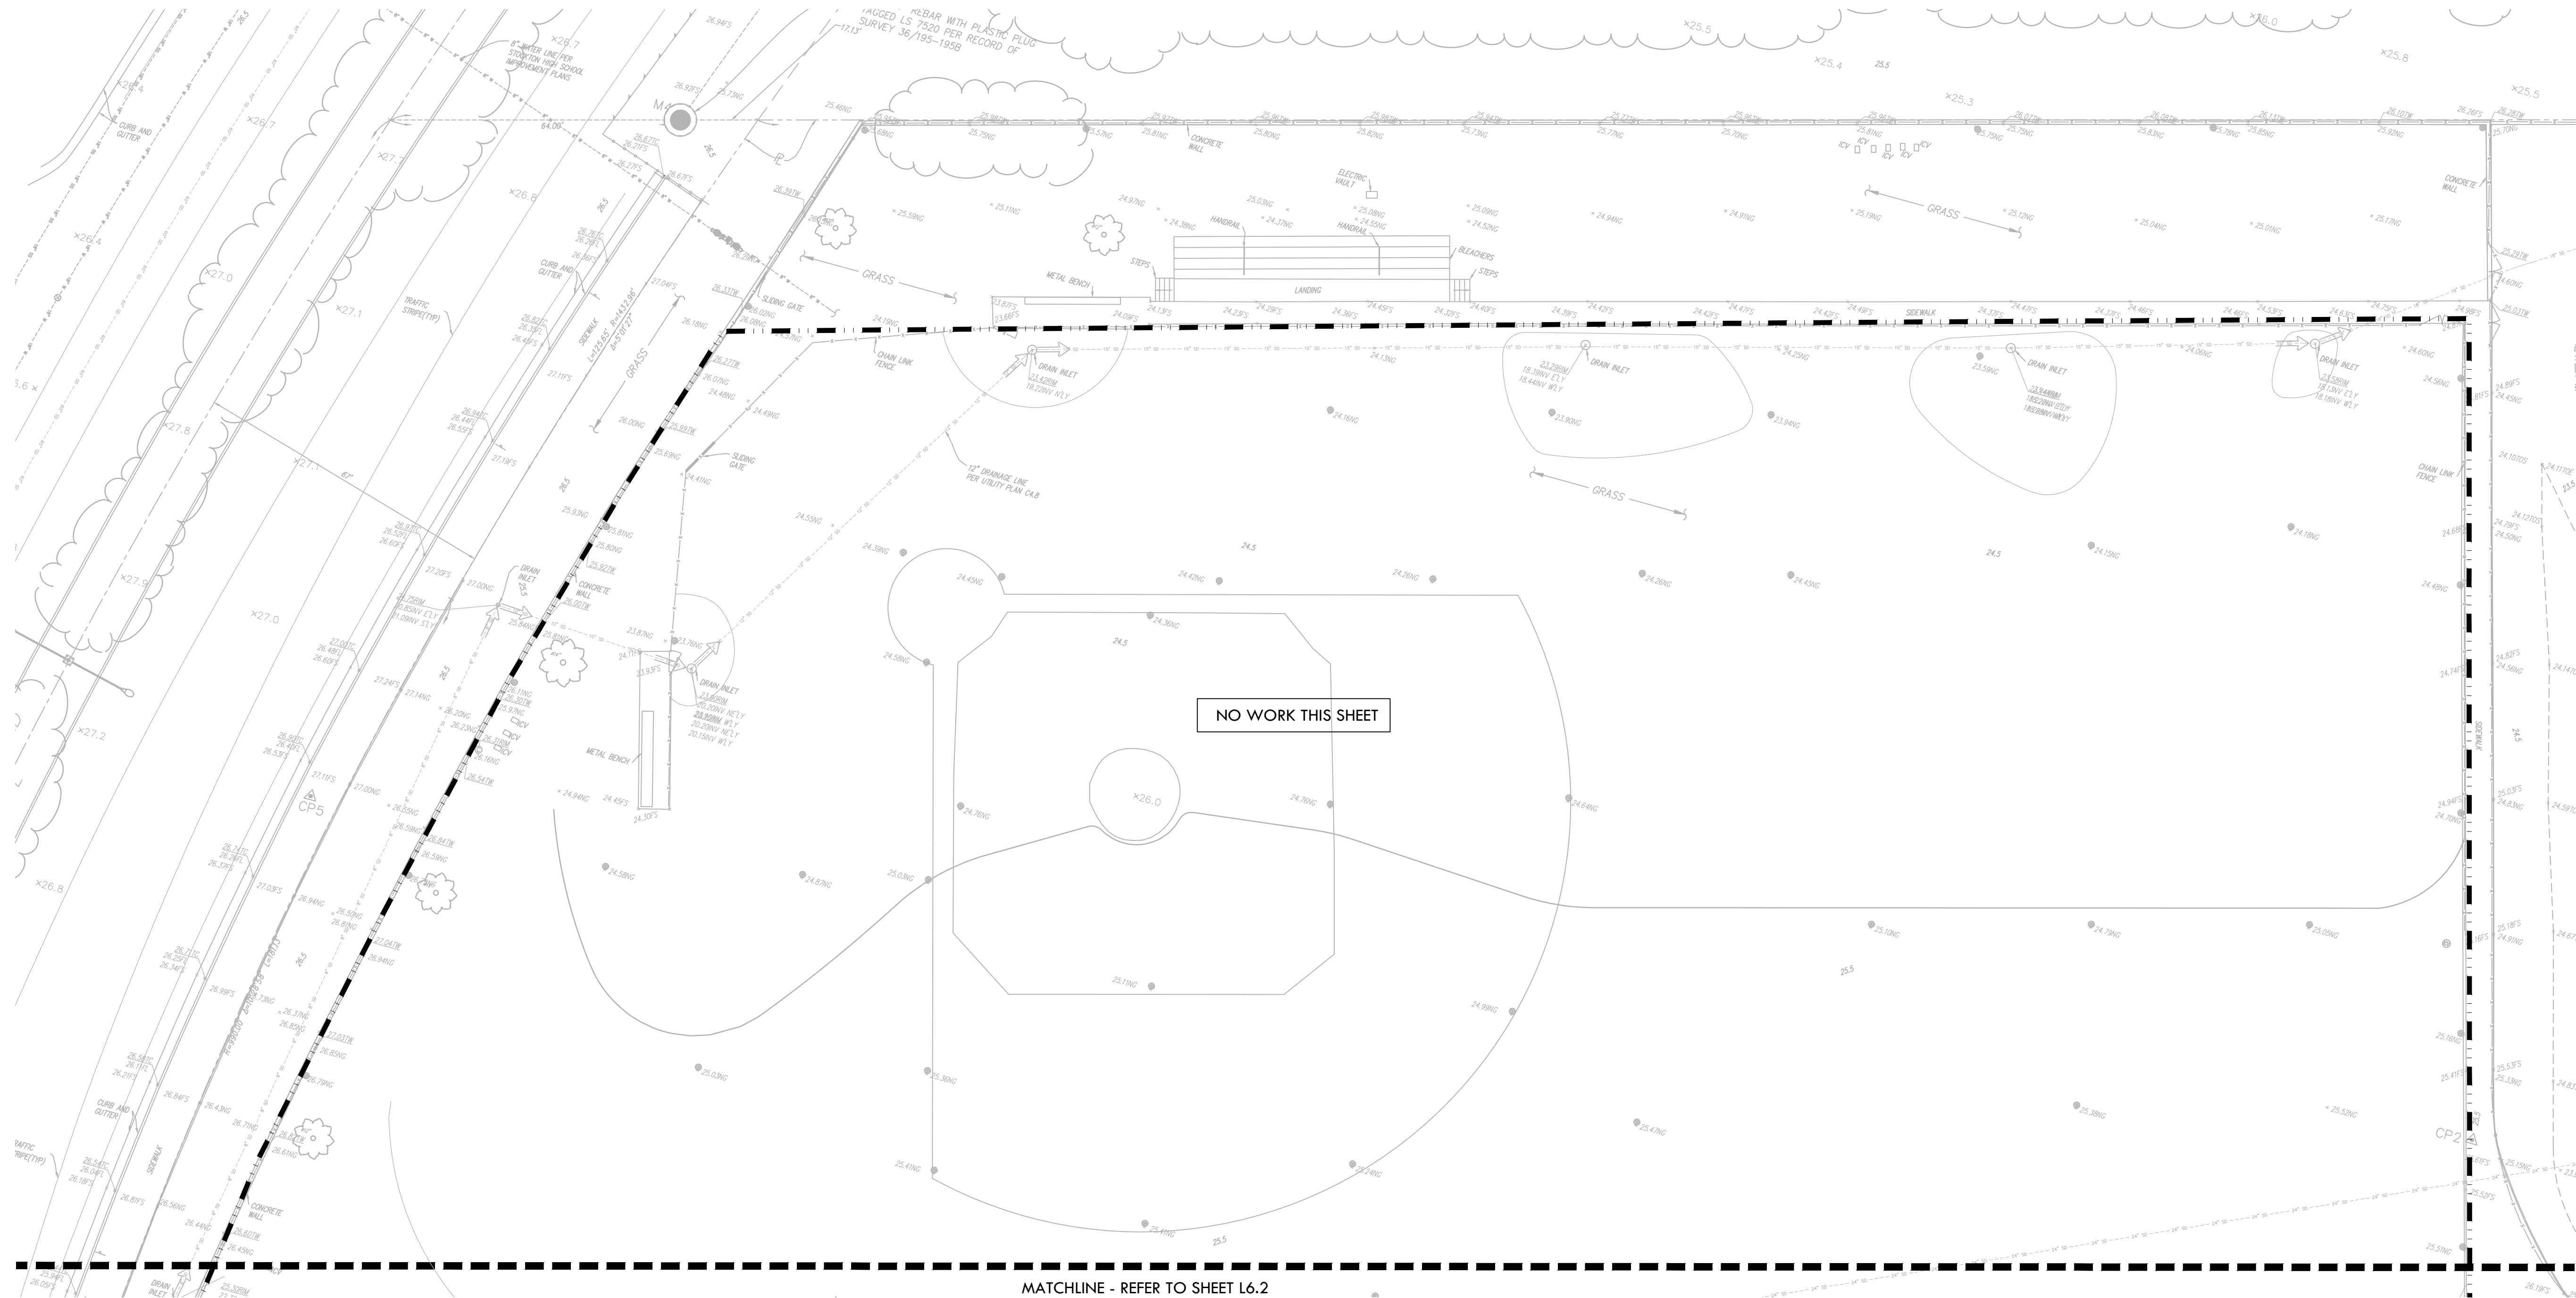

| DRAINAGE & UTILITY LEGEND |   |
|---------------------------|---|
| SYM                       | DESCRIPTION   |
| TOR                       | TOP OF ROCK ELEVATION   |
| LF                        | LINEAR FEET   |
| COS                       | CLEANOUT IN SOFTSCAPE   |
| COT                       | CLEANOUT AT SYNTHETIC TURF  |
| COIT                      | CLEANOUT AT INFILTRATION TRENCH   |
| SSCO                      | SANITARY SEWER CLEANOUT   |
| S=0.5%                    | SLOPE   |
| MIN                       | MINIMUM   |
| TDCB                      | TRENCH DRAIN CATCH BASIN  |
| (A)                       | DOMESTIC WATER POINT OF CONNECTION. CONTRACTOR TO VERIFY LOCATION PRIOR TO INITIATING DRAINAGE IMPROVEMENTS. ANY DISCREPANCY TO BE PROVIDED TO OWNER IN WRITING.                      |
| (B)                       | DOMESTIC WATER CONNECTION TO DRINKING FOUNTAIN  |
| (C)                       | DOMESTIC WATER CONNECTION TO BUILDING   |
| (D)                       | STORM DRAIN POINT OF CONNECTION. CONTRACTOR TO VERIFY LOCATION AND INVERT ELEVATION PRIOR TO INITIATING DRAINAGE IMPROVEMENTS. ANY DISCREPANCY TO BE PROVIDED TO OWNER IN WRITING.    |
| (E)                       | SANITARY SEWER POINT OF CONNECTION. CONTRACTOR TO VERIFY LOCATION AND INVERT ELEVATION PRIOR TO INITIATING DRAINAGE IMPROVEMENTS. ANY DISCREPANCY TO BE PROVIDED TO OWNER IN WRITING. |
| (F)                       | SANITARY SEWER CONNECTION TO DRINKING FOUNTAIN  |
| (G)                       | SANITARY SEWER CONNECTION TO BUILDING   |

- | DRAINAGE & UTILITY NOTES |   |
|--------------------------|---|
| 1.                       | THE CONTRACTOR SHALL VERIFY THE LOCATIONS OF ALL EXISTING UTILITIES, STRUCTURES, AND SERVICES BEFORE COMMENCING WORK. THE LOCATIONS OF UTILITIES, STRUCTURES, AND SERVICES SHOWN IN THE CONTRACT DOCUMENTS SHALL BE DEEMED TO BE APPROXIMATIONS ONLY. ALL DISCREPANCIES BETWEEN WHAT IS SHOWN AND THE ACTUAL FIELD CONDITIONS SHALL BE REPORTED TO THE DISTRICT REPRESENTATIVE. THE CONTRACTOR SHALL CONTACT UNDER GROUND SERVICE ALERT (UGSA) AT (800) 227-2600 PRIOR TO ANY DEMOLITION OR EXCAVATION. UPON COMPLETION OF UGA MARKING OPERATIONS, CONTRACTOR SHALL RECORD ALL UTILITY MARKINGS ON A SEPARATE SET OF DRAWINGS. THIS SET SHALL BE KEPT ON-SITE FOR REFERENCE FOR DURATION OF CONTRACT. |
| 2.                       | ALL EXISTING DRAINAGE STRUCTURES, BOXES, UTILITY VAULTS ETC. TO REMAIN, SHALL BE BROUGHT TO FINAL FINISH GRADE PRIOR TO FINAL SURFACE TREATMENT. VERIFY CONDITION OF EXISTING STRUCTURES WITH DISTRICT REPRESENTATIVE PRIOR TO FINAL FINISH GRADING.  |
| 3.                       | THE CONTRACTOR IS TO PROTECT DRAINAGE SYSTEM FROM DEBRIS, INCLUDING SOIL, ROCK MATERIAL, AND TRASH FROM ENTERING THE PIPE DURING CONSTRUCTION. CONTRACTOR SHALL AVOID PLACING CONSTRUCTION VEHICLES OVER INSTALLED DRAINAGE TRENCHES TO PREVENT CRUSHING OF PIPE.   |
| 4.                       | COORDINATE ALL SLEEVING AND UTILITY LOCATIONS AS SHOWN ON THE PLANS AND DETAILS CONTAINED WITHIN THESE CONTRACT DOCUMENTS.  |
| 5.                       | THE CONTRACTOR IS TO ENSURE THAT ALL REMAINING ACTIVE AND NEW DRAINAGE AND UTILITY LINES ARE PROTECTED AND UNDAMAGED FROM TRENCHING AND FOOTING EXCAVATIONS FOR NEW FOOTINGS, PARTICULARLY FOR NEW FENCING AND WALLS.   |
| 6.                       | ALL ABANDONED STORM LINES SHALL REMAIN IN PLACE UNLESS IN CONFLICT WITH PROPOSED DRAINAGE, UTILITY, OR SUBGRADING OPERATIONS, IN WHICH CASE ABANDONED PIPE IN CONFLICT SHALL BE REMOVED. REMAINING ABANDONED STORM PIPE SHALL BE SEALED WITH APPROPRIATELY SIZED CONCRETE CAP (3 SACK MIN) 6" ENVELOPE OUTSIDE AND INSIDE DIAMETER OF PIPE.   |
| 7.                       | PRIOR TO ALL DRAINAGE AND UTILITY WORK, CONTRACTOR SHALL BE RESPONSIBLE FOR VERIFYING ALL POTENTIAL DRAINAGE CONNECTIONS AND EXISTING UTILITY BY POTHOLING. IN ADDITION, ALL DOWNSTREAM CONNECTIONS TO EXISTING STRUCTURES SHALL BE THE START OF THESE OPERATIONS, AND GRADES SHALL BE VERIFIED.  |
| 8.                       | WHEN WORK HAS TO OCCUR UNDER THE DRIPLINE OF EXISTING TREES NOT SCHEDULED FOR REMOVAL, THE CONTRACTOR SHALL USE ALL POSSIBLE CARE TO AVOID INJURY TO THE TREES AND TREE ROOTS. GRADE IN LINES RADIAL TO THE EXISTING TREES RATHER THAN TANGENTIAL. ALL PARTIAL CUTS OR TEARS THROUGH ROOTS TWO INCHES IN DIAMETER AND LARGER SHALL BE CUT CLEAN. TRENCHES ADJACENT TO TREES SHALL BE FILLED WITHIN 24 HOURS AFTER EXCAVATION, BUT WHERE THIS IS NOT POSSIBLE, THE SIDE OF THE TRENCH ADJACENT TO THE TREE, AND ANY EXPOSED ROOTS SHALL BE KEPT SHADED AND MOIST WITH DAMPENED BURLAP OR CANVAS.   |
| 9.                       | ALL DRAIN LINES LEAVING COMBOXES, WATER CANNONS AND QUICK COUPLERS SHALL BE DAYLIGHTING TO NEAREST SUBRAIN TRENCH.  |

| DRAINAGE & UTILITY LEGEND |  |
|---------------------------|--|
| SYM                       | DESCRIPTION  |
| LIMIT OF WORK             |  |
| (JB)                      | JUNCTION BOX, SIZE PER PLAN (JB)                               |
| (CB)                      | CATCH BASIN, SIZE PER PLAN (CB)                                |
| (COT)                     | CLEANOUT IN SYNTHETIC TURF (COT)                               |
| (SSCO)                    | SANITARY SEWER CLEANOUT (SSCO)                                 |
| (COIT)                    | CLEANOUT IN BIORETENTION AREA (COIT)                           |
| (COS)                     | CLEANOUT IN SOFTSCAPE (COS)                                    |
| (OFR)                     | OVERFLOW RISER (OFR) WITH GRATE/STANDPIPE AT BIORETENTION AREA |
| (ED)                      | COBBLE ENERGY DISSIPATOR (ED)                                  |
| (DW)                      | DRYWELL (DW)   |
| (SSMH)                    | SANITARY SEWER MANHOLE (SSMH)                                  |
| (DI)                      | DISCUS DRAINAGE (DI)   |
| (SD)                      | PERFORATED SUBRAIN, SIZE PER PLAN                              |
| (IT)                      | SOLID WALL STORM DRAIN   |
| (IT)                      | INFILTRATION TRENCH (BIORETENTION AREA)                        |
| (SS)                      | SANITARY SEWER LINE  |
| (FD)                      | TRENCH DRAIN   |
| (FD)                      | FRENCH DRAIN   |
| (DW)                      | DOMESTIC WATER LINE  |
| (B)                       | BIORETENTION AREA (BOTTOM OF BIORETENTION BASIN)               |
| (M)                       | DOMESTIC WATER GATE VALVE                                      |
| (e)                       | EXISTING   |
| CB                        | CATCH BASIN  |
| DF                        | DRINKING FOUNTAIN  |
| INV                       | INVERT   |
| RIM                       | RIM ELEVATION  |

IDENTIFICATION STAMP  
DIV. OF THE STATE ARCHITECT  
APP. 02-118017 INC.  
REVIEWED FOR  
SS ☒ FL ☒ ACS ☒  
DATE: 04/10/2020

**VERDE DESIGN**  
LANDSCAPE ARCHITECTURE  
CIVIL ENGINEERING  
SPORT PLANNING & DESIGN  
1843 Iron Point Rd #140  
Folsom, CA 95630  
tel: 916.415.6554  
fax: 408.985.7260  
www.VerdeDesignInc.com

STAMP

CONSULTANT

KEYMAP

SHEET TITLE  
**DRAINAGE AND UTILITY PLAN - MULTI-USE NORTH**

PROJECT NAME  
**CHAVEZ HIGH SCHOOL STOCKTON USD ATHLETIC FACILITY IMPROVEMENTS**

PROJECT ADDRESS  
**2929 WINDFLOWER LN STOCKTON, CA 95212**

| SUBMITTAL               | DATE     |
|-------------------------|----------|
| DD/50% SUBMITTAL        | 10/25/19 |
| DSA SUBMITTAL           | 12/20/19 |
| DSA BACKCHECK SUBMITTAL | 03/27/20 |

| NO. | REVISIONS | DATE |
|-----|-----------|------|
| 1   |           |      |
| 2   |           |      |
| 3   |           |      |
| 4   |           |      |
| 5   |           |      |

|                                  |                             |
|----------------------------------|-----------------------------|
| DRAWN BY<br><b>QH</b>            | CHECKED BY<br><b>CS</b>     |
| DATE ISSUED<br><b>03/27/20</b>   | SCALE<br><b>1" = 20'-0"</b> |
| PROJ. NO.<br><b>1910900-1211</b> |                             |
| SHEET NO.<br><b>L6.3</b>         |                             |


DRAINAGE AND UTILITY PLAN - MULTI-USE NORTH

OF 122



ALL DESIGN, CONSTRUCTION AND/OR MATERIALS SPECIFICATIONS ARE THE PROPERTY OF VERDE DESIGN, INC. AND ARE NOT TO BE REPRODUCED, COPIED, OR DISCLOSED TO ANY PERSON, FIRM, OR CORPORATION FOR ANY PURPOSES WITHOUT WRITTEN PERMISSION OF VERDE DESIGN, INC.

DRAWING NAME: Y:\projects-fa\2019\1910900 - chavez restor\CAD\LAY- Athletics.dwg  
PLOT DATE: 03-31-20 PLOTTED BY: station40

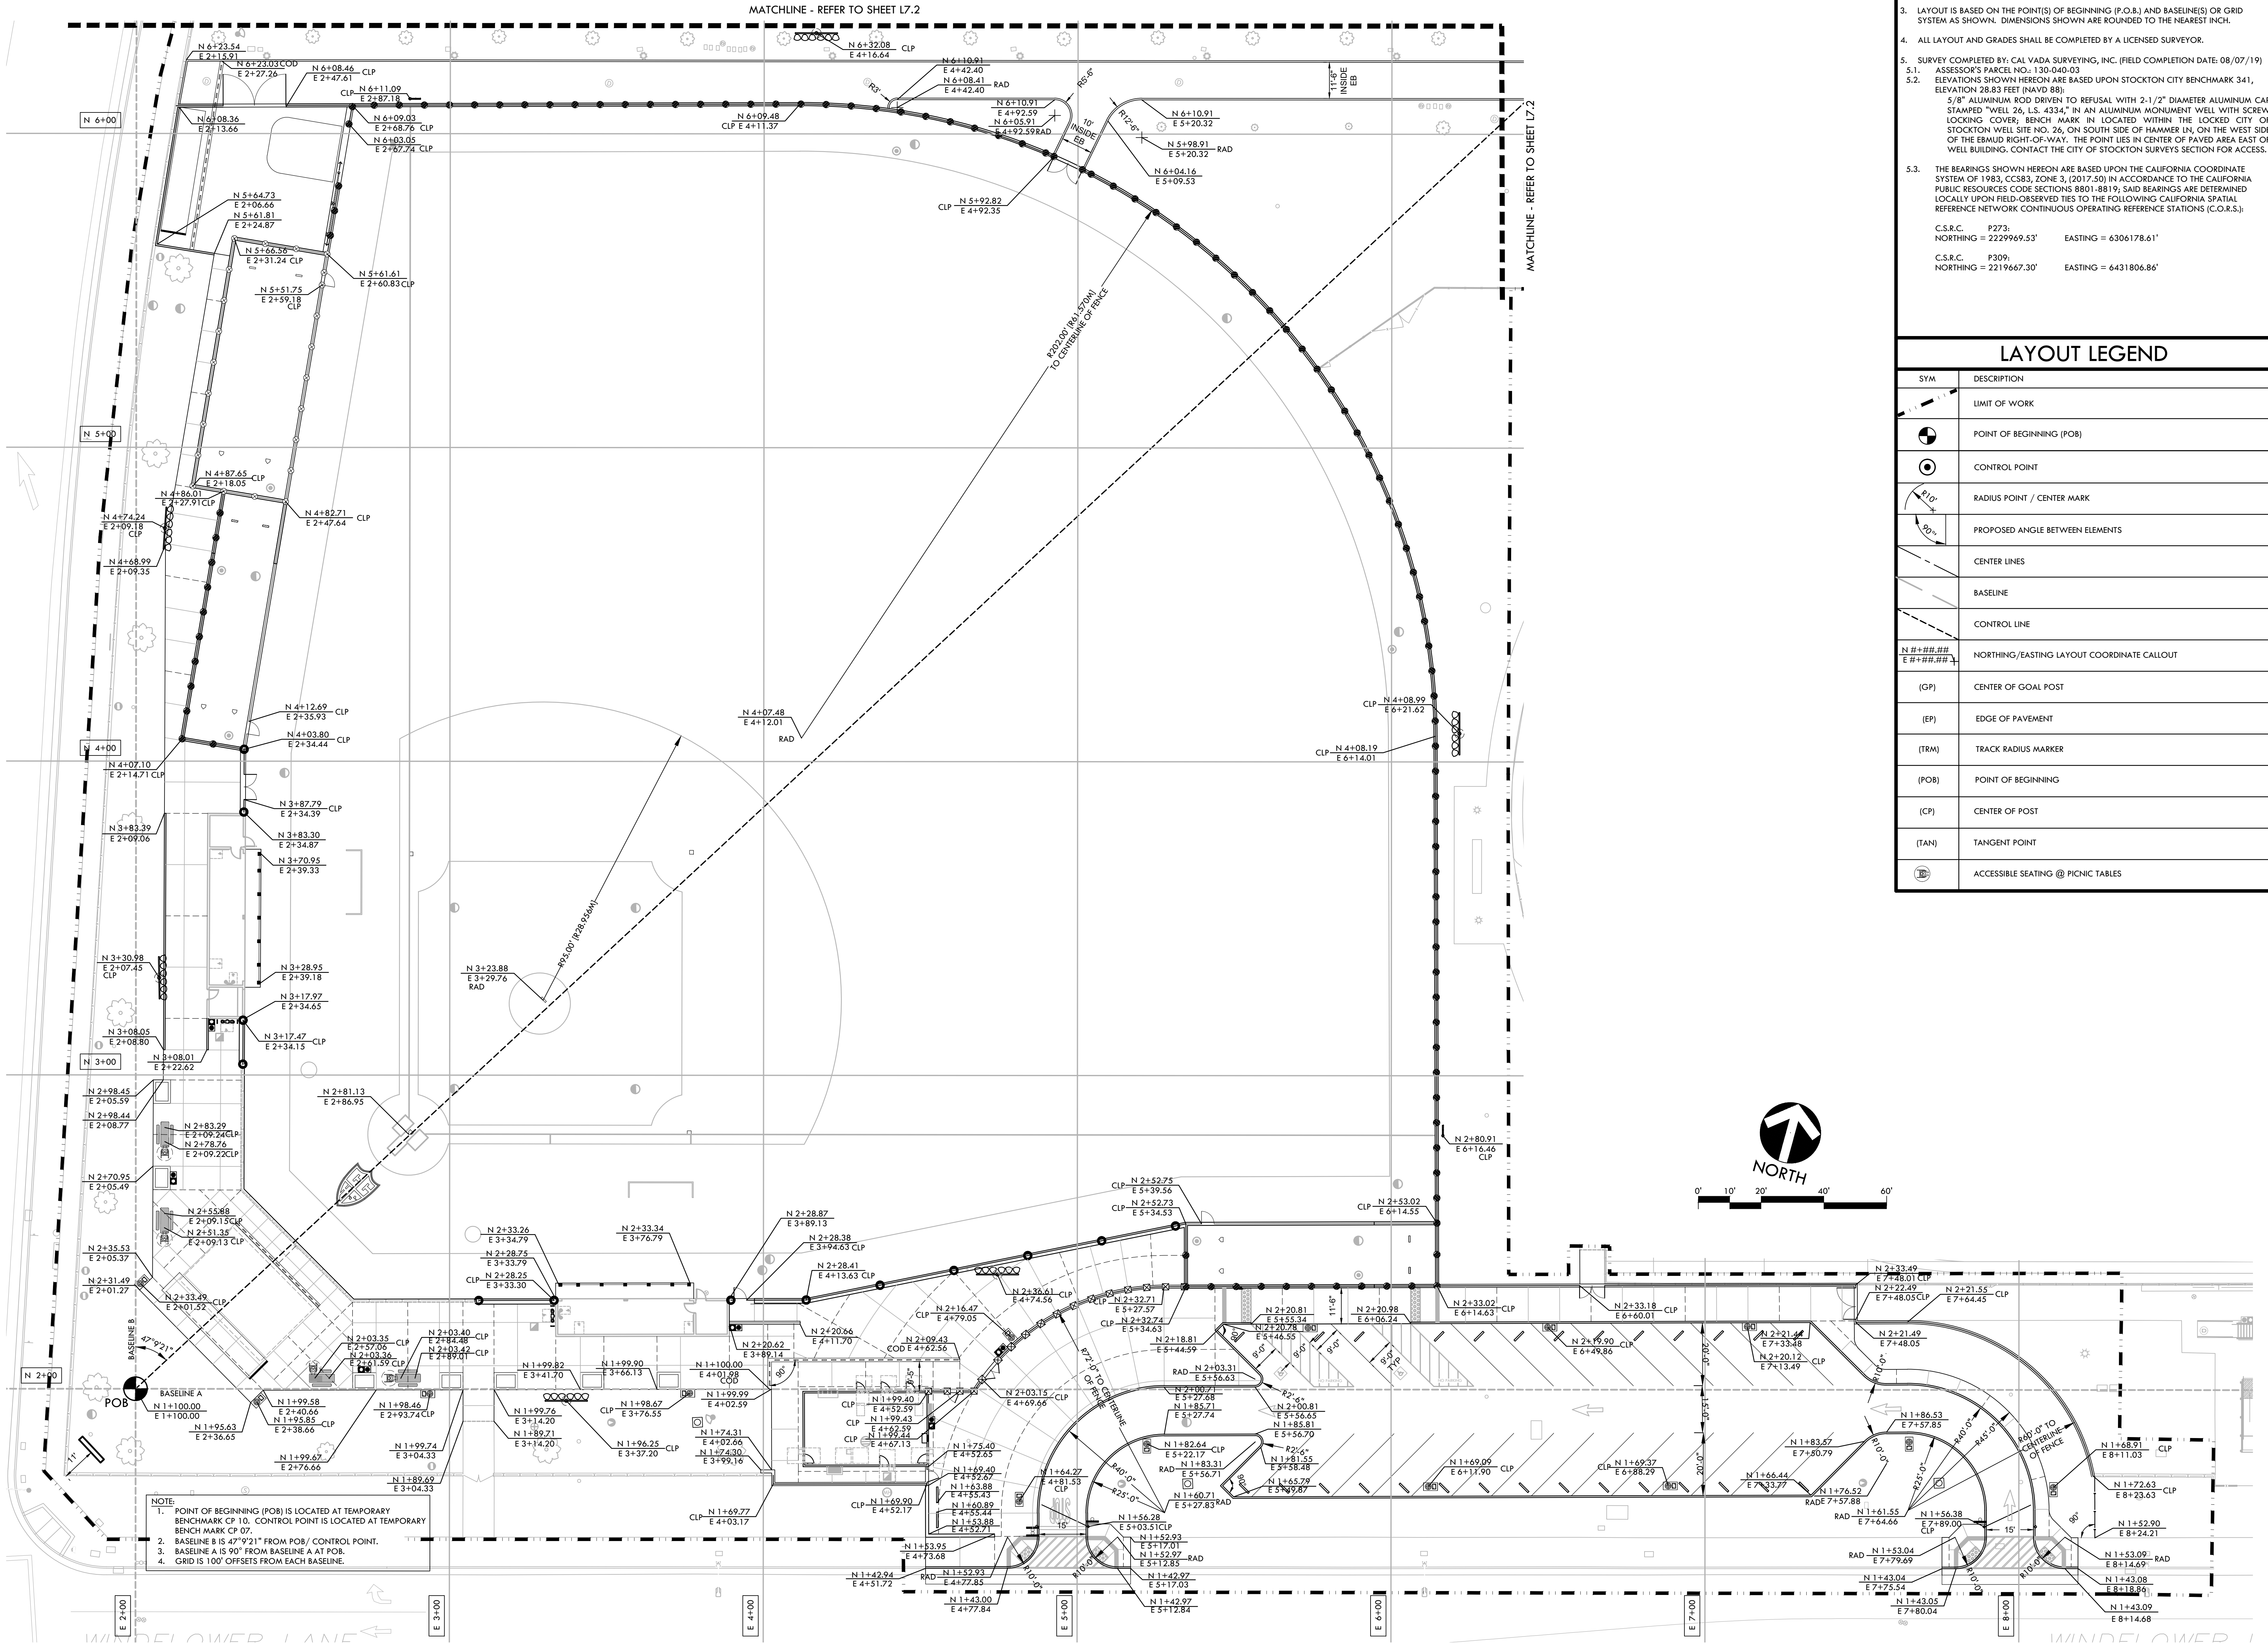

LAYOUT NOTES

- THE CONTRACTOR SHALL COORDINATE ALL CONSTRUCTION ELEMENTS INCLUDING UTILITY LOCATIONS AND REQUIRED SLEEVING PRIOR TO INSTALLATION. VERIFY CRITICAL DIMENSIONS, REFERENCE POINT LOCATIONS AND CONSTRUCTION CONDITIONS PRIOR TO INITIATING CONSTRUCTION. TEMPORARY BENCHMARKS OR REFERENCE POINTS SHALL BE SET BY THE CONTRACTOR AS NECESSARY. NOTIFY THE OWNER'S REPRESENTATIVE IMMEDIATELY SHOULD DISCREPANCY ARISE AND REDIRECT WORK TO AVOID DELAYS.
- ALL DIMENSIONS SHALL BE VERIFIED IN FIELD AND CHALKED, STRING LINED OR FLAGGED BY THE CONTRACTOR PRIOR TO CONSTRUCTION. ANY MINOR ADJUSTMENTS MADE TO ACHIEVE OVERALL DESIGN LAYOUT SHALL BE ACCEPTED BY THE OWNER PRIOR TO CONSTRUCTION.
- LAYOUT IS BASED ON THE POINT(S) OF BEGINNING (P.O.B.) AND BASELINE(S) OR GRID SYSTEM AS SHOWN. DIMENSIONS SHOWN ARE ROUNDED TO THE NEAREST INCH.
- ALL LAYOUT AND GRADES SHALL BE COMPLETED BY A LICENSED SURVEYOR.
- SURVEY COMPLETED BY: CAL VADA SURVEYING, INC. (FIELD COMPLETION DATE: 08/07/19)
  - ASSESSOR'S PARCEL NO.: 130-040-03
  - ELEVATIONS SHOWN HEREON ARE BASED UPON STOCKTON CITY BENCHMARK 341, ELEVATION 26.83 FEET (NAVD 88).
  - 5/8" ALUMINUM ROD DRIVEN TO REFUSAL WITH 2-1/2" DIAMETER ALUMINUM CAP STAMPED "WELL 26, L.S. 43347" IN AN ALUMINUM MONUMENT WELL WITH SCREW LOCKING COVER, BENCH MARK IN LOCATED WITHIN THE LOCKED CITY OF STOCKTON WELL SITE NO. 26, ON SOUTH SIDE OF HAMMER LN, ON THE WEST SIDE OF THE EBMUD RIGHT-OF-WAY. THE POINT LIES IN CENTER OF PAVED AREA EAST OF WELL BUILDING. CONTACT THE CITY OF STOCKTON SURVEYS SECTION FOR ACCESS.
- THE BEARINGS SHOWN HEREON ARE BASED UPON THE CALIFORNIA COORDINATE SYSTEM OF 1983, CC83, ZONE 3, (2017.50) IN ACCORDANCE TO THE CALIFORNIA PUBLIC RESOURCES CODE SECTIONS 8801-8819, SAID BEARINGS ARE DETERMINED LOCALLY UPON FIELD-OBSERVED TIES TO THE FOLLOWING CALIFORNIA SPATIAL REFERENCE NETWORK CONTINUOUS OPERATING REFERENCE STATIONS (C.O.R.S.):

|                |                        |                       |
|----------------|------------------------|-----------------------|
| C.S.R.C. P273: | NORTHING = 2229969.53' | EASTING = 6306178.61' |
| C.S.R.C. P309: | NORTHING = 2219667.30' | EASTING = 6431806.86' |

LAYOUT LEGEND

| SYM | DESCRIPTION                                |
|-----|--|
|     | LIMIT OF WORK                              |
|     | POINT OF BEGINNING (POB)                   |
|     | CONTROL POINT                              |
|     | RADIUS POINT / CENTER MARK                 |
|     | PROPOSED ANGLE BETWEEN ELEMENTS            |
|     | CENTER LINES                               |
|     | BASELINE                                   |
|     | CONTROL LINE                               |
|     | NORTHING/EASTING LAYOUT COORDINATE CALLOUT |
|     | CENTER OF GOAL POST                        |
|     | EDGE OF PAVEMENT                           |
|     | TRACK RADIUS MARKER                        |
|     | POINT OF BEGINNING                         |
|     | CENTER OF POST                             |
|     | TANGENT POINT                              |
|     | ACCESSIBLE SEATING @ PICNIC TABLES         |


IDENTIFICATION STAMP  
DIV. OF THE STATE ARCHITECT  
APP. 02-118017 INC.  
REVIEWED FOR  
SS ☒ FLS ☒ ACS ☒  
DATE: 04/10/2020

VERDE DESIGN  
LANDSCAPE ARCHITECTURE  
CIVIL ENGINEERING  
SPORT PLANNING & DESIGN  
1843 Iron Point Rd #140  
Folsom, CA 95630  
tel: 916.415.6554  
fax: 408.985.7260  
www.VerdeDesignInc.com

REGISTERED LANDSCAPE ARCHITECT  
WILLIAM S. BARNETT  
EXPIRATION DATE: JULY 2021  
STATE OF CALIFORNIA

CONSULTANT

KEYMAP

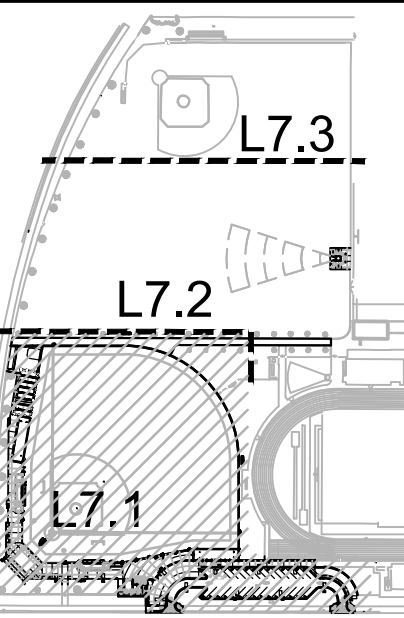

SHEET TITLE

LAYOUT PLAN -  
BASEBALL FIELD

PROJECT NAME

CHAVEZ HIGH SCHOOL  
STOCKTON USD  
ATHLETIC FACILITY  
IMPROVEMENTS

PROJECT ADDRESS

2929 WINDFLOWER LN  
STOCKTON, CA 95212

| SUBMITTAL               | DATE     |
|-------------------------|----------|
| DD/50% SUBMITTAL        | 10/25/19 |
| DSA SUBMITTAL           | 12/20/19 |
| DSA BACKCHECK SUBMITTAL | 03/27/20 |

| NO. | REVISIONS | DATE |
|-----|-----------|------|
| 1   |           |      |
| 2   |           |      |
| 3   |           |      |
| 4   |           |      |


|                         |                    |
|-------------------------|--------------------|
| DRAWN BY: HM            | CHECKED BY: CS     |
| DATE ISSUED: 03/27/20   | SCALE: 1" = 20'-0" |
| PROJ. NO.: 1910900-1211 |                    |

SHEET NO. L7.1 OF 122  
LAYOUT PLAN - BASEBALL FIELD



ALL DESIGN, DRAWING, AND CONSTRUCTION INFORMATION IS THE PROPERTY OF VERDE DESIGN, INC. AND IS NOT TO BE REPRODUCED, COPIED, OR DISCLOSED TO ANY PERSON, FIRM, OR CORPORATION FOR ANY PURPOSE WITHOUT WRITTEN PERMISSION OF VERDE DESIGN, INC.

DRAWING NAME: Y:\projects-fa\2019\1910900 - chavez restor\CAD\LAY- Athletics.dwg  
PLOT DATE: 03-31-20 PLOTTED BY: station40

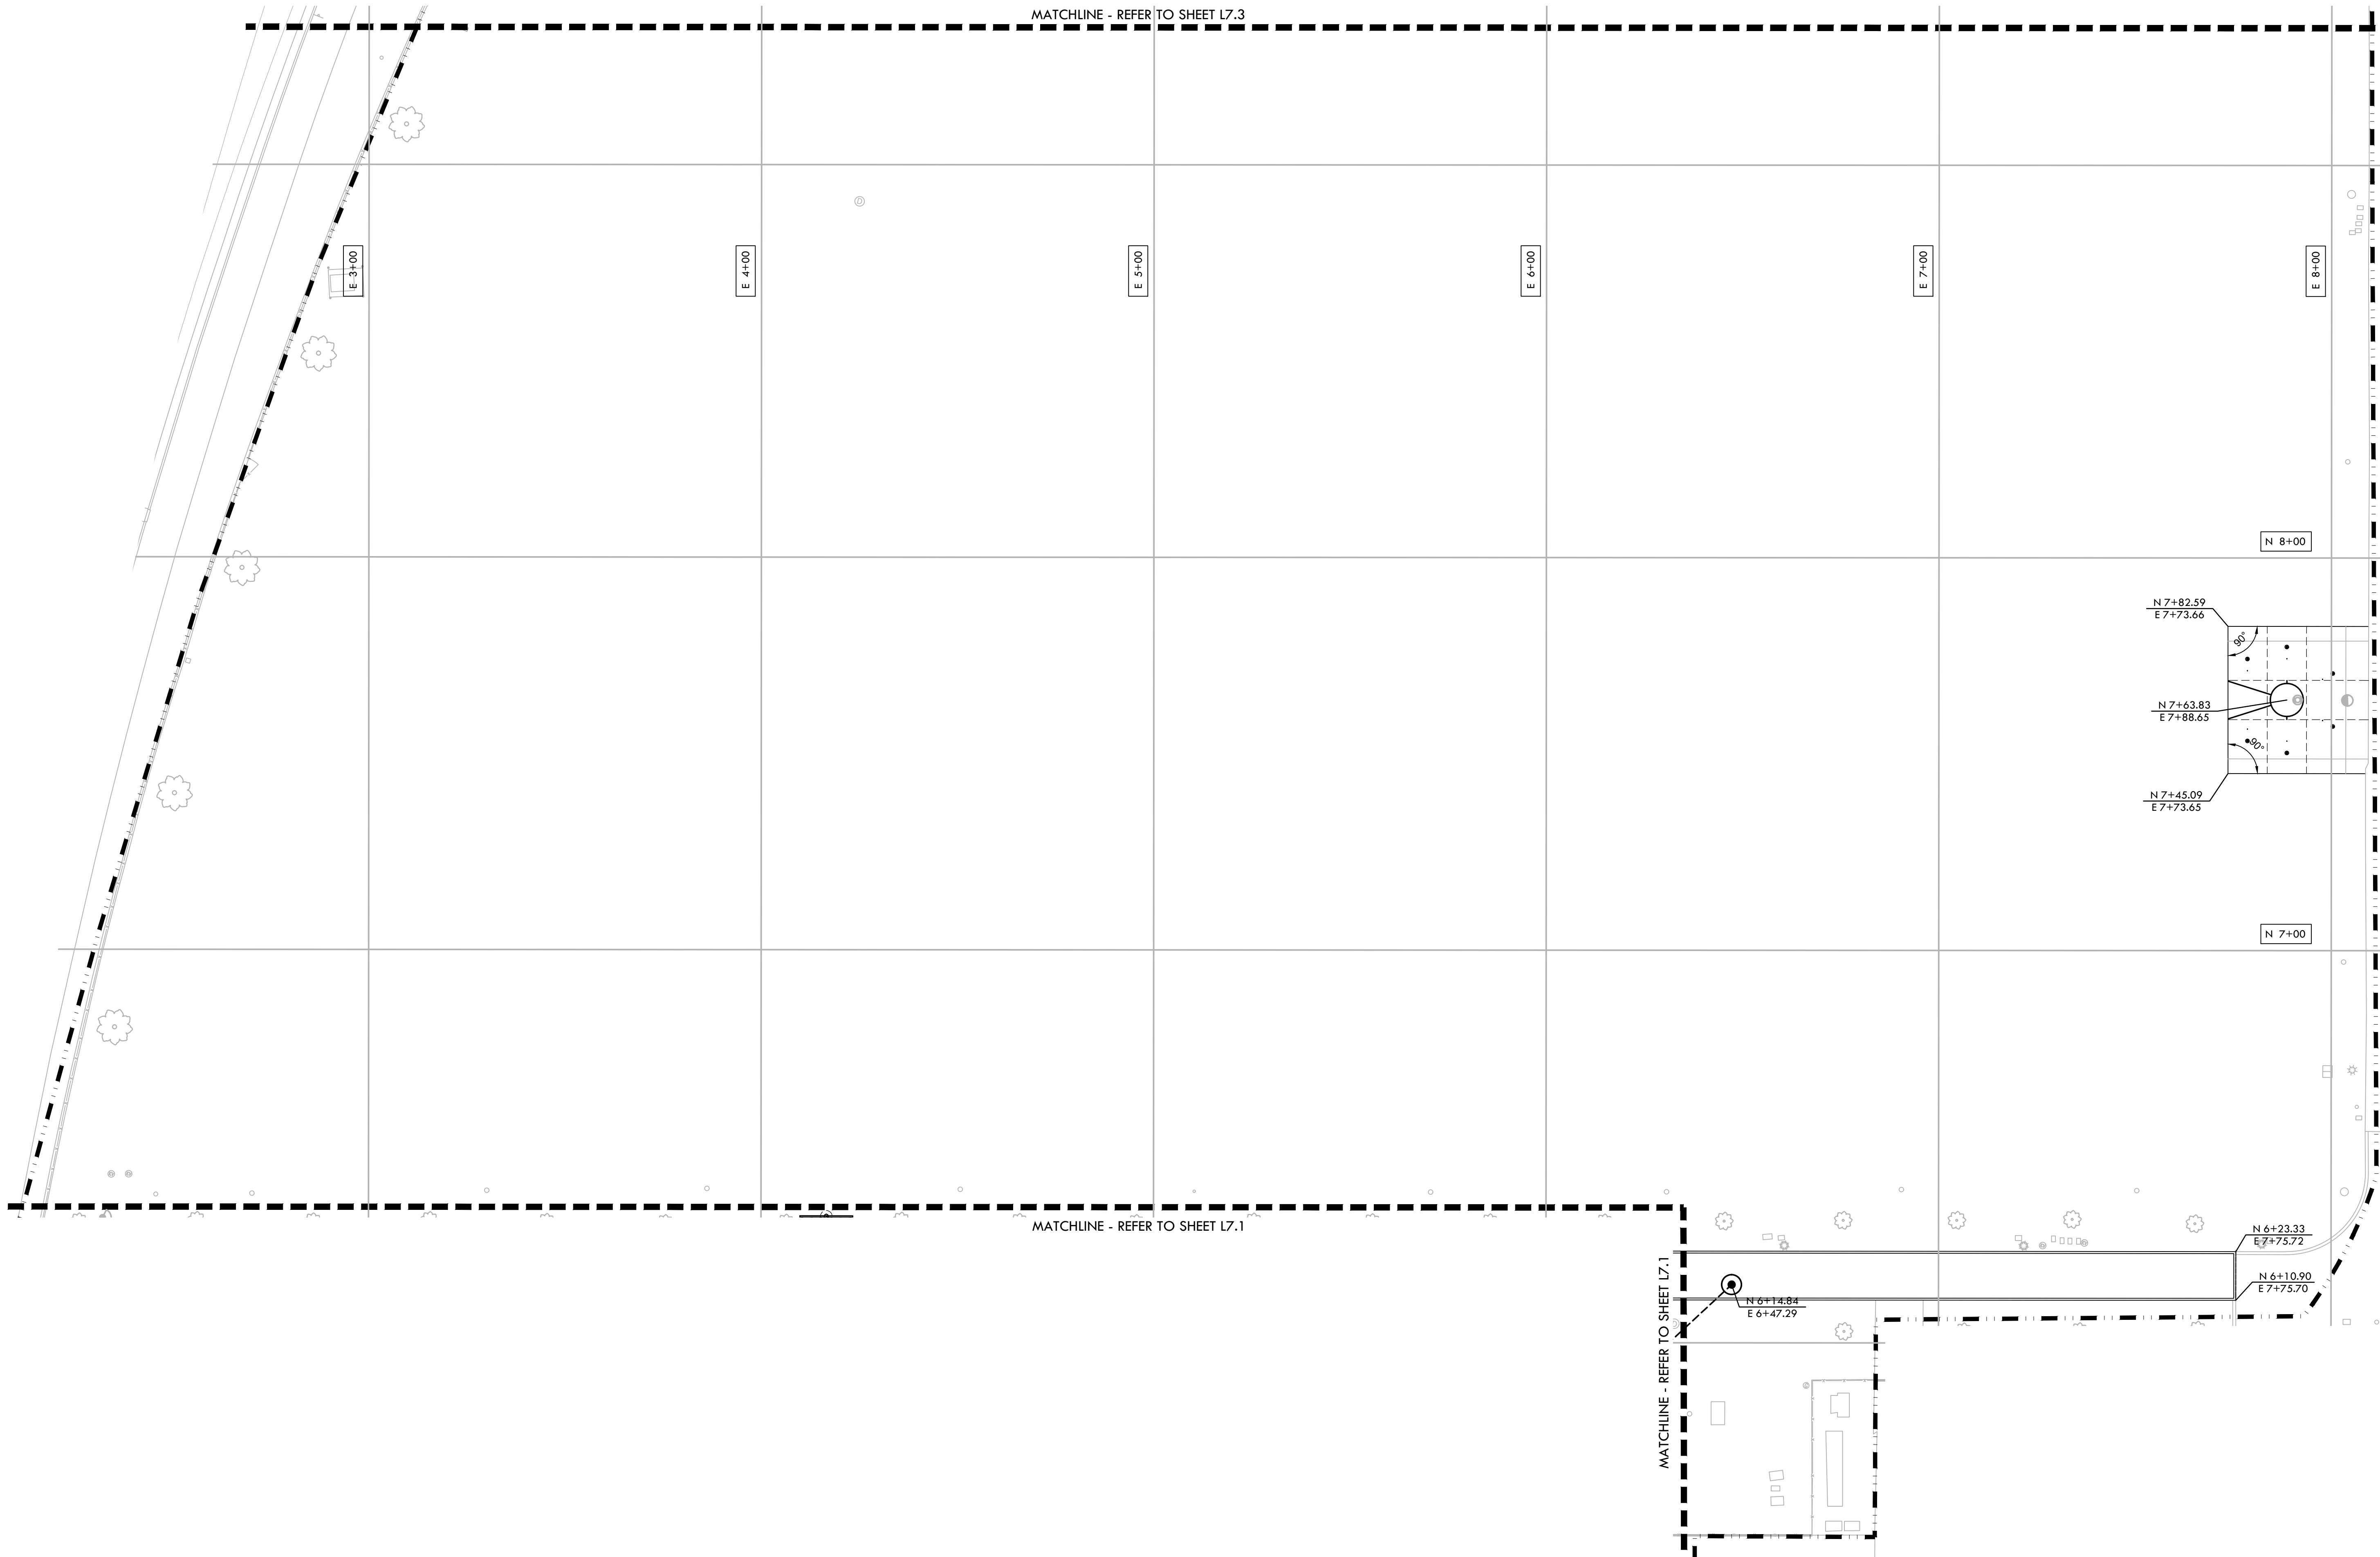

## LAYOUT NOTES

1. THE CONTRACTOR SHALL COORDINATE ALL CONSTRUCTION ELEMENTS INCLUDING UTILITY LOCATIONS AND REQUIRED SLEEVING PRIOR TO INSTALLATION. VERIFY CRITICAL DIMENSIONS, REFERENCE POINT LOCATIONS AND CONSTRUCTION CONDITIONS PRIOR TO INITIATING CONSTRUCTION. TEMPORARY BENCHMARKS OR REFERENCE POINTS SHALL BE SET BY THE CONTRACTOR AS NECESSARY. NOTIFY THE OWNER'S REPRESENTATIVE IMMEDIATELY SHOULD DISCREPANCY ARISE AND REDIRECT WORK TO AVOID DELAYS.
2. ALL DIMENSIONS SHALL BE VERIFIED IN FIELD AND CHALKED, STRING LINED OR FLAGGED BY THE CONTRACTOR PRIOR TO CONSTRUCTION. ANY MINOR ADJUSTMENTS MADE TO ACHIEVE OVERALL DESIGN LAYOUT SHALL BE ACCEPTED BY THE OWNER PRIOR TO CONSTRUCTION.
3. LAYOUT IS BASED ON THE POINT(S) OF BEGINNING (P.O.B.) AND BASELINE(S) OR GRID SYSTEM AS SHOWN. DIMENSIONS SHOWN ARE ROUNDED TO THE NEAREST INCH.
4. ALL LAYOUT AND GRADES SHALL BE COMPLETED BY A LICENSED SURVEYOR.
5. SURVEY COMPLETED BY: CAL VADA SURVEYING, INC. (FIELD COMPLETION DATE: 08/07/19)
  - 5.1. ASSESSOR'S PARCEL NO.: 130-040-03
  - 5.2. ELEVATIONS SHOWN HEREON ARE BASED UPON STOCKTON CITY BENCHMARK 341, ELEVATION 26.83 FEET (MAYO 88).  
5/8" ALUMINUM ROD DRIVEN TO REFUSAL WITH 2-1/2" DIAMETER ALUMINUM CAP STAMPED "WELL 26, L.S. 43347" IN AN ALUMINUM MONUMENT WELL WITH SCREW LOCKING COVER, BENCH MARK IN LOCATED WITHIN THE LOCKED CITY OF STOCKTON WELL SITE NO. 26, ON SOUTH SIDE OF HAMMER LN, ON THE WEST SIDE OF THE EBMUD RIGHT-OF-WAY. THE POINT LIES IN CENTER OF PAVED AREA EAST OF WELL BUILDING. CONTACT THE CITY OF STOCKTON SURVEYS SECTION FOR ACCESS.
  - 5.3. THE BEARINGS SHOWN HEREON ARE BASED UPON THE CALIFORNIA COORDINATE SYSTEM OF 1983, CC583, ZONE 3, (2017-50) IN ACCORDANCE TO THE CALIFORNIA PUBLIC RESOURCES CODE SECTIONS 8801-8819, SAID BEARINGS ARE DETERMINED LOCALLY UPON FIELD-OBSERVED TIES TO THE FOLLOWING CALIFORNIA SPATIAL REFERENCE NETWORK CONTINUOUS OPERATING REFERENCE STATIONS (C.O.R.S.):  
  
C.S.R.C. P273:  
NORTHING = 2229969.53'      EASTING = 6306178.61'  
  
C.S.R.C. P309:  
NORTHING = 2219667.30'      EASTING = 6431806.86'

## LAYOUT LEGEND

| SYM | DESCRIPTION                                |
|-----|--|
|     | LIMIT OF WORK                              |
|     | POINT OF BEGINNING (POB)                   |
|     | CONTROL POINT                              |
|     | RADIUS POINT / CENTER MARK                 |
|     | PROPOSED ANGLE BETWEEN ELEMENTS            |
|     | CENTER LINES                               |
|     | BASELINE                                   |
|     | CONTROL LINE                               |
|     | NORTHING/EASTING LAYOUT COORDINATE CALLOUT |
|     | CENTER OF GOAL POST                        |
|     | EDGE OF PAVEMENT                           |
|     | TRACK RADIUS MARKER                        |
|     | POINT OF BEGINNING                         |
|     | CENTER OF POST                             |
|     | TANGENT POINT                              |
|     | ACCESSIBLE SEATING @ PICNIC TABLES         |


IDENTIFICATION STAMP  
DIV. OF THE STATE ARCHITECT  
APP. 02-118017 INC.  
REVIEWED FOR  
SS ☒ FLS ☒ ACS ☒  
DATE: 04/10/2020

**VERDE DESIGN**  
LANDSCAPE ARCHITECTURE  
CIVIL ENGINEERING  
SPORT PLANNING & DESIGN  
1843 Iron Point Rd #140  
Folsom, CA 95630  
tel: 916.415.6554  
fax: 408.985.7260  
www.VerdeDesignInc.com



CONSULTANT

KEYMAP

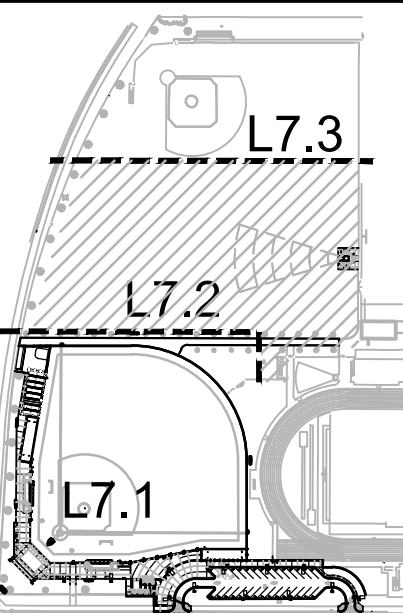

SHEET TITLE

LAYOUT PLAN -  
MULTI-USE SOUTH

PROJECT NAME

CHAVEZ HIGH SCHOOL  
STOCKTON USD  
ATHLETIC FACILITY  
IMPROVEMENTS

PROJECT ADDRESS

2929 WINDFLOWER LN  
STOCKTON, CA 95212

| SUBMITTAL               | DATE     |
|-------------------------|----------|
| DD/50% SUBMITTAL        | 10/25/19 |
| DSA SUBMITTAL           | 12/20/19 |
| DSA BACKCHECK SUBMITTAL | 03/27/20 |

| NO. | REVISIONS | DATE |
|-----|-----------|------|
| 1   |           |      |
| 2   |           |      |
| 3   |           |      |
| 4   |           |      |
| 5   |           |      |


|                           |                       |
|---------------------------|-----------------------|
| DRAWN BY:<br>HM           | CHECKED BY:<br>CS     |
| DATE ISSUED:<br>03/27/20  | SCALE:<br>1" = 20'-0" |
| PROJ. NO.<br>1910900-1211 |                       |
| SHEET NO.<br>L7.2         | OF 122                |

LAYOUT PLAN - MULTI-USE SOUTH



ALL DESIGN CONCEPTS, DIMENSIONS, AND MATERIALS OF CONSTRUCTION ARE OWNED BY AND THE PROPERTY OF VERDE DESIGN, INC. AND WERE CREATED, DEVELOPED, AND DISCLOSED FOR USE ON AND IN CONNECTION WITH THE SPECIFIED PROJECT. NONE OF SUCH IDEAS, DESIGNS, ARRANGEMENTS OR PLANS SHALL BE USED, REPRODUCED, OR PUBLISHED BY ANY METHOD, IN WHOLE OR IN PART, OR DISCLOSED TO ANY PERSON, FIRM, OR CORPORATION FOR ANY PURPOSES WITHOUT WRITTEN PERMISSION OF VERDE DESIGN, INC.

DRAWING NAME: Y:\projects-fa\2019\1910900 - chavez restor\VCAD\LAY- Athletics.dwg  
PLOT DATE: 03-31-20 PLOTTED BY: station40

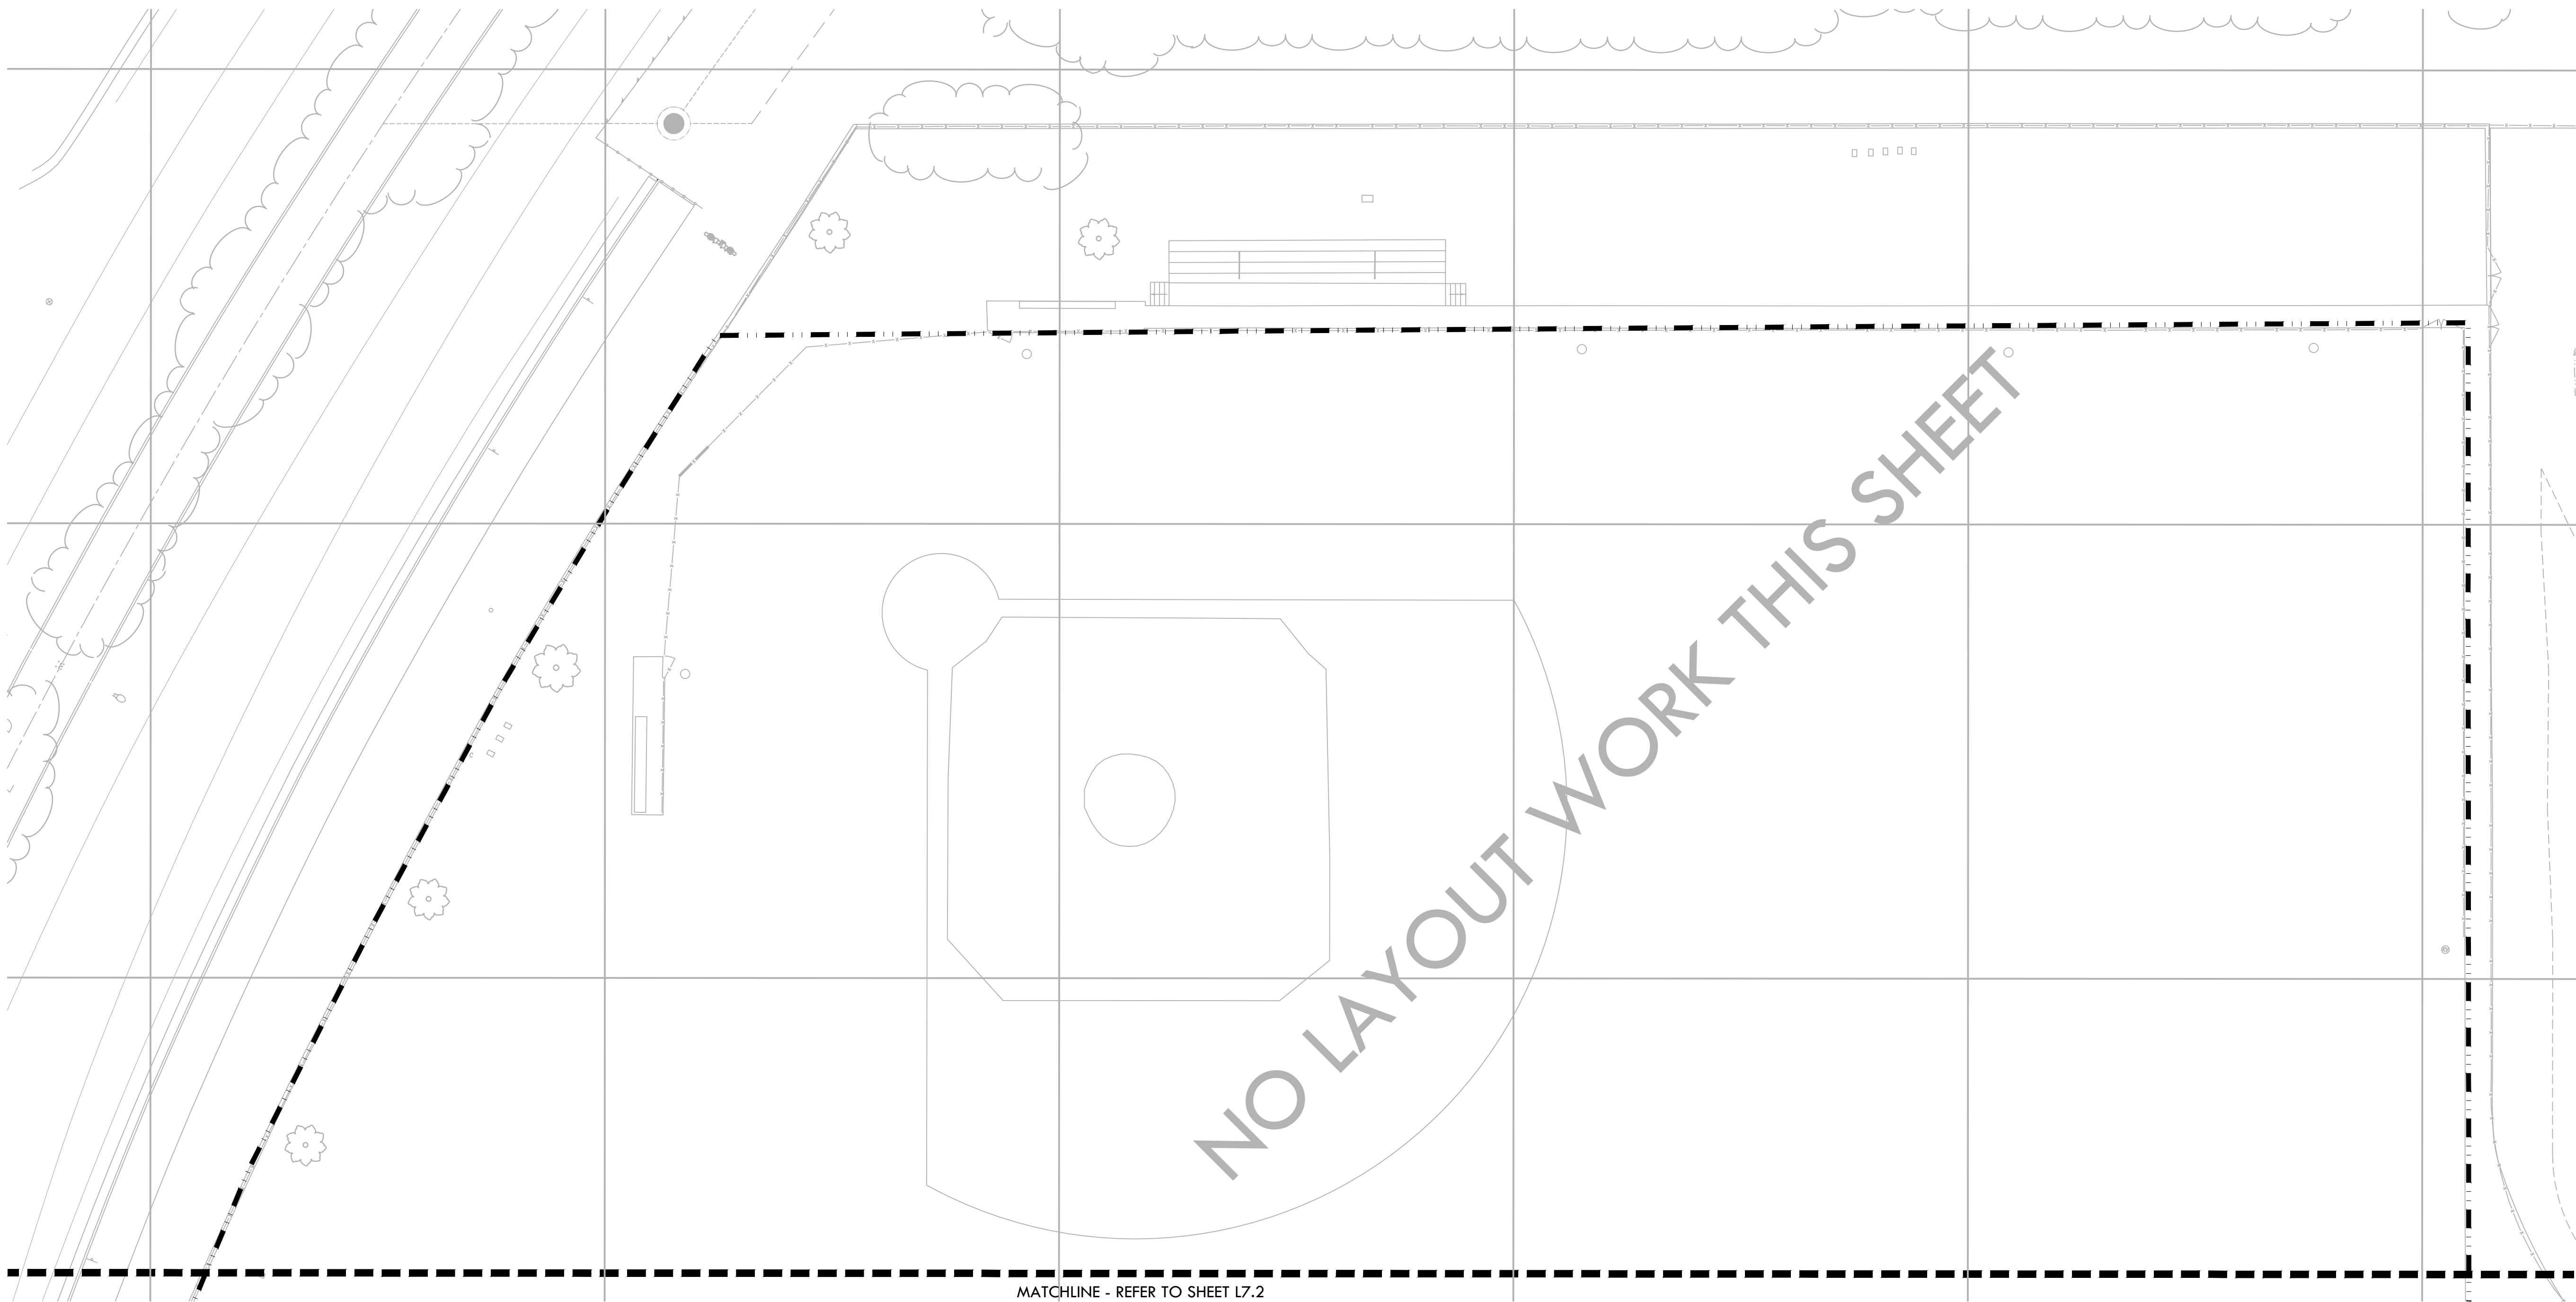

## LAYOUT NOTES

- THE CONTRACTOR SHALL COORDINATE ALL CONSTRUCTION ELEMENTS INCLUDING UTILITY LOCATIONS AND REQUIRED SLEEVING PRIOR TO INSTALLATION. VERIFY CRITICAL DIMENSIONS, REFERENCE POINT LOCATIONS AND CONSTRUCTION CONDITIONS PRIOR TO INITIATING CONSTRUCTION. TEMPORARY BENCHMARKS OR REFERENCE POINTS SHALL BE SET BY THE CONTRACTOR AS NECESSARY. NOTIFY THE OWNER'S REPRESENTATIVE IMMEDIATELY SHOULD DISCREPANCY ARISE AND REDIRECT WORK TO AVOID DELAYS.
- ALL DIMENSIONS SHALL BE VERIFIED IN FIELD AND CHALKED, STRING LINED OR FLAGGED BY THE CONTRACTOR PRIOR TO CONSTRUCTION. ANY MINOR ADJUSTMENTS MADE TO ACHIEVE OVERALL DESIGN LAYOUT SHALL BE ACCEPTED BY THE OWNER PRIOR TO CONSTRUCTION.
- LAYOUT IS BASED ON THE POINT(S) OF BEGINNING (P.O.B.) AND BASELINE(S) OR GRID SYSTEM AS SHOWN. DIMENSIONS SHOWN ARE ROUNDED TO THE NEAREST INCH.
- ALL LAYOUT AND GRADES SHALL BE COMPLETED BY A LICENSED SURVEYOR.
- SURVEY COMPLETED BY: CAL VADA SURVEYING, INC. (FIELD COMPLETION DATE: 08/07/19)
  - ASSESSOR'S PARCEL NO.: 130-040-03
  - ELEVATIONS SHOWN HEREON ARE BASED UPON STOCKTON CITY BENCHMARK 341, ELEVATION 26.83 FEET (MAYO 88):  
5/8" ALUMINUM ROD DRIVEN TO REFUSAL WITH 2-1/2" DIAMETER ALUMINUM CAP STAMPED "WELL 26, L.S. 43347" IN AN ALUMINUM MONUMENT WELL WITH SCREW LOCKING COVER, BENCH MARK IN LOCATED WITHIN THE LOCKED CITY OF STOCKTON WELL SITE NO. 26, ON SOUTH SIDE OF HAMMER LN, ON THE WEST SIDE OF THE EBMUD RIGHT-OF-WAY. THE POINT LIES IN CENTER OF PAVED AREA EAST OF WELL BUILDING. CONTACT THE CITY OF STOCKTON SURVEYS SECTION FOR ACCESS.
- THE BEARINGS SHOWN HEREON ARE BASED UPON THE CALIFORNIA COORDINATE SYSTEM OF 1983, CC583, ZONE 3, (2017-50) IN ACCORDANCE TO THE CALIFORNIA PUBLIC RESOURCES CODE SECTIONS 8801-8819, SAID BEARINGS ARE DETERMINED LOCALLY UPON FIELD-OBSERVED TIES TO THE FOLLOWING CALIFORNIA SPATIAL REFERENCE NETWORK CONTINUOUS OPERATING REFERENCE STATIONS (C.O.R.S.):  
  
C.S.R.C. P273: NORTHING = 2229969.53' EASTING = 6306178.61'  
C.S.R.C. P309: NORTHING = 2219667.30' EASTING = 6431806.86'

## LAYOUT LEGEND

| SYM | DESCRIPTION                                |
|-----|--|
|     | LIMIT OF WORK                              |
|     | POINT OF BEGINNING (POB)                   |
|     | CONTROL POINT                              |
|     | RADIUS POINT / CENTER MARK                 |
|     | PROPOSED ANGLE BETWEEN ELEMENTS            |
|     | CENTER LINES                               |
|     | BASELINE                                   |
|     | CONTROL LINE                               |
|     | NORTHING/EASTING LAYOUT COORDINATE CALLOUT |
|     | CENTER OF GOAL POST                        |
|     | EDGE OF PAVEMENT                           |
|     | TRACK RADIUS MARKER                        |
|     | POINT OF BEGINNING                         |
|     | CENTER OF POST                             |
|     | TANGENT POINT                              |
|     | ACCESSIBLE SEATING @ PICNIC TABLES         |


IDENTIFICATION STAMP  
DIV. OF THE STATE ARCHITECT  
APP. 02-118017 INC.  
REVIEWED FOR  
SS ☒ FLS ☒ ACS ☒  
DATE: 04/10/2020

**VERDE DESIGN**  
LANDSCAPE ARCHITECTURE  
CIVIL ENGINEERING  
SPORT PLANNING & DESIGN  
1843 Iron Point Rd #140  
Folsom, CA 95630  
tel: 916.415.6554  
fax: 408.985.7260  
www.VerdeDesignInc.com



CONSULTANT

KEYMAP

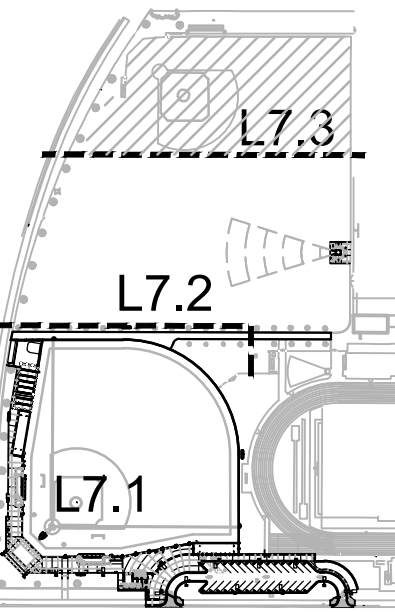

SHEET TITLE

LAYOUT PLAN -  
MULTI-USE NORTH

PROJECT NAME

CHAVEZ HIGH SCHOOL  
STOCKTON USD  
ATHLETIC FACILITY  
IMPROVEMENTS

PROJECT ADDRESS

2929 WINDFLOWER LN  
STOCKTON, CA 95212

| SUBMITTAL               | DATE     |
|-------------------------|----------|
| DD/50% SUBMITTAL        | 10/25/19 |
| DSA SUBMITTAL           | 12/20/19 |
| DSA BACKCHECK SUBMITTAL | 03/27/20 |


| NO. | REVISIONS | DATE |
|-----|-----------|------|
| 1   |           |      |
| 2   |           |      |
| 3   |           |      |
| 4   |           |      |
| 5   |           |      |

|                           |                       |
|---------------------------|-----------------------|
| DRAWN BY:<br>HM           | CHECKED BY:<br>CS     |
| DATE ISSUED:<br>03/27/20  | SCALE:<br>1" = 20'-0" |
| PROJ. NO.<br>1910900-1211 |                       |

SHEET NO.  
**L7.3** OF 122

LAYOUT PLAN- MULTI-USE NORTH



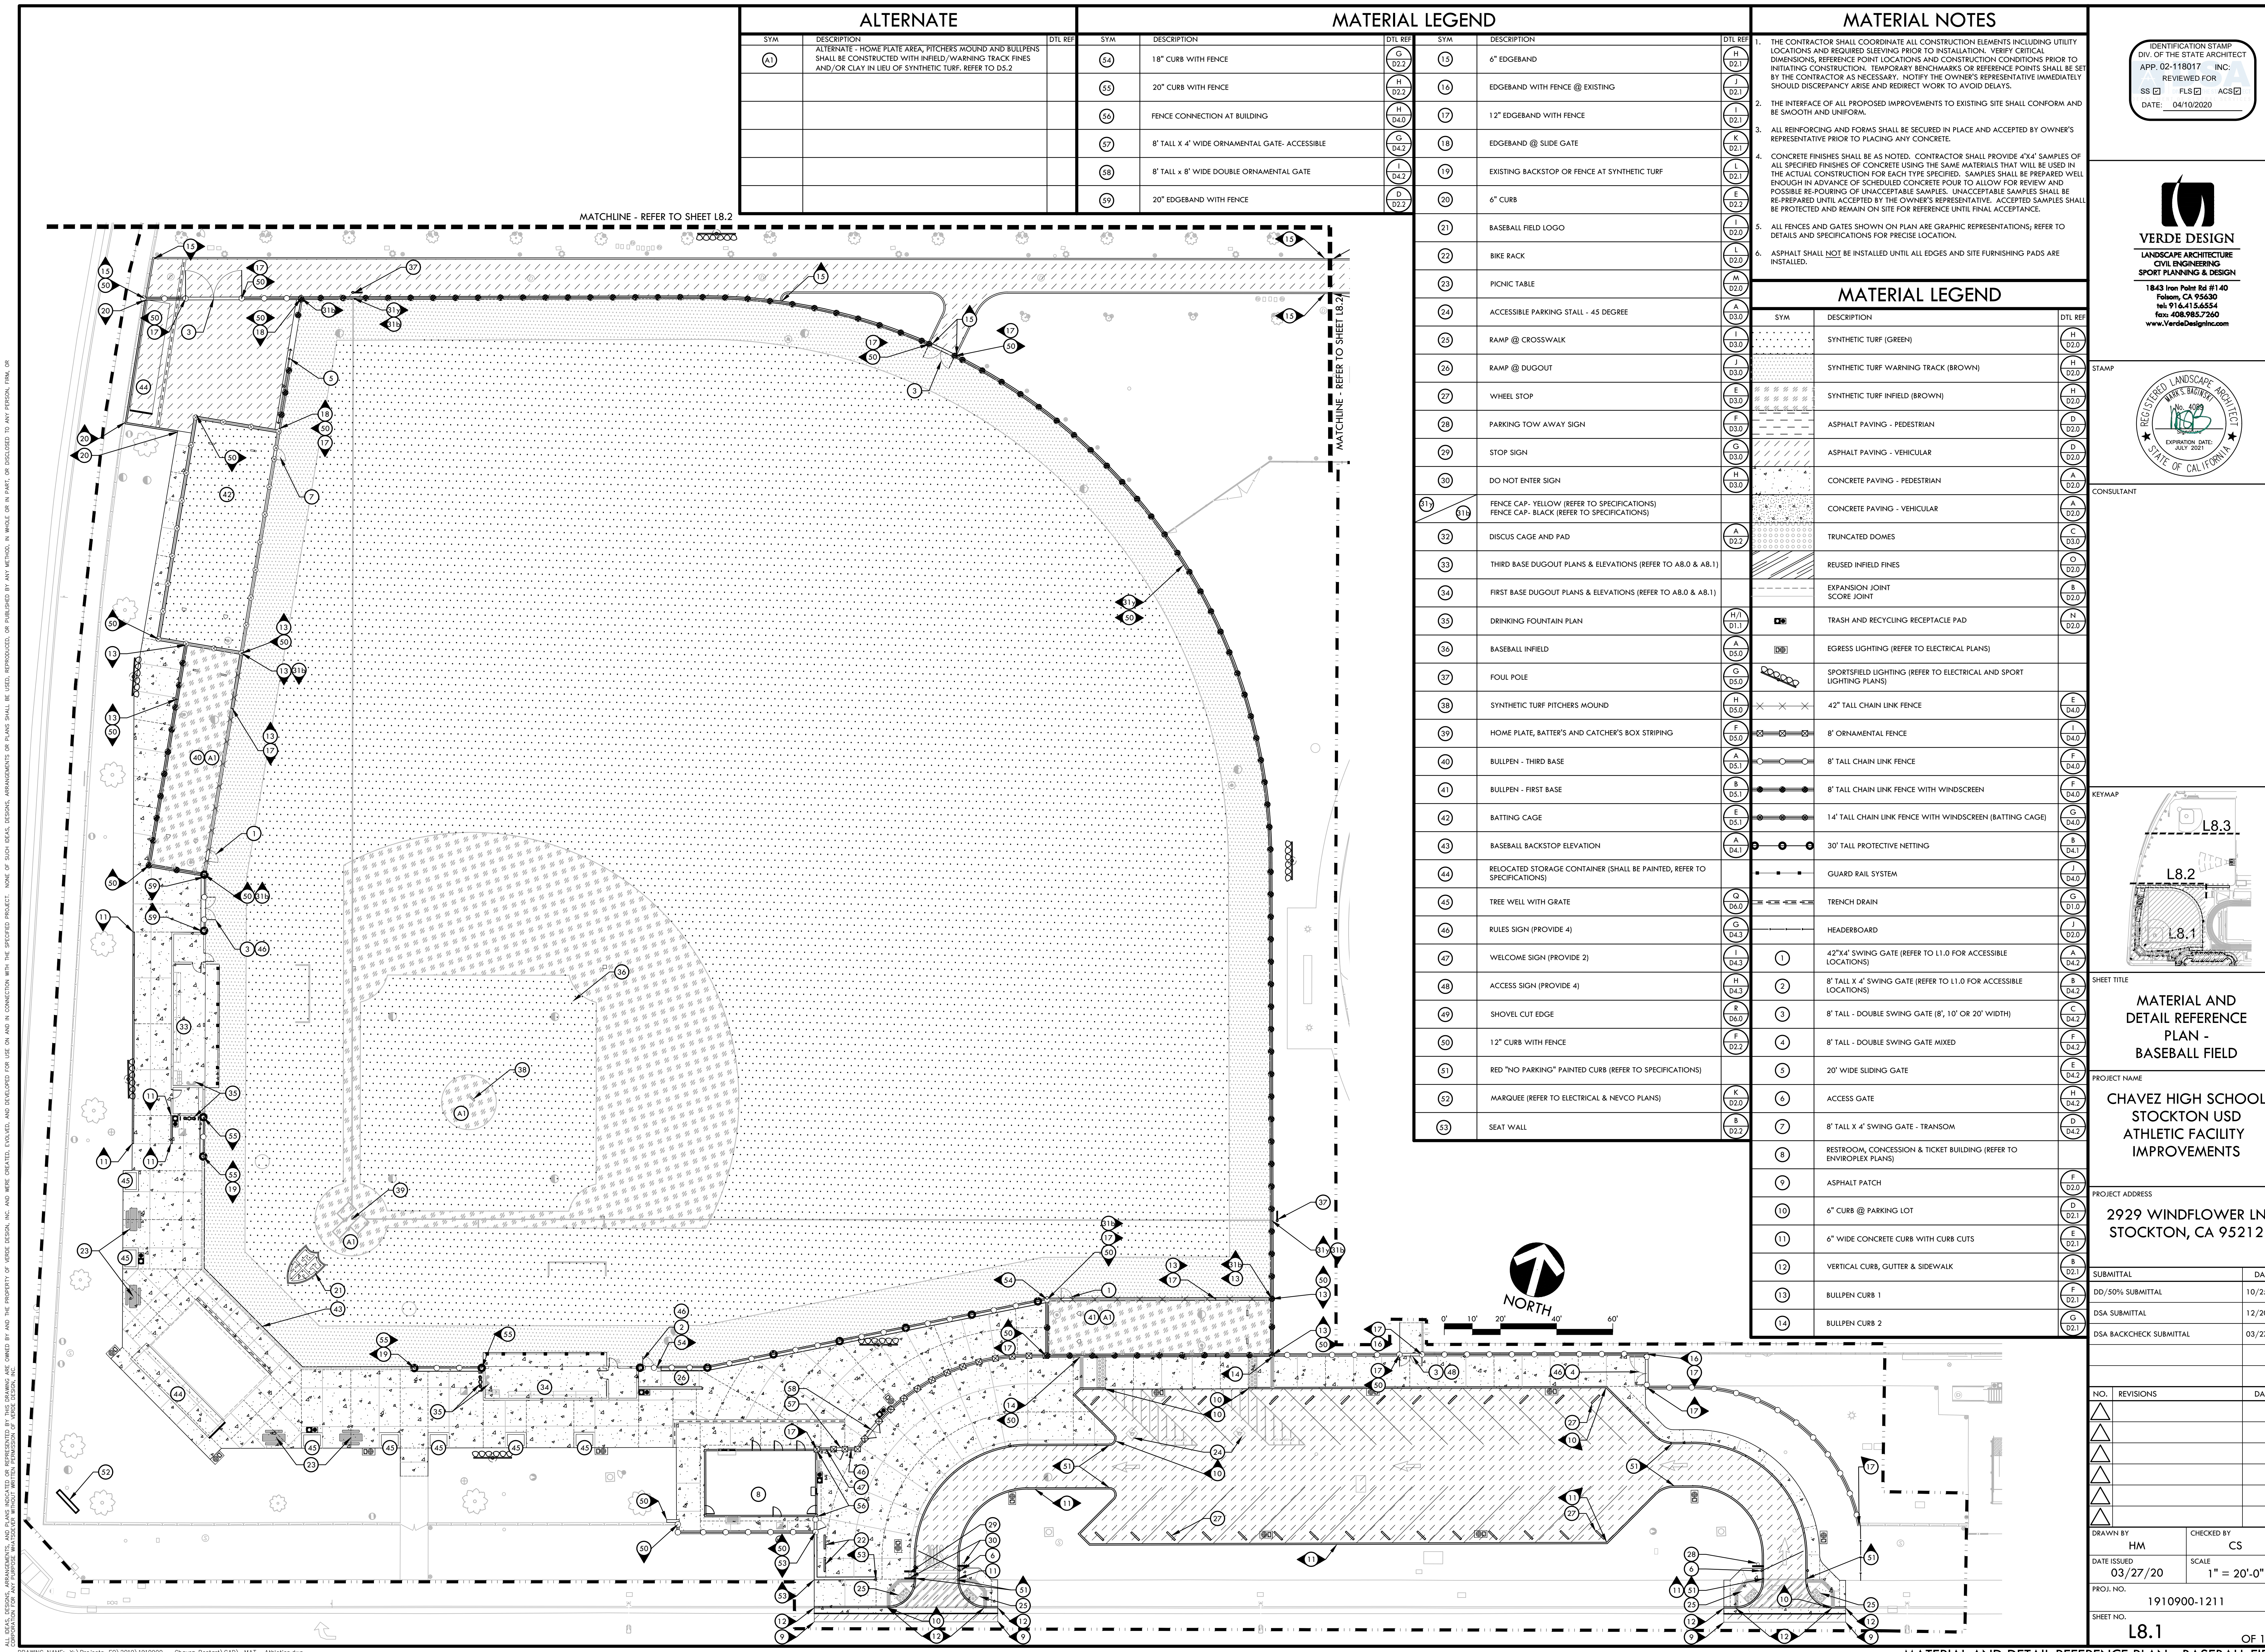

| ALTERNATE |   |         | MATERIAL LEGEND |   |         |
|-----------|---|---------|-----------------|---|---------|
| SYM       | DESCRIPTION   | DTL REF | SYM             | DESCRIPTION                                   | DTL REF |
| A1        | ALTERNATE - HOME PLATE AREA, PITCHERS MOUND AND BULLPENS SHALL BE CONSTRUCTED WITH INFIELD/WARNING TRACK FINES AND/OR CLAY IN LIEU OF SYNTHETIC TURF. REFER TO D5.2 |         | 54              | 18" CURB WITH FENCE                           | G D2.2  |
|           |   |         | 55              | 20" CURB WITH FENCE                           | H D2.2  |
|           |   |         | 56              | FENCE CONNECTION AT BUILDING                  | H D4.0  |
|           |   |         | 57              | 8' TALL X 4' WIDE ORNAMENTAL GATE- ACCESSIBLE | C D4.2  |
|           |   |         | 58              | 8' TALL X 8' WIDE DOUBLE ORNAMENTAL GATE      | I D4.2  |
|           |   |         | 59              | 20" EDGE BAND WITH FENCE                      | D D2.2  |

| MATERIAL NOTES  |  |
|---|--|
| 1. THE CONTRACTOR SHALL COORDINATE ALL CONSTRUCTION ELEMENTS INCLUDING UTILITY LOCATIONS AND REQUIRED SLEEVING PRIOR TO INSTALLATION. VERIFY CRITICAL DIMENSIONS, REFERENCE POINT LOCATIONS AND CONSTRUCTION CONDITIONS PRIOR TO INITIATING CONSTRUCTION. TEMPORARY BENCHMARKS OR REFERENCE POINTS SHALL BE SET BY THE CONTRACTOR AS NECESSARY. NOTIFY THE OWNER'S REPRESENTATIVE IMMEDIATELY SHOULD DISCREPANCY ARISE AND REDIRECT WORK TO AVOID DELAYS.   |  |
| 2. THE INTERFACE OF ALL PROPOSED IMPROVEMENTS TO EXISTING SITE SHALL CONFORM AND BE SMOOTH AND UNIFORM.   |  |
| 3. ALL REINFORCING AND FORMS SHALL BE SECURED IN PLACE AND ACCEPTED BY OWNER'S REPRESENTATIVE PRIOR TO PLACING ANY CONCRETE.  |  |
| 4. CONCRETE FINISHES SHALL BE AS NOTED. CONTRACTOR SHALL PROVIDE 4"x4" SAMPLES OF ALL SPECIFIED FINISHES OF CONCRETE USING THE SAME MATERIALS THAT WILL BE USED IN THE ACTUAL CONSTRUCTION FOR EACH TYPE SPECIFIED. SAMPLES SHALL BE PREPARED WELL ENOUGH IN ADVANCE OF SCHEDULED CONCRETE POUR TO ALLOW FOR REVIEW AND POSSIBLE RE-POURING OF UNACCEPTABLE SAMPLES. UNACCEPTABLE SAMPLES SHALL BE RE-PREPARED UNTIL ACCEPTED BY THE OWNER'S REPRESENTATIVE. ACCEPTED SAMPLES SHALL BE PROTECTED AND REMAIN ON SITE FOR REFERENCE UNTIL FINAL ACCEPTANCE. |  |
| 5. ALL FENCES AND GATES SHOWN ON PLAN ARE GRAPHIC REPRESENTATIONS; REFER TO DETAILS AND SPECIFICATIONS FOR PRECISE LOCATION.  |  |
| 6. ASPHALT SHALL NOT BE INSTALLED UNTIL ALL EDGES AND SITE FURNISHING PADS ARE INSTALLED.   |  |


| MATERIAL LEGEND |   |         |
|-----------------|---|---------|
| SYM             | DESCRIPTION   | DTL REF |
|                 | SYNTHETIC TURF (GREEN)  | H D2.0  |
|                 | SYNTHETIC TURF WARNING TRACK (BROWN)                                | H D2.0  |
|                 | SYNTHETIC TURF INFIELD (BROWN)                                      | H D2.0  |
|                 | ASPHALT PAVING - PEDESTRIAN   | D D2.0  |
|                 | ASPHALT PAVING - VEHICULAR  | D D2.0  |
|                 | CONCRETE PAVING - PEDESTRIAN  | A D2.0  |
|                 | CONCRETE PAVING - VEHICULAR   | A D2.0  |
|                 | TRUNCATED DOMES   | C D3.0  |
|                 | REUSED INFELD FINES   | D D2.0  |
|                 | EXPANSION JOINT SCORE JOINT   | B D2.0  |
|                 | TRASH AND RECYCLING RECEPTACLE PAD                                  | N D2.0  |
|                 | EGRESS LIGHTING (REFER TO ELECTRICAL PLANS)                         |         |
|                 | SPORTSFIELD LIGHTING (REFER TO ELECTRICAL AND SPORT LIGHTING PLANS) |         |
|                 | 42" TALL CHAIN LINK FENCE   | E D4.0  |
|                 | 8' ORNAMENTAL FENCE   | I D4.0  |
|                 | 8' TALL CHAIN LINK FENCE  | F D4.0  |
|                 | 8' TALL CHAIN LINK FENCE WITH WINDSCREEN                            | F D4.0  |
|                 | 14' TALL CHAIN LINK FENCE WITH WINDSCREEN (BATTING CAGE)            | G D4.0  |
|                 | 30' TALL PROTECTIVE NETTING   | B D4.1  |
|                 | GUARD RAIL SYSTEM   | J D4.0  |
|                 | TRENCH DRAIN  | G D1.0  |
|                 | HEADERBOARD   | J D2.0  |
|                 | 42"x4" SWING GATE (REFER TO L1.0 FOR ACCESSIBLE LOCATIONS)          | A D4.2  |
|                 | 8' TALL X 4' SWING GATE (REFER TO L1.0 FOR ACCESSIBLE LOCATIONS)    | B D4.2  |
|                 | 8' TALL - DOUBLE SWING GATE (8', 10' OR 20' WIDTH)                  | C D4.2  |
|                 | 8' TALL - DOUBLE SWING GATE MIXED                                   | F D4.2  |
|                 | 20' WIDE SLIDING GATE   | E D4.2  |
|                 | ACCESS GATE   | H D4.2  |
|                 | 8' TALL X 4' SWING GATE - TRANSOM                                   | D D4.2  |
|                 | RESTROOM, CONCESSION & TICKET BUILDING (REFER TO ENVIROPLEX PLANS)  |         |
|                 | ASPHALT PATCH   | F D2.0  |
|                 | 6" CURB @ PARKING LOT   | D D2.1  |
|                 | 6" WIDE CONCRETE CURB WITH CURB CUTS                                | E D2.1  |
|                 | VERTICAL CURB, GUTTER & SIDEWALK                                    | B D2.1  |
|                 | BULLPEN CURB 1  | F D2.1  |
|                 | BULLPEN CURB 2  | G D2.1  |

IDENTIFICATION STAMP  
DIV. OF THE STATE ARCHITECT  
APP. 02-118017 INC.  
REVIEWED FOR  
SS ☐ FLS ☐ ACS ☐  
DATE: 04/10/2020

**VERDE DESIGN**  
LANDSCAPE ARCHITECTURE  
CIVIL ENGINEERING  
SPORT PLANNING & DESIGN  
1843 Iron Point Rd #140  
Folsom, CA 95630  
tel: 916.415.6554  
fax: 916.985.7260  
www.VerdeDesignInc.com



CONSULTANT

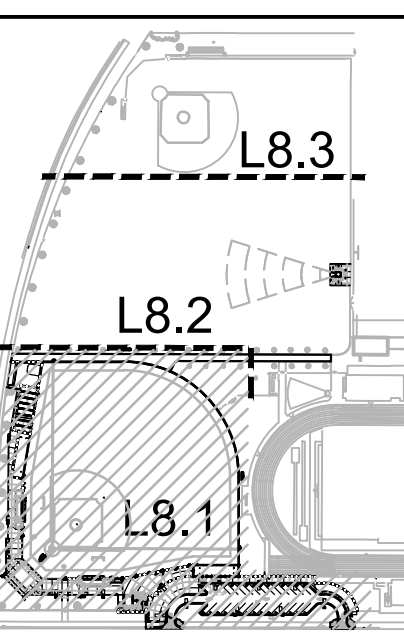

SHEET TITLE  
**MATERIAL AND  
DETAIL REFERENCE  
PLAN -  
BASEBALL FIELD**

PROJECT NAME  
**CHAVEZ HIGH SCHOOL  
STOCKTON USD  
ATHLETIC FACILITY  
IMPROVEMENTS**

PROJECT ADDRESS  
**2929 WINDFLOWER LN  
STOCKTON, CA 95212**

| SUBMITTAL               | DATE     |
|-------------------------|----------|
| DD/50% SUBMITTAL        | 10/25/19 |
| DSA SUBMITTAL           | 12/20/19 |
| DSA BACKCHECK SUBMITTAL | 03/27/20 |

| NO. | REVISIONS | DATE |
|-----|-----------|------|
| 1   |           |      |
| 2   |           |      |
| 3   |           |      |
| 4   |           |      |

|                           |                      |
|---------------------------|----------------------|
| DRAWN BY<br>HM            | CHECKED BY<br>CS     |
| DATE ISSUED<br>03/27/20   | SCALE<br>1" = 20'-0" |
| PROJ. NO.<br>1910900-1211 |                      |
| SHEET NO.<br>L8.1         | OF 122               |

ALL DESIGN, CONSTRUCTION, AND MATERIALS SPECIFICATIONS ARE THE PROPERTY OF VERDE DESIGN, INC. AND ARE NOT TO BE REPRODUCED, COPIED, OR DISCLOSED TO ANY PERSON, FIRM, OR CORPORATION FOR ANY PURPOSE WITHOUT WRITTEN PERMISSION OF VERDE DESIGN, INC.



ALL DESIGN, CONSTRUCTION, AND/OR MATERIALS SPECIFICATIONS ARE THE PROPERTY OF VERDE DESIGN, INC. AND WERE CREATED, EVOLVED, AND DEVELOPED FOR USE ON AND IN CONNECTION WITH THE SPECIFIED PROJECT. NONE OF SUCH IDEAS, DESIGNS, ARRANGEMENTS OR PLANS SHALL BE USED, REPRODUCED, OR PUBLISHED BY ANY METHOD, IN WHOLE OR IN PART, OR DISCLOSED TO ANY PERSON, FIRM, OR CORPORATION FOR ANY PURPOSE WITHOUT THE WRITTEN PERMISSION OF VERDE DESIGN, INC.

| ALTERNATE |   |         |
|-----------|---|---------|
| SYM       | DESCRIPTION   | DTL REF |
| A1        | ALTERNATE - HOME PLATE AREA, PITCHERS MOUND AND BULLPENS SHALL BE CONSTRUCTED WITH INFIELD/WARNING TRACK FINES AND/OR CLAY IN LIEU OF SYNTHETIC TURF. REFER TO D5.2 |         |
|           |   |         |
|           |   |         |
|           |   |         |
|           |   |         |

| MATERIAL LEGEND |   |         |      |   |           |
|-----------------|---|---------|------|---|-----------|
| SYM             | DESCRIPTION   | DTL REF | SYM  | DESCRIPTION   | DTL REF   |
| 49              | SHOVEL CUT EDGE   | R D6.0  | 32   | DISCUS CAGE AND PAD   | A D2.2    |
| 50              | 12" CURB WITH FENCE                                     | F D2.2  | 33   | THIRD BASE DUGOUT PLANS & ELEVATIONS (REFER TO A8.0 & A8.1)             |           |
| 51              | RED "NO PARKING" PAINTED CURB (REFER TO SPECIFICATIONS) |         | 34   | FIRST BASE DUGOUT PLANS & ELEVATIONS (REFER TO A8.0 & A8.1)             |           |
| 52              | MARQUEE (REFER TO ELECTRICAL & NEVCO PLANS)             | K D2.0  | 35   | DRINKING FOUNTAIN PLAN  | 11/1 D1.1 |
| 53              | SEAT WALL   | B D2.2  | 36   | BASEBALL INFIELD  | A D5.0    |
| 54              | 18" CURB WITH FENCE                                     | G D2.2  | 37   | FOUL POLE   | G D5.0    |
| 55              | 20" CURB WITH FENCE                                     | H D2.2  | 38   | SYNTHETIC TURF PITCHERS MOUND   | H D5.0    |
| 56              | FENCE CONNECTION AT BUILDING                            | H D4.0  | 39   | HOME PLATE, BATTER'S AND CATCHER'S BOX STRIPING                         | F D5.0    |
| 57              | 8' TALL X 4' WIDE ORNAMENTAL GATE - ACCESSIBLE          | G D4.2  | 40   | BULLPEN - THIRD BASE  | A D5.1    |
| 58              | 8' TALL x 8' WIDE DOUBLE ORNAMENTAL GATE                | I D4.2  | 41   | BULLPEN - FIRST BASE  | B D5.1    |
| 59              | 20" EDGEBAND WITH FENCE                                 | D D2.2  | 42   | BATTING CAGE  | E D5.1    |
|                 |   |         | 43   | BASEBALL BACKSTOP ELEVATION   | A D4.1    |
|                 |   |         | 44   | RELOCATED STORAGE CONTAINER (SHALL BE PAINTED, REFER TO SPECIFICATIONS) |           |
|                 |   |         | 45   | TREE WELL WITH GRATE  | D D6.0    |
|                 |   |         | 46   | RULES SIGN (PROVIDE 4)  | G D4.3    |
|                 |   |         | 47   | WELCOME SIGN (PROVIDE 2)  | I D4.3    |
|                 |   |         | 48   | ACCESS SIGN (PROVIDE 4)   | H D4.3    |
|                 |   |         | 61/1 | FENCE CAP - YELLOW (REFER TO SPECIFICATIONS)                            |           |
|                 |   |         | 61/2 | FENCE CAP - BLACK (REFER TO SPECIFICATIONS)                             |           |

| MATERIAL NOTES  |  |
|---|--|
| 1. THE CONTRACTOR SHALL COORDINATE ALL CONSTRUCTION ELEMENTS INCLUDING UTILITY LOCATIONS AND REQUIRED SLEEPING PRIOR TO INSTALLATION. VERIFY CRITICAL DIMENSIONS, REFERENCE POINT LOCATIONS AND CONSTRUCTION CONDITIONS PRIOR TO INITIATING CONSTRUCTION. TEMPORARY BENCHMARKS OR REFERENCE POINTS SHALL BE SET BY THE CONTRACTOR AS NECESSARY. NOTIFY THE OWNER'S REPRESENTATIVE IMMEDIATELY SHOULD DISCREPANCY ARISE AND REDIRECT WORK TO AVOID DELAYS.   |  |
| 2. THE INTERFACE OF ALL PROPOSED IMPROVEMENTS TO EXISTING SITE SHALL CONFORM AND BE SMOOTH AND UNIFORM.   |  |
| 3. ALL REINFORCING AND FORMS SHALL BE SECURED IN PLACE AND ACCEPTED BY OWNER'S REPRESENTATIVE PRIOR TO PLACING ANY CONCRETE.  |  |
| 4. CONCRETE FINISHES SHALL BE AS NOTED. CONTRACTOR SHALL PROVIDE 4"x4" SAMPLES OF ALL SPECIFIED FINISHES OF CONCRETE USING THE SAME MATERIALS THAT WILL BE USED IN THE ACTUAL CONSTRUCTION FOR EACH TYPE SPECIFIED. SAMPLES SHALL BE PREPARED WELL ENOUGH IN ADVANCE OF SCHEDULED CONCRETE POUR TO ALLOW FOR REVIEW AND POSSIBLE RE-POURING OF UNACCEPTABLE SAMPLES. UNACCEPTABLE SAMPLES SHALL BE RE-PREPARED UNTIL ACCEPTED BY THE OWNER'S REPRESENTATIVE. ACCEPTED SAMPLES SHALL BE PROTECTED AND REMAIN ON SITE FOR REFERENCE UNTIL FINAL ACCEPTANCE. |  |
| 5. ALL FENCES AND GATES SHOWN ON PLAN ARE GRAPHIC REPRESENTATIONS; REFER TO DETAILS AND SPECIFICATIONS FOR PRECISE LOCATION.  |  |
| 6. ASPHALT SHALL NOT BE INSTALLED UNTIL ALL EDGES AND SITE FURNISHING PADS ARE INSTALLED.   |  |

| MATERIAL LEGEND |   |         |
|-----------------|---|---------|
| SYM             | DESCRIPTION   | DTL REF |
|                 | SYNTHETIC TURF (GREEN)  | H D2.0  |
|                 | SYNTHETIC TURF WARNING TRACK (BROWN)                                | H D2.0  |
|                 | SYNTHETIC TURF INFIELD (BROWN)                                      | H D2.0  |
|                 | ASPHALT PAVING - PEDESTRIAN   | D D2.0  |
|                 | ASPHALT PAVING - VEHICULAR  | D D2.0  |
|                 | CONCRETE PAVING - PEDESTRIAN  | A D2.0  |
|                 | CONCRETE PAVING - VEHICULAR   | A D2.0  |
|                 | TRUNCATED DOMES   | C D3.0  |
|                 | REUSED INFELD FINES   | D D2.0  |
|                 | EXPANSION JOINT SCORE JOINT   | B D2.0  |
|                 | TRASH AND RECYCLING RECEPTACLE PAD                                  | N D2.0  |
|                 | EGRESS LIGHTING (REFER TO ELECTRICAL PLANS)                         |         |
|                 | SPORTSFIELD LIGHTING (REFER TO ELECTRICAL AND SPORT LIGHTING PLANS) |         |
|                 | 42" TALL CHAIN LINK FENCE   | E D4.0  |
|                 | 8' ORNAMENTAL FENCE   | I D4.0  |
|                 | 8' TALL CHAIN LINK FENCE  | F D4.0  |
|                 | 8' TALL CHAIN LINK FENCE WITH WINDSCREEN                            | F D4.0  |
|                 | 14' TALL CHAIN LINK FENCE WITH WINDSCREEN (BATTING CAGE)            | G D4.0  |
|                 | 30' TALL PROTECTIVE NETTING   | B D4.1  |
|                 | GUARD RAIL SYSTEM   | J D4.0  |
|                 | TRENCH DRAIN  | G D1.0  |
|                 | HEADERBOARD   | J D2.0  |
| 1               | 42"x4' SWING GATE (REFER TO L1.0 FOR ACCESSIBLE LOCATIONS)          | A D4.2  |
| 2               | 8' TALL X 4' SWING GATE (REFER TO L1.0 FOR ACCESSIBLE LOCATIONS)    | B D4.2  |
| 3               | 8' TALL - DOUBLE SWING GATE (8', 10' OR 20' WIDTH)                  | C D4.2  |
| 4               | 8' TALL - DOUBLE SWING GATE MIXED                                   | F D4.2  |
| 5               | 20' WIDE SLIDING GATE   | E D4.2  |
| 6               | ACCESS GATE   | H D4.2  |
| 7               | 8' TALL X 4' SWING GATE - TRANSOM                                   | D D4.2  |
| 8               | RESTROOM, CONCESSION & TICKET BUILDING (REFER TO ENVIROPLEX PLANS)  |         |
| 9               | ASPHALT PATCH   | F D2.0  |
| 10              | 6" CURB @ PARKING LOT   | D D2.1  |
| 11              | 6" WIDE CONCRETE CURB WITH CURB CUTS                                | E D2.1  |
| 12              | VERTICAL CURB, GUTTER & SIDEWALK                                    | B D2.1  |
| 13              | BULLPEN CURB 1  | F D2.1  |
| 14              | BULLPEN CURB 2  | G D2.1  |

IDENTIFICATION STAMP  
DIV. OF THE STATE ARCHITECT  
APP. 02-118017 INC.  
REVIEWED FOR  
SS ☐ FLS ☐ ACS ☐  
DATE: 04/10/2020

VERDE DESIGN

LANDSCAPE ARCHITECTURE  
CIVIL ENGINEERING  
SPORT PLANNING & DESIGN  
1843 Iron Point Rd #140  
Folsom, CA 95630  
tel: 916.415.6554  
fax: 916.985.7260  
www.VerdeDesignInc.com

STAMP

REGISTERED LANDSCAPE ARCHITECT  
MARK S. BARNER  
No. 1093  
EXPIRATION DATE: JULY 2021  
STATE OF CALIFORNIA

CONSULTANT

KEYMAP

SHEET TITLE

PROJECT NAME

PROJECT ADDRESS

SUBMITTAL

NO. REVISIONS

DRAWN BY

DATE ISSUED

PROJ. NO.

SHEET NO.

MATERIAL AND  
DETAIL REFERENCE  
PLAN -  
MULTI-USE SOUTH

CHAVEZ HIGH SCHOOL  
STOCKTON USD  
ATHLETIC FACILITY  
IMPROVEMENTS

2929 WINDFLOWER LN  
STOCKTON, CA 95212

DATE

10/25/19

12/20/19

03/27/20

DATE

CHECKED BY

SCALE

1910900-1211

L8.2


OF 122

DRAWING NAME: Y:\Projects\FO\2019\1910900 - Chavez Restor\CAD\MAT - Athletics.dwg  
PLOT DATE: 03-30-20 PLOTTED BY: station40

MATERIAL AND DETAIL REFERENCE PLAN - MULTI-USE SOUTH



ALL DESIGN, CONSTRUCTION, AND/OR MATERIALS OF THIS PROJECT ARE THE PROPERTY OF VERDE DESIGN, INC. AND WERE CREATED, EVOLVED, AND DEVELOPED FOR USE ON AND IN CONNECTION WITH THE SPECIFIED PROJECT. NONE OF SUCH IDEAS, DESIGNS, ARRANGEMENTS OR PLANS SHALL BE USED, REPRODUCED, OR PUBLISHED BY ANY METHOD, IN WHOLE OR IN PART, OR DISCLOSED TO ANY PERSON, FIRM, OR CORPORATION FOR ANY PURPOSE WITHOUT THE WRITTEN PERMISSION OF VERDE DESIGN, INC.

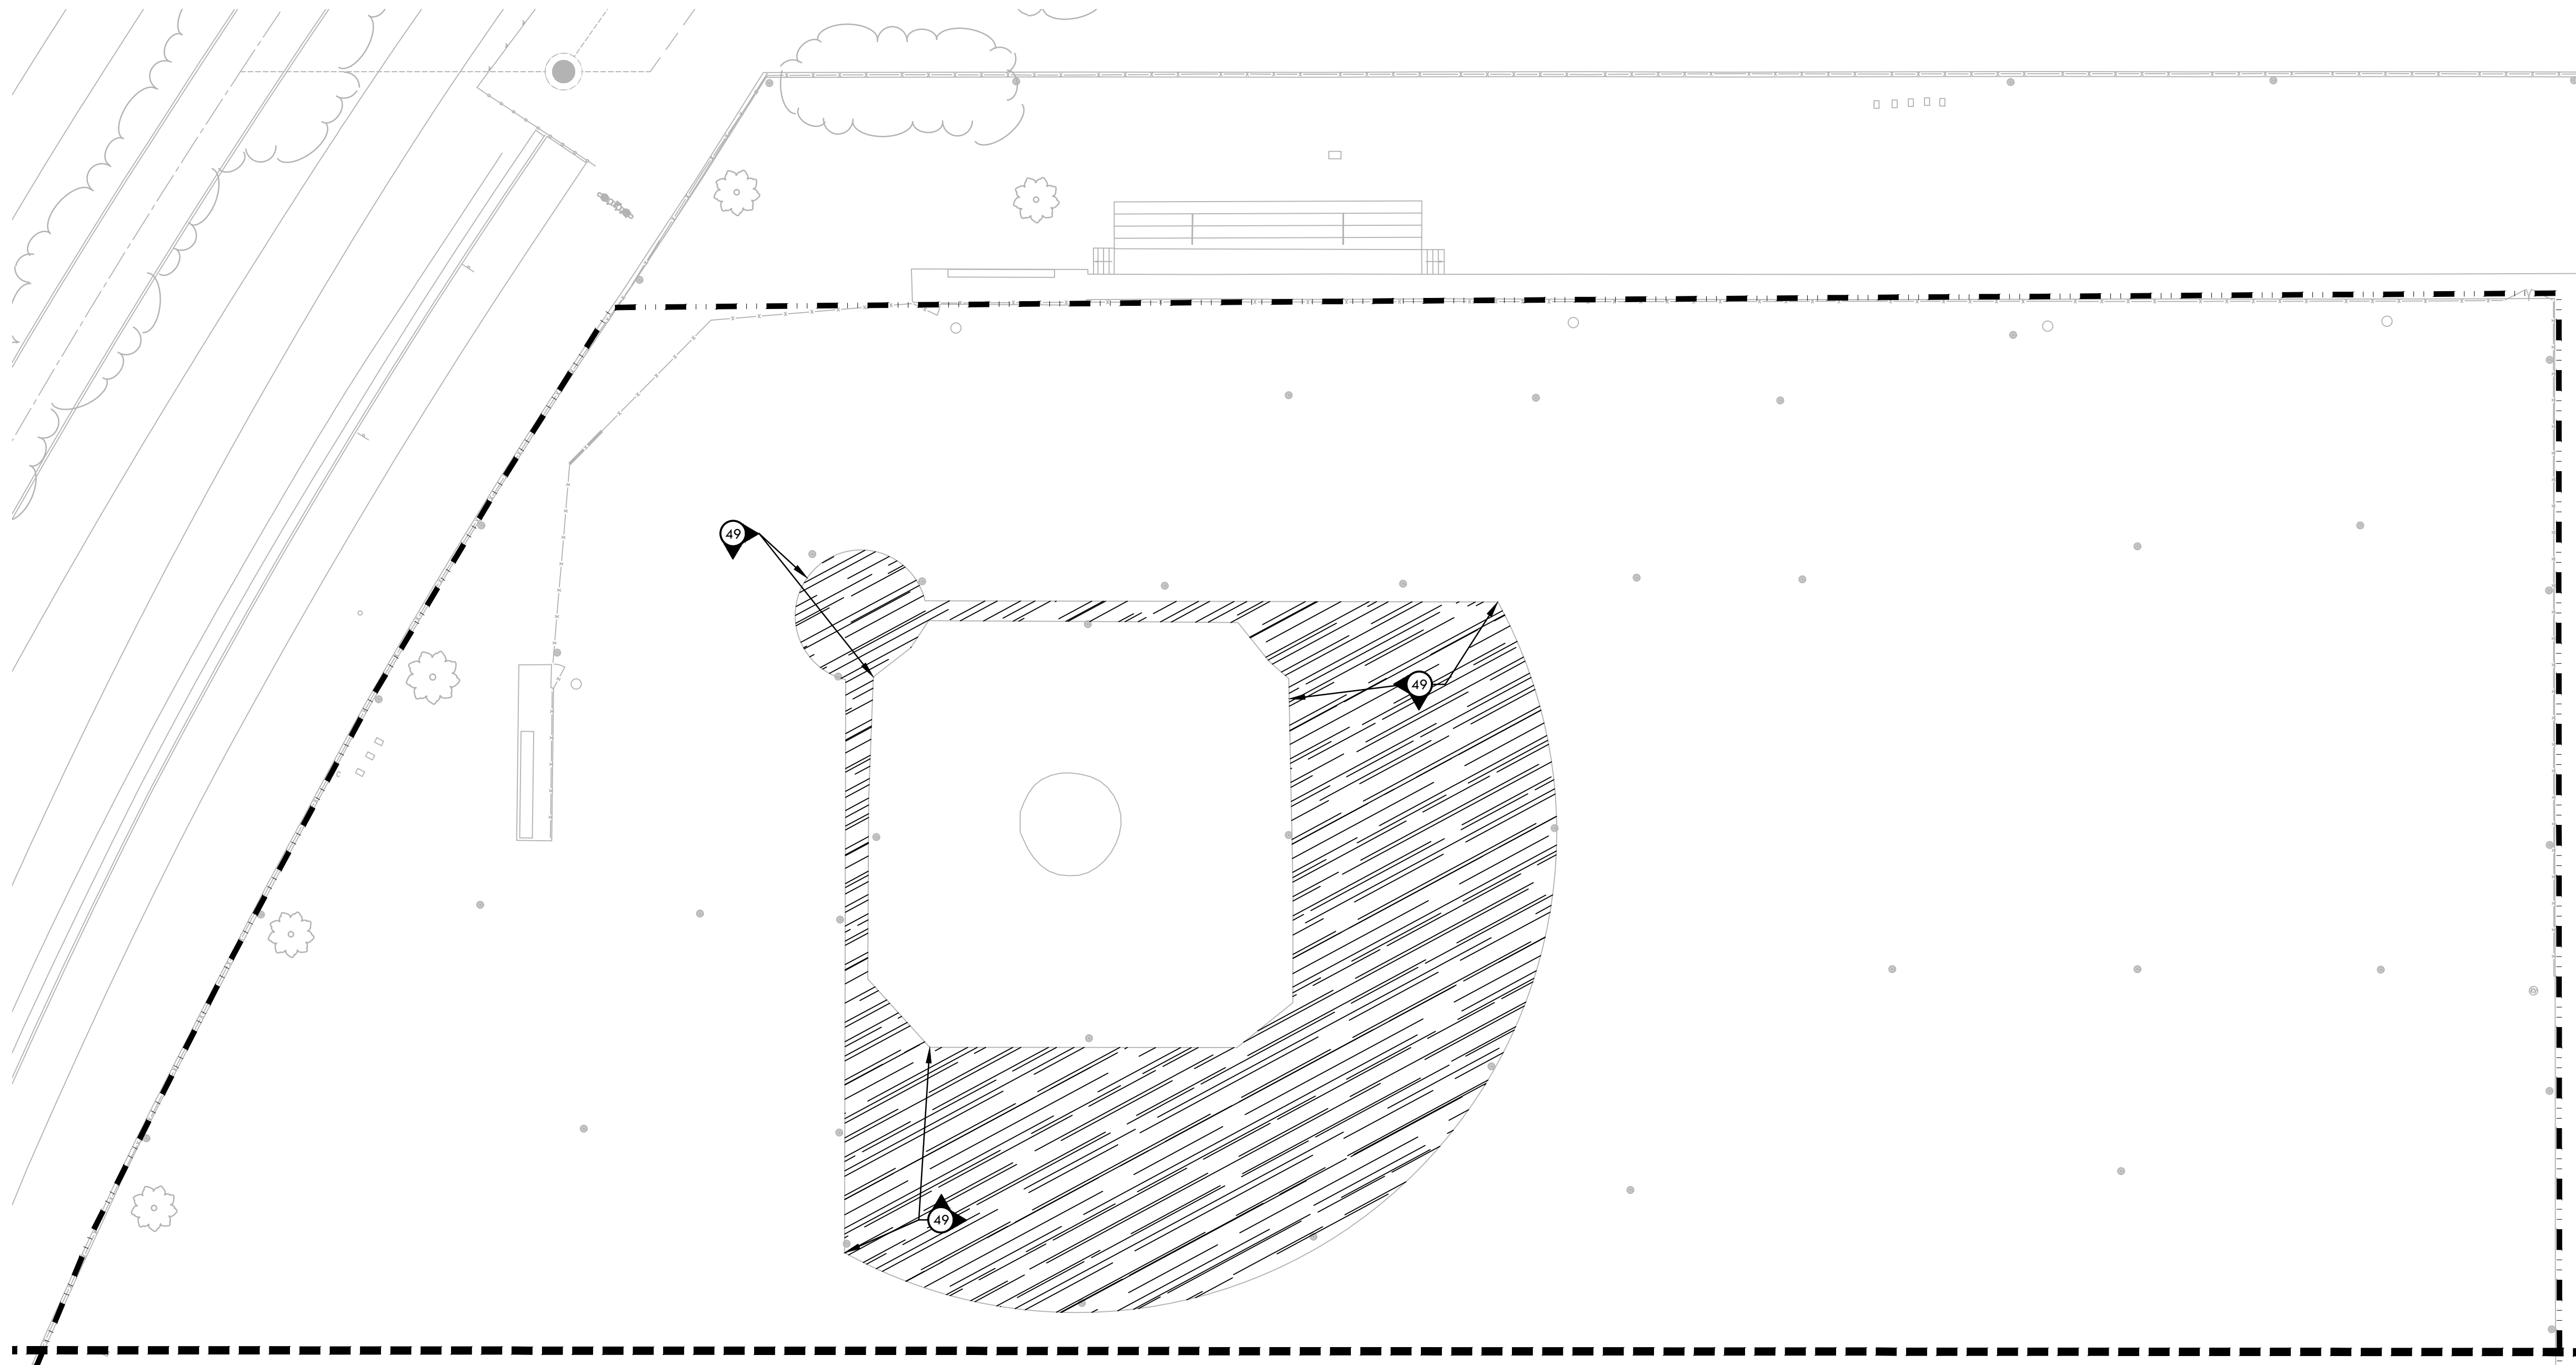

MATCHLINE - REFER TO SHEET L8.2

| ALTERNATE |   |         |
|-----------|---|---------|
| SYM       | DESCRIPTION   | DTL REF |
| A1        | ALTERNATE - HOME PLATE AREA, PITCHERS MOUND AND BULLPENS SHALL BE CONSTRUCTED WITH INFIELD WARNING TRACK FINES AND/OR CLAY IN LIEU OF SYNTHETIC TURF. REFER TO D5.2 |         |
|           |   |         |
|           |   |         |
|           |   |         |
|           |   |         |

| MATERIAL LEGEND |   |         |     |   |           |
|-----------------|---|---------|-----|---|-----------|
| SYM             | DESCRIPTION   | DTL REF | SYM | DESCRIPTION   | DTL REF   |
| 49              | SHOVEL CUT EDGE   | R D6.0  | 32  | DISCUS CAGE AND PAD   | A D2.2    |
| 50              | 12" CURB WITH FENCE                                     | F D2.2  | 33  | THIRD BASE DUGOUT PLANS & ELEVATIONS (REFER TO A8.0 & A8.1)             |           |
| 51              | RED "NO PARKING" PAINTED CURB (REFER TO SPECIFICATIONS) |         | 34  | FIRST BASE DUGOUT PLANS & ELEVATIONS (REFER TO A8.0 & A8.1)             |           |
| 52              | MARQUEE (REFER TO ELECTRICAL & NEVCO PLANS)             | K D2.0  | 35  | DRINKING FOUNTAIN PLAN  | 11/1 D1.1 |
| 53              | SEAT WALL   | B D2.2  | 36  | BASEBALL INFIELD  | A D5.0    |
| 54              | 18" CURB WITH FENCE                                     | G D2.2  | 37  | FOUL POLE   | G D5.0    |
| 55              | 20" CURB WITH FENCE                                     | H D2.2  | 38  | SYNTHETIC TURF PITCHERS MOUND   | H D5.0    |
| 56              | FENCE CONNECTION AT BUILDING                            | H D4.0  | 39  | HOME PLATE, BATTER'S AND CATCHER'S BOX STRIPING                         | F D5.0    |
| 57              | 8' TALL X 4' WIDE ORNAMENTAL GATE - ACCESSIBLE          | G D4.2  | 40  | BULLPEN - THIRD BASE  | A D5.1    |
| 58              | 8' TALL X 8' WIDE DOUBLE ORNAMENTAL GATE                | I D4.2  | 41  | BULLPEN - FIRST BASE  | B D5.1    |
| 59              | 20" EDGE BAND WITH FENCE                                | D D2.2  | 42  | BATTING CAGE  | E D5.1    |
|                 |   |         | 43  | BASEBALL BACKSTOP ELEVATION   | A D4.1    |
|                 |   |         | 44  | RELOCATED STORAGE CONTAINER (SHALL BE PAINTED, REFER TO SPECIFICATIONS) |           |
|                 |   |         | 45  | TREE WELL WITH GRATE  | D D6.0    |
|                 |   |         | 46  | RULES SIGN (PROVIDE 4)  | G D4.3    |
|                 |   |         | 47  | WELCOME SIGN (PROVIDE 2)  | I D4.3    |
|                 |   |         | 48  | ACCESS SIGN (PROVIDE 4)   | H D4.3    |

| MATERIAL NOTES  |  |
|---|--|
| 1. THE CONTRACTOR SHALL COORDINATE ALL CONSTRUCTION ELEMENTS INCLUDING UTILITY LOCATIONS AND REQUIRED SLEEVING PRIOR TO INSTALLATION. VERIFY CRITICAL DIMENSIONS, REFERENCE POINT LOCATIONS AND CONSTRUCTION CONDITIONS PRIOR TO INITIATING CONSTRUCTION. TEMPORARY BENCHMARKS OR REFERENCE POINTS SHALL BE SET BY THE CONTRACTOR AS NECESSARY. NOTIFY THE OWNER'S REPRESENTATIVE IMMEDIATELY SHOULD DISCREPANCY ARISE AND REDIRECT WORK TO AVOID DELAYS.   |  |
| 2. THE INTERFACE OF ALL PROPOSED IMPROVEMENTS TO EXISTING SITE SHALL CONFORM AND BE SMOOTH AND UNIFORM.   |  |
| 3. ALL REINFORCING AND FORMS SHALL BE SECURED IN PLACE AND ACCEPTED BY OWNER'S REPRESENTATIVE PRIOR TO PLACING ANY CONCRETE.  |  |
| 4. CONCRETE FINISHES SHALL BE AS NOTED. CONTRACTOR SHALL PROVIDE 4"x4" SAMPLES OF ALL SPECIFIED FINISHES OF CONCRETE USING THE SAME MATERIALS THAT WILL BE USED IN THE ACTUAL CONSTRUCTION FOR EACH TYPE SPECIFIED. SAMPLES SHALL BE PREPARED WELL ENOUGH IN ADVANCE OF SCHEDULED CONCRETE POUR TO ALLOW FOR REVIEW AND POSSIBLE RE-POURING OF UNACCEPTABLE SAMPLES. UNACCEPTABLE SAMPLES SHALL BE RE-PREPARED UNTIL ACCEPTED BY THE OWNER'S REPRESENTATIVE. ACCEPTED SAMPLES SHALL BE PROTECTED AND REMAIN ON SITE FOR REFERENCE UNTIL FINAL ACCEPTANCE. |  |
| 5. ALL FENCES AND GATES SHOWN ON PLAN ARE GRAPHIC REPRESENTATIONS; REFER TO DETAILS AND SPECIFICATIONS FOR PRECISE LOCATION.  |  |
| 6. ASPHALT SHALL NOT BE INSTALLED UNTIL ALL EDGES AND SITE FURNISHING PADS ARE INSTALLED.   |  |

| MATERIAL LEGEND |   |         |
|-----------------|---|---------|
| SYM             | DESCRIPTION   | DTL REF |
|                 | SYNTHETIC TURF (GREEN)  | H D2.0  |
|                 | SYNTHETIC TURF WARNING TRACK (BROWN)                                | H D2.0  |
|                 | SYNTHETIC TURF INFIELD (BROWN)                                      | H D2.0  |
|                 | ASPHALT PAVING - PEDESTRIAN   | D D2.0  |
|                 | ASPHALT PAVING - VEHICULAR  | D D2.0  |
|                 | CONCRETE PAVING - PEDESTRIAN  | A D2.0  |
|                 | CONCRETE PAVING - VEHICULAR   | A D2.0  |
|                 | TRUNCATED DOMES   | C D3.0  |
|                 | REUSED INFELD FINES   | D D2.0  |
|                 | EXPANSION JOINT SCORE JOINT   | B D2.0  |
|                 | TRASH AND RECYCLING RECEPTACLE PAD                                  | N D2.0  |
|                 | EGRESS LIGHTING (REFER TO ELECTRICAL PLANS)                         |         |
|                 | SPORTSFIELD LIGHTING (REFER TO ELECTRICAL AND SPORT LIGHTING PLANS) |         |
|                 | 42" TALL CHAIN LINK FENCE   | E D4.0  |
|                 | 8' ORNAMENTAL FENCE   | I D4.0  |
|                 | 8' TALL CHAIN LINK FENCE  | F D4.0  |
|                 | 8' TALL CHAIN LINK FENCE WITH WINDSCREEN                            | F D4.0  |
|                 | 14" TALL CHAIN LINK FENCE WITH WINDSCREEN (BATTING CAGE)            | G D4.0  |
|                 | 30' TALL PROTECTIVE NETTING   | B D4.1  |
|                 | GUARD RAIL SYSTEM   | J D4.0  |
|                 | TRENCH DRAIN  | G D1.0  |
|                 | HEADERBOARD   | J D2.0  |
| 1               | 42"x4' SWING GATE (REFER TO L1.0 FOR ACCESSIBLE LOCATIONS)          | A D4.2  |
| 2               | 8' TALL X 4' SWING GATE (REFER TO L1.0 FOR ACCESSIBLE LOCATIONS)    | B D4.2  |
| 3               | 8' TALL - DOUBLE SWING GATE (8', 10' OR 20' WIDTH)                  | C D4.2  |
| 4               | 8' TALL - DOUBLE SWING GATE MIXED                                   | F D4.2  |
| 5               | 20' WIDE SLIDING GATE   | E D4.2  |
| 6               | ACCESS GATE   | H D4.2  |
| 7               | 8' TALL X 4' SWING GATE - TRANSOM                                   | D D4.2  |
| 8               | RESTROOM, CONCESSION & TICKET BUILDING (REFER TO ENVIROPLEX PLANS)  |         |
| 9               | ASPHALT PATCH   | F D2.0  |
| 10              | 6" CURB @ PARKING LOT   | D D2.1  |
| 11              | 6" WIDE CONCRETE CURB WITH CURB CUTS                                | E D2.1  |
| 12              | VERTICAL CURB, GUTTER & SIDEWALK                                    | B D2.1  |
| 13              | BULLPEN CURB 1  | F D2.1  |
| 14              | BULLPEN CURB 2  | G D2.1  |

IDENTIFICATION STAMP  
DIV. OF THE STATE ARCHITECT  
APP. 02-118017 INC.  
REVIEWED FOR  
SS ☐ FLS ☐ ACS ☐  
DATE: 04/10/2020

**VERDE DESIGN**  
LANDSCAPE ARCHITECTURE  
CIVIL ENGINEERING  
SPORT PLANNING & DESIGN  
1843 Iron Point Rd #140  
Folsom, CA 95630  
tel: 916.415.6554  
fax: 916.985.7260  
www.VerdeDesignInc.com

STAMP

CONSULTANT

KEYMAP

SHEET TITLE  
**MATERIAL AND  
DETAIL REFERENCE  
PLAN -  
MULTI-USE NORTH**

PROJECT NAME  
**CHAVEZ HIGH SCHOOL  
STOCKTON USD  
ATHLETIC FACILITY  
IMPROVEMENTS**

PROJECT ADDRESS  
**2929 WINDFLOWER LN  
STOCKTON, CA 95212**

|                         |          |
|-------------------------|----------|
| SUBMITTAL               | DATE     |
| DD/50% SUBMITTAL        | 10/25/19 |
| DSA SUBMITTAL           | 12/20/19 |
| DSA BACKCHECK SUBMITTAL | 03/27/20 |

|     |           |      |
|-----|-----------|------|
| NO. | REVISIONS | DATE |
| △   |           |      |
| △   |           |      |
DRAWN BY  
HM

CHECKED BY  
CS


DATE ISSUED  
03/27/20

SCALE

PROJ. NO.  
1910900-1211

SHEET NO.  
**L8.3**

OF 122

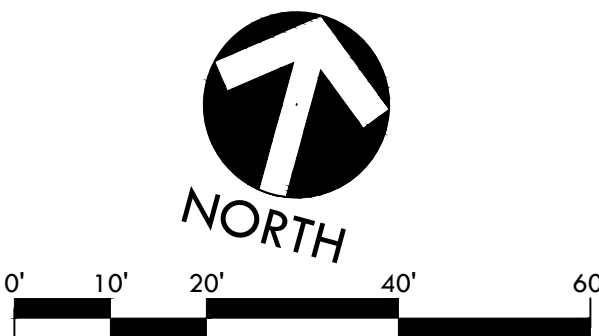





1 CONTROLLER STATION NUMBER

2 APPROX. GPM FLOW THROUGH VALVE

3 CONTROL VALVE SIZE

1. THIS SYSTEM IS DESIGNED TO OPERATE AT A MAXIMUM FLOW OF (X) GPM WITH A MINIMUM 50 PSI STATIC P.S.I. AT THE POINT OF CONNECTION. CONTRACTOR SHALL VERIFY PRESSURE PRIOR TO BEGINNING WORK. CONTRACT OWNER IMMEDIATELY SHOULD DISCREPANCY ARISE AND RE-DIRECT WORK TO AVOID DELAY.
2. CONTRACTOR SHALL COORDINATE ELECTRICAL SUPPLY WITH GENERAL CONTRACTOR. GENERAL CONTRACTOR SHALL STUB APPROPRIATE POWER SUPPLY IN VICINITY OF CONTROLLER LOCATION.
3. IRRIGATION SYSTEM DESIGN IS DIAGRAMMATIC. WHERE PIPING, VALVES, QUICK COUPLERS, ETC. ARE SHOWN OUTSIDE PLANTING AREAS, OR LIMIT OF WORK; INTENT IS FOR PIPING, VALVES, ETC., TO BE INSTALLED WITHIN PLANTING AREAS OF PROPERTY. INDICATE EXACT LOCATIONS OF IRRIGATION EQUIPMENT ON RECORD DRAWINGS. REFER TO SPECIFICATIONS.
4. CONTRACTOR SHALL PROGRAM CONTROLLER TO ENSURE PROPER IRRIGATION, BASED ON PLANT TYPE, EXPOSURE AND SEASON.
5. CONTRACTOR SHALL USE EXTREME CARE WHERE IT IS NECESSARY TO TRENCH NEAR EXISTING TREES. EXCAVATION DEPTHS EXHIBITING ROOT 2" AND LARGER SHALL BE DONE BY HAND. ROOTS 2" OR LARGER IN DIAMETER DAMAGED IN CONSTRUCTION SHALL BE CLEANLY CUT.
6. CONTRACTOR SHALL MAKE MINOR ADJUSTMENTS TO HEAD LOCATIONS IN FIELD AS NECESSARY.
7. CONTRACTOR SHALL REFER TO DETAILS AND SPECIFICATIONS FOR ADDITIONAL INFORMATION.

| SYM. | ITEM                              | MODEL NO./ DESCRIPTION   | CAT. RAD. D | GPM       | PSI | DTL REF.      |
|------|-----------------------------------|--|-------------|-----------|-----|---------------|
| ☉    | ROTOR                             | RAIN BIRD 6504 F4-PC-55<br>PARTIAL CIRCLE ROTOR  | 59°/50'     | 12.7      | 50  | (H)<br>D6.0   |
| ●    | ROTOR                             | RAIN BIRD 6504 F4-PC-55<br>FULL CIRCLE ROTOR   | 59°/50'     | 12.7      | 50  | (H)<br>D6.0   |
| ⊗    | ROTATOR                           | RAINBIRD 1806-SAM-PRS BODY<br>WITH R.VAN.14 ADJ. ARC /<br>FULL CIRCLE NOZZLE   | 13°/11"     | 0.28-1.10 | 30  |               |
| ⊙    | ROTATOR                           | RAINBIRD 1806-SAM-PRS BODY<br>WITH R.VAN.18 ADJ. ARC /<br>FULL CIRCLE NOZZLE   | 16°/14"     | 0.42-1.65 | 30  |               |
| ⊖    | ROTATOR                           | RAINBIRD 1806-SAM-PRS BODY<br>WITH R.VAN.24 ADJ. ARC /<br>FULL CIRCLE NOZZLE   | 19°/17"     | 0.60-2.35 | 30  |               |
| ☼☼☼  | SPRAY                             | RAINBIRD 1806-SAM-PRS BODY<br>WITH 4VAN VARIABLE ARC<br>NOZZLE   | 4°/3.5'     | 0.29-0.88 | 30  | (I)<br>D6.0   |
| ☼☼☼  | SPRAY                             | RAINBIRD 1806-SAM-PRS BODY<br>WITH 6VAN VARIABLE ARC<br>NOZZLE   | 6°/5'       | 0.37-1.20 | 30  |               |
| ☼☼☼  | SPRAY                             | RAINBIRD 1806-SAM-PRS BODY<br>WITH 8VAN VARIABLE ARC<br>NOZZLE   | 8°/6.5'     | 0.72-1.70 | 30  |               |
| ☼☼☼  | SPRAY                             | RAINBIRD 1806-SAM-PRS BODY<br>WITH 10VAN VARIABLE ARC<br>NOZZLE  | 10°/8.5'    | 0.75-2.60 | 30  |               |
| ☼☼☼  | ROTOR/SPRAY                       | NEW ROTOR/SPRAY HEAD TO MATCH EXISTING RADIUS AND<br>THROW AS ADJACENT HEAD, CONTRACTOR TO ADJUST PATTERN<br>AS NEEDED TO ACHIEVE HEAD TO HEAD COVERAGE.   |             |           |     |               |
| ☼    | BUBBLER                           | RAIN BIRD: RW5-B-C-1402<br>ROOT WATER ASSEMBLY<br>7 PER 15 GAL. TREE, 4 PER 24"<br>BOX, 6 PER 36" AND 48" BOX  | -           | 0.5       |     | (M)<br>D6.0   |
| ☼    | REMOTE<br>CONTROL<br>VALVE        | RAIN BIRD: PER SERIES REMOTE CONTROL VALVE WITH<br>PRESSURE REGULATOR. - SIZE AS NOTED   |             |           |     | (E)<br>D6.0   |
| ☼    | GATE<br>VALVE                     | GATE VALVES 3" AND SMALLER SHALL BE NIBCO T-113. FOR<br>VALVES ABOVE 2" IN SIZE UTILIZE NIBCO F-619 FLANGED<br>VALVE WITH SQUARE OPERATING NUT.  |             |           |     | (C/D)<br>D6.0 |
| ☼    | QUICK<br>COUPLER<br>VALVE         | RAIN BIRD: 44LRC QUICK COUPLING VALVE IN LANDSCAPE   |             |           |     | (F)<br>D6.0   |
| ☼    | QUICK<br>COUPLER<br>VALVE         | RAIN BIRD: 44LRC QUICK COUPLING VALVE IN HARDSCAPE<br>OR SYNTHETIC TURF  |             |           |     | (G)<br>D6.0   |
| ---  | LATERAL LINE                      | 3/4" LATERAL LINE - SCHEDULE 40 PVC WITH<br>SOLVENT-WELD FITTINGS, WITH 18" COVER.   |             |           |     |               |
| ---  | LATERAL LINE                      | 1" LATERAL LINE - SCHEDULE 40 PVC WITH<br>SOLVENT-WELD FITTINGS, WITH 18" COVER.   |             |           |     |               |
| ---  | LATERAL LINE                      | 1-1/4" LATERAL LINE - SCHEDULE 40 PVC WITH<br>SOLVENT-WELD FITTINGS, WITH 18" COVER.   |             |           |     |               |
| ---  | LATERAL LINE                      | 1-1/2" LATERAL LINE - SCHEDULE 40 PVC WITH<br>SOLVENT-WELD FITTINGS, WITH 18" COVER.   |             |           |     |               |
| ---  | LATERAL LINE                      | 2" LATERAL LINE - SCHEDULE 40 PVC WITH<br>SOLVENT-WELD FITTINGS, WITH 18" COVER.   |             |           |     |               |
| ---  | LATERAL LINE                      | 2-1/2" LATERAL LINE - SCHEDULE 40 PVC WITH<br>SOLVENT-WELD FITTINGS, WITH 18" COVER.   |             |           |     | (J)<br>D6.0   |
| ---  | LATERAL LINE                      | 3" LATERAL LINE - SCHEDULE 40 PVC WITH<br>SOLVENT-WELD FITTINGS, WITH 18" COVER.   |             |           |     |               |
| ---  | MAINLINE                          | 2" AND SMALLER: SCHEDULE 40 PVC WITH<br>SOLVENT-WELD FITTINGS; 2-1/2" AND LARGER: CLASS<br>200 WITH RING - TITE CONNECTIONS WITH 24" COVER.  |             |           |     |               |
| ---  | MAINLINE<br>FOR QUICK<br>COUPLERS | 2" SCHEDULE 40 PVC WITH SOLVENT-WELD FITTINGS<br>WITH 24" COVER.   |             |           |     |               |
| ---  | SLEEVES                           | IRRIGATION SLEEVE - CLASS 200 PVC, SIZE AS NOTED<br>WITH 30" COVER.  |             |           |     |               |
| ---  | EXISTING<br>MAINLINE              | EXISTING IRRIGATION MAINLINE BASED ON AS-BUILTS PROVIDED.<br>CONTRACTOR TO VERIFY SIZE AND LOCATIONS PRIOR TO<br>CONSTRUCTION. MAIN LINE TO REMAIN UNLESS OTHERWISE NOTED.                       |             |           |     |               |
| ---  | EXISTING<br>MAINLINE              | EXISTING IRRIGATION MAINLINE FOR QUICK COUPLERS BASED ON<br>AS-BUILTS PROVIDED. CONTRACTOR TO VERIFY SIZE AND<br>LOCATIONS PRIOR TO CONSTRUCTION. MAIN LINE TO REMAIN<br>UNLESS OTHERWISE NOTED. |             |           |     |               |
| ---  | EXISTING<br>LATERAL<br>LINE       | EXISTING LATERAL LINE BASED ON AS-BUILTS PROVIDED.<br>CONTRACTOR TO VERIFY APPROXIMATE SIZE AND LOCATIONS PRIOR<br>TO CONSTRUCTION.  |             |           |     |               |
| ---  | EXISTING<br>IRRIGATION<br>HEAD    | EXISTING IRRIGATION HEAD BASED ON AS-BUILTS PROVIDED.<br>CONTRACTOR TO VERIFY APPROXIMATE LOCATIONS IN FIELD PRIOR<br>TO CONSTRUCTION.   |             |           |     |               |
| ---  | EXISTING<br>IRRIGATION<br>HEAD    | EXISTING IRRIGATION HEAD TO BE RELOCATED PER DRAWINGS.<br>CONTRACTOR TO EXTEND LATERAL AS NEEDED. CONTRACTOR TO<br>ADJUST SPRAY PATTERN AS NEEDED TO AVOID SPRAYING<br>ADJACENT HARDSCAPE.       |             |           |     |               |



**VERDE DESIGN**

---

**LANDSCAPE ARCHITECTURE  
CIVIL ENGINEERING  
SPORT PLANNING & DESIGN**

---

**1843 Iron Point Rd #140  
Folsom, CA 95630  
tel: 916.415.6554  
fax: 408.985.7260  
[www.VerdeDesignInc.com](http://www.VerdeDesignInc.com)**

PROJECT NAME

CHAVEZ HIGH SCHOOL  
STOCKTON USD  
ATHLETIC FACILITY  
IMPROVEMENTS

2929 WINDFLOWER LN  
STOCKTON, CA 95212

| SUBMITTAL               | DATE     |
|-------------------------|----------|
| DD/50% SUBMITTAL        | 10/25/19 |
| DSA SUBMITTAL           | 12/20/19 |
| DSA BACKCHECK SUBMITTAL | 03/27/20 |


[illegible]

|                         |                      |
|-------------------------|----------------------|
| DRAWN BY<br>JC          | CHECKED BY<br>CS     |
| DATE ISSUED<br>03/27/20 | SCALE<br>1" = 20'-0" |

1910900-1211

OF 122



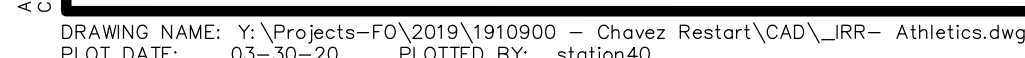






1 CONTROLLER STATION NUMBER  
2 APPROX. GPM FLOW THROUGH VALVE  
3 CONTROL VALVE SIZE

1. THIS SYSTEM IS DESIGNED TO OPERATE AT A MAXIMUM FLOW OF (X) GPM WITH A MINIMUM 50' STATIC P.S.I. AT THE POINT OF CONNECTION. CONTRACTOR SHALL VERIFY PRESSURE PRIOR TO BEGINNING WORK. CONTRACT OWNER IMMEDIATELY SHOULD DISCREPANCY ARISE AND RE-DIRECT WORK TO AVOID DELAY.
2. CONTRACTOR SHALL COORDINATE ELECTRICAL SUPPLY WITH GENERAL CONTRACTOR. GENERAL CONTRACTOR SHALL STUB APPROPRIATE POWER SUPPLY IN VICINITY OF CONTROLLER LOCATION.
3. IRRIGATION SYSTEM DESIGN IS DIAGRAMMATIC. WHERE PIPING, VALVES, QUICK COUPLERS, ETC. ARE SHOWN OUTSIDE PLANTING AREAS, OR LIMIT OF WORK; INTENT IS FOR PIPING, VALVES, ETC., TO BE INSTALLED WITHIN PLANTING AREAS OF PROPERTY. INDICATE EXACT LOCATIONS OF IRRIGATION EQUIPMENT ON RECORD DRAWINGS. REFER TO SPECIFICATIONS.
4. CONTRACTOR SHALL PROGRAM CONTROLLER TO ENSURE PROPER IRRIGATION, BASED ON PLANT TYPE, EXPOSURE AND SEASON.
5. CONTRACTOR SHALL USE EXTREME CARE WHERE IT IS NECESSARY TO TRENCH NEAR EXISTING TREES. EXCAVATION DEPTHS EXHIBITING ROOT 2" AND LARGER SHALL BE DONE BY HAND. ROOTS 2" OR LARGER IN DIAMETER DAMAGED IN CONSTRUCTION SHALL BE CLEANLY CUT.
6. CONTRACTOR SHALL MAKE MINOR ADJUSTMENTS TO HEAD LOCATIONS IN FIELD AS NECESSARY.
7. CONTRACTOR SHALL REFER TO DETAILS AND SPECIFICATIONS FOR ADDITIONAL INFORMATION.


| SYM. | ITEM                              | MODEL NO./<br>DESCRIPTION  | CAT. RAD.<br>DES. RAD. | GPM       | PSI | DTL<br>REF.   |
|------|-----------------------------------|--|------------------------|-----------|-----|---------------|
| ⊖    | ROTOR                             | RAIN BIRD 6504 F4-PC-55<br>PARTIAL CIRCLE ROTOR  | 59°/50'                | 12.7      | 50  | (H)<br>D6.0   |
| ●    | ROTOR                             | RAIN BIRD 6504 F4-PC-55<br>FULL CIRCLE ROTOR   | 59°/50'                | 12.7      | 50  | (H)<br>D6.0   |
| ⊗    | ROTATOR                           | RAINBIRD 1806-SAM-PRS BODY<br>WITH R.VAN.14 ADJ. ARC /<br>FULL CIRCLE NOZZLE   | 13°/11"                | 0.28-1.10 | 30  |               |
| ⊙    | ROTATOR                           | RAINBIRD 1806-SAM-PRS BODY<br>WITH R.VAN.18 ADJ. ARC /<br>FULL CIRCLE NOZZLE   | 16°/14"                | 0.42-1.65 | 30  |               |
| ⊙    | ROTATOR                           | RAINBIRD 1806-SAM-PRS BODY<br>WITH R.VAN.24 ADJ. ARC /<br>FULL CIRCLE NOZZLE   | 19°/17"                | 0.60-2.35 | 30  |               |
| ☼☼☼  | SPRAY                             | RAINBIRD 1806-SAM-PRS BODY<br>WITH 4VAN VARIABLE ARC<br>NOZZLE   | 4°/3.5'                | 0.29-0.88 | 30  | (I)<br>D6.0   |
| ☼☼☼  | SPRAY                             | RAINBIRD 1806-SAM-PRS BODY<br>WITH 6VAN VARIABLE ARC<br>NOZZLE   | 6°/5'                  | 0.37-1.20 | 30  |               |
| ☼☼☼  | SPRAY                             | RAINBIRD 1806-SAM-PRS BODY<br>WITH 8VAN VARIABLE ARC<br>NOZZLE   | 8°/6.5'                | 0.72-1.70 | 30  |               |
| ☼☼☼  | SPRAY                             | RAINBIRD 1806-SAM-PRS BODY<br>WITH 10VAN VARIABLE ARC<br>NOZZLE  | 10°/8.5'               | 0.75-2.60 | 30  |               |
| ⊗    | ROTOR/SPRAY                       | NEW ROTOR/SPRAY HEAD TO MATCH EXISTING RADIUS AND<br>THROW AS ADJACENT HEAD, CONTRACTOR TO ADJUST PATTERN<br>AS NEEDED TO ACHIEVE HEAD TO HEAD COVERAGE.   |                        |           |     |               |
| ⊞    | BUBBLER                           | RAIN BIRD: RW5-B-C-1402<br>ROOT WATER ASSEMBLY<br>2 PER 15 GAL. TREE, 4 PER 24"<br>BOX, 6 PER 36" AND 48" BOX  | -                      | 0.5       |     | (M)<br>D6.0   |
| ⊞    | REMOTE<br>CONTROL<br>VALVE        | RAIN BIRD: PER SERIES REMOTE CONTROL VALVE WITH<br>PRESSURE REGULATOR. - SIZE AS NOTED   |                        |           |     | (E)<br>D6.0   |
| ⊞    | GATE<br>VALVE                     | GATE VALVES 3" AND SMALLER SHALL BE NIBCO T-113. FOR<br>VALVES ABOVE 2" IN SIZE UTILIZE NIBCO F-619 FLANGED<br>VALVE WITH SQUARE OPERATING NUT.  |                        |           |     | (C/D)<br>D6.0 |
| ⊞    | QUICK<br>COUPLER<br>VALVE         | RAIN BIRD: 44LRC QUICK COUPLING VALVE IN LANDSCAPE   |                        |           |     | (F)<br>D6.0   |
| ⊞    | QUICK<br>COUPLER<br>VALVE         | RAIN BIRD: 44LRC QUICK COUPLING VALVE IN HARDSCAPE<br>OR SYNTHETIC TURF  |                        |           |     | (G)<br>D6.0   |
| —    | LATERAL LINE                      | 3/4" LATERAL LINE - SCHEDULE 40 PVC WITH<br>SOLVENT-WELD FITTINGS, WITH 18" COVER.   |                        |           |     |               |
| —    | LATERAL LINE                      | 1" LATERAL LINE - SCHEDULE 40 PVC WITH<br>SOLVENT-WELD FITTINGS, WITH 18" COVER.   |                        |           |     |               |
| —    | LATERAL LINE                      | 1-1/4" LATERAL LINE - SCHEDULE 40 PVC WITH<br>SOLVENT-WELD FITTINGS, WITH 18" COVER.   |                        |           |     |               |
| —    | LATERAL LINE                      | 1-1/2" LATERAL LINE - SCHEDULE 40 PVC WITH<br>SOLVENT-WELD FITTINGS, WITH 18" COVER.   |                        |           |     |               |
| —    | LATERAL LINE                      | 2" LATERAL LINE - SCHEDULE 40 PVC WITH<br>SOLVENT-WELD FITTINGS, WITH 18" COVER.   |                        |           |     |               |
| —    | LATERAL LINE                      | 2-1/2" LATERAL LINE - SCHEDULE 40 PVC WITH<br>SOLVENT-WELD FITTINGS, WITH 18" COVER.   |                        |           |     | (J)<br>D6.0   |
| —    | LATERAL LINE                      | 3" LATERAL LINE - SCHEDULE 40 PVC WITH<br>SOLVENT-WELD FITTINGS, WITH 18" COVER.   |                        |           |     |               |
| —    | MAINLINE                          | 2" AND SMALLER: SCHEDULE 40 PVC WITH<br>SOLVENT-WELD FITTINGS; 2-1/2" AND LARGER: CLASS<br>200 WITH RING - TITE CONNECTIONS WITH 24" COVER.  |                        |           |     |               |
| —    | MAINLINE<br>FOR QUICK<br>COUPLERS | 2" SCHEDULE 40 PVC WITH SOLVENT-WELD FITTINGS<br>WITH 24" COVER.   |                        |           |     |               |
| —    | SLEEVES                           | IRRIGATION SLEEVE - CLASS 200 PVC, SIZE AS NOTED<br>WITH 30" COVER.  |                        |           |     |               |
| —    | EXISTING<br>MAINLINE              | EXISTING IRRIGATION MAINLINE BASED ON AS-BUILTS PROVIDED.<br>CONTRACTOR TO VERIFY SIZE AND LOCATIONS PRIOR TO<br>CONSTRUCTION. MAIN LINE TO REMAIN UNLESS OTHERWISE NOTED.                       |                        |           |     |               |
| —    | EXISTING<br>MAINLINE              | EXISTING IRRIGATION MAINLINE FOR QUICK COUPLERS BASED ON<br>AS-BUILTS PROVIDED. CONTRACTOR TO VERIFY SIZE AND<br>LOCATIONS PRIOR TO CONSTRUCTION. MAIN LINE TO REMAIN<br>UNLESS OTHERWISE NOTED. |                        |           |     |               |
| —    | EXISTING<br>LATERAL<br>LINE       | EXISTING LATERAL LINE BASED ON AS-BUILTS PROVIDED.<br>CONTRACTOR TO VERIFY APPROXIMATE SIZE AND LOCATIONS PRIOR<br>TO CONSTRUCTION.  |                        |           |     |               |
| —    | EXISTING<br>IRRIGATION<br>HEAD    | EXISTING IRRIGATION HEAD BASED ON AS-BUILTS PROVIDED.<br>CONTRACTOR TO VERIFY APPROXIMATE LOCATIONS IN FIELD PRIOR<br>TO CONSTRUCTION.   |                        |           |     |               |
| —    | EXISTING<br>IRRIGATION<br>HEAD    | EXISTING IRRIGATION HEAD TO BE RELOCATED PER DRAWINGS.<br>CONTRACTOR TO EXTEND LATERAL AS NEEDED. CONTRACTOR TO<br>ADJUST SPRAY PATTERN AS NEEDED TO AVOID SPRAYING<br>ADJACENT HARDSCAPE.       |                        |           |     |               |
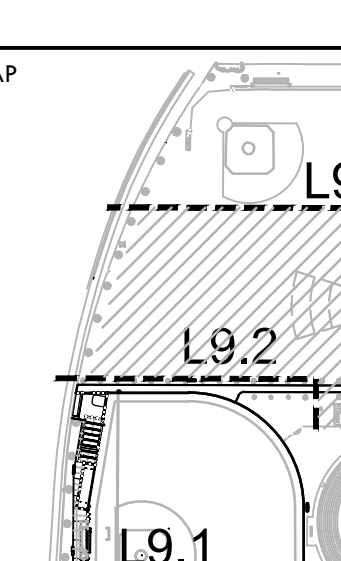
|                 |   |
|-----------------|---|
|                 | <div style="border: 2px solid black; border-radius: 15px; padding: 5px; margin: 0 auto; width: 80%;"> <p style="margin: 0;">IDENTIFICATION STAMP</p> <p style="margin: 0;">DIV. OF THE STATE ARCHITECT</p> <p style="margin: 0;">APP. 02-118017 INC.</p> <p style="margin: 0;">REVIEWED FOR</p> <div style="display: flex; justify-content: space-around; margin: 0;"> <span>SS <input type="checkbox"/></span> <span>FLS <input type="checkbox"/></span> <span>ACS <input checked="" type="checkbox"/></span> </div> <p style="margin: 0;">DATE: 04/10/2020</p> </div>   |
|                 |  <p style="margin: 5px 0;"><b>VERDE DESIGN</b></p> <p style="margin: 0 0 0 40px;">LANDSCAPE ARCHITECTURE</p> <p style="margin: 0 0 0 40px;">CIVIL ENGINEERING</p> <p style="margin: 0 0 0 40px;">SPORT PLANNING &amp; DESIGN</p> <p style="margin: 10px 0 0 40px;">1843 Iron Point Rd #140</p> <p style="margin: 0 0 0 40px;">Folsom, CA 95630</p> <p style="margin: 0 0 0 40px;">tel: 916.411.5654</p> <p style="margin: 0 0 0 40px;">fax: 408.985.7260</p> <p style="margin: 0 0 0 40px;"><a href="http://www.VerdeDesigninc.com">www.VerdeDesigninc.com</a></p> |
| STAMP           |    |
| CONSULTANT      |   |
| KEYMAP          |   |
| SHEET TITLE     | <p style="margin: 0;"><b>IRRIGATION PLAN -</b></p> <p style="margin: 0;"><b>MULTI-USE SOUTH</b></p>   |
| PROJECT NAME    | <p style="margin: 0;"><b>CHAVEZ HIGH SCHOOL</b></p> <p style="margin: 0;"><b>STOCKTON USD</b></p> <p style="margin: 0;"><b>ATHLETIC FACILITY</b></p> <p style="margin: 0;"><b>IMPROVEMENTS</b></p>  |
| PROJECT ADDRESS | <p style="margin: 0;"><b>2929 WINDFLOWER</b></p> <p style="margin: 0;"><b>STOCKTON, CA 952</b></p>  |
| SUBMITTAL       |   |

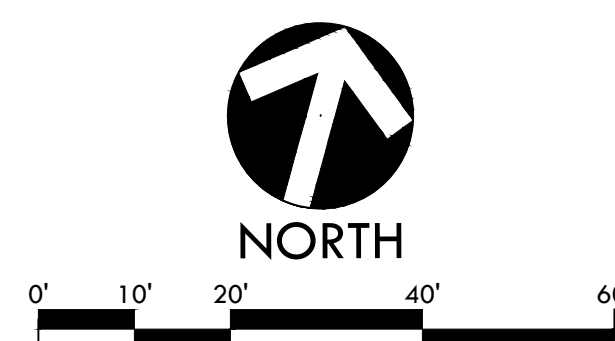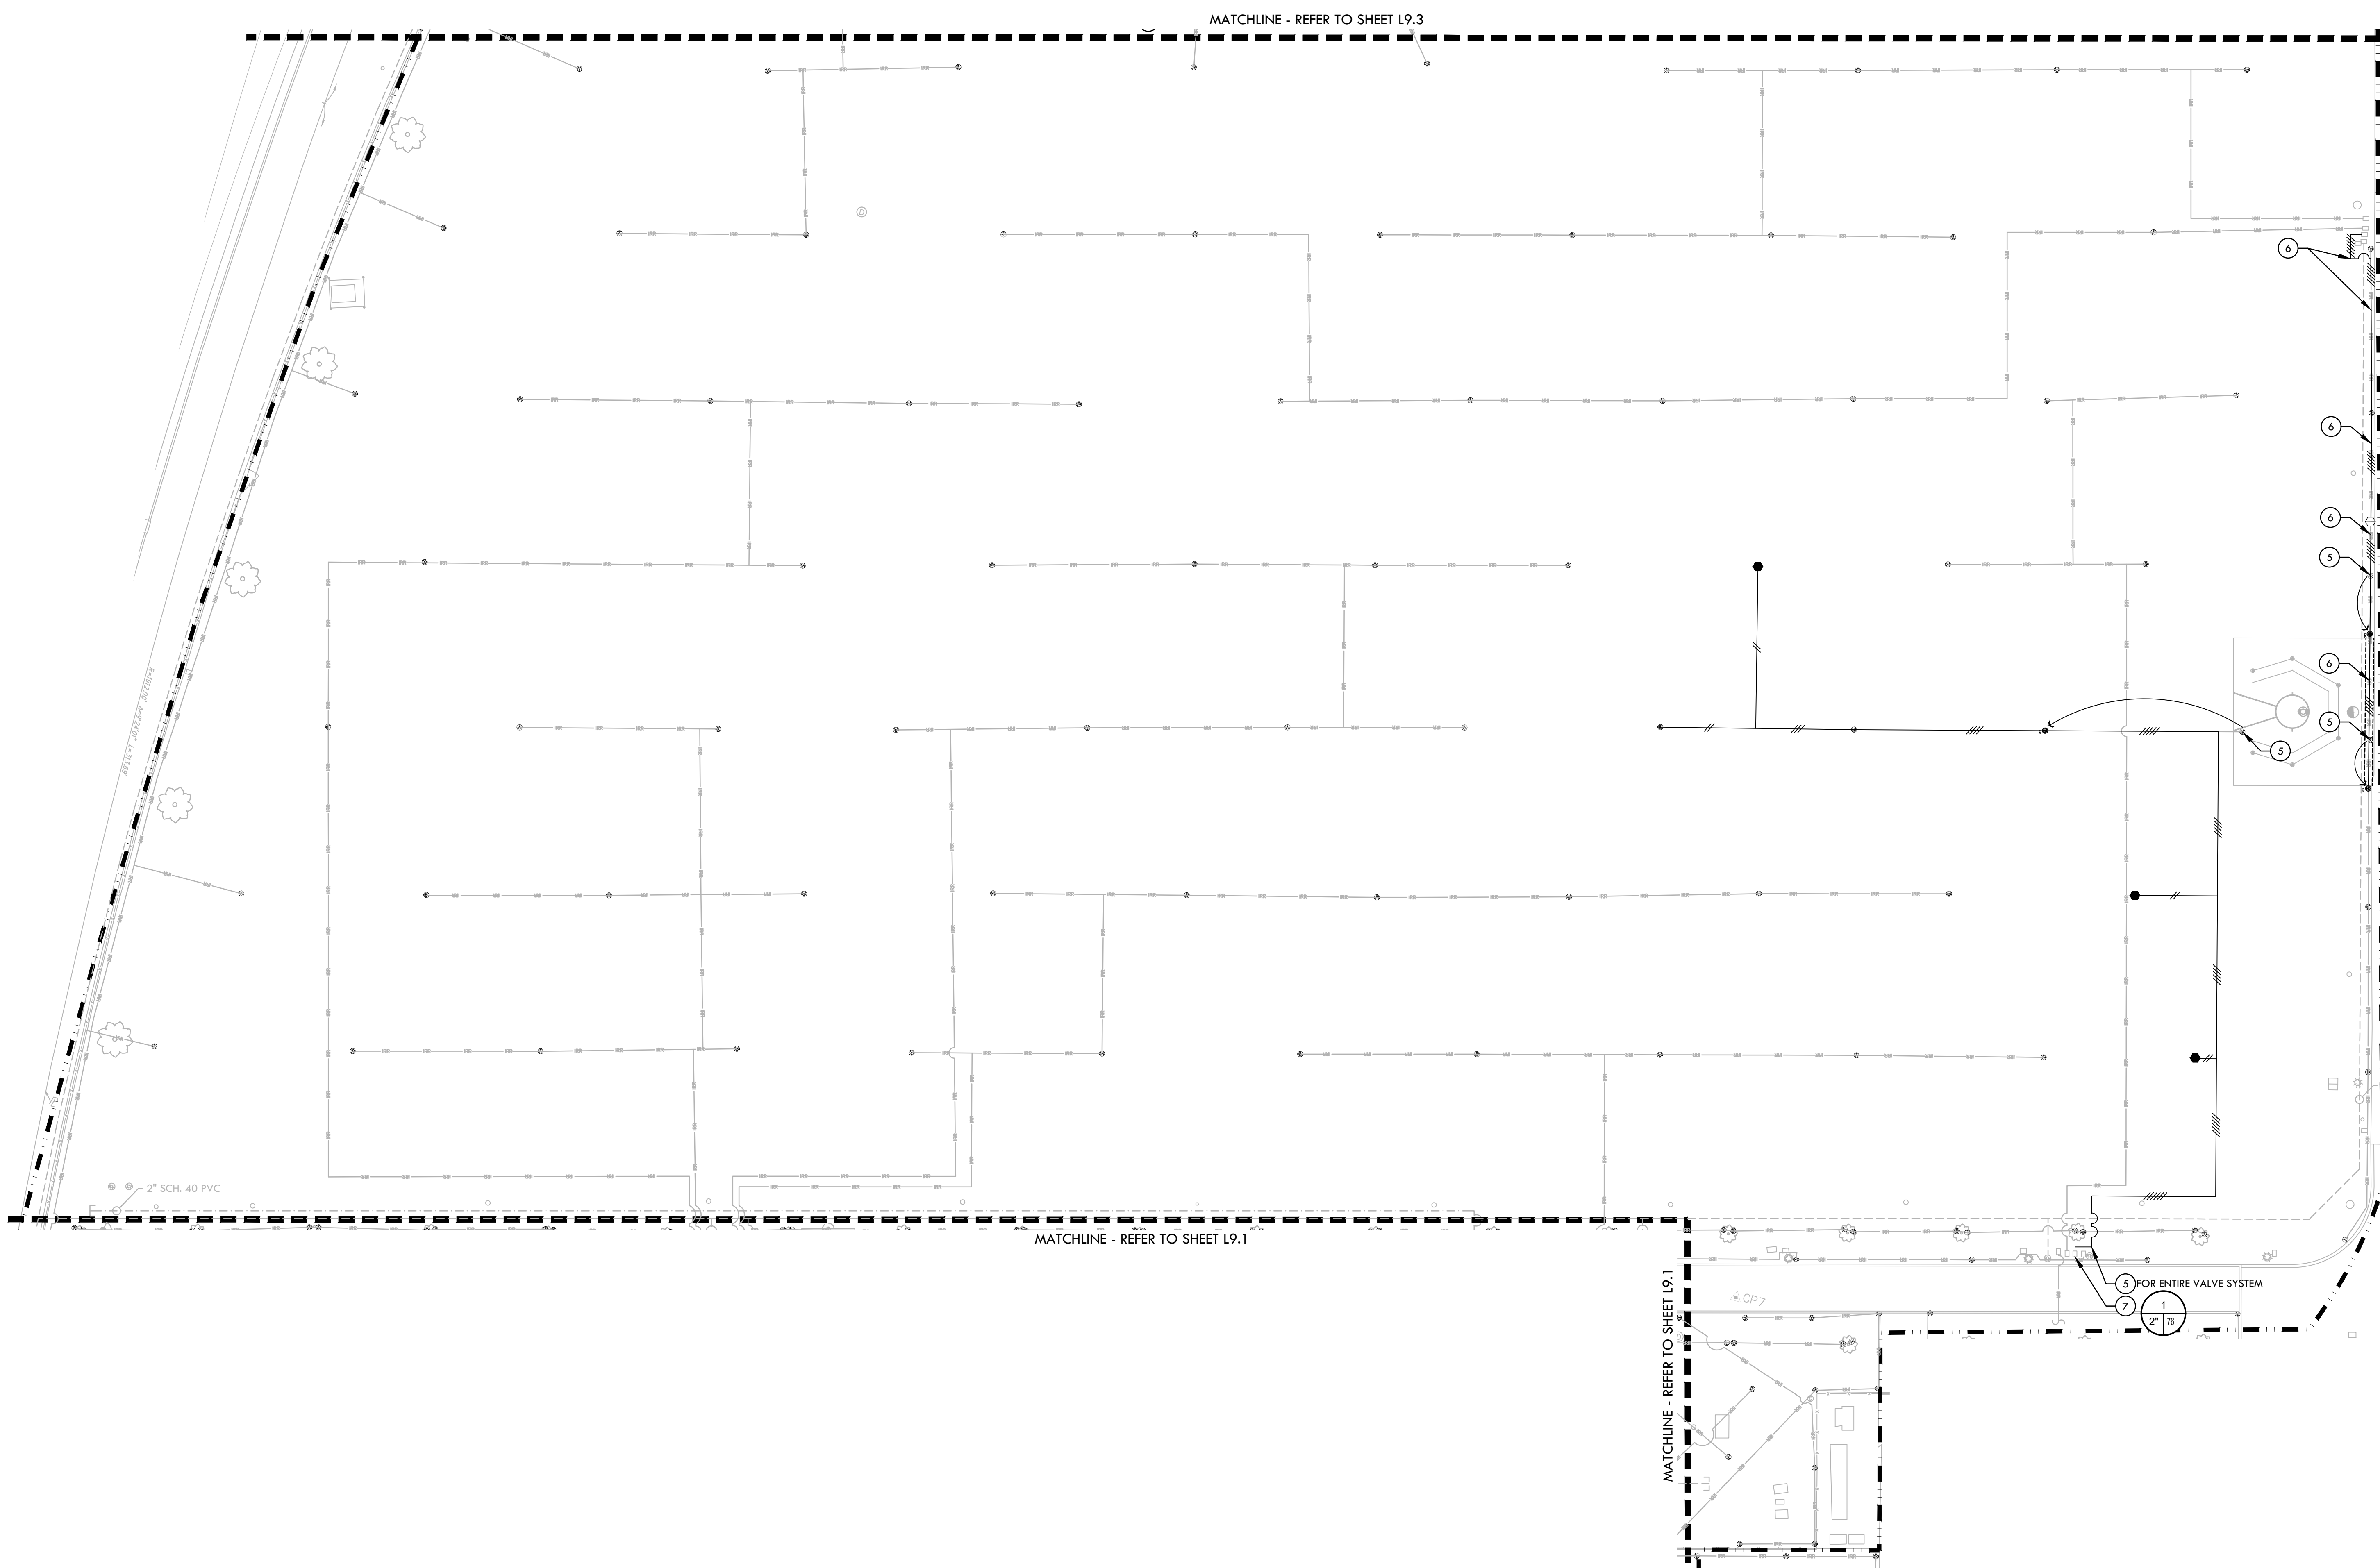



ALL DESIGNS, CALCULATIONS, AND ANY SCHEDULES OR SPECIFICATIONS BY VERDE DESIGN, INC. ARE THE PROPERTY OF VERDE DESIGN, INC. AND WERE CREATED, DEVELOPED, AND DELETED FOR USE ON AND IN CONNECTION WITH THE SPECIFIED PROJECT. NONE OF SUCH IDEAS, DESIGNS, ARRANGEMENTS OR PLANS SHALL BE USED, REPRODUCED, OR PUBLISHED BY ANY METHOD, IN WHOLE OR IN PART, OR DISCLOSED TO ANY PERSON, FIRM, OR CORPORATION FOR ANY PURPOSE WITHOUT THE WRITTEN PERMISSION OF VERDE DESIGN, INC.

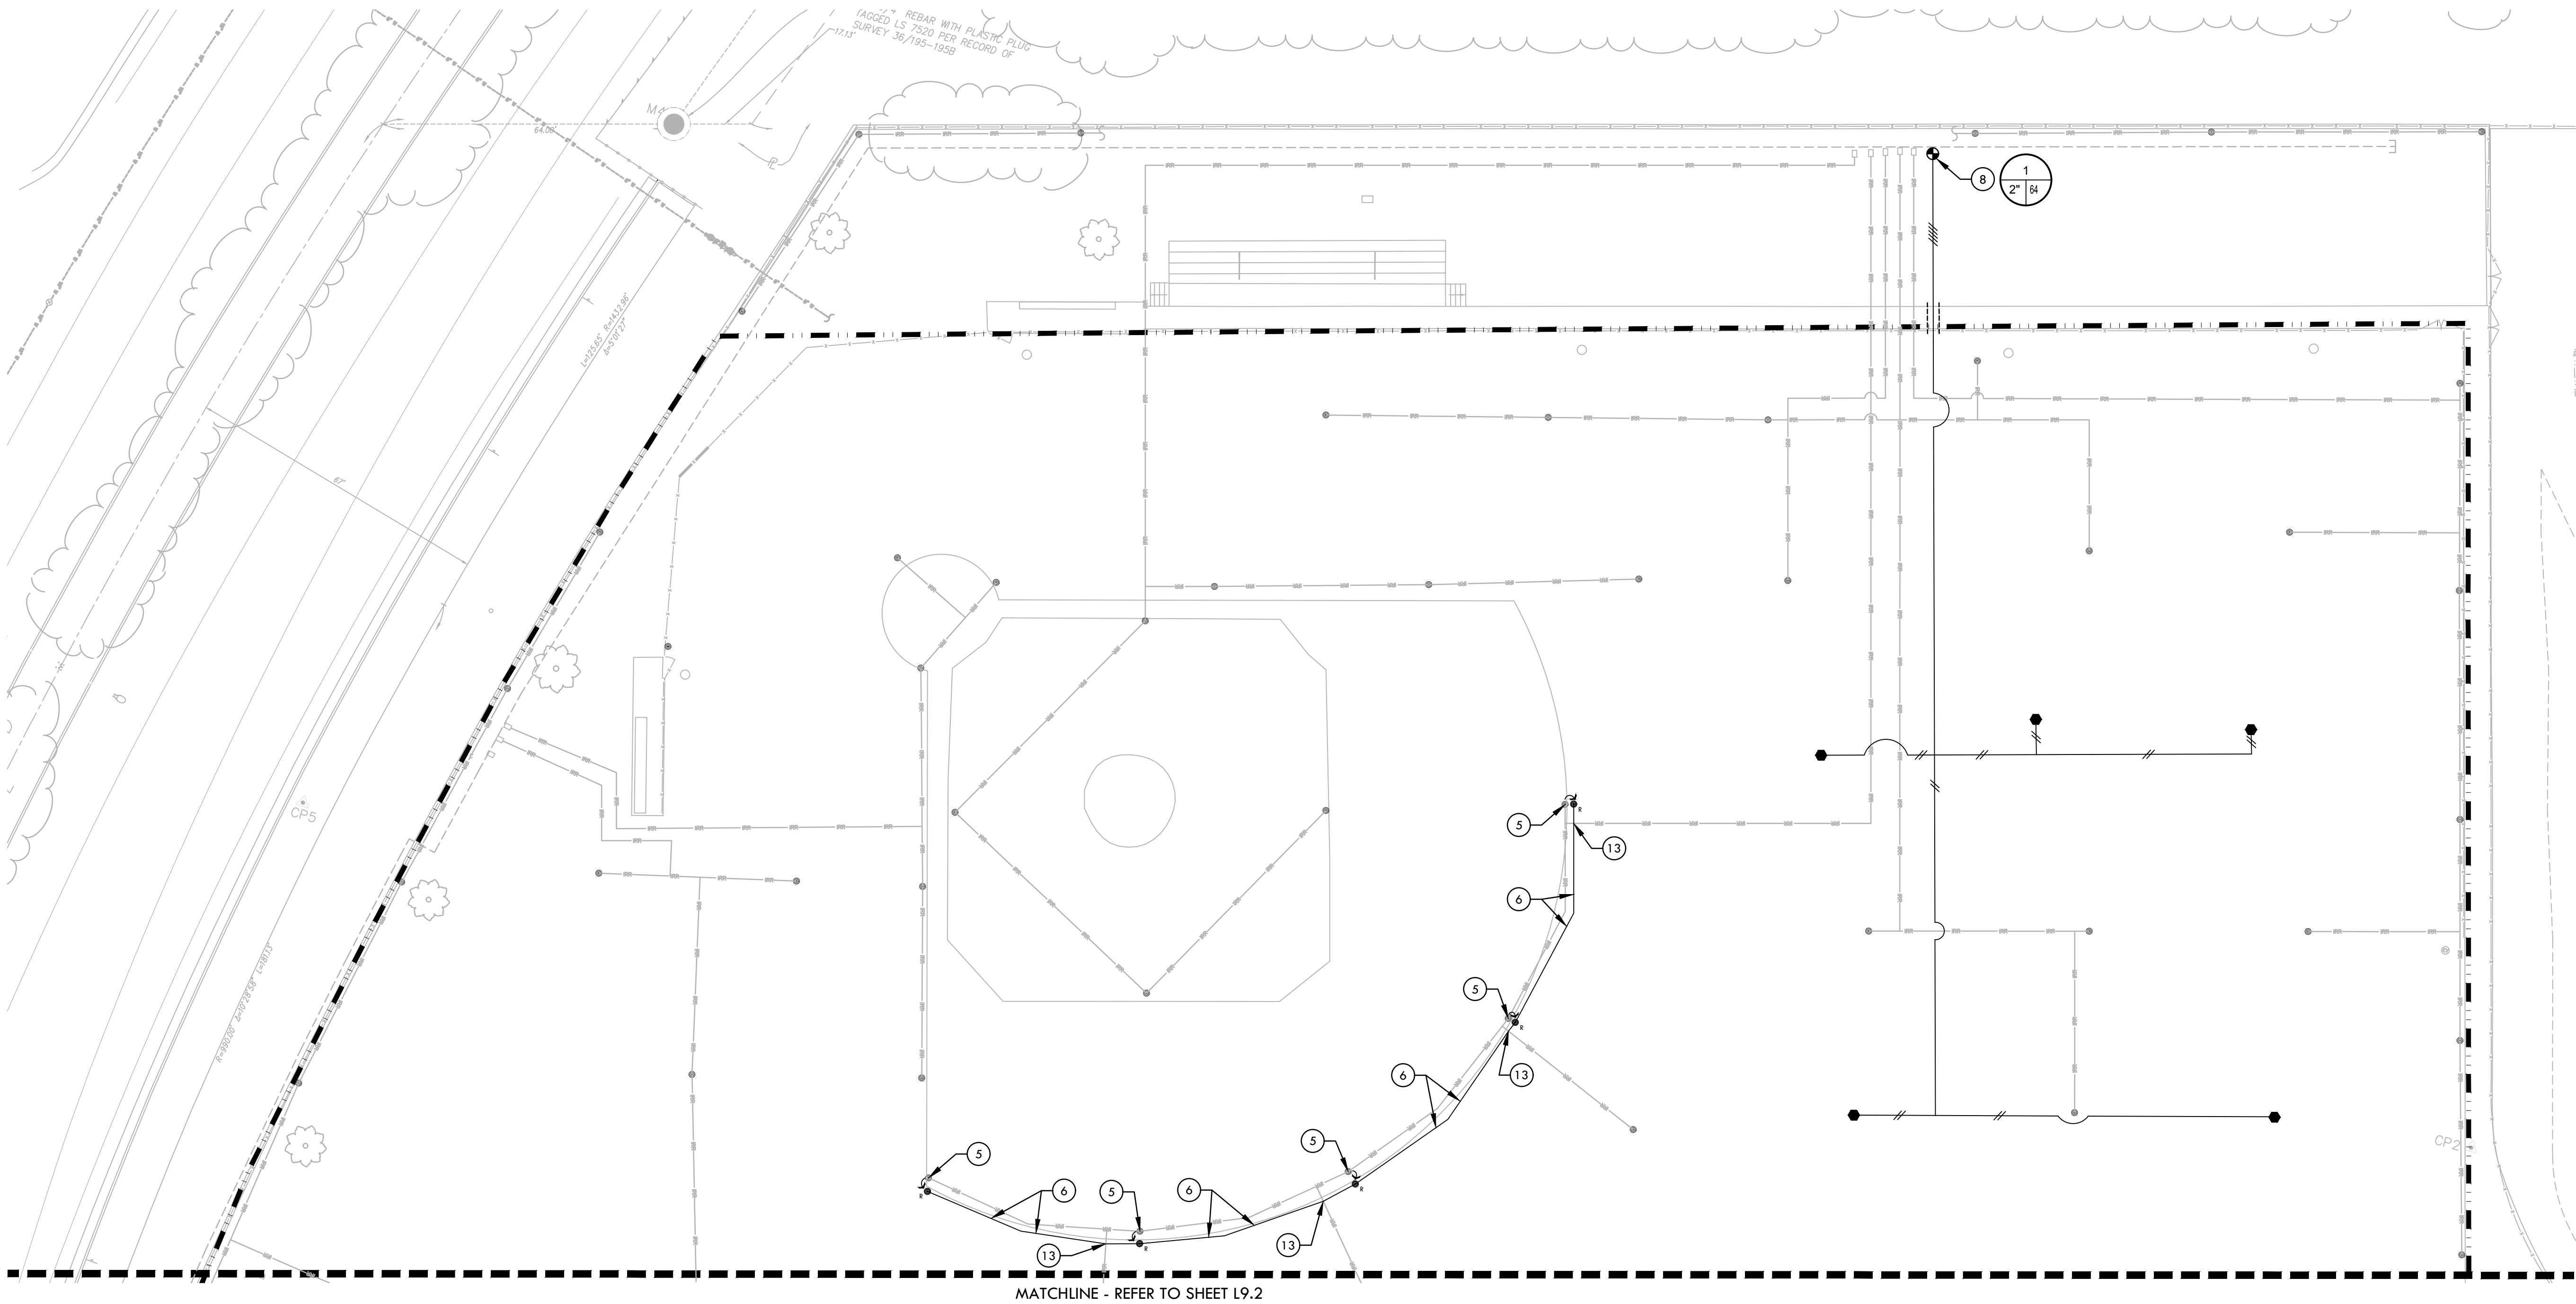


|   |   |
|---|---|
| ①   | IRRIGATION MAIN LINE POINT OF CONNECTION, TIE INTO EXISTING MAINLINE.   |
| ②   | DOMESTIC WATER LINE POINT OF CONNECTION (FOR QUICK COUPLERS), TIE INTO EXISTING DOMESTIC WATER LINE.  |
| ③   | CONTRACTOR TO CUT AND CAP EXISTING MAIN LINE, LATERAL LINE OR DOMESTIC WATER LINE, REFER TO PLANS.  |
| ④   | CONTRACTOR TO HORIZONTALLY BORE UNDERNEATH HARDSCAPE TO INSTALL SLEEVE AND RUN VALVE LATERAL LINE OR MAIN LINE AS SHOWN.  |
| ⑤   | EXISTING ROTOR TO BE RELOCATED. CONTRACTOR TO RELOCATE EXISTING ROTOR TO NEW LOCATION SHOWN ON THE PLANS, EXTEND NEW LATERAL LINE AS NEEDED.  |
| ⑥   | EXISTING LATERAL LINE TO BE REPLACED. CONTRACTOR TO REMOVE EXISTING LATERAL LINE AND INSTALL NEW PVC SCH. 40 LATERAL LINE SIZE PER THE PLANS.   |
| ⑦   | CONTRACTOR TO VERIFY EXISTING VALVE SIZE AND REPORT FINDINGS TO DISTRICT. IF EXISTING VALVE SIZE IS TOO SMALL FOR THE ADJUSTED ZONE, CONTRACTOR TO REMOVE EXISTING VALVE AND INSTALL APPROPRIATELY SIZED VALVE. |
| ⑧   | NEW VALVE/STATION. CONTRACTOR TO INSTALL VALVE ADJACENT TO EXISTING VALVES. VERIFY CONTROLLER OPERATION AND SPARE WIRES AVAILABLE AT THE EXISTING VALVES, EXTEND WIRE TO NEW VALVE AS NEEDED.                   |
| ⑨   | NEW VALVE TO BE WIRED USING SALVAGED WIRES FROM PROJECT SITE. REFER TO DEMO PLAN FOR ADDITIONAL INFORMATION. CONTRACTOR TO EXTEND WIRES TO IRRIGATION VALVE.  |
| ⑩   | AVOID UTILITY LINE OR STRUCTURE.  |
| ⑪   | IRRIGATION LINE /EQUIPMENT SHOWN IN HARDSCAPE FOR PLAN CLARITY. CONTRACTOR TO INSTALL IRRIGATION LINE/EQUIPMENT IN ADJACENT PLANTER.  |
| ⑫   | CONTRACTOR TO DETERMINE LATERAL LINE LAYOUT BASED ON PROJECT SITE EXISTING CONDITIONS. LATERAL LINE LAYOUT SHALL NOT EXCEED 5 FPS.  |
| ⑬   | CONTRACTOR TO CONNECT EXISTING LATERAL LINE TO NEW LATERAL LINE AS SHOWN ON THE DRAWINGS AND VERIFY SYSTEM OPERATION.   |
| ⑭   | CONTRACTOR TO REPAIR OR REPLACE ANY DAMAGED EXISTING IRRIGATION EQUIPMENT TO AS-WAS OR BETTER CONDITION. REFER TO DEMOLITION PLAN FOR ADDITIONAL INFORMATION.   |
| LIMIT OF WORK   |   |
| CONTROLLER STATION NUMBER<br>APPROX. GPM FLOW THROUGH VALVE |   |
| CONTROL VALVE SIZE  |   |

## IRRIGATION NOTES

- THIS SYSTEM IS DESIGNED TO OPERATE AT A MAXIMUM FLOW OF (XX) GPM WITH A MINIMUM (50) STATIC P.S.I. AT THE POINT OF CONNECTION. CONTRACTOR SHALL VERIFY PRESSURE PRIOR TO BEGINNING WORK. CONTACT OWNER IMMEDIATELY SHOULD DISCREPANCY ARISE AND RE-DIRECT WORK TO AVOID DELAY.
- CONTRACTOR SHALL COORDINATE ELECTRICAL SUPPLY WITH GENERAL CONTRACTOR. GENERAL CONTRACTOR SHALL STUB APPROPRIATE POWER SUPPLY IN VICINITY OF CONTROLLER LOCATION.
- IRRIGATION SYSTEM DESIGN IS DIAGRAMMATIC. WHERE PIPING, VALVES, QUICK COUPLERS, ETC. ARE SHOWN OUTSIDE PLANTING AREAS, OR LIMIT OF WORK; INTENT IS FOR PIPING, VALVES, ETC., TO BE INSTALLED WITHIN PLANTING AREAS OF PROPERTY. INDICATE EXACT LOCATIONS OF IRRIGATION EQUIPMENT ON RECORD DRAWINGS. REFER TO SPECIFICATIONS.
- CONTRACTOR SHALL PROGRAM CONTROLLER TO ENSURE PROPER IRRIGATION. BASED ON PLANT TYPE, EXPOSURE AND SEASON.
- CONTRACTOR SHALL USE EXTREME CARE WHERE IT IS NECESSARY TO TRENCH NEAR EXISTING TREES. EXCAVATION IN AREAS EXHIBITING ROOT 3" AND LARGER SHALL BE DONE BY HAND. ROOTS 2" OR LARGER IN DIAMETER DAMAGED IN CONSTRUCTION SHALL BE CLEANLY CUT.
- CONTRACTOR SHALL MAKE MINOR ADJUSTMENTS TO HEAD LOCATIONS IN FIELD AS NECESSARY.
- CONTRACTOR SHALL REFER TO DETAILS AND SPECIFICATIONS FOR ADDITIONAL INFORMATION.

## IRRIGATION LEGEND

| SYM. | ITEM                        | MODEL NO./ DESCRIPTION  | CAT. RAD./ DES. RAD. | GPM       | PSI | DTL REF |
|------|-----------------------------|---|----------------------|-----------|-----|---------|
| ⊖    | ROTOR                       | RAIN BIRD 6504 F4-PC-SS PARTIAL CIRCLE ROTOR  | 59°/50'              | 12.7      | 50  | H D6.0  |
| ●    | ROTOR                       | RAIN BIRD 6504 F4-FC-SS FULL CIRCLE ROTOR   | 59°/50'              | 12.7      | 50  |         |
| ⦿    | ROTATOR                     | RAINBIRD 1806-SAM-PRS BODY WITH R-VAN-14 ADJ. ARC / FULL CIRCLE NOZZLE  | 13°/11'              | 0.28-1.10 | 30  |         |
| ⊙    | ROTATOR                     | RAINBIRD 1806-SAM-PRS BODY WITH R-VAN-18 ADJ. ARC / FULL CIRCLE NOZZLE  | 16°/14'              | 0.42-1.65 | 30  |         |
| ⦿    | ROTATOR                     | RAINBIRD 1806-SAM-PRS BODY WITH R-VAN-24 ADJ. ARC / FULL CIRCLE NOZZLE  | 19°/17'              | 0.60-2.35 | 30  |         |
| ☐    | SPRAY                       | RAINBIRD 1806-SAM-PRS BODY WITH AVAN VARIABLE ARC NOZZLE  | 4°/3.5'              | 0.29-0.88 | 30  | I D6.0  |
| ☐    | SPRAY                       | RAINBIRD 1806-SAM-PRS BODY WITH BVAN VARIABLE ARC NOZZLE  | 6°/5'                | 0.37-1.20 | 30  |         |
| ☐    | SPRAY                       | RAINBIRD 1806-SAM-PRS BODY WITH BVAN VARIABLE ARC NOZZLE  | 8°/6.5'              | 0.72-1.70 | 30  |         |
| ☐    | SPRAY                       | RAINBIRD 1806-SAM-PRS BODY WITH 10VAN VARIABLE ARC NOZZLE   | 10°/8.5'             | 0.75-2.60 | 30  |         |
| ⊗    | ROTOR/SPRAY                 | NEW ROTOR/SPRAY HEAD TO MATCH EXISTING RADIUS AND THROW AS ADJACENT HEAD. CONTRACTOR TO ADJUST PATTERN AS NEEDED TO ACHIEVE HEAD TO HEAD COVERAGE.                                      |                      |           |     |         |
| ☐    | BUBBLER                     | RAIN BIRD: RWS-B-C-1402 ROOT WATER ASSEMBLY 2 PER 1.5 GAL. TREE, 4 PER 24" BOX, 6 PER 36" AND 48" BOX   | -                    | 0.5       |     | M D6.0  |
| ⦿    | REMOTE CONTROL VALVE        | RAIN BIRD: PEB SERIES REMOTE CONTROL VALVE WITH PRESSURE REGULATOR - SIZE AS NOTED  |                      |           |     | E D6.0  |
| ✂    | GATE VALVE                  | GATE VALVES 2" AND SMALLER SHALL BE NIBCO T-113. FOR VALVES ABOVE 2" IN SIZE UTILIZE NIBCO F-619 FLANGED VALVE WITH SQUARE OPERATING NUT.   |                      |           |     | D D6.0  |
| ◆    | QUICK COUPLER VALVE         | RAIN BIRD: 44LRC QUICK COUPLING VALVE IN LANDSCAPE  |                      |           |     | F D6.0  |
| ⬮    | QUICK COUPLER VALVE         | RAIN BIRD: 44LRC QUICK COUPLING VALVE IN HARDSCAPE OR SYNTHETIC TURF  |                      |           |     | G D6.0  |
|      | LATERAL LINE                | 3/4" LATERAL LINE - SCHEDULE 40 PVC WITH SOLVENT-WELD FITTINGS, WITH 18" COVER.   |                      |           |     |         |
|      | LATERAL LINE                | 1" LATERAL LINE - SCHEDULE 40 PVC WITH SOLVENT-WELD FITTINGS, WITH 18" COVER.   |                      |           |     |         |
|      | LATERAL LINE                | 1-1/4" LATERAL LINE - SCHEDULE 40 PVC WITH SOLVENT-WELD FITTINGS, WITH 18" COVER.   |                      |           |     |         |
|      | LATERAL LINE                | 1-1/2" LATERAL LINE - SCHEDULE 40 PVC WITH SOLVENT-WELD FITTINGS, WITH 18" COVER.   |                      |           |     |         |
|      | LATERAL LINE                | 2" LATERAL LINE - SCHEDULE 40 PVC WITH SOLVENT-WELD FITTINGS, WITH 18" COVER.   |                      |           |     |         |
|      | LATERAL LINE                | 2-1/2" LATERAL LINE - SCHEDULE 40 PVC WITH SOLVENT-WELD FITTINGS, WITH 18" COVER.   |                      |           |     |         |
|      | LATERAL LINE                | 3" LATERAL LINE - SCHEDULE 40 PVC WITH SOLVENT-WELD FITTINGS, WITH 18" COVER.   |                      |           |     |         |
|      | MAINLINE                    | 2" AND SMALLER, SCHEDULE 40 PVC WITH SOLVENT-WELD FITTINGS; 2-1/2" AND LARGER, CLASS 200 WITH RING - TIE CONNECTIONS WITH 24" COVER.  |                      |           |     |         |
|      | MAINLINE FOR QUICK COUPLERS | 2" SCHEDULE 40 PVC WITH SOLVENT-WELD FITTINGS WITH 24" COVER.   |                      |           |     |         |
|      | SLEEVES                     | IRRIGATION SLEEVE - CLASS 200 PVC, SIZE AS NOTED WITH 30" COVER.  |                      |           |     |         |
|      | EXISTING MAINLINE           | EXISTING IRRIGATION MAINLINE BASED ON AS-BUILTS PROVIDED. CONTRACTOR TO VERIFY SIZE AND LOCATIONS PRIOR TO CONSTRUCTION. MAIN LINE TO REMAIN UNLESS OTHERWISE NOTED.                    |                      |           |     |         |
|      | EXISTING MAINLINE           | EXISTING IRRIGATION MAINLINE FOR QUICK COUPLERS BASED ON AS-BUILTS PROVIDED. CONTRACTOR TO VERIFY SIZE AND LOCATIONS PRIOR TO CONSTRUCTION. MAIN LINE TO REMAIN UNLESS OTHERWISE NOTED. |                      |           |     |         |
|      | EXISTING LATERAL LINE       | EXISTING LATERAL LINE BASED ON AS-BUILTS PROVIDED. CONTRACTOR TO VERIFY APPROXIMATE SIZE AND LOCATIONS PRIOR TO CONSTRUCTION.   |                      |           |     |         |
|      | EXISTING IRRIGATION HEAD    | EXISTING IRRIGATION HEAD BASED ON AS-BUILTS PROVIDED. CONTRACTOR TO VERIFY APPROXIMATE LOCATIONS IN FIELD PRIOR TO CONSTRUCTION.  |                      |           |     |         |
|      | EXISTING IRRIGATION HEAD    | EXISTING IRRIGATION HEAD TO BE RELOCATED PER DRAWINGS. CONTRACTOR TO EXTEND LATERAL AS NEEDED. CONTRACTOR TO ADJUST SPRAY PATTERN AS NEEDED TO AVOID SPRAYING ADJACENT HARDSCAPE.       |                      |           |     |         |

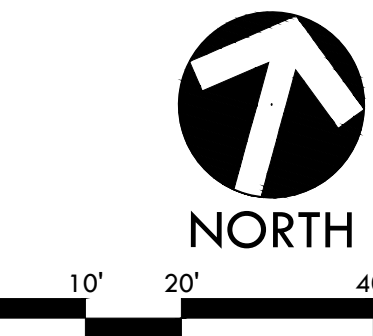

IDENTIFICATION STAMP  
DIV. OF THE STATE ARCHITECT  
APP. 02-118017 INC.  
REVIEWED FOR  
SS ☒ FLS ☒ ACS ☒  
DATE: 04/10/2020


**VERDE DESIGN**  
LANDSCAPE ARCHITECTURE  
CIVIL ENGINEERING  
SPORT PLANNING & DESIGN  
1843 Iron Point Rd #140  
Folsom, CA 95630  
tel: 916.415.6554  
fax: 408.985.7260  
www.VerdeDesignInc.com



STAMP

CONSULTANT

KEYMAP

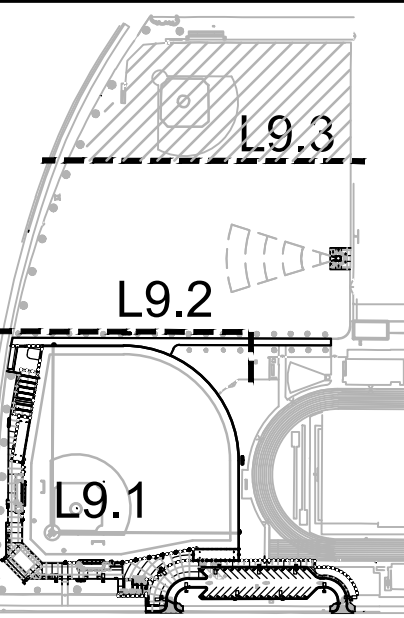

SHEET TITLE

IRRIGATION PLAN -  
MULTI-USE NORTH

PROJECT NAME

CHAVEZ HIGH SCHOOL  
STOCKTON USD  
ATHLETIC FACILITY  
IMPROVEMENTS

PROJECT ADDRESS

2929 WINDFLOWER LN  
STOCKTON, CA 95212

| SUBMITTAL               | DATE     |
|-------------------------|----------|
| DD/50% SUBMITTAL        | 10/25/19 |
| DSA SUBMITTAL           | 12/20/19 |
| DSA BACKCHECK SUBMITTAL | 03/27/20 |


| NO. | REVISIONS | DATE |
|-----|-----------|------|
| △   |           |      |
| △   |           |      |
|                           |                      |
|---------------------------|----------------------|
| DRAWN BY<br>JC            | CHECKED BY<br>CS     |
| DATE ISSUED<br>03/27/20   | SCALE<br>1" = 20'-0" |
| PROJ. NO.<br>1910900-1211 |                      |
| SHEET NO.<br>L9.3         | OF 122               |

IRRIGATION PLAN - MULTI-USE NORTH



ALL LANDSCAPE ARCHITECTURE AND LANDSCAPE ARCHITECTURE SERVICES ARE THE PROPERTY OF VERDE DESIGN, INC. AND WERE CREATED, EVOLVED, AND DEVELOPED FOR USE ON AND IN CONNECTION WITH THE SPECIFIED PROJECT. NONE OF SUCH IDEAS, DESIGNS, ARRANGEMENTS OR PLANS SHALL BE USED, REPRODUCED, OR PUBLISHED BY ANY METHOD, IN WHOLE OR IN PART, OR DISCLOSED TO ANY PERSON, FIRM, OR CORPORATION FOR ANY PURPOSES WITHOUT WRITTEN PERMISSION OF VERDE DESIGN, INC.

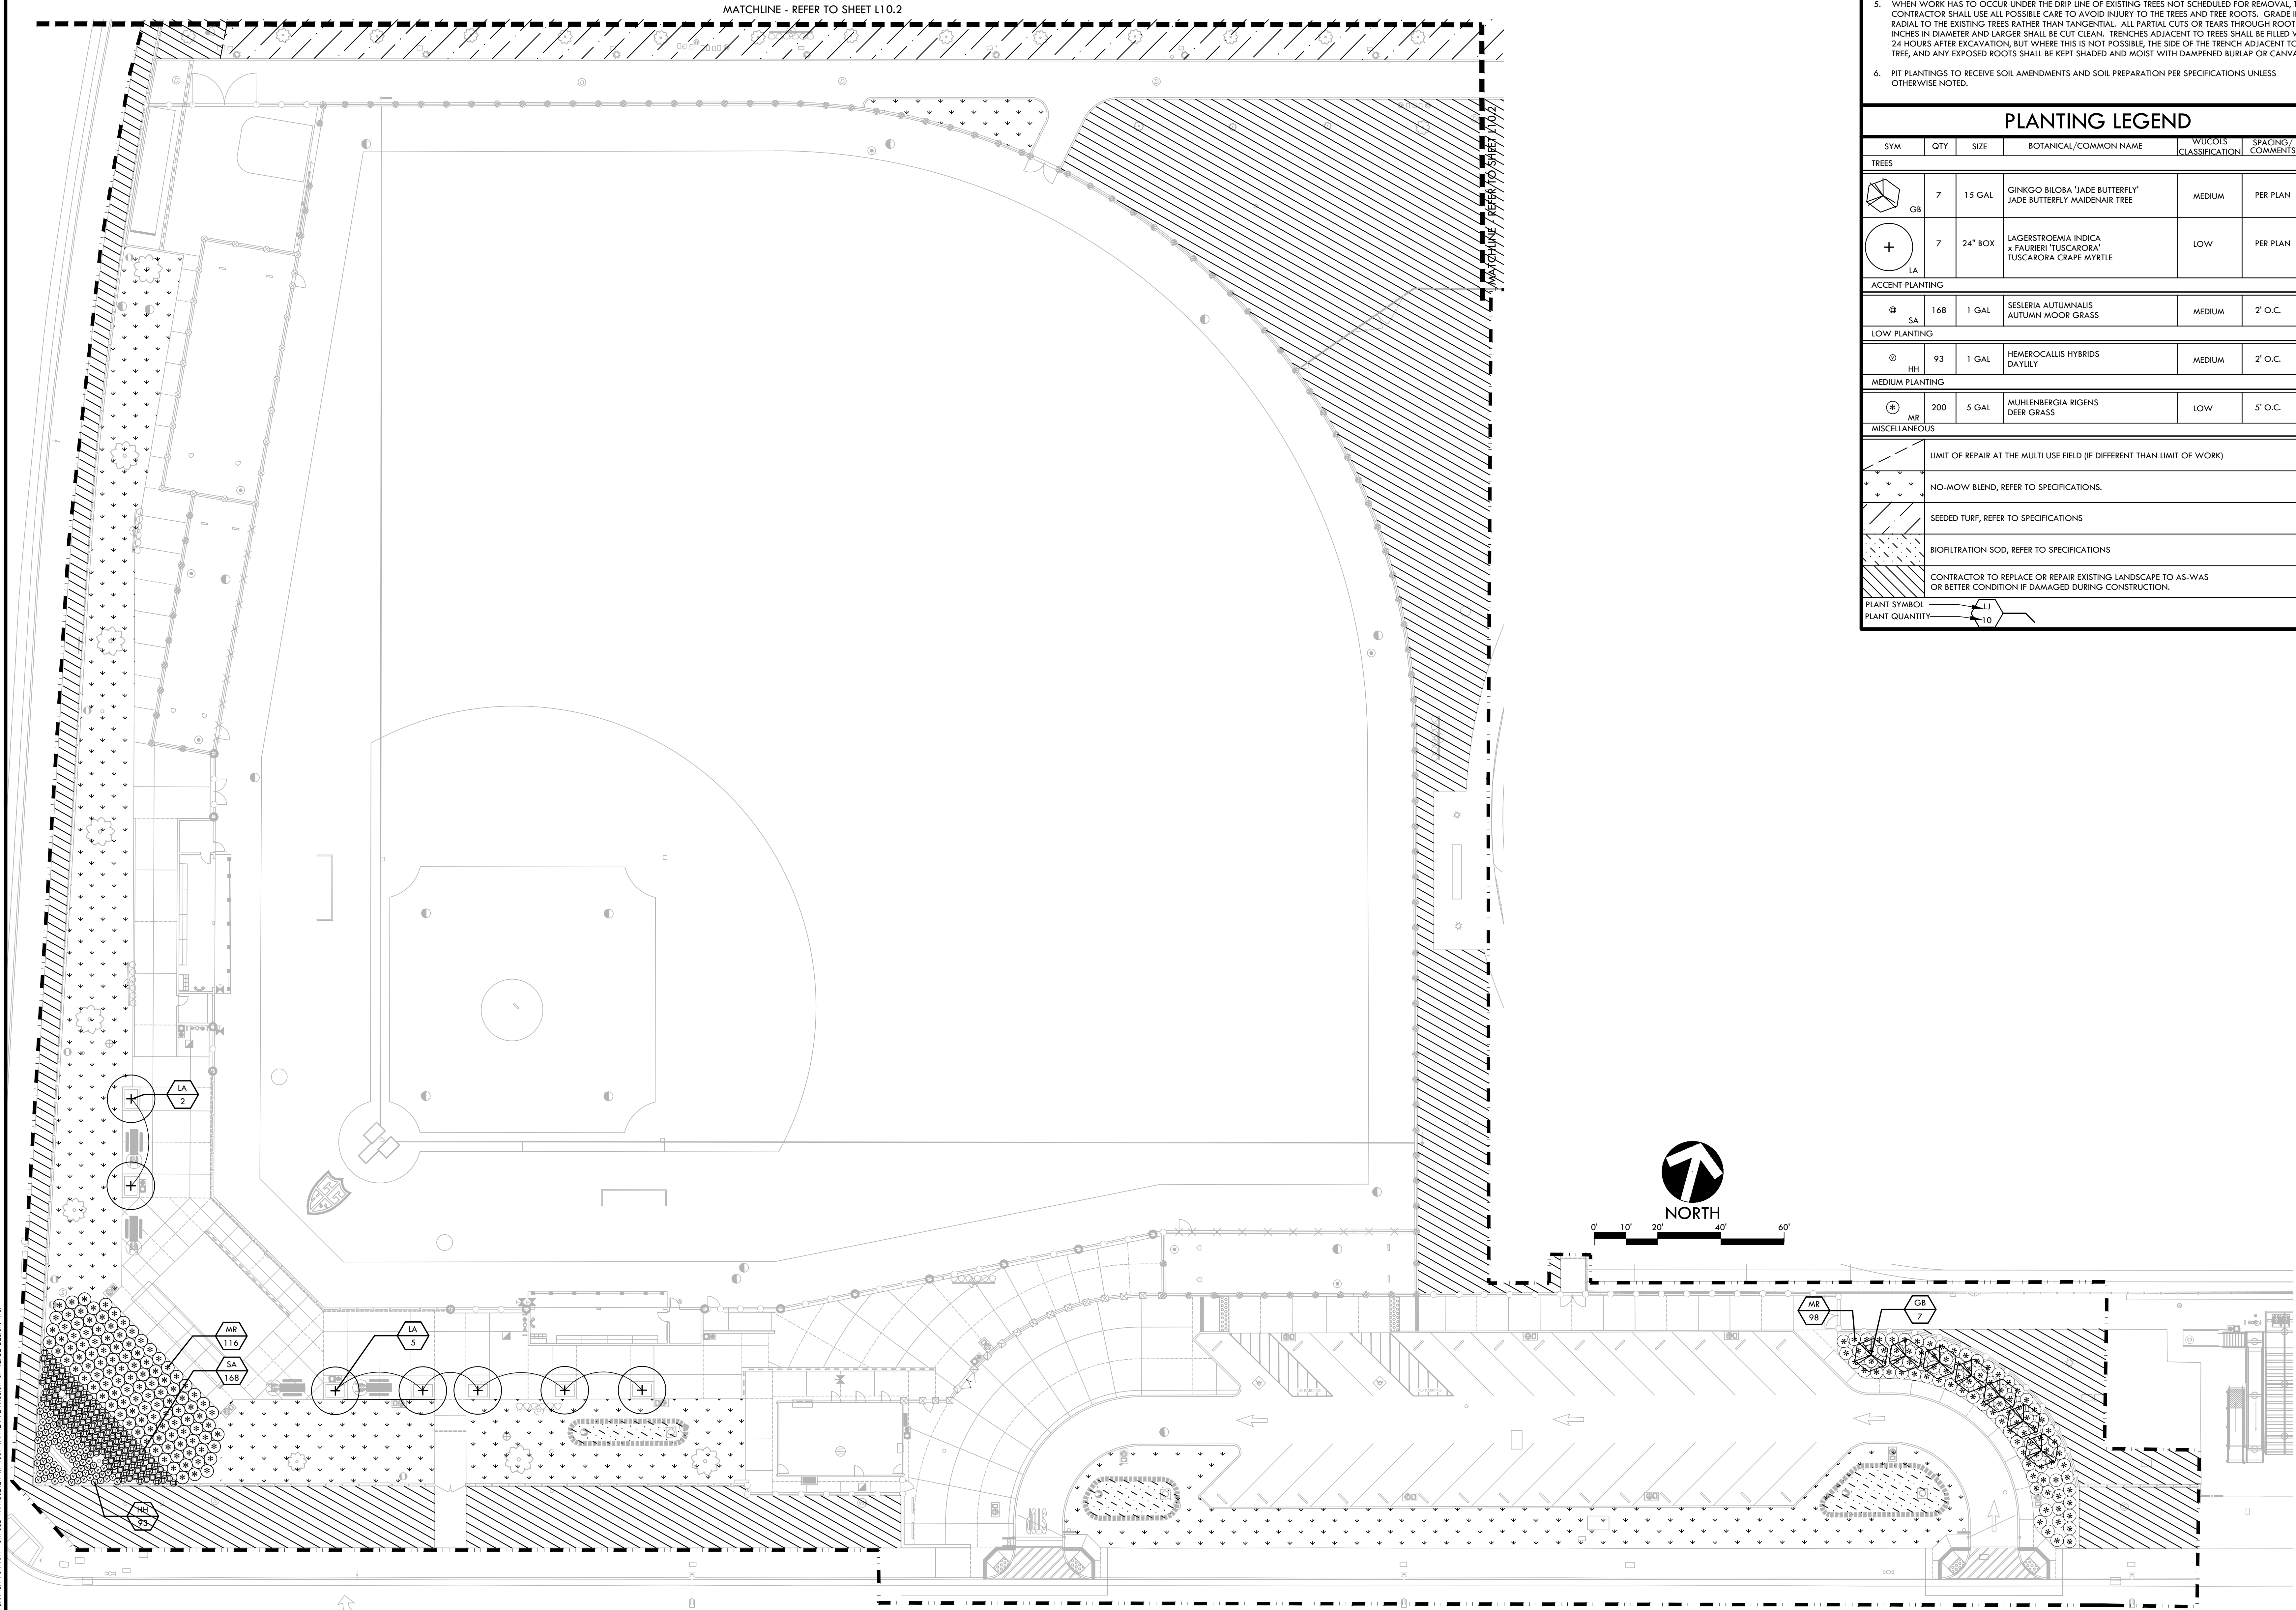


## PLANTING NOTES


1. PLANT COUNTS SHOWN ARE FOR BIDDING REFERENCE ONLY. CONTRACTOR SHALL SUPPLY ALL PLANTS REQUIRED TO FULFILL DESIGN INTENT AS SHOWN.
2. CONTRACTOR SHALL PROTECT AND MAINTAIN ALL PLANT MATERIAL FROM TIME OF DELIVERY TO TIME OF FINAL ACCEPTANCE. OWNER SHALL NOT BE RESPONSIBLE FOR LOSSES DUE TO VANDALISM, THEFT OR SEVERE WEATHER.
3. CONTRACTOR SHALL PLACE PLANT MATERIALS SO THEY DO NOT INTERFERE WITH IRRIGATION SYSTEM OR INHIBIT REQUIRED COVERAGE. PLANT LOCATIONS MAY BE ADJUSTED AS LONG AS DESIGN INTENT IS NOT COMPROMISED. CONTRACTOR SHALL SET OUT PLANT MATERIAL AS PER PLAN AND RECEIVE ACCEPTANCE FROM OWNER'S REPRESENTATIVE WITH RESPECT TO PLANT HEALTH AND LOCATION PRIOR TO INSTALLATION. CONTRACTOR SHALL GIVE MINIMUM 2 WORKING DAYS NOTICE FOR OBSERVATION AND SHALL HAVE ALL PLANT MATERIAL IN SPECIFIED LOCATIONS FOR REVIEW AT ONE TIME. CONTRACTOR SHALL REPLACE ANY MATERIAL AS REQUESTED BY OWNER'S REPRESENTATIVE.
4. ALL NON-TURF PLANTING AREAS SHALL RECEIVE A 3" LAYER OF MULCH TOP DRESS (UNLESS NOTED OTHERWISE). REFER TO SPECIFICATIONS.
5. WHEN WORK HAS TO OCCUR UNDER THE DRIP LINE OF EXISTING TREES NOT SCHEDULED FOR REMOVAL, THE CONTRACTOR SHALL USE ALL POSSIBLE CARE TO AVOID INJURY TO THE TREES AND TREE ROOTS. GRADE IN LINES RADIAL TO THE EXISTING TREES RATHER THAN TANGENTIAL. ALL PARTIAL CUTS OR TEARS THROUGH ROOTS TWO INCHES IN DIAMETER AND LARGER SHALL BE CUT CLEAN. TRENCHES ADJACENT TO TREES SHALL BE FILLED WITHIN 24 HOURS AFTER EXCAVATION, BUT WHERE THIS IS NOT POSSIBLE, THE SIDE OF THE TRENCH ADJACENT TO THE TREE, AND ANY EXPOSED ROOTS SHALL BE KEPT SHADED AND MOIST WITH DAMPENED BURLAP OR CANVAS.
6. PIT PLANTINGS TO RECEIVE SOIL AMENDMENTS AND SOIL PREPARATION PER SPECIFICATIONS UNLESS OTHERWISE NOTED.

## PLANTING LEGEND

| SYM             | QTY  | SIZE    | BOTANICAL/COMMON NAME  | WUCOLS CLASSIFICATION | SPACING/ COMMENTS | DTL REF |
|-----------------|--|---------|--|-----------------------|-------------------|---------|
| TREES           |  |         |  |                       |                   |         |
|                 | 7  | 15 GAL  | GINKGO BILOBA 'JADE BUTTERFLY'<br>JADE BUTTERFLY MAIDENHAIR TREE         | MEDIUM                | PER PLAN          |         |
|                 | 7  | 24" BOX | LAGERSTROEMIA INDICA<br>x FAURIERI 'TUSCARORA'<br>TUSCARORA CRAPE MYRTLE | LOW                   | PER PLAN          |         |
| ACCENT PLANTING |  |         |  |                       |                   |         |
|                 | 168  | 1 GAL   | SESLERIA AUTUMNALIS<br>AUTUMN MOOR GRASS                                 | MEDIUM                | 2' O.C.           |         |
| LOW PLANTING    |  |         |  |                       |                   |         |
|                 | 93   | 1 GAL   | HEMEROCALLIS HYBRIDS<br>DAYLILY  | MEDIUM                | 2' O.C.           |         |
| MEDIUM PLANTING |  |         |  |                       |                   |         |
|                 | 200  | 5 GAL   | MUHLENBERGIA RIGENS<br>DEER GRASS  | LOW                   | 5' O.C.           |         |
| MISCELLANEOUS   |  |         |  |                       |                   |         |
|                 | LIMIT OF REPAIR AT THE MULTI USE FIELD (IF DIFFERENT THAN LIMIT OF WORK)   |         |  |                       |                   |         |
|                 | NO-MOW BLEND, REFER TO SPECIFICATIONS.   |         |  |                       |                   |         |
|                 | SEEDED TURF, REFER TO SPECIFICATIONS   |         |  |                       |                   |         |
|                 | BIOPILTRATION SOD, REFER TO SPECIFICATIONS   |         |  |                       |                   |         |
|                 | CONTRACTOR TO REPLACE OR REPAIR EXISTING LANDSCAPE TO AS-WAS OR BETTER CONDITION IF DAMAGED DURING CONSTRUCTION. |         |  |                       |                   |         |
| PLANT SYMBOL    |  |         |  |                       |                   |         |
| PLANT QUANTITY  |  |         |  |                       |                   |         |

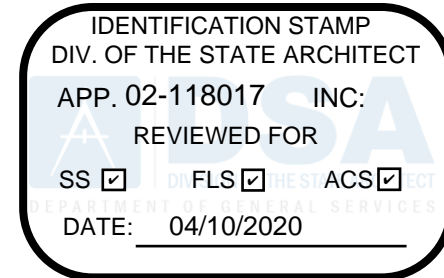

CONSULTANT

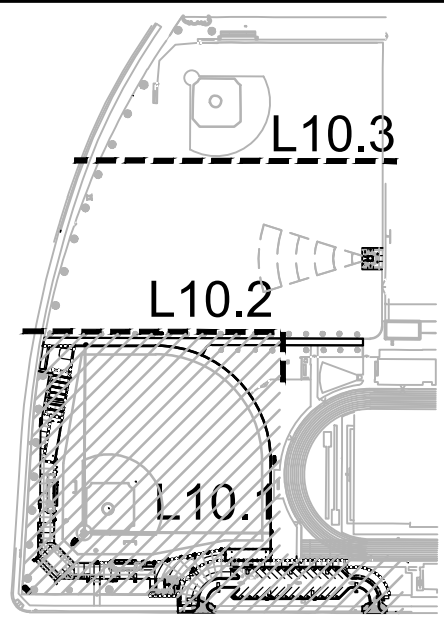

SHEET TITLE

## PLANTING PLAN - BASEBALL FIELD

PROJECT NAME

CHAVEZ HIGH SCHOOL  
STOCKTON USD  
ATHLETIC FACILITY  
IMPROVEMENTS

PROJECT ADDRESS

2929 WINDFLOWER LN  
STOCKTON, CA 95212

SUBMITTAL

DD/50% SUBMITTAL

DSA SUBMITTAL

DSA BACKCHECK SUBMITTAL

NO. REVISIONS

DATE

DATE


DATE


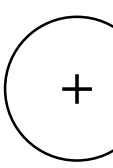



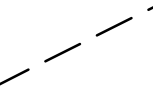
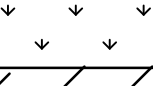
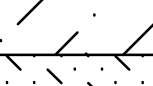
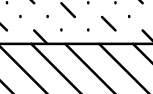
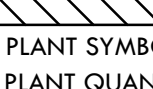

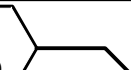
DATE

DATE

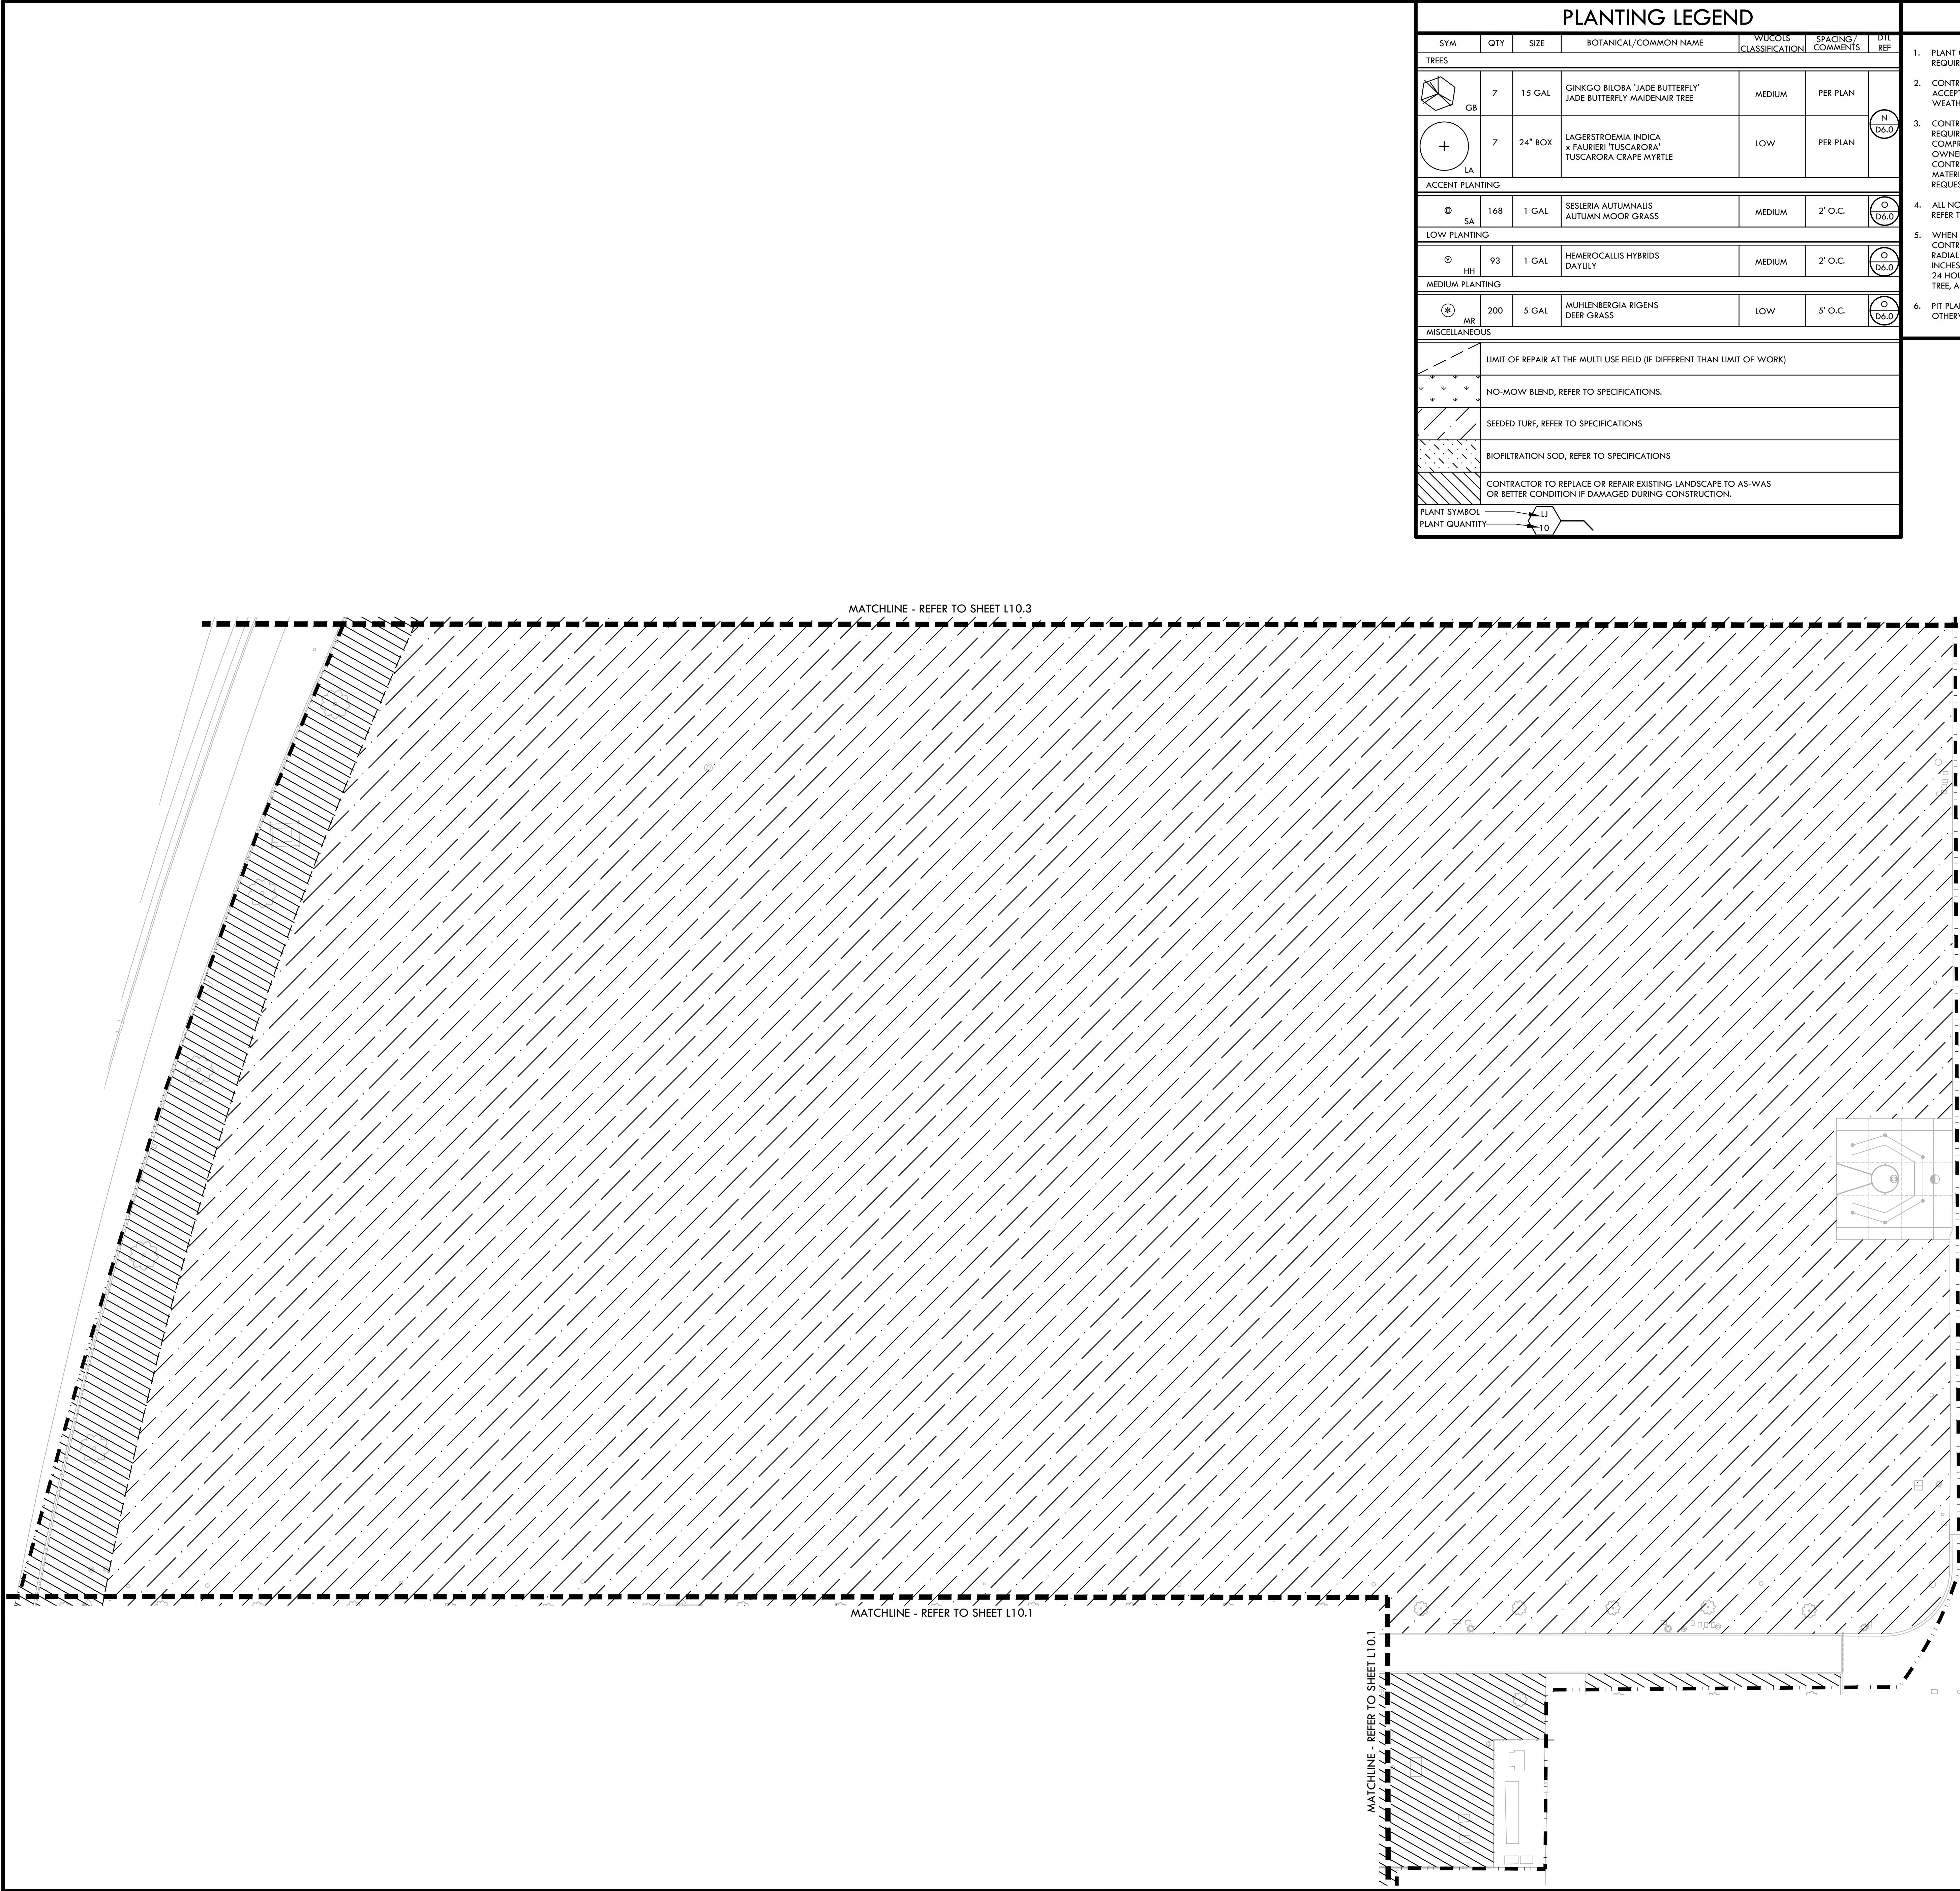

ALL LANDSCAPE ARCHITECTURE, PLANS, SPECIFICATIONS, OR PRESENTATIONS OF THESE DRAWINGS ARE OWNED BY AND THE PROPERTY OF VERDE DESIGN, INC. AND WERE CREATED, EVOLVED, AND DEVELOPED FOR USE ON AND IN CONNECTION WITH THE SPECIFIED PROJECT. NONE OF SUCH IDEAL DESIGN, ARRANGEMENTS OR PLANS SHALL BE USED, REPRODUCED, OR PUBLISHED BY ANY METHOD, IN WHOLE OR IN PART, OR DISCLOSED TO ANY PERSON, FIRM, OR CORPORATION FOR ANY PURPOSES WHATSOEVER WITHOUT WRITTEN PERMISSION OF VERDE DESIGN, INC.



| PLANTING LEGEND   |  |   |                       |   |                                |         |          |
|---|--|---|-----------------------|---|--------------------------------|---------|----------|
| SYM   | QTY  | SIZE  | BOTANICAL/COMMON NAME | WUCOLS CLASSIFICATION                       | SPACING/ COMMENTS              | DTL REF |          |
| TREES   |  |   |                       |   |                                |         |          |
|  | GB   | 7   | 15 GAL                | GINKGO BILOBA 'JADE BUTTERFLY'              | JADE BUTTERFLY MAIDENHAIR TREE | MEDIUM  | PER PLAN |
|  | LA   | 7   | 24" BOX               | LAGERSTROEMIA INDICA x FAURIERI 'TUSCARORA' | TUSCARORA CRAPE MYRTLE         | LOW     | PER PLAN |
| ACCENT PLANTING   |  |   |                       |   |                                |         |          |
|  | SA   | 168   | 1 GAL                 | SESLERIA AUTUMNALIS                         | AUTUMN MOOR GRASS              | MEDIUM  | 2' O.C.  |
| LOW PLANTING  |  |   |                       |   |                                |         |          |
|  | HH   | 93  | 1 GAL                 | HEMEROCALLIS HYBRIDS                        | DAYLILY                        | MEDIUM  | 2' O.C.  |
| MEDIUM PLANTING   |  |   |                       |   |                                |         |          |
|  | MR   | 200   | 5 GAL                 | MUEHLENBERGIA RIGENS                        | DEER GRASS                     | LOW     | 5' O.C.  |
| MISCELLANEOUS   |  |   |                       |   |                                |         |          |
|  | LIMIT OF REPAIR AT THE MULTI USE FIELD (IF DIFFERENT THAN LIMIT OF WORK)   |   |                       |   |                                |         |          |
|  | NO-MOW BLEND, REFER TO SPECIFICATIONS.   |   |                       |   |                                |         |          |
|  | SEEDED TURF, REFER TO SPECIFICATIONS   |   |                       |   |                                |         |          |
|  | BIOFILTRATION SOD, REFER TO SPECIFICATIONS   |   |                       |   |                                |         |          |
|  | CONTRACTOR TO REPLACE OR REPAIR EXISTING LANDSCAPE TO AS-WAS OR BETTER CONDITION IF DAMAGED DURING CONSTRUCTION. |   |                       |   |                                |         |          |
| PLANT SYMBOL  |  |  |                       |   |                                |         |          |
| PLANT QUANTITY  |  |  |                       |   |                                |         |          |

- ### PLANTING NOTES
1. PLANT COUNTS SHOWN ARE FOR BIDDING REFERENCE ONLY. CONTRACTOR SHALL SUPPLY ALL PLANTS REQUIRED TO FULFILL DESIGN INTENT AS SHOWN.
  2. CONTRACTOR SHALL PROTECT AND MAINTAIN ALL PLANT MATERIAL FROM TIME OF DELIVERY TO TIME OF FINAL ACCEPTANCE. OWNER SHALL NOT BE RESPONSIBLE FOR LOSSES DUE TO VANDALISM, THEFT OR SEVERE WEATHER.
  3. CONTRACTOR SHALL PLACE PLANT MATERIALS SO THEY DO NOT INTERFERE WITH IRRIGATION SYSTEM OR INHIBIT REQUIRED COVERAGE. PLANT LOCATIONS MAY BE ADJUSTED AS LONG AS DESIGN INTENT IS NOT COMPROMISED. CONTRACTOR SHALL SET OUT PLANT MATERIAL AS PER PLAN AND RECEIVE ACCEPTANCE FROM OWNER'S REPRESENTATIVE WITH RESPECT TO PLANT HEALTH AND LOCATION PRIOR TO INSTALLATION. CONTRACTOR SHALL GIVE MINIMUM 2 WORKING DAYS NOTICE FOR OBSERVATION AND SHALL HAVE ALL PLANT MATERIAL IN SPECIFIED LOCATIONS FOR REVIEW AT ONE TIME. CONTRACTOR SHALL REPLACE ANY MATERIAL AS REQUESTED BY OWNER'S REPRESENTATIVE.
  4. ALL NON-TURF PLANTING AREAS SHALL RECEIVE A 3" LAYER OF MULCH TOP DRESS (UNLESS NOTED OTHERWISE). REFER TO SPECIFICATIONS.
  5. WHEN WORK HAS TO OCCUR UNDER THE DRIP LINE OF EXISTING TREES NOT SCHEDULED FOR REMOVAL, THE CONTRACTOR SHALL USE ALL POSSIBLE CARE TO AVOID INJURY TO THE TREES AND TREE ROOTS. GRADE IN LINES RADIAL TO THE EXISTING TREES RATHER THAN TANGENTIAL. ALL PARTIAL CUTS OR TEARS THROUGH ROOTS TWO INCHES IN DIAMETER AND LARGER SHALL BE CUT CLEAN. TRENCHES ADJACENT TO TREES SHALL BE FILLED WITHIN 24 HOURS AFTER EXCAVATION, BUT WHERE THIS IS NOT POSSIBLE, THE SIDE OF THE TRENCH ADJACENT TO THE TREE, AND ANY EXPOSED ROOTS SHALL BE KEPT SHADED AND MOIST WITH DAMPENED BURLAP OR CANVAS.
  6. PIT PLANTINGS TO RECEIVE SOIL AMENDMENTS AND SOIL PREPARATION PER SPECIFICATIONS UNLESS OTHERWISE NOTED.

IDENTIFICATION STAMP  
DIV. OF THE STATE ARCHITECT  
APP. 02-118017 INC.  
REVIEWED FOR  
SS ☒ FLS ☐ ACS ☐  
DATE: 04/10/2020

**VERDE DESIGN**  
LANDSCAPE ARCHITECTURE  
CIVIL ENGINEERING  
SPORT PLANNING & DESIGN  
1843 Iron Point Rd #140  
Folsom, CA 95630  
tel: 916.415.6554  
fax: 408.985.7260  
www.VerdeDesignInc.com

STAMP

CONSULTANT

KEYMAP

SHEET TITLE  
**PLANTING  
PLAN -  
MULTI-USE SOUTH**

PROJECT NAME  
**CHAVEZ HIGH SCHOOL  
STOCKTON USD  
ATHLETIC FACILITY  
IMPROVEMENTS**

PROJECT ADDRESS  
**2929 WINDFLOWER LN  
STOCKTON, CA 95212**

|                         |          |
|-------------------------|----------|
| SUBMITTAL               | DATE     |
| DD/50% SUBMITTAL        | 10/25/19 |
| DSA SUBMITTAL           | 12/20/19 |
| DSA BACKCHECK SUBMITTAL | 03/27/20 |


|     |           |      |
|-----|-----------|------|
| NO. | REVISIONS | DATE |
|     |           |      |
|     |           |      |
|                           |                      |
|---------------------------|----------------------|
| DRAWN BY<br>HM            | CHECKED BY<br>CS     |
| DATE ISSUED<br>03/27/20   | SCALE<br>1" = 20'-0" |
| PROJ. NO.<br>1910900-1211 |                      |
| SHEET NO.<br><b>L10.2</b> | OF 122               |


PLANTING PLAN - MULTI-USE SOUTH



ALL LANDSCAPE ARCHITECTURE AND LANDSCAPE ARCHITECTURE REPRESENTATIVE OF VERDE DESIGN, INC. AND THE PROPERTY OF VERDE DESIGN, INC. AND WERE CREATED, DEVELOPED, AND DELETED FOR USE ON AND IN CONNECTION WITH THE SPECIFIED PROJECT. NONE OF SUCH IDEAS, DESIGNS, ARRANGEMENTS OR PLANS SHALL BE USED, REPRODUCED, OR PUBLISHED BY ANY METHOD, IN WHOLE OR IN PART, OR DISCLOSED TO ANY PERSON, FIRM, OR CORPORATION FOR ANY PURPOSE WITHOUT THE WRITTEN PERMISSION OF VERDE DESIGN, INC.

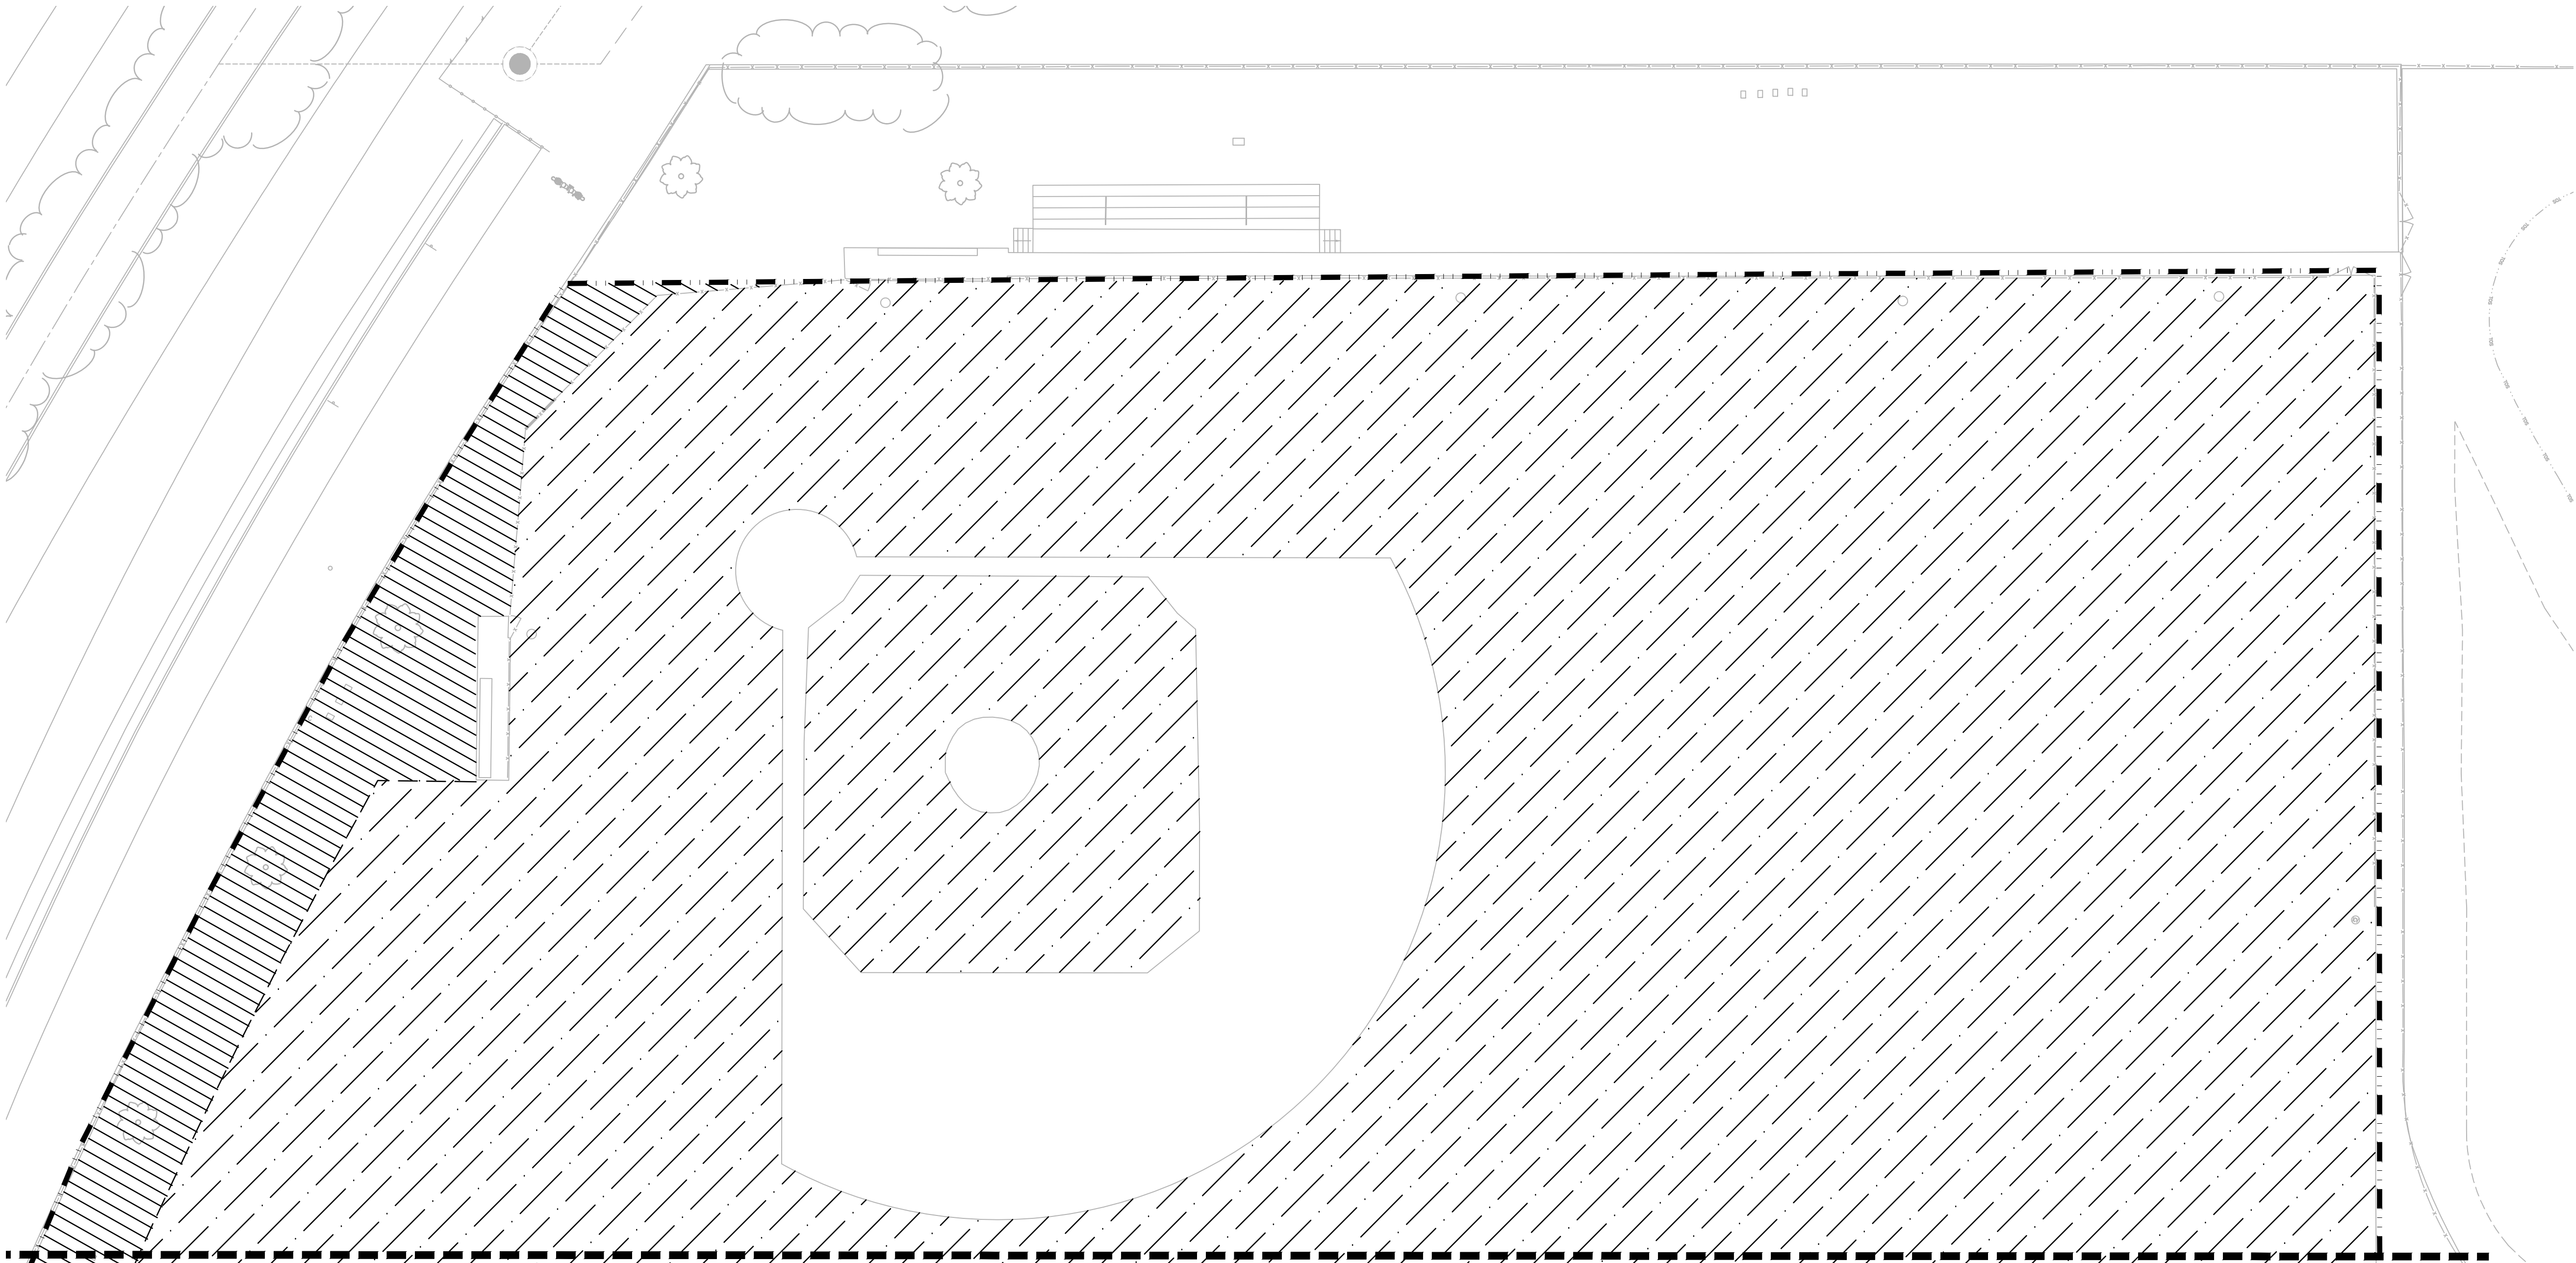

MATCHLINE - REFER TO SHEET L10.2

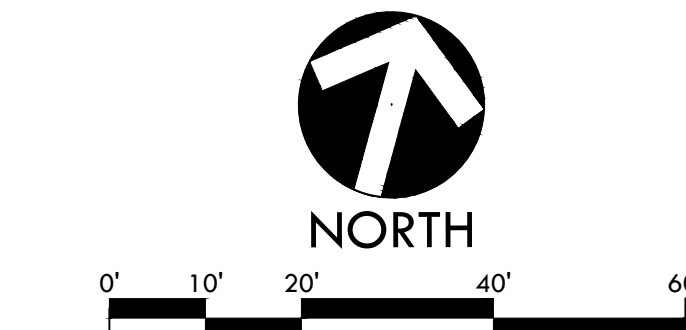

## PLANTING NOTES

1. PLANT COUNTS SHOWN ARE FOR BIDDING REFERENCE ONLY. CONTRACTOR SHALL SUPPLY ALL PLANTS REQUIRED TO FULFILL DESIGN INTENT AS SHOWN.
2. CONTRACTOR SHALL PROTECT AND MAINTAIN ALL PLANT MATERIAL FROM TIME OF DELIVERY TO TIME OF FINAL ACCEPTANCE. OWNER SHALL NOT BE RESPONSIBLE FOR LOSSES DUE TO VANDALISM, THEFT OR SEVERE WEATHER.
3. CONTRACTOR SHALL PLACE PLANT MATERIALS SO THEY DO NOT INTERFERE WITH IRRIGATION SYSTEM OR INHIBIT REQUIRED COVERAGE. PLANT LOCATIONS MAY BE ADJUSTED AS LONG AS DESIGN INTENT IS NOT COMPROMISED. CONTRACTOR SHALL SET OUT PLANT MATERIAL AS PER PLAN AND RECEIVE ACCEPTANCE FROM OWNER'S REPRESENTATIVE WITH RESPECT TO PLANT HEALTH AND LOCATION PRIOR TO INSTALLATION. CONTRACTOR SHALL GIVE MINIMUM 2 WORKING DAYS NOTICE FOR OBSERVATION AND SHALL HAVE ALL PLANT MATERIAL IN SPECIFIED LOCATIONS FOR REVIEW AT ONE TIME. CONTRACTOR SHALL REPLACE ANY MATERIAL AS REQUESTED BY OWNER'S REPRESENTATIVE.
4. ALL NON-TURF PLANTING AREAS SHALL RECEIVE A 3" LAYER OF MULCH TOP DRESS (UNLESS NOTED OTHERWISE). REFER TO SPECIFICATIONS.
5. WHEN WORK HAS TO OCCUR UNDER THE DRIP LINE OF EXISTING TREES NOT SCHEDULED FOR REMOVAL, THE CONTRACTOR SHALL USE ALL POSSIBLE CARE TO AVOID INJURY TO THE TREES AND TREE ROOTS. GRADE IN LINES RADIAL TO THE EXISTING TREES RATHER THAN TANGENTIAL. ALL PARTIAL CUTS OR TEARS THROUGH ROOTS TWO INCHES IN DIAMETER AND LARGER SHALL BE CUT CLEAN. TRENCHES ADJACENT TO TREES SHALL BE FILLED WITHIN 24 HOURS AFTER EXCAVATION, BUT WHERE THIS IS NOT POSSIBLE, THE SIDE OF THE TRENCH ADJACENT TO THE TREE, AND ANY EXPOSED ROOTS SHALL BE KEPT SHADED AND MOIST WITH DAMPENED BURLAP OR CANVAS.
6. PIT PLANTINGS TO RECEIVE SOIL AMENDMENTS AND SOIL PREPARATION PER SPECIFICATIONS UNLESS OTHERWISE NOTED.

## PLANTING LEGEND

| SYM             | QTY  | SIZE    | BOTANICAL/COMMON NAME  | WUCOLS CLASSIFICATION | SPACING/ COMMENTS | DTL REF |
|-----------------|--|---------|--|-----------------------|-------------------|---------|
| TREES           |  |         |  |                       |                   |         |
|                 | 7  | 15 GAL  | GINKGO BILOBA 'JADE BUTTERFLY'<br>JADE BUTTERFLY MAIDENHAIR TREE         | MEDIUM                | PER PLAN          |         |
|                 | 7  | 24" BOX | LAGERSTROEMIA INDICA<br>x FAURIERI 'TUSCARORA'<br>TUSCARORA CRAPE MYRTLE | LOW                   | PER PLAN          |         |
| ACCENT PLANTING |  |         |  |                       |                   |         |
|                 | 168  | 1 GAL   | SESLERIA AUTUMNALIS<br>AUTUMN MOOR GRASS                                 | MEDIUM                | 2' O.C.           |         |
| LOW PLANTING    |  |         |  |                       |                   |         |
|                 | 93   | 1 GAL   | HEMEROCALLIS HYBRIDS<br>DAYLILY  | MEDIUM                | 2' O.C.           |         |
| MEDIUM PLANTING |  |         |  |                       |                   |         |
|                 | 200  | 5 GAL   | MUHLENBERGIA RIGENS<br>DEER GRASS  | LOW                   | 5' O.C.           |         |
| MISCELLANEOUS   |  |         |  |                       |                   |         |
|                 | LIMIT OF REPAIR AT THE MULTI USE FIELD (IF DIFFERENT THAN LIMIT OF WORK)   |         |  |                       |                   |         |
|                 | NO-MOW BLEND, REFER TO SPECIFICATIONS.   |         |  |                       |                   |         |
|                 | SEEDED TURF, REFER TO SPECIFICATIONS   |         |  |                       |                   |         |
|                 | BIOFILTRATION SOD, REFER TO SPECIFICATIONS   |         |  |                       |                   |         |
|                 | CONTRACTOR TO REPLACE OR REPAIR EXISTING LANDSCAPE TO AS-WAS OR BETTER CONDITION IF DAMAGED DURING CONSTRUCTION. |         |  |                       |                   |         |
| PLANT SYMBOL    |  |         |  |                       |                   |         |
| PLANT QUANTITY  |  |         |  |                       |                   |         |

IDENTIFICATION STAMP  
DIV. OF THE STATE ARCHITECT  
APP. 02-118017 INC.  
REVIEWED FOR  
SS ☒ FLS ☒ ACS ☒  
DATE: 04/10/2020


**VERDE DESIGN**  
LANDSCAPE ARCHITECTURE  
CIVIL ENGINEERING  
SPORT PLANNING & DESIGN  
1843 Iron Point Rd #140  
Folsom, CA 95630  
tel: 916.415.6554  
fax: 408.985.7260  
www.VerdeDesignInc.com

STAMP



CONSULTANT

KEYMAP

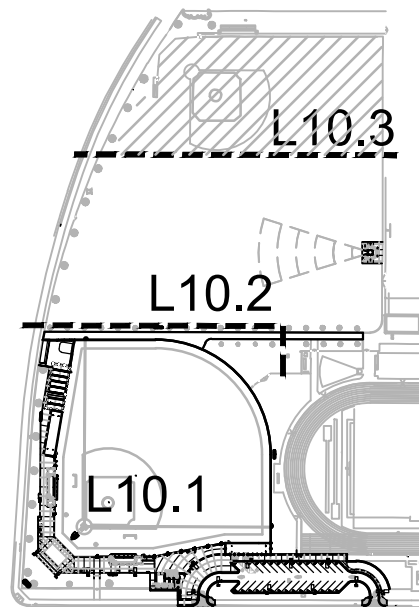

SHEET TITLE

PLANTING  
PLAN -  
MULTI-USE NORTH

PROJECT NAME

CHAVEZ HIGH SCHOOL  
STOCKTON USD  
ATHLETIC FACILITY  
IMPROVEMENTS

PROJECT ADDRESS

2929 WINDFLOWER LN  
STOCKTON, CA 95212

| SUBMITTAL               | DATE     |
|-------------------------|----------|
| DD/50% SUBMITTAL        | 10/25/19 |
| DSA SUBMITTAL           | 12/20/19 |
| DSA BACKCHECK SUBMITTAL | 03/27/20 |

| NO. | REVISIONS | DATE |
|-----|-----------|------|
| 1   |           |      |
| 2   |           |      |
| 3   |           |      |
| 4   |           |      |
| 5   |           |      |

|             |              |            |             |
|-------------|--------------|------------|-------------|
| DRAWN BY    | HM           | CHECKED BY | CS          |
| DATE ISSUED | 03/27/20     | SCALE      | 1" = 20'-0" |
| PROJ. NO.   | 1910900-1211 |            |             |

SHEET NO.  
**L10.3** OF 122

PLANTING PLAN - MULTI-USE NORTH



ALL DESIGN, DESIGN DEVELOPMENT, AND CONSTRUCTION DETAILS ARE THE PROPERTY OF VERDE DESIGN, INC. AND WERE CREATED, EVOLVED, AND DEVELOPED FOR USE ON AND IN CONNECTION WITH THE SPECIFIED PROJECT. NONE OF SUCH IDEAS, DESIGNS, ARRANGEMENTS OR PLANS SHALL BE USED, REPRODUCED, OR PUBLISHED IN WHOLE OR IN PART, OR DISCLOSED TO ANY PERSON, FIRM, OR ORGANIZATION FOR ANY PURPOSES WITHOUT WRITTEN PERMISSION OF VERDE DESIGN, INC.

DRAWING NAME: Y:\Projects\FO\2019\1910900 - Chavez Restort\CAD\01-D-DR-- Athletics.dwg  
PLOT DATE: 03-30-20 PLOTTED BY: station40


S

R

Q

P

STORM DRAIN MESSAGE AND LOCATION NTS

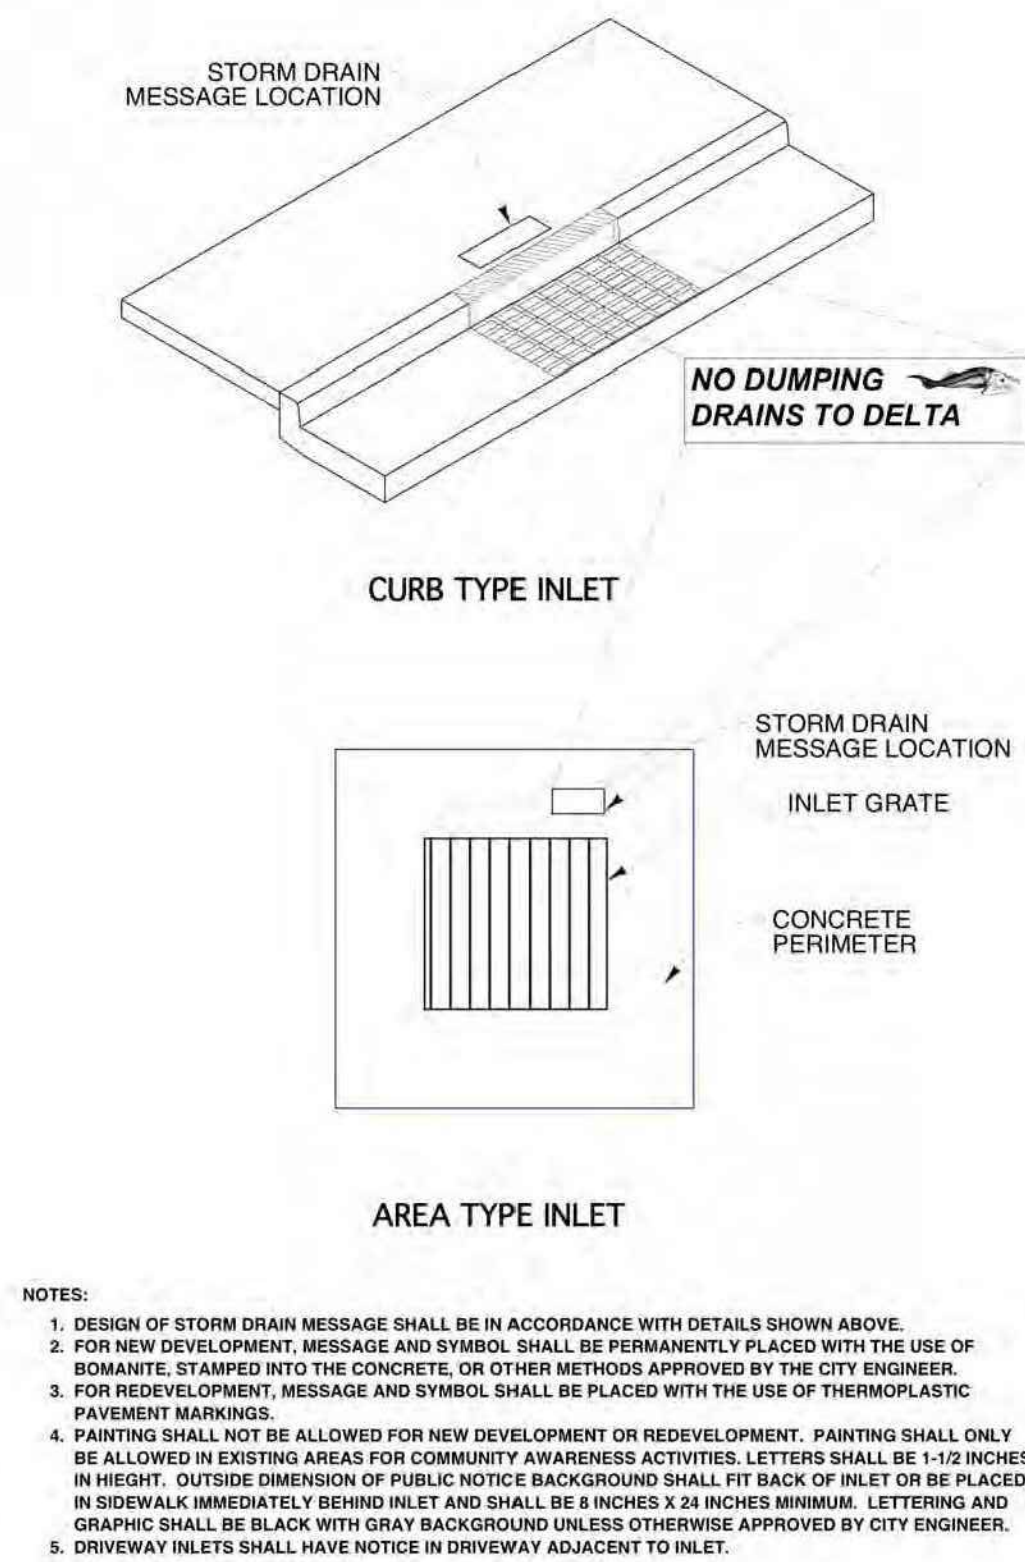

O


N

M

L

K

STORM DRAIN CLEANOUT NTS

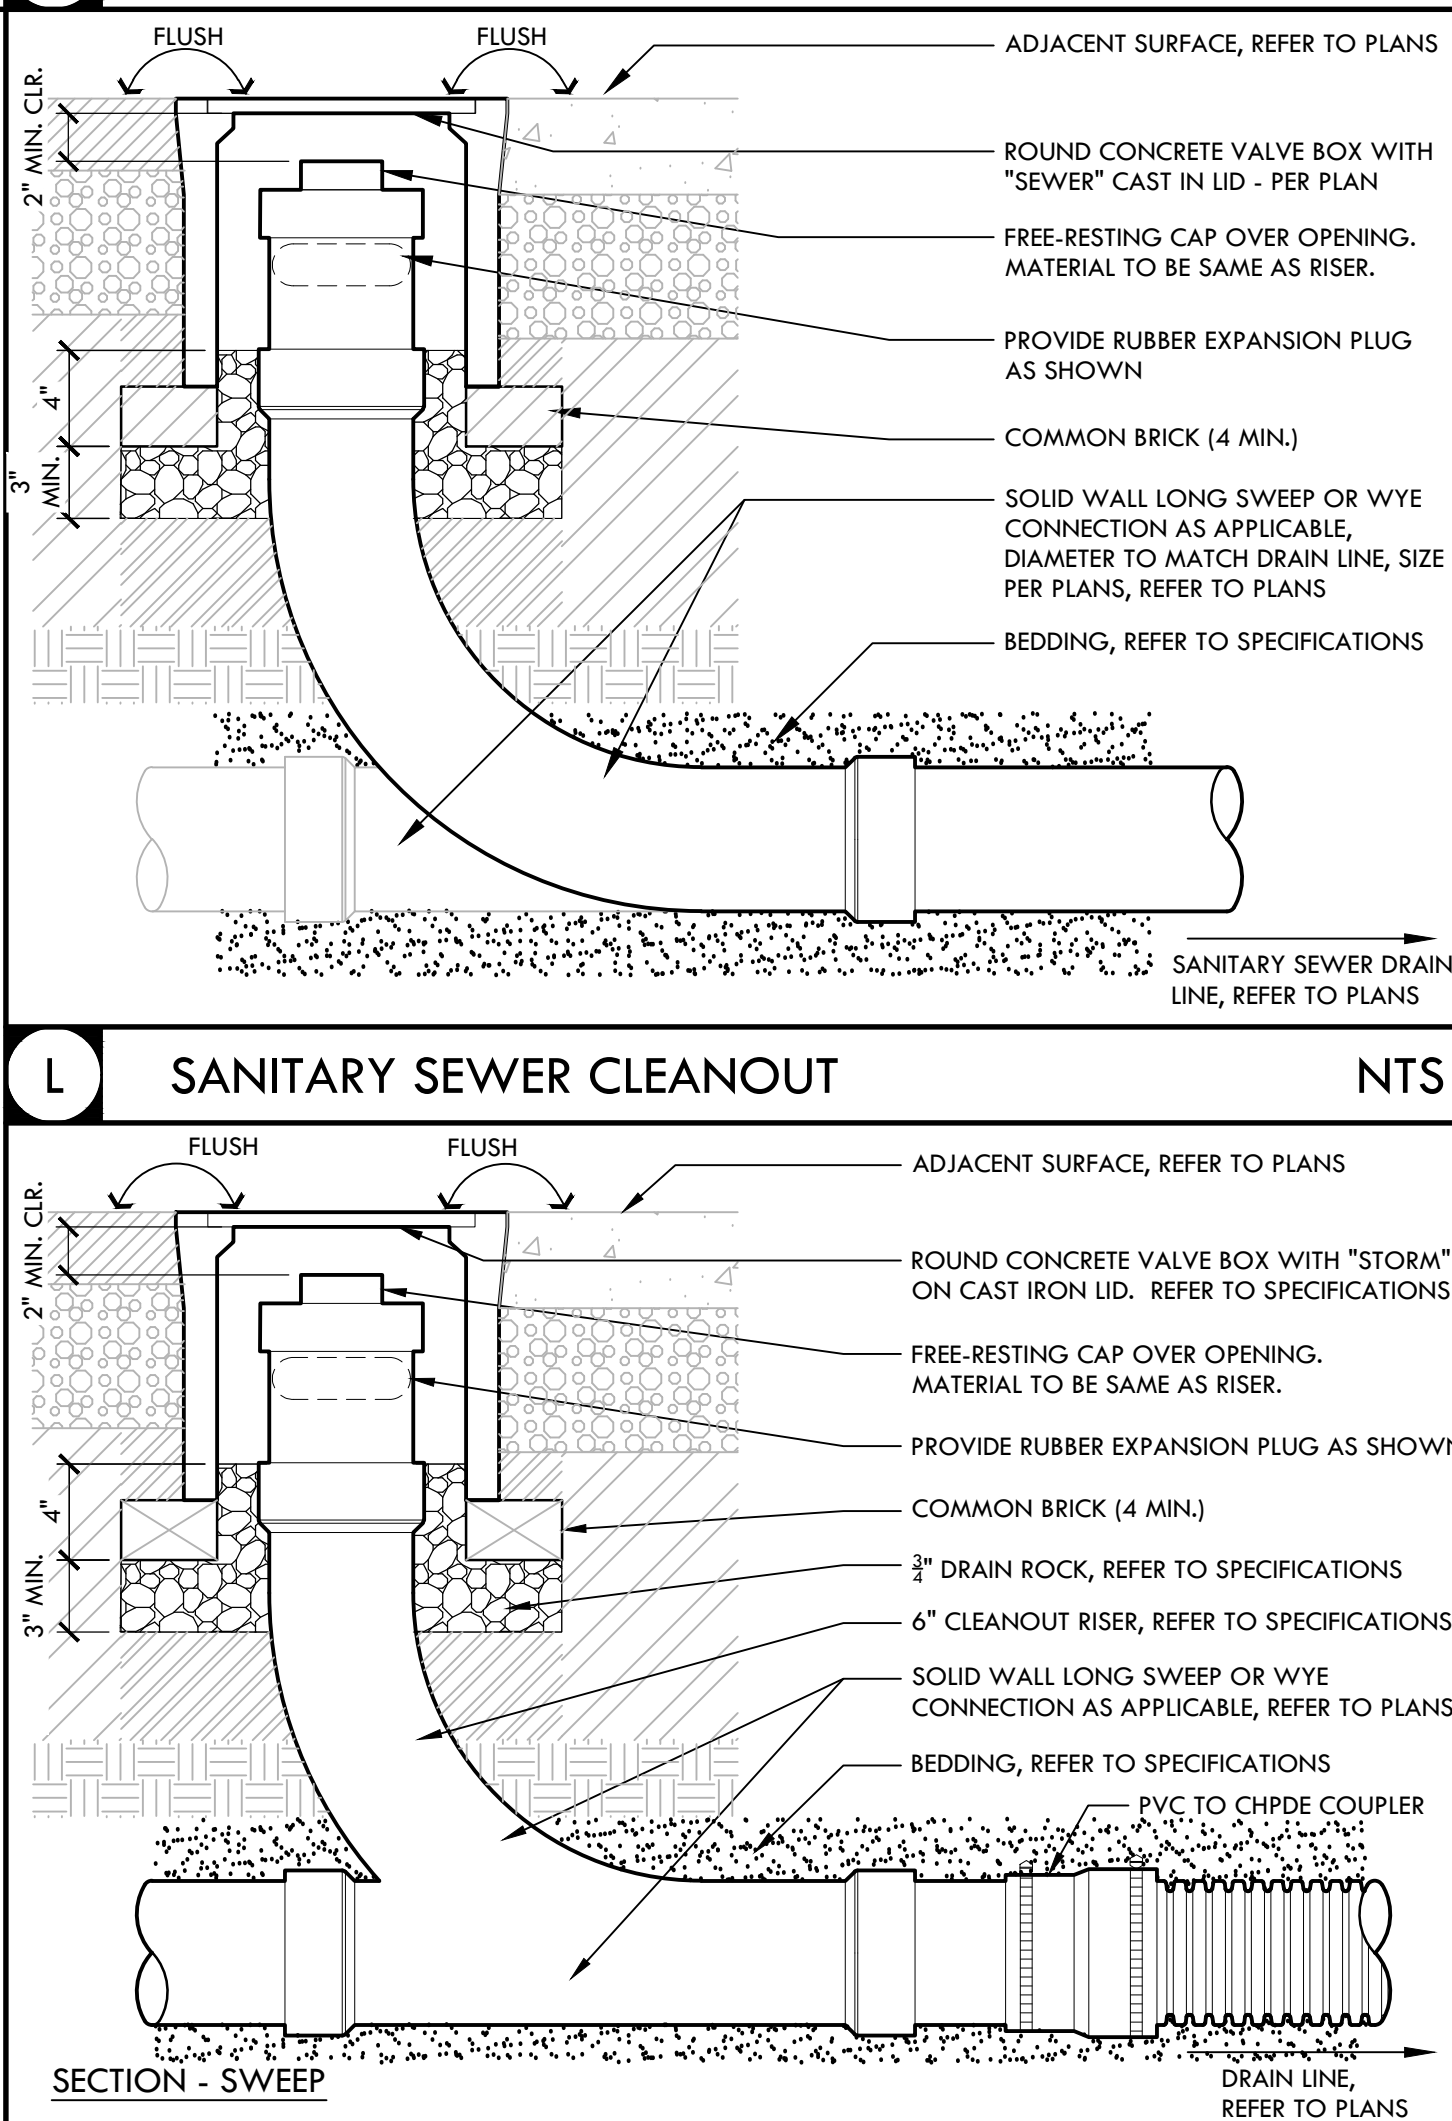

J


I

H

G

F

PERFORATED SUBDRAIN NTS

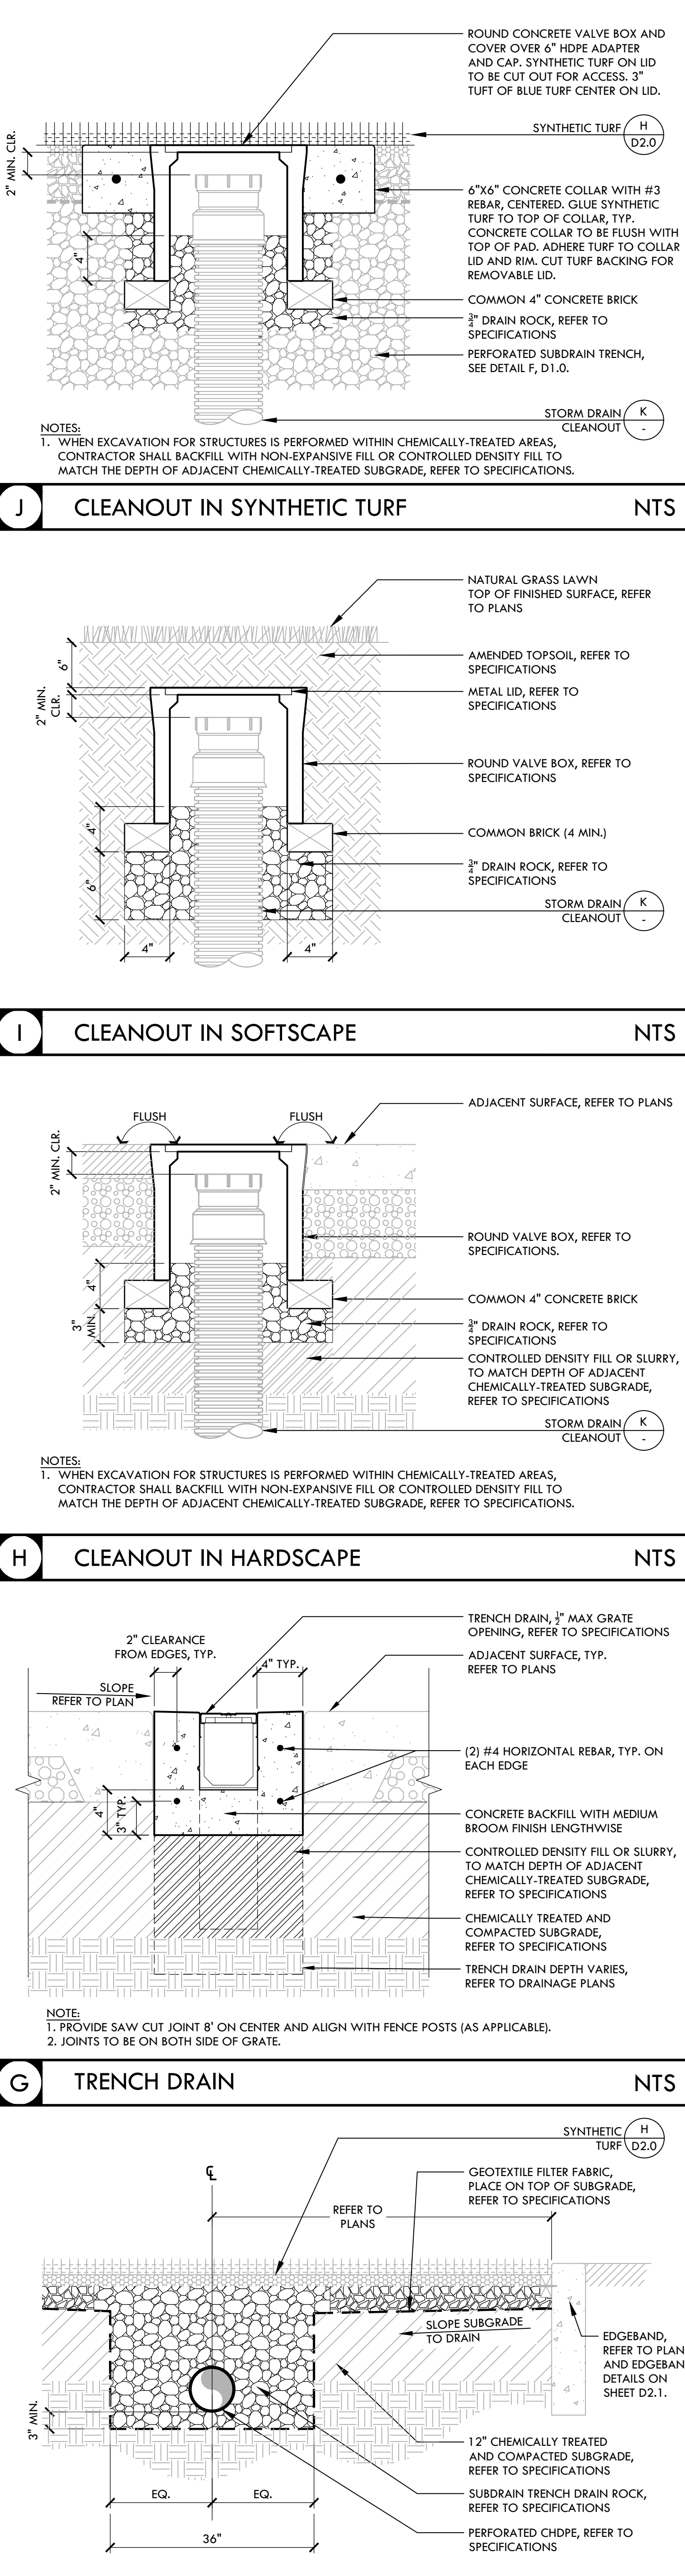

E


D

C

B

A

CATCH BASIN / JUNCTION BOX NTS

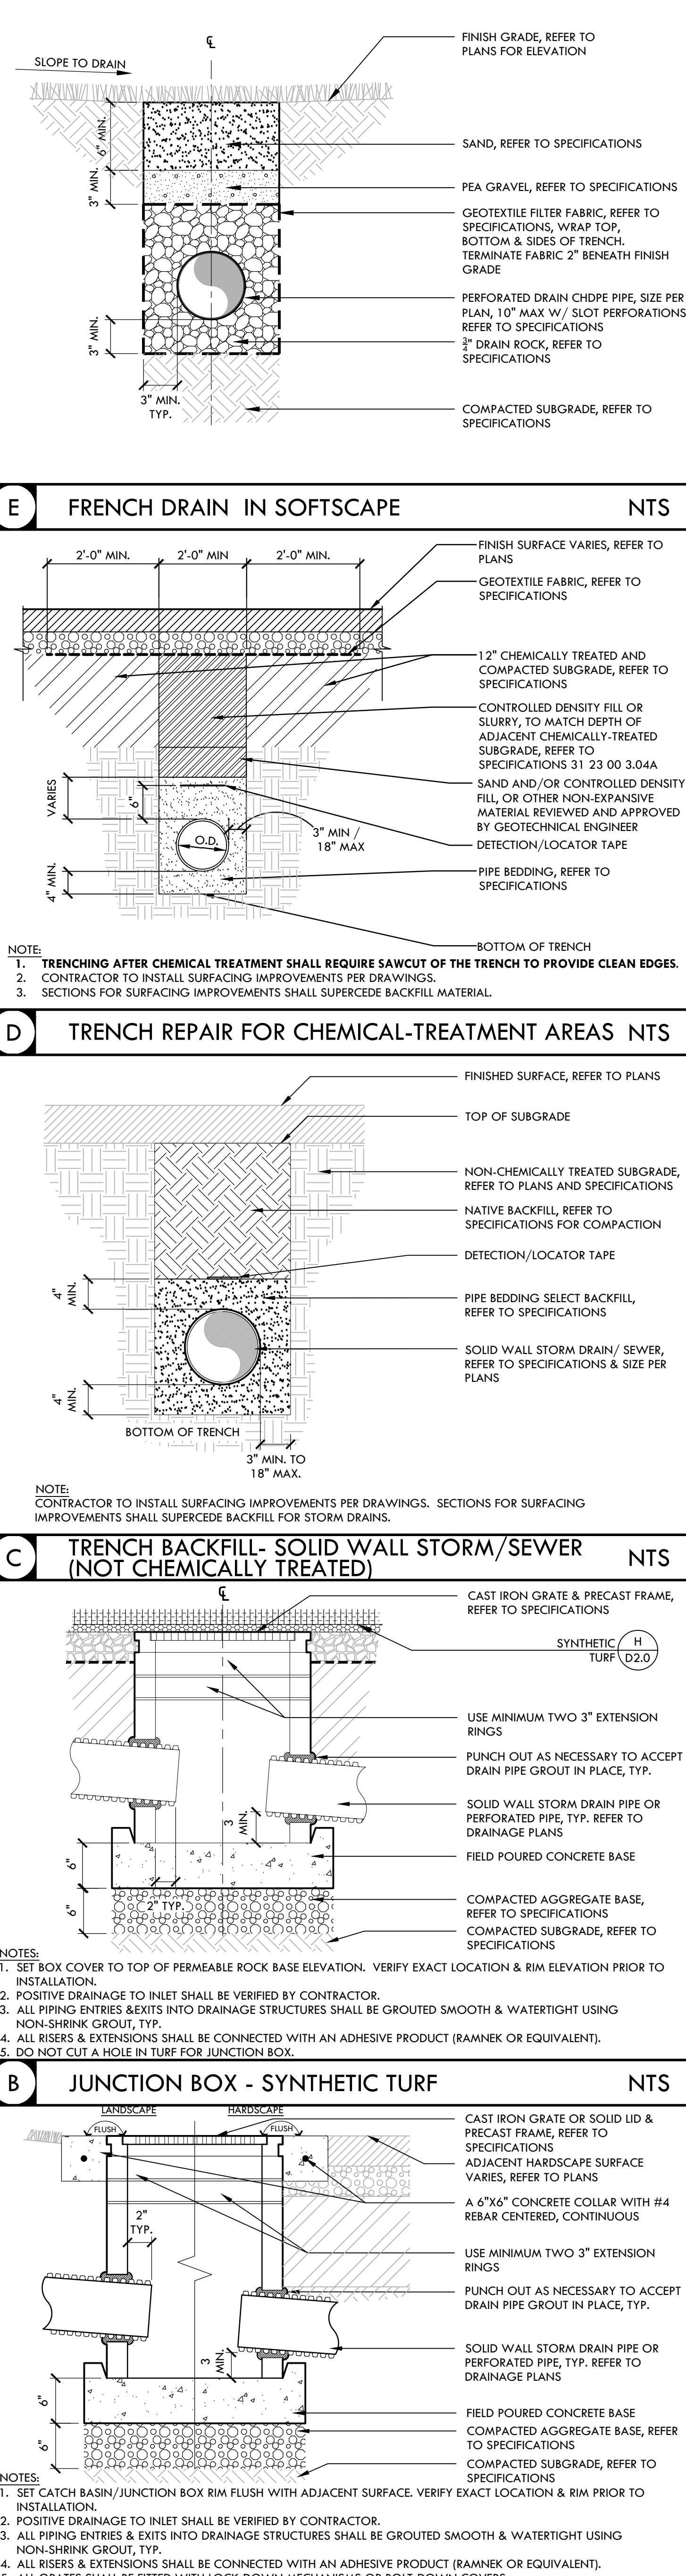

IDENTIFICATION STAMP  
DIV. OF THE STATE ARCHITECT  
APP. 02-118017 INC.  
REVIEWED FOR  
SS ☒ FLS ☒ ACS ☒  
DATE: 04/10/2020

**VERDE DESIGN**  
LANDSCAPE ARCHITECTURE  
CIVIL ENGINEERING  
SPORT PLANNING & DESIGN  
1843 Iron Point Rd #140  
Folsom, CA 95630  
tel: 916.415.6554  
fax: 408.985.7260  
www.VerdeDesignInc.com

STAMP

CONSULTANT

KEYMAP

SHEET TITLE  
**DRAINAGE AND UTILITY DETAILS**

PROJECT NAME  
**CHAVEZ HIGH SCHOOL STOCKTON USD ATHLETIC FACILITY IMPROVEMENTS**

PROJECT ADDRESS  
**2929 WINDFLOWER LN STOCKTON, CA 95212**

| SUBMITTAL               | DATE     |
|-------------------------|----------|
| DD/50% SUBMITTAL        | 10/25/19 |
| DSA SUBMITTAL           | 12/20/19 |
| DSA BACKCHECK SUBMITTAL | 03/27/20 |

| NO. | REVISIONS | DATE |
|-----|-----------|------|
| 1   |           |      |
| 2   |           |      |
| 3   |           |      |
| 4   |           |      |
| 5   |           |      |

DRAWN BY: VDI CHECKED BY: CS  
DATE ISSUED: 03/27/20 SCALE: AS NOTED  
PROJ. NO.: 1910900-1211  
SHEET NO.: **D1.0**



ALL DESIGN, CONSTRUCTION, AND/OR INSTALLATION OF ANY PARTS OR PORTIONS OF THIS DRAWING ARE OWNED BY AND THE PROPERTY OF VERDE DESIGN, INC. AND WERE CREATED, DEVELOPED, AND DISCLOSED FOR USE ON AND IN CONNECTION WITH THE SPECIFIED PROJECT. NONE OF SUCH IDEAS, DESIGNS, ARRANGEMENTS OR PLANS SHALL BE USED, REPRODUCED, OR PUBLISHED BY ANY METHOD, IN WHOLE OR IN PART, OR DISCLOSED TO ANY PERSON, FIRM, OR CORPORATION FOR ANY PURPOSES AND WITHOUT WRITTEN PERMISSION OF VERDE DESIGN, INC.

IDENTIFICATION STAMP  
DIV. OF THE STATE ARCHITECT  
APP. 02-118017 INC.  
REVIEWED FOR  
SS ☐ FLS ☐ ACS ☐  
DATE: 04/10/2020

**VERDE DESIGN**  
LANDSCAPE ARCHITECTURE  
CIVIL ENGINEERING  
SPORT PLANNING & DESIGN  
1843 Iron Point Rd #140  
Folsom, CA 95630  
tel: 916.415.6554  
fax: 408.985.7260  
www.VerdeDesigninc.com



STAMP

CONSULTANT

KEYMAP

SHEET TITLE

## DRAINAGE AND UTILITY DETAILS

PROJECT NAME

CHAVEZ HIGH SCHOOL  
STOCKTON USD  
ATHLETIC FACILITY  
IMPROVEMENTS

PROJECT ADDRESS


2929 WINDFLOWER LN  
STOCKTON, CA 95212

| SUBMITTAL               | DATE     |
|-------------------------|----------|
| DD/50% SUBMITTAL        | 10/25/19 |
| DSA SUBMITTAL           | 12/20/19 |
| DSA BACKCHECK SUBMITTAL | 03/27/20 |

| NO. | REVISIONS | DATE |
|-----|-----------|------|
| 1   |           |      |
| 2   |           |      |
| 3   |           |      |
| 4   |           |      |
| 5   |           |      |


SHEET NO. **D1.1** OF 122

DRAINAGE AND UTILITY DETAILS

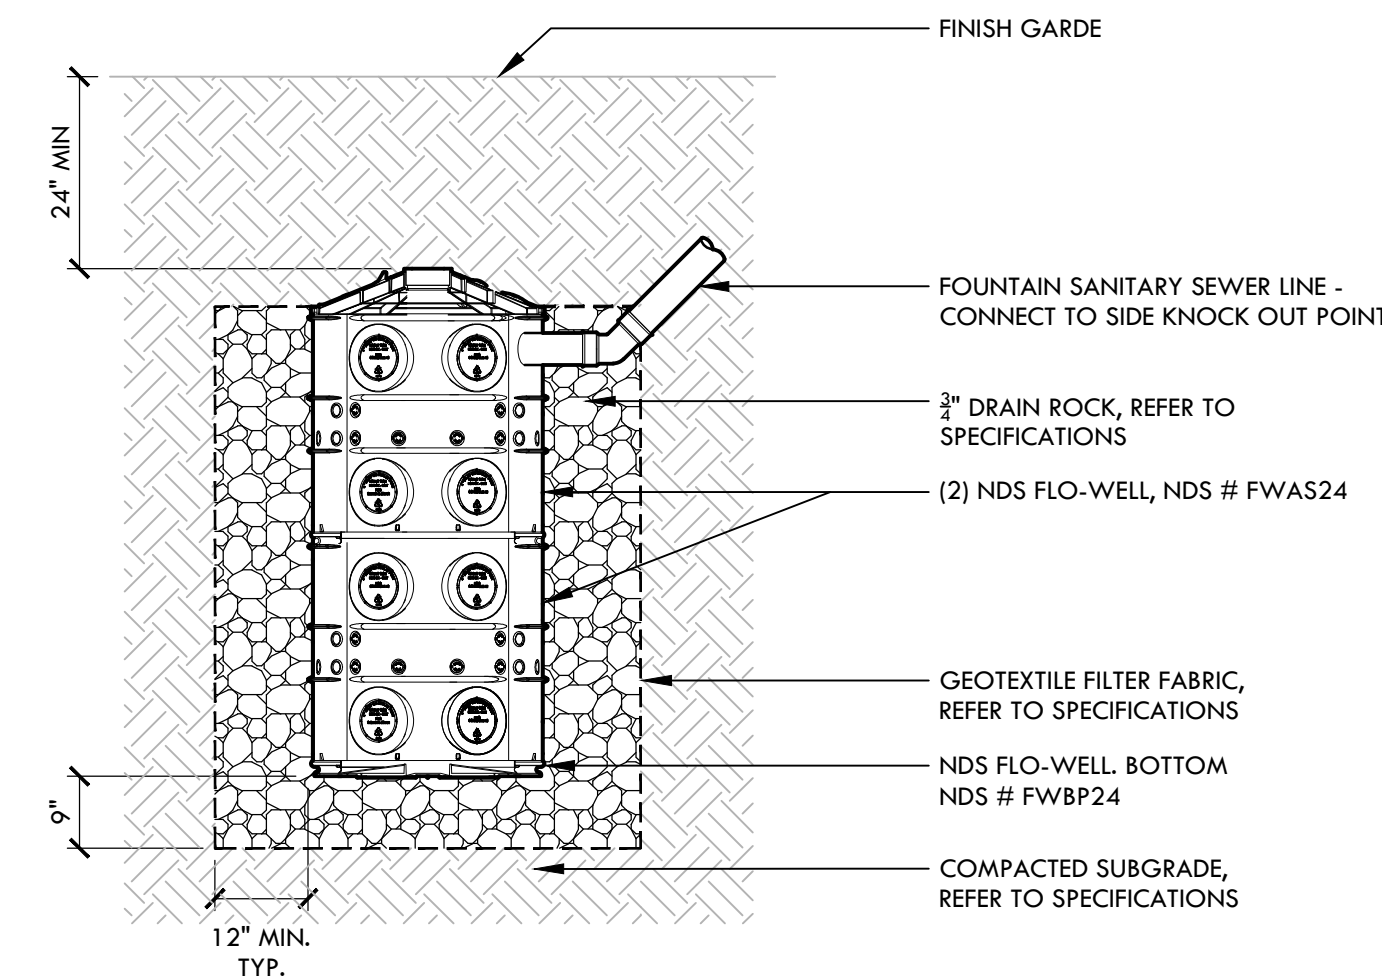


**DRYWELL - DRINKING FOUNTAIN**

NTS

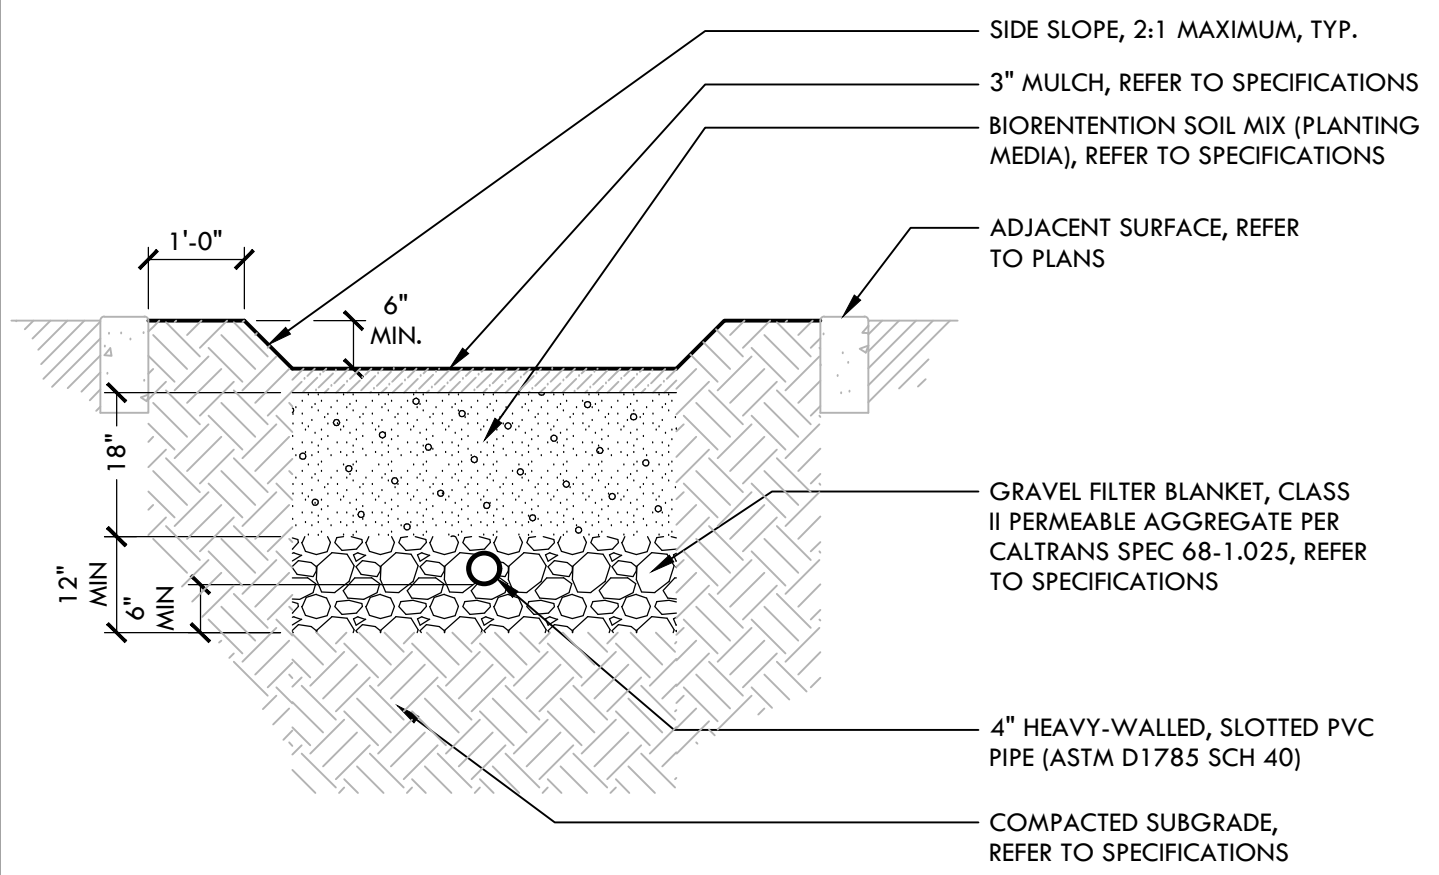


**BIORETENTION AREA**

NTS

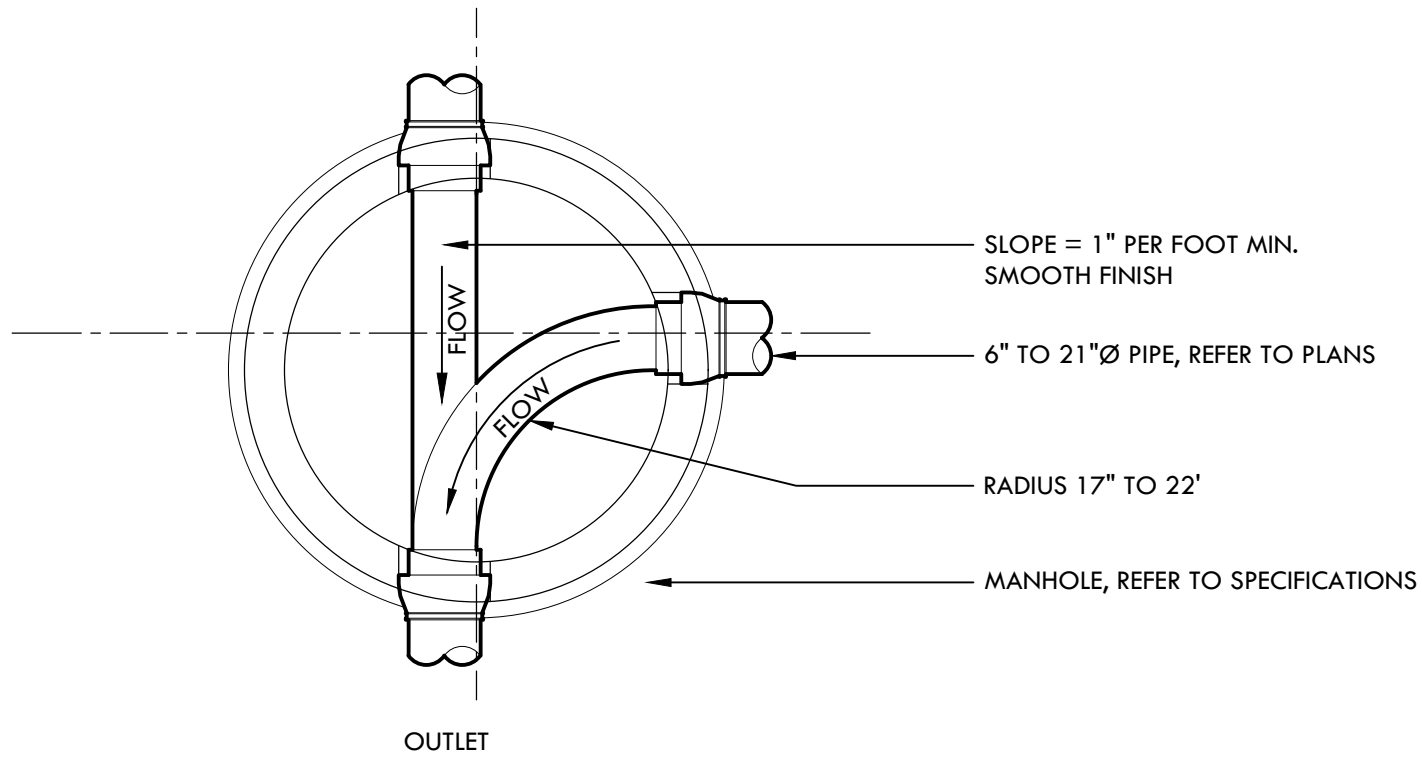


**PLAN VIEW**

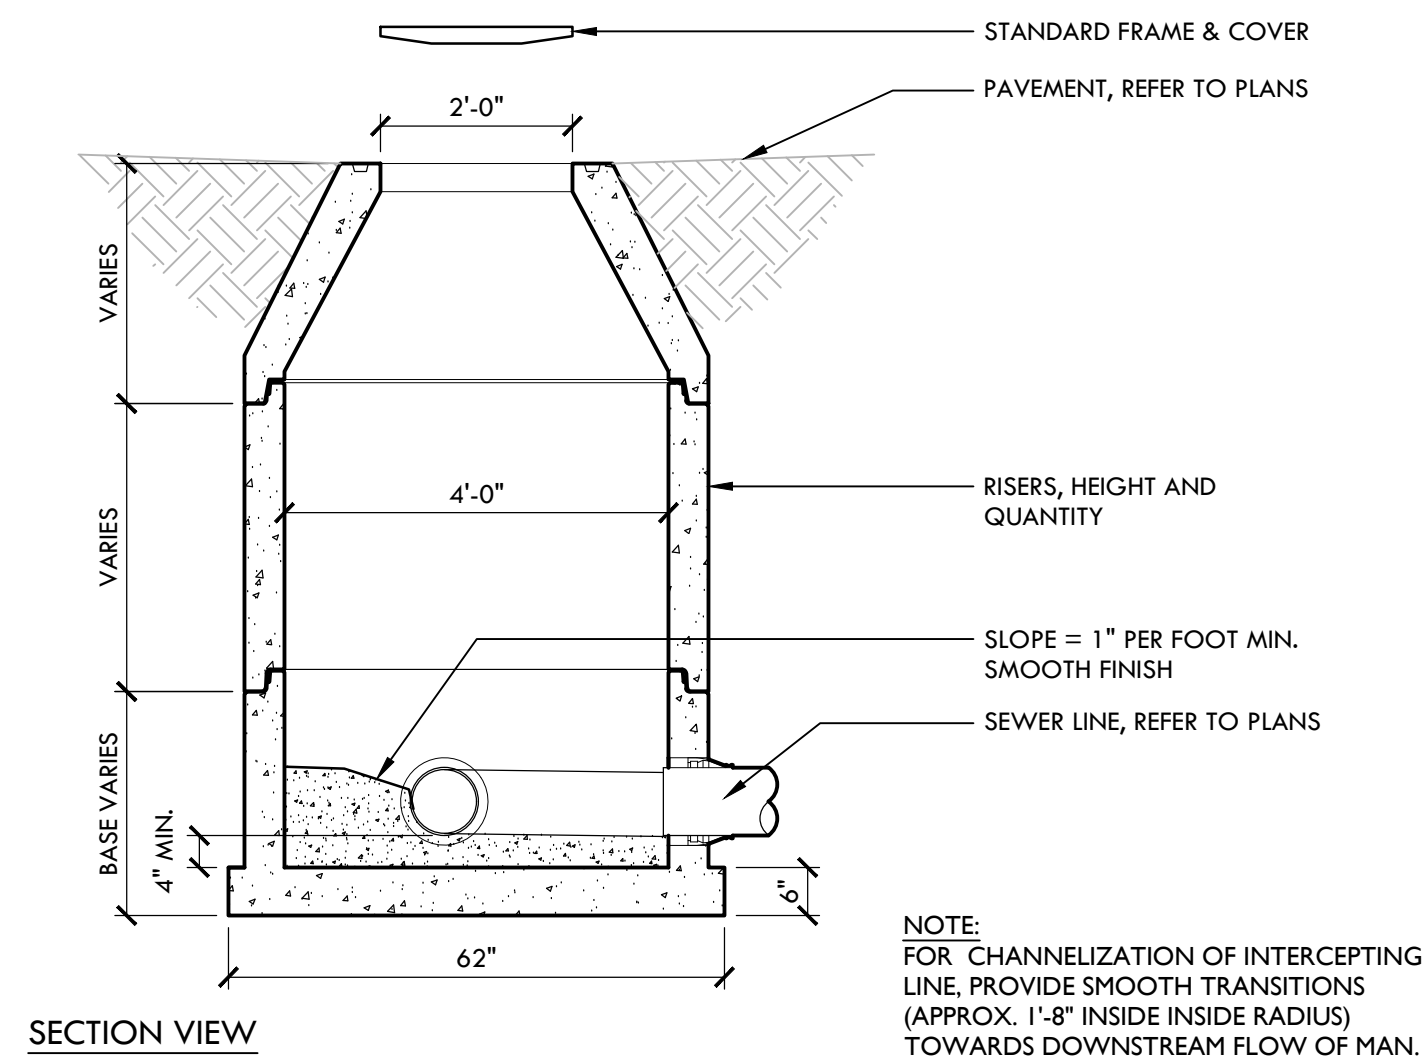

**SECTION VIEW**


**SANITARY SEWER MANHOLE**

NTS

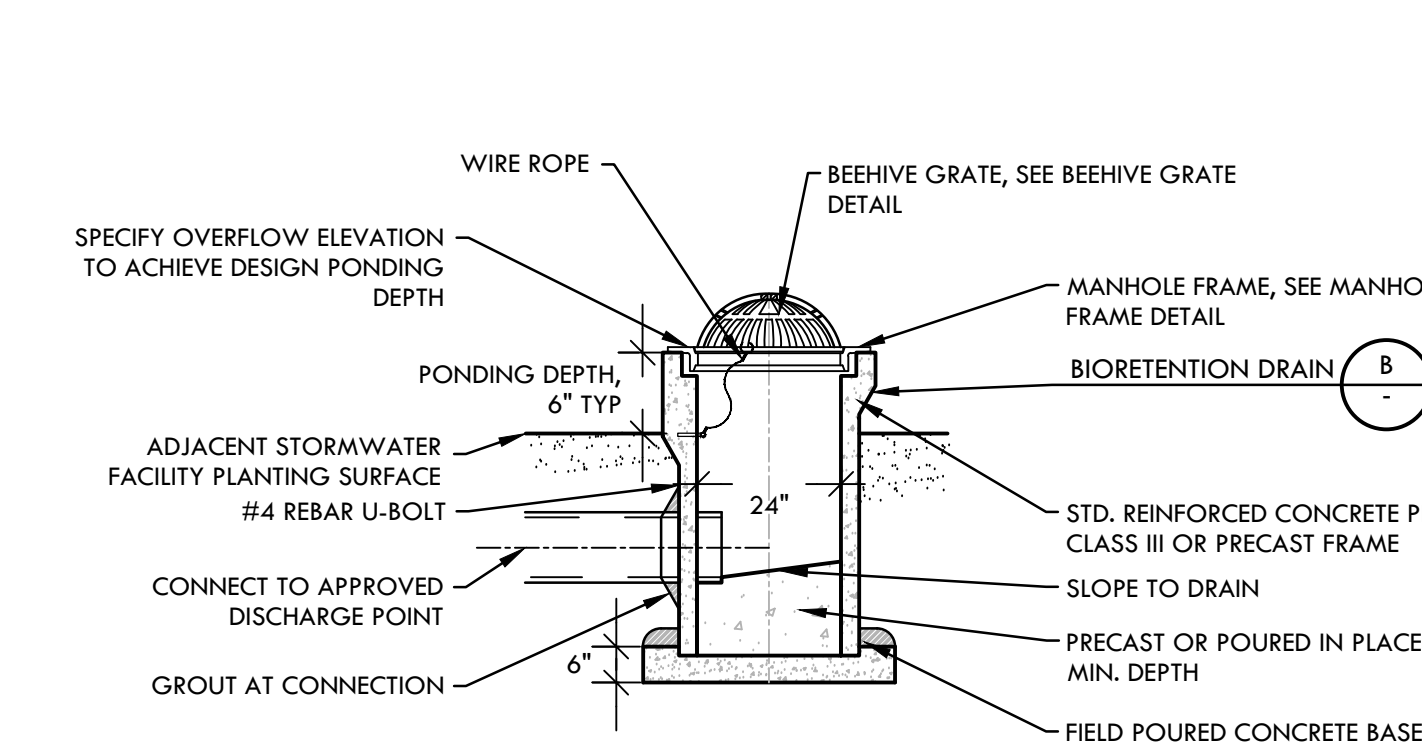


**OVERFLOW RISER WITH GRATE/ STANDPIPE**

NTS

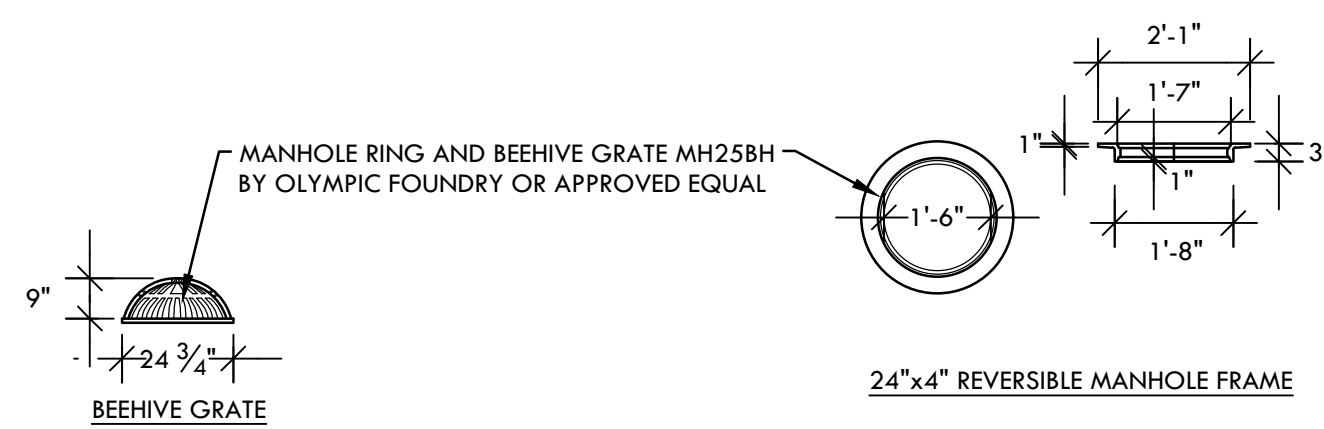

### NOTES


- ALL PIPING ENTRIES AND EXITS INTO DRAINAGE STRUCTURES SHALL BE GROUTED SMOOTH AND WATERTIGHT USING NON-SHRINK GROUT, TYP.
- ALL RISERS AND EXTENSIONS SHALL BE CONNECTED WITH AN ADHESIVE PRODUCT (RAMNEK OR EQUIVALENT)
- ALL GRATES SHALL BE FITTED WITH LOCK-DOWN MECHANISMS OR BOLT-DOWN COVERS.

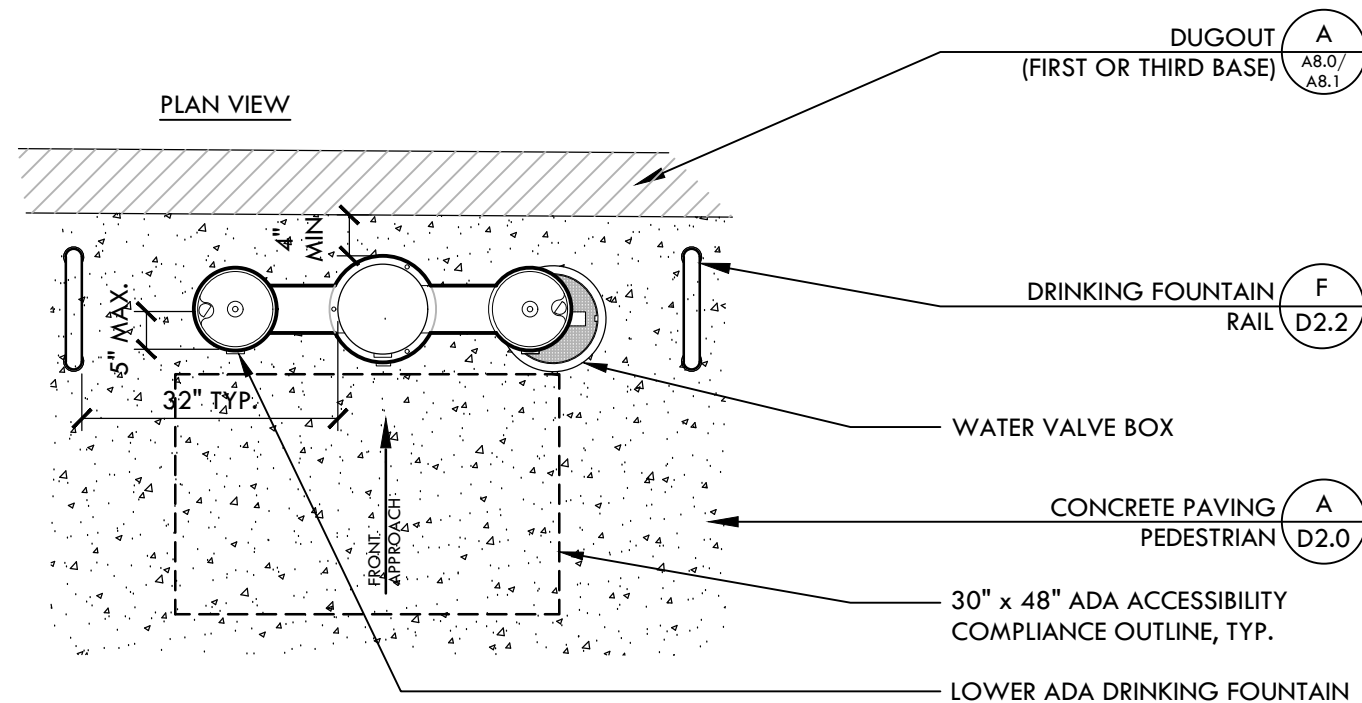

- NOTES:
- MEETS ADA REGULATIONS. ALL DRINKING FOUNTAINS TO BE INSTALLED CLEAR OF ACCESSIBLE PATH OF TRAVEL.
  - REFER TO SPECIFICATIONS.
  - FOUNTAIN SHALL HAVE SAME DIRECTION OF APPROACH FOR BOTTLE FILLER, HI & LO USERS.
  - DRINKING FOUNTAIN BUTTONS TO FACE TOWARD APPROACH.
  - CONTRACTOR TO COORDINATE INSTALLATION OF FOOTINGS FOR DRINKING FOUNTAIN AND ASSOCIATIVE RAILINGS WITH DUGOUT FOUNDATION.

**DRINKING FOUNTAIN WITH BOTTLE FILLER**


NTS

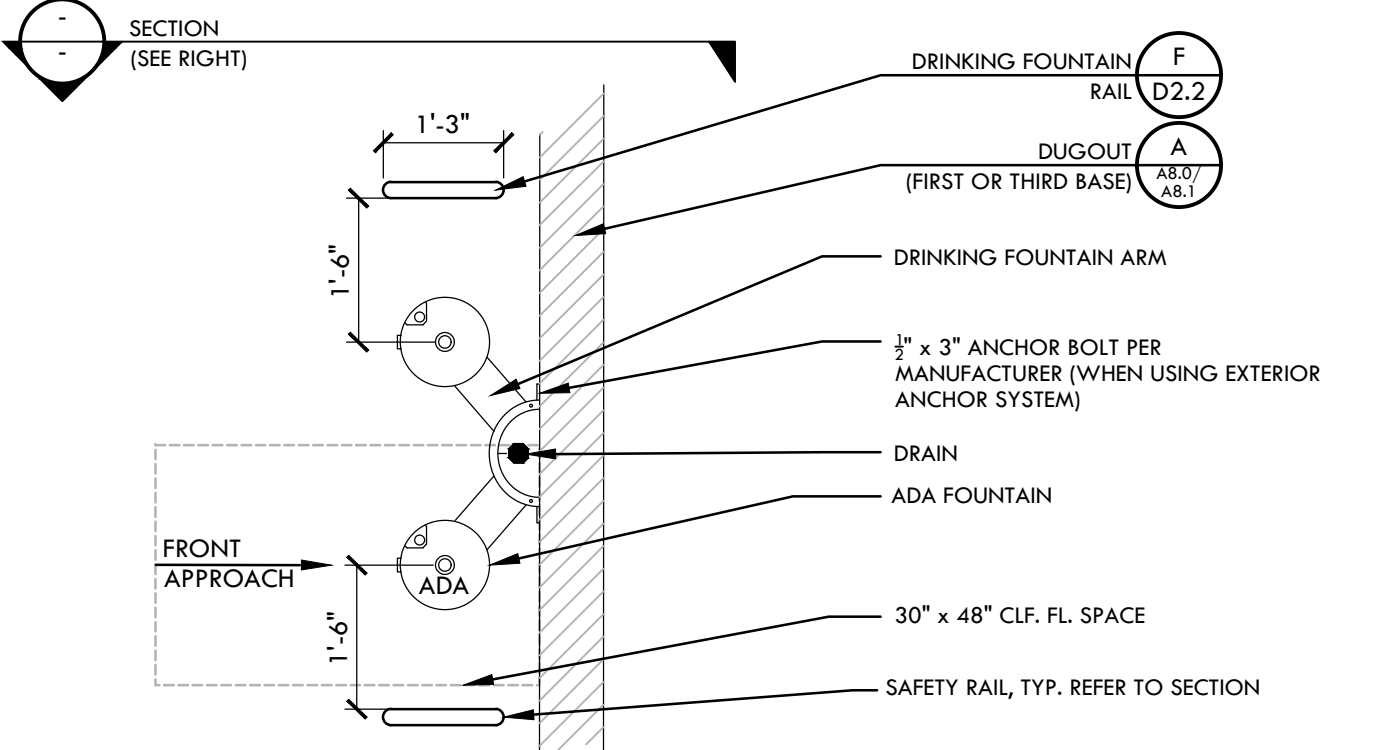

- NOTES:
- REFER TO SPECIFICATIONS.
  - FOUNTAIN SHALL HAVE SAME DIRECTION OF APPROACH FOR BOTH HI & LO USERS.
  - DRINKING FOUNTAIN BUTTONS TO FACE TOWARD APPROACH.
  - P-TRAP TO BE INSTALLED.
  - CONTRACTOR TO COORDINATE INSTALLATION OF FOOTINGS FOR DRINKING FOUNTAIN AND ASSOCIATIVE RAILINGS WITH DUGOUT FOUNDATION.


**DRINKING FOUNTAIN PLAN (IN DUGOUT)**

NTS

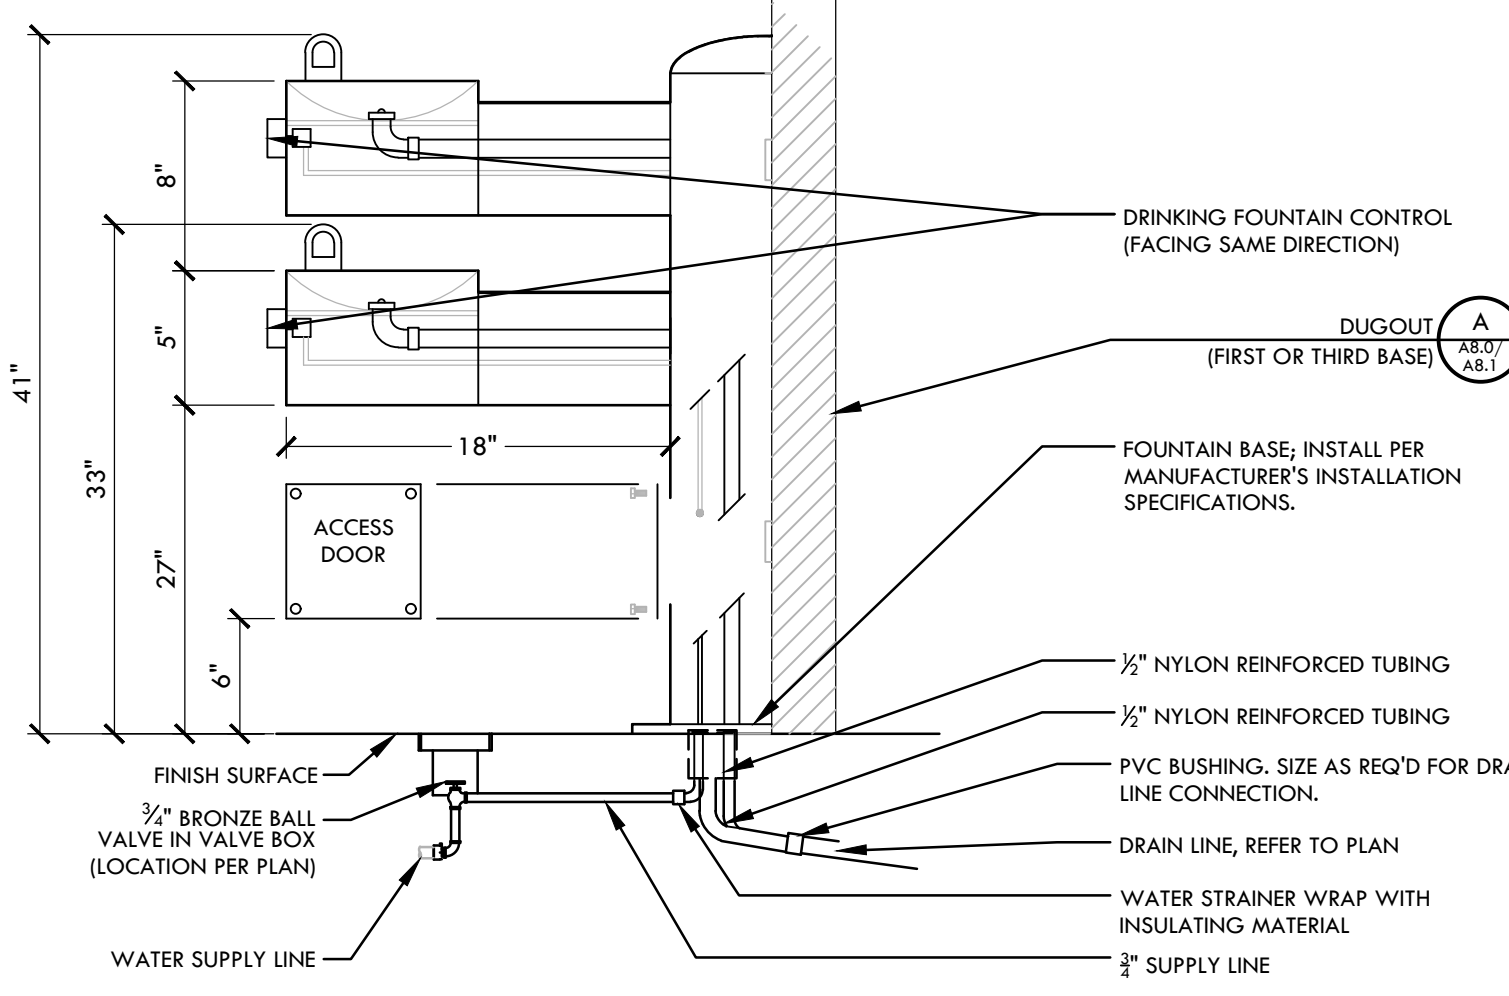

**BIORETENTION DRAIN**

NTS

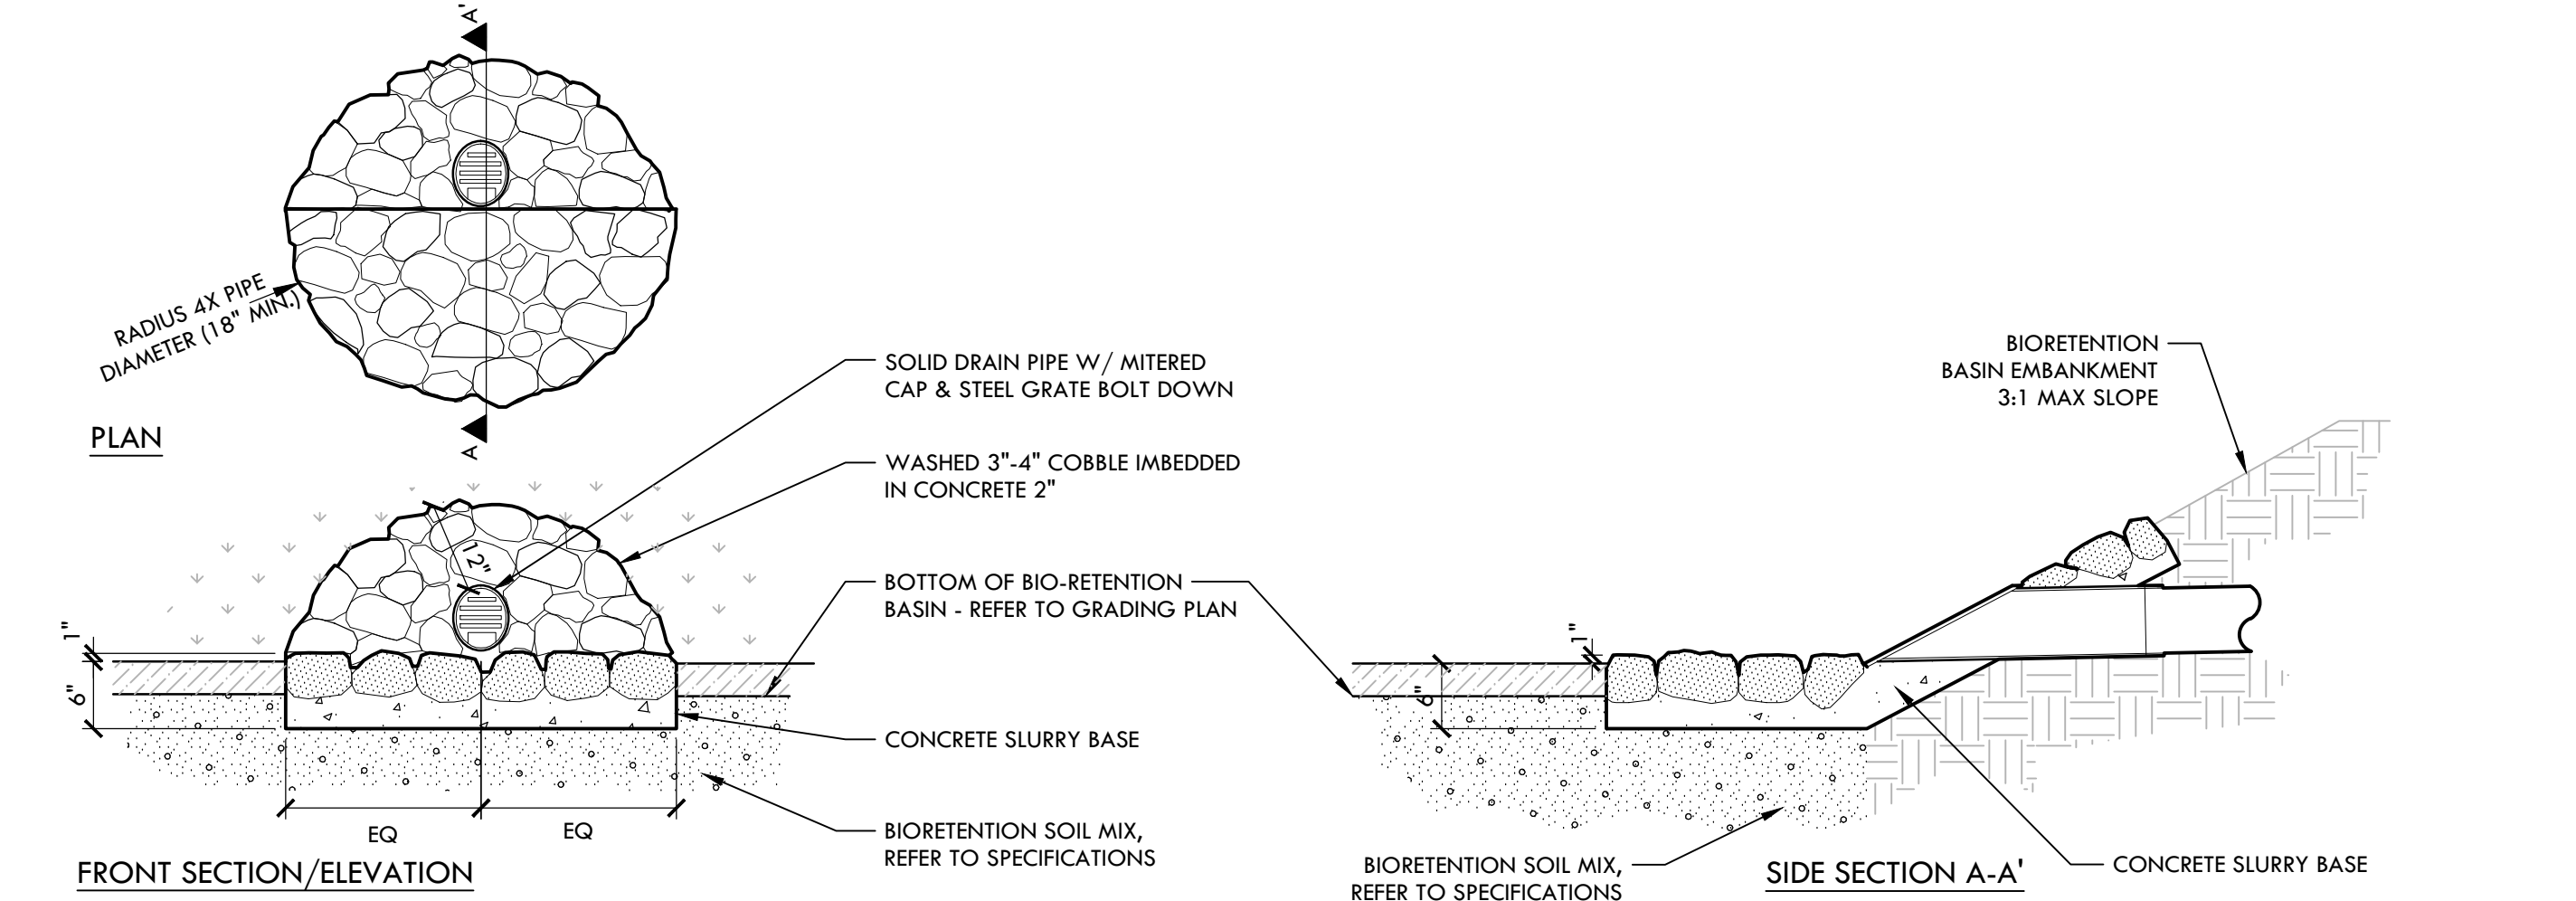


**COBBLE ENERGY DISSIPATOR**


NTS




ALL DESIGN, DRAWING, AND CONSTRUCTION INFORMATION IS THE PROPERTY OF VERDE DESIGN, INC. AND IS NOT TO BE REPRODUCED, COPIED, OR TRANSMITTED IN ANY FORM OR BY ANY MEANS, ELECTRONIC OR MECHANICAL, WITHOUT THE WRITTEN PERMISSION OF VERDE DESIGN, INC. ANY REUSE OF THIS INFORMATION WITHOUT THE WRITTEN PERMISSION OF VERDE DESIGN, INC. IS PROHIBITED. VERDE DESIGN, INC. IS NOT RESPONSIBLE FOR ANY DAMAGE TO ANY PERSON, PROPERTY, OR ENVIRONMENT CAUSED BY THE USE OF THIS INFORMATION. VERDE DESIGN, INC. IS NOT RESPONSIBLE FOR ANY DAMAGE TO ANY PERSON, PROPERTY, OR ENVIRONMENT CAUSED BY THE USE OF THIS INFORMATION. VERDE DESIGN, INC. IS NOT RESPONSIBLE FOR ANY DAMAGE TO ANY PERSON, PROPERTY, OR ENVIRONMENT CAUSED BY THE USE OF THIS INFORMATION.

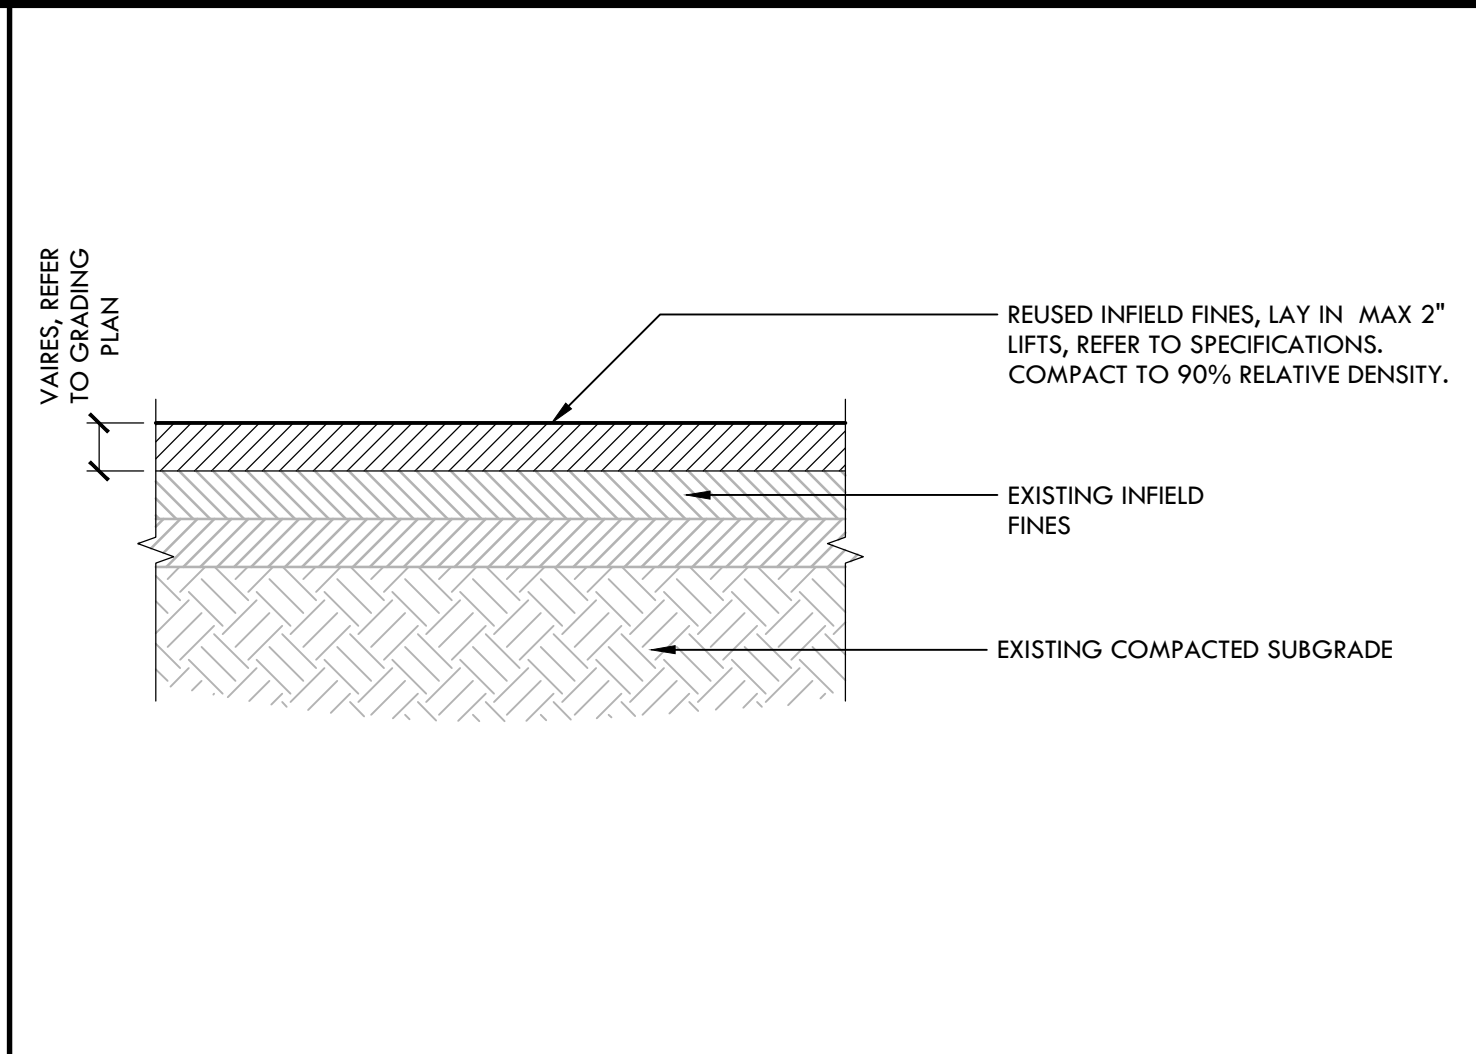


**O REUSED INFELD FINES** NTS

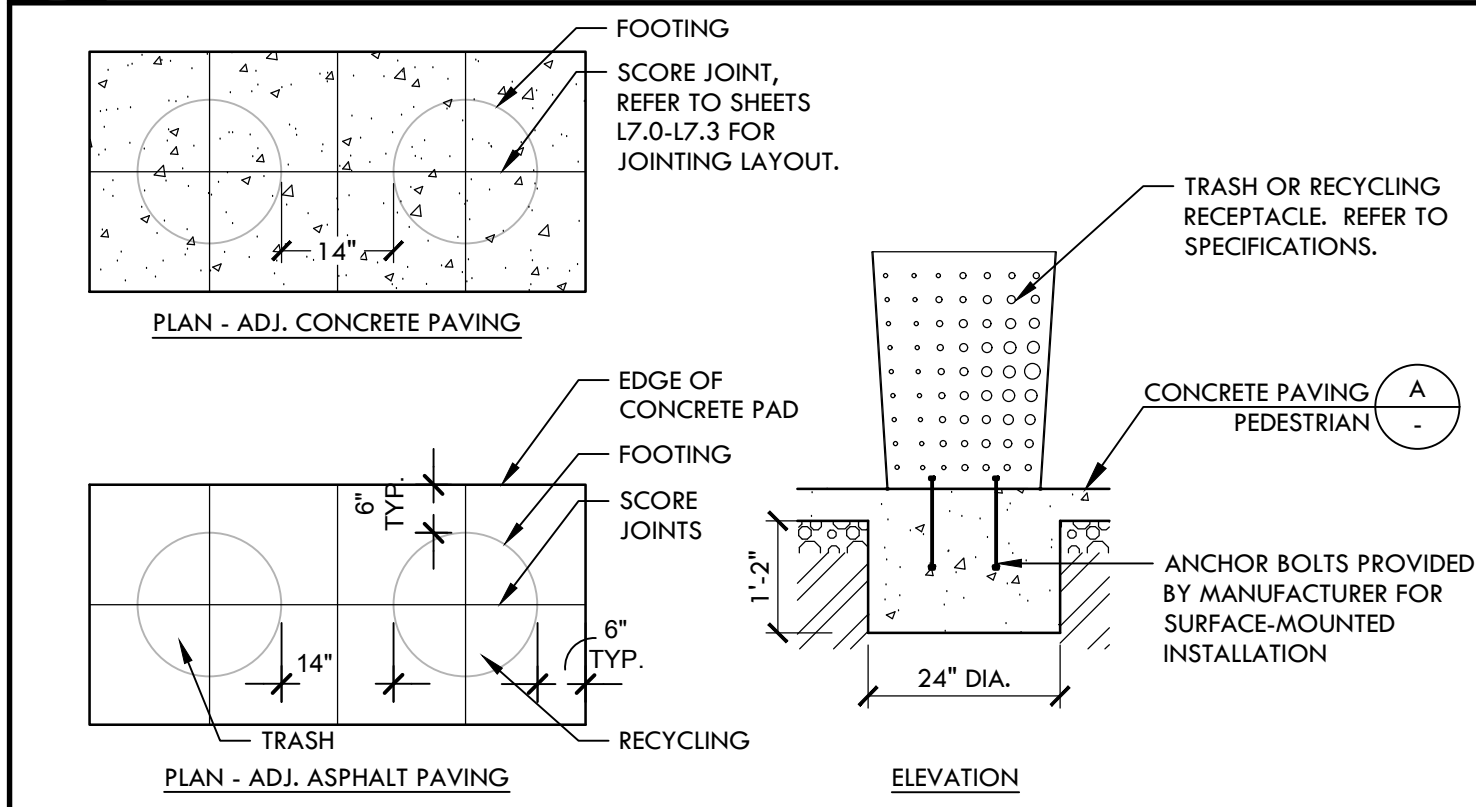


**N TRASH AND RECYCLING RECEPTACLE PAD** NTS

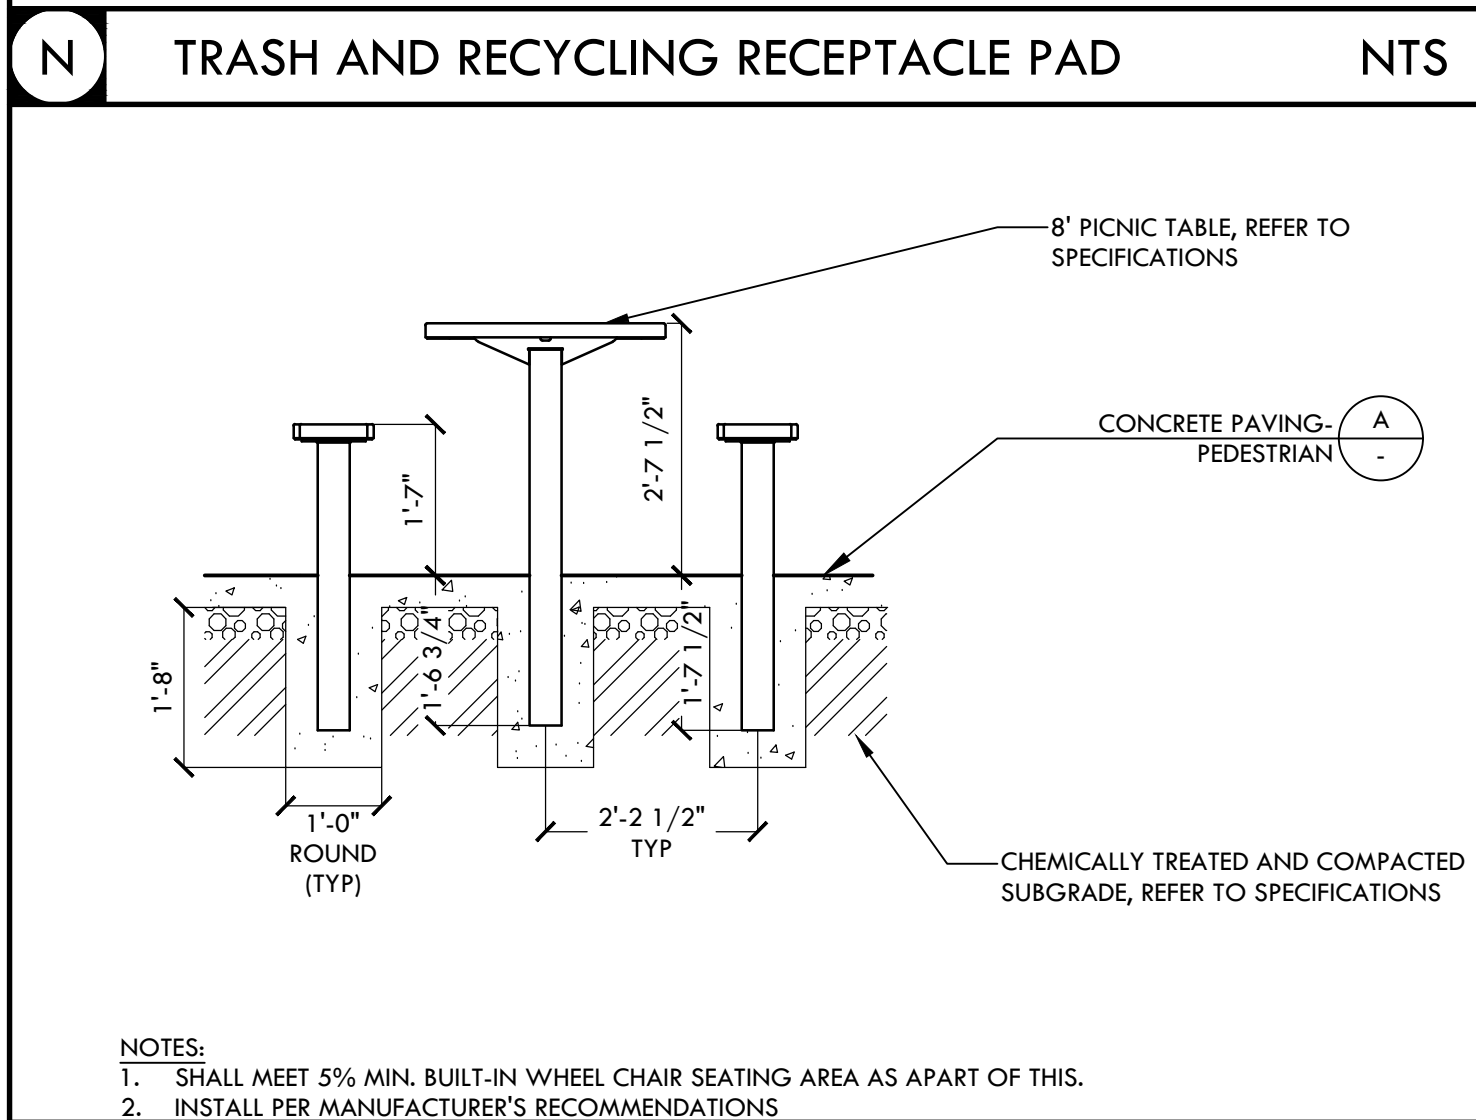


**M PICNIC TABLE** NTS

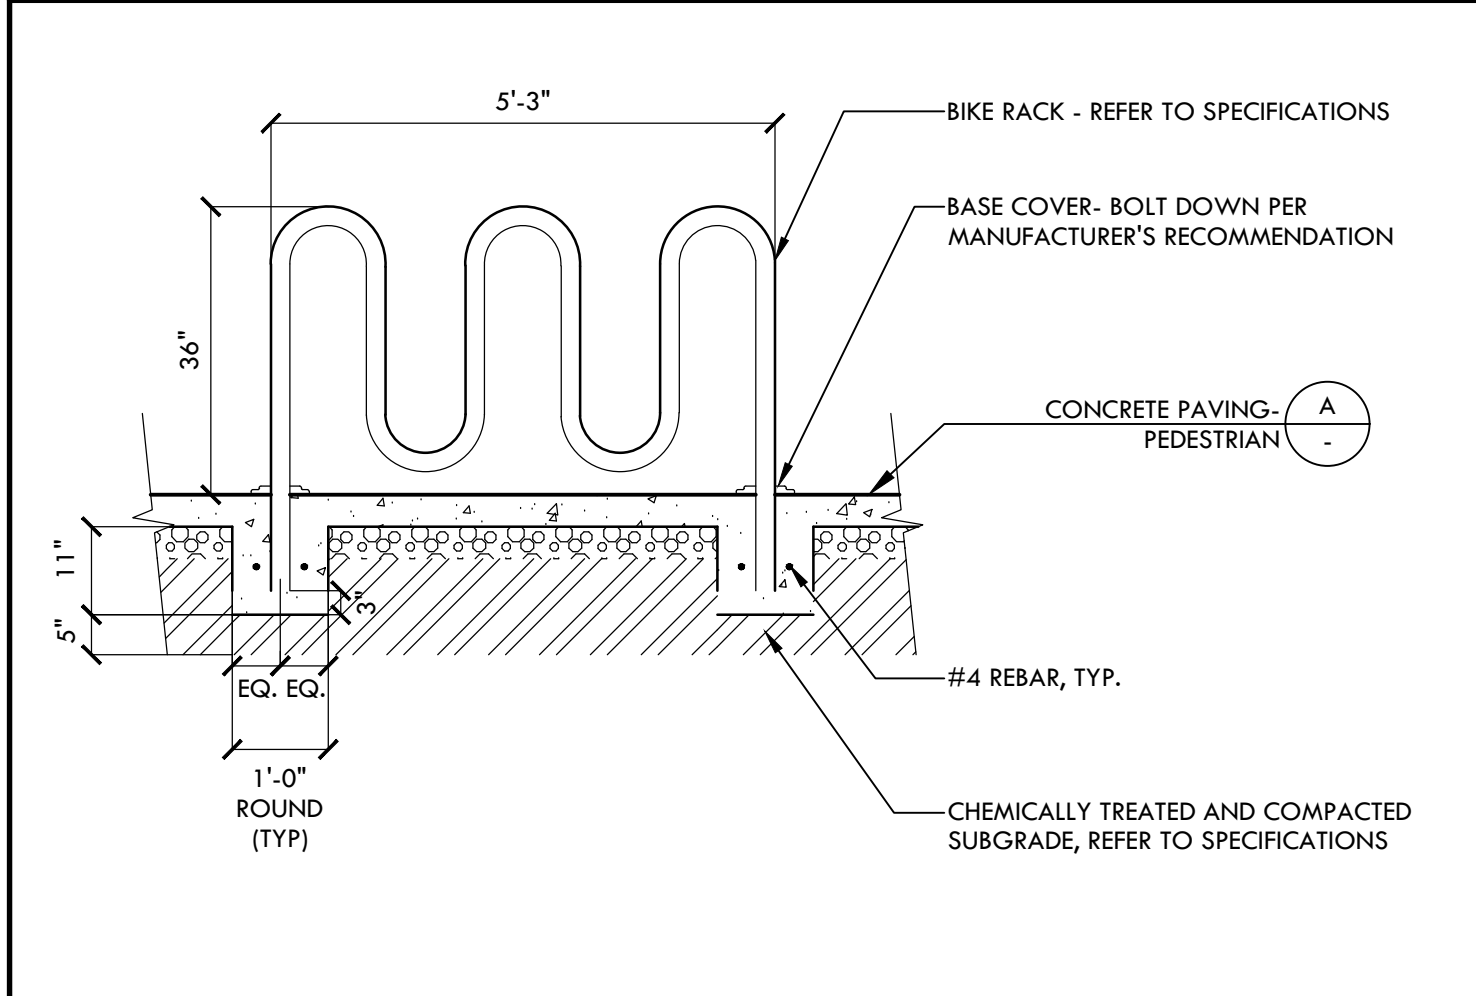


**L BIKE RACK** NTS

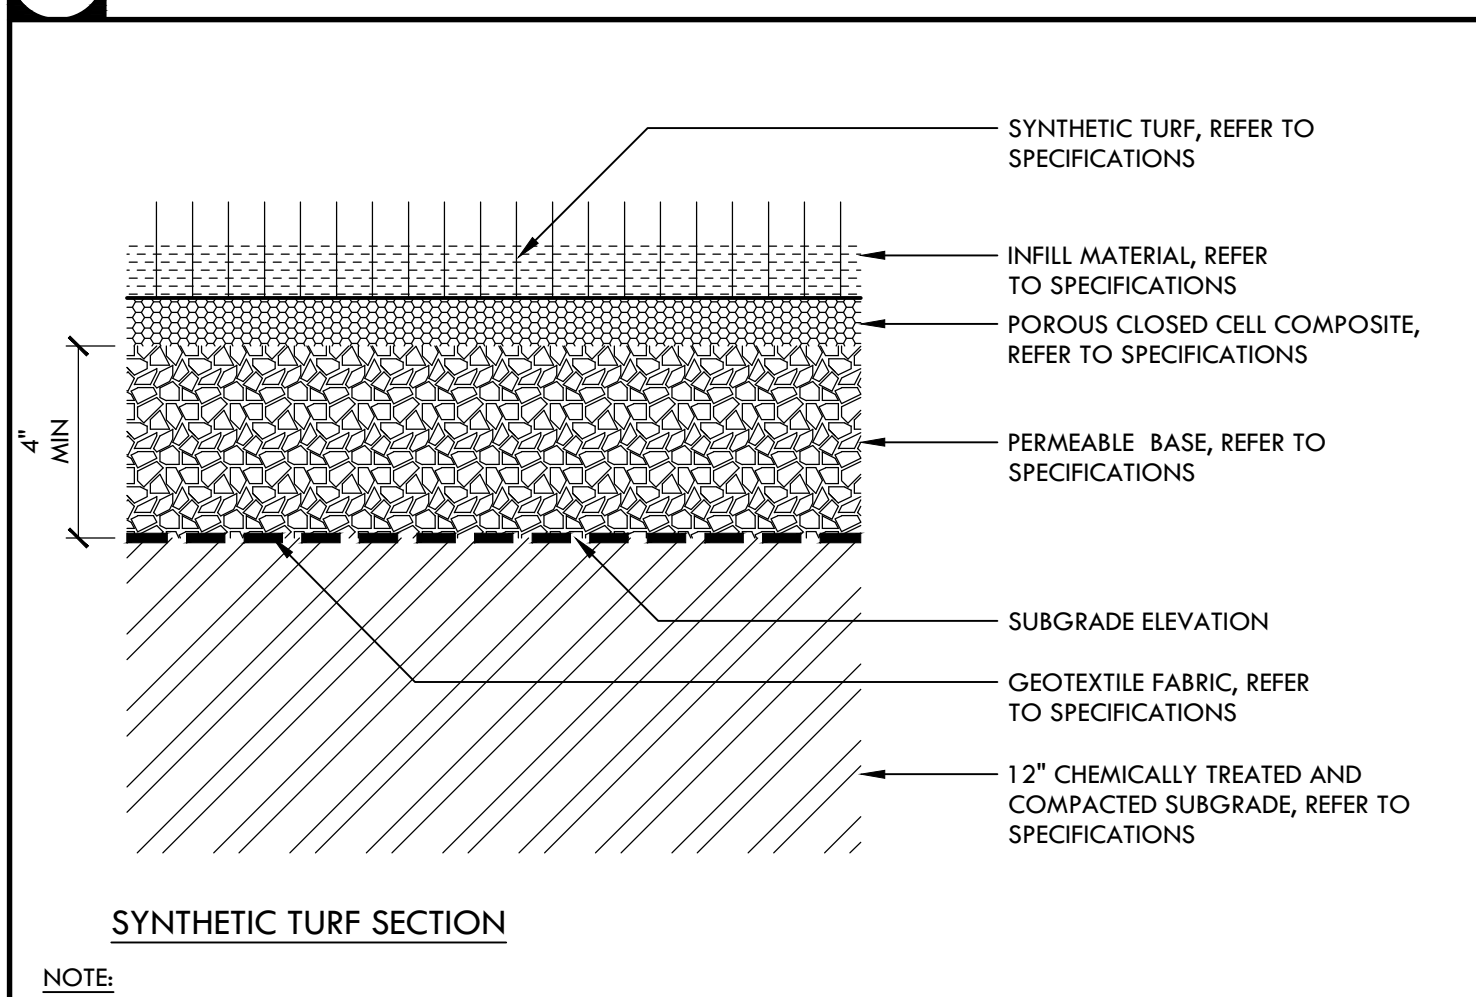


**H SYNTHETIC TURF WITH BROCK PAD** NTS

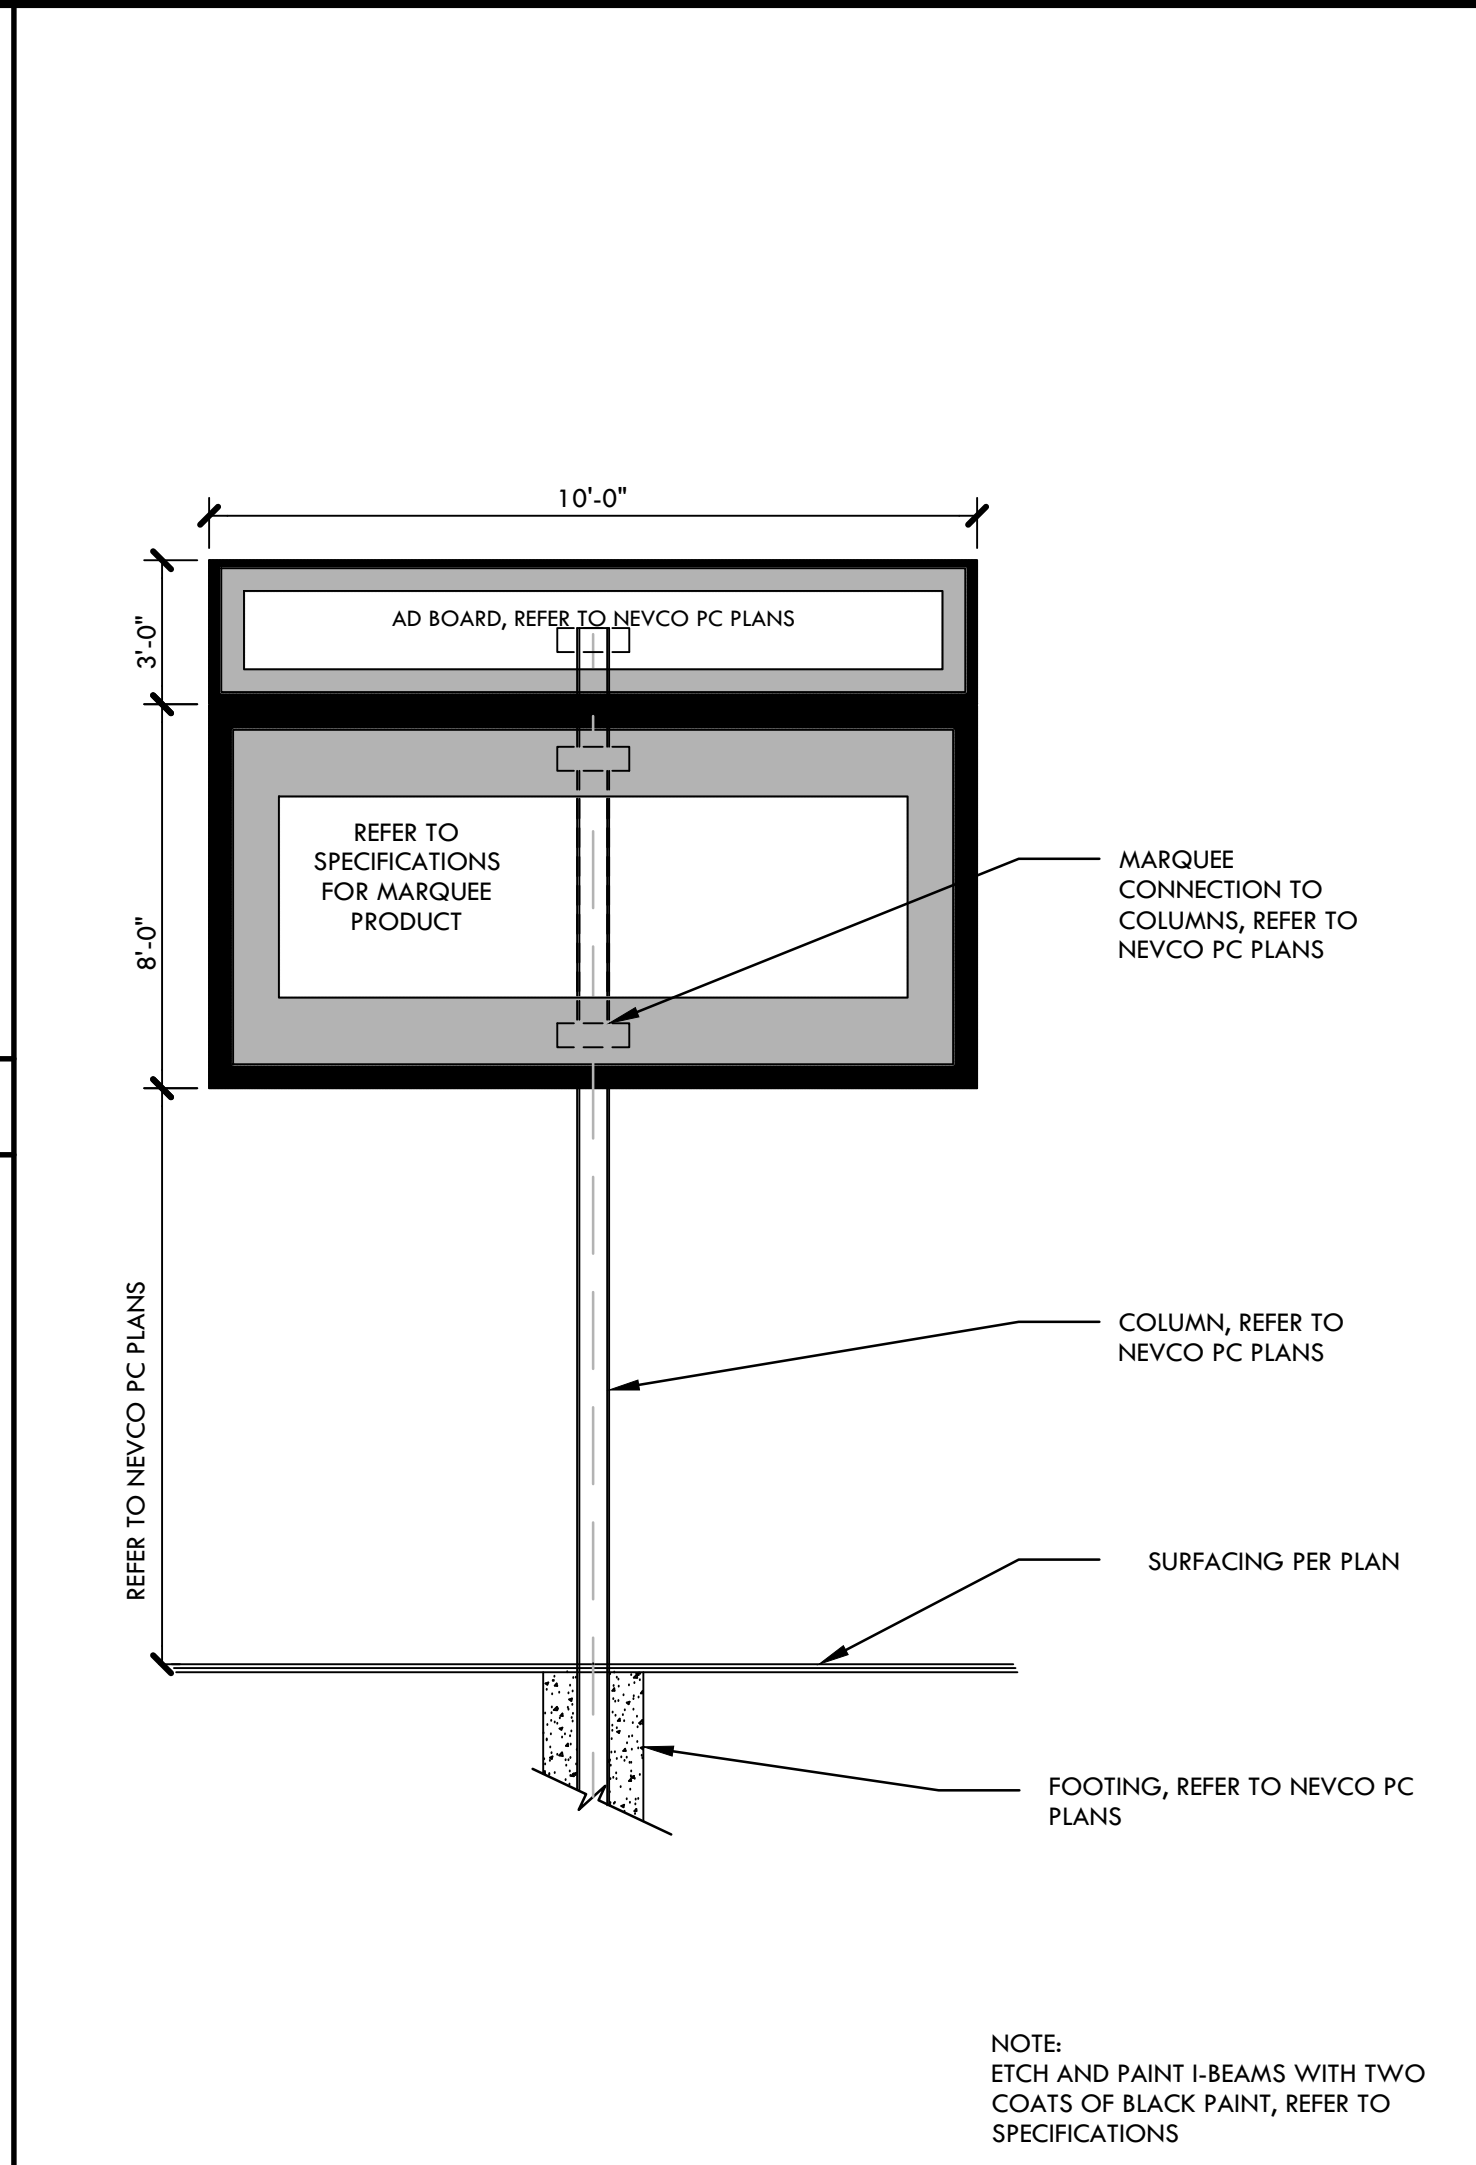


**K MARQUEE** NTS

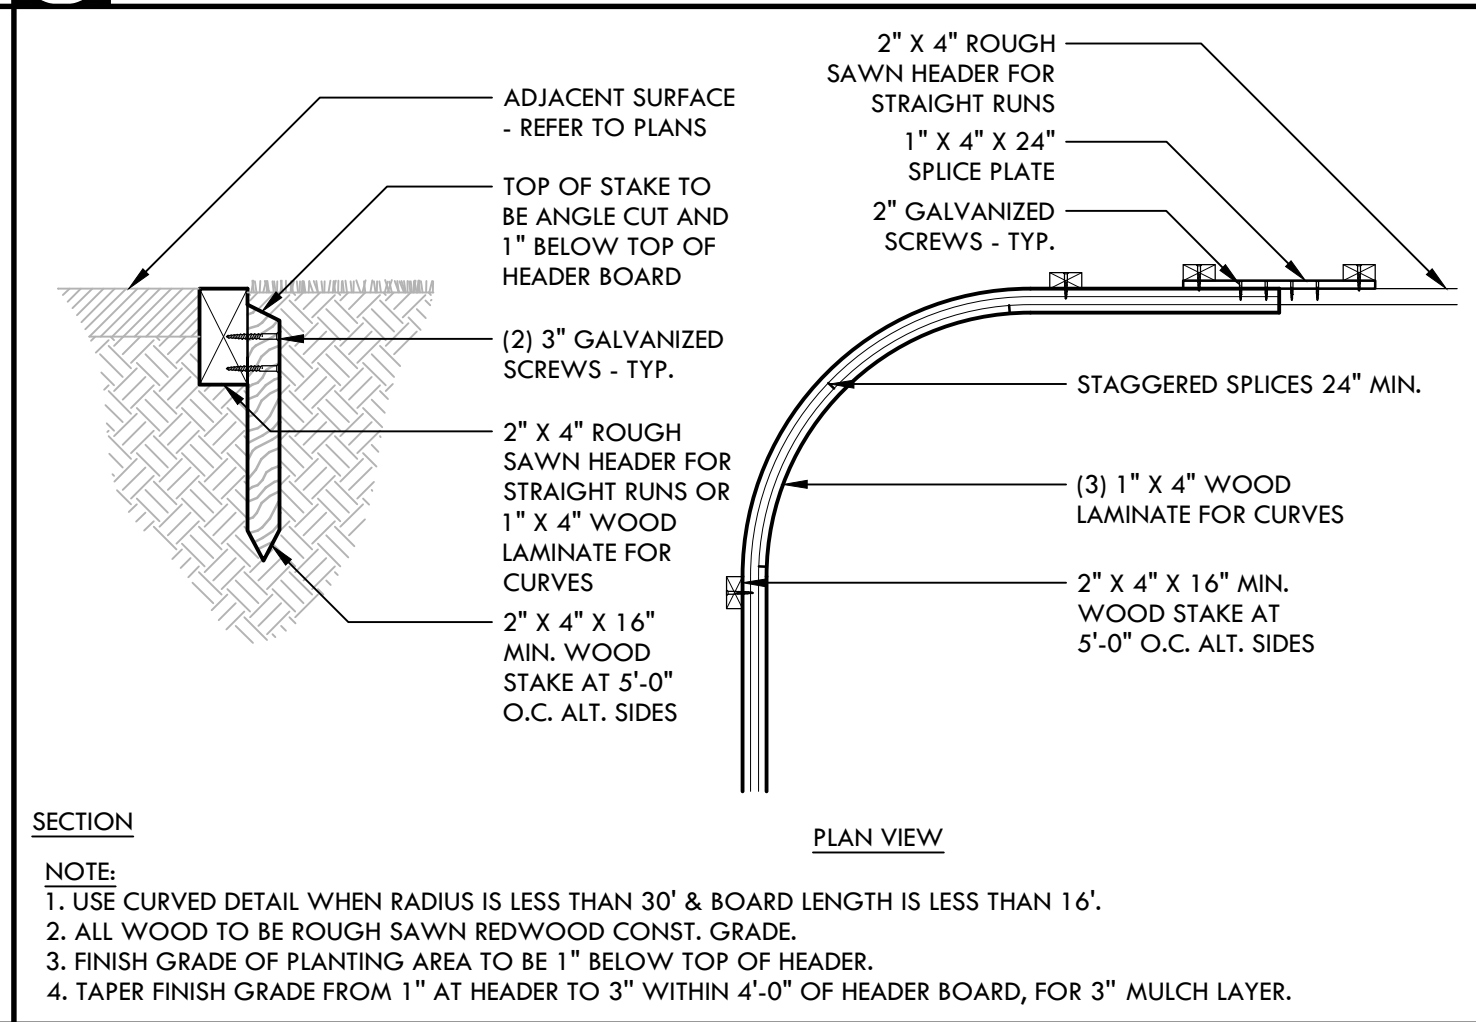


**J REDWOOD HEADER BOARD** NTS

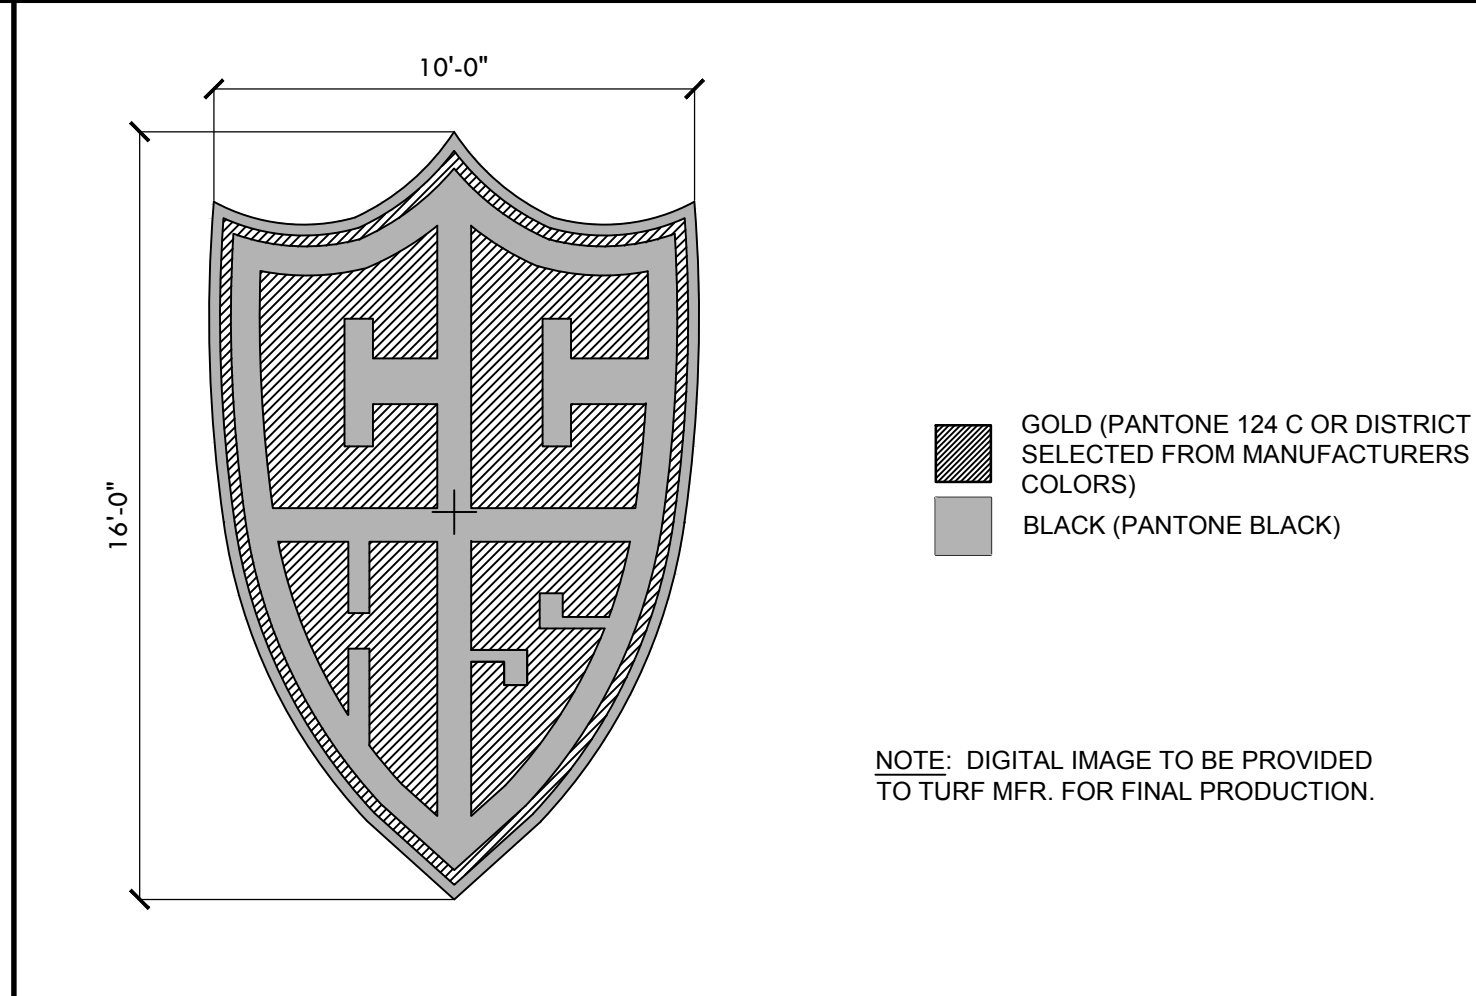


**I BASEBALL FIELD LOGO (SYNTHETIC TURF)** NTS

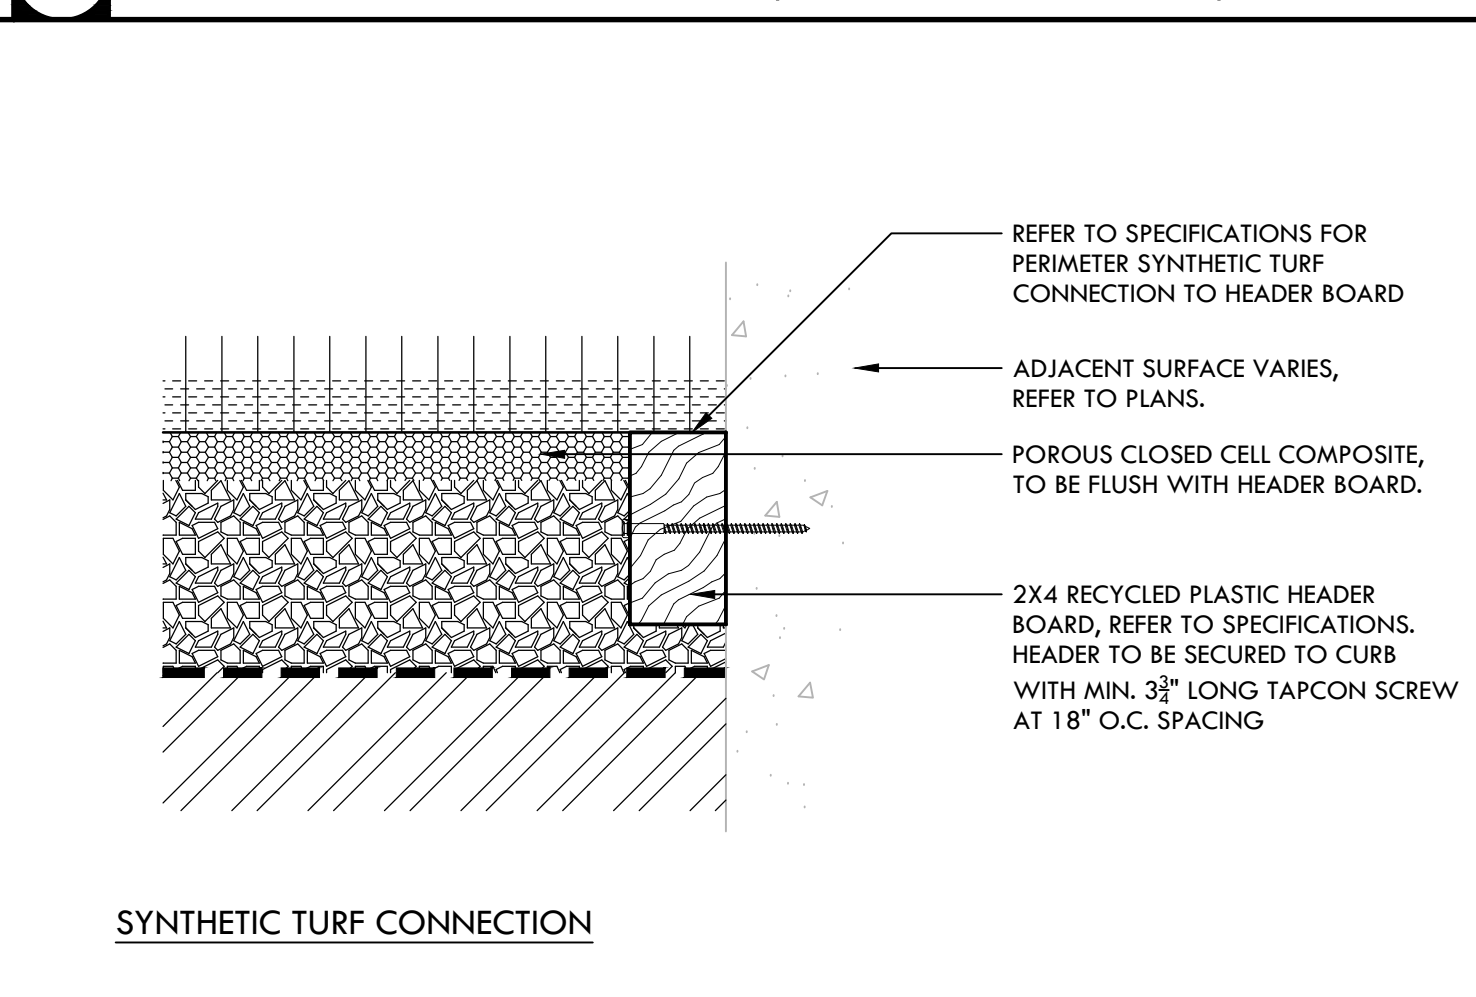


**SYNTHETIC TURF SECTION**

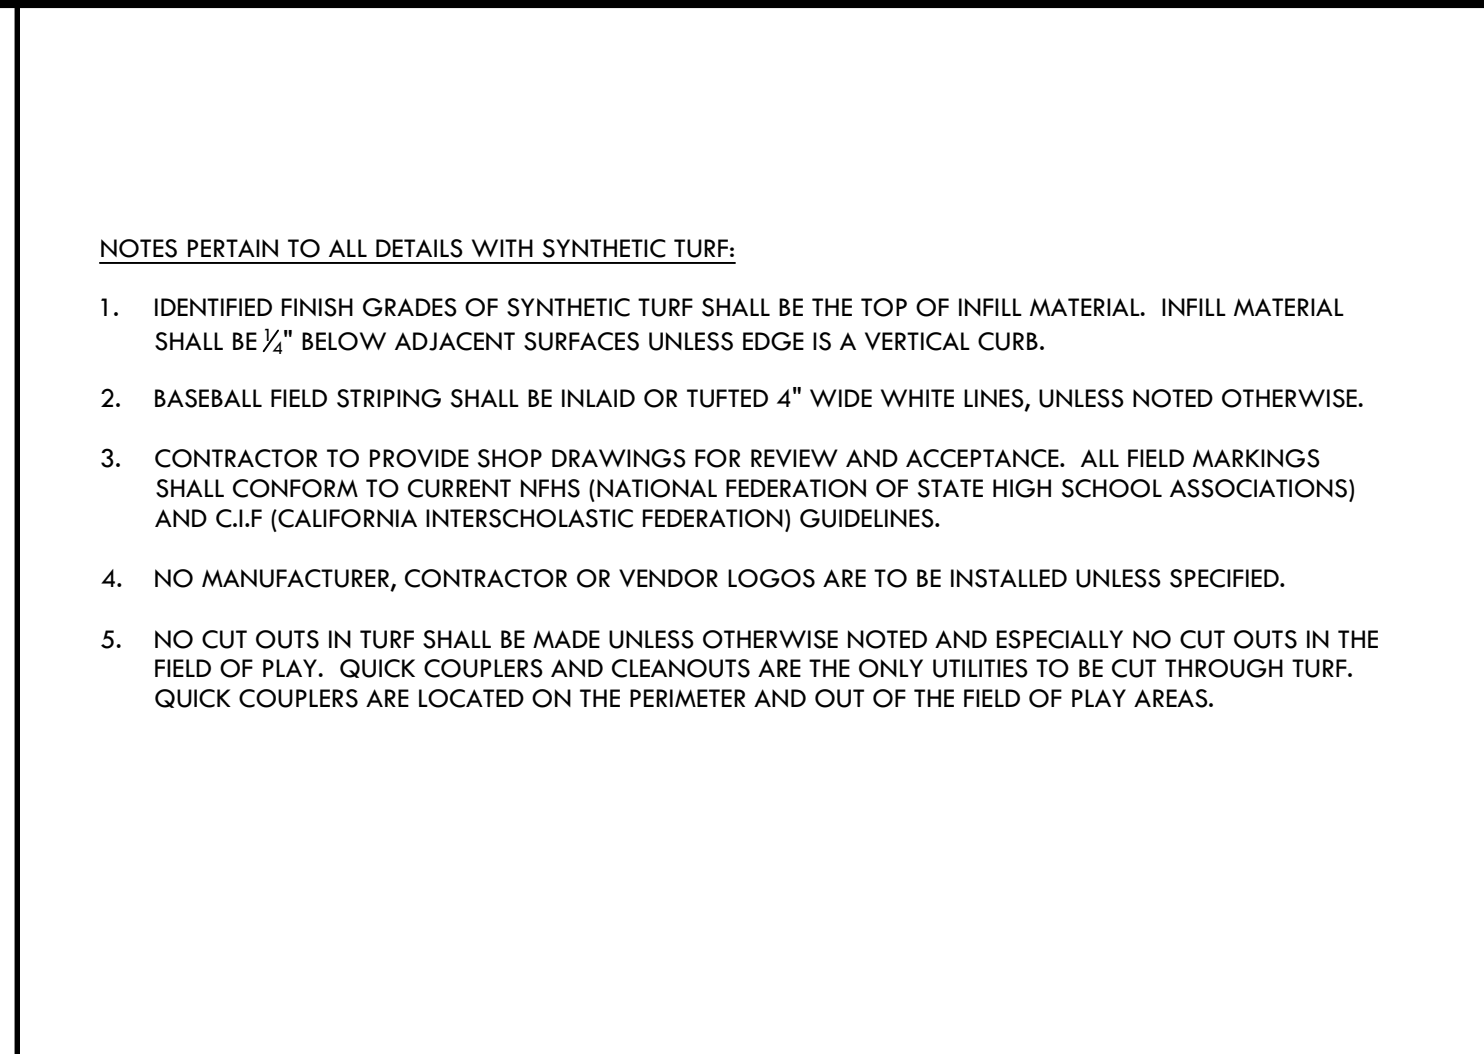


**G SYNTHETIC TURF NOTES** NTS

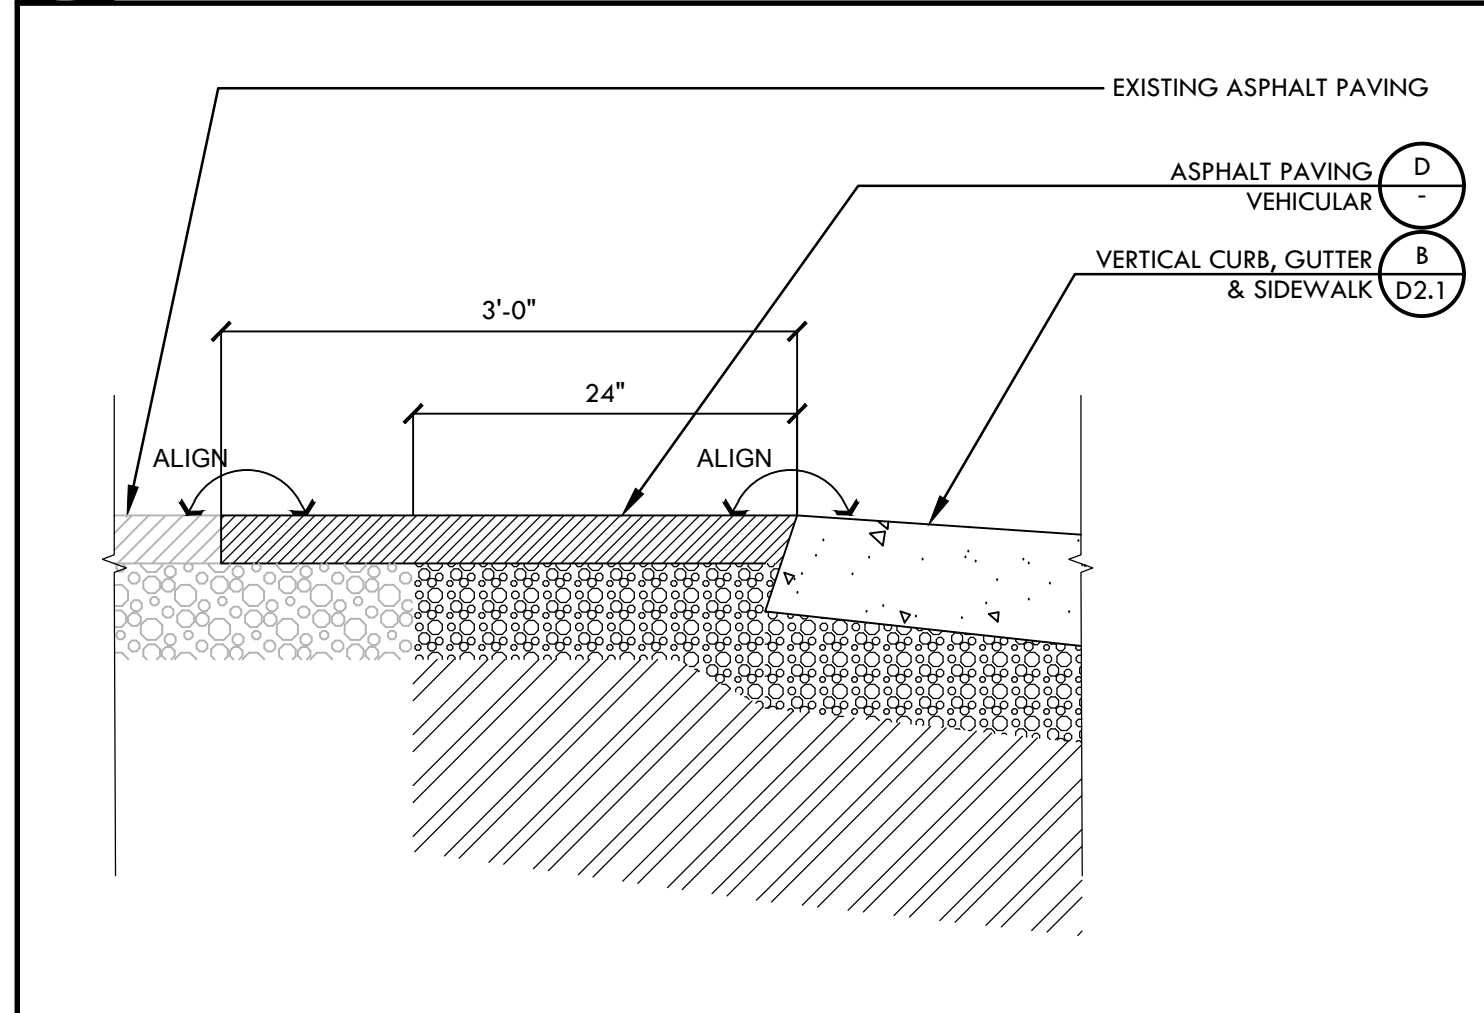


**F ASPHALT PATCH** NTS

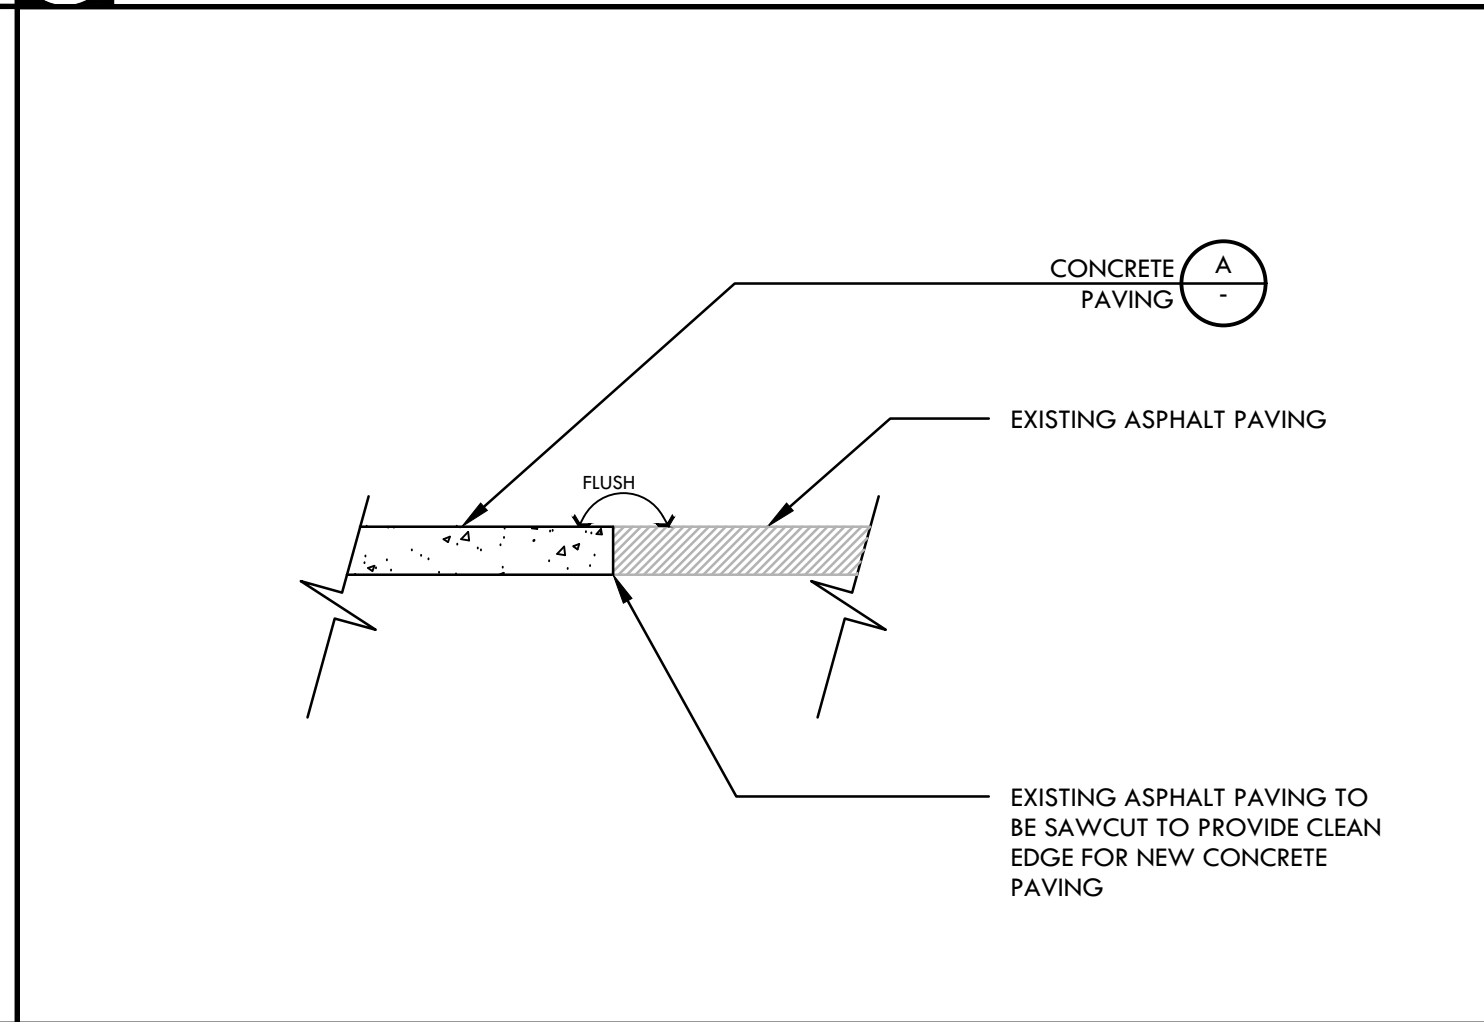


**E CONCRETE/ AC CONFORM** NTS

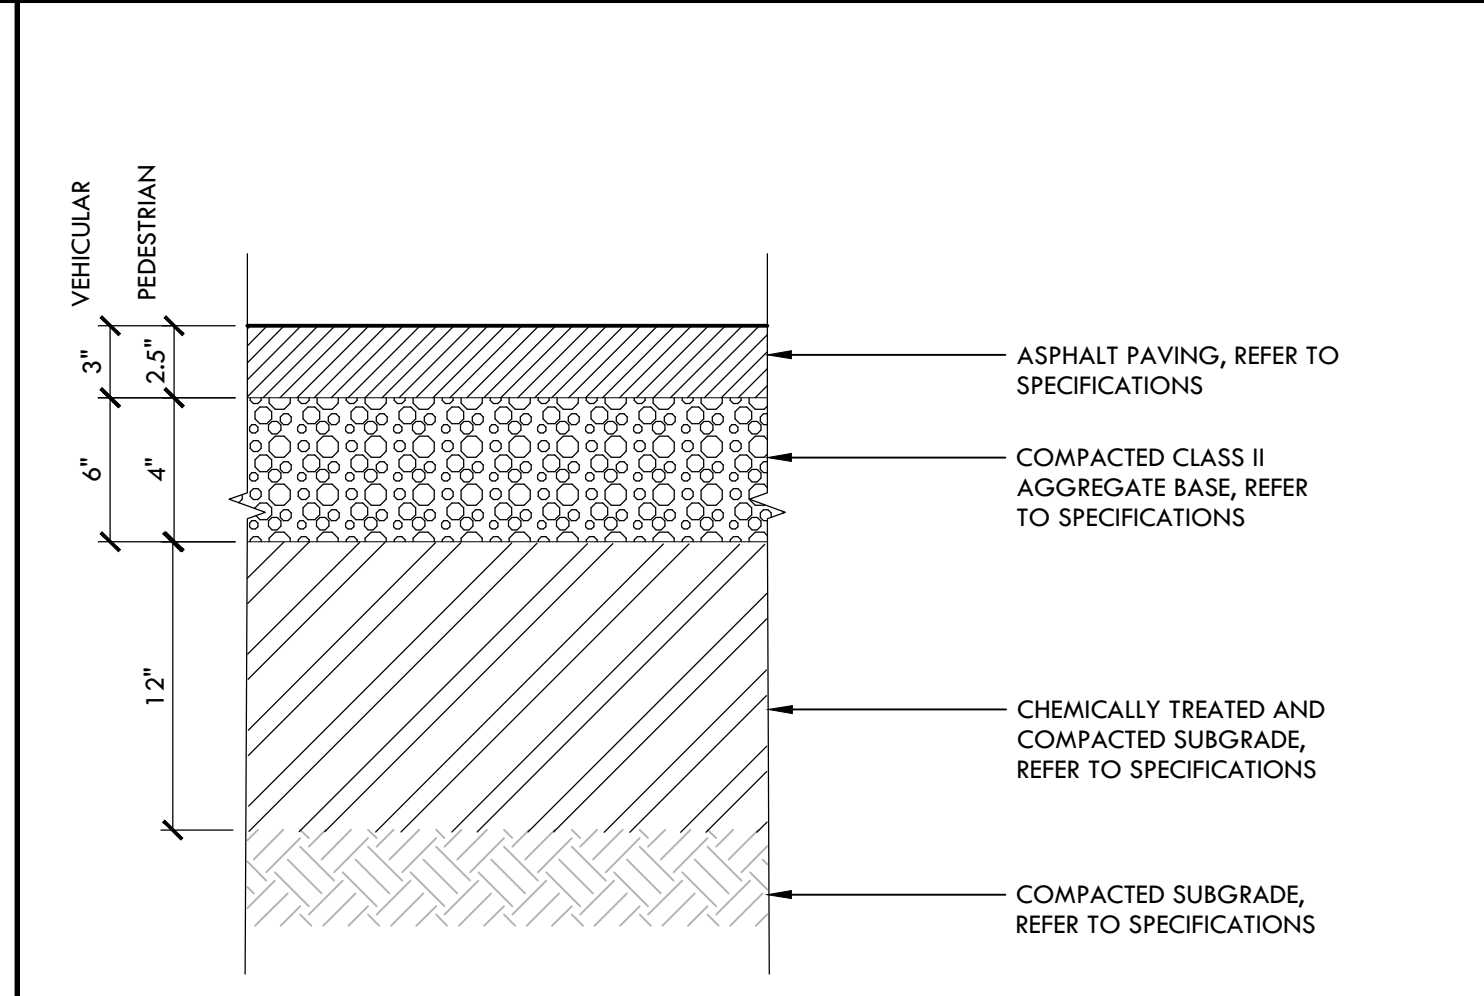


**D ASPHALT PAVING** NTS

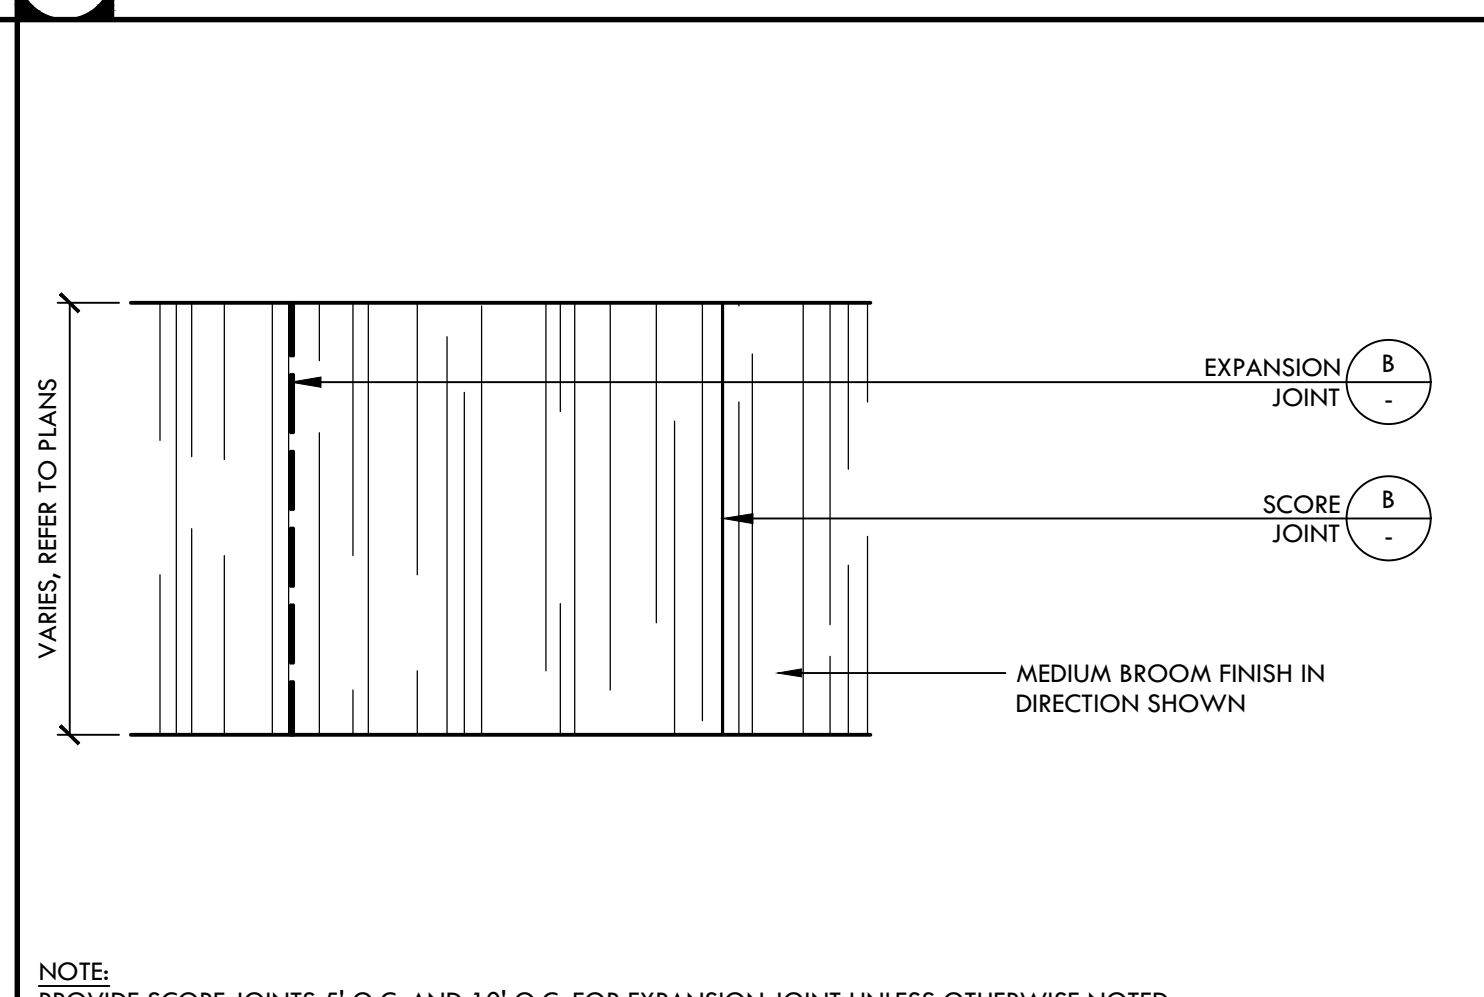


**C CONCRETE PAVING FINISH** NTS

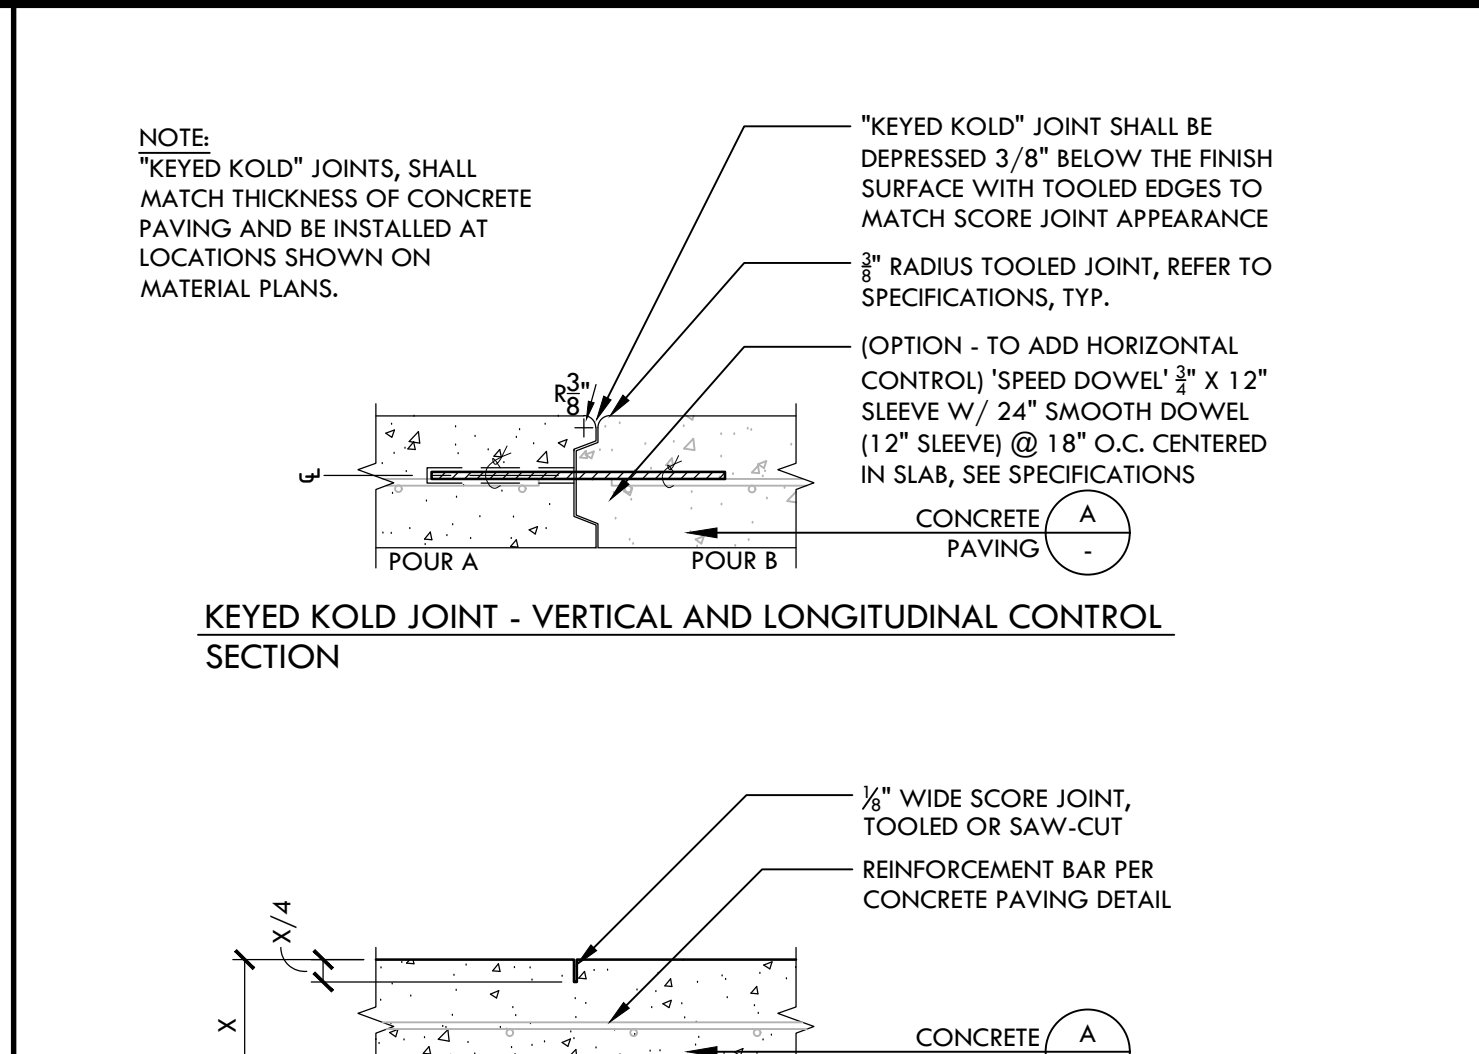


**A CONCRETE PAVING** NTS

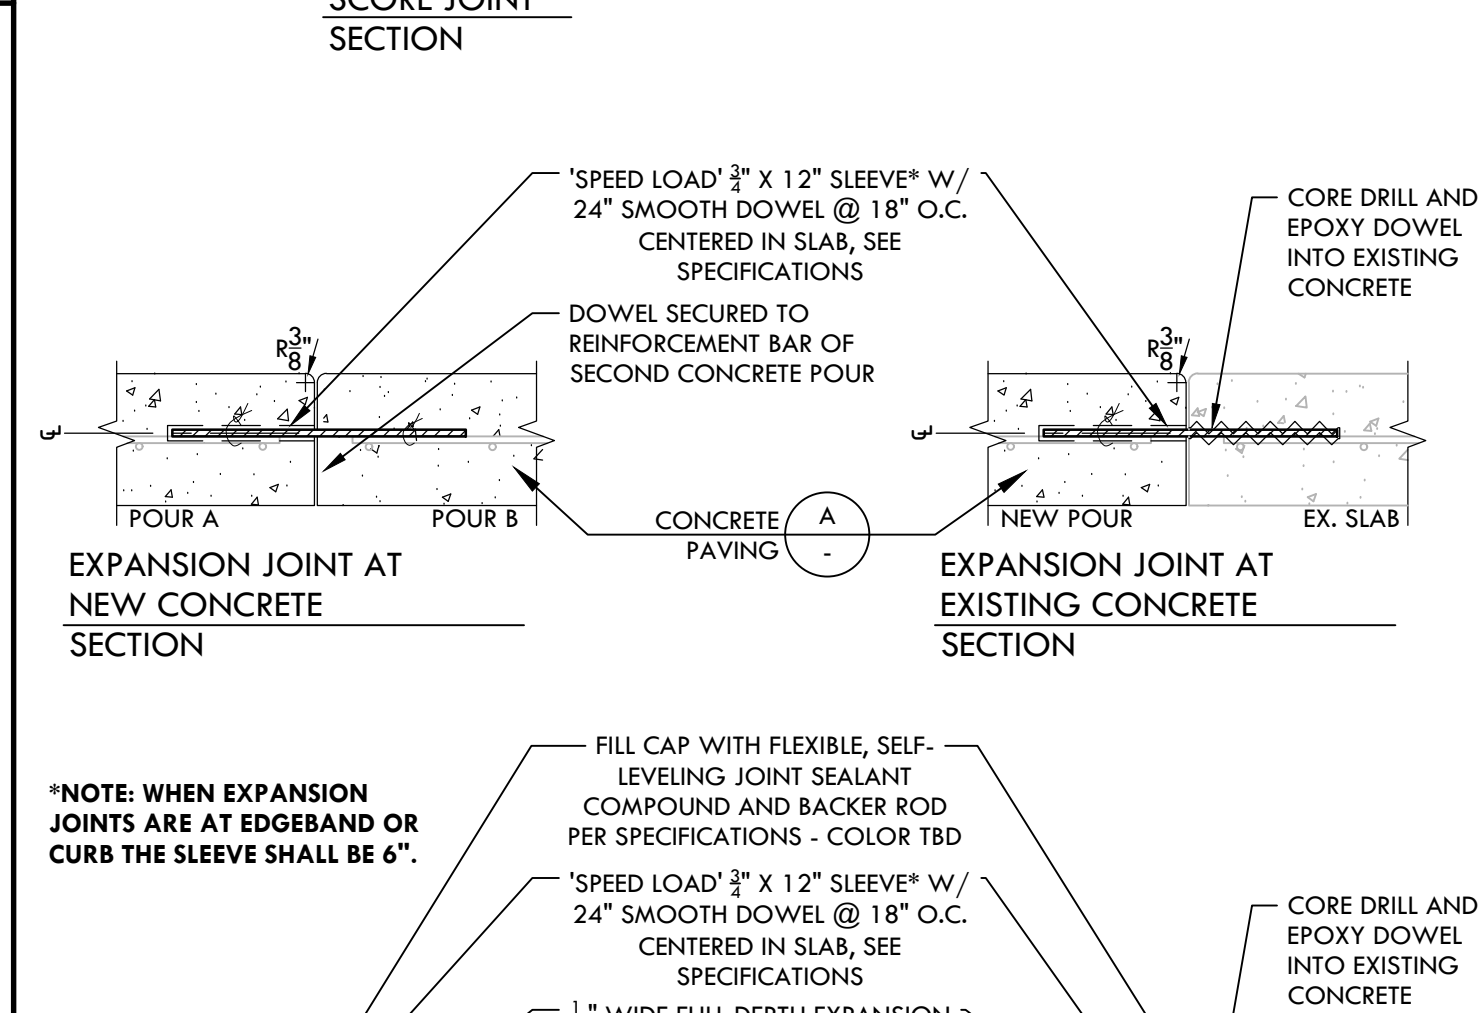


**B CONCRETE JOINTS** NTS

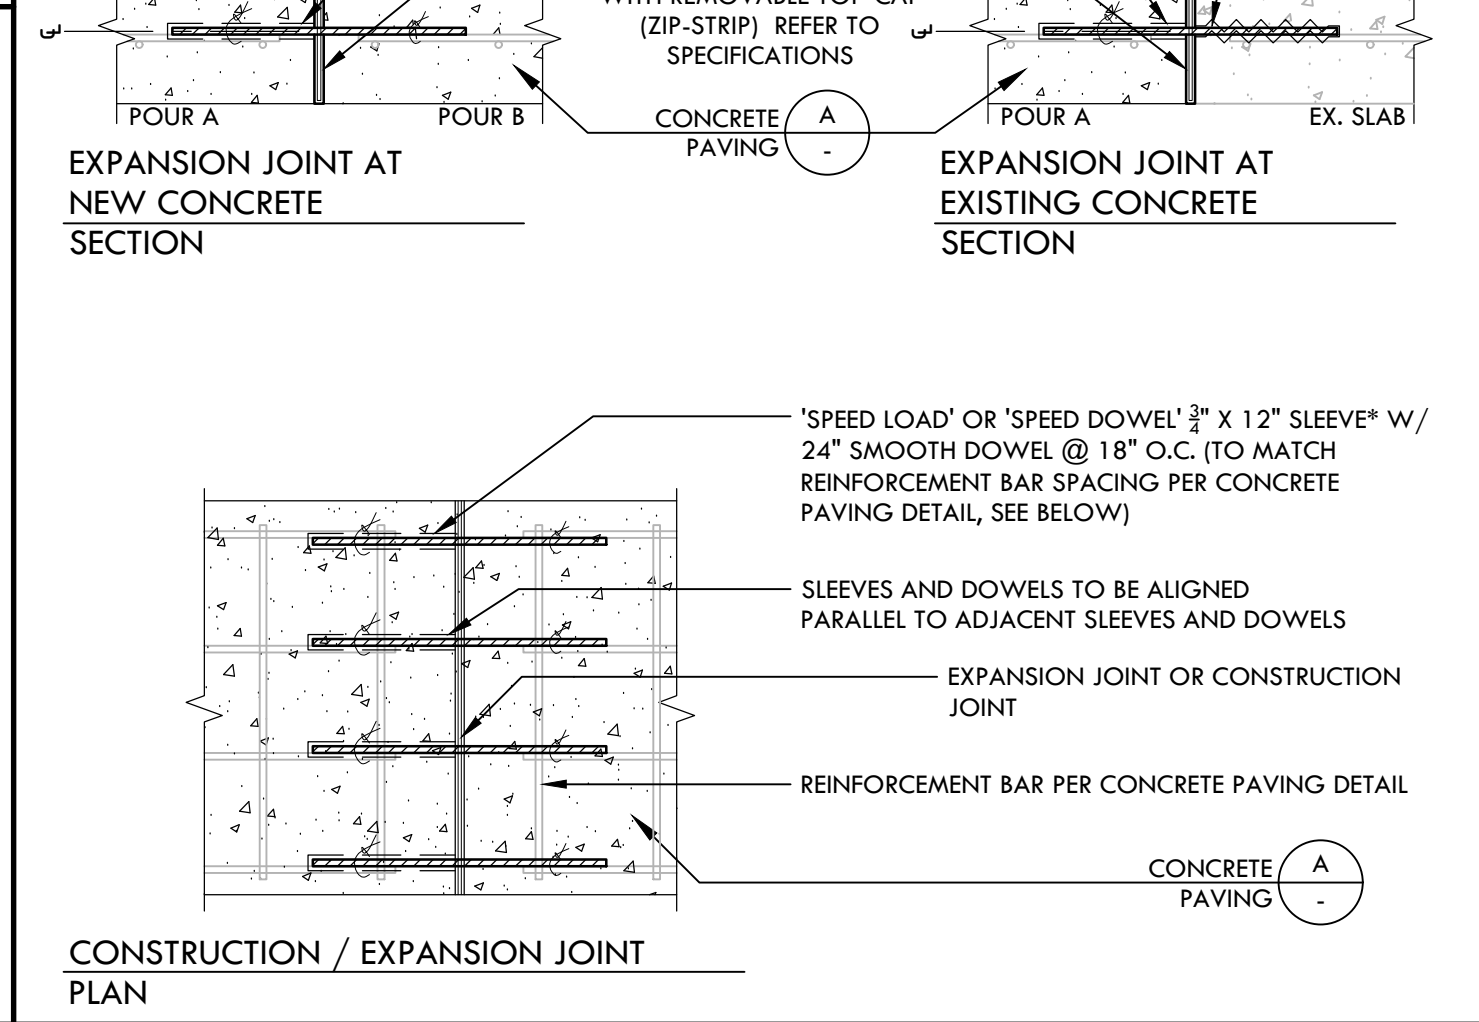

**CONSTRUCTION / EXPANSION JOINT PLAN**

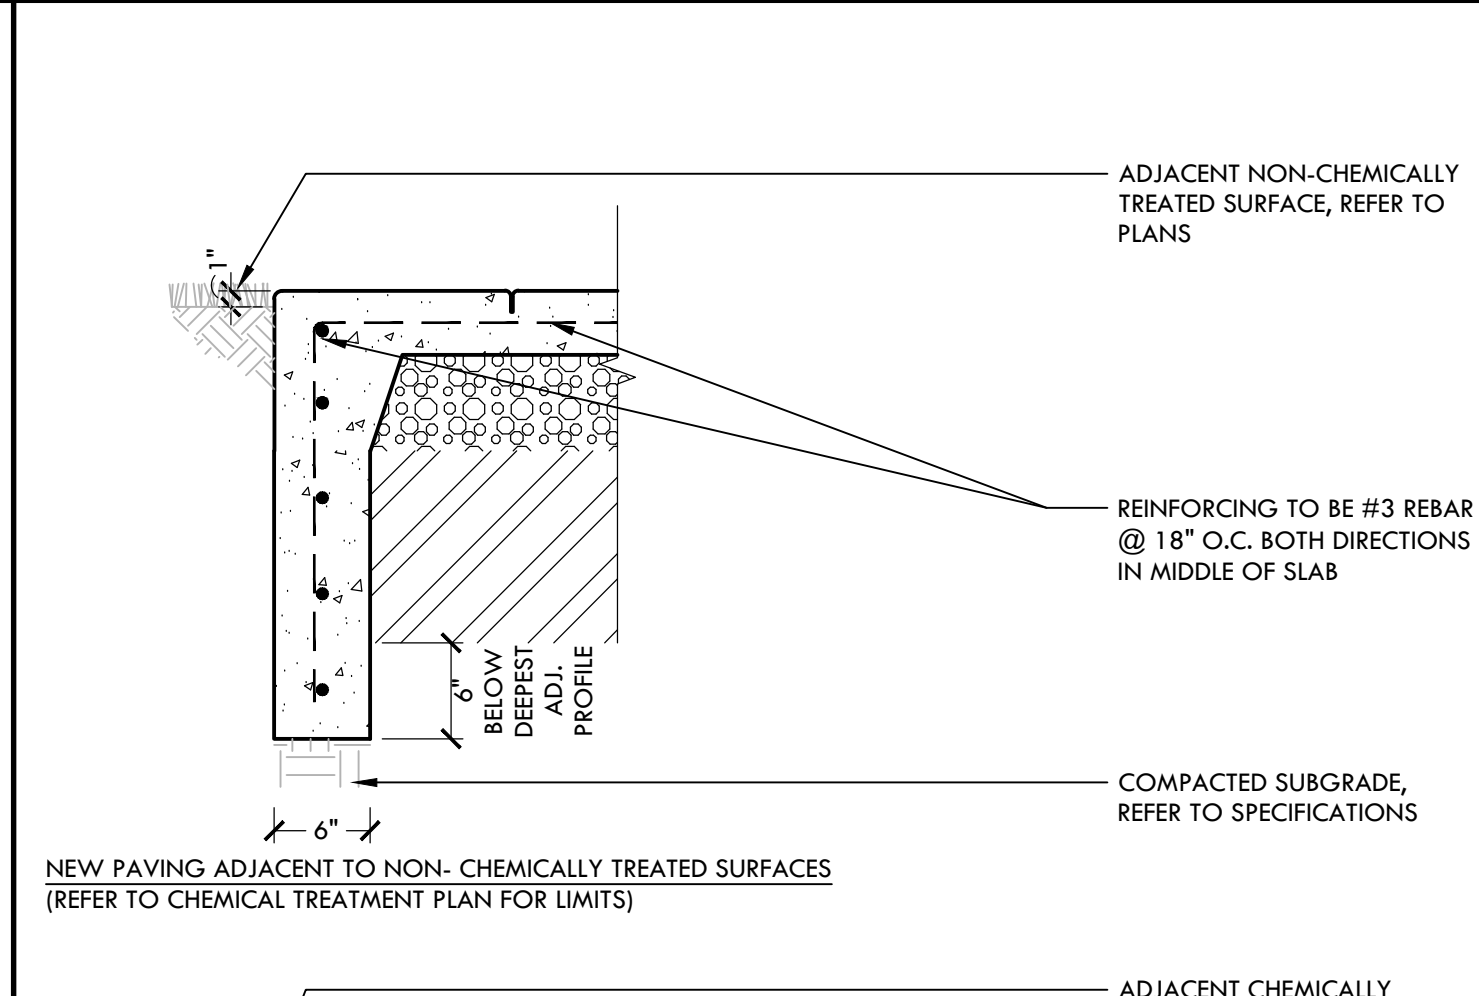

**CONSTRUCTION / EXPANSION JOINT SECTION**

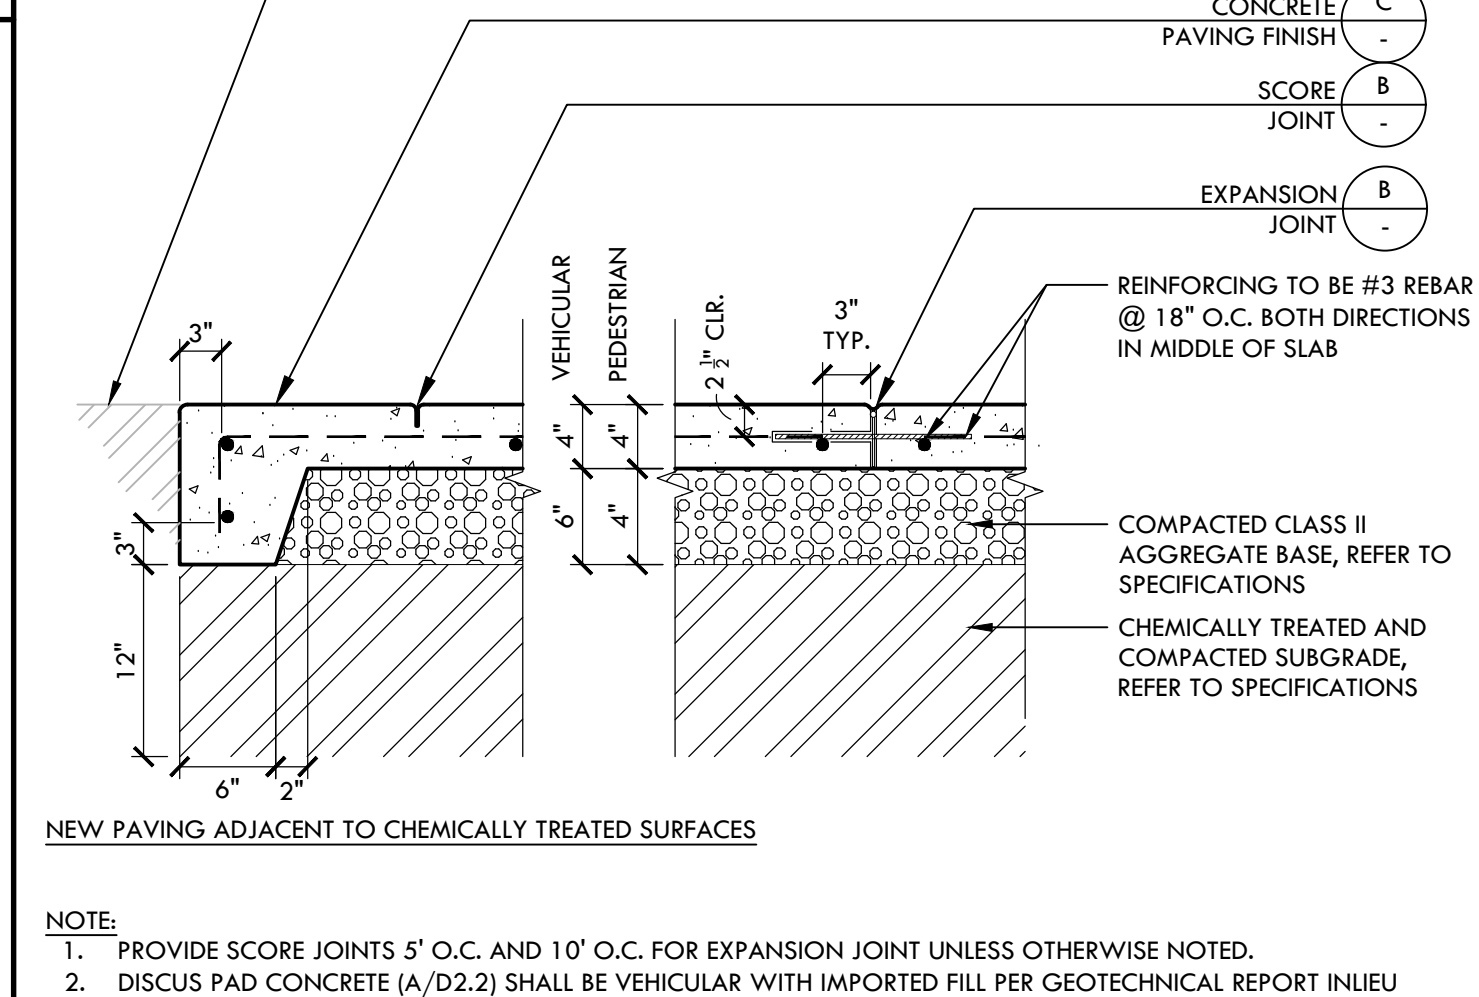

**CONSTRUCTION / EXPANSION JOINT SECTION**

IDENTIFICATION STAMP  
DIV. OF THE STATE ARCHITECT  
APP. 02-118017 INC.  
REVIEWED FOR  
SS ☐ FLS ☐ ACS ☐  
DATE: 04/10/2020

**VERDE DESIGN**  
LANDSCAPE ARCHITECTURE  
CIVIL ENGINEERING  
SPORT PLANNING & DESIGN  
1843 Iron Point Rd #140  
Folsom, CA 95630  
tel: 916.415.6554  
fax: 916.985.7260  
www.VerdeDesignInc.com

STAMP

CONSULTANT

KEYMAP

SHEET TITLE  
**CONSTRUCTION DETAILS - HARDSCAPE**

PROJECT NAME  
**CHAVEZ HIGH SCHOOL STOCKTON USD ATHLETIC FACILITY IMPROVEMENTS**

PROJECT ADDRESS  
**2929 WINDFLOWER LN STOCKTON, CA 95212**

| SUBMITTAL               | DATE     |
|-------------------------|----------|
| DD/50% SUBMITTAL        | 10/25/19 |
| DSA SUBMITTAL           | 12/20/19 |
| DSA BACKCHECK SUBMITTAL | 03/27/20 |

| NO. | REVISIONS | DATE |
|-----|-----------|------|
| 1   |           |      |
| 2   |           |      |
| 3   |           |      |
| 4   |           |      |
| 5   |           |      |

DRAWN BY  
**VDI**

CHECKED BY  
**CS**

DATE ISSUED  
**03/27/20**

SCALE

PROJ. NO.  
**1910900-1211**

SHEET NO.  
**D2.0**


OF 122

CONSTRUCTION DETAILS - HARDSCAPE




ALL DESIGN, CONSTRUCTION, AND FINISHES ARE THE PROPERTY OF VERDE DESIGN, INC. AND WILL BE USED, REPRODUCED, OR DISCLOSED TO ANY PERSON, FIRM, OR ORGANIZATION FOR ANY PURPOSE WITHOUT WRITTEN PERMISSION OF VERDE DESIGN, INC. NO PART OF THIS DRAWING SHALL BE USED, REPRODUCED, OR DISCLOSED TO ANY PERSON, FIRM, OR ORGANIZATION FOR ANY PURPOSE WITHOUT WRITTEN PERMISSION OF VERDE DESIGN, INC. NO PART OF THIS DRAWING SHALL BE USED, REPRODUCED, OR DISCLOSED TO ANY PERSON, FIRM, OR ORGANIZATION FOR ANY PURPOSE WITHOUT WRITTEN PERMISSION OF VERDE DESIGN, INC.


N

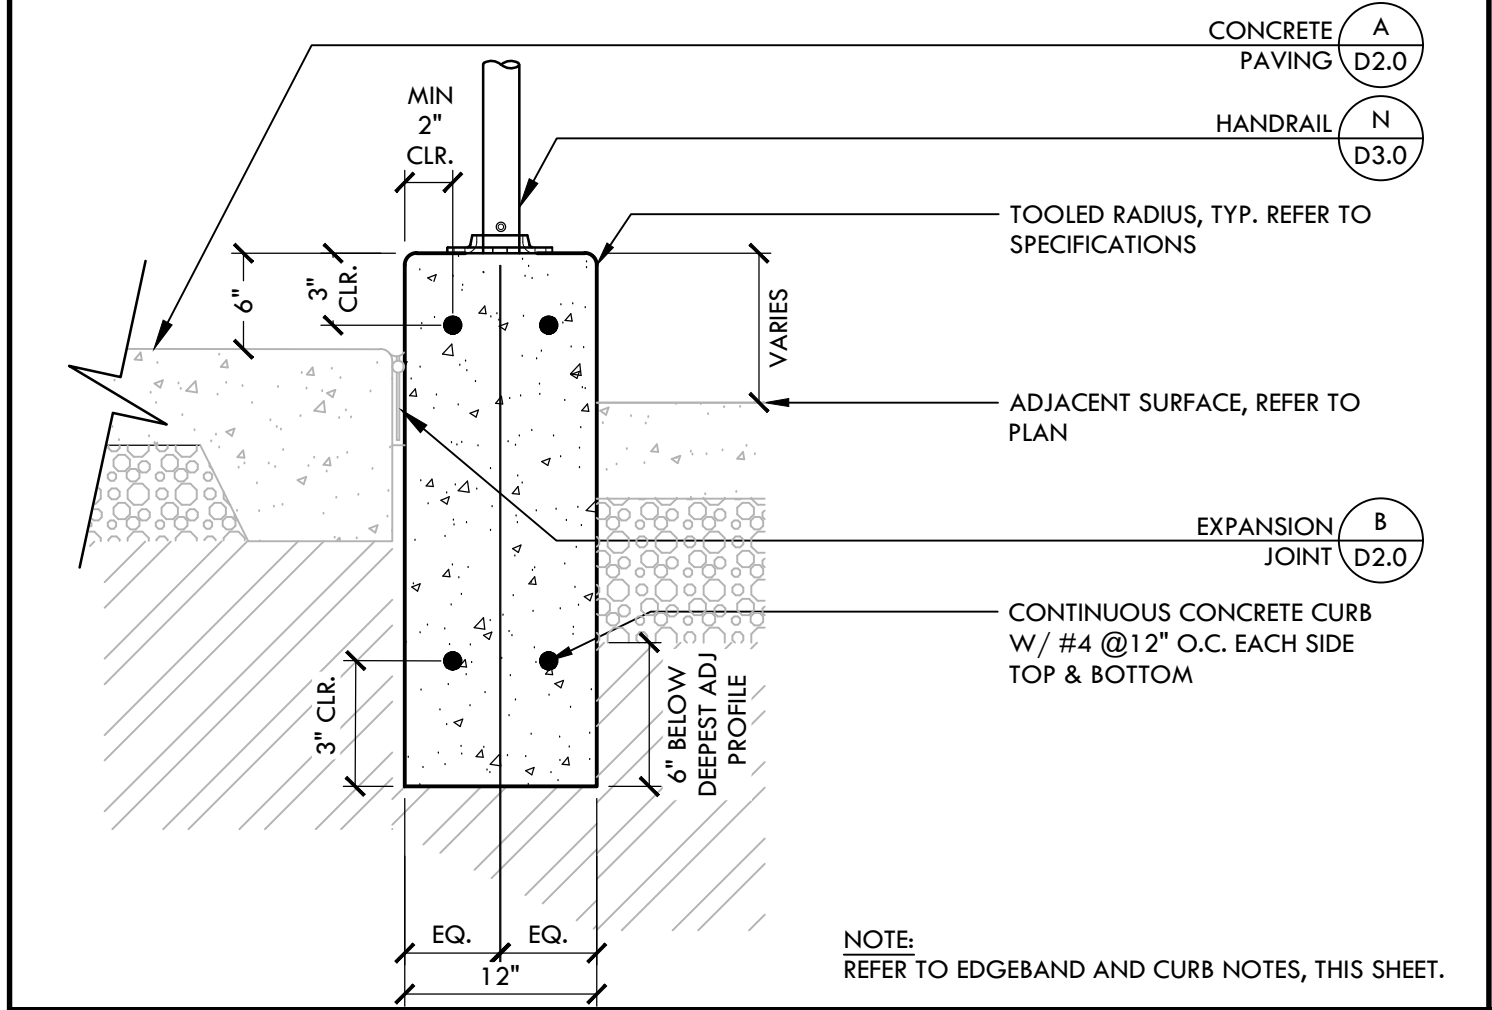


M CURB @ DUGOUT RAMP NTS

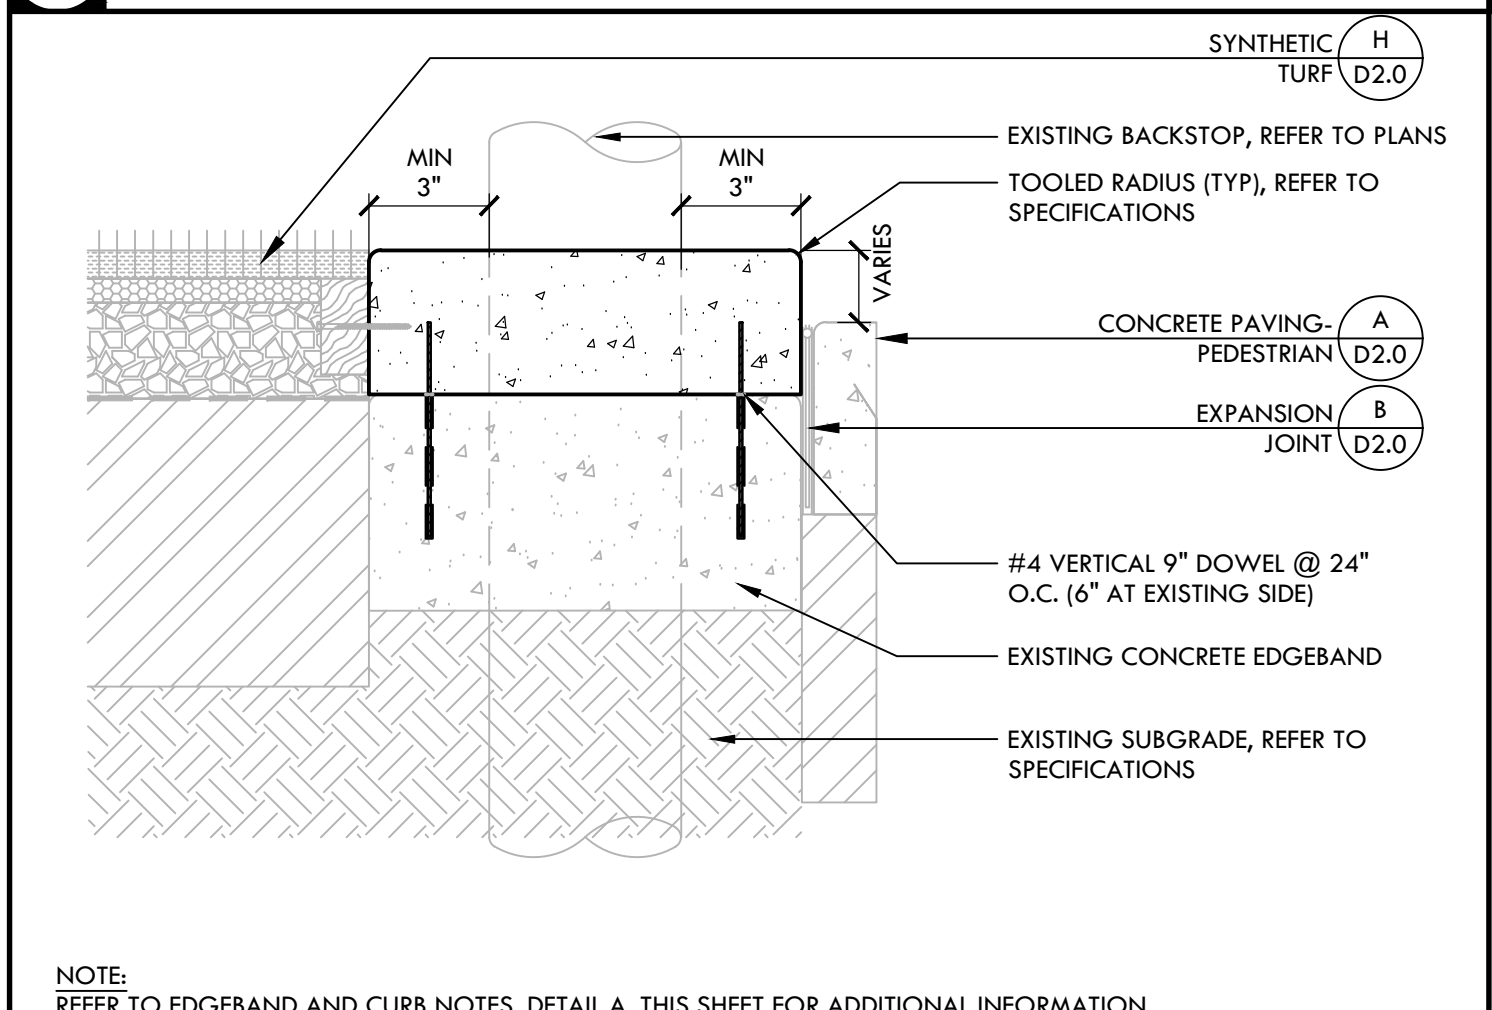


L EXISTING BACKSTOP OR FENCE AT SYNTHETIC TURF NTS

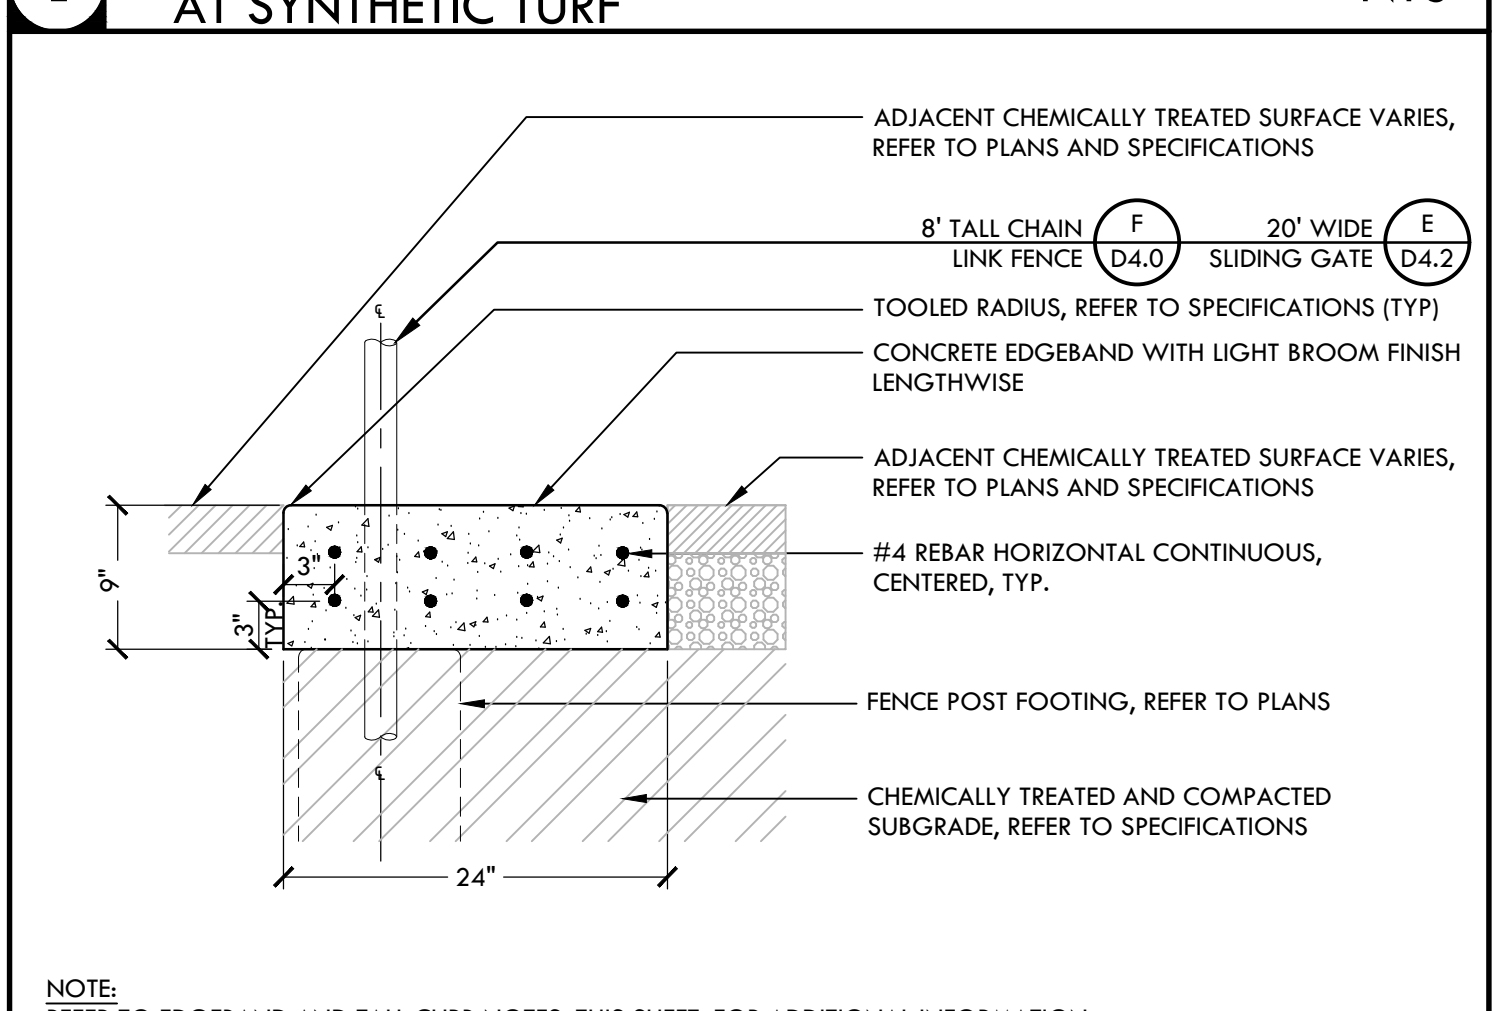


K EDGE BAND @ SLIDE GATE NTS

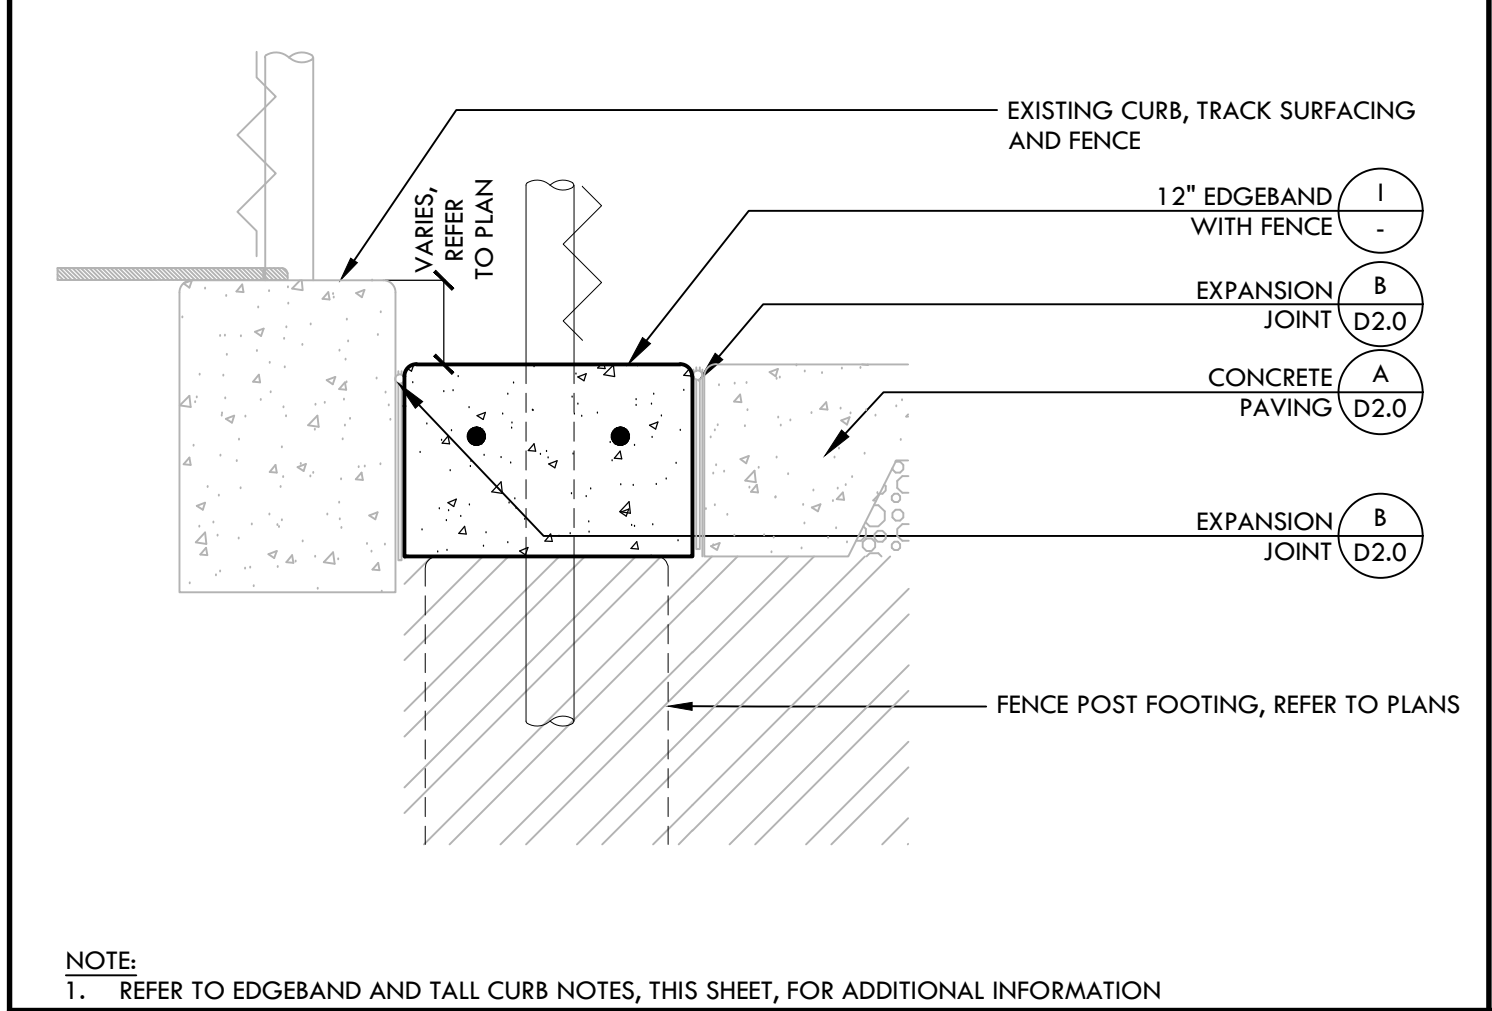


J EDGE BAND WITH FENCE @ EXISTING NTS

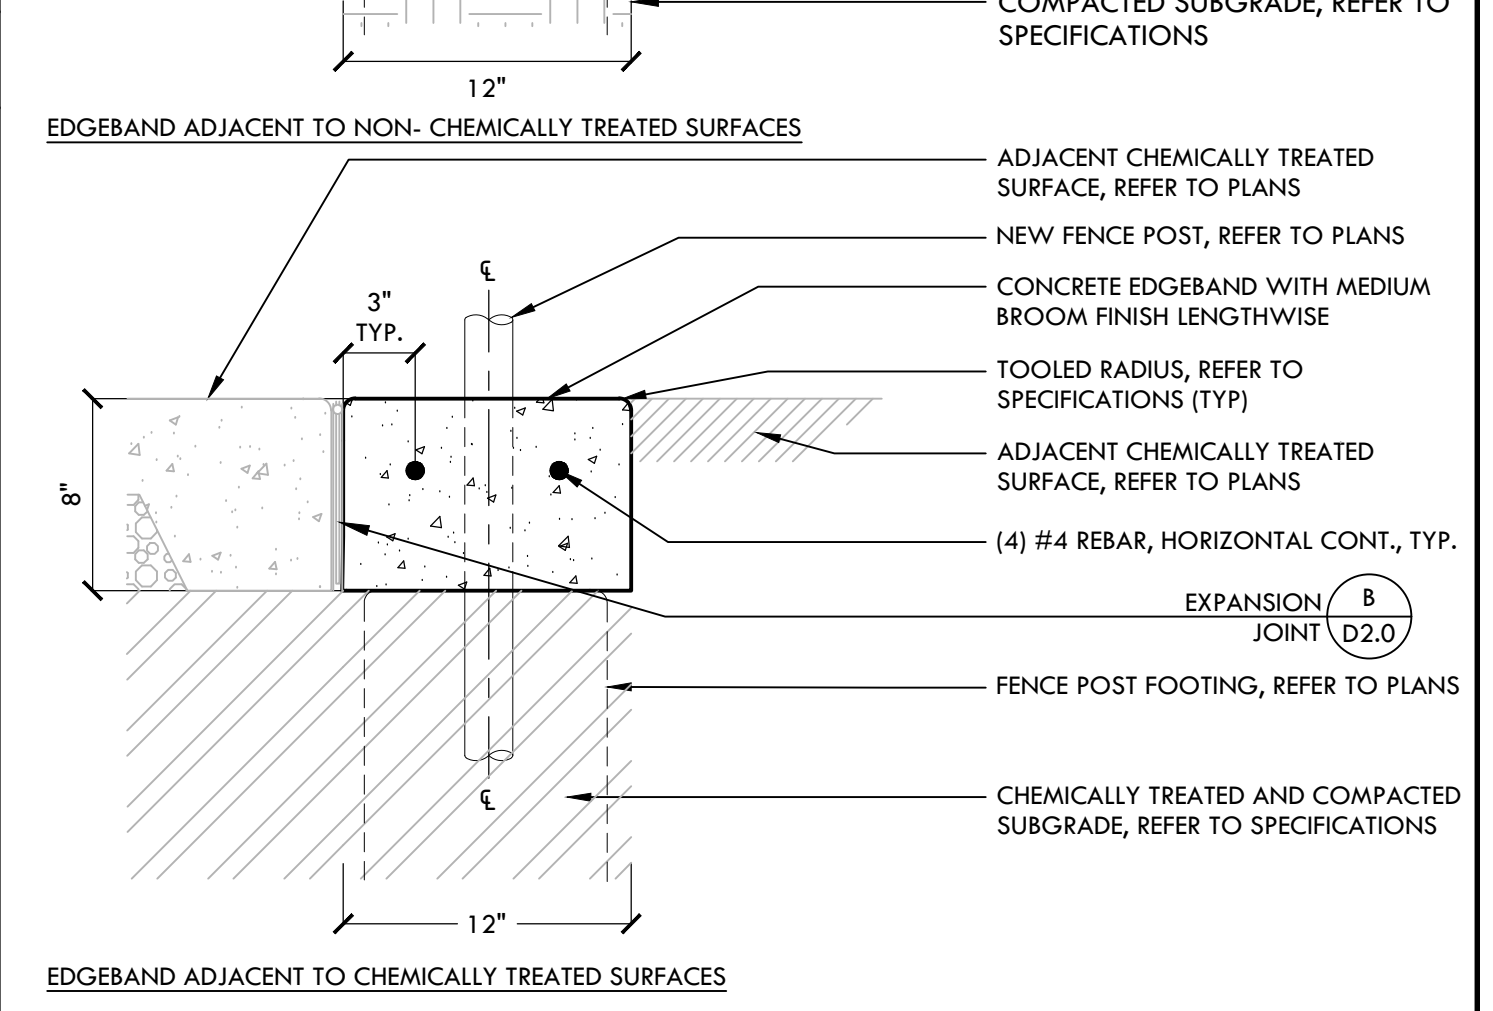


I 12 inch EDGE BAND WITH FENCE NTS

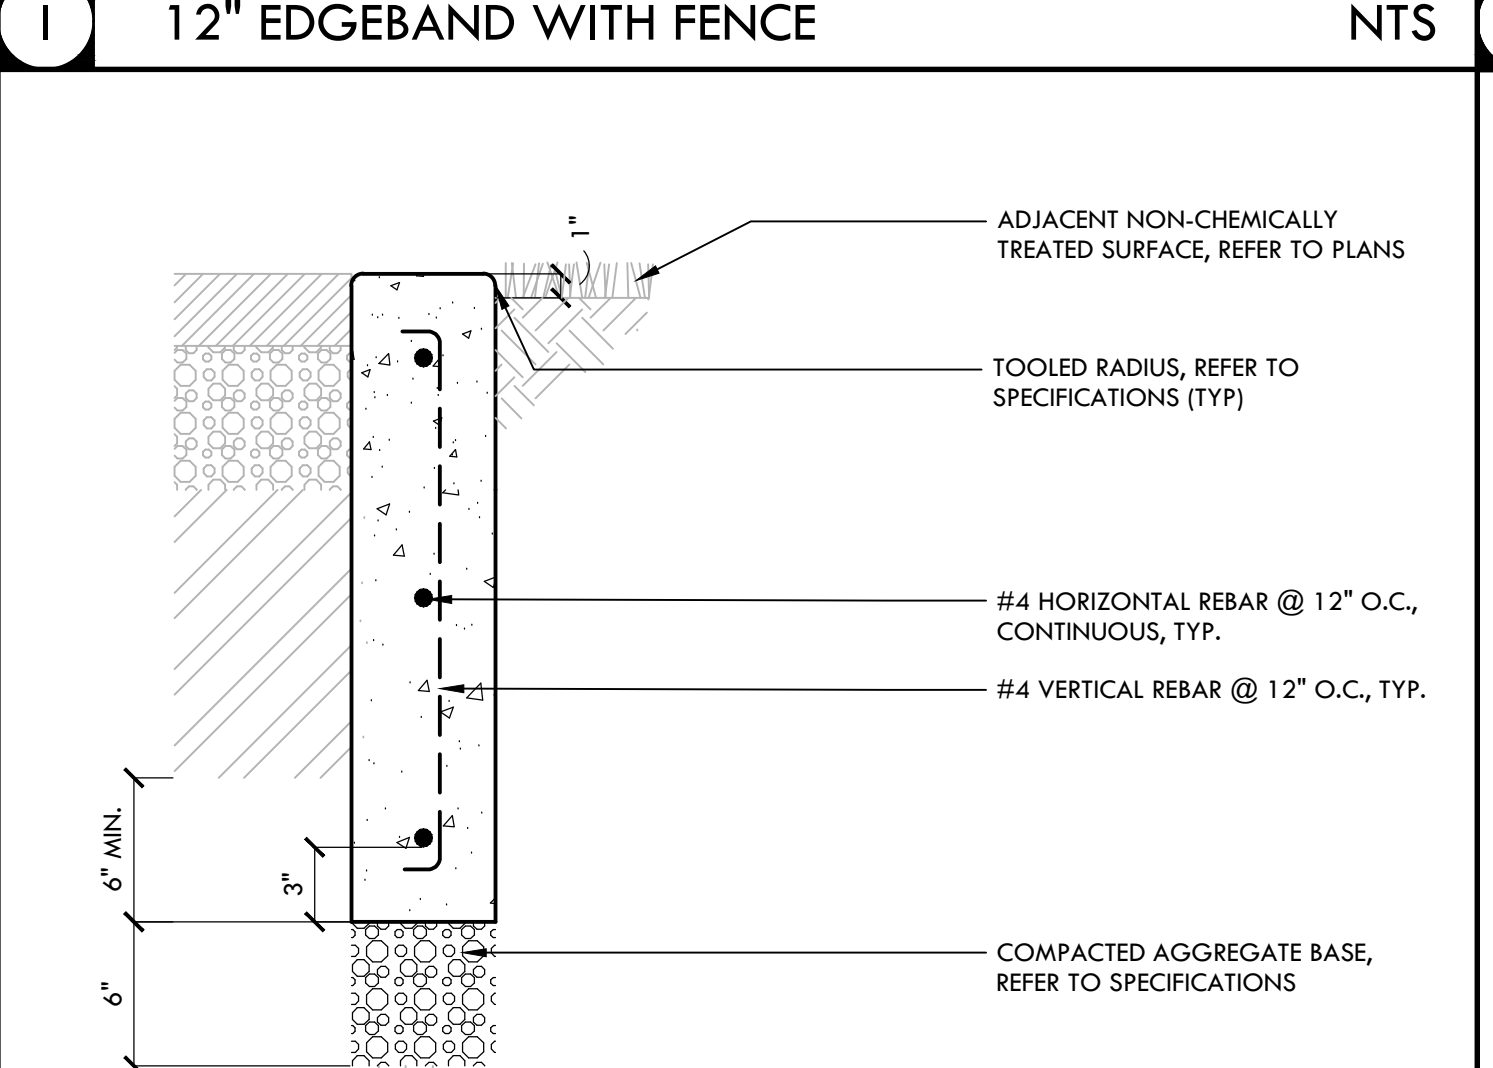


H 6 inch EDGE BAND NTS

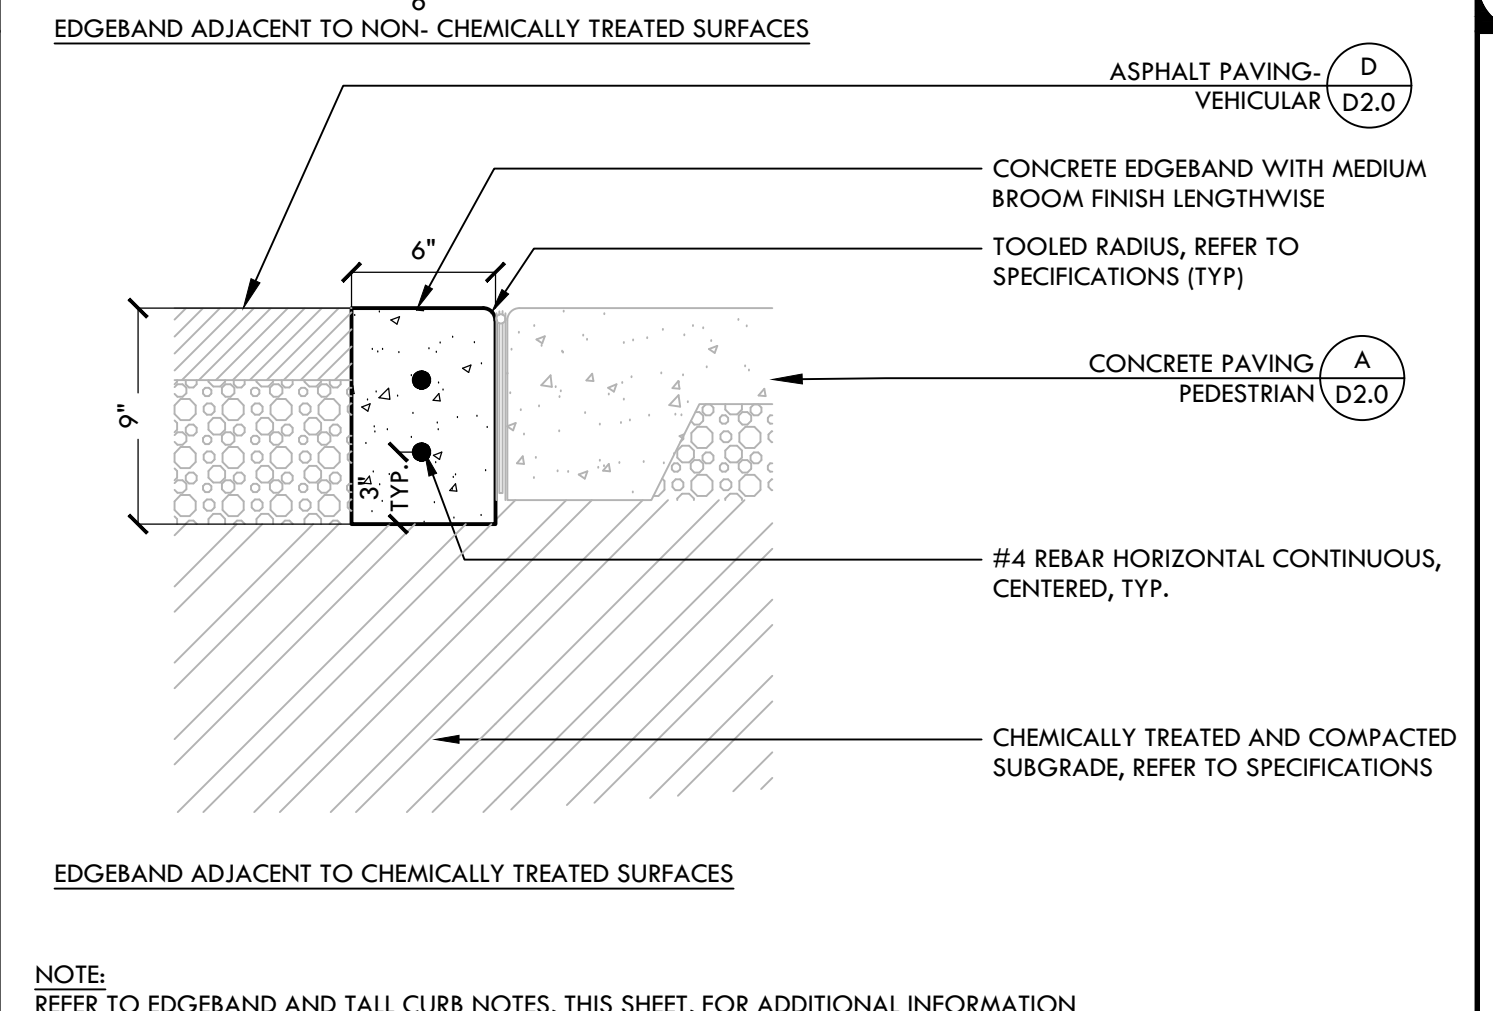


G BULLPEN CURB 2 NTS

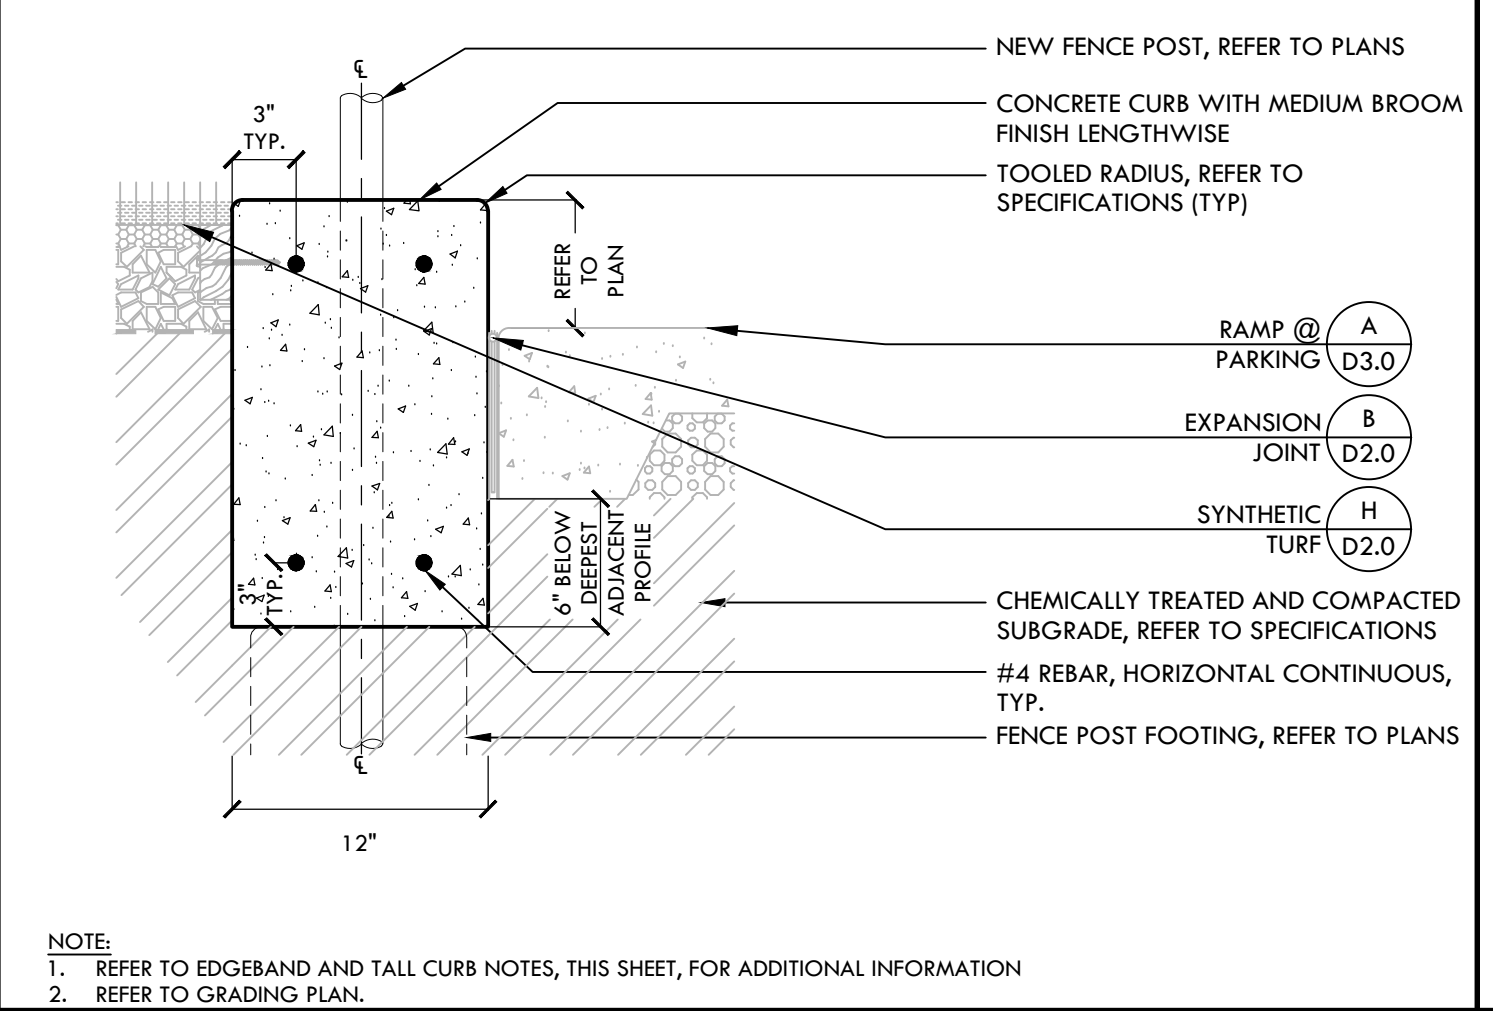


D 6 inch CURB @ PARKING LOT NTS

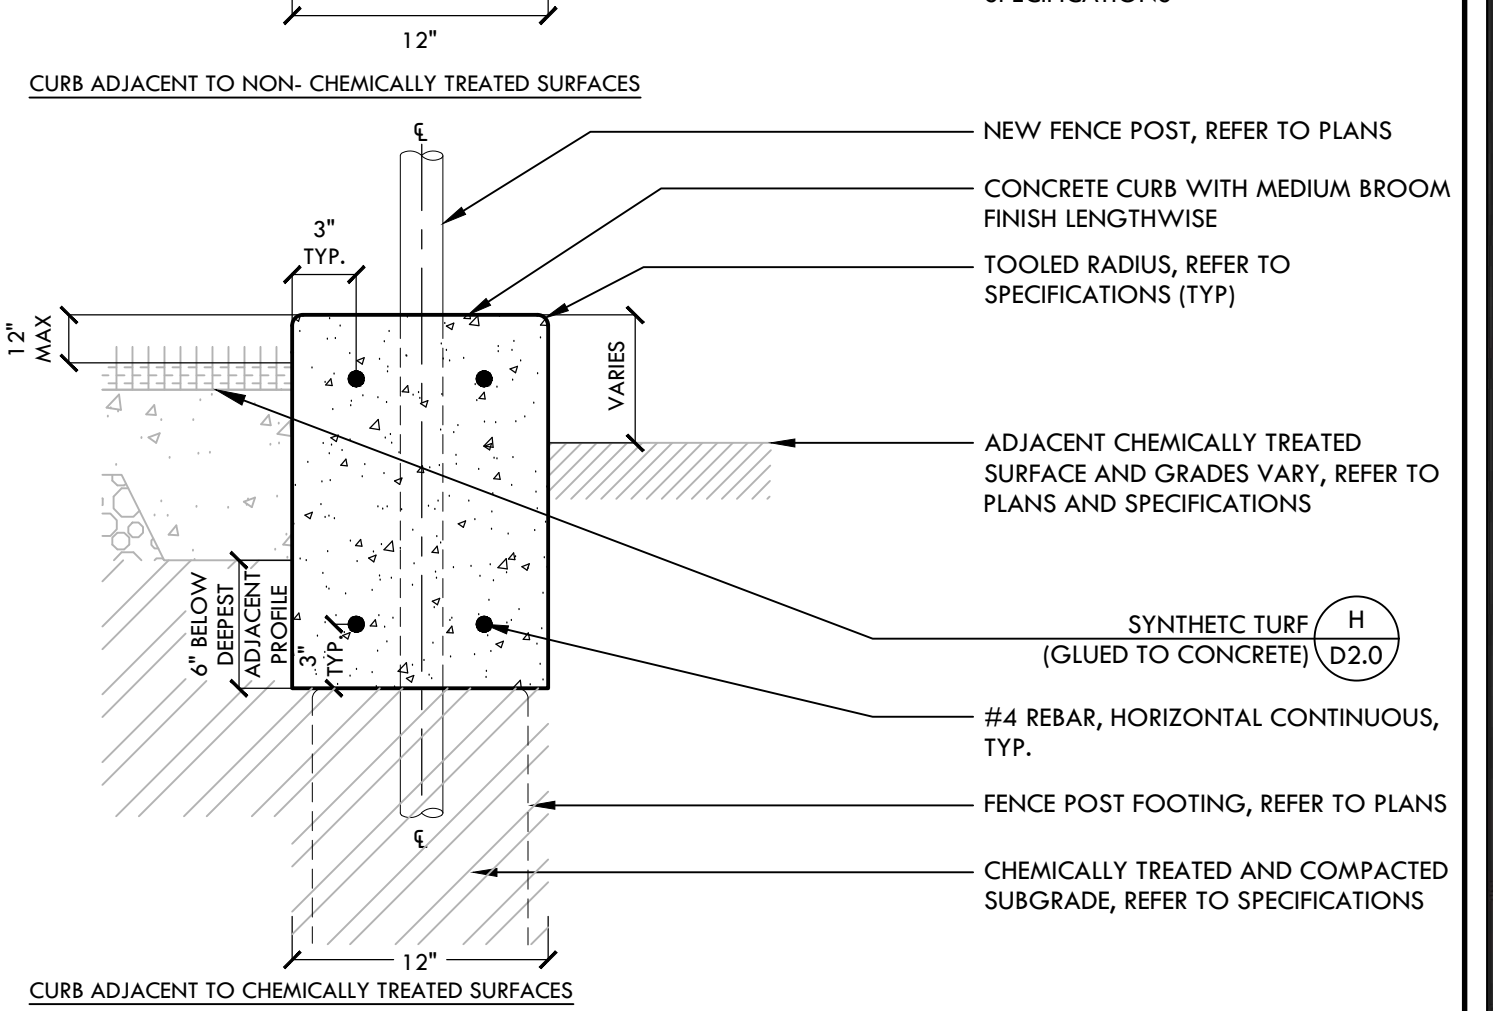


F BULLPEN CURB 1 NTS

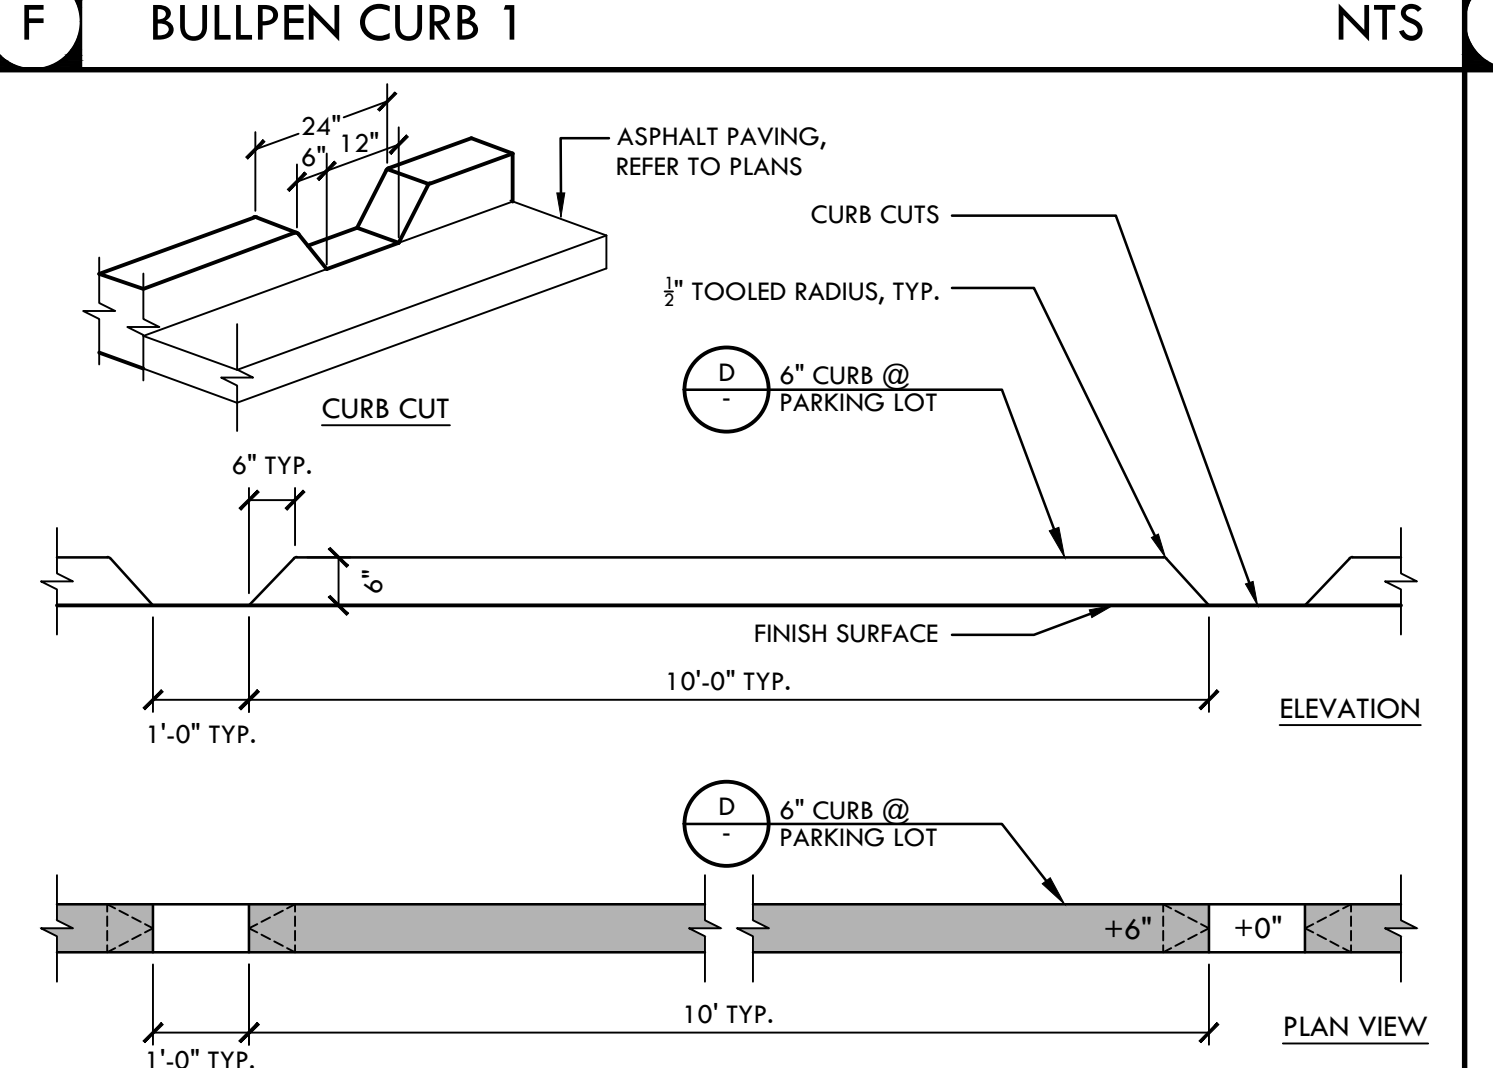

E 6 inch WIDE CONCRETE CURB WITH CURB CUTS NTS

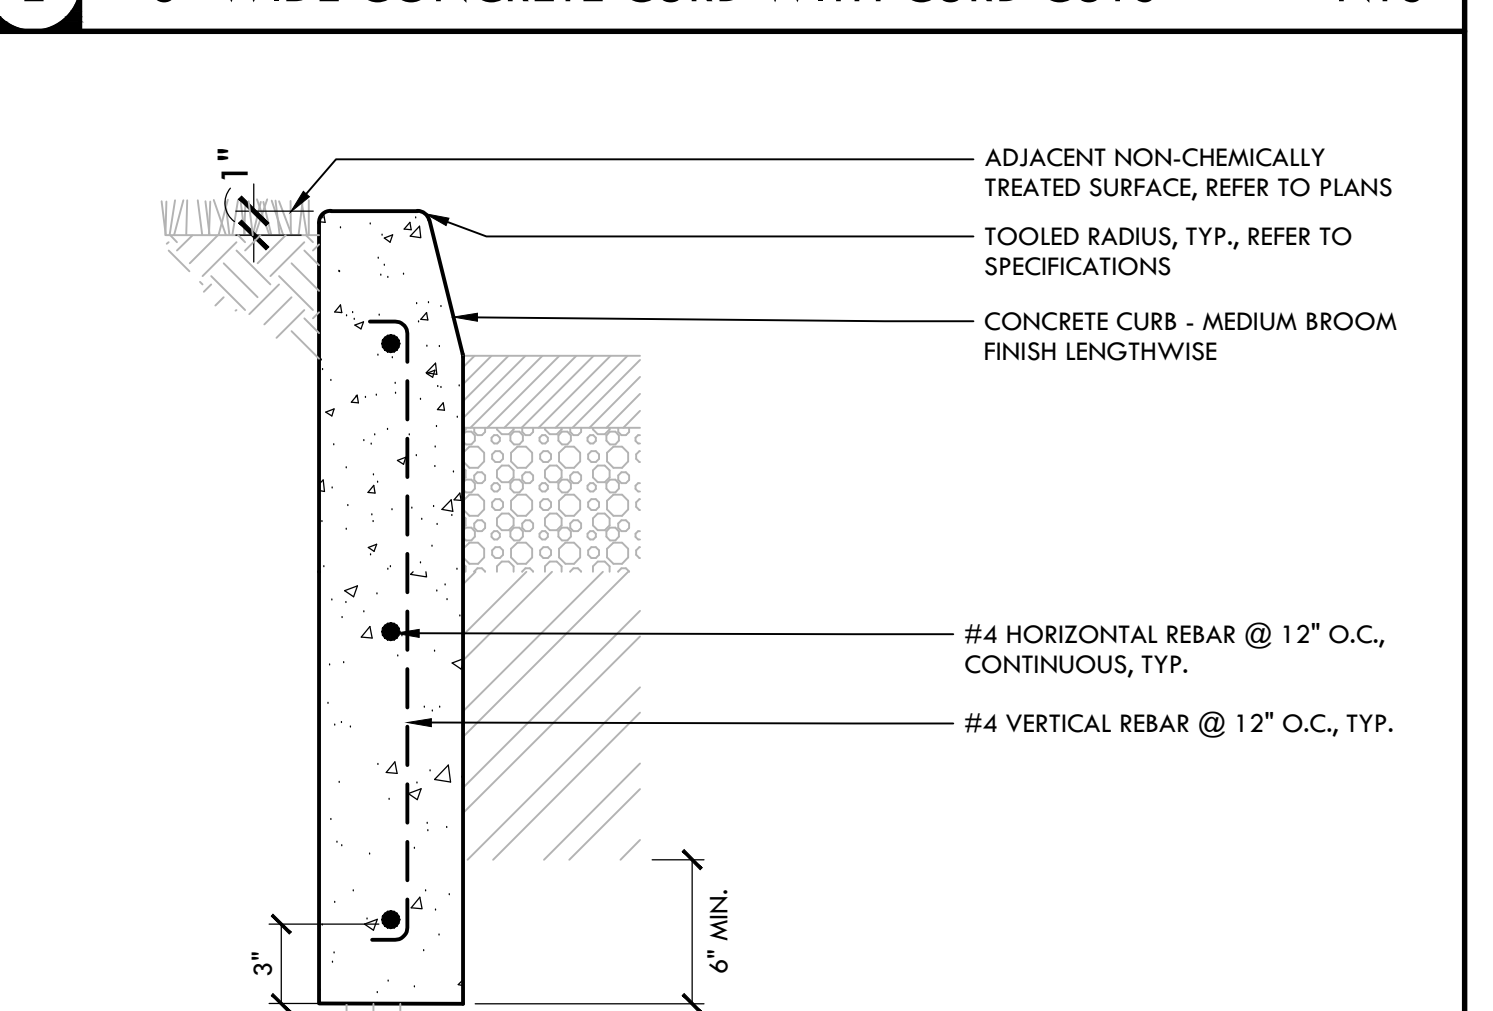

B VERTICAL CURB, GUTTER & SIDEWALK NTS

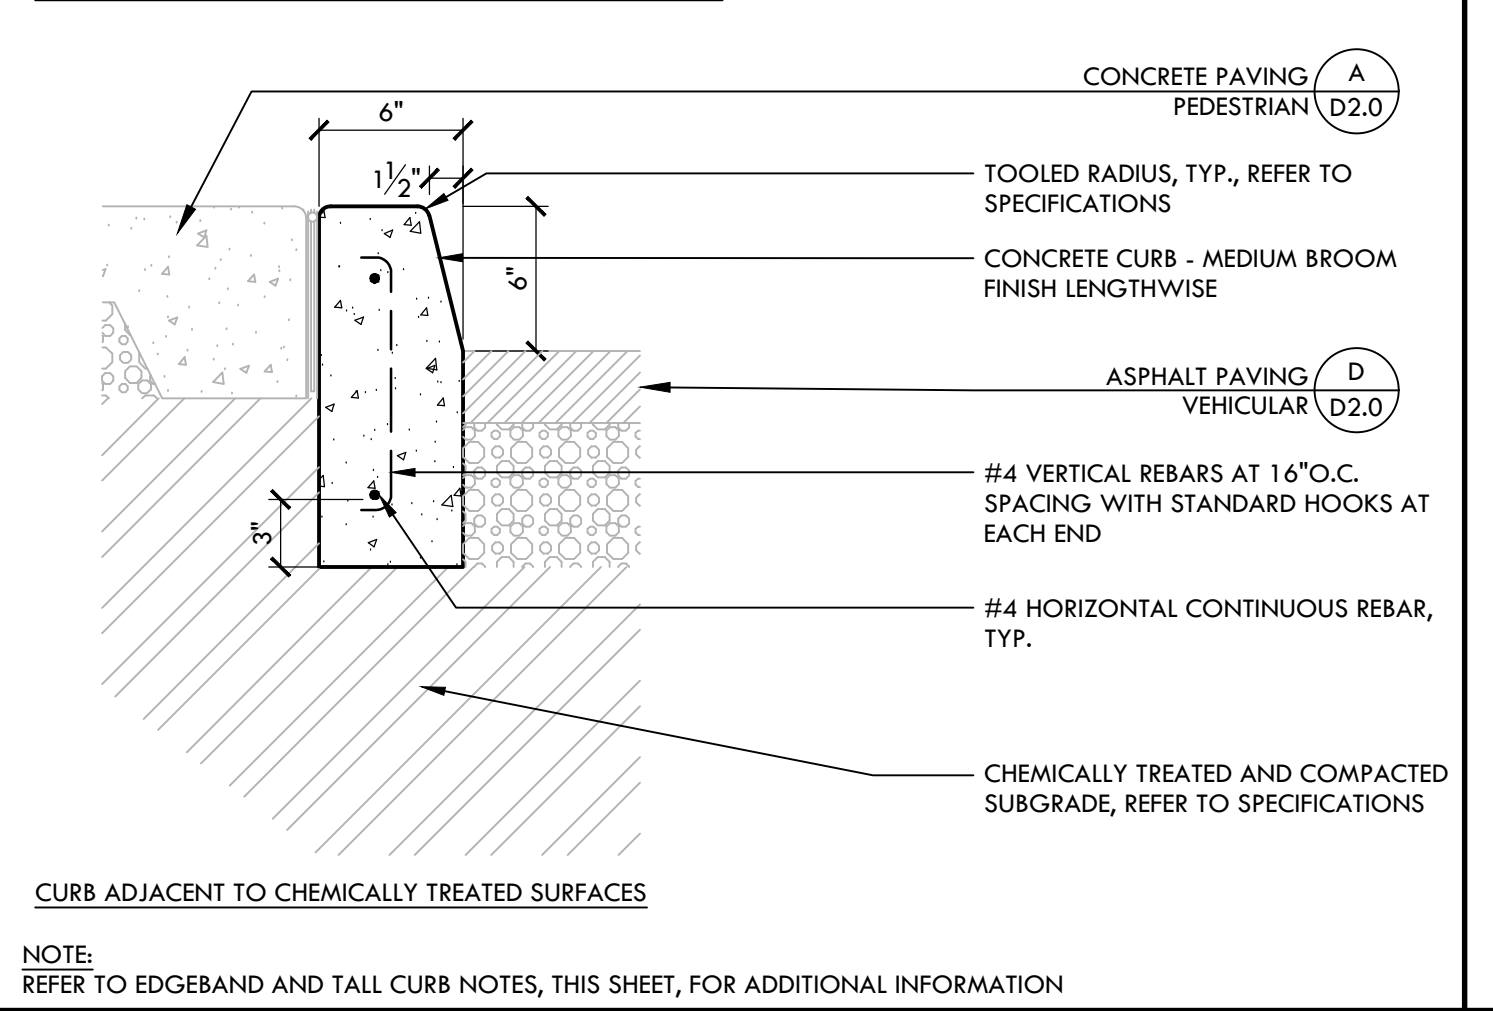

A EDGE BAND AND CURB NOTES NTS


NOTES:

- CURB, GUTTER AND SIDEWALK AND ALL P.C.C. FLATWORK SHALL HAVE A FINE HAIR LIGHT BROOM FINISH; CURB AND GUTTER PARALLEL TO THE FLOW LINE.
- CONSTRUCT EXPANSION JOINTS 150'-0" ON CENTER MAXIMUM, AND AT RETURNS, LIGHT POLES, HYDRANTS, CATCH BASINS, BOTH SIDES OF DRIVEWAY, AND OTHER FIXED OBJECTS.
- CONSTRUCTION SHALL BE IN ACCORDANCE WITH THE APPLICABLE SECTIONS OF THE CURRENT CITY OF STOCKTON STANDARDS SPECIFICATIONS.
- SEE DEFINITION SECTION OF STANDARD SPECIFICATIONS FOR DEFINITION OF SAND.
- WEAKENED PLANE JOINTS AND SCORE MARKS AS SHOWN. SEE DWG R-50 FOR WEAKENED PLANE JOINT WIDTH AND DEPTH.
- PLACE 5/8" X 24" LONG STEEL DOWELS THROUGH EVERY EXPANSION JOINT SPACED AT 1'-6" ON CENTER (MIN.) GREASED AND WRAPPED ON ONE SIDE, OFFSET 6" FROM CONCRETE EDGES, UNLESS OTHERWISE SHOWN OR SPECIFIED. MINIMUM THREE DOWELS IN 5' WIDE SIDEWALK.
- SIDEWALK CONSTRUCTION SHALL CONFORM TO SECTION 73, STANDARD SPECIFICATIONS, CALIFORNIA DEPARTMENT OF TRANSPORTATION (CALTRANS), EXCEPT AS MODIFIED HEREIN.
- SUBGRADE FOR SIDEWALK SHALL BE SCARIFIED AND COMPACTED TO A MINIMUM RELATIVE COMPACTION OF 90% TO A DEPTH OF 6". PLACE 4" MINIMUM OF AGGREGATE SUBBASE CLASS II OR IV UNDER THE CONCRETE SECTIONS AND COMPACT TO A MINIMUM OF 90%.
- SUBGRADE FOR CURB, GUTTER, AND DRIVEWAYS SHALL BE SCARIFIED AND COMPACTED TO A MINIMUM RELATIVE COMPACTION OF 95% TO A DEPTH OF 6", BASE FOR CURB, GUTTER, AND DRIVEWAYS TO BE AS ONLY.
- ALL RADI FOR ROUNDING EDGES SHALL BE 3/4" UNLESS NOTED.
- CONCRETE SHALL BE PER SECTION 90. MINOR CONCRETE PER SPECIFICATION.
- EXPANSION JOINTS AND WEAKENED PLANE JOINTS SHALL BE INSTALLED AS INDICATED ON THE PLANS OR STANDARD DETAILS.
- DEPRESS A 2" HIGH LETTER "W", "S", OR "I" FOR IRRIGATION SLEEVE LOCATION, 1/4" DEEP INTO THE TOP OF CURB TO IDENTIFY SERVICE LOCATIONS.
- WATER SHALL BE USED TO ENSURE PROPER DRAINAGE OF GUTTERS AT BOTH THE FINAL WALKTHROUGH AND PRIOR TO THE EXPIRATION OF THE ONE-YEAR WARRANTY.
- 3-5/8" X 24" LONG STEEL DOWELS MINIMUM THROUGH EVERY EXPANSION JOINT.
- 2-5/8" X 24" LONG STEEL DOWELS MINIMUM THROUGH EVERY EXPANSION JOINT.
- IN AN EXISTING STREET, WHENEVER THE CURB AND GUTTER ARE REMOVED, SAWCUT EXISTING STREET 1" OUT FROM LIP OF GUTTER MIN. & REPLACE WITH 8" OF ASPHALT CONCRETE, MIN. MATCHING EXISTING SECTION.


NOTES APPLY TO CITY DETAILS ONLY (I.E. R-52)

| CONCRETE CURB, GUTTER & SIDEWALKS CONSTRUCTION STANDARDS | REVISION NO. 1  | APPROVED BY CITY ENGINEER: [Signature] |
|--|-----------------|--|
| CITY OF STOCKTON DEPARTMENT OF PUBLIC WORKS              | DATE 09/27/2016 | SUPERSEDES DWG. DATED 11/25/03         |
|  | NONE            | DRAWING NO. R-55                       |

C CONCRETE CURB, GUTTER & SIDEWALKS CONSTRUCTION STANDARDS NTS

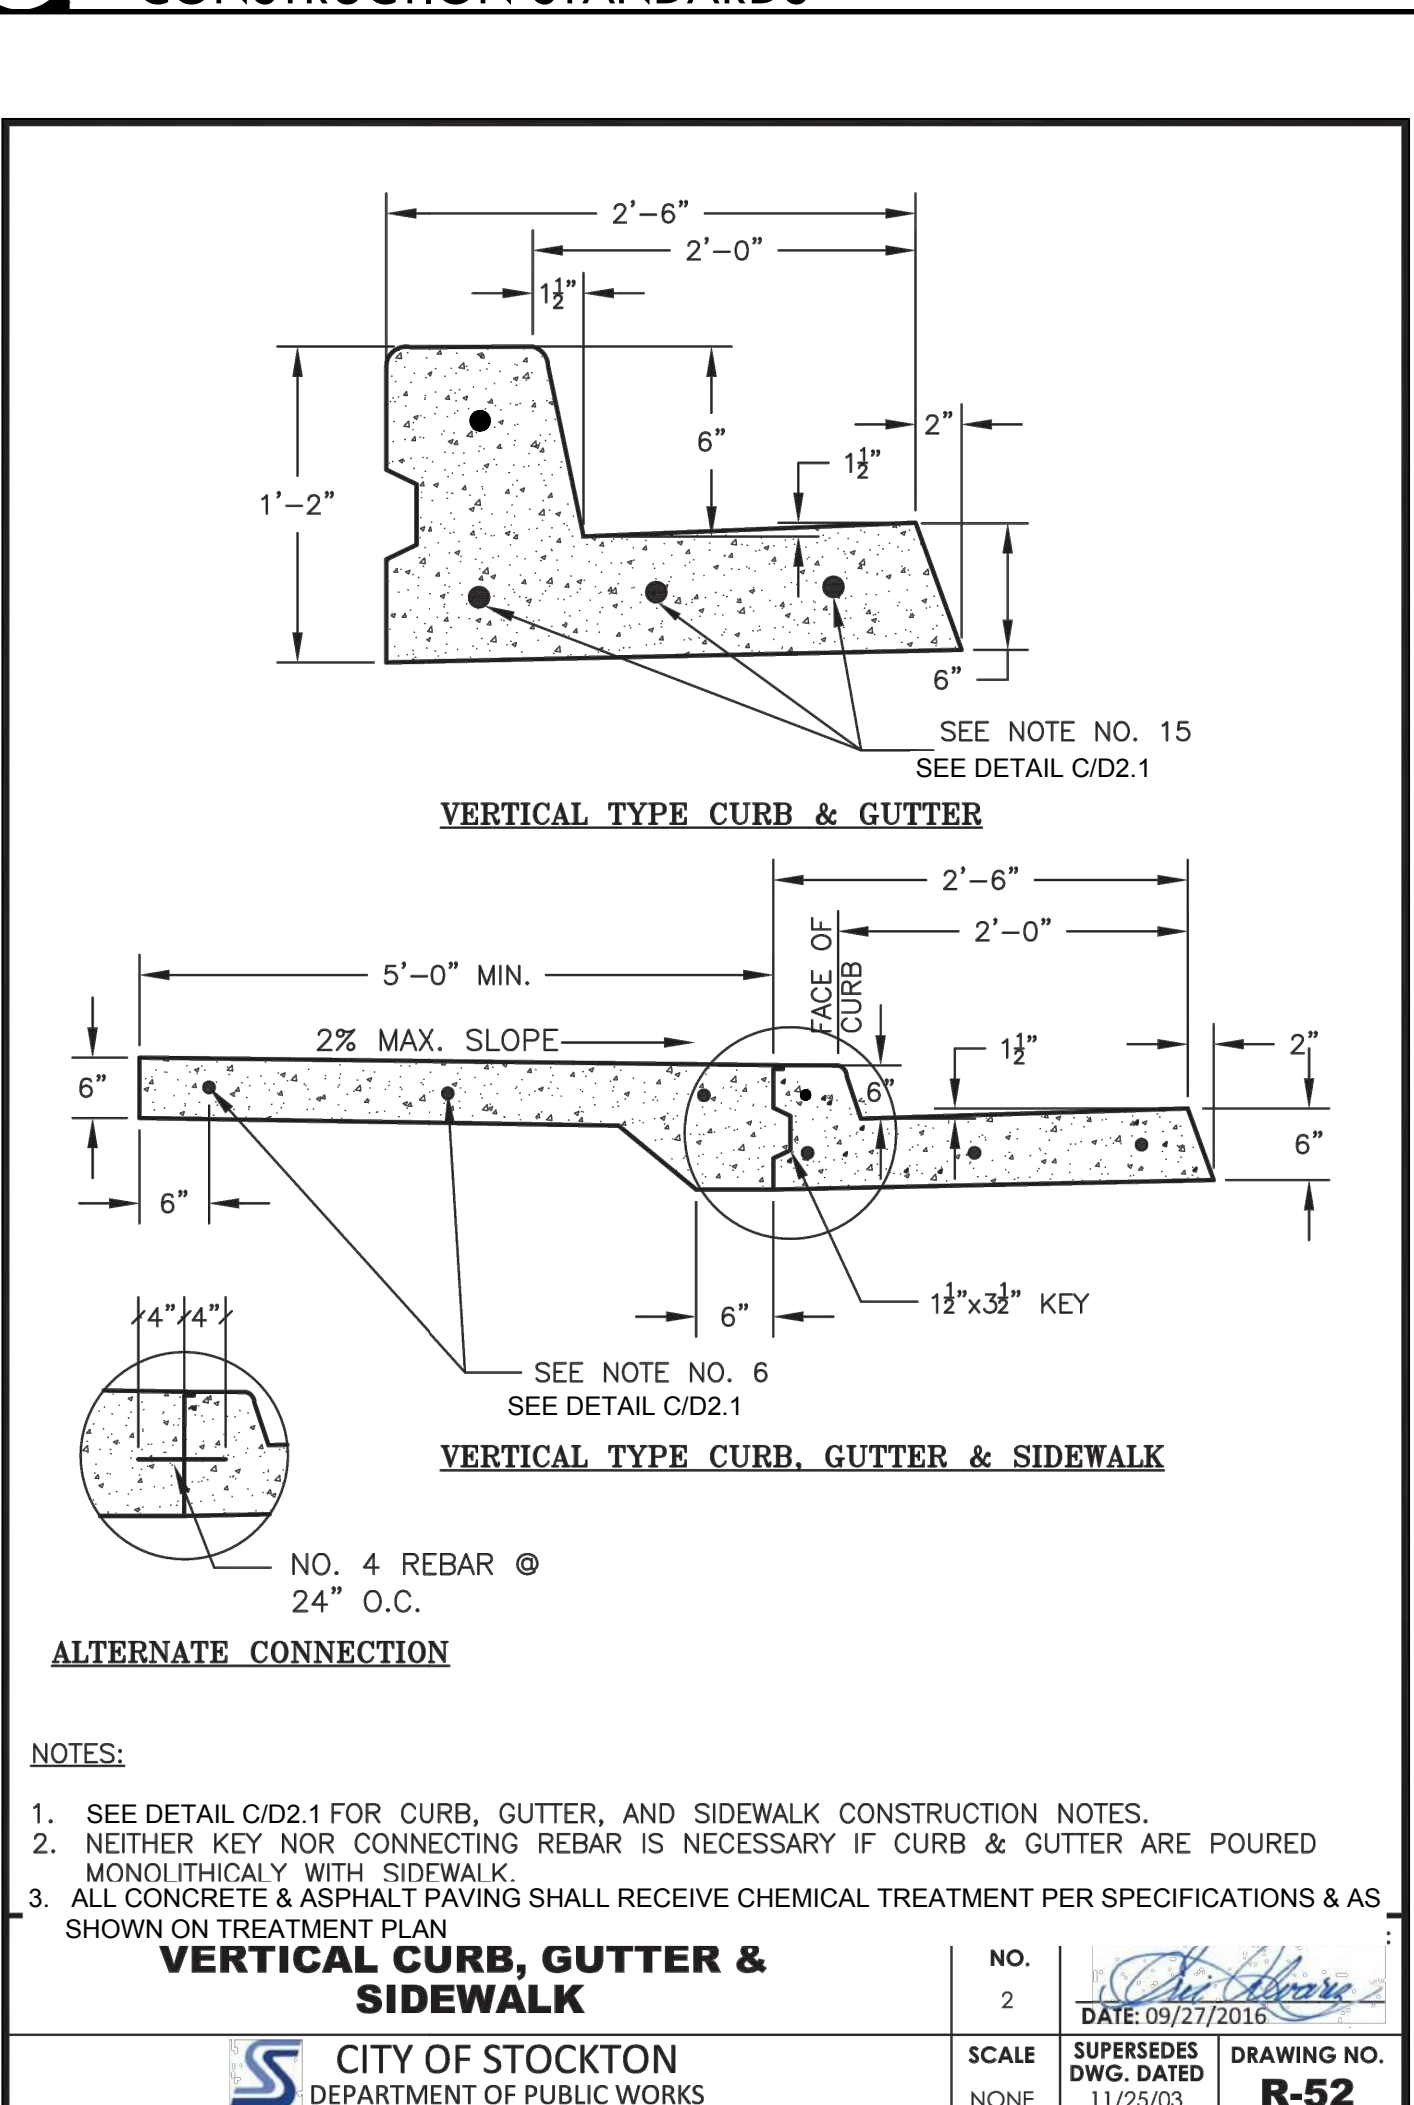

B VERTICAL CURB, GUTTER & SIDEWALK NTS

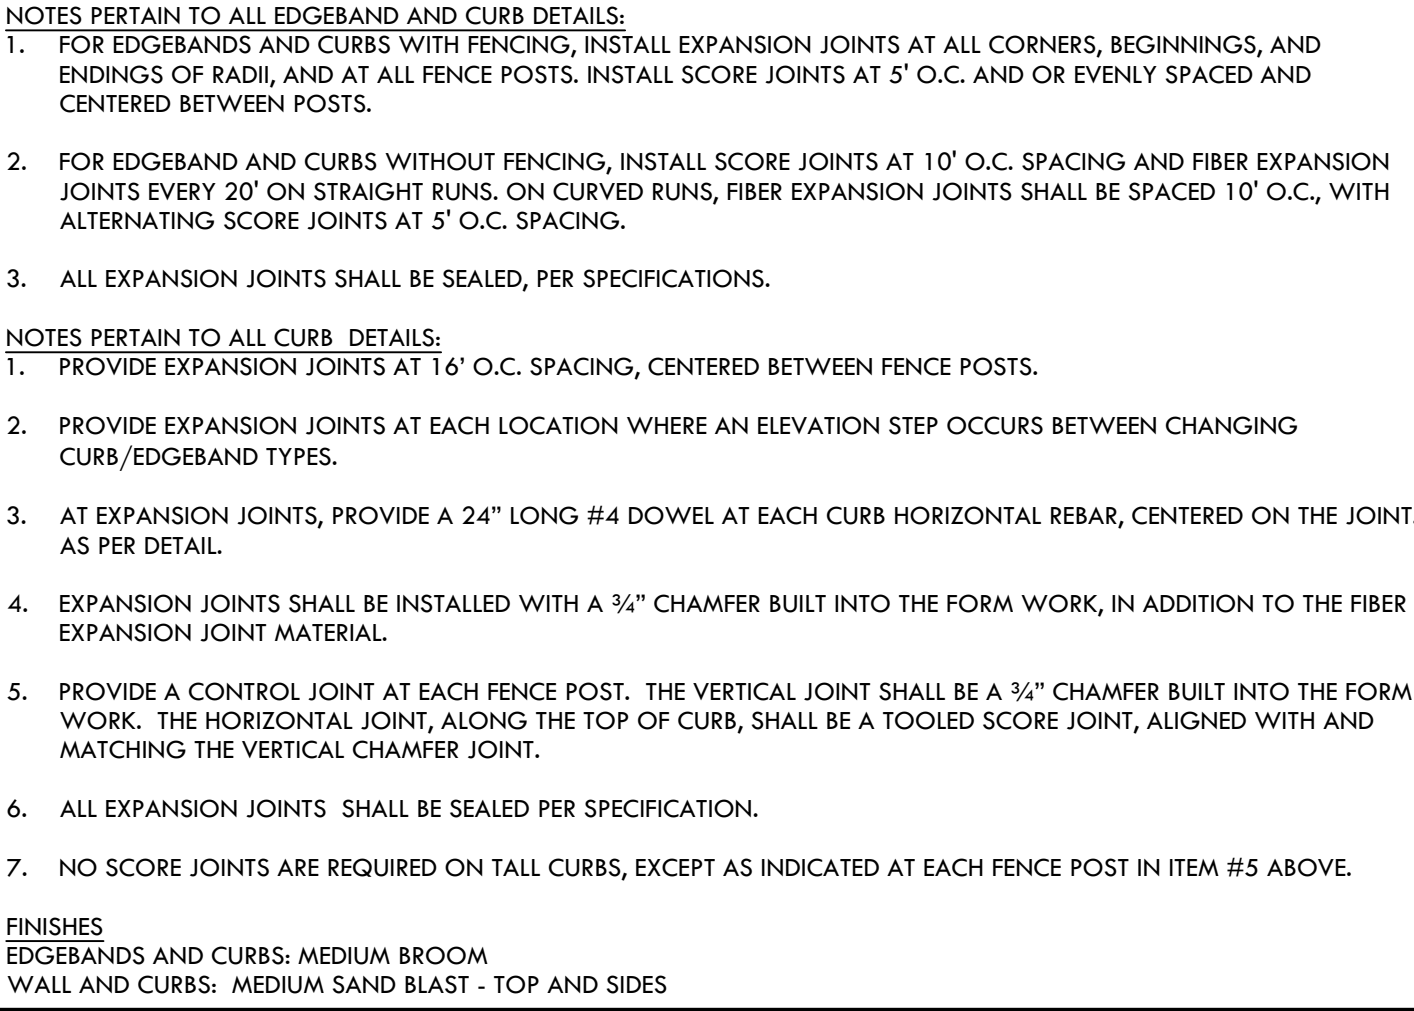

A EDGE BAND AND CURB NOTES NTS

IDENTIFICATION STAMP  
DIV. OF THE STATE ARCHITECT  
APP. 02-118017 INC.  
REVIEWED FOR  
SS ☒ FLS ☒ ACS ☒  
DATE: 04/10/2020

VERDE DESIGN  
LANDSCAPE ARCHITECTURE  
CIVIL ENGINEERING  
SPORT PLANNING & DESIGN  
1843 Iron Point Rd #140  
Folsom, CA 95630  
tel: 916.415.6554  
fax: 916.985.7260  
www.VerdeDesign.com

STAMP  
REGISTERED LANDSCAPE ARCHITECT  
MARK S. BARNES  
EXPIRATION DATE: JULY 2021  
STATE OF CALIFORNIA






CONSULTANT

KEYMAP

SHEET TITLE  
CONSTRUCTION DETAILS - HARDSCAPE

PROJECT NAME  
CHAVEZ HIGH SCHOOL STOCKTON USD ATHLETIC FACILITY IMPROVEMENTS

PROJECT ADDRESS  
2929 WINDFLOWER LN  
STOCKTON, CA 95212

| SUBMITTAL   |           | DATE             |
|---|-----------|------------------|
| DD/50% SUBMITTAL  |           | 10/25/19         |
| DSA SUBMITTAL   |           | 12/20/19         |
| DSA BACKCHECK SUBMITTAL   |           | 03/27/20         |
|   |           |                  |
|   |           |                  |
| NO.   | REVISIONS | DATE             |
|  |           |                  |
|  |           |                  |
| DRAWN BY<br>VDI   |           | CHECKED BY<br>CS |
| DATE ISSUED<br>03/27/20   |           | SCALE            |
| PROJ. NO.<br>1910900-1211   |           |                  |
| SHEET NO.<br>D2.1   |           |                  |



ALL DESIGN, DRAWING, AND CONSTRUCTION DETAILS ARE THE PROPERTY OF VERDE DESIGN, INC. AND WILL BE USED, REPRODUCED, OR PUBLISHED BY ANY METHOD, IN WHOLE OR IN PART, OR DISCLOSED TO ANY PERSON, FIRM, OR CORPORATION FOR ANY PURPOSE WITHOUT THE WRITTEN PERMISSION OF VERDE DESIGN, INC.

M

L

K


J

I

H


G

F

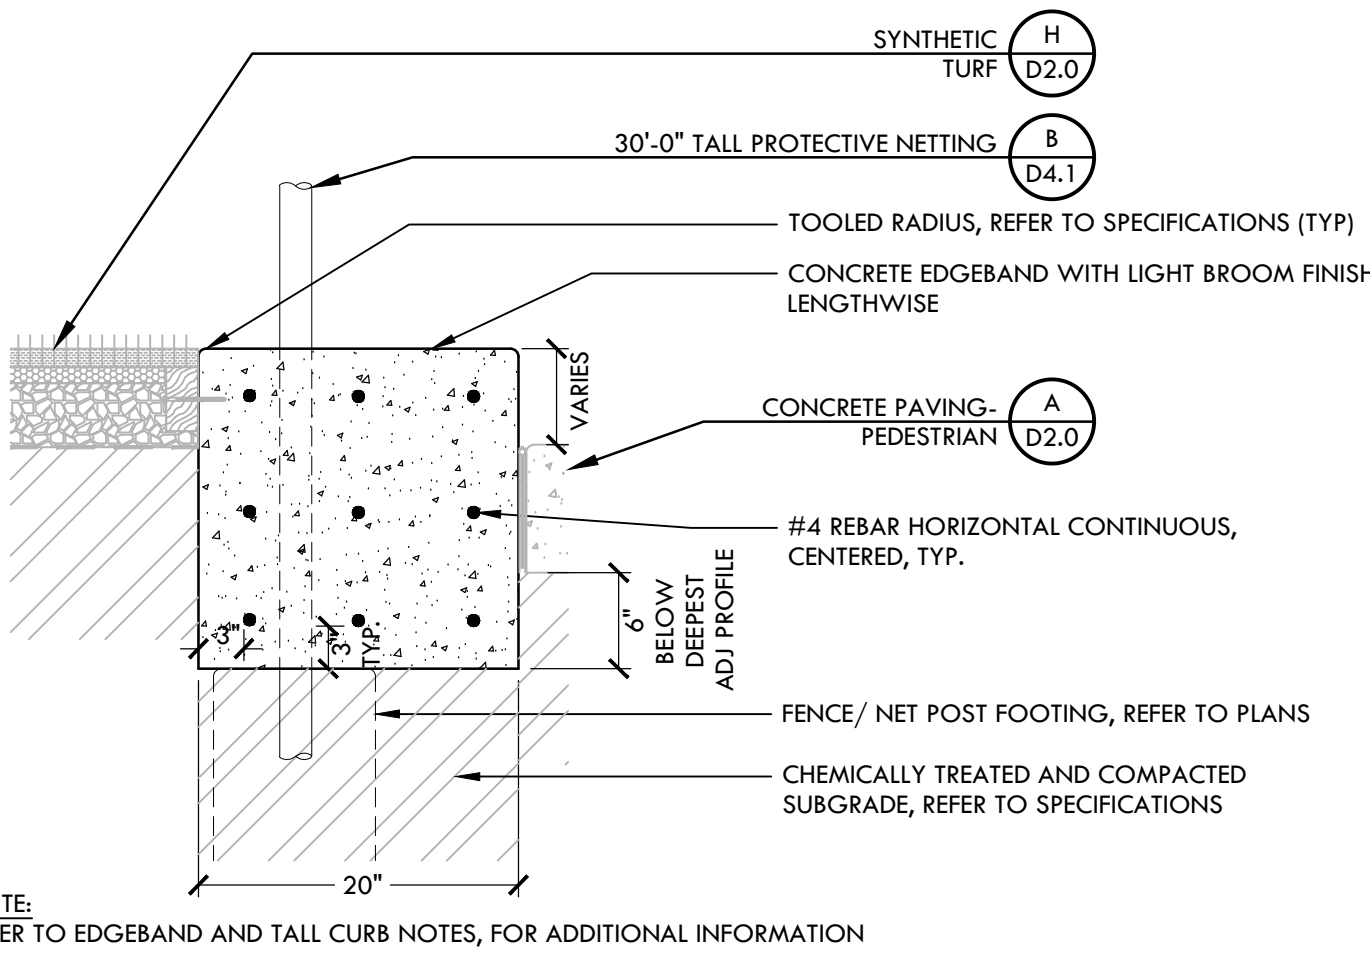


20" CURB WITH FENCE

NTS

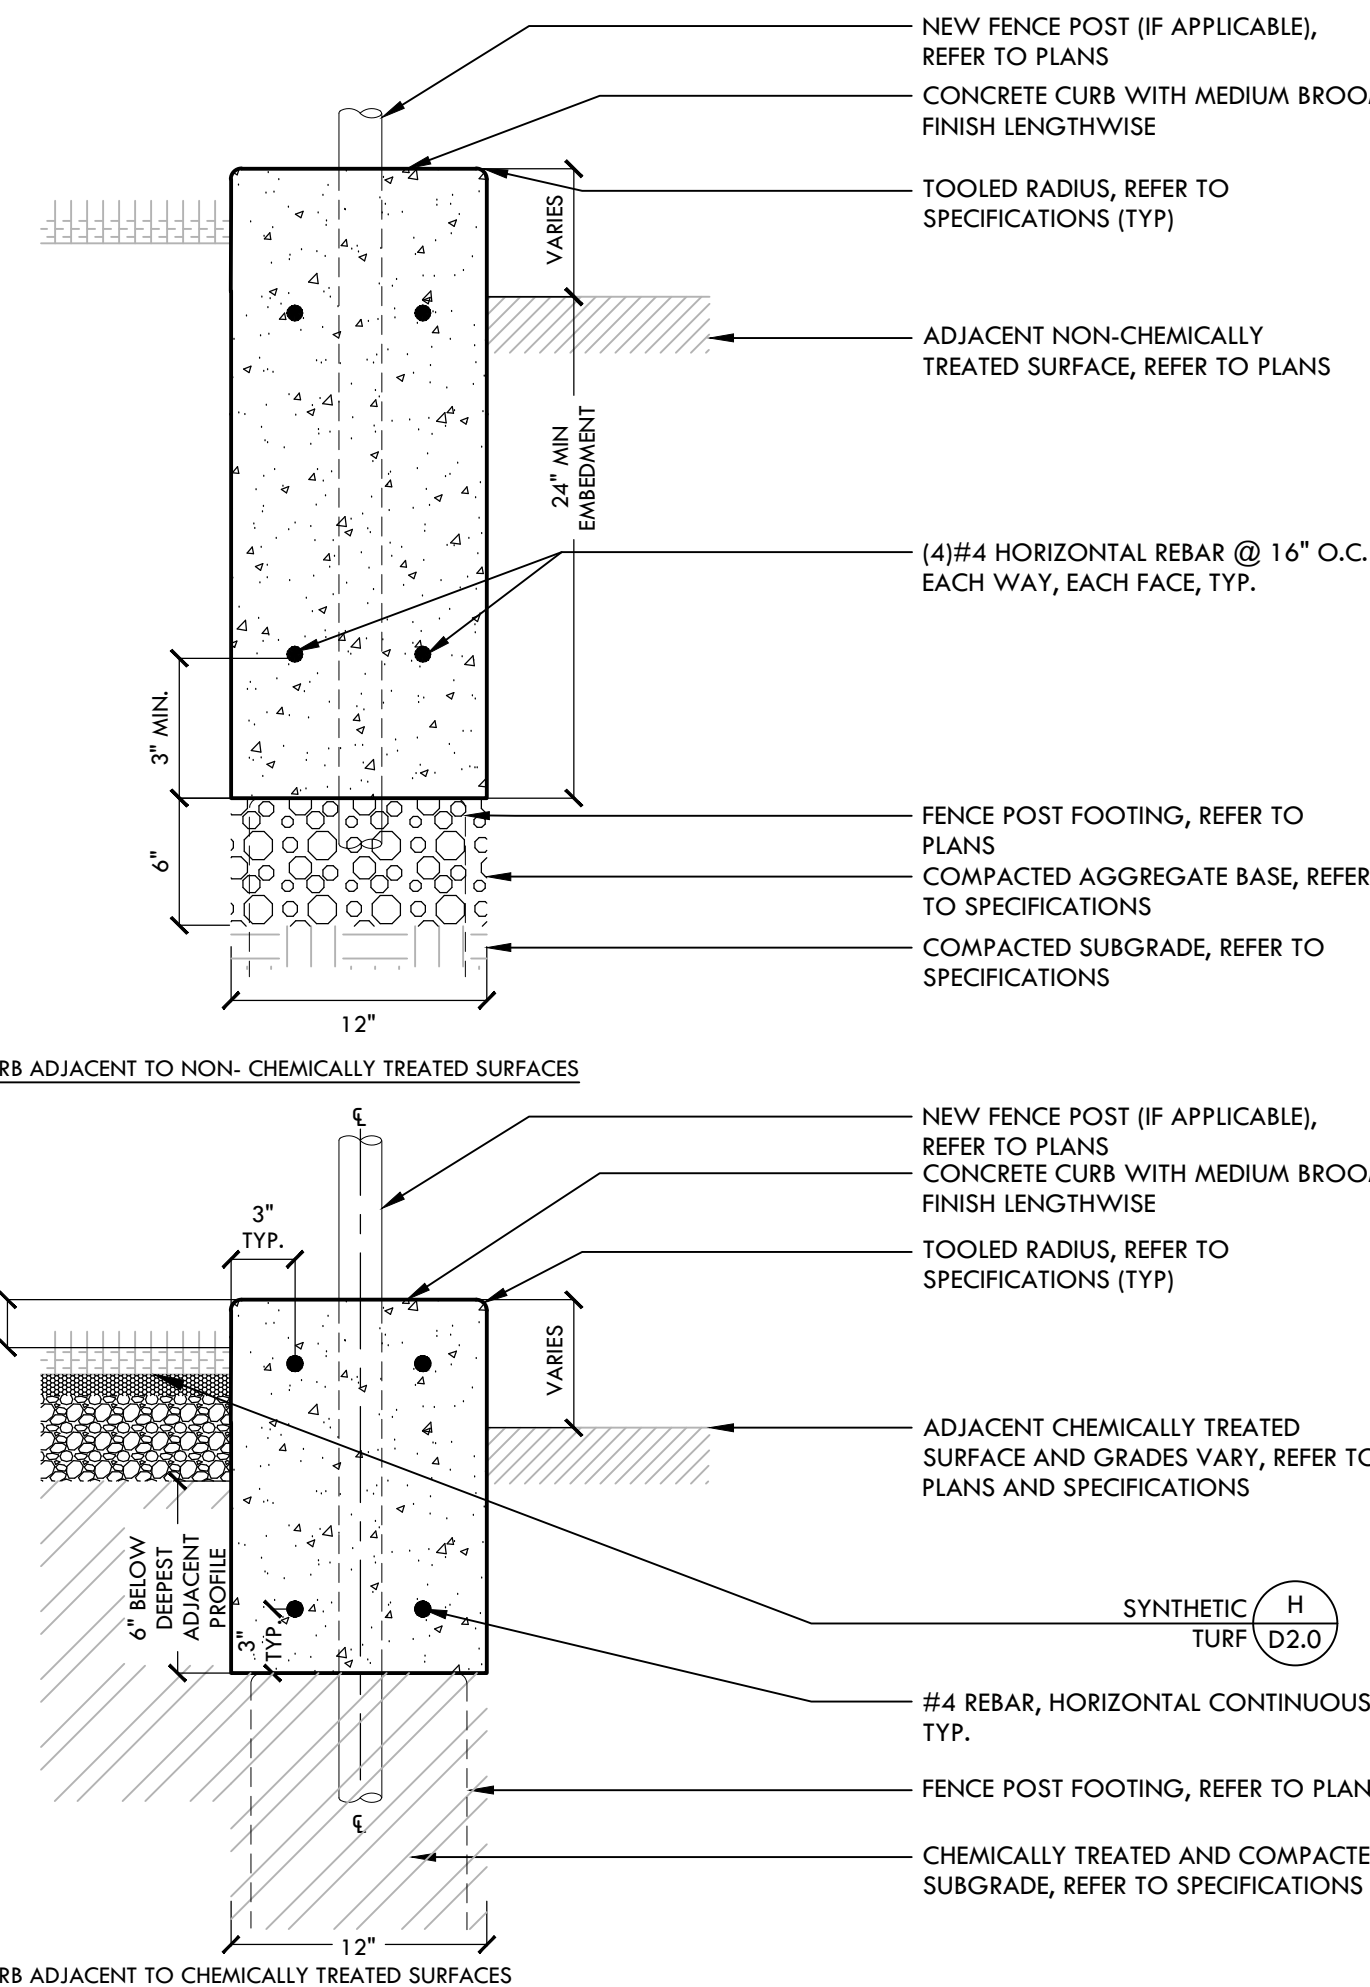


12" CURB WITH FENCE

NTS

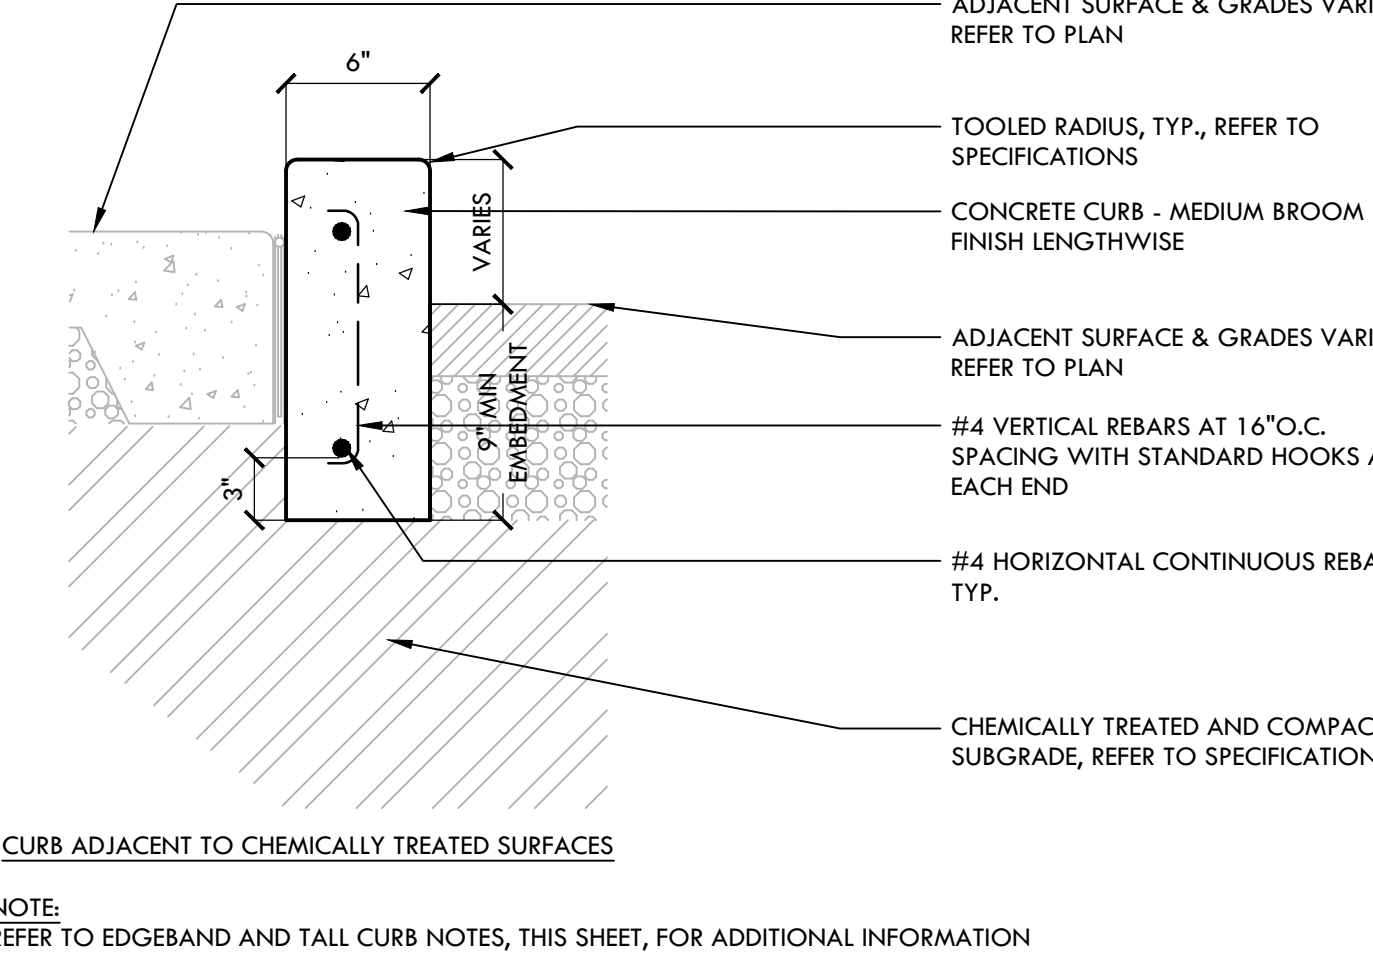

6" CURB


NTS

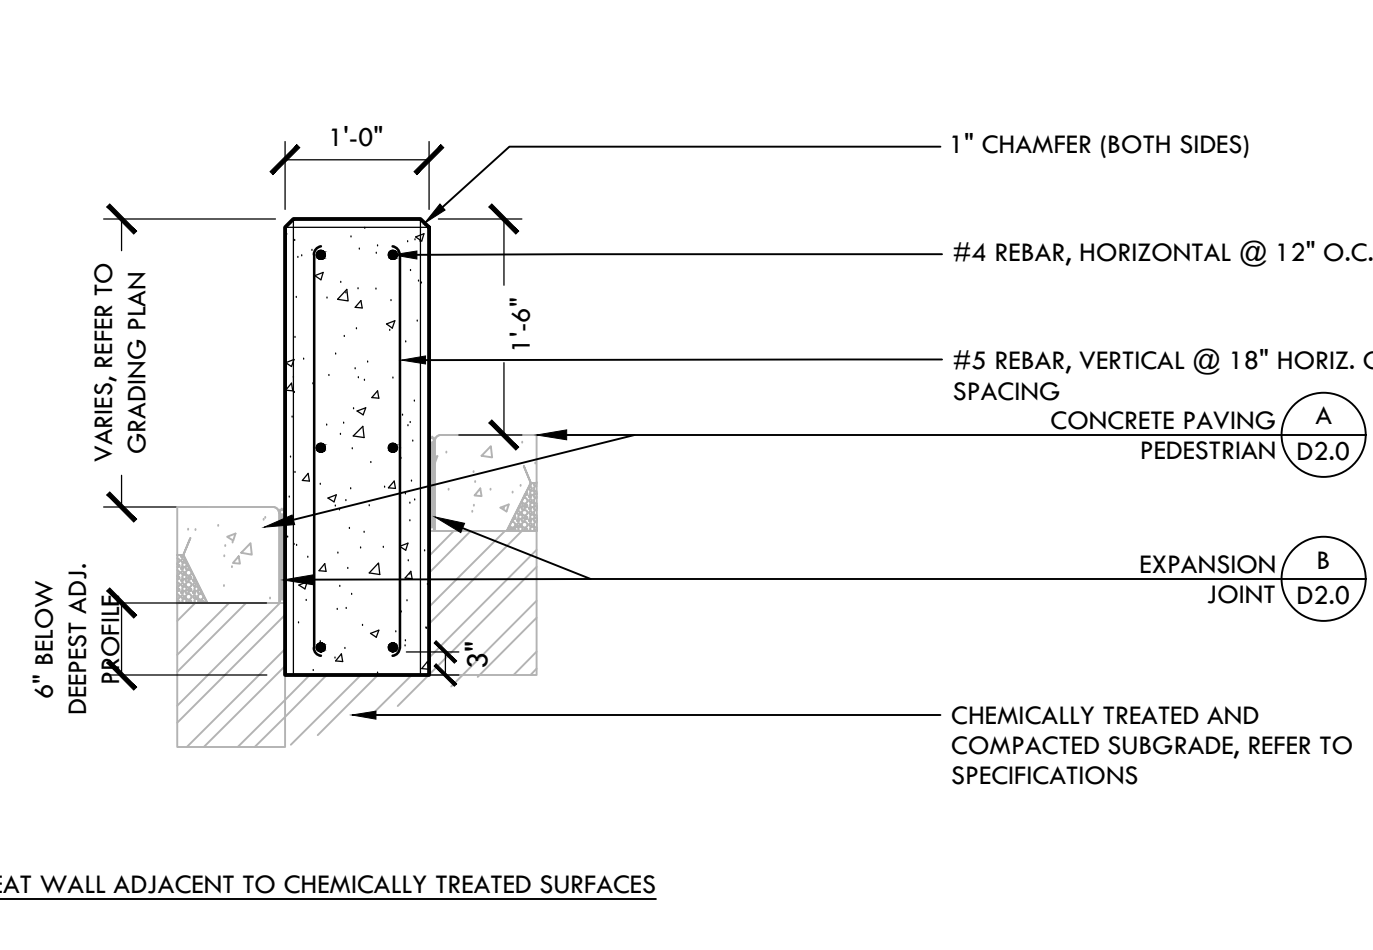

SEAT WALL


NTS

DISCUS CAGE AND PAD

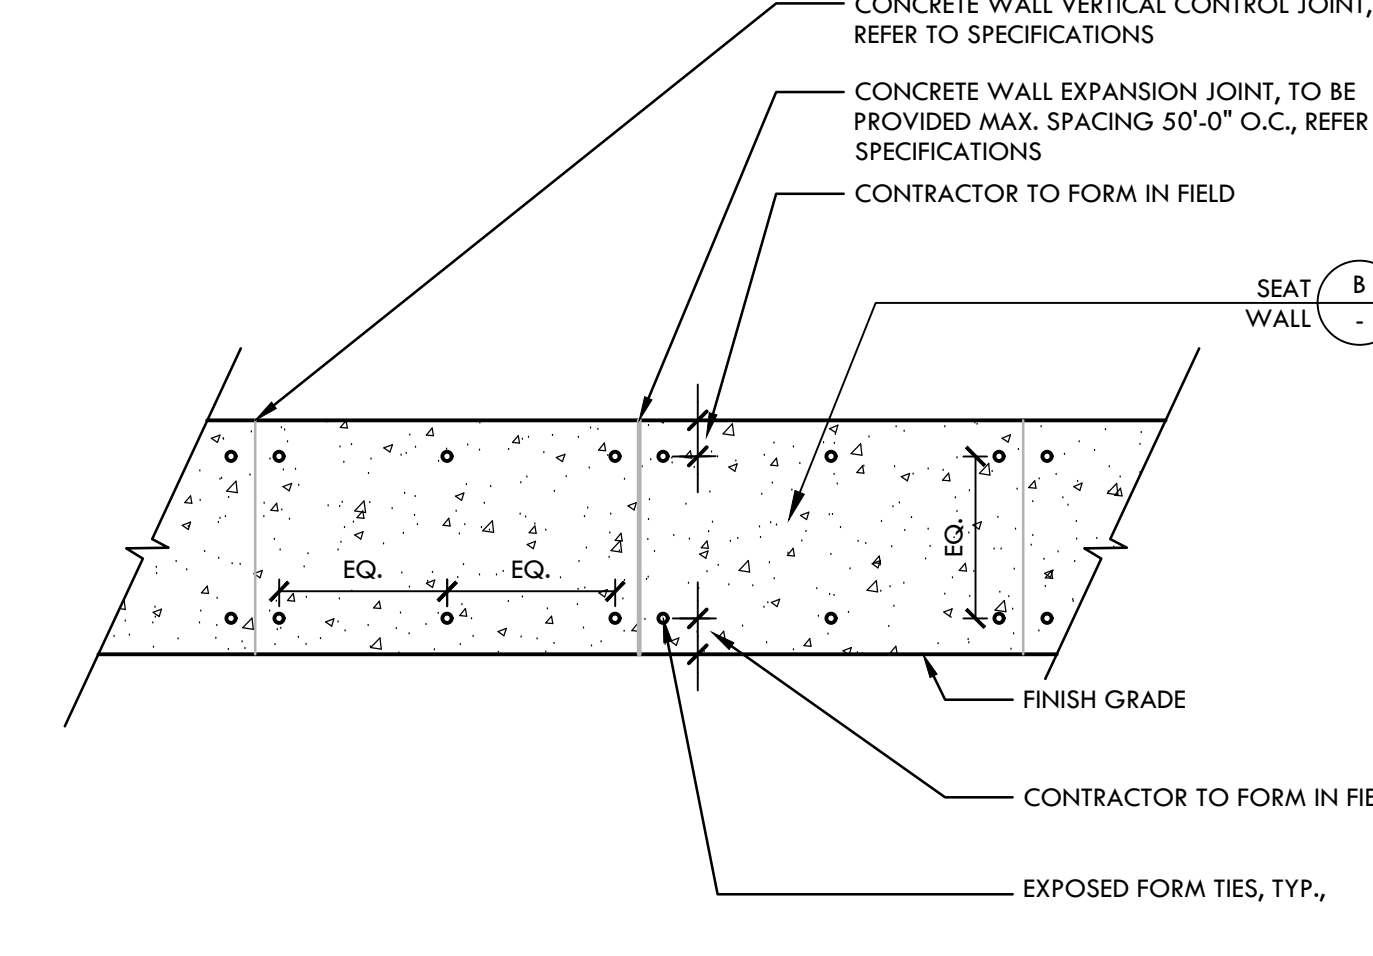

20" EDGEBAND WITH FENCE

NTS

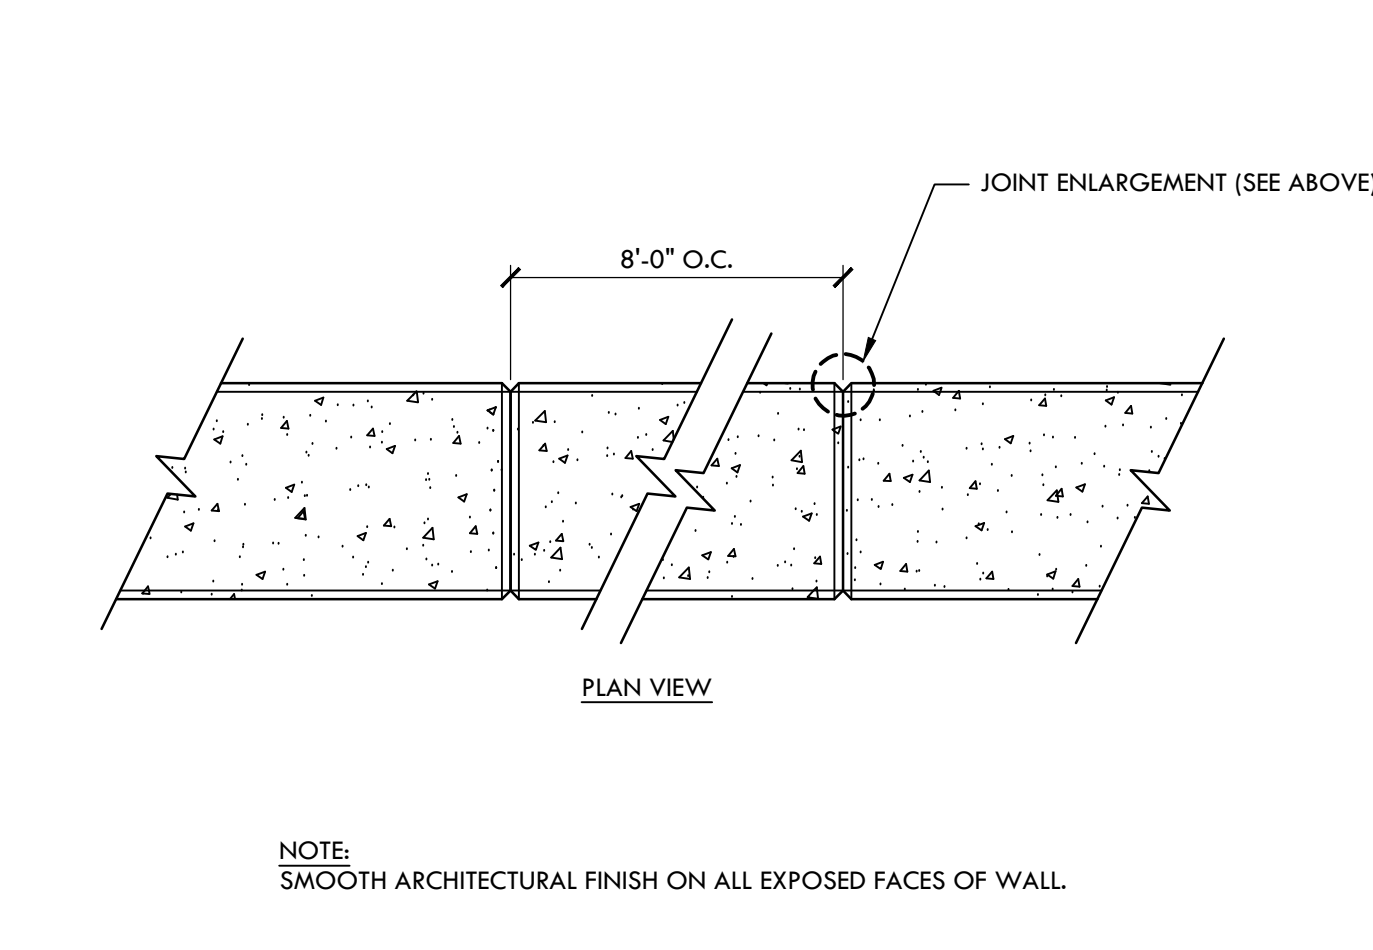

CONCRETE WALL FORM TIES

NTS

CONCRETE WALL FORM TIES

NTS

IDENTIFICATION STAMP  
DIV. OF THE STATE ARCHITECT  
APP. 02-118017 INC.  
REVIEWED FOR  
SS ☐ FLS ☐ ACS ☐  
DATE: 04/10/2020

**VERDE DESIGN**  
LANDSCAPE ARCHITECTURE  
CIVIL ENGINEERING  
SPORT PLANNING & DESIGN  
1843 Iron Point Rd #140  
Folsom, CA 95630  
tel: 916.415.6554  
fax: 916.985.7260  
www.VerdeDesigninc.com

REGISTERED LANDSCAPE ARCHITECT  
MARK S. BARNES  
EXPIRATION DATE: JULY 2021  
STATE OF CALIFORNIA

CONSULTANT

KEYMAP

SHEET TITLE  
**CONSTRUCTION  
DETAILS -  
HARDSCAPE**

PROJECT NAME  
**CHAVEZ HIGH SCHOOL  
STOCKTON USD  
ATHLETIC FACILITY  
IMPROVEMENTS**

PROJECT ADDRESS  
**2929 WINDFLOWER LN  
STOCKTON, CA 95212**

SUBMITTAL

DD/50% SUBMITTAL

DSA SUBMITTAL

DSA BACKCHECK SUBMITTAL

NO. REVISIONS

DATE

DATE ISSUED

03/27/20

PROJ. NO.

1910900-1211


SHEET NO.

D2.2

CONSTRUCTION DETAILS - HARDSCAPE

OF 122



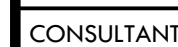

## PARKING AND ACCESSIBILITY DETAILS



ALL DESIGN, DRAWING, AND CONSTRUCTION SHALL BE THE PROPERTY OF VERDE DESIGN, INC. AND SHALL REMAIN THE PROPERTY OF VERDE DESIGN, INC. AND SHALL NOT BE REPRODUCED, COPIED, OR USED IN ANY MANNER WITHOUT THE WRITTEN PERMISSION OF VERDE DESIGN, INC. VERDE DESIGN, INC. IS NOT RESPONSIBLE FOR ANY DAMAGE OR INJURY TO ANY PERSON OR PROPERTY CAUSED BY THE USE OF ANY DESIGN, DRAWING, OR CONSTRUCTION PROVIDED BY VERDE DESIGN, INC. WITHOUT THE WRITTEN PERMISSION OF VERDE DESIGN, INC.

P

M

H

D

O

L

C

N

K

G

J

I

E

A

M

H

D

N

O

L

C

N

K

G

J

I

E

A

M

H

D

N

O

L

C

N

K

G

J

I

E

A

M

H

D

N

O

L

C

N

K

G

J

I

E

A

M

H

D

N

O

L

C

N

K

G

J

I

E

A

M

H

D

N

O

L

C

N

K

G

J

I

E

A

M

H

D

N

O

L

C

N

K

G

J

I

E

A

M

H

D

N

O

L

C

N

K

G

J

I

E

A

M

H

D

N

O

L

C

N

K

G

J

I

E

A

M

H

D

N

O

L

C

N

K

G

J

I

E

A

M

H

D

N

O

L

C

N

K

G

J

I

E

A

M

H

D

N

O

L

C

N

K

G

J

I

E

A

M

H

D

N

O

L

C

N

K

G

J

I

E

A

M

H

D

N

O

L

C

N

K

G

J

I

E

A

M

H

D

N

O

L

C

N

K

G

J

I

E

A

M

H

D

N

O

L

C

N

K

G

J

I

E

A

M

H

D

N

O

L

C

N

K

G

J

I

E

A

M

H

D

N

O

L

C

N

K

G

J

I

E

A

M

H

D

N

O

L

C

N

K

G

J

I

E

A

M

H

D

N

O

L

C

N

K

G

J

I

E

A

M

H

D

N

O

L

C

N

K

G

J

I

E

A

M

H

D

N

O

L

C

N

K

G

J

I

E

A

M

H

D

N

O

L

C

N

K

G

J

I

E

A

M

H

D

N

O

L

C

N

K

G

J

I

E

A

M

H

D

N

O

L

C

N

K

G

J

I

E

A

M

H

D

N

O

L

C

N

K

G

J

I

E

A

M

H





D






| SUBMITTAL               | DATE     |
|-------------------------|----------|
| DD/50% SUBMITTAL        | 10/25/15 |
| DSA SUBMITTAL           | 12/20/15 |
| DSA BACKCHECK SUBMITTAL | 03/27/20 |

|   | NO. | REVISIONS | DATE |
|---|-----|-----------|------|
|   | △   |           |      |
|   | △   |           |      |
|   | △   |           |      |
| / | △   |           |      |
|   | △   |           |      |
| Δ | △   |           |      |


|                         |                   |
|-------------------------|-------------------|
| DRAWN BY<br>VDI         | CHECKED BY<br>CS  |
| DATE ISSUED<br>03/27/20 | SCALE<br>AS NOTED |

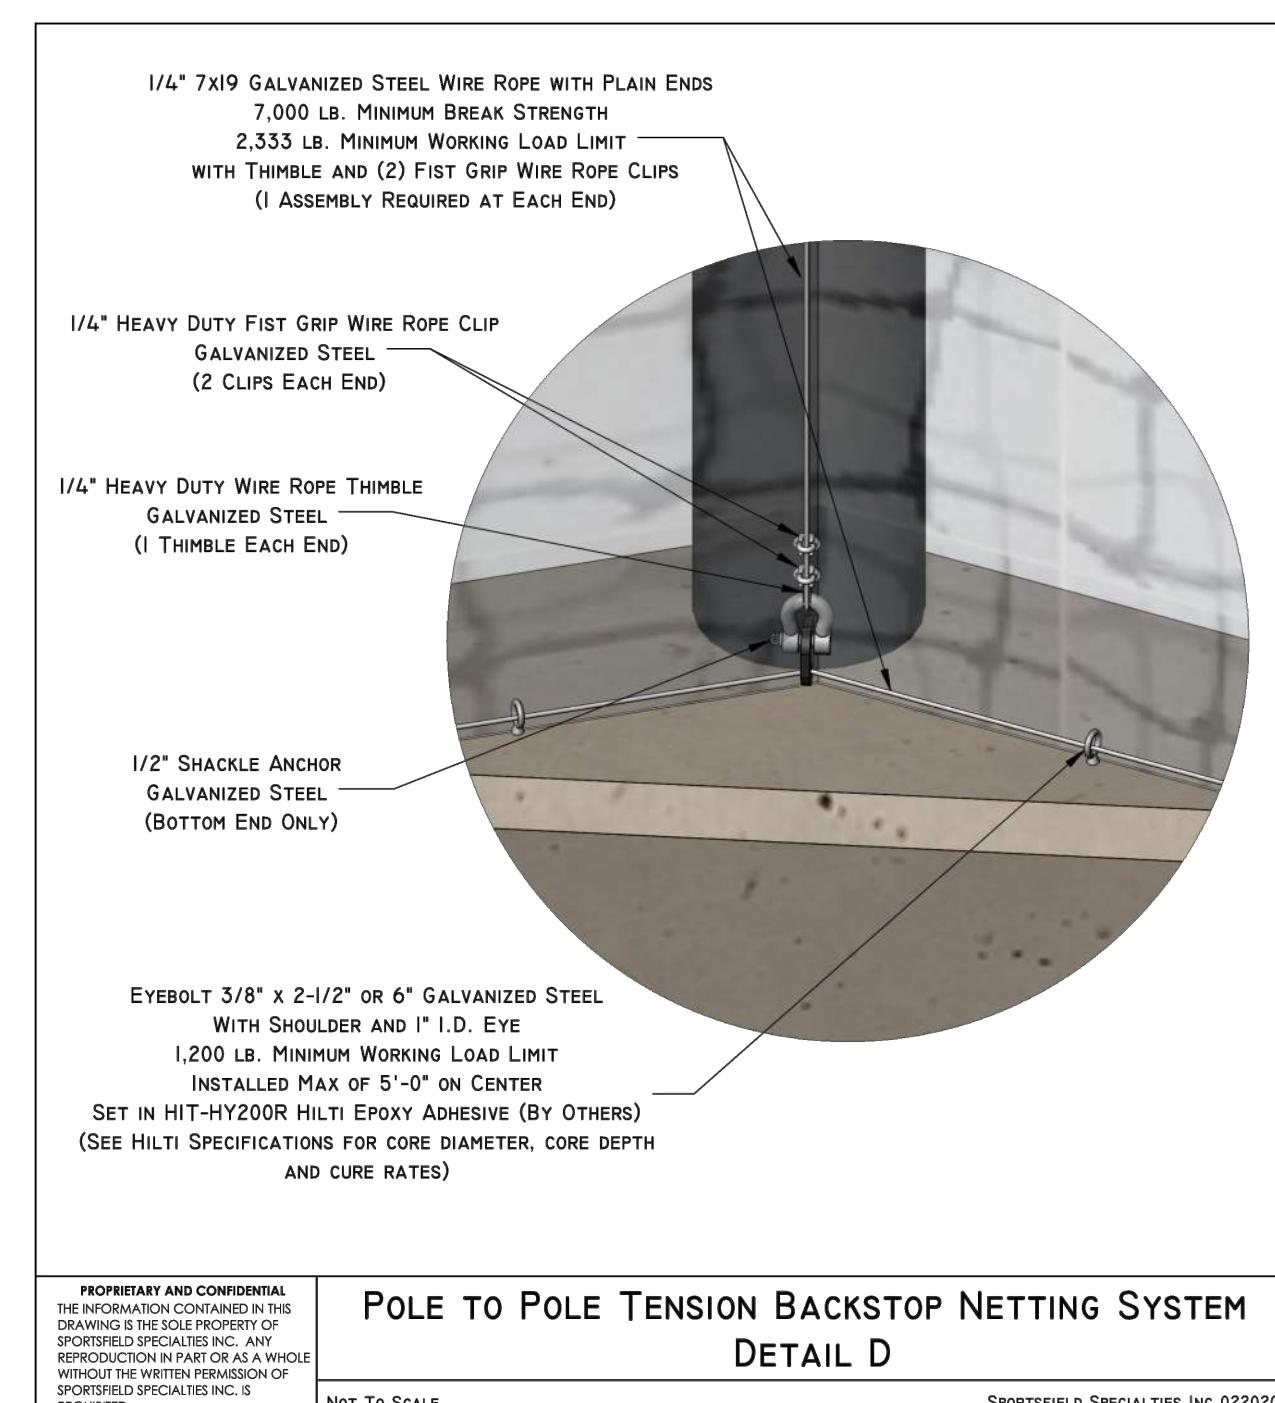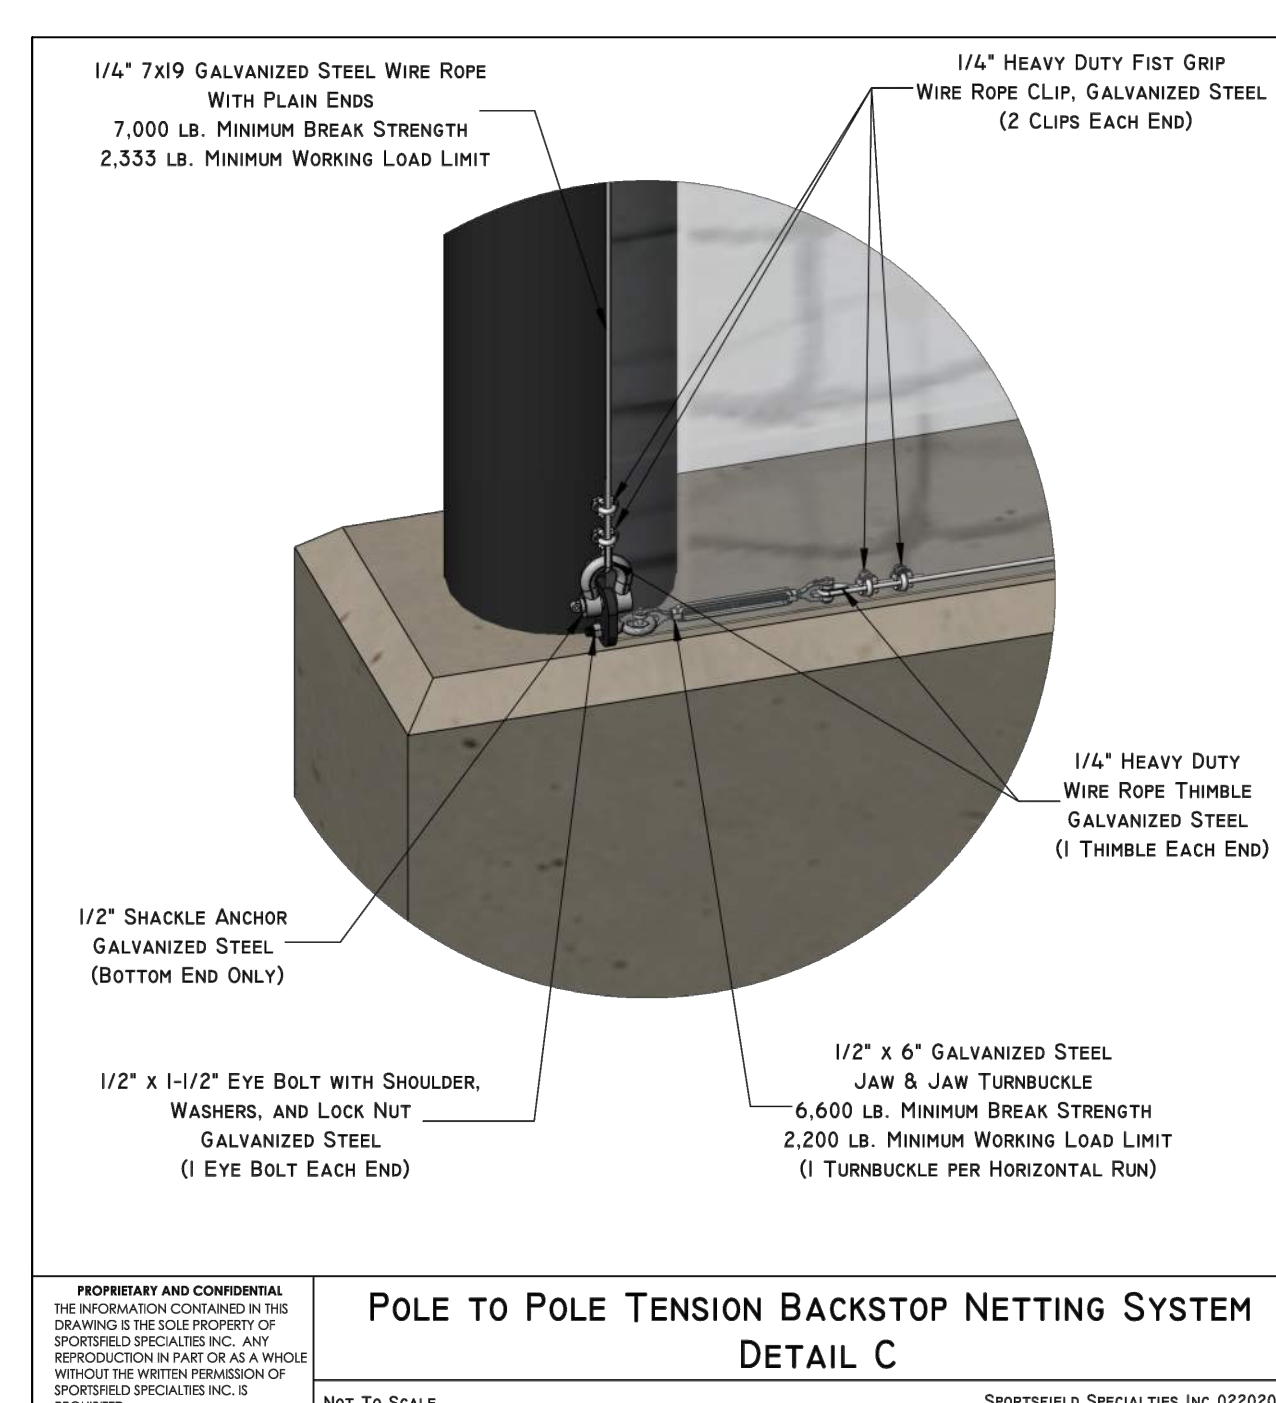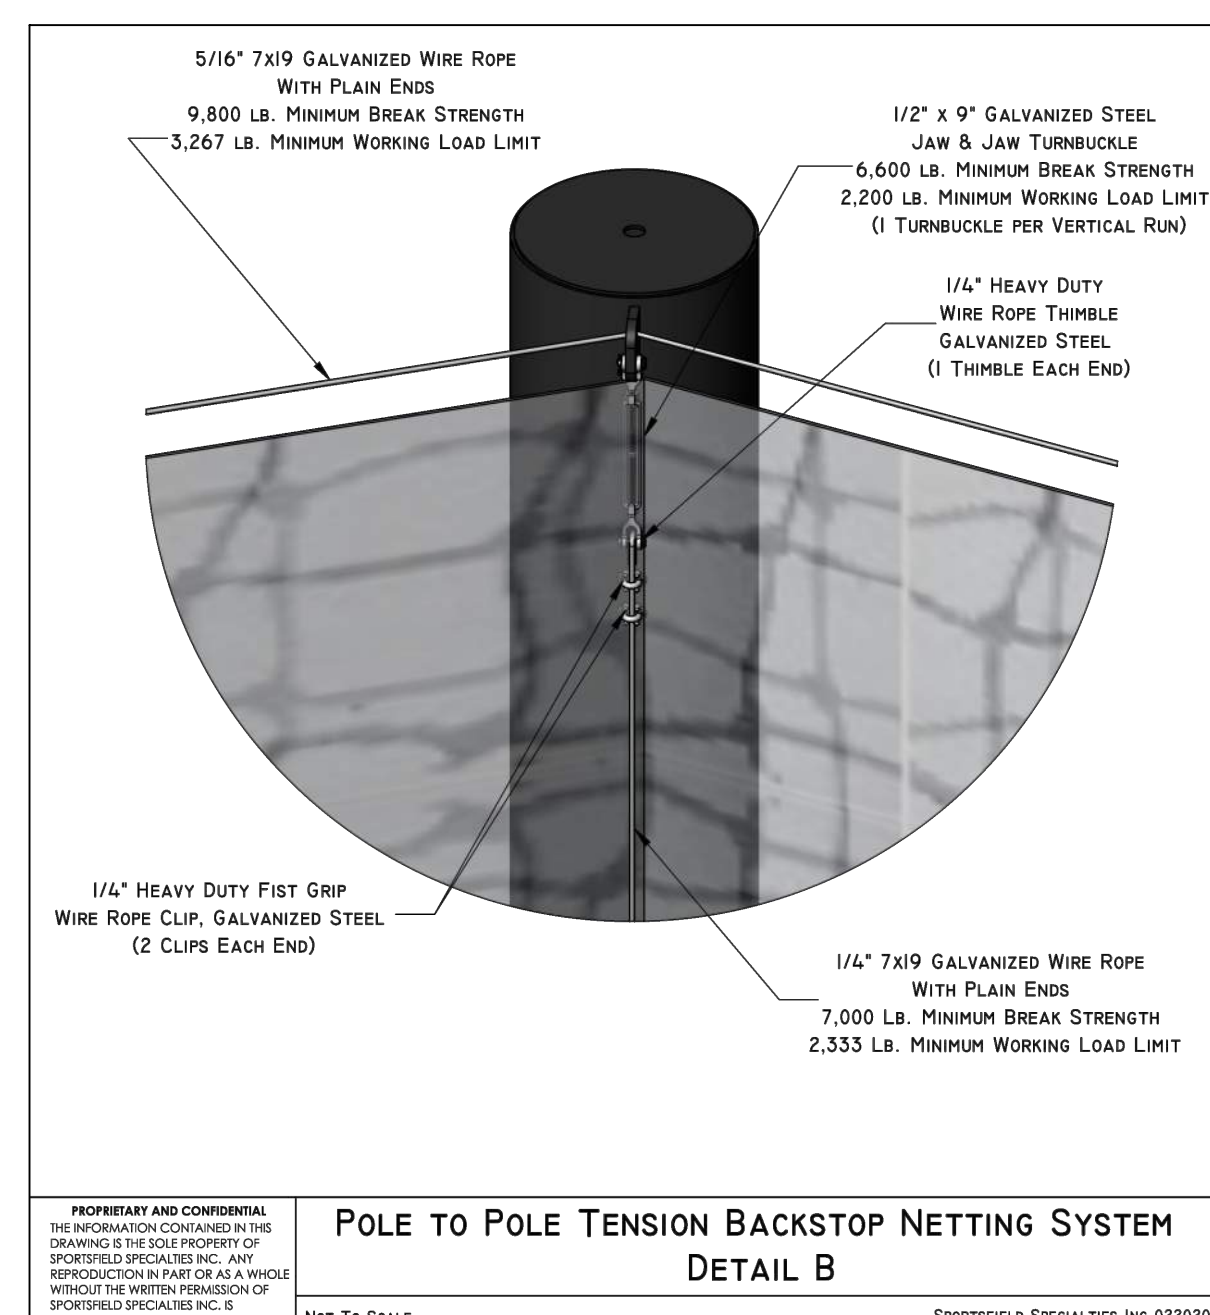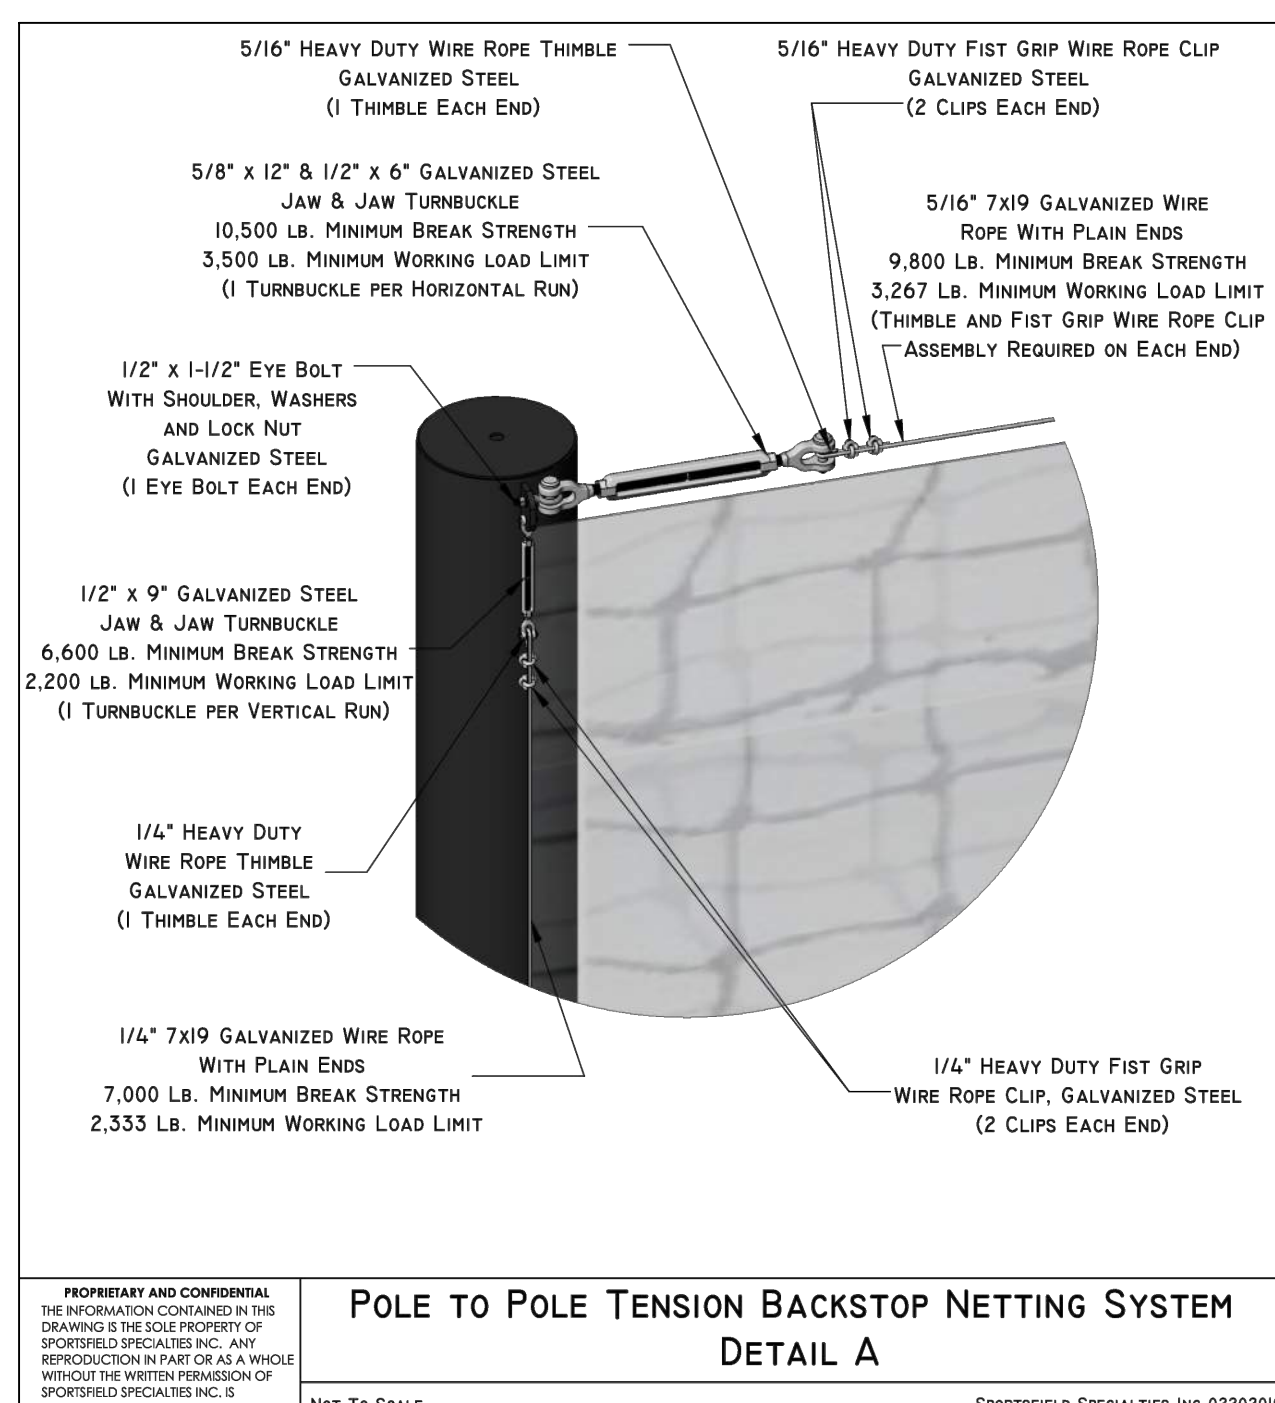


### E NETTING SYSTEM DETAIL

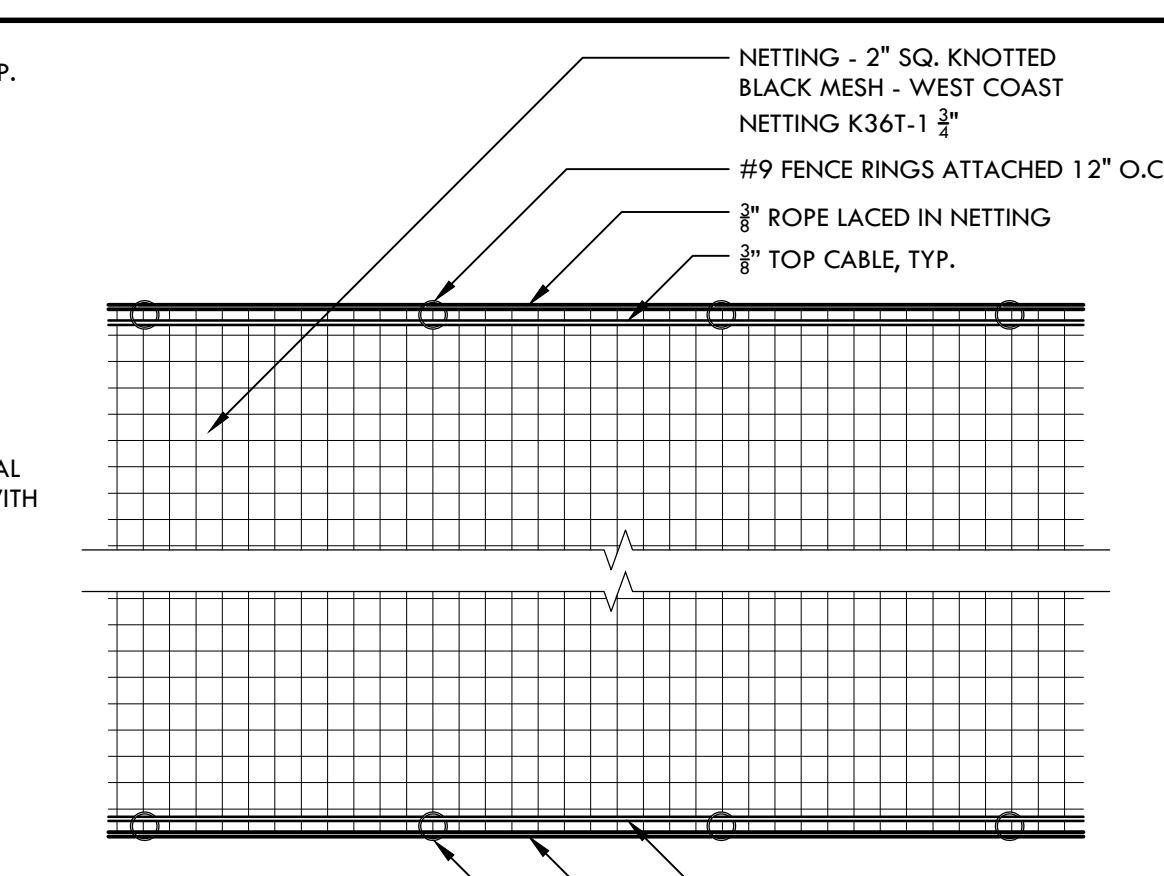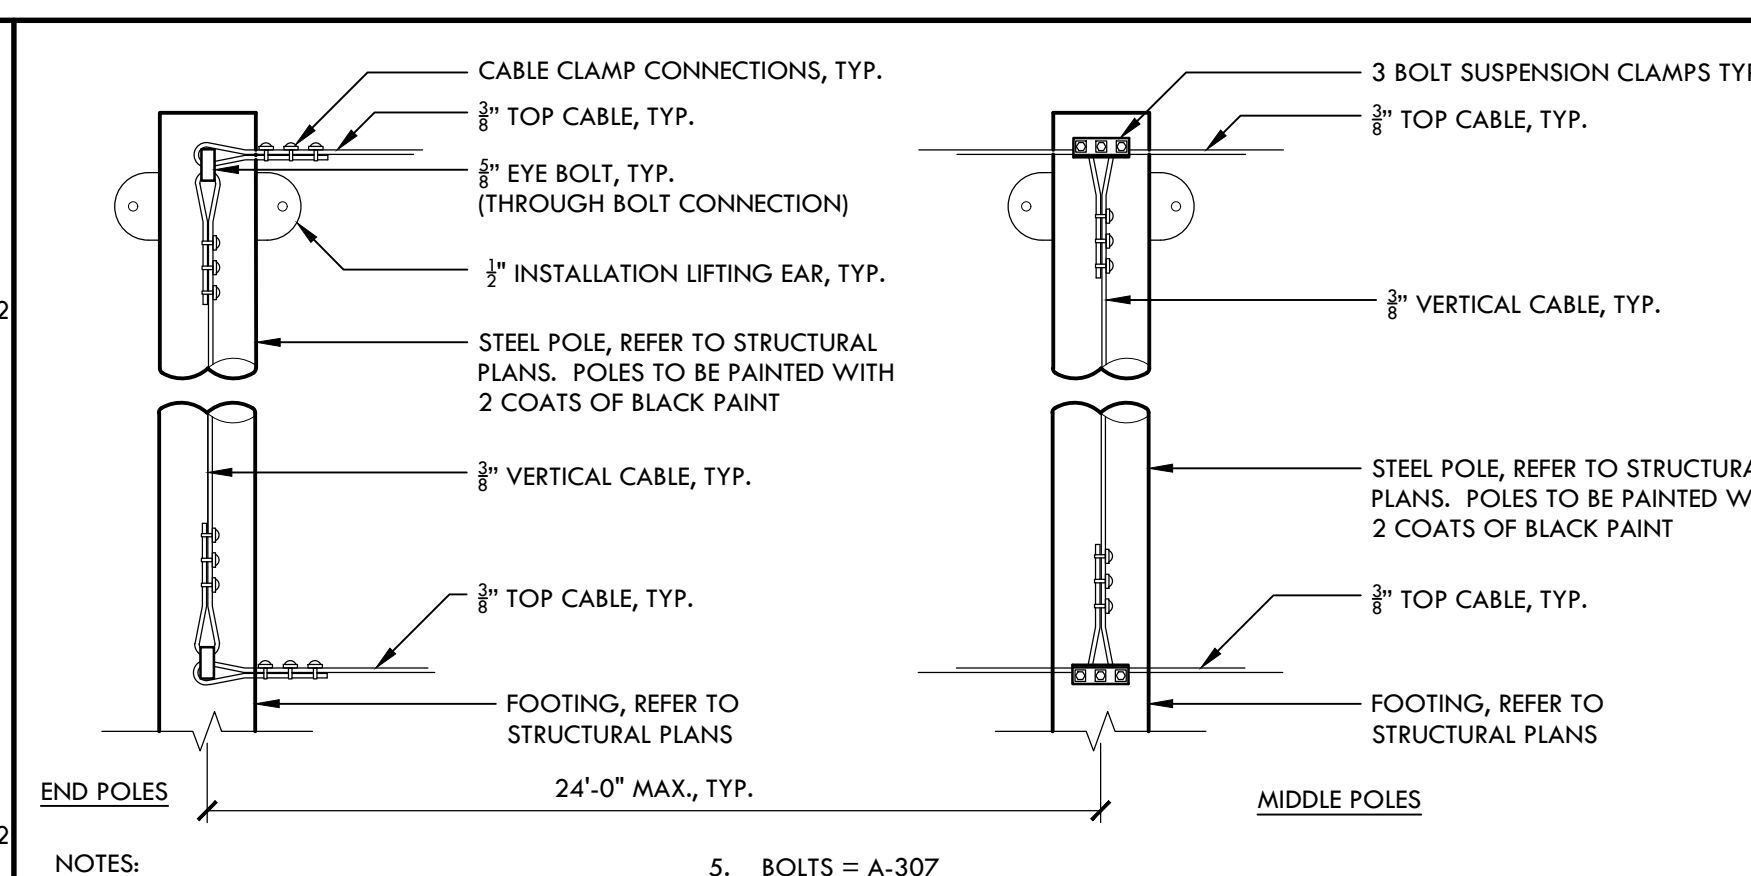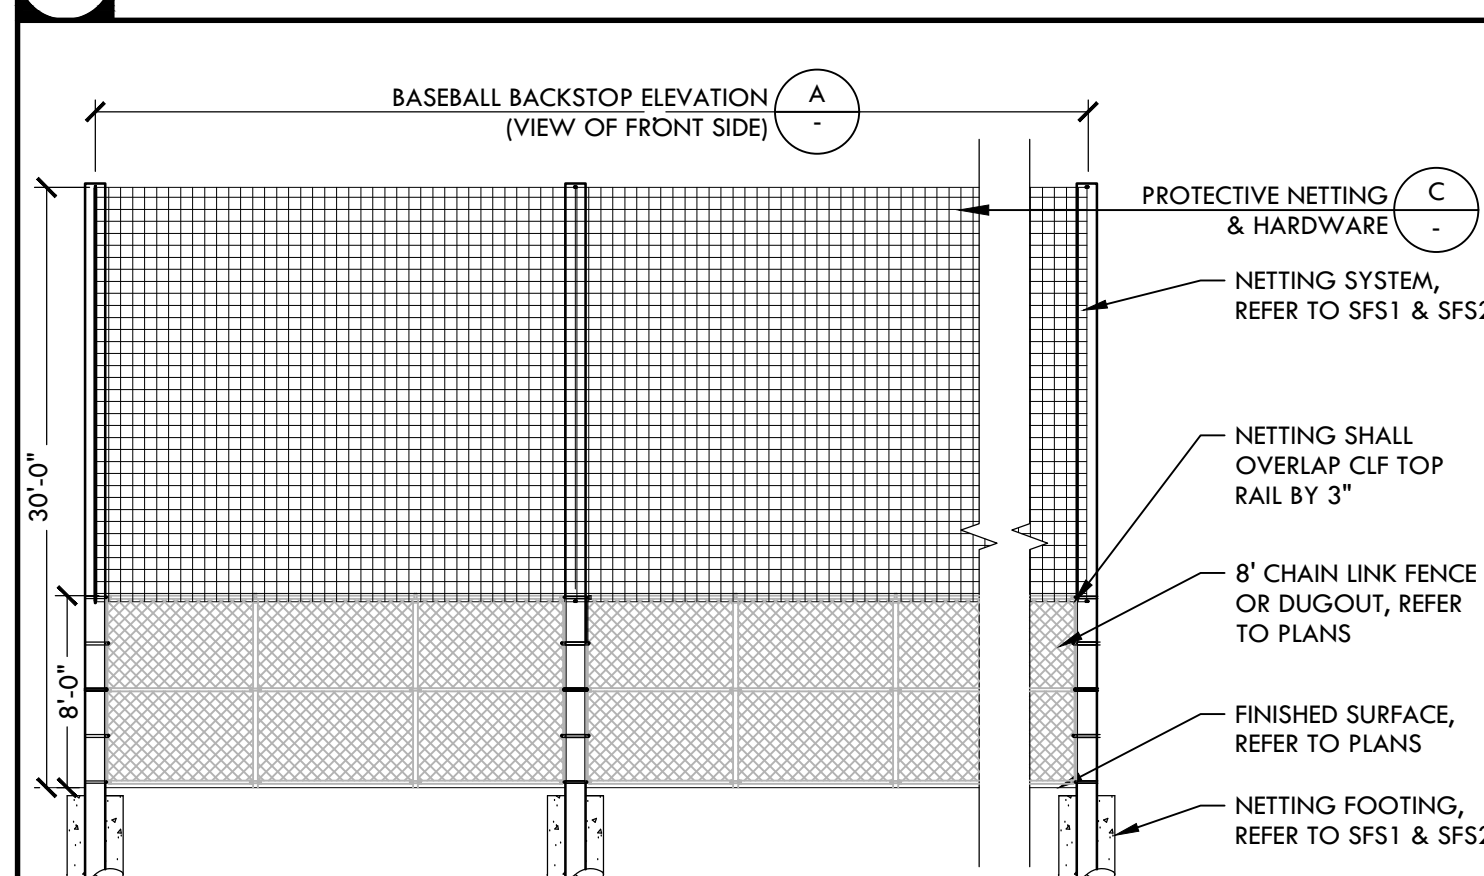


**B** 30'-0" TALL PROTECTIVE NETTING

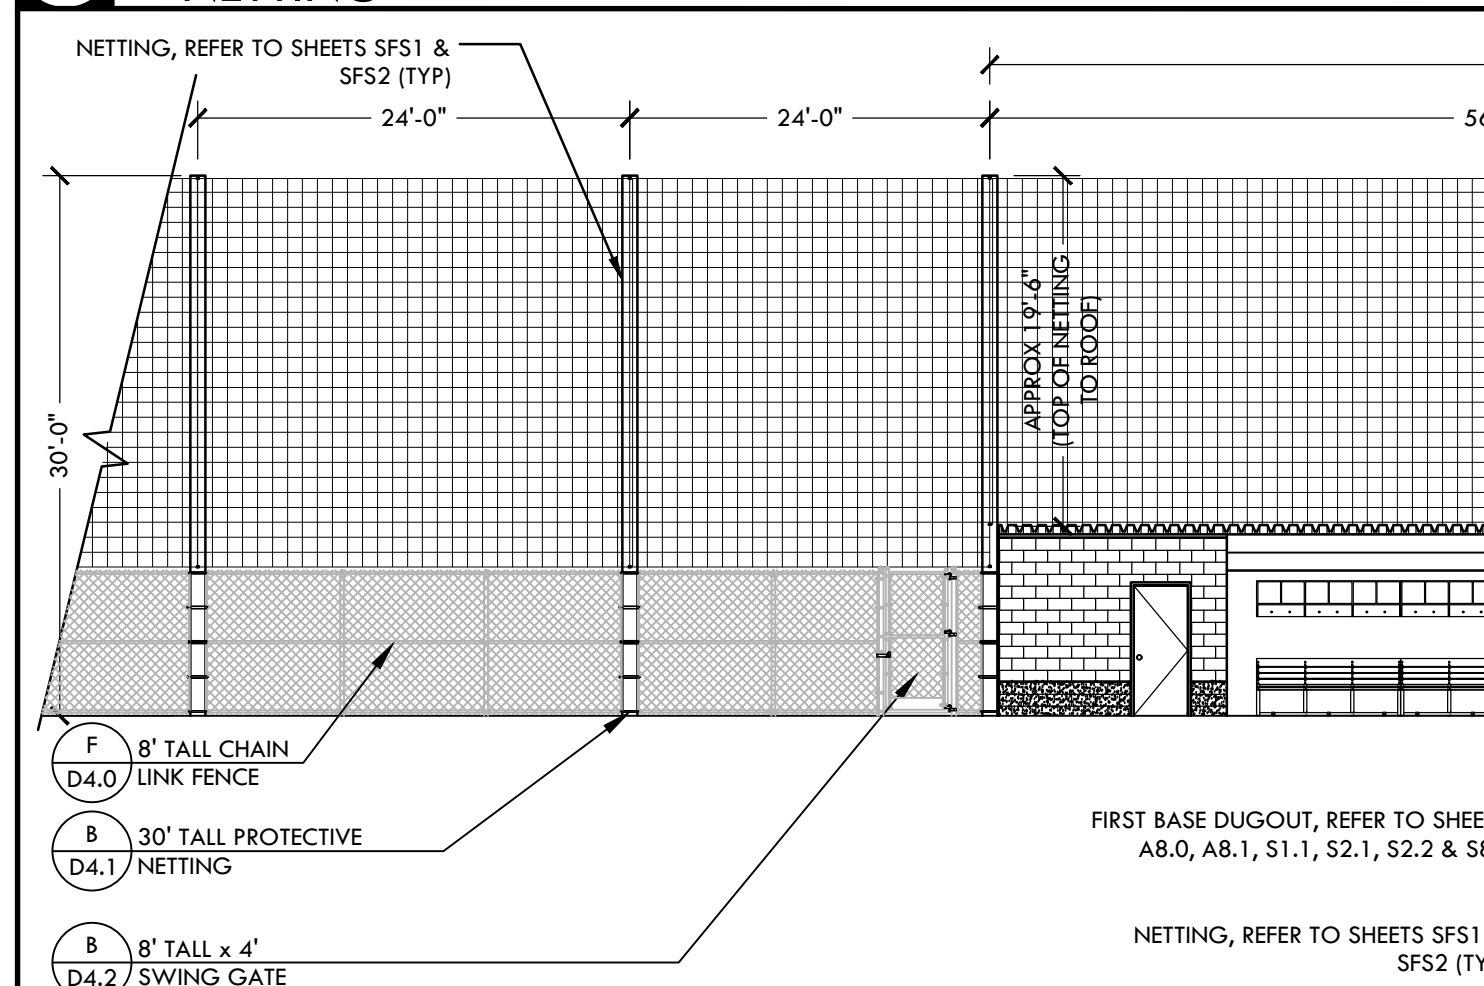

**C** PROTECTIVE NETTING & HARDWARE

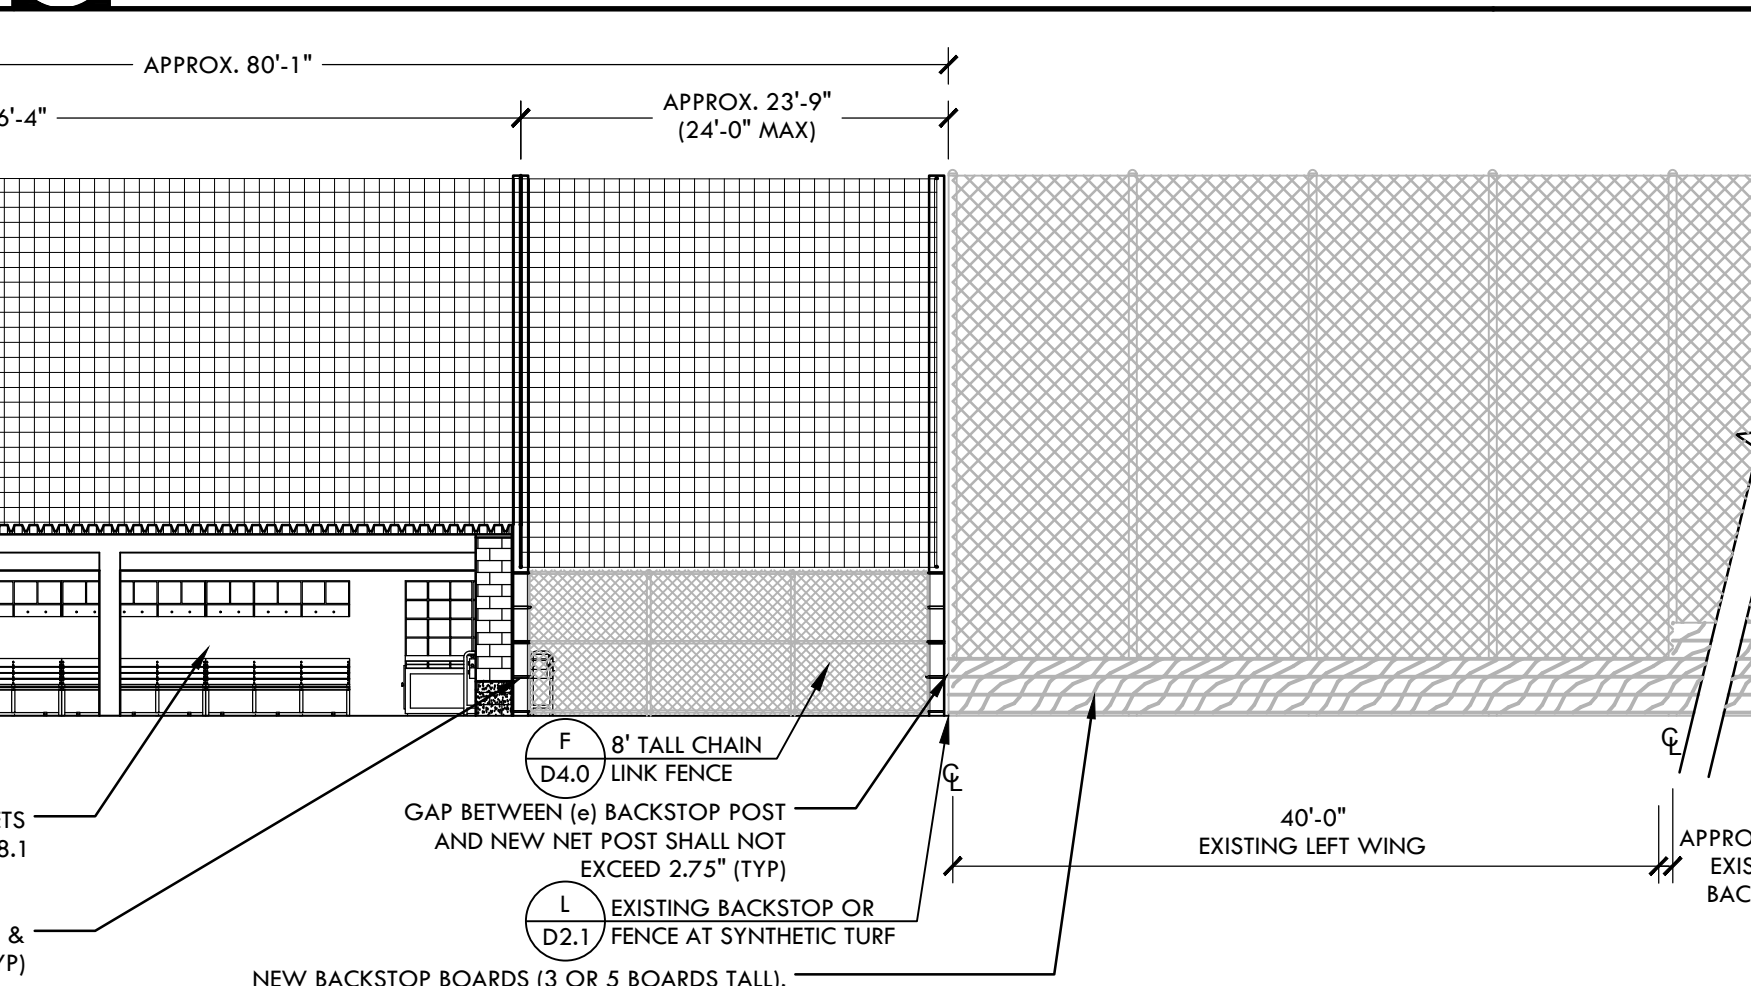


|     |   |
|-----|---|
| NTS | D |
|-----|---|

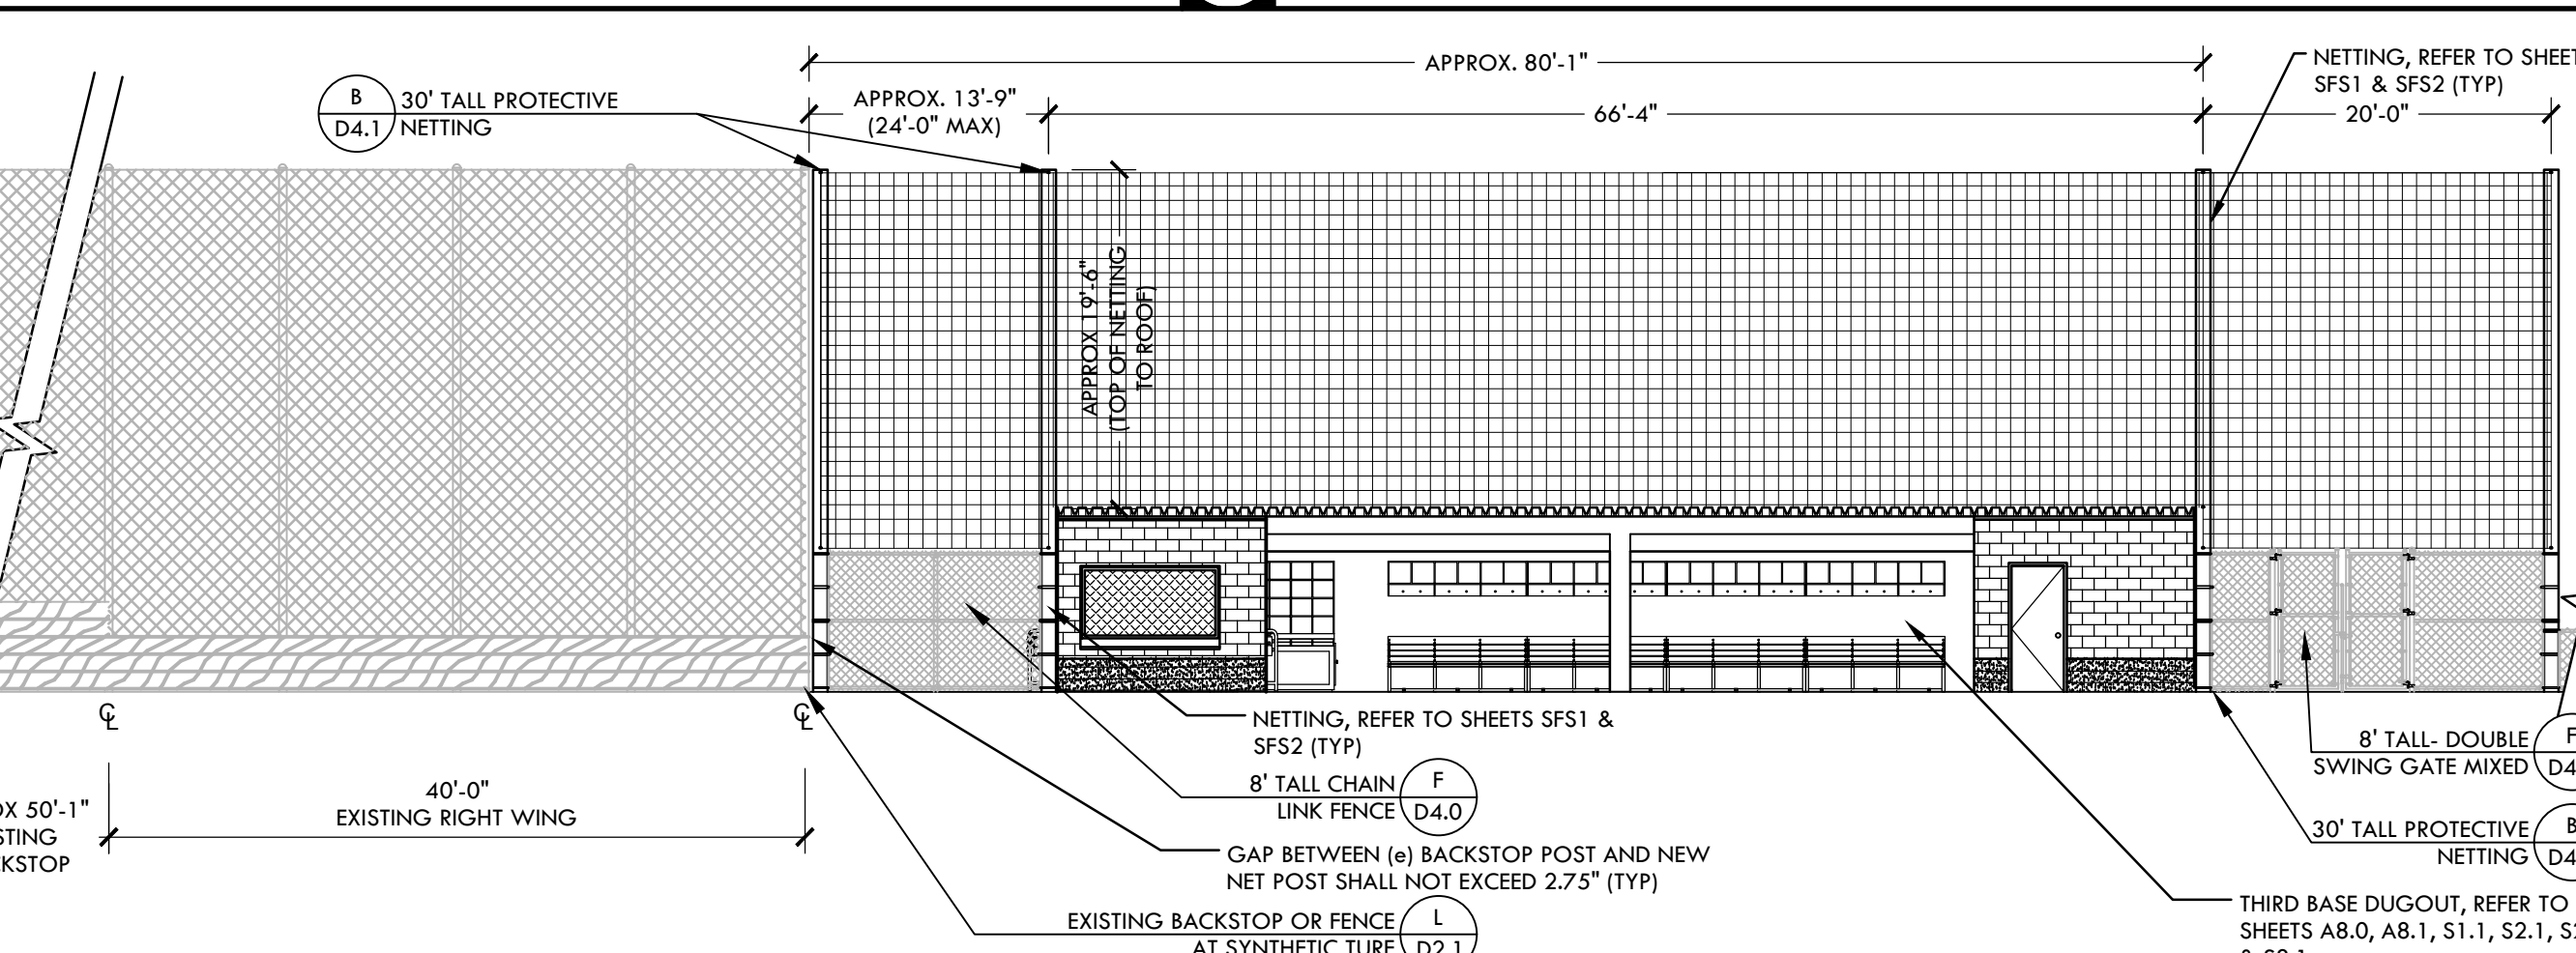


**A** BASEBALL BACKSTOP ELEVATION (VIEW OF FRONT SIDE)



 
ALL DESIGN, DRAWING, AND CONSTRUCTION SHALL BE IN ACCORDANCE WITH THE SPECIFICATIONS OF THE CITY OF STOCKTON, CALIFORNIA. NO PART OF THIS DRAWING SHALL BE REPRODUCED, COPIED, OR TRANSMITTED IN ANY FORM OR BY ANY MEANS, WITHOUT THE WRITTEN PERMISSION OF VERDE DESIGN, INC. ANY REUSE OR MODIFICATION OF THIS DRAWING WITHOUT THE WRITTEN PERMISSION OF VERDE DESIGN, INC. IS PROHIBITED. VERDE DESIGN, INC. IS NOT RESPONSIBLE FOR ANY DAMAGE OR INJURY TO PERSONS OR PROPERTY CAUSED BY THE USE OF THIS DRAWING. VERDE DESIGN, INC. IS NOT RESPONSIBLE FOR ANY DAMAGE OR INJURY TO PERSONS OR PROPERTY CAUSED BY THE USE OF THIS DRAWING.



L

 


K

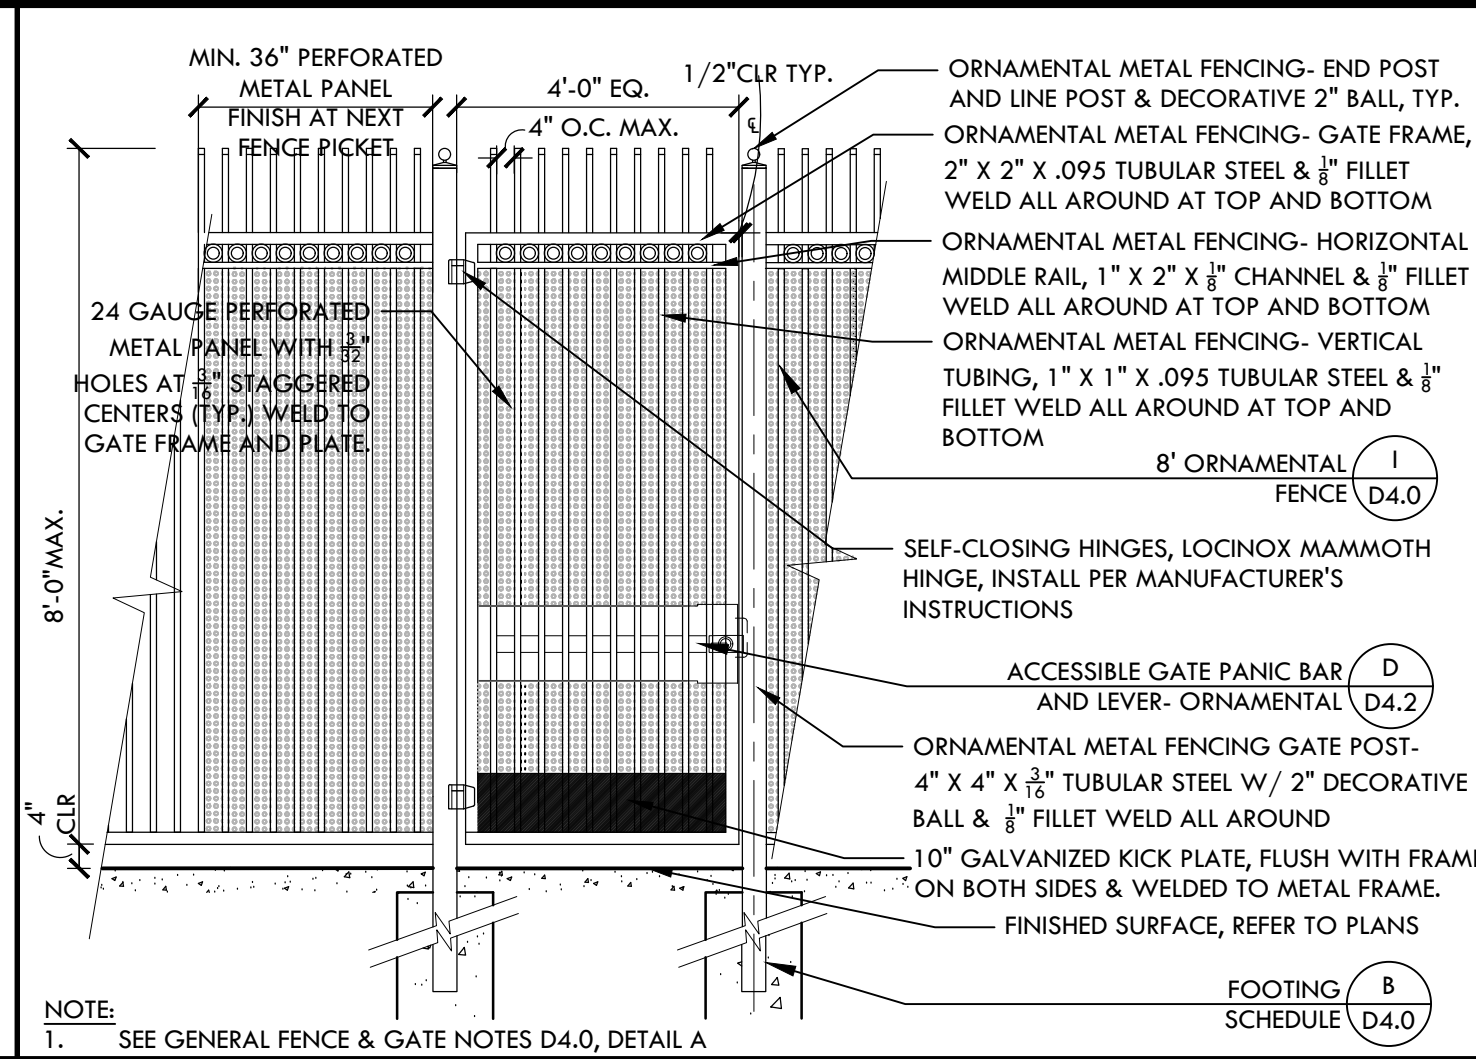

G

8' TALL X 4' WIDE ORNAMENTAL GATE - ACCESSIBLE

NTS

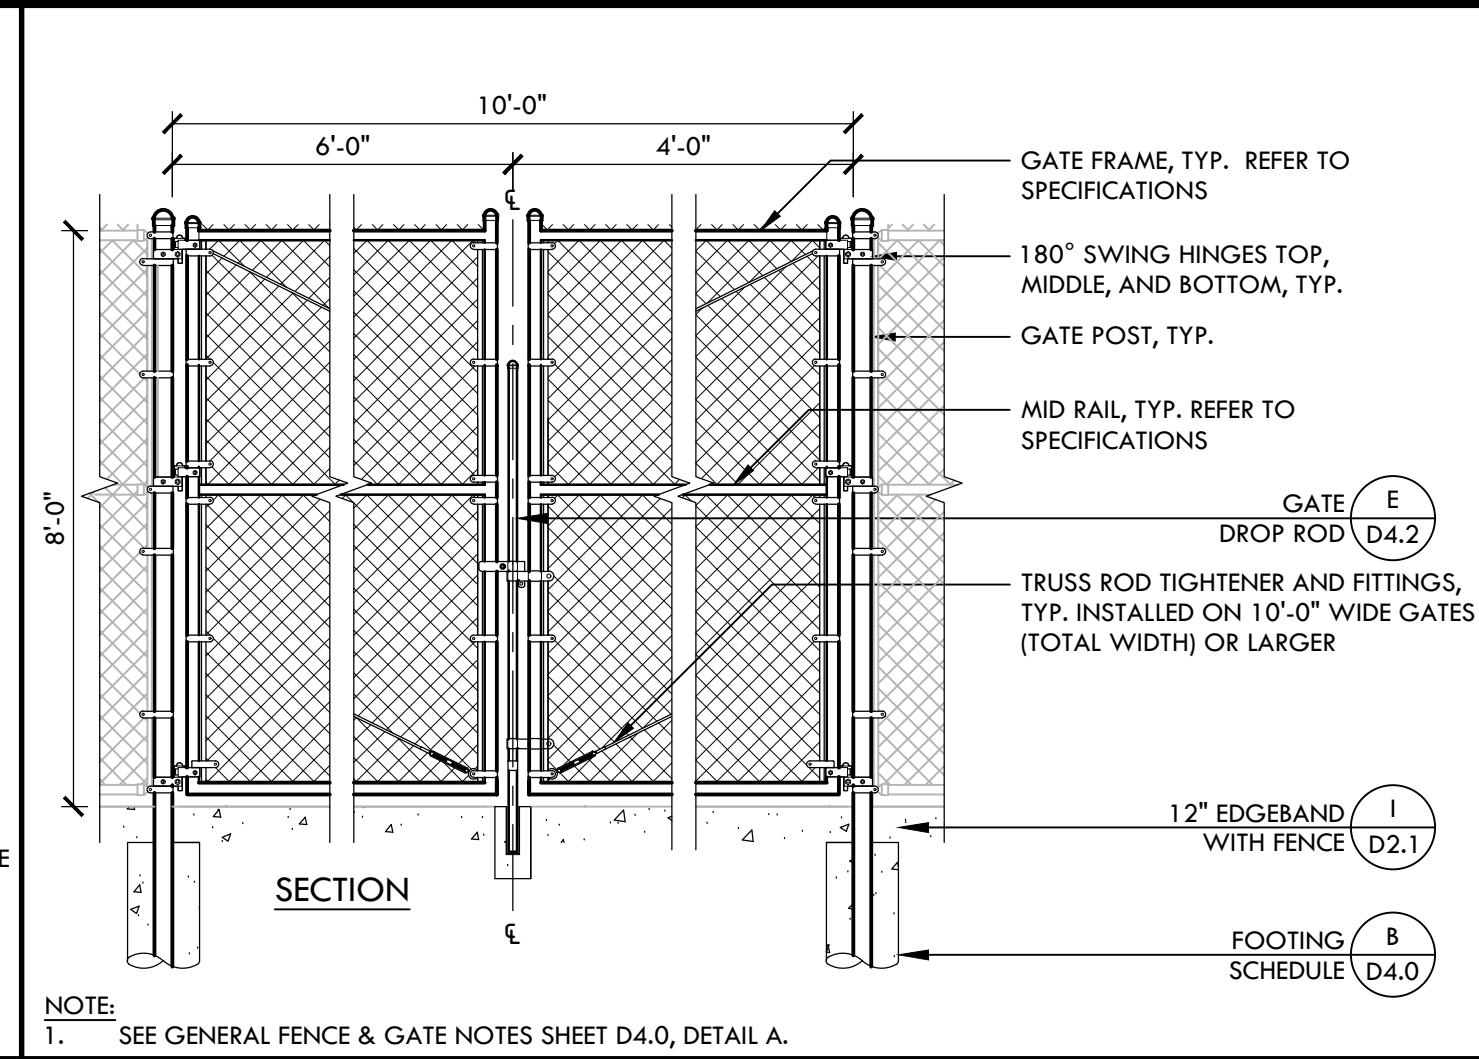


F

8' TALL - DOUBLE SWING GATE MIXED

NTS




J

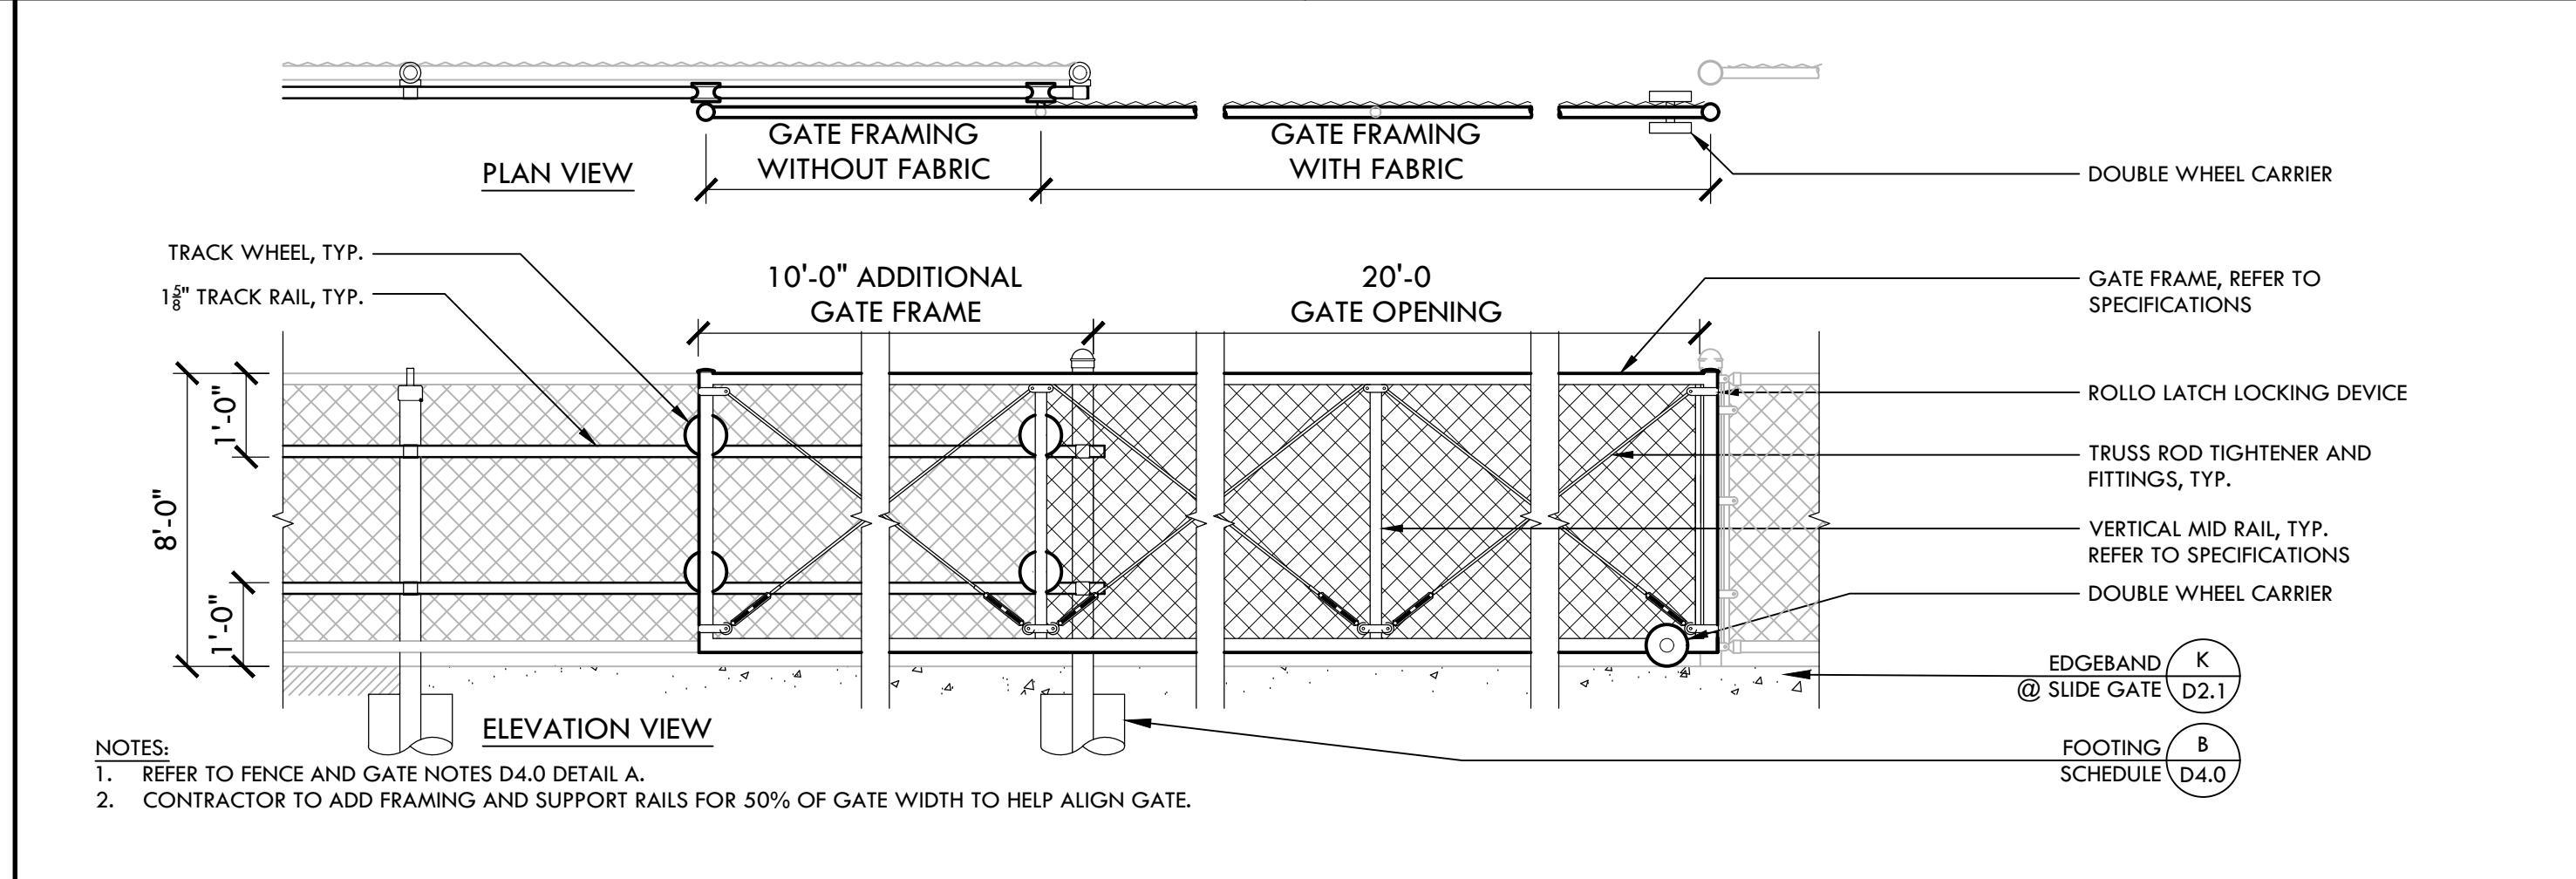

E

20' WIDE SLIDING GATE


NTS

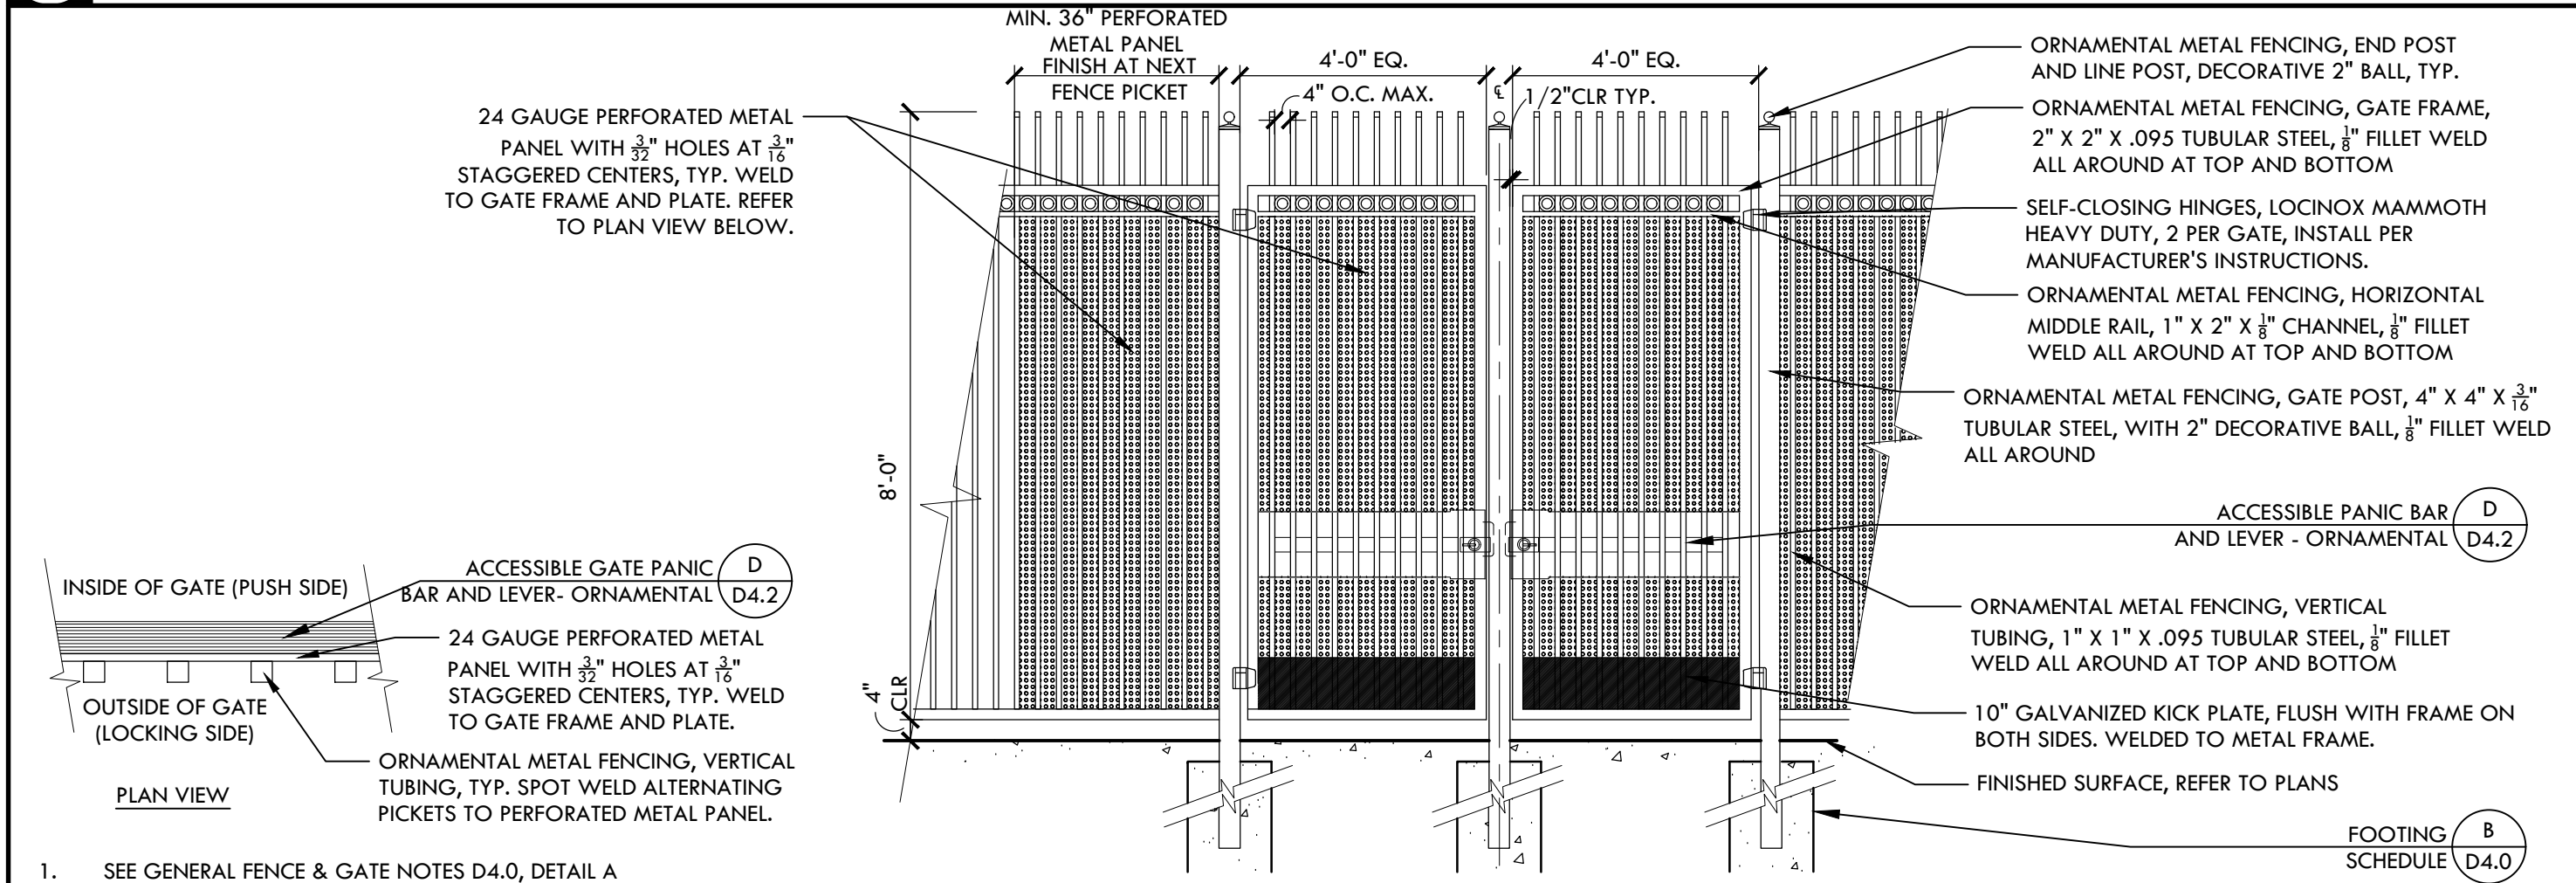

I

8' TALL X 8' WIDE DOUBLE ORNAMENTAL GATE (ACCESSIBLE)


NTS

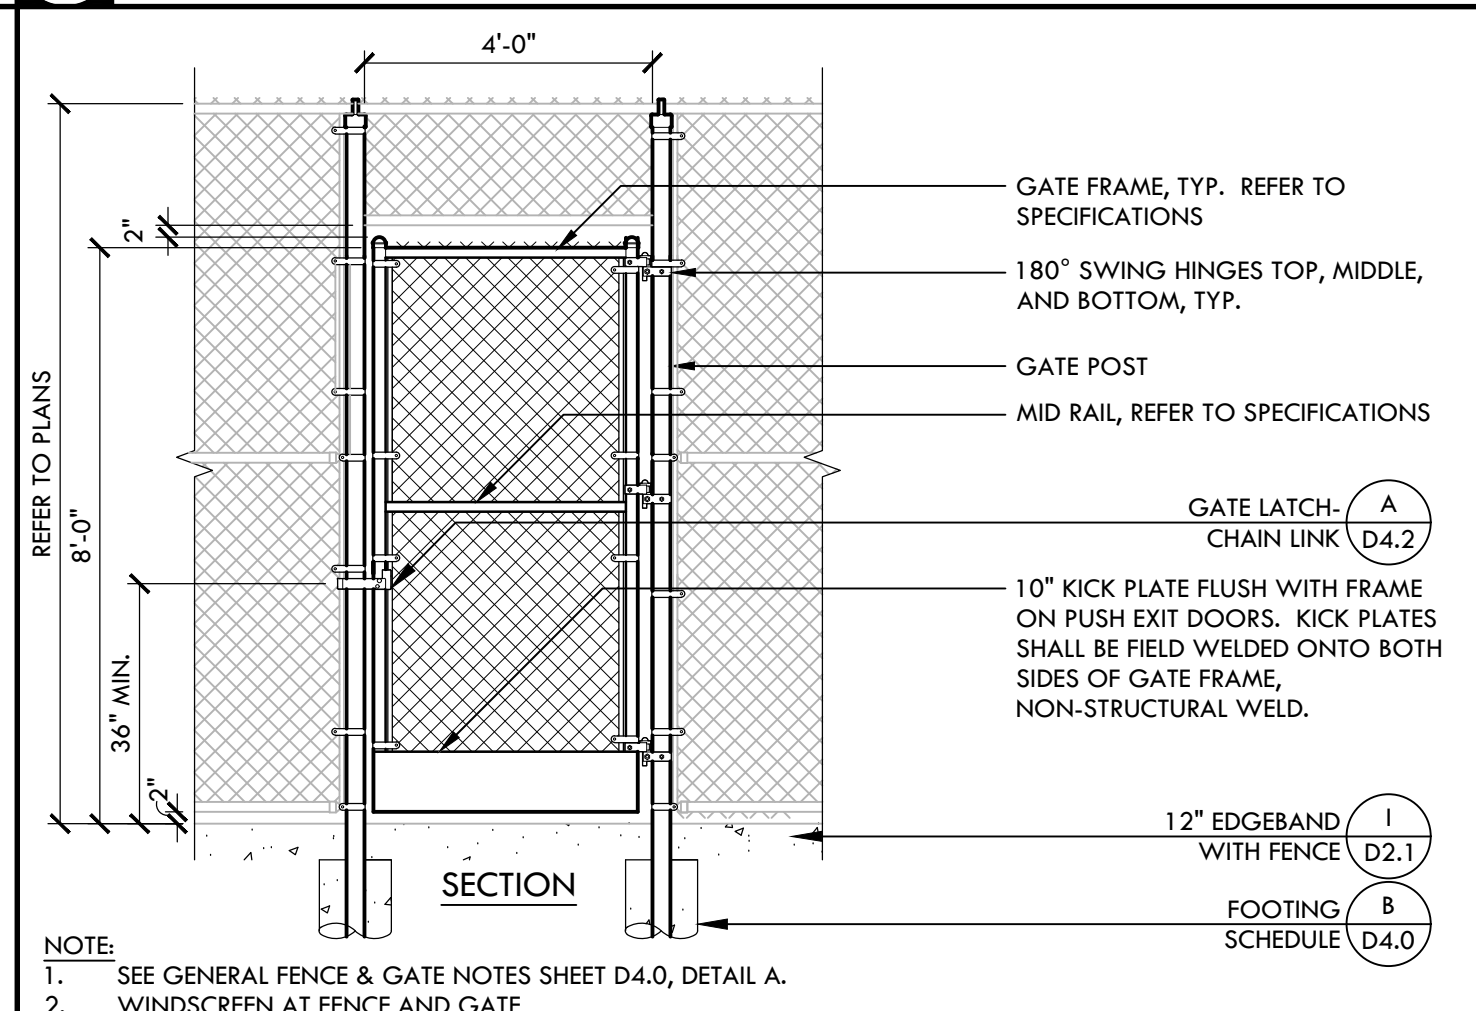

D

8' TALL x 4' SWING GATE - TRANSMOM


NTS

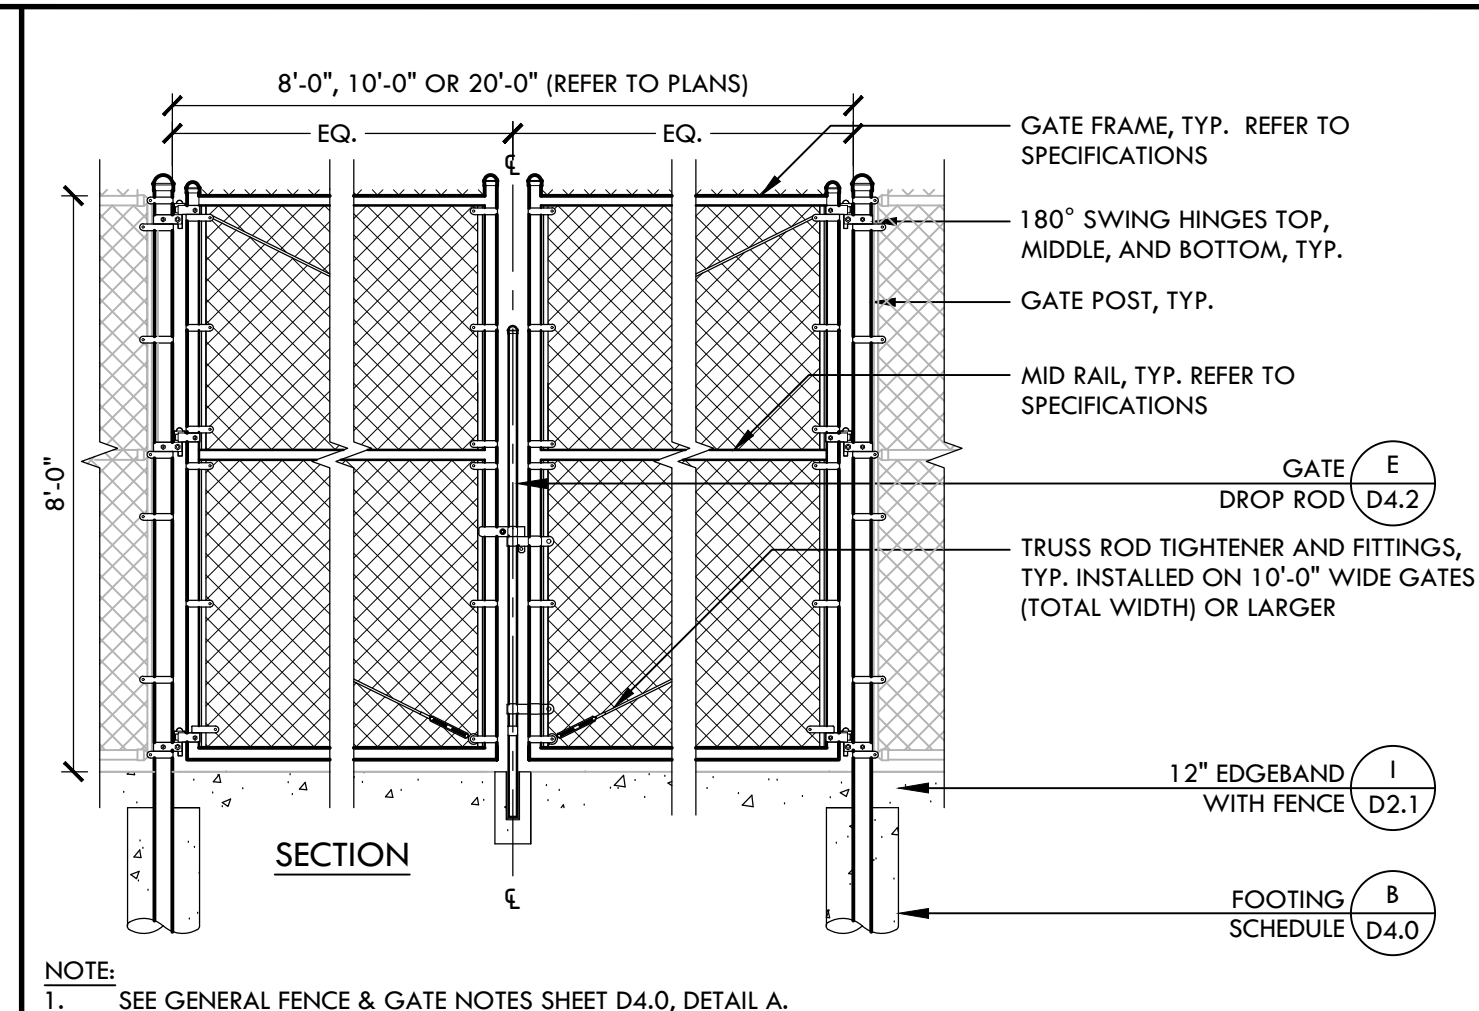


C

8' TALL - DOUBLE SWING GATE

NTS

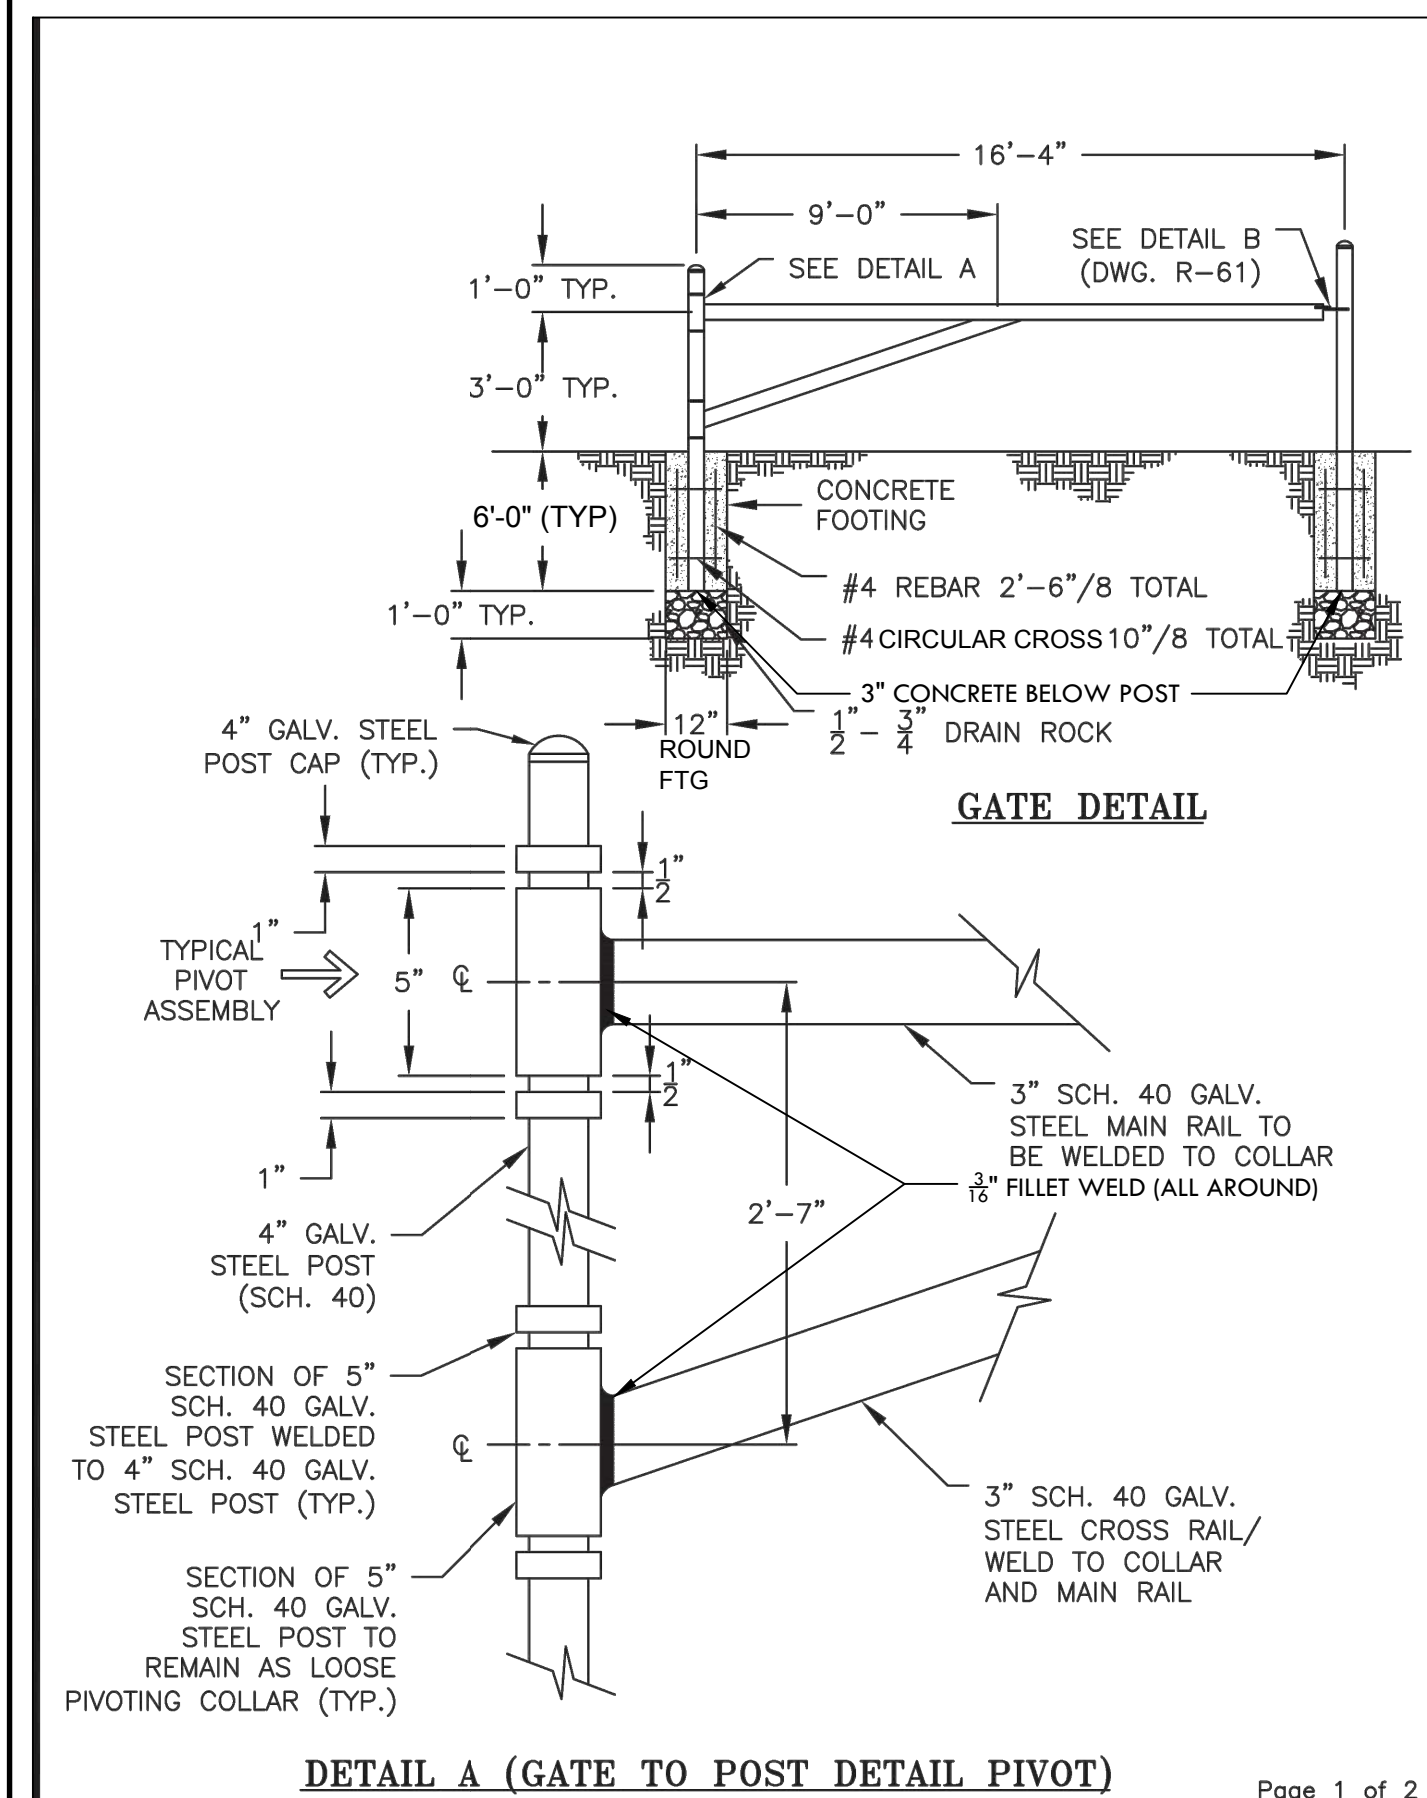

| ACCESS GATE | REVISION NO. | APPROVED BY CITY ENGINEER |
|-------------|--------------|---------------------------|
|             | 1            |                           |
|             | 2            |                           |
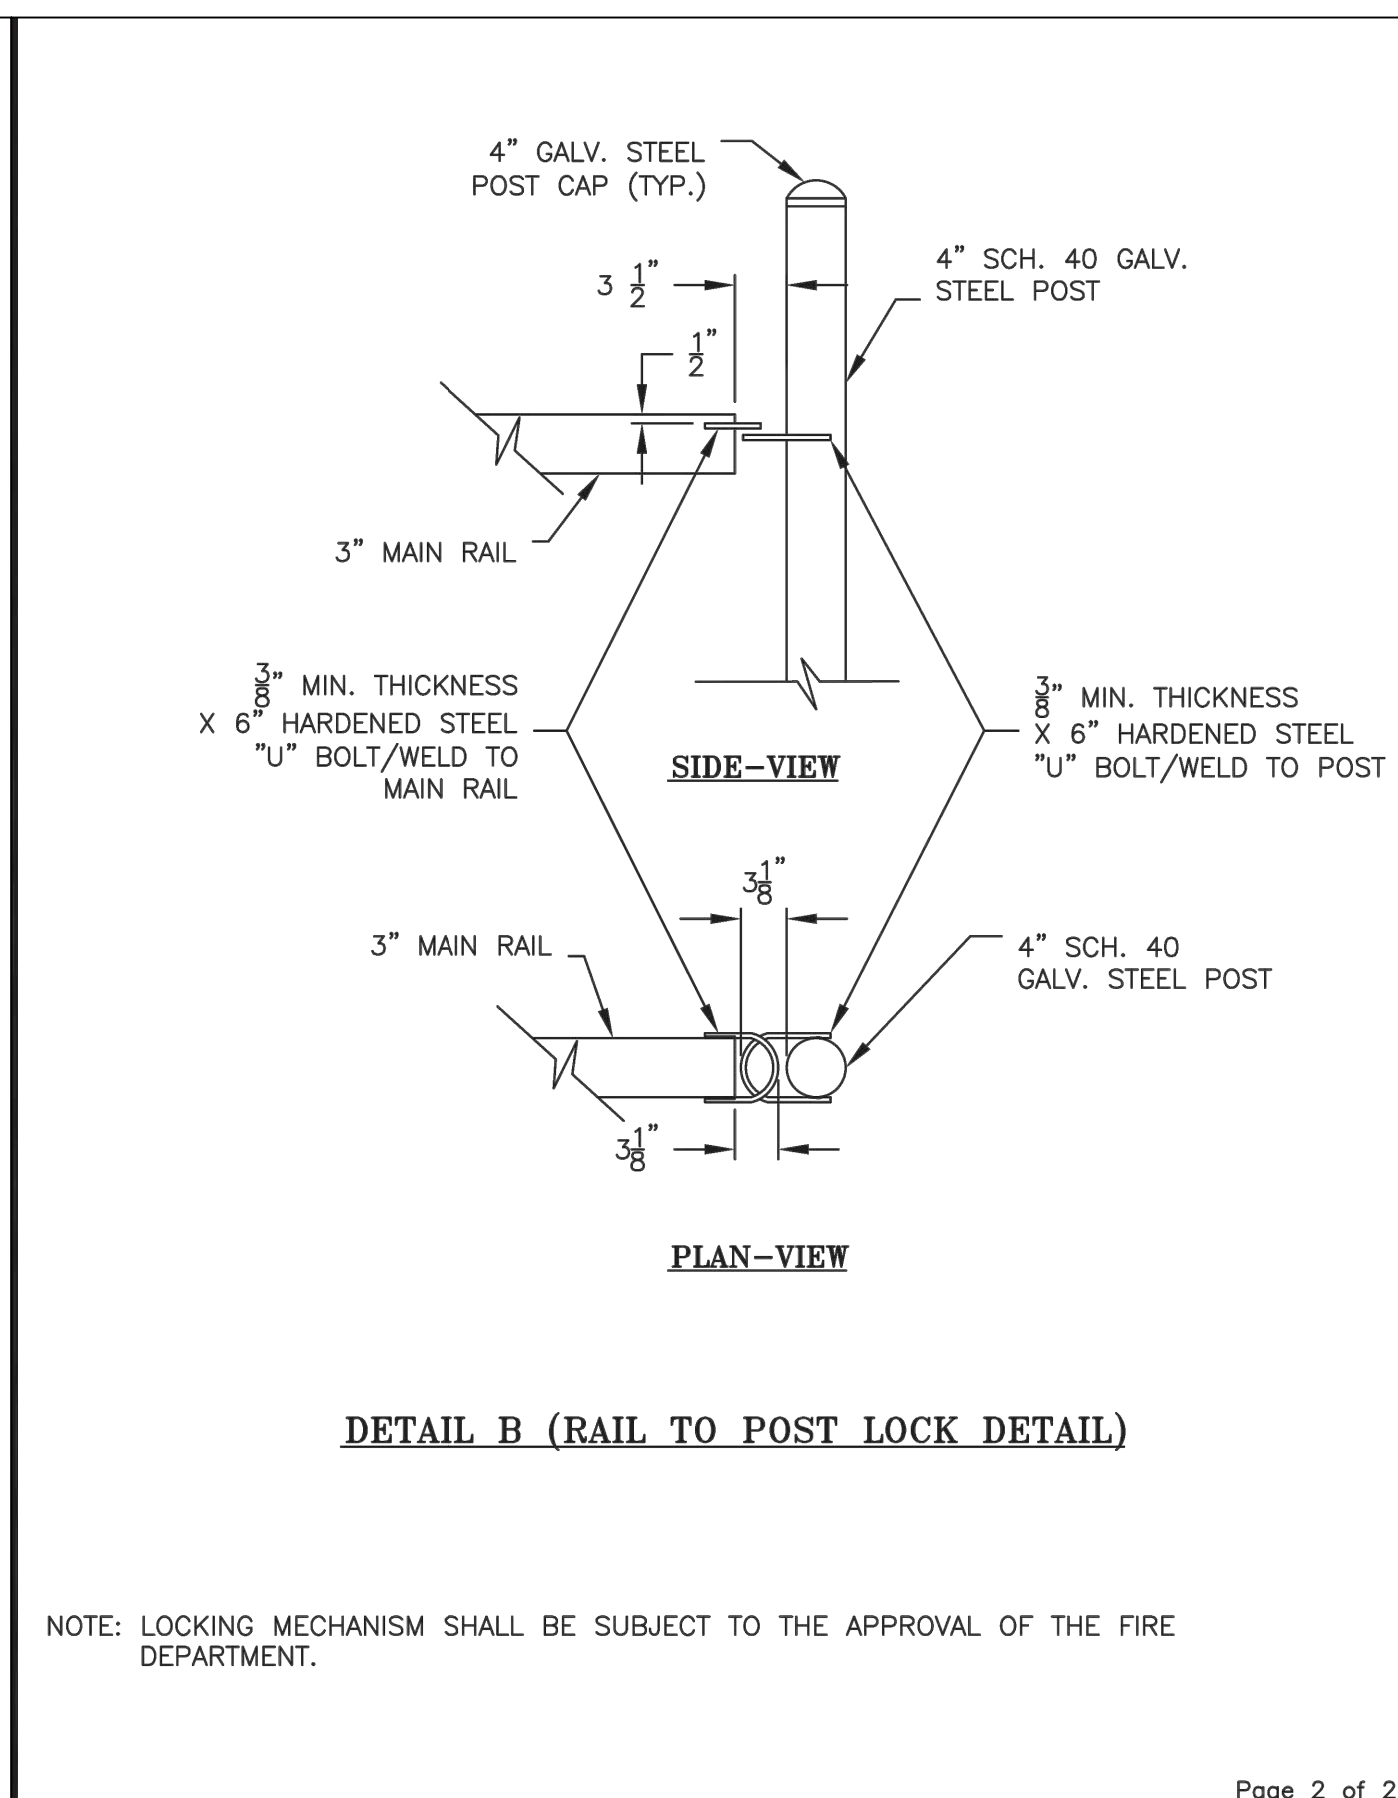


| ACCESS GATE | REVISION NO. | APPROVED BY CITY ENGINEER |
|-------------|--------------|---------------------------|
|             | 1            |                           |
|             | 2            |                           |
H

ACCESS GATE


NTS

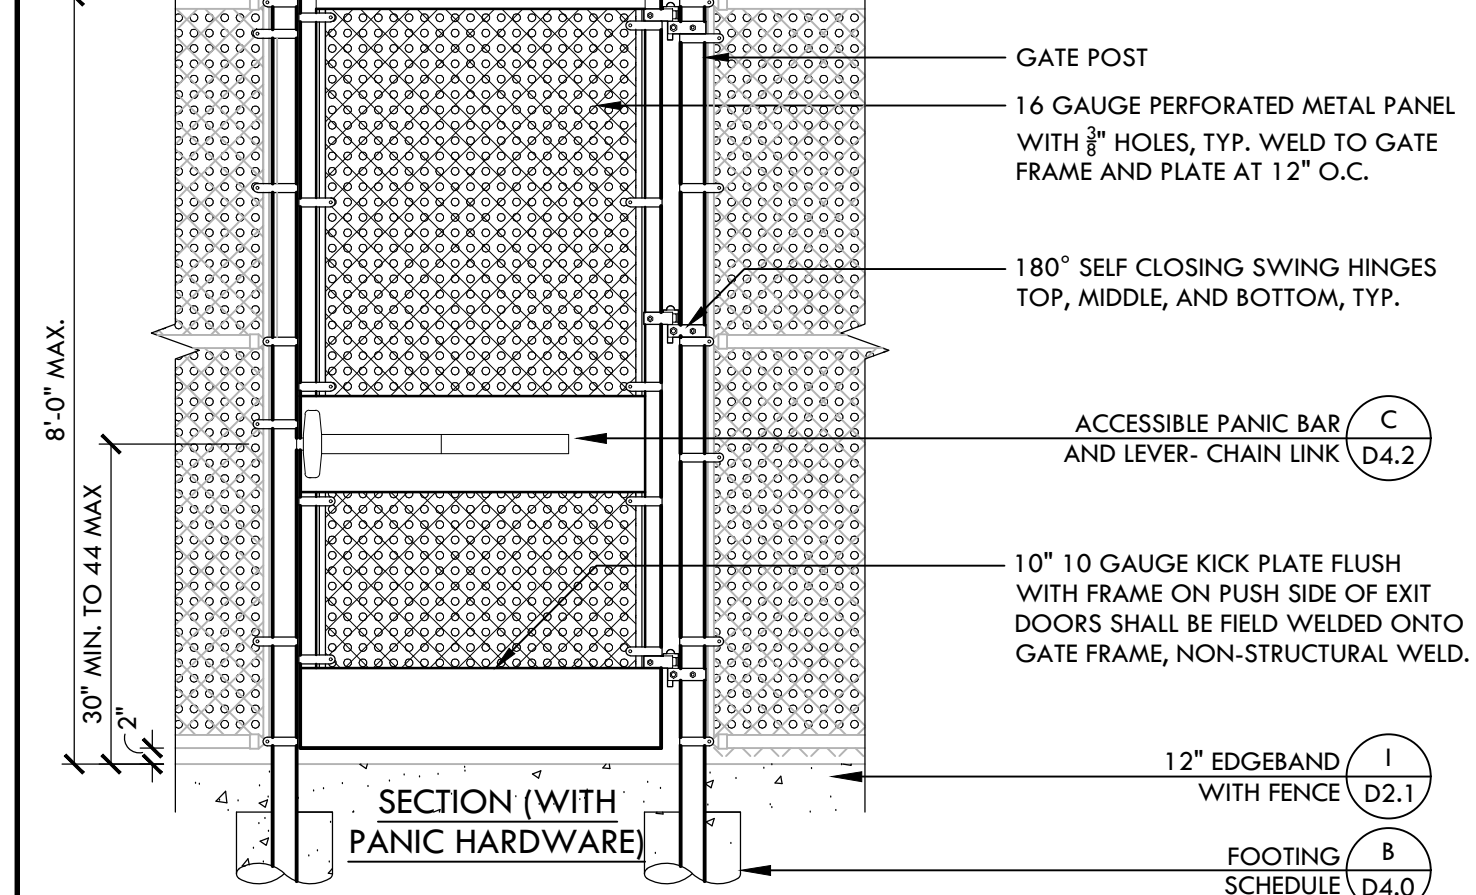

B

8' TALL X 4' SWING GATE


NTS

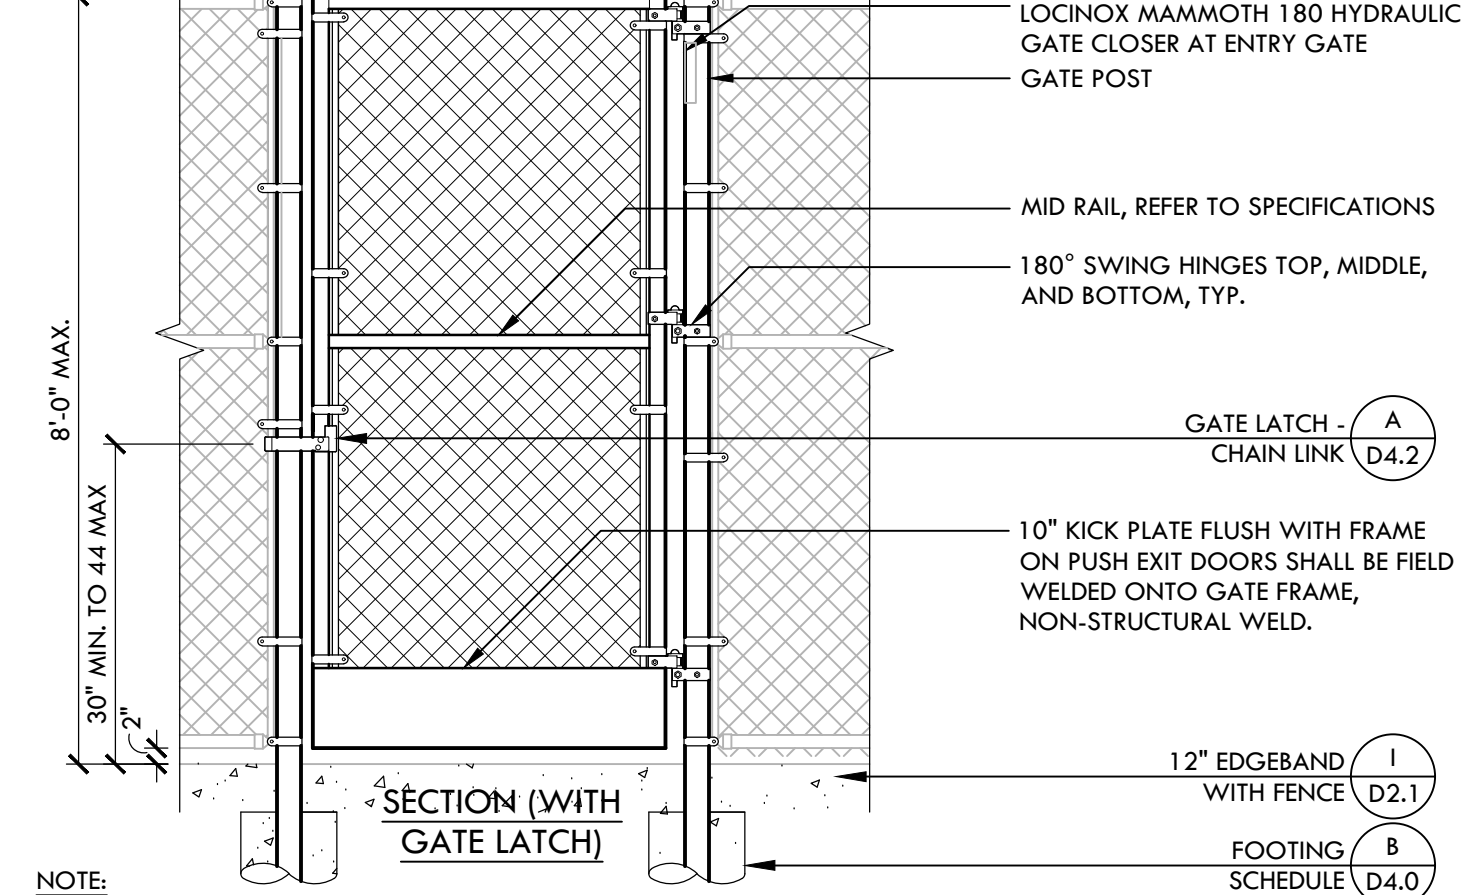

C

8' TALL - DOUBLE SWING GATE


NTS

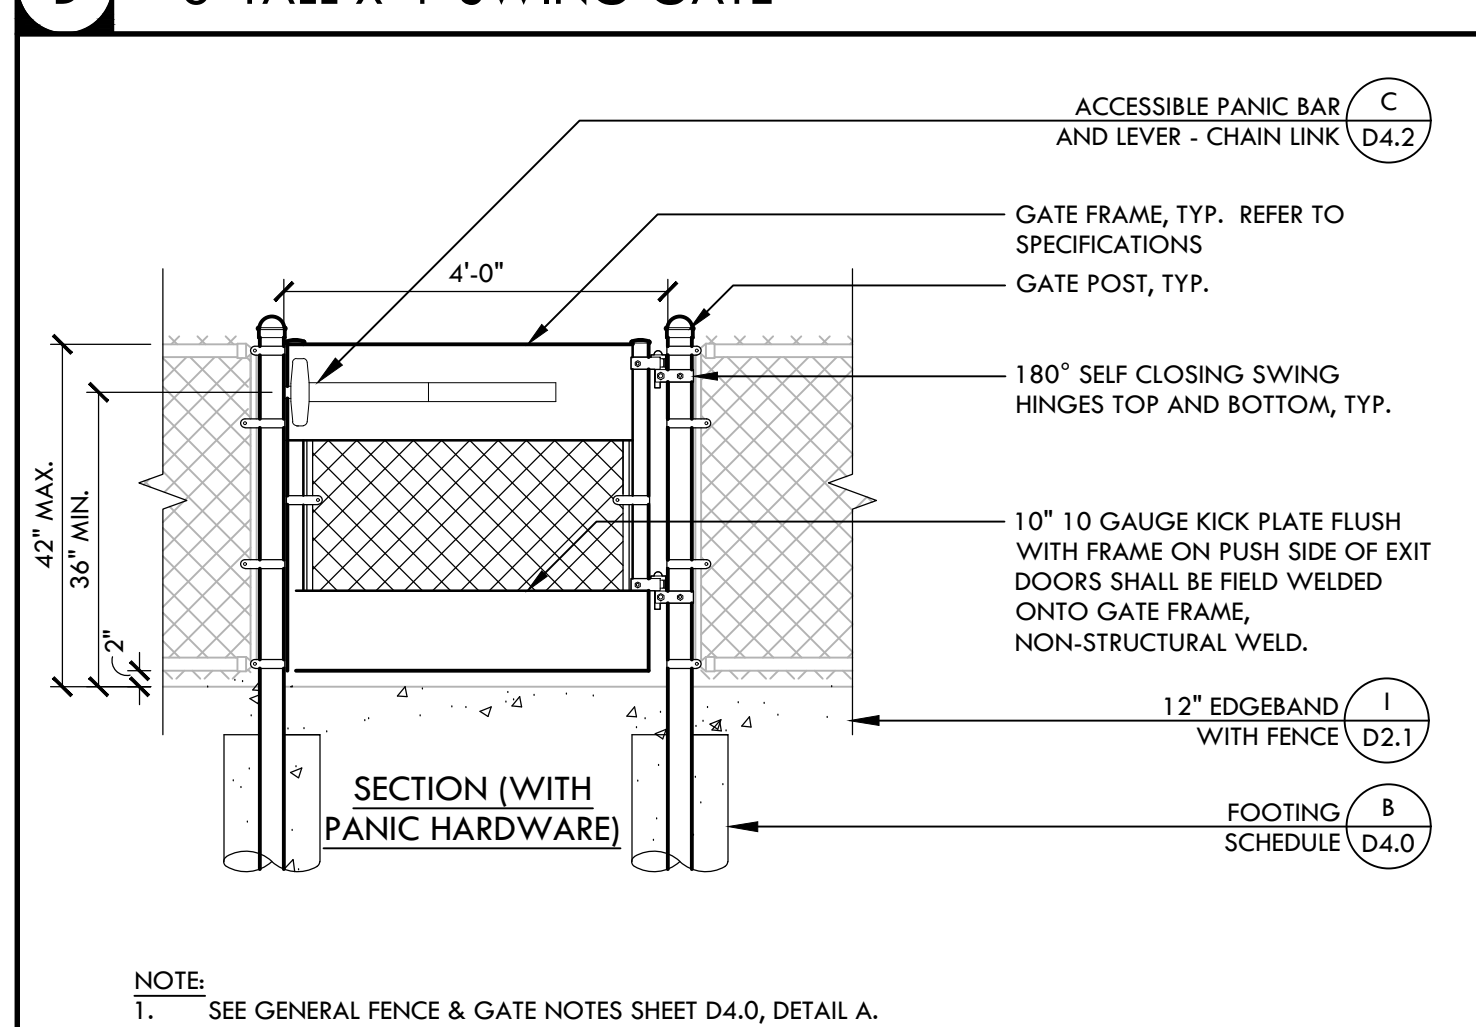

A

42" x 4' SWING GATE

NTS

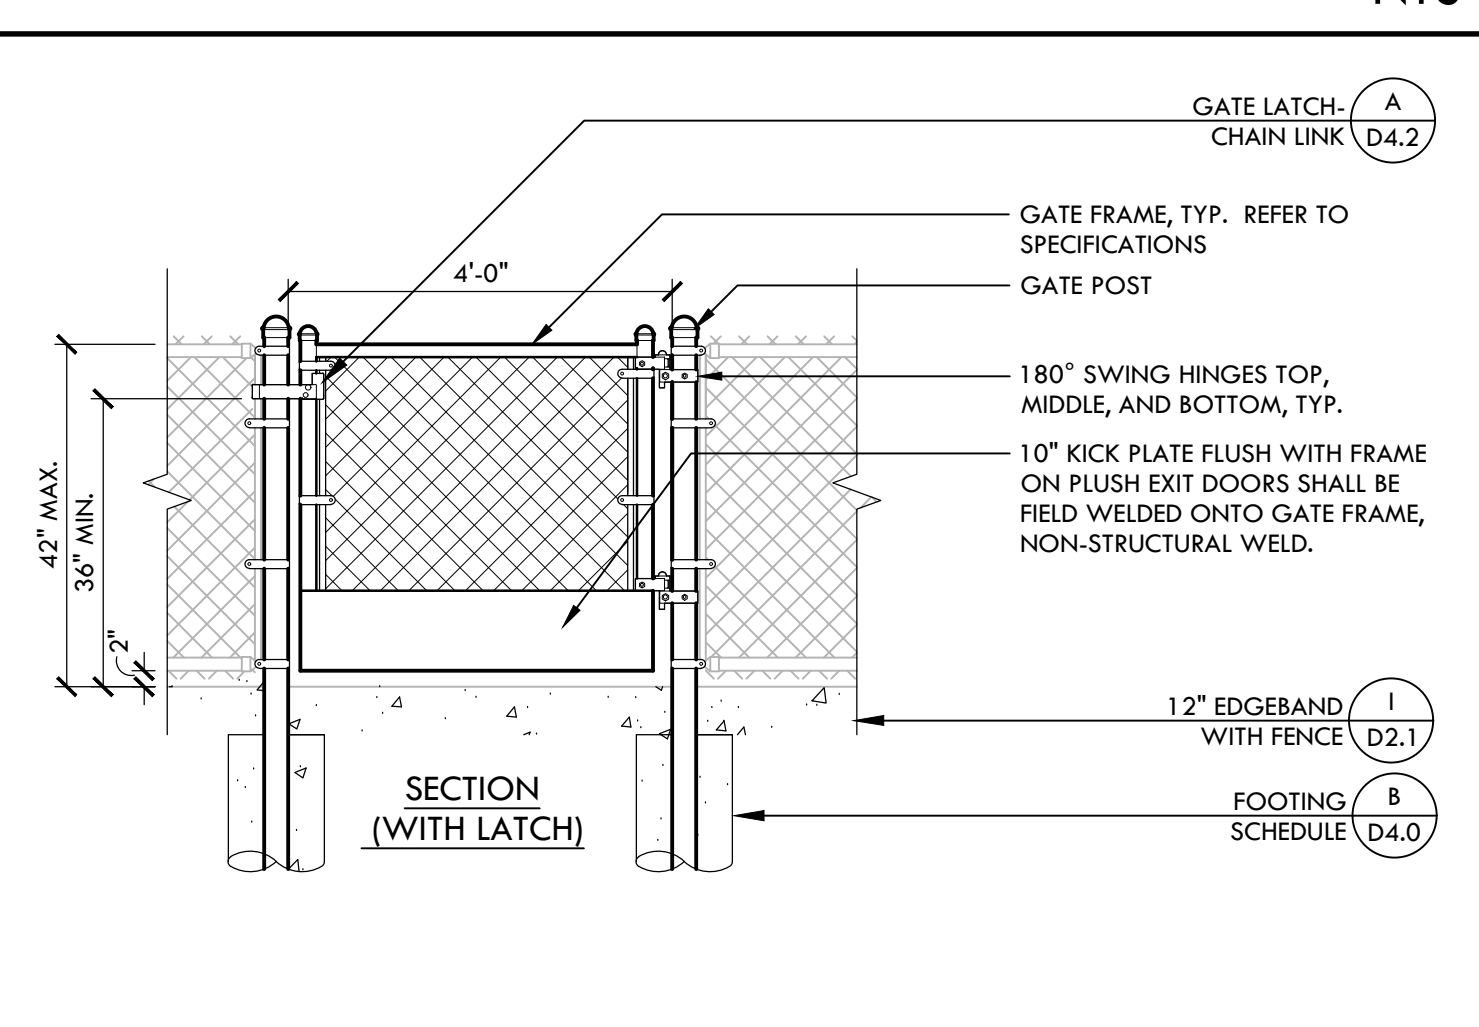

IDENTIFICATION STAMP  
DIV. OF THE STATE ARCHITECT  
APP. 02-118017 INC.  
REVIEWED FOR  
SS ☐ FLS ☐ ACS ☐  
DATE: 04/10/2020

**VERDE DESIGN**  
LANDSCAPE ARCHITECTURE  
CIVIL ENGINEERING  
SPORT PLANNING & DESIGN  
1843 Iron Point Rd #140  
Folsom, CA 95630  
tel: 916.415.6554  
fax: 916.985.7260  
www.VerdeDesignInc.com

CONSULTANT

KEYMAP

SHEET TITLE  
**FENCING DETAILS - GATES**

PROJECT NAME  
**CHAVEZ HIGH SCHOOL  
STOCKTON USD  
ATHLETIC FACILITY  
IMPROVEMENTS**

PROJECT ADDRESS  
**2929 WINDFLOWER LN  
STOCKTON, CA 95212**

| SUBMITTAL               | DATE     |
|-------------------------|----------|
| DD/50% SUBMITTAL        | 10/25/19 |
| DSA SUBMITTAL           | 12/20/19 |
| DSA BACKCHECK SUBMITTAL | 03/27/20 |

| NO. | REVISIONS | DATE |
|-----|-----------|------|
| 1   |           |      |
| 2   |           |      |
| 3   |           |      |
| DRAWN BY | CHECKED BY |
|----------|------------|
| VDI      | CS         |


| DATE ISSUED | SCALE    |
|-------------|----------|
| 03/27/20    | AS NOTED |

| PROJ. NO.    |
|--------------|
| 1910900-1211 |

| SHEET NO. |
|-----------|
| D4.2      |

| OF 122                  |
|-------------------------|
| FENCING DETAILS - GATES |



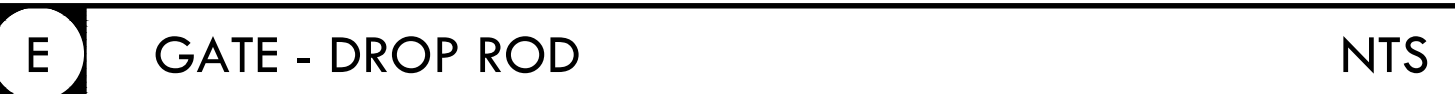




**VERDE DESIGN**

---

**LANDSCAPE ARCHITECTURE  
CIVIL ENGINEERING  
SPORT PLANNING & DESIGN**

---


**1843 Iron Point Rd #140  
Folsom, CA 95630  
tel: 916.415.6554  
fax: 408.985.7260  
[www.VerdeDesignInc.com](http://www.VerdeDesignInc.com)**

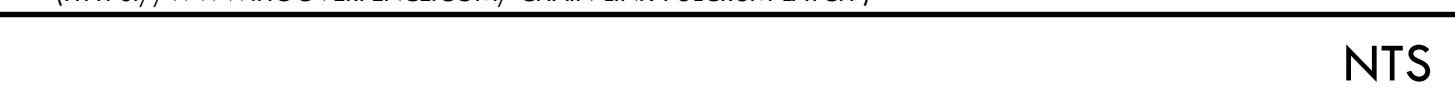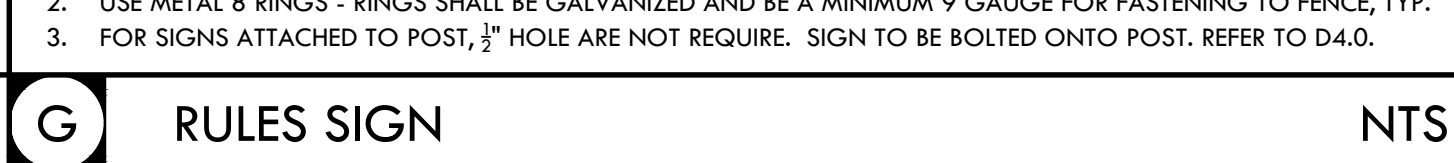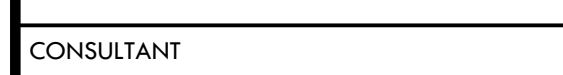

## ENCING DETAILS - HARDWARE



ALL DESIGN, CONSTRUCTION, AND/OR MATERIALS OF THIS DRAWING ARE OWNED BY AND THE PROPERTY OF VERDE DESIGN, INC. AND WERE CREATED, DEVELOPED, OR DISCLOSED FOR USE ON AND IN CONNECTION WITH THE SPECIFIED PROJECT. NONE OF SUCH IDEAS, DESIGNS, ARRANGEMENTS OR PLANS SHALL BE USED, REPRODUCED, OR PUBLISHED IN WHOLE OR IN PART, OR DISCLOSED TO ANY PERSON, FIRM, OR CORPORATION FOR ANY PURPOSES WHATSOEVER WITHOUT WRITTEN PERMISSION OF VERDE DESIGN, INC.

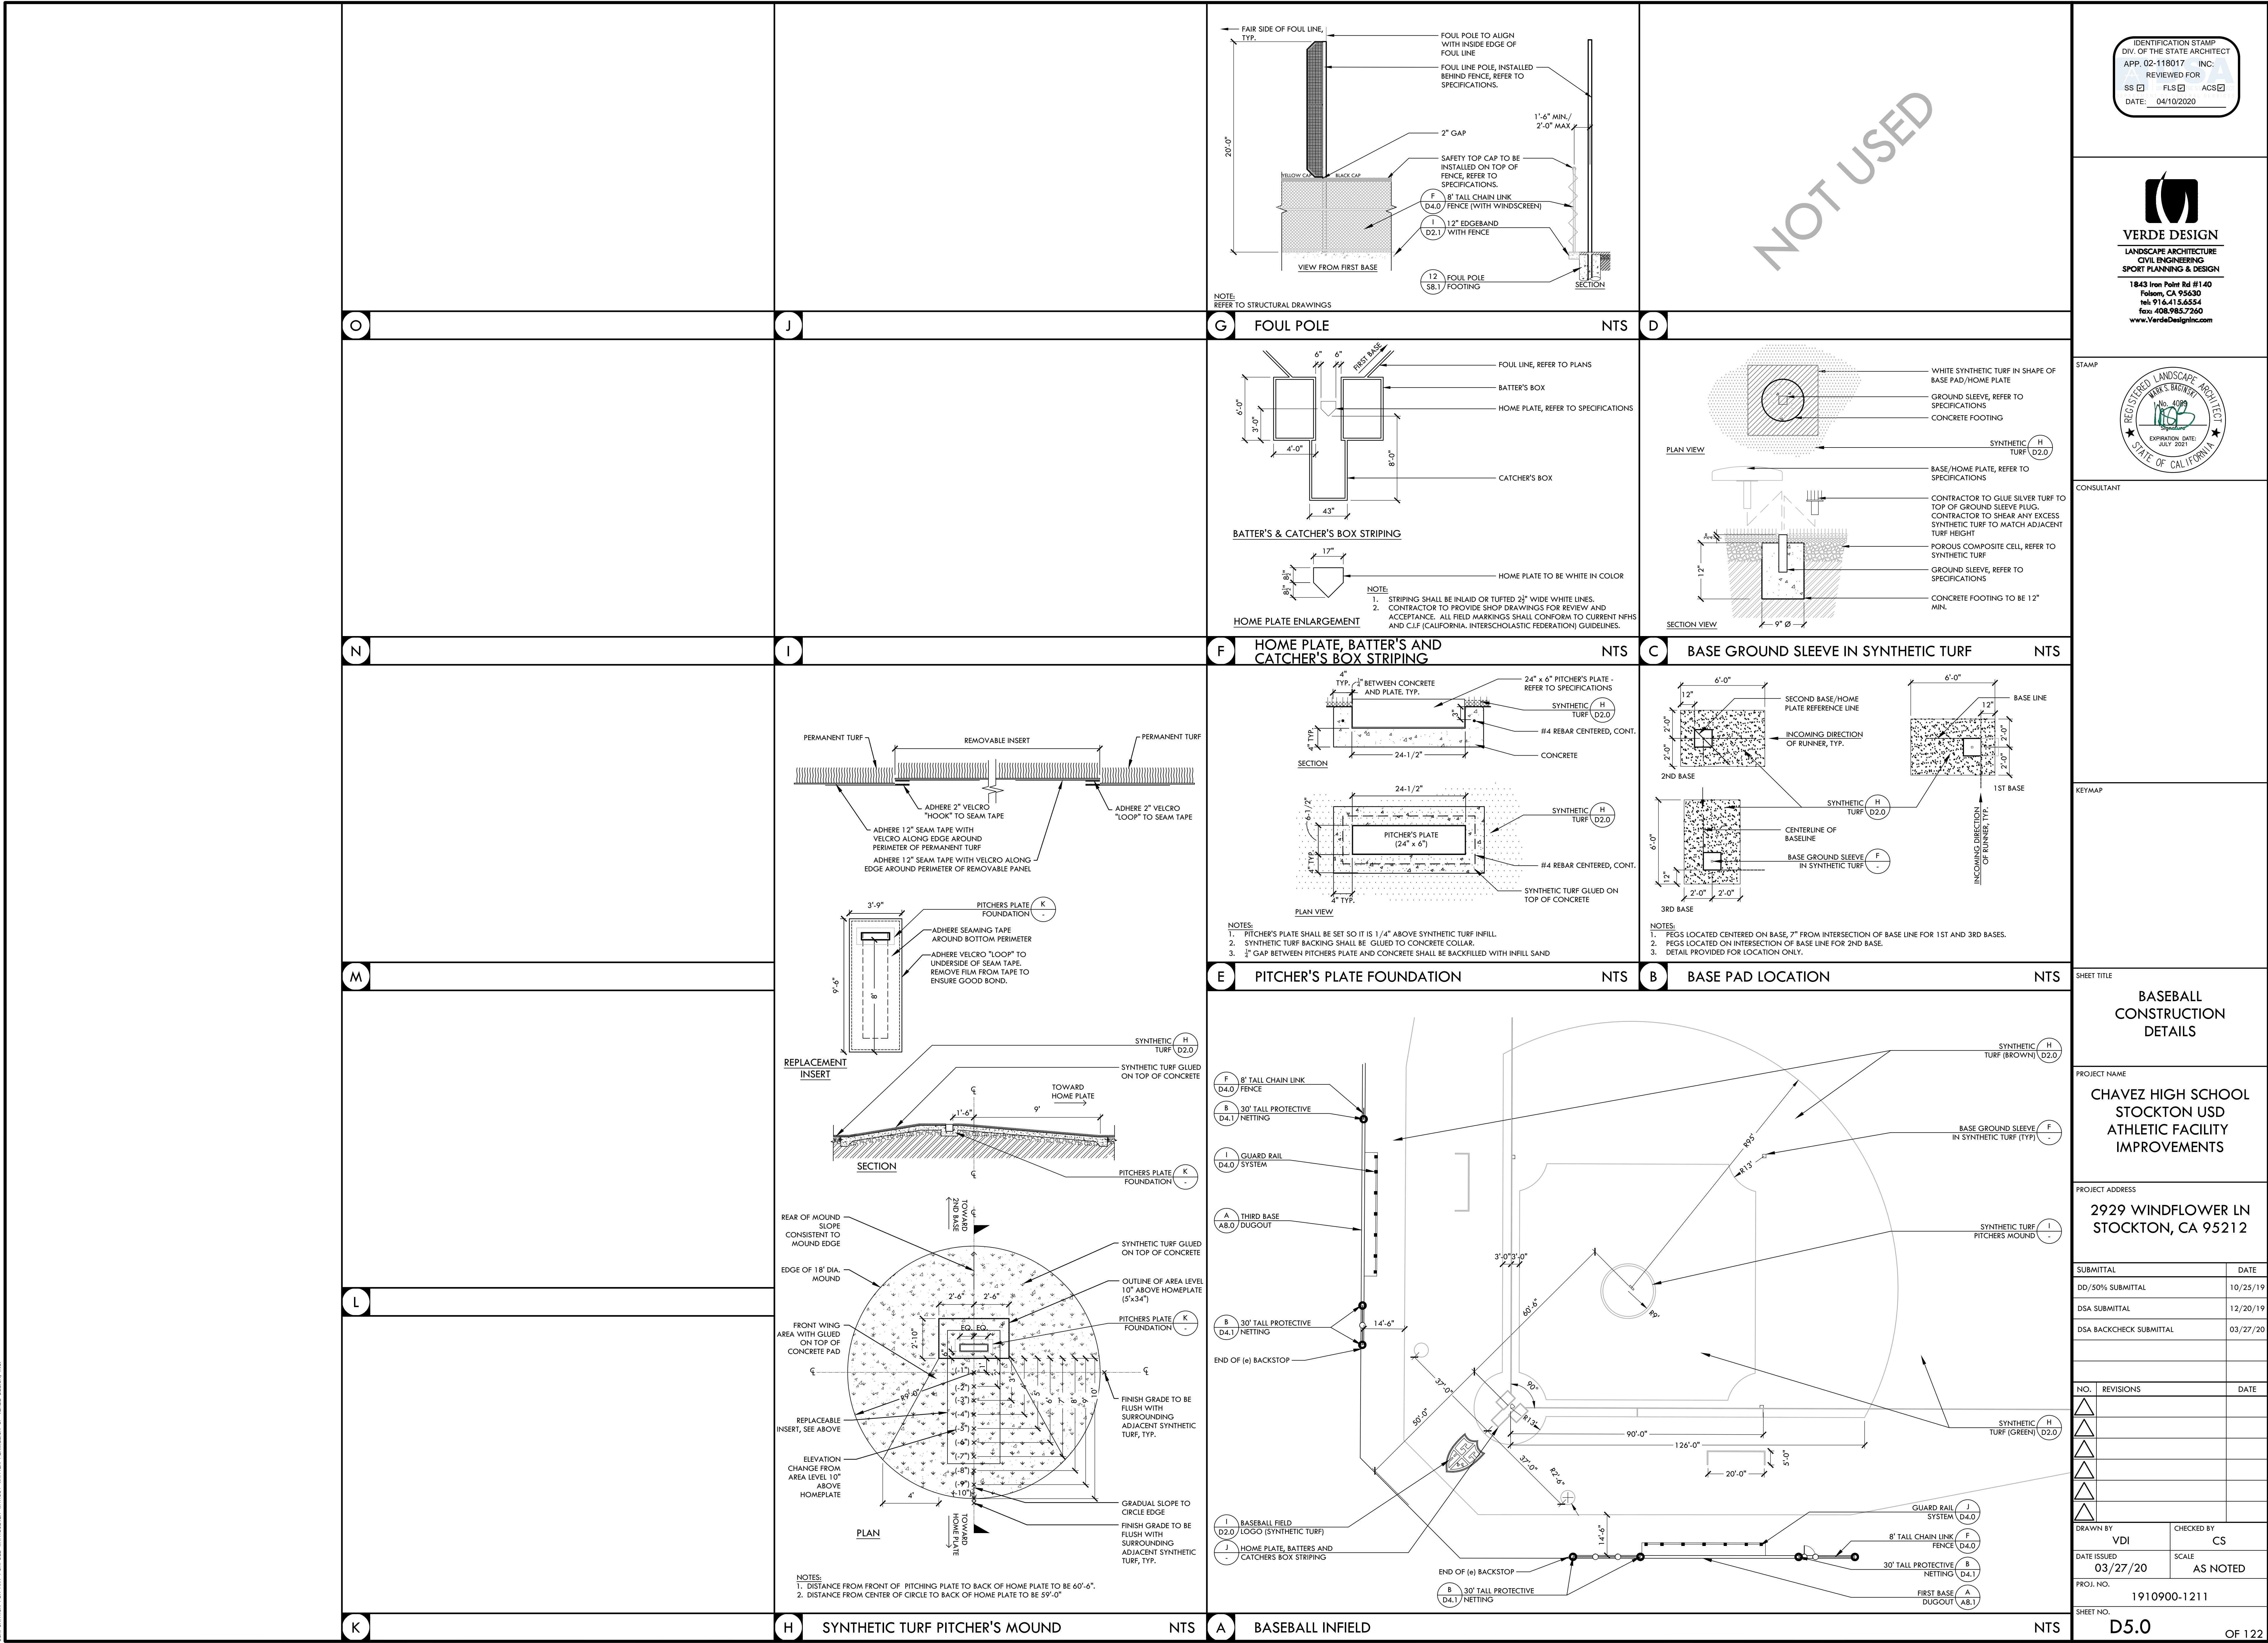

IDENTIFICATION STAMP  
DIV. OF THE STATE ARCHITECT  
APP. 02-118017 INC.  
REVIEWED FOR  
SS ☐ FLS ☐ ACS ☐  
DATE: 04/10/2020

**VERDE DESIGN**  
LANDSCAPE ARCHITECTURE  
CIVIL ENGINEERING  
SPORT PLANNING & DESIGN  
1843 Iron Point Rd #140  
Folsom, CA 95630  
tel: 916.415.6554  
fax: 408.985.7260  
www.VerdeDesignInc.com

REGISTERED LANDSCAPE ARCHITECT  
MARK S. BARKER  
No. 409  
EXPIRATION DATE: JULY 2021  
STATE OF CALIFORNIA

STAMP

CONSULTANT

KEYMAP

SHEET TITLE

**BASEBALL  
CONSTRUCTION  
DETAILS**

PROJECT NAME

**CHAVEZ HIGH SCHOOL  
STOCKTON USD  
ATHLETIC FACILITY  
IMPROVEMENTS**

PROJECT ADDRESS

**2929 WINDFLOWER LN  
STOCKTON, CA 95212**

| SUBMITTAL               | DATE     |
|-------------------------|----------|
| DD/50% SUBMITTAL        | 10/25/19 |
| DSA SUBMITTAL           | 12/20/19 |
| DSA BACKCHECK SUBMITTAL | 03/27/20 |

| NO. | REVISIONS | DATE |
|-----|-----------|------|
| 1   |           |      |
| 2   |           |      |
| 3   |           |      |
| 4   |           |      |

|                           |                   |
|---------------------------|-------------------|
| DRAWN BY<br>VDI           | CHECKED BY<br>CS  |
| DATE ISSUED<br>03/27/20   | SCALE<br>AS NOTED |
| PROJ. NO.<br>1910900-1211 |                   |

SHEET NO.  
**D5.0**  
OF 122


**BASEBALL CONSTRUCTION DETAILS**



ALL DESIGN, DRAWING, AND CONSTRUCTION INFORMATION IS THE PROPERTY OF VERDE DESIGN, INC. AND WILL BE USED, REPRODUCED, OR PUBLISHED BY ANY METHOD, IN WHOLE OR IN PART, OR DISCLOSED TO ANY PERSON, FIRM, OR CORPORATION FOR ANY PURPOSE WITHOUT WRITTEN PERMISSION OF VERDE DESIGN, INC.

IDENTIFICATION STAMP  
DIV. OF THE STATE ARCHITECT  
APP. 02-118017 INC.  
REVIEWED FOR  
SS ☐ FLS ☐ ACS ☐  
DATE: 04/10/2020

**VERDE DESIGN**  
LANDSCAPE ARCHITECTURE  
CIVIL ENGINEERING  
SPORT PLANNING & DESIGN  
1843 Iron Point Rd #140  
Folsom, CA 95630  
tel: 916.415.6554  
fax: 408.985.7260  
www.VerdeDesignInc.com

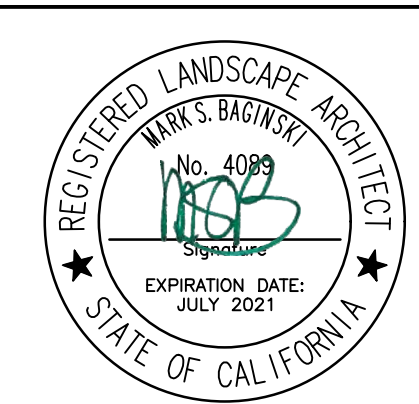

CONSULTANT

KEYMAP

SHEET TITLE

**BASEBALL  
CONSTRUCTION  
DETAILS**

PROJECT NAME

**CHAVEZ HIGH SCHOOL  
STOCKTON USD  
ATHLETIC FACILITY  
IMPROVEMENTS**

PROJECT ADDRESS

**2929 WINDFLOWER LN  
STOCKTON, CA 95212**

SUBMITTAL

DATE

DD/50% SUBMITTAL 10/25/19

DSA SUBMITTAL 12/20/19

DSA BACKCHECK SUBMITTAL 03/27/20

NO. REVISIONS DATE

1

2

3

</





CONSULTAN

KEYMA

SHEET TITLE

PROJECT NAME

PROJECT ADDRESS

SHEET NO.



NT



NOTES:  
ALL CLAY LAYERS TO BE TAMPED AND COMPACTED PRIOR TO NEXT LEVEL INSTALL



NTS




Y:\Projects-F0\2018\50000 - Chavez Restari\CAD\05.0-Baseball.dwg

Y:\Projects-F0\2018\190900 - Chavez Restari\CAD\05.0-Basebld.dwg



NT

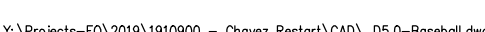

Y:\Projects-F0\2018\50000 - Chever Restor\CAD\DS-Baseball.dwg



**A** BUILDING THIRD BASE (FINES)



INFILL FINES TO BE INSTALLED  $1\frac{3}{4}$ " ABOVE EDGE BAND OR EQUAL TO SYNTHETIC TURF INFILL LEVEL.



NITS

NOTES:

1. LOCATE FRONT EDGE OF PLATE 18" BEHIND CENTER OF MOUND.
2. PITCHING MOUND HEIGHT PER OFFICIAL BASEBALL RULES.
3. DISTANCE FROM FRONT OF PITCHING PLATE TO BACK OF HOME PLATE TO BE 60'-0".
4. INSTALL PITCHER'S PLATE PER MANUFACTURER'S SPECIFICATIONS.
5. REFER TO PITCHER'S MOUND SECTION





NIT







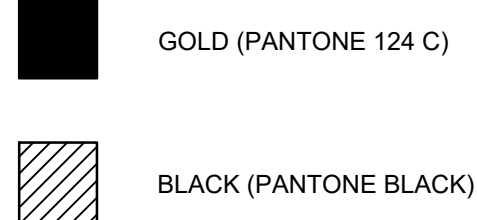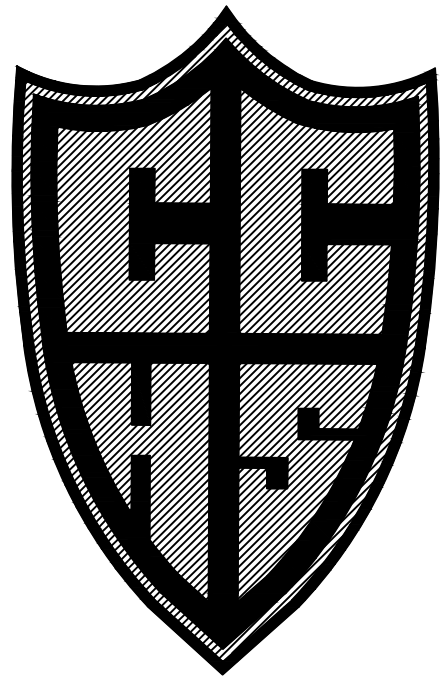

DIGITAL IMAGE TO BE PROVIDED TO PAINTING CONTRACTOR FOR FINAL PRODUCTION.

#### PROJECT DATA:


CONSTRUCTION TYPE:  
OCCUPANCY GROUP:  
AREA CALCULATIONS:

V-B  
A-5, S-2  
536 S.F.  
128 S.F.  
536 S.F.  
128 S.F.  
120 S.F.

FIRST BASE DUGOUT  
FIRST BASE STORAGE  
THIRD BASE DUGOUT  
THIRD BASE STORAGE  
THIRD BASE PRESSBOX


#### 1 SCHOOL LOGO

SCALE: N.T.S.

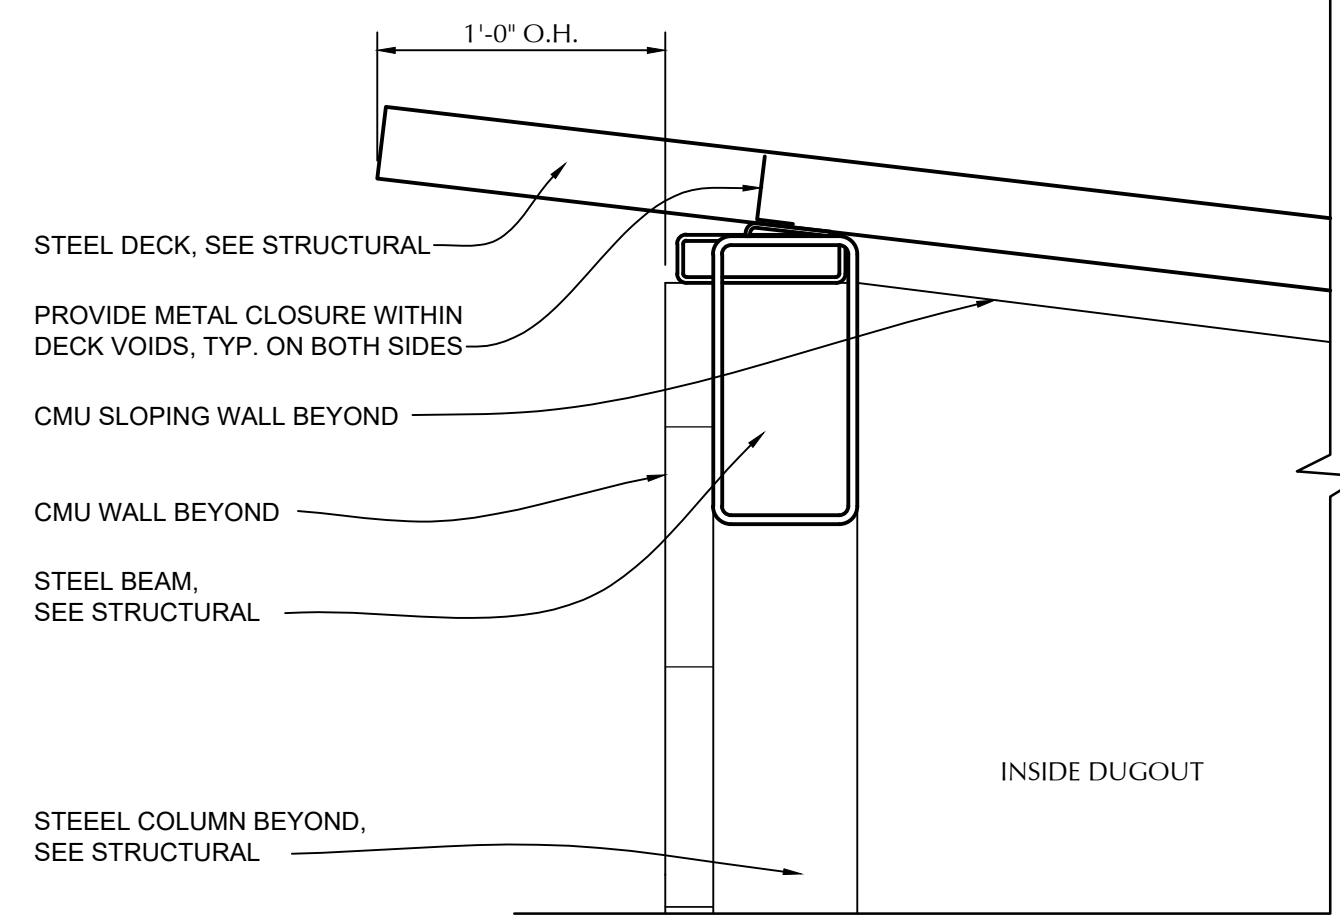


#### 2 EAVE DETAIL

SCALE: 1 1/2"= 1'-0"

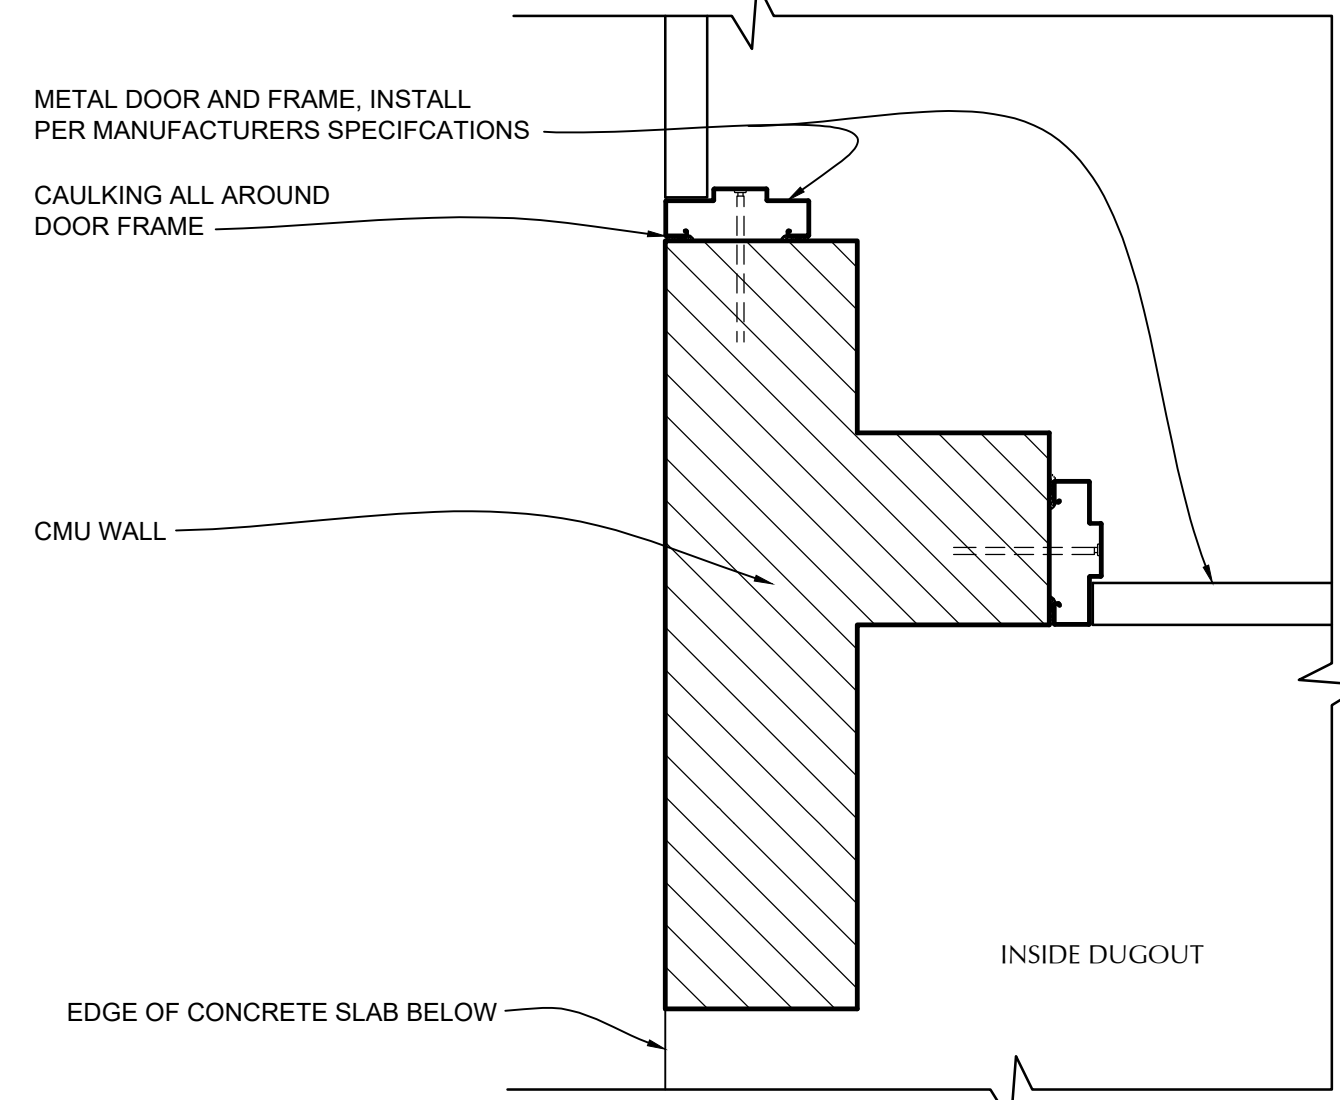

#### 3 MAN DOOR JAMB DETAIL

SCALE: 1 1/2"= 1'-0"

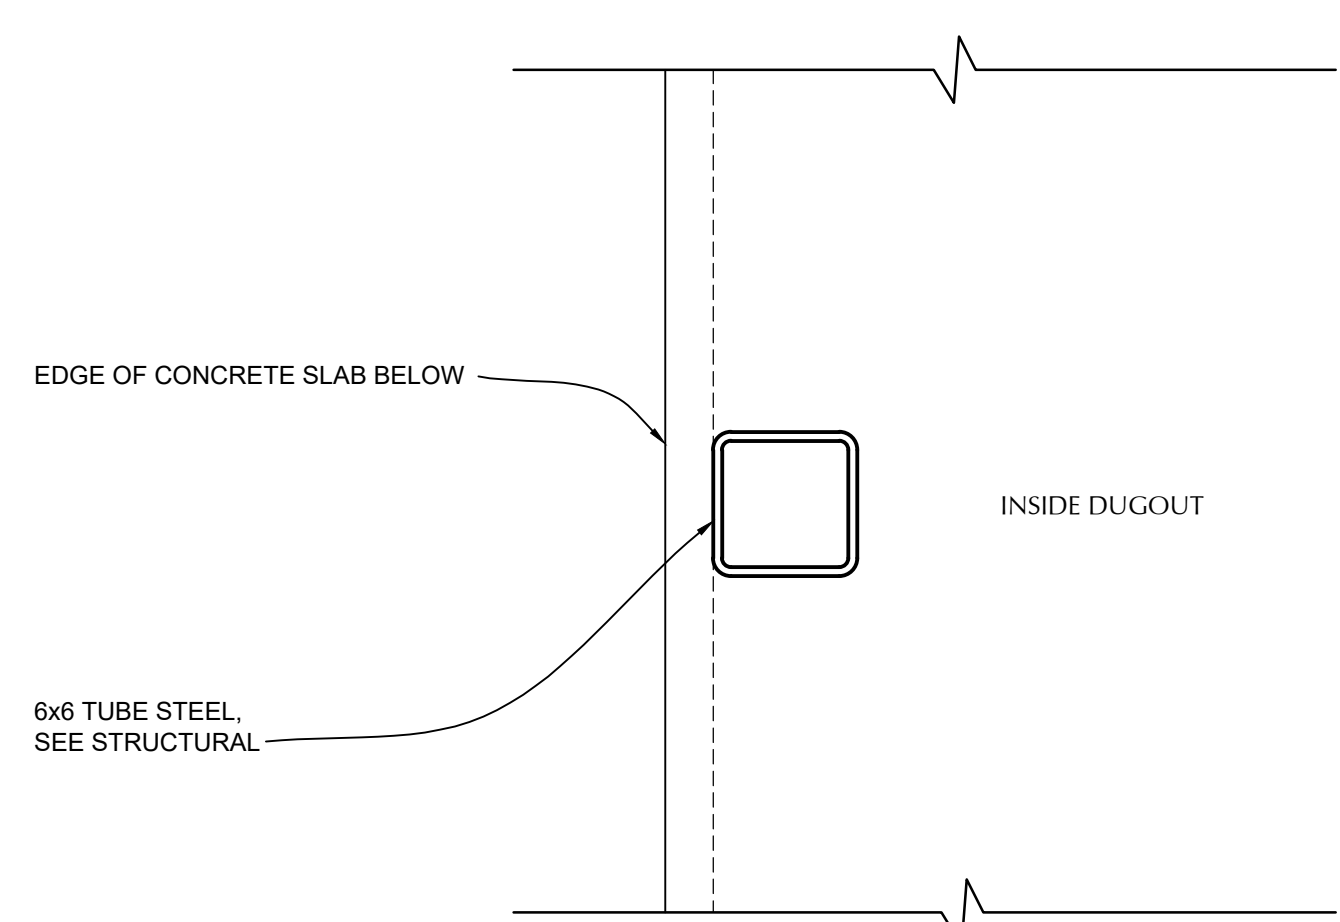

#### 4 MID COLUMN SUPPORT

SCALE: 1 1/2"=1'-0"

| DOOR AND FRAME SCHEDULE |       |        |           |                |        |      |
|-------------------------|-------|--------|-----------|----------------|--------|------|
| DOOR NO.                | DOOR  |        |           | FRAME MATERIAL | RATING |      |
|                         | WIDTH | HEIGHT | THICKNESS |                |        |      |
| A                       | 3'-0" | 7'-0"  | 1 3/4"    | MTL.           | STEEL  | NONE |


#### DOOR NOTES:

- CONTRACTOR SHALL VERIFY ALL DOOR SIZES & ROUGH OPENINGS IN FIELD PRIOR TO ORDERING
- VERIFY ALL DOORS, FRAMES, AND HARDWARE WITH OWNER
- DOOR HARDWARE AT ALL EXIT DOORS SHALL ALLOW DOORS TO BE OPENED FROM THE INSIDE WITHOUT KEY, SPECIAL KNOWLEDGE, OR EFFORT, PER U.S.C. SEC. 10043.
- MAXIMUM DOOR OPENING EFFORTS SHALL BE: 5 LBS. AT EXTERIOR DOORS, 5 LBS. AT INTERIOR DOORS
- ALL DOORS SHALL BE EQUIPPED WITH SINGLE EFFORT, NON-GRASP HARDWARE (i.e. LEVER) CENTERED BETWEEN 30" AND 44" ABOVE THE FLOOR
- ALL DOORS SHALL HAVE A 10" HIGH MINIMUM FLAT SURFACE AT THE DOOR BOTTOM TO BE USED AS A KICKPLATE, NO GLAZING
- DOORS SHALL HAVE KEYED PRIVACY HARDWARE AND SECURITY DEADBOLT
- NONE OF THE DOORS SHALL BE EQUIPPED WITH THRESHOLDS

#### 5 DOOR FRAME AND SCHEDULE


SCALE: N.T.S.

#### A THIRD BASE DUGOUT WITH PRESSBOX / PLANS AND ELEVATIONS

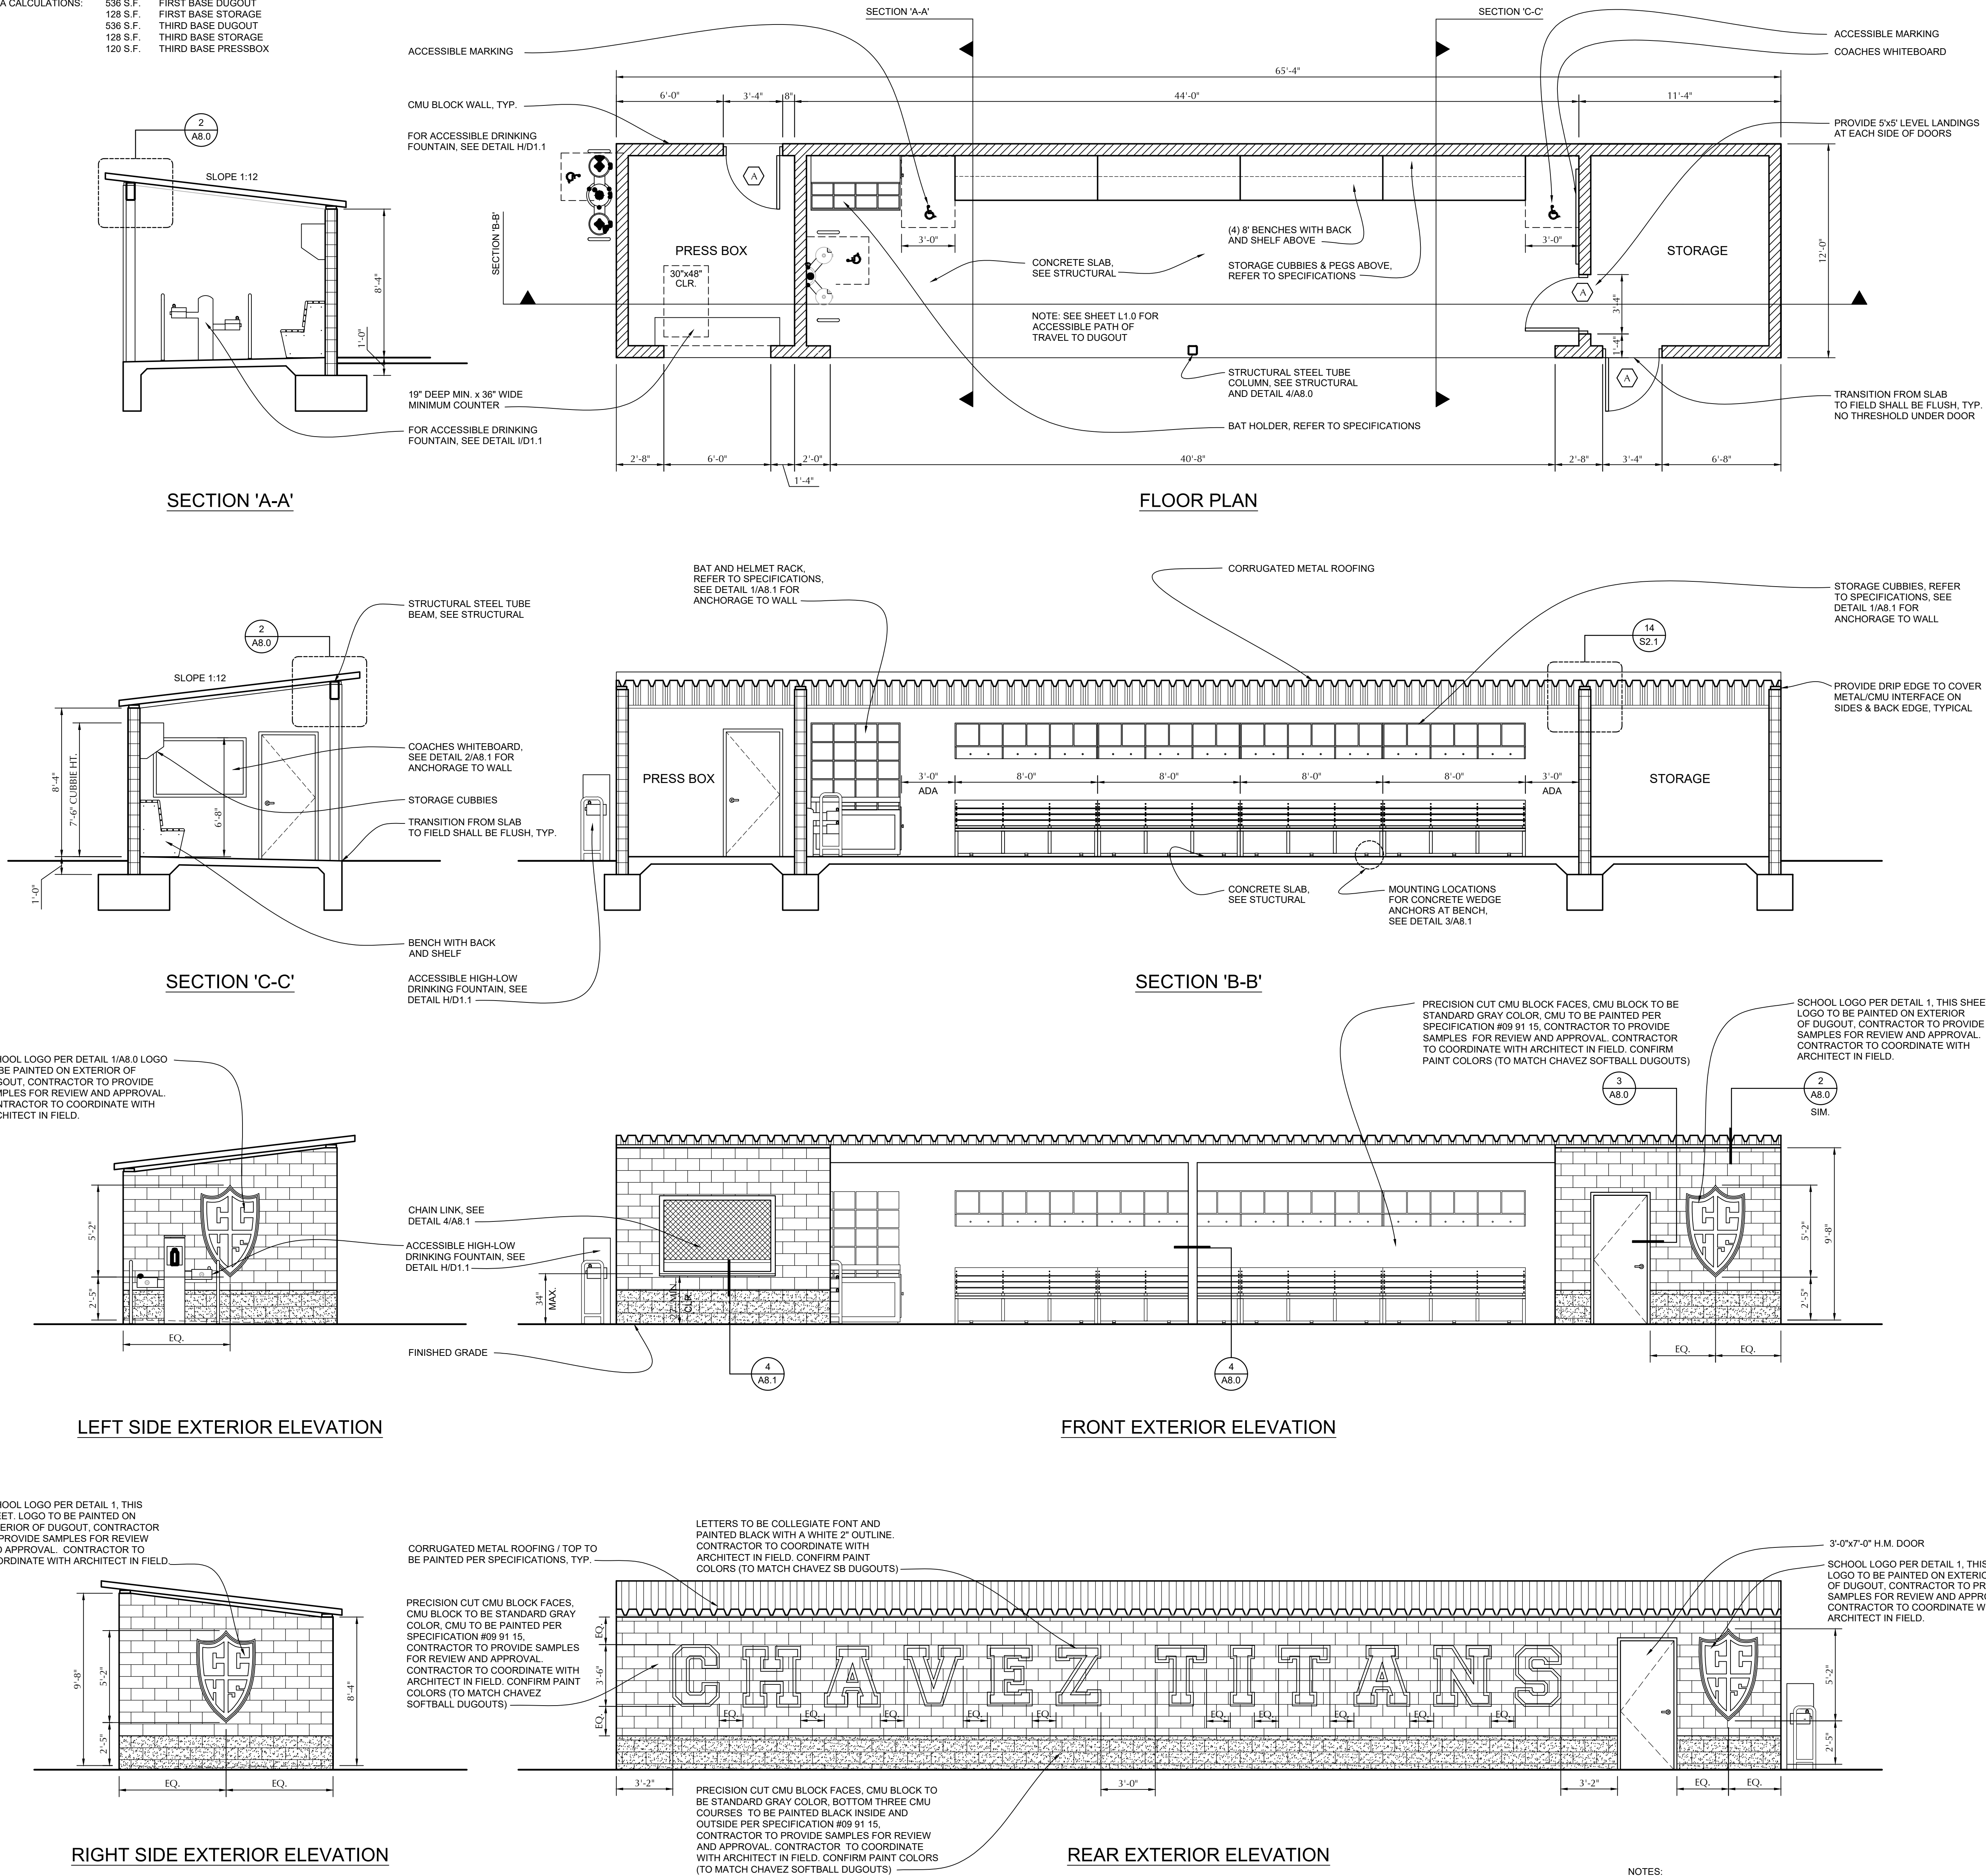

#### NOTES:

- APPLY BLOCK FILLER PRIOR TO PAINTING, REFER TO SPECIFICATIONS
- REFER TO STRUCTURAL DRAWINGS FOR MORE INFORMATION
- REFER TO ELECTRICAL DRAWINGS FOR OUTLET AND LIGHTING INFORMATION

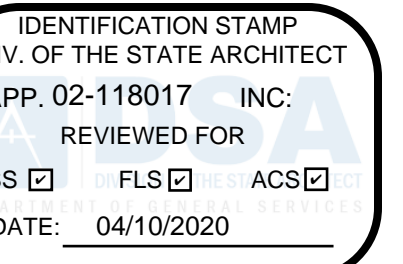


**VERDE DESIGN**  
LANDSCAPE ARCHITECTURE  
CIVIL ENGINEERING  
SPORT PLANNING & DESIGN  
1843 Iron Point Rd #140  
Folsom, CA 95630  
Tel: 916.415.6554  
Fax: 916.415.6554  
www.VerdeDesignInc.com




CONSULTANT



**WILLIAM C. KEMPf**  
ARCHITECT  
911 Center Street, Suite F  
Santa Cruz, CA 95060  
(831) 450-0951  
www.wckempf.com

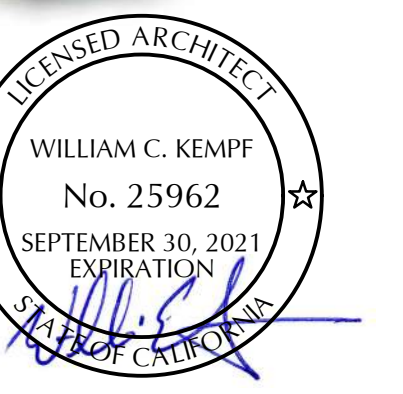

KEYMAP

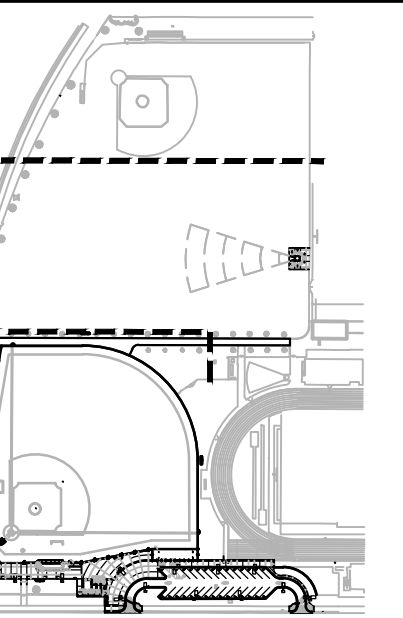

SHEET TITLE

**THIRD BASE DUGOUT  
PLANS & ELEVATIONS  
DETAILS**

PROJECT NAME

**CHAVEZ HIGH SCHOOL  
STOCKTON USD  
ATHLETIC FACILITY  
IMPROVEMENTS**

PROJECT ADDRESS

**2929 WINDFLOWER LN  
STOCKTON, CA 95212**

SUBMITTAL

DD/50% SUBMITTAL

10/25/19

DSA SUBMITTAL

12/20/19

DSA BACKCHECK SUBMITTAL

03/27/20

NO. REVISIONS DATE

1 1 10/25/19

2 2 12/20/19

3 3 03/27/20

4 4

5 5

6 6

222 222



223 223

224 224

225 225

226 226



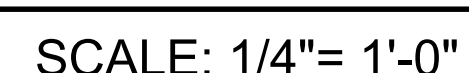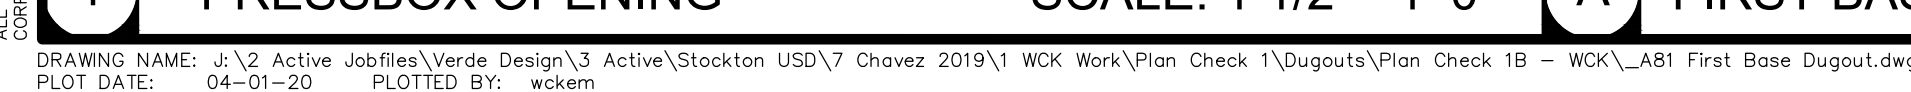































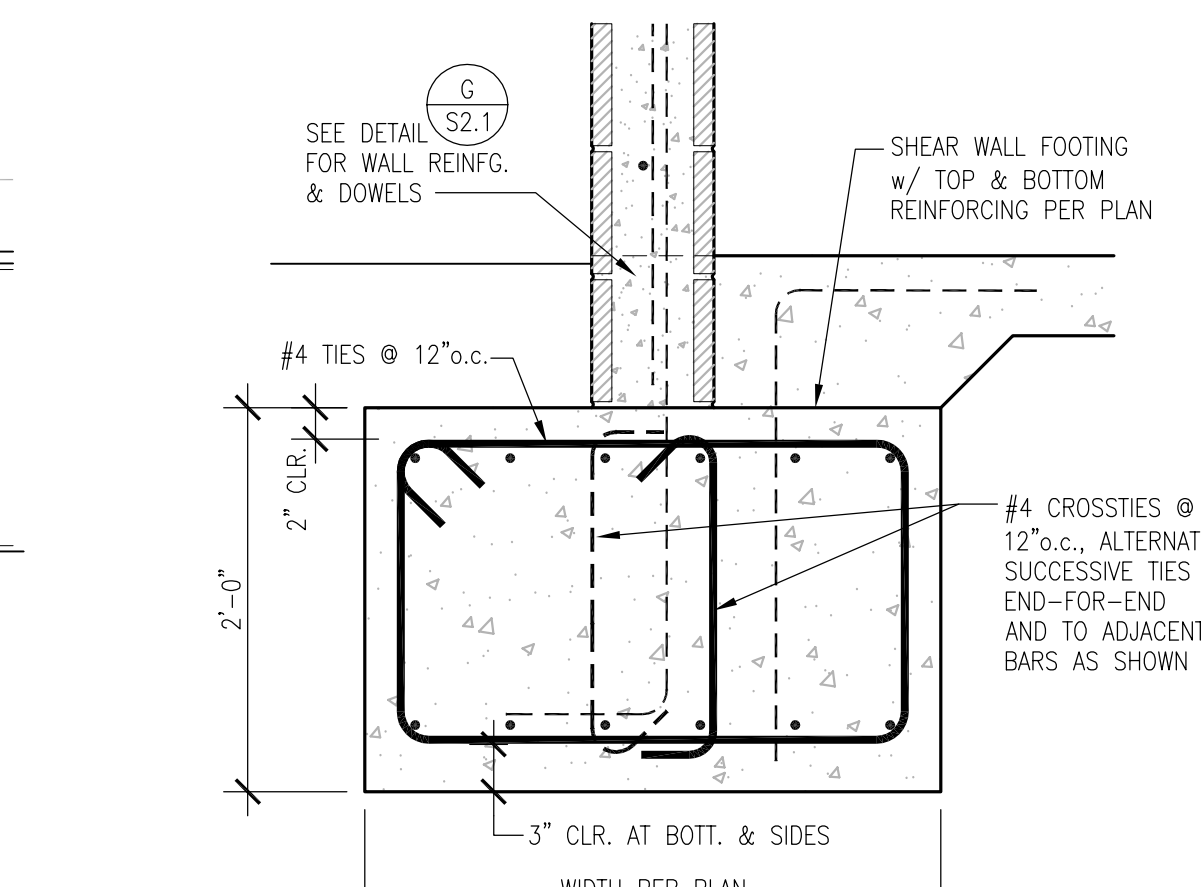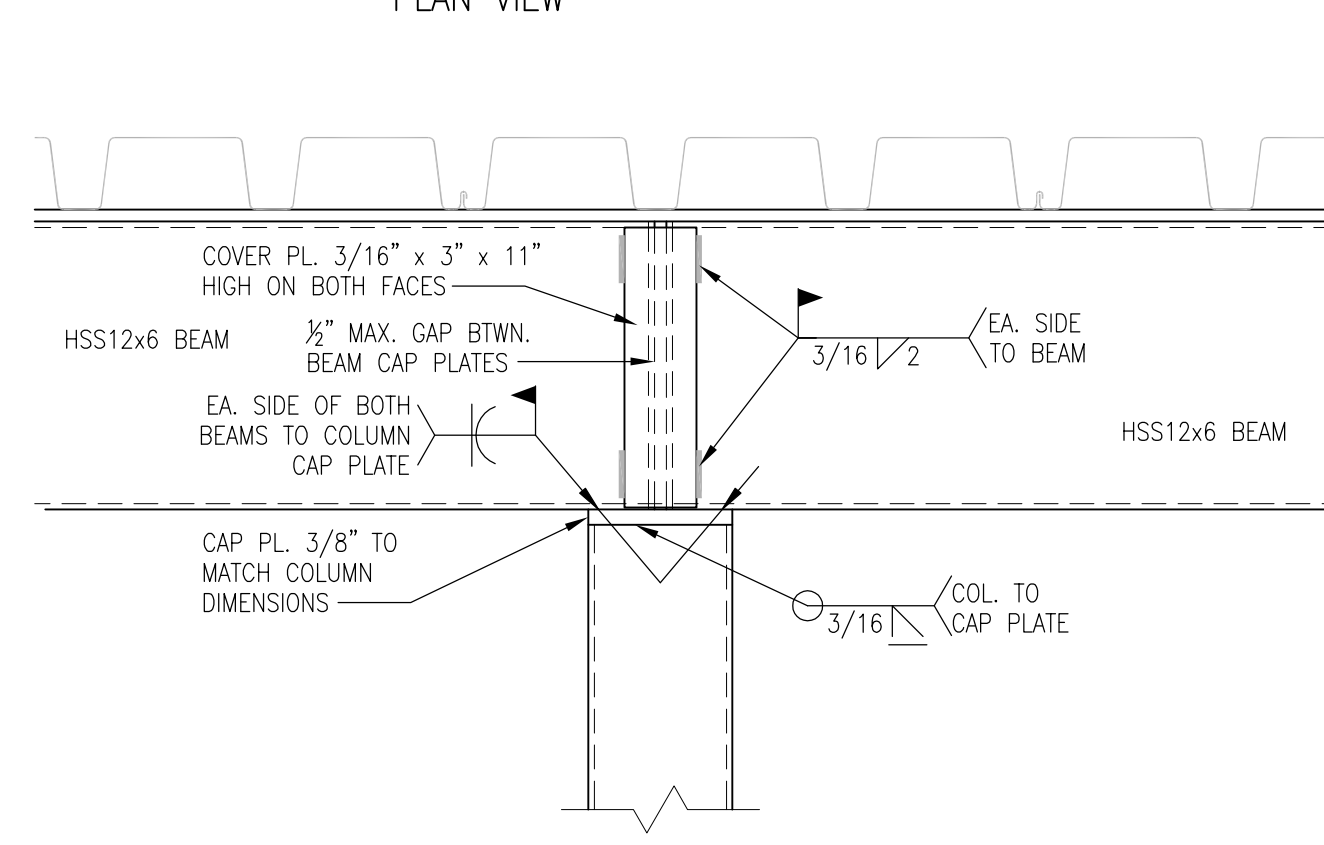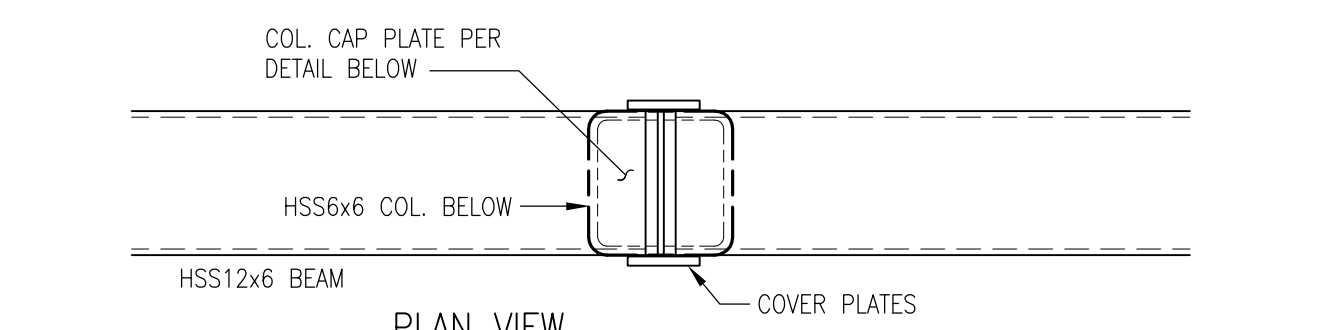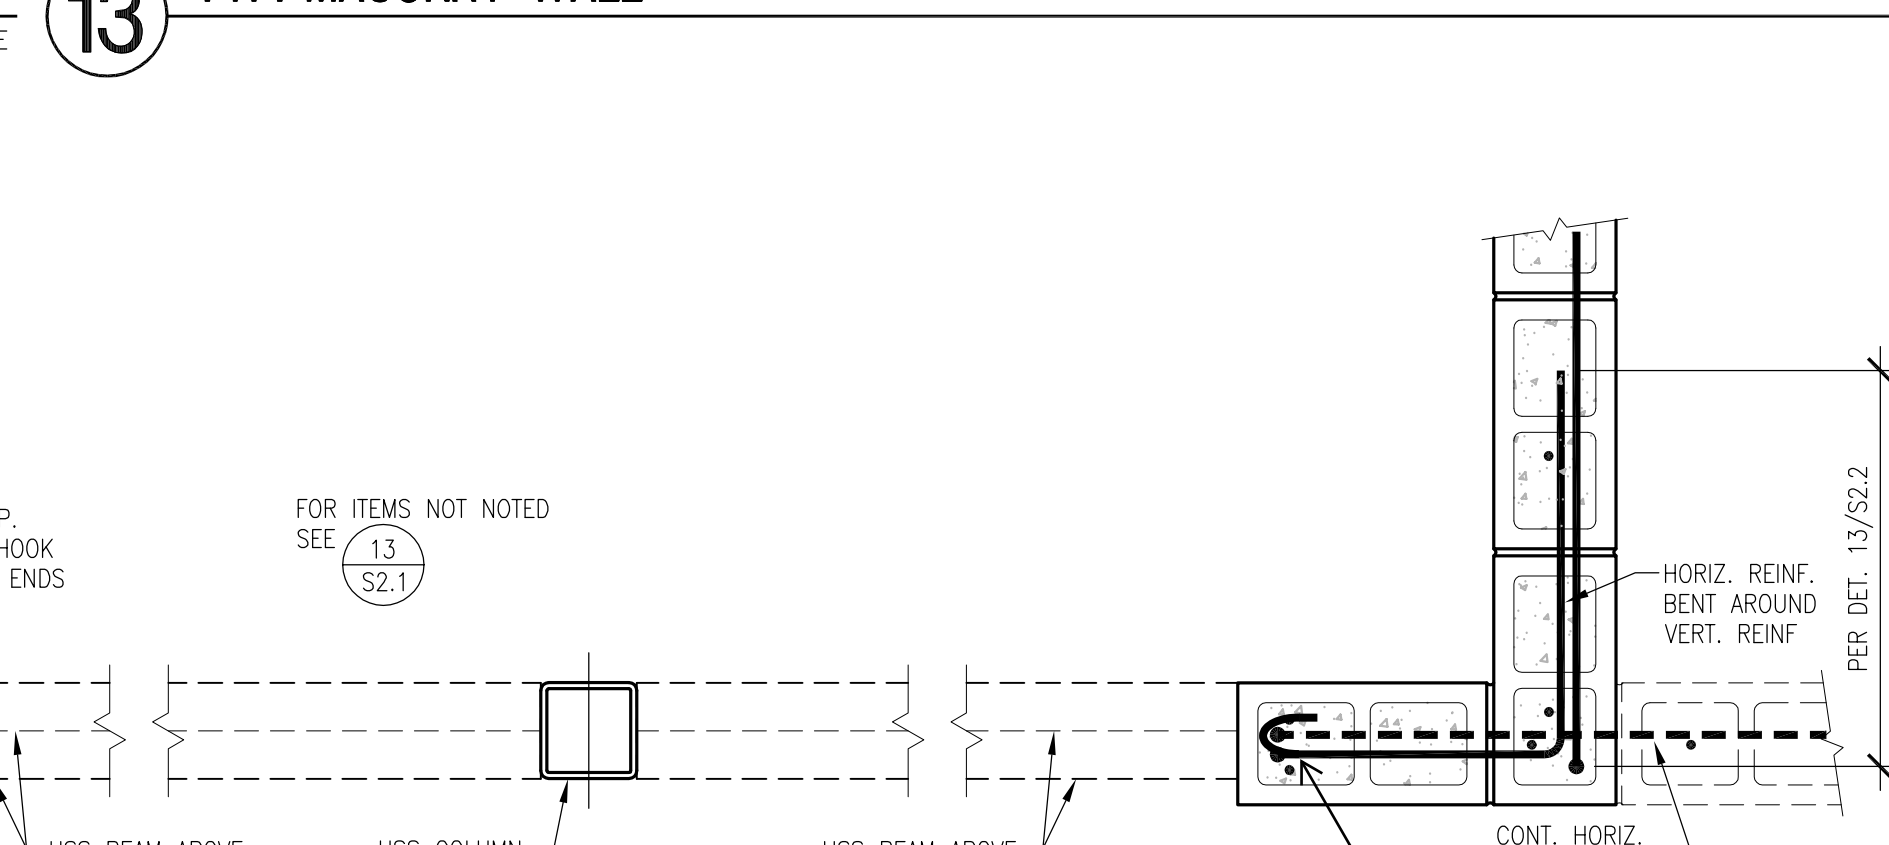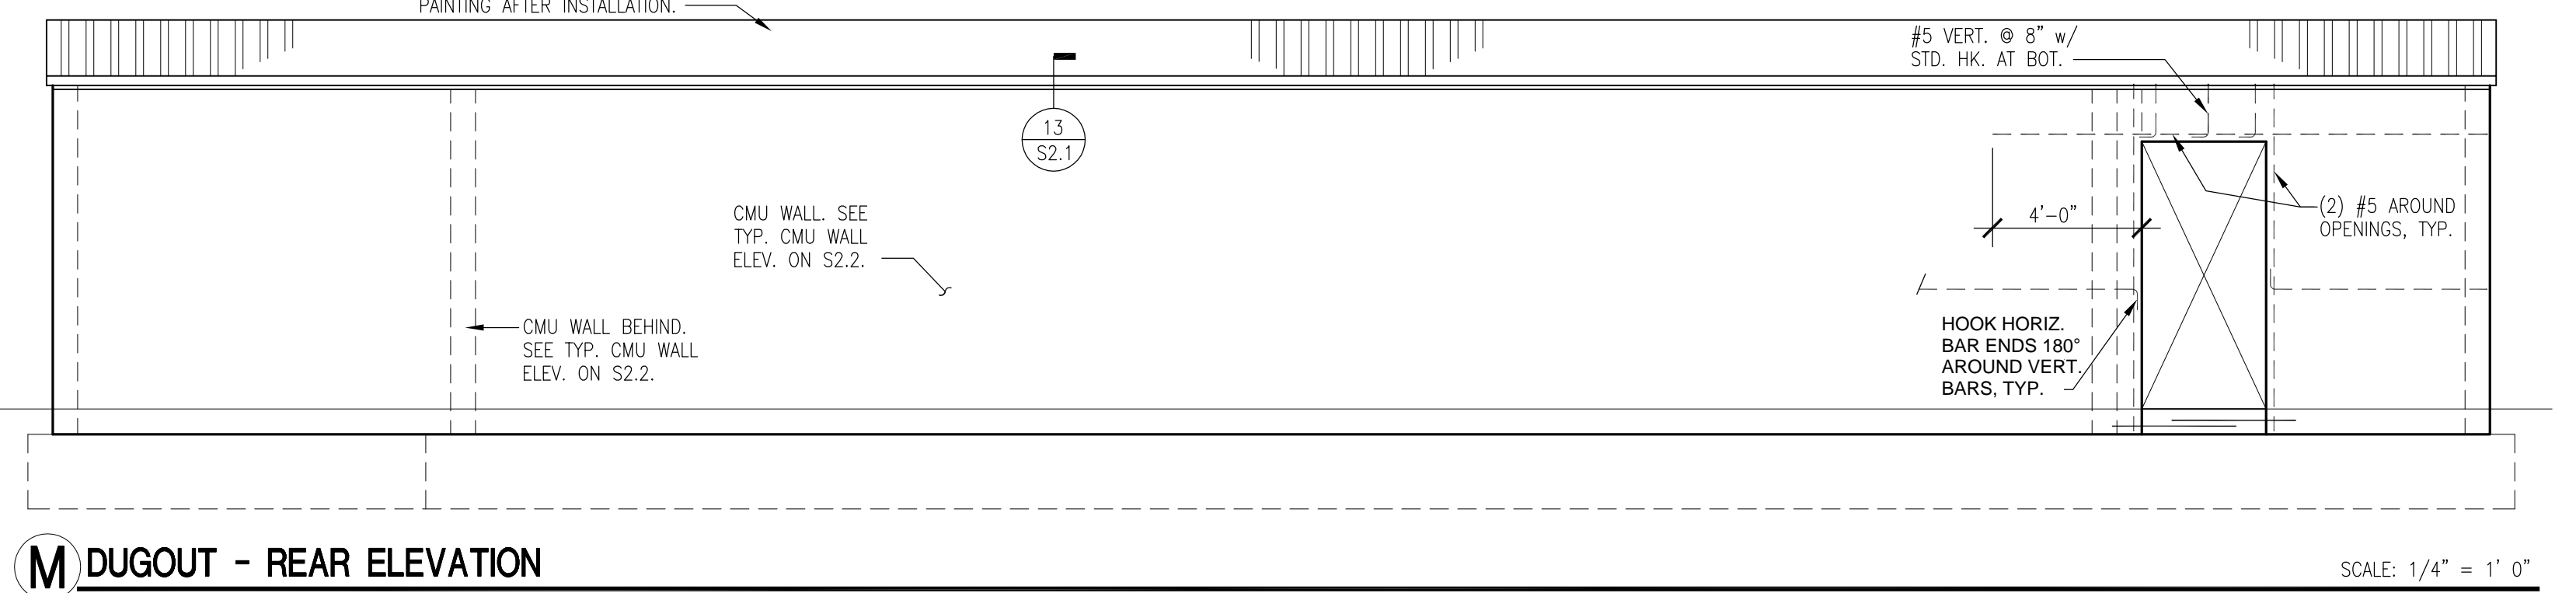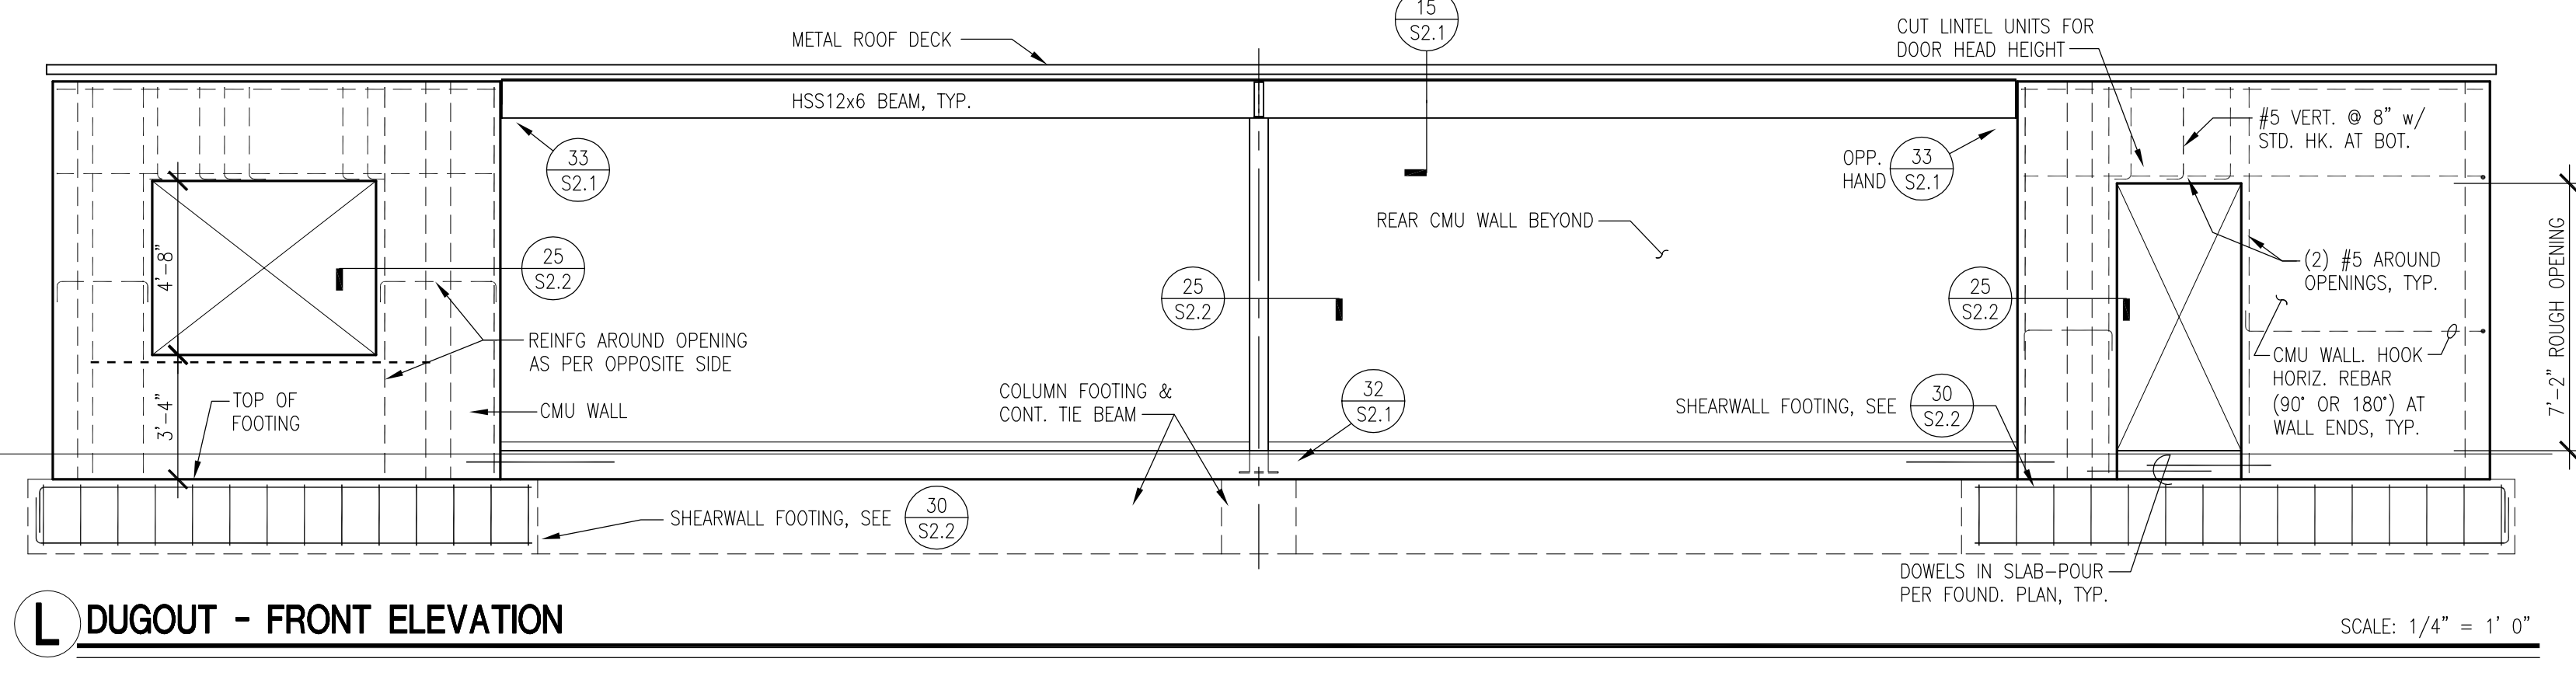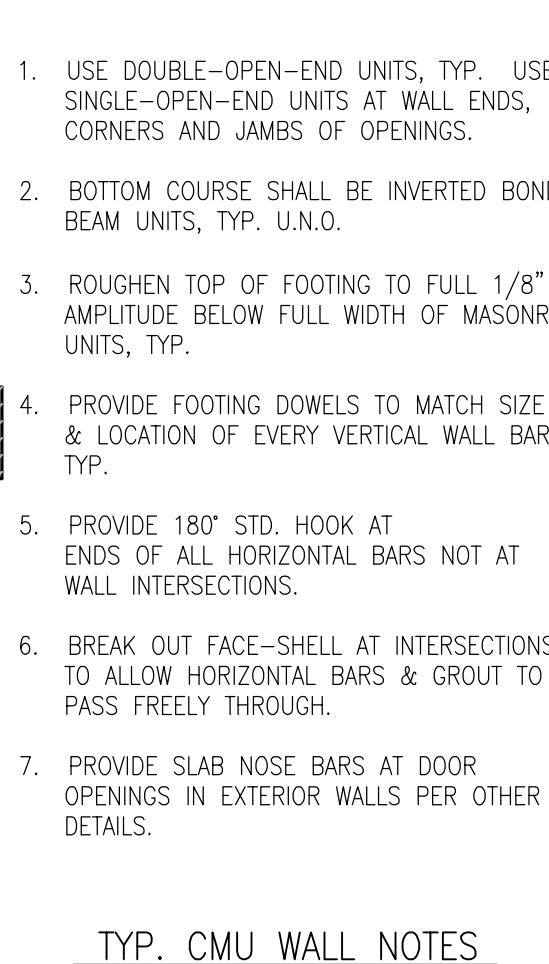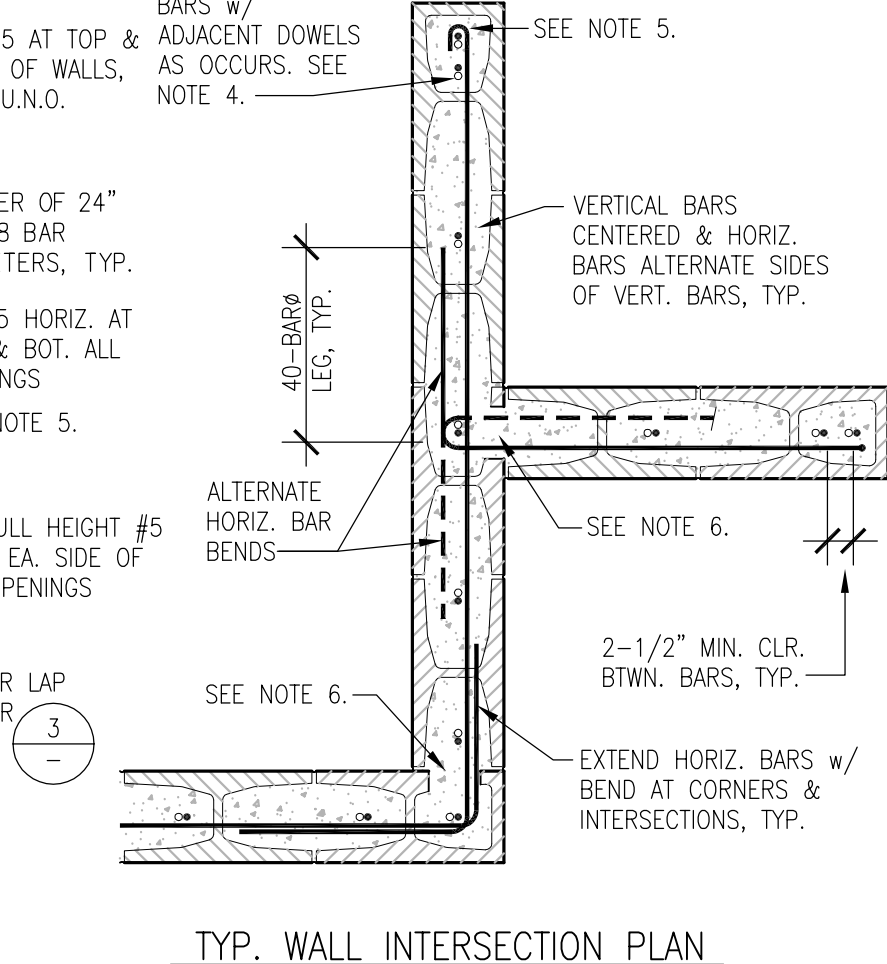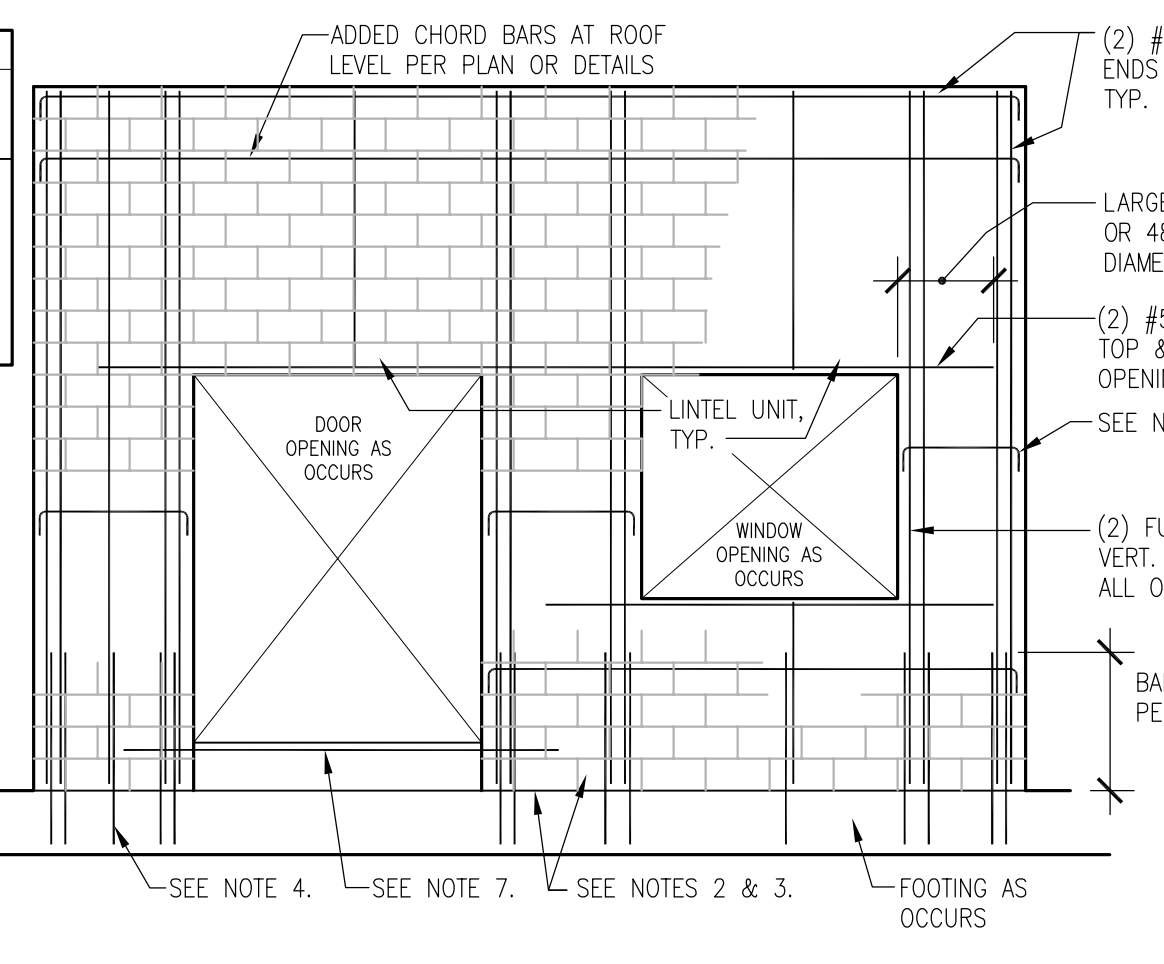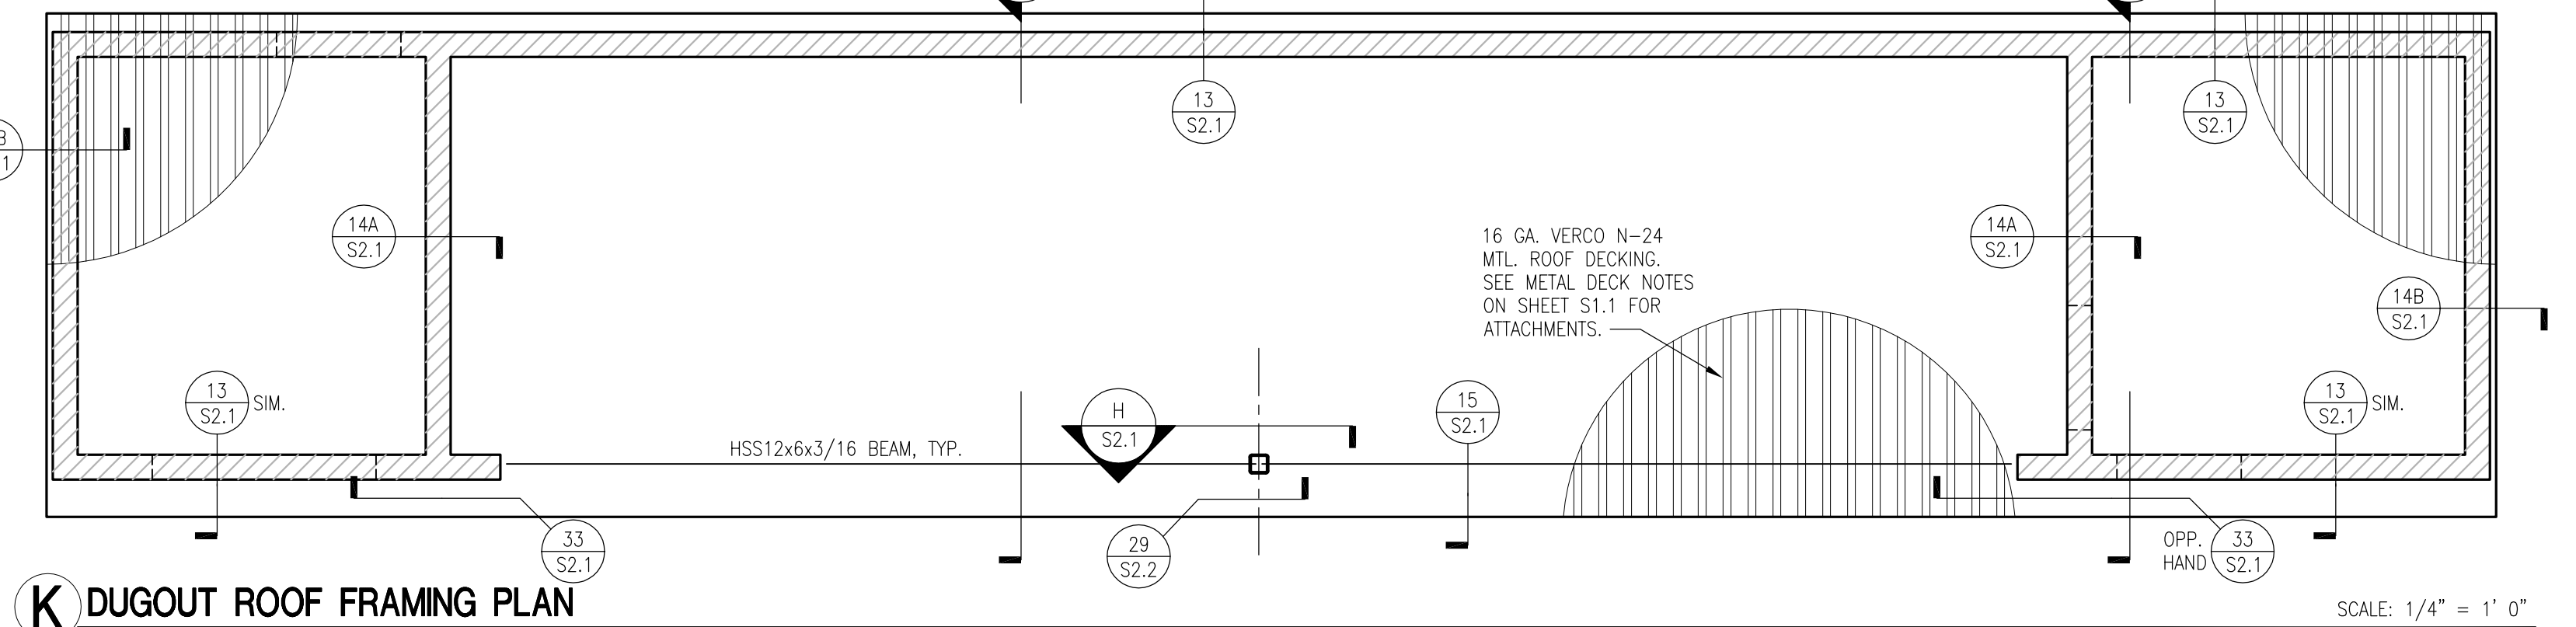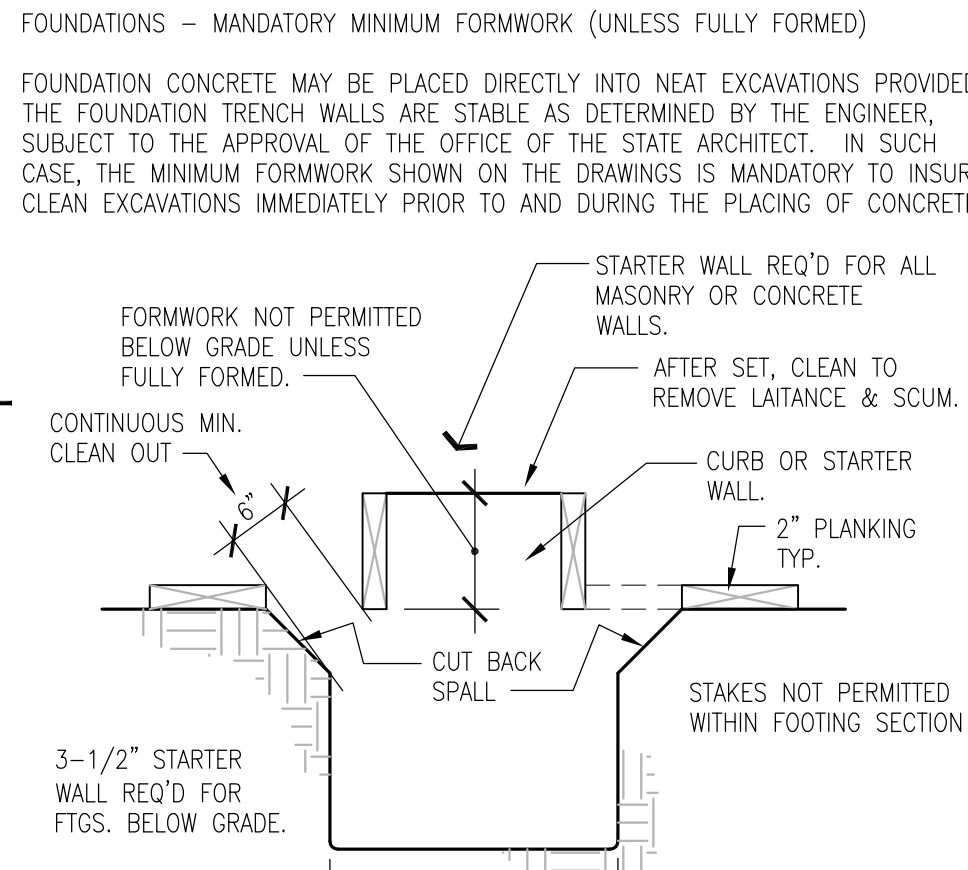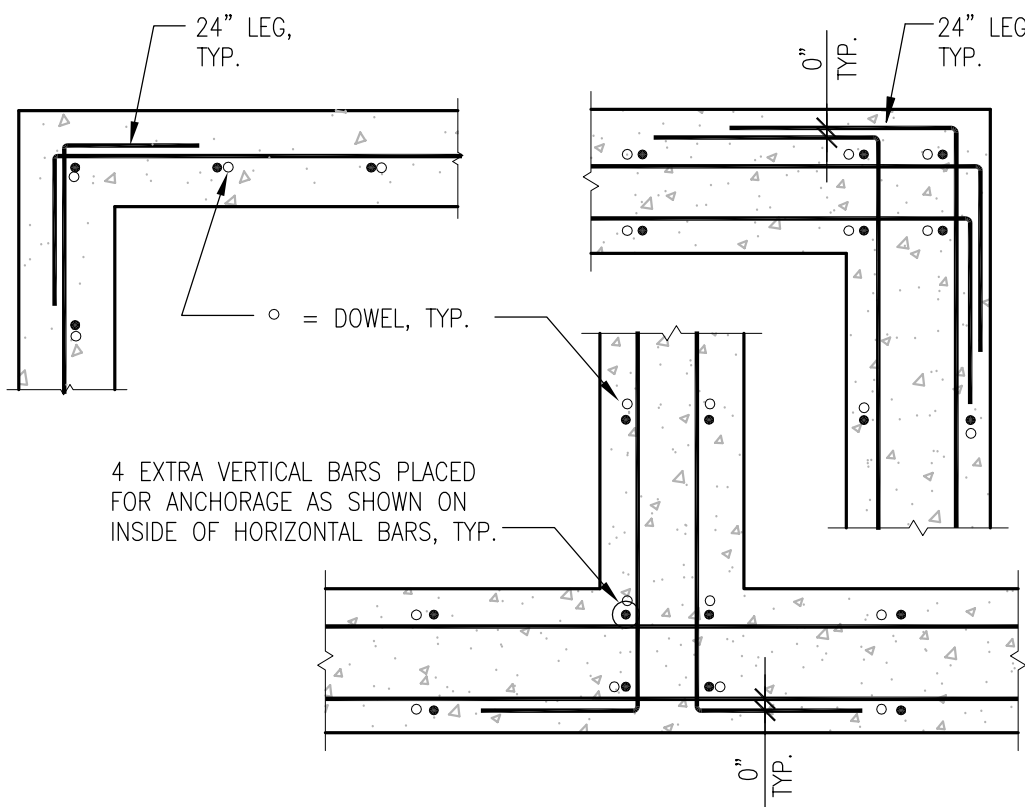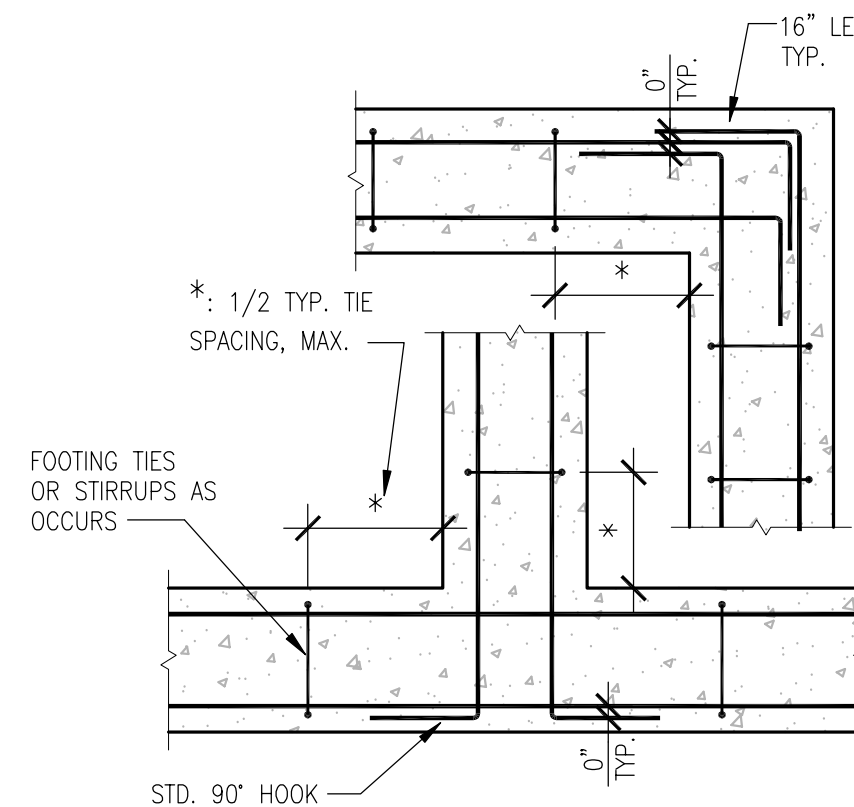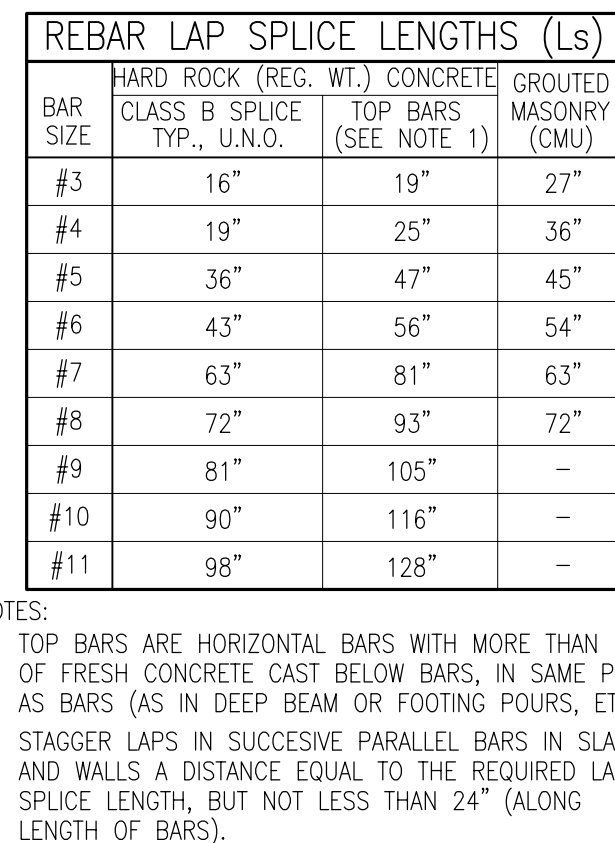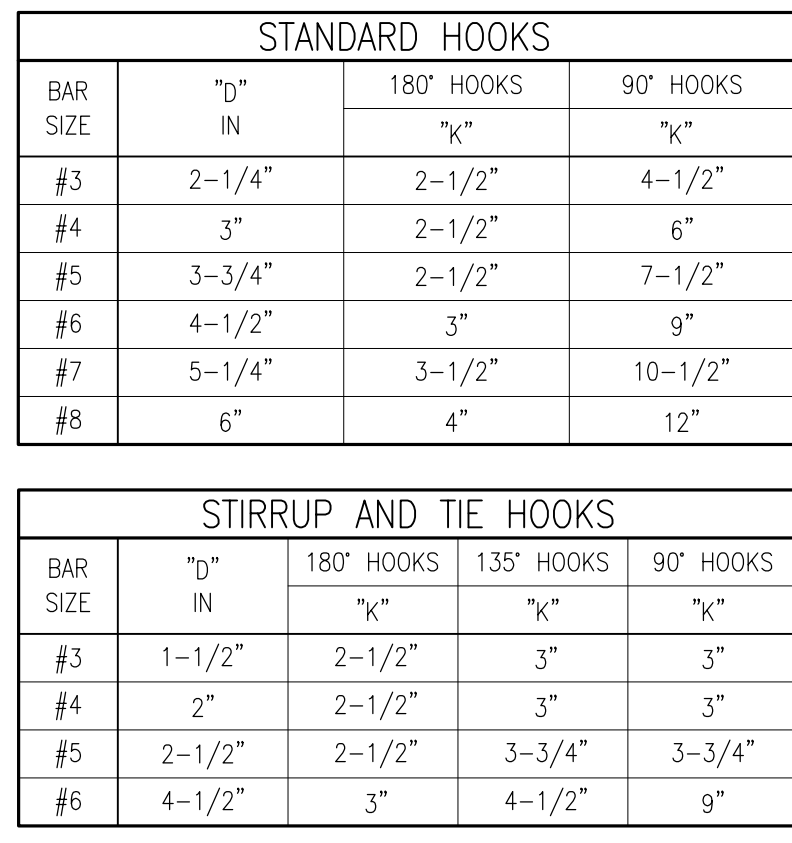



ALL DESIGN, DRAWING, AND CONSTRUCTION INFORMATION IS THE PROPERTY OF VERDE DESIGN, INC. AND IS NOT TO BE REPRODUCED, COPIED, OR TRANSMITTED IN ANY FORM OR BY ANY MEANS, WITHOUT THE WRITTEN PERMISSION OF VERDE DESIGN, INC. NO PART OF THIS DOCUMENT SHALL BE USED, REPRODUCED, OR PUBLISHED BY ANY METHOD, IN WHOLE OR IN PART, OR DISCLOSED TO ANY PERSON, FIRM, OR CORPORATION FOR ANY PURPOSE WITHOUT THE WRITTEN PERMISSION OF VERDE DESIGN, INC.

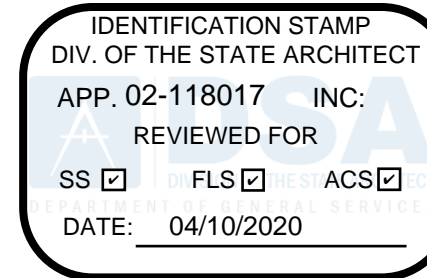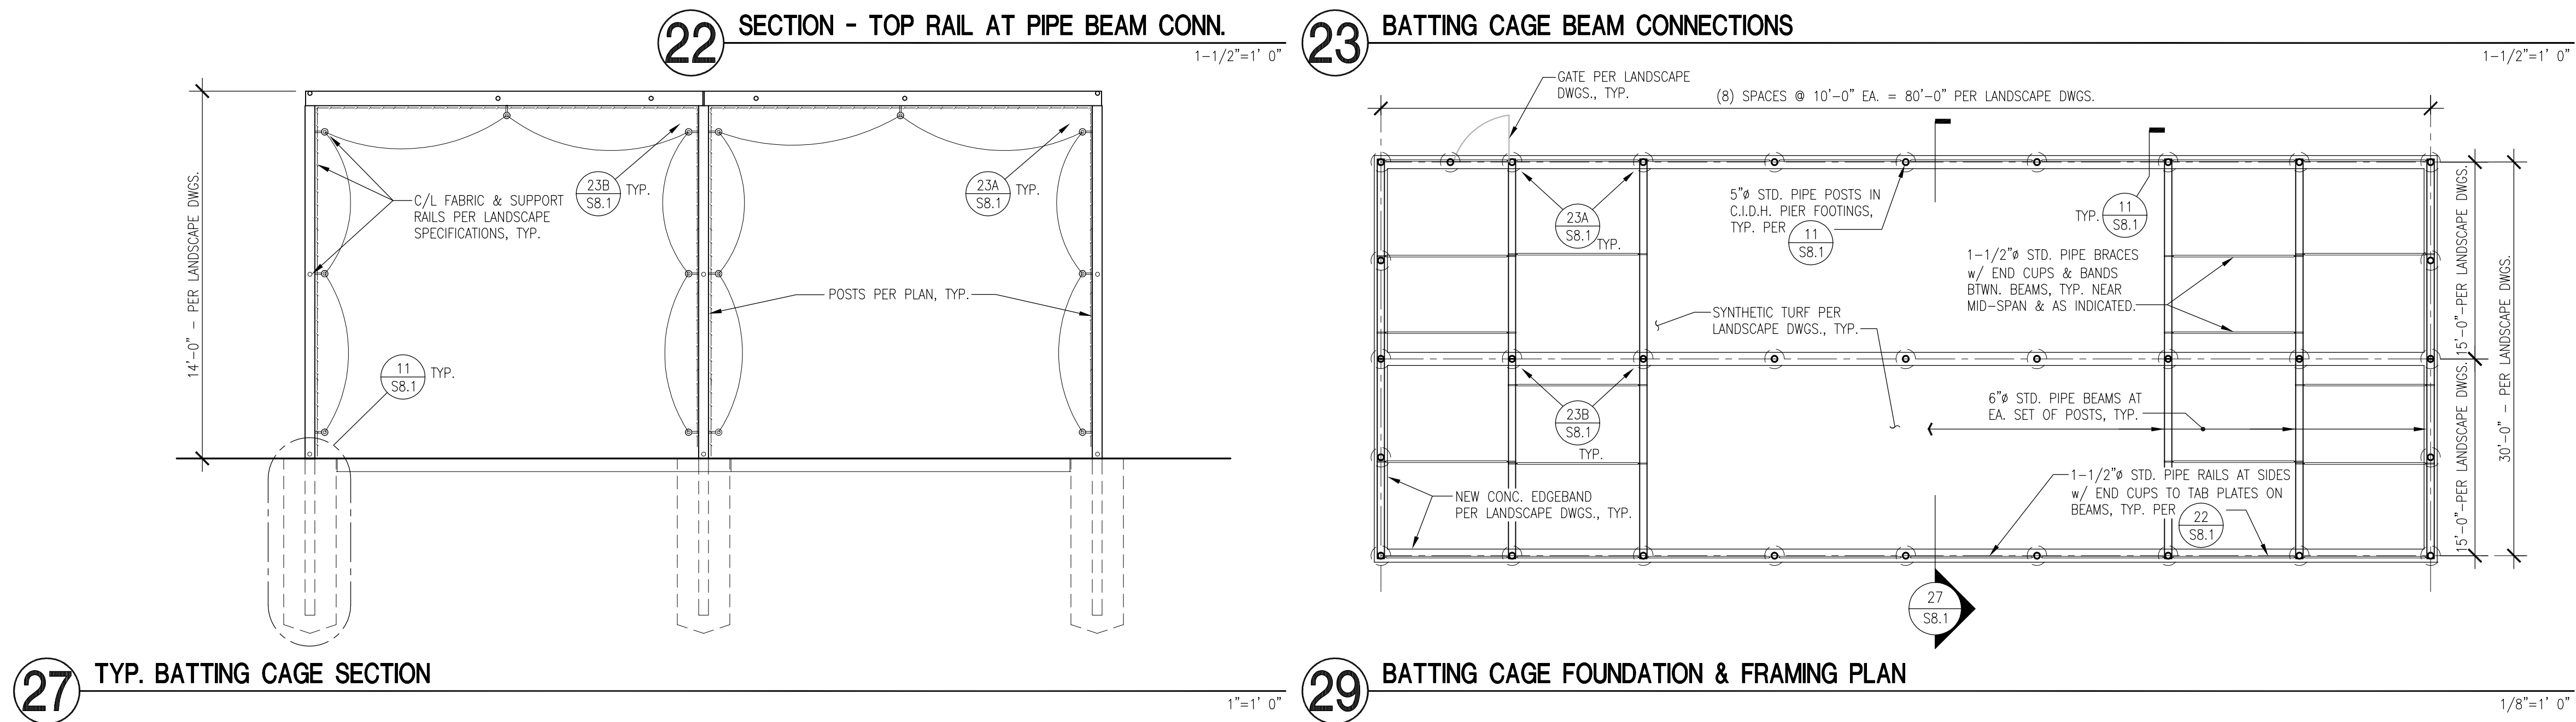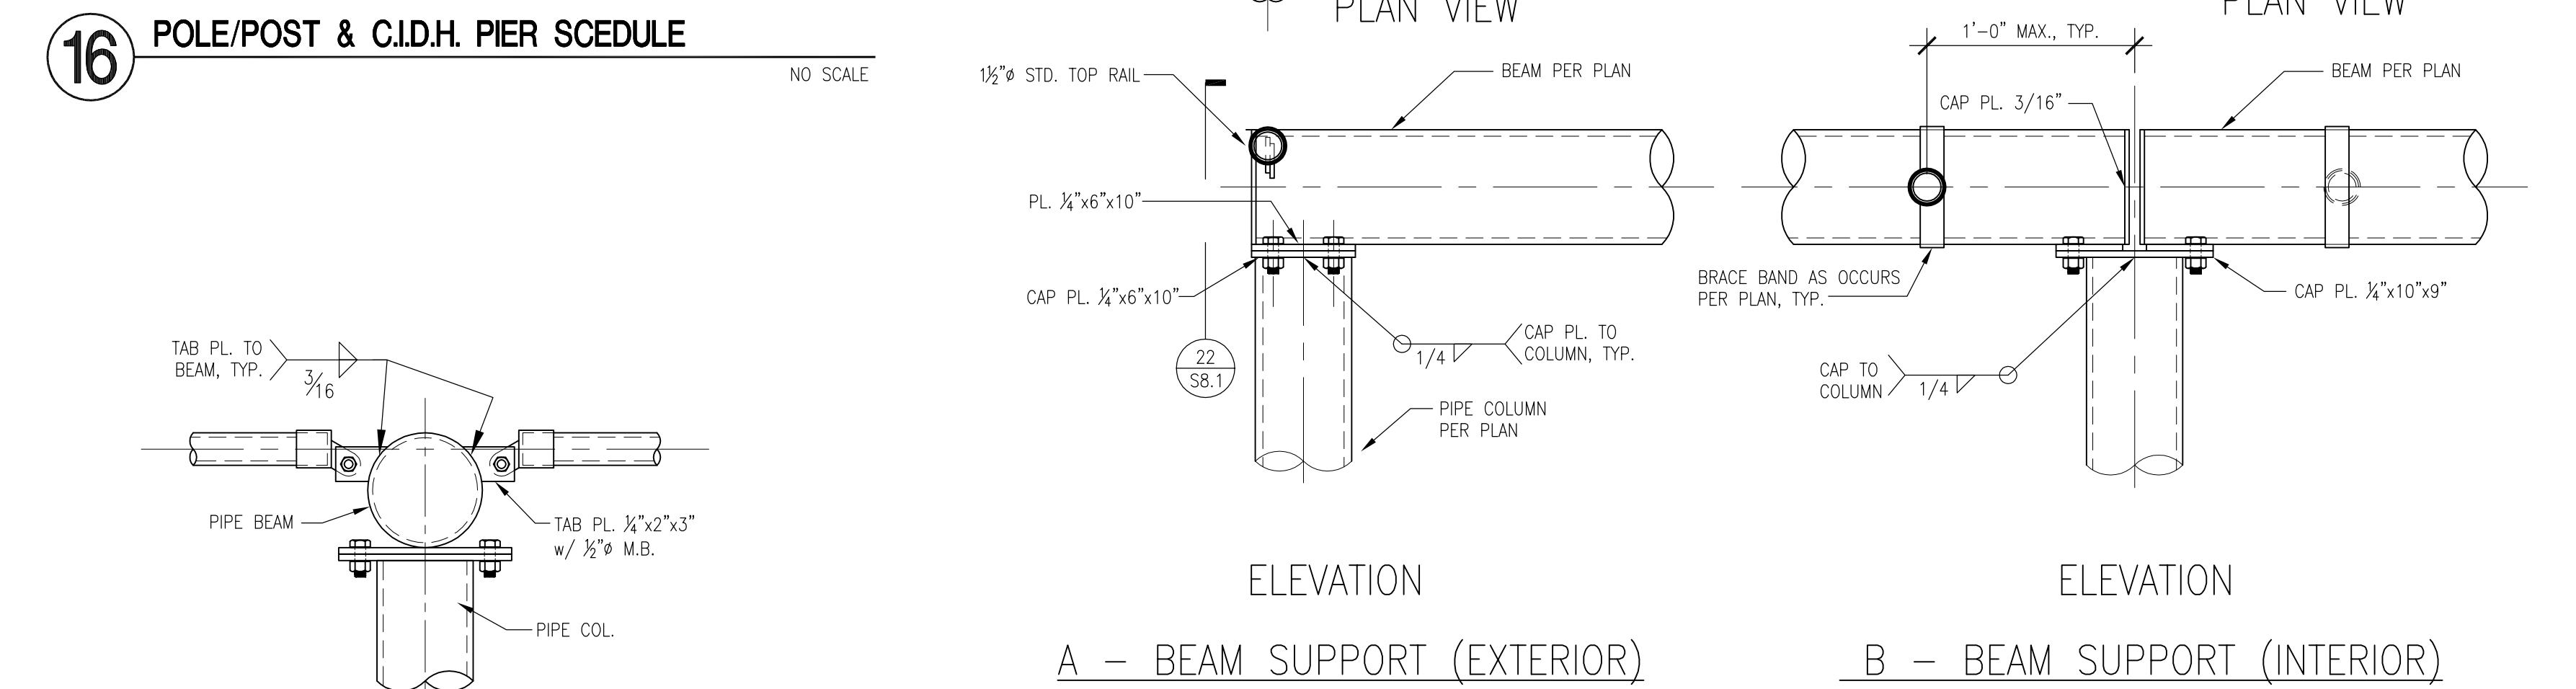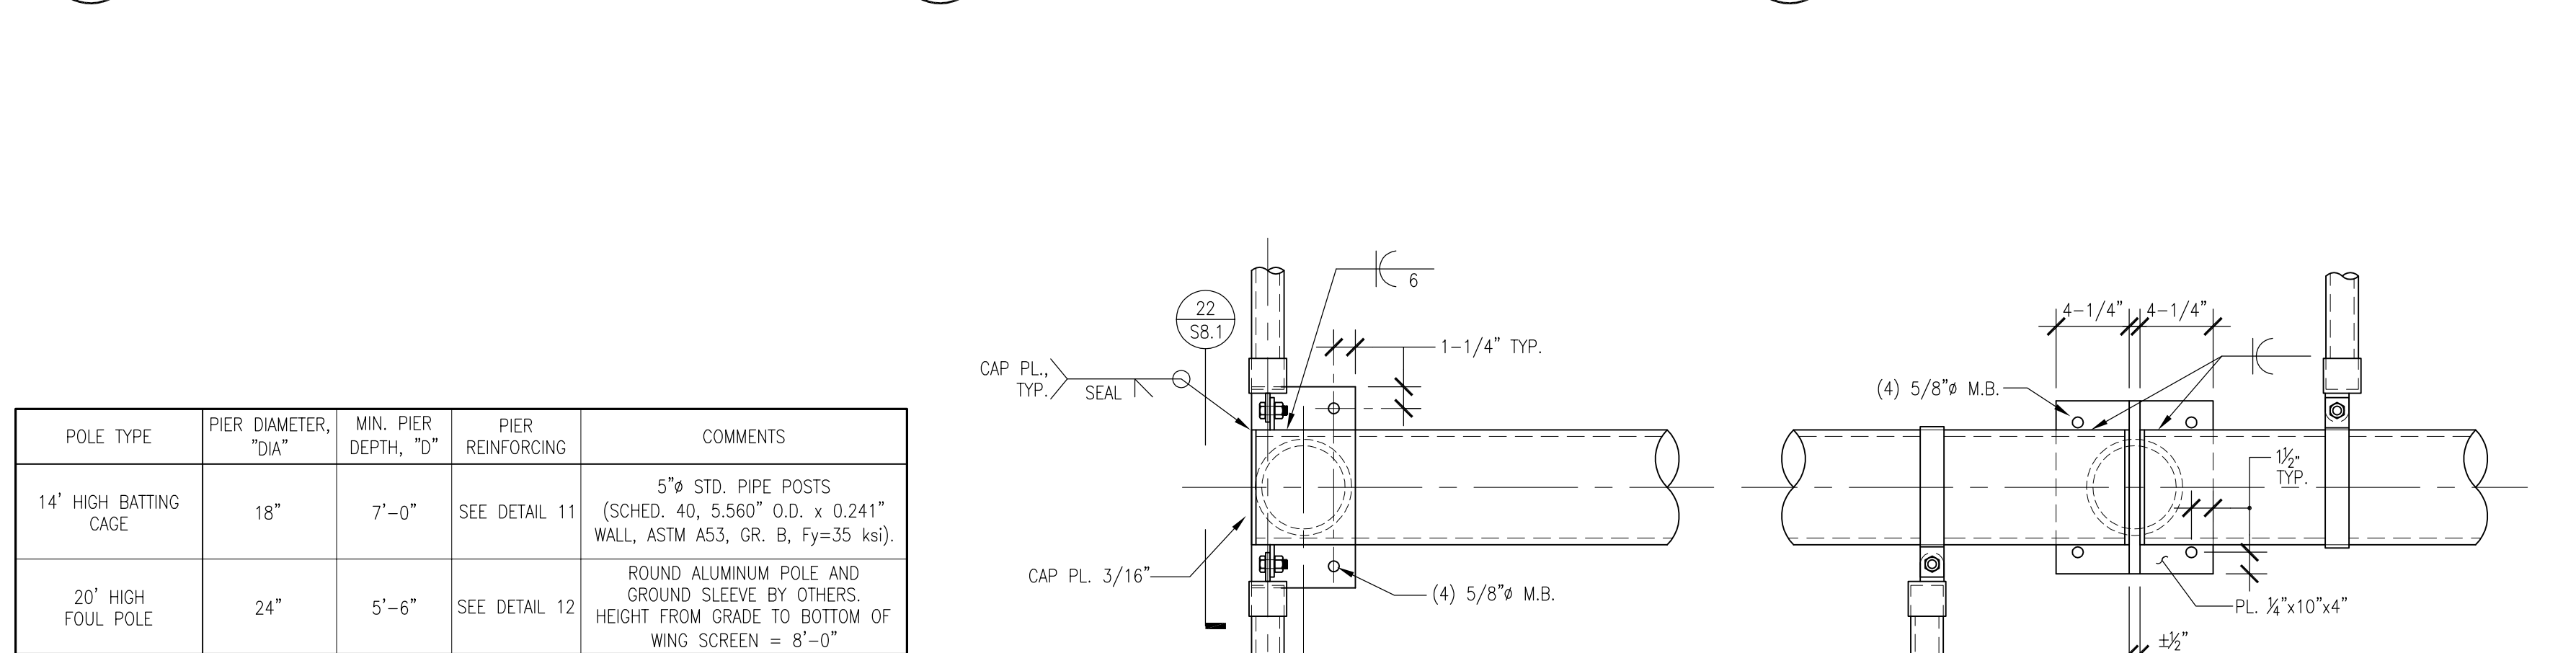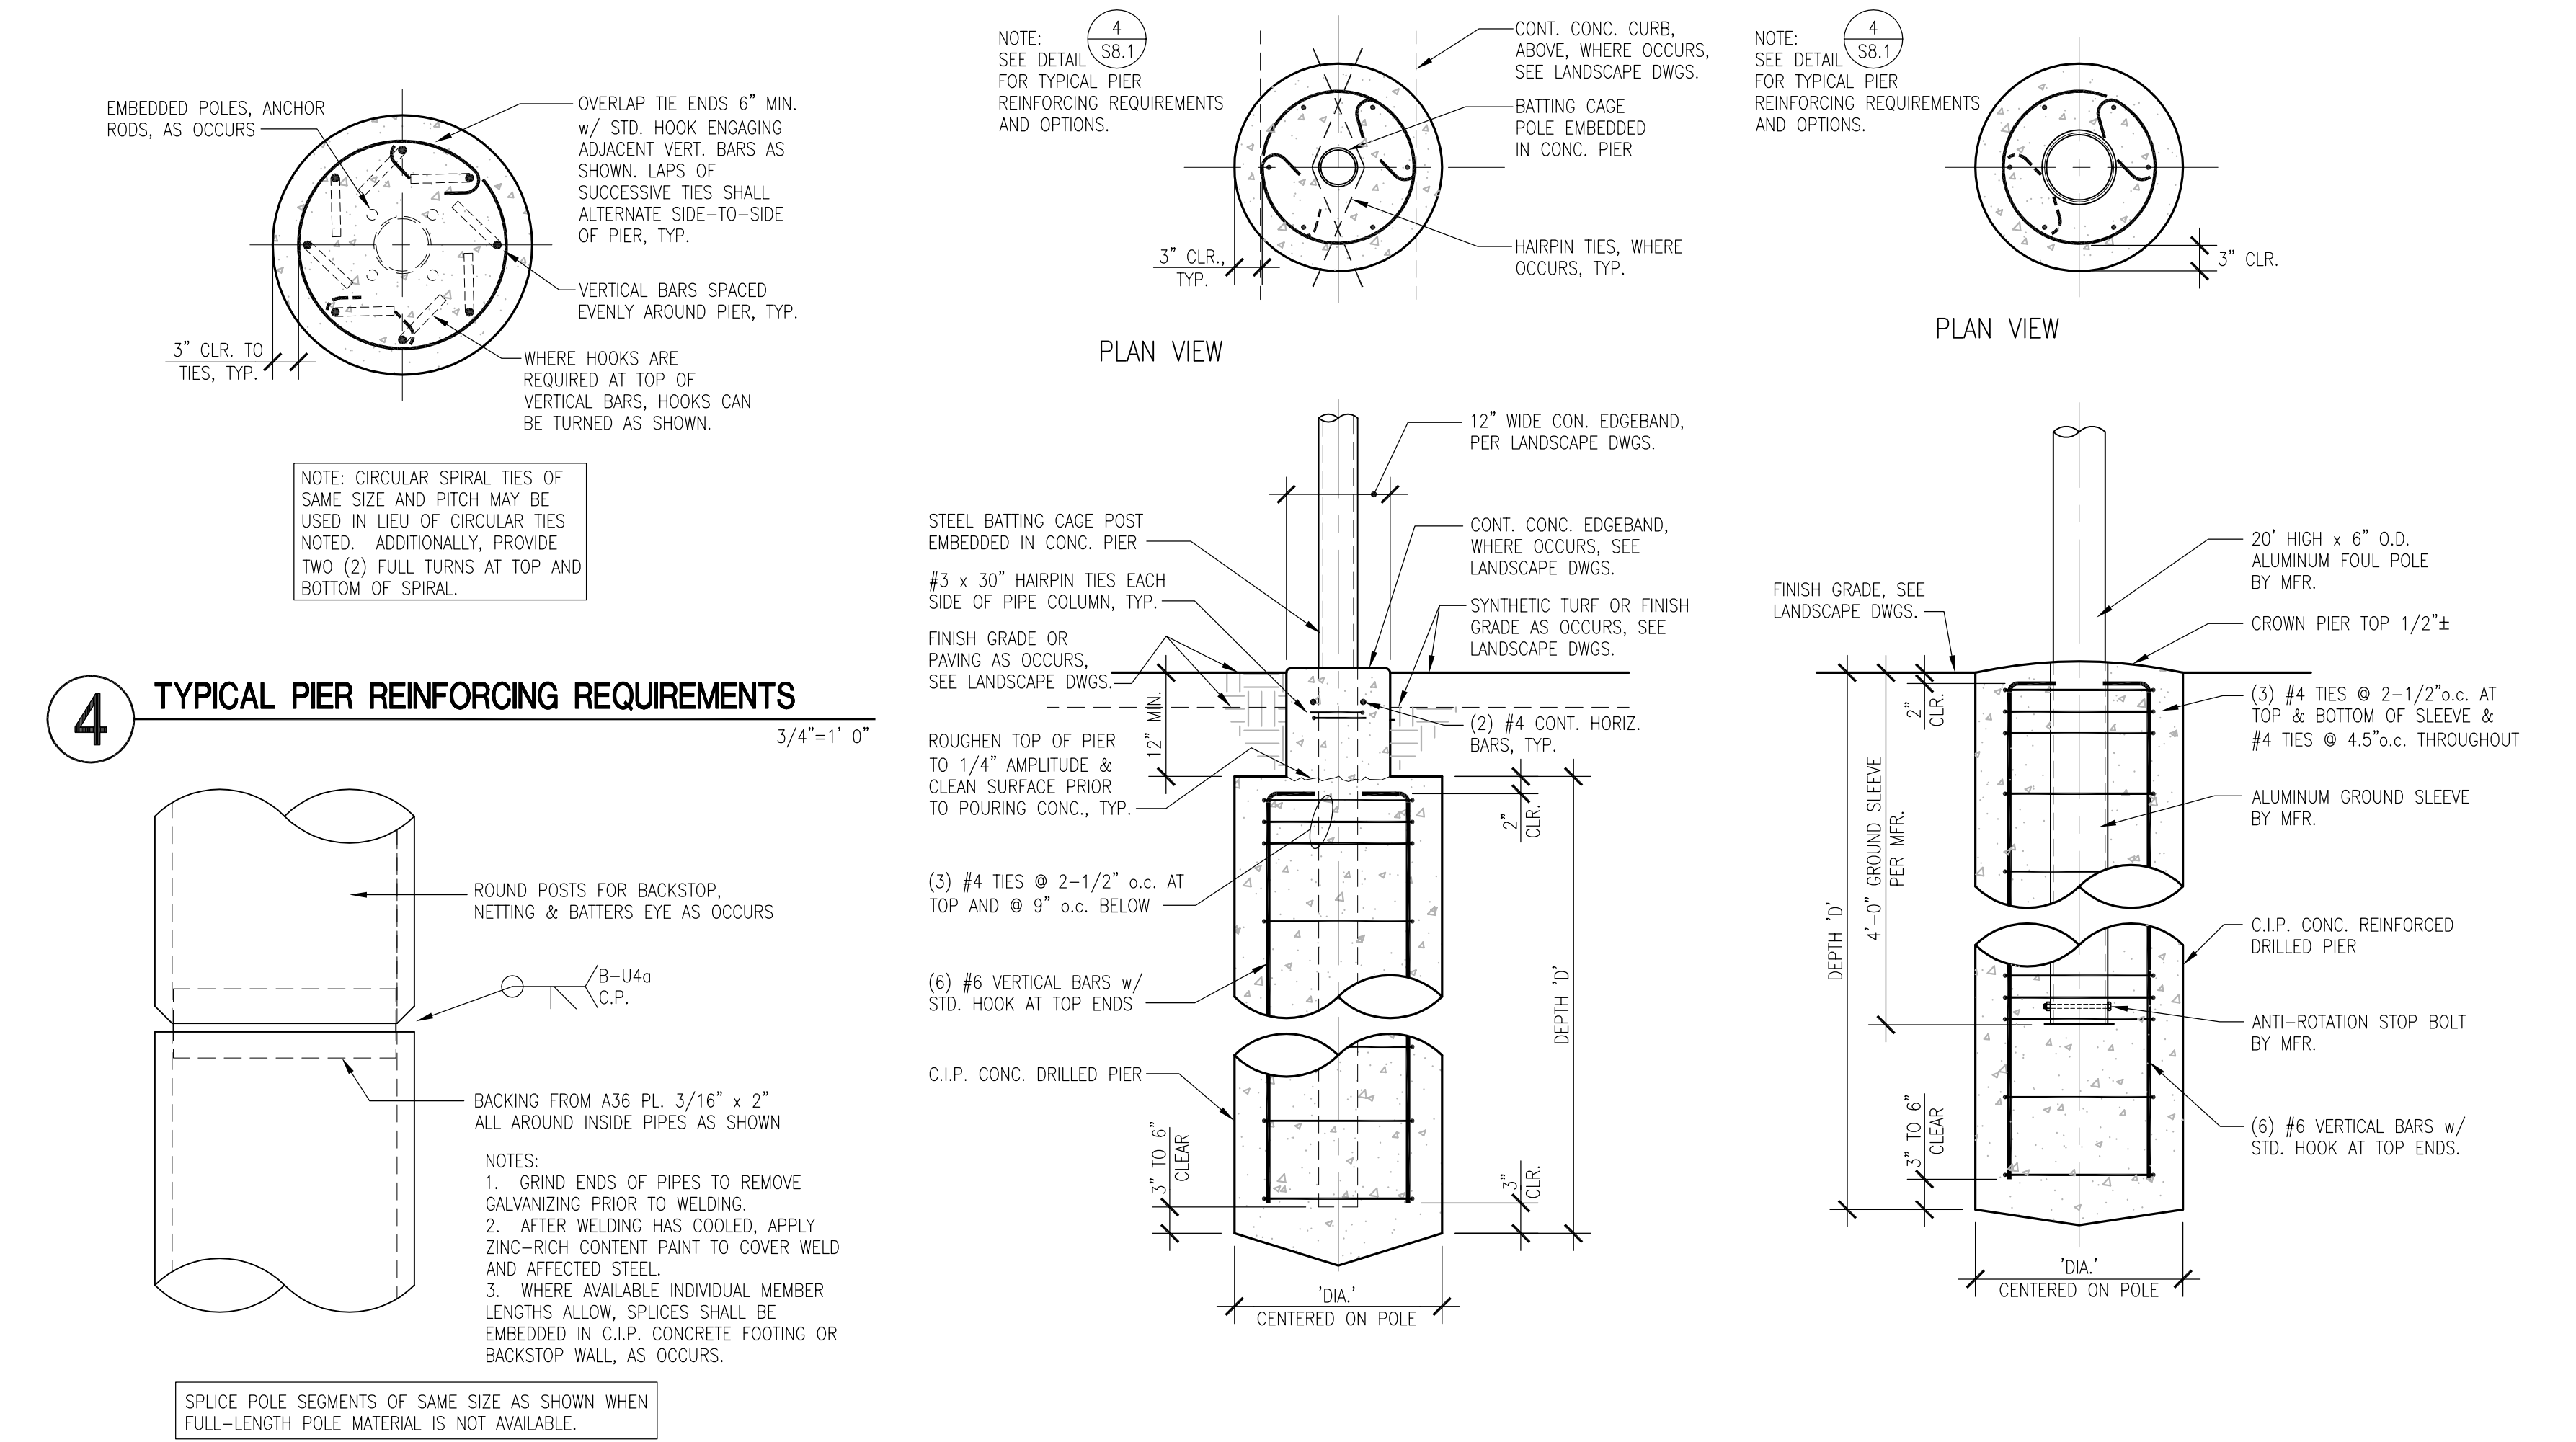

STAMP

CONSULTANT



*Jim O'Hara*

KEYMAP

SHEET TITLE

**ATHLETICS  
SITE STRUCTURES  
FOUNDATION DETAILS**

PROJECT NAME

**CHAVEZ HIGH SCHOOL  
STOCKTON USD  
ATHLETIC FACILITY  
IMPROVEMENTS**

PROJECT ADDRESS

**2929 WINDFLOWER LN  
STOCKTON, CA 95212**

| SUBMITTAL               | DATE     |
|-------------------------|----------|
| DD/50% SUBMITTAL        | 10/25/19 |
| DSA SUBMITTAL           | 12/20/19 |
| DSA BACKCHECK SUBMITTAL | 03/27/20 |

| NO. | REVISIONS | DATE |
|-----|-----------|------|
| △   |           |      |
| △   |           |      |
| △   |           |      |
| △   |           |      |

|                           |                   |
|---------------------------|-------------------|
| DRAWN BY<br>JJQ, TDH      | CHECKED BY<br>TDH |
| DATE ISSUED<br>03/27/20   | SCALE<br>AS NOTED |
| PROJ. NO.<br>1910900-1211 |                   |

SHEET NO. **S8.1** OF #

ATHLETICS SITE STRUCTURES FOUNDATION DETAILS











ALL ELECTRICAL SYMBOLS, ABBREVIATIONS, NOTES AND SCHEDULES ARE THE PROPERTY OF VERDE DESIGN, INC. AND ARE NOT TO BE REPRODUCED, COPIED, OR USED IN ANY MANNER WITHOUT THE WRITTEN PERMISSION OF VERDE DESIGN, INC. ANY REUSE OR MODIFICATION OF THESE DOCUMENTS WITHOUT THE WRITTEN PERMISSION OF VERDE DESIGN, INC. IS PROHIBITED. VERDE DESIGN, INC. IS NOT RESPONSIBLE FOR ANY ERRORS OR OMISSIONS IN THIS DOCUMENT. VERDE DESIGN, INC. IS NOT RESPONSIBLE FOR ANY ERRORS OR OMISSIONS IN THIS DOCUMENT. VERDE DESIGN, INC. IS NOT RESPONSIBLE FOR ANY ERRORS OR OMISSIONS IN THIS DOCUMENT.

## GENERAL NOTES:

1. READ THE COMPLETE SPECIFICATIONS, CONTRACT DOCUMENTS AND COMPLY WITH EACH REQUIREMENTS.
2. THE COMPLETE ELECTRICAL INSTALLATIONS SHALL BE IN ACCORDANCE WITH THE CURRENT EDITION OF THE NEC, AND ALL APPLICABLE STATE AND LOCAL CODES ISSUED BY AUTHORITIES HAVING JURISDICTION.
3. THE CONTRACTOR SHALL BE LICENSED BY THE STATE OF CALIFORNIA C-10 AND SHALL COMPLY WITH ALL APPLICABLE CODES AND REGULATIONS. MATERIALS AND EQUIPMENT SHALL BE U.L. LISTED AND LABELED FOR THE APPLICATION.
4. THE CONTRACTOR SHALL OBTAIN AND PAY FOR ALL PERMITS, LICENSES AND INSPECTION FEES REQUIRED BY THIS CONTRACT WORK.
5. PRIOR TO SUBMITTING A BID THE CONTRACTOR SHALL VISIT THE SITE, REVIEW THE EXISTING CONDITIONS AND ALLOW FOR LABOR, MATERIAL AND COORDINATION THAT IS NECESSARY TO PROVIDE A COMPLETE INSTALLATION OF EACH SYSTEM. THE CONTRACTOR SHALL OBTAIN AND BE FAMILIAR WITH ALL OTHER TRADES. THE CONTRACTOR SHALL BE RESPONSIBLE FOR ALL ELECTRICAL WORK NOTED AND CALLED OUT ON ALL CONTRACT DOCUMENTS. THE CONTRACTOR SHALL BE RESPONSIBLE FOR COORDINATION BETWEEN OTHER TRADES ON PROJECT.
6. THE CONTRACTOR SHALL BE RESPONSIBLE FOR THE SAFETY OF PERSONS AND PROPERTY AND SHALL PROVIDE INSURANCE COVERAGE AS NECESSARY FOR LIABILITY, PERSONAL PROPERTY DAMAGE, TO FULLY PROTECT THE OWNER, ARCHITECT AND ENGINEER FROM ANY AND ALL CLAIMS RESULTING FROM THIS WORK.
7. THE CONTRACTOR SHALL MAINTAIN RECORD DRAWINGS AT THE PROJECT SITE INDICATING ALL MODIFICATIONS TO ELECTRICAL SYSTEMS. THE CONTRACTOR SHALL AT THE CONCLUSION OF THE PROJECT PROVIDE ACCURATE "AS-BUILT" DRAWINGS. "AS-BUILT" DRAWINGS SHALL SHOW ACTUAL CHANGES TO ORIGINAL ELECTRICAL DRAWINGS, SHOW LOCATIONS OF PULLBOXES, CONDUIT RUNS AND WIRING CHANGES.
8. ALL MATERIALS PROVIDED TO THE PROJECT SHALL BE U.L. OR CSA LISTED AND SHALL BE NEW. THE CONTRACTOR SHALL BE RESPONSIBLE TO PROVIDE AND INSTALL ALL INCIDENTAL MATERIALS REQUIRED FOR A COMPLETE INSTALLATION.
9. THE CONTRACTOR SHALL PROVIDE ALL REQUIRED "CUTTING PATCHING, EXCAVATION, BACKFILL AND REPAIRS" NECESSARY TO RESTORE DAMAGED SURFACES TO EQUAL OR BETTER THAN ORIGINAL CONDITIONS EXISTING AT START OF WORK. THE CONTRACTOR SHALL CONTACT "UNDERGROUND SERVICES ALERT" FOR LOCATION OF EXISTING UTILITIES PRIOR TO COMMENCEMENT OF UNDERGROUND WORK.
10. THE CONTRACTOR SHALL BE RESPONSIBLE FOR PAINTING ALL EXPOSED CONDUITS AND ELECTRICAL EQUIPMENT. REFER TO ARCHITECT'S PAINTING SECTION FOR REQUIREMENTS.
11. ALL ELECTRICAL EQUIPMENT INSTALLED OUTDOORS SHALL BE WEATHERPROOF. EXTERIOR CONDUITS RUN INTO BUILDINGS SHALL BE INSTALLED WITH FLASHING, CAULKED AND SEALED. CONDUITS FOR EXTERIOR ELECTRICAL DEVICES SHALL BE RUN INSIDE BUILDING UNLESS OTHERWISE NOTED ON DRAWINGS. ALL EXTERIOR CONDUITS SHALL BE "RGS" UNLESS OTHERWISE NOTED ON DRAWINGS.
12. ALL CONDUITS UNLESS OTHERWISE NOTED ON DRAWINGS SHALL HAVE AS A MINIMUM, TWO (2) #2'S WITH ONE (1) #2 GROUND. "TICK" MARKS SHOWN ON CIRCUITRY ARE FOR "ROUGH" ESTIMATING ONLY. THE CONTRACTOR SHALL BE RESPONSIBLE FOR ALL WIRES AND WIRE SIZES REQUIRED BY LATEST CODE.
13. COORDINATE ALL CONDUIT RUNS, ELECTRICAL EQUIPMENT AND PANELS WITH ALL OTHER WORK TO AVOID CONFLICTS.
14. ELECTRICAL EQUIPMENT SHOWN ON THIS DRAWING HAS BEEN SELECTED BASED ON DIMENSIONS TO FIT THE SPACE. THE CONTRACTOR SHALL VERIFY ALL EQUIPMENT DIMENSIONS PRIOR TO ORDERING OF THE EQUIPMENT.
15. CONTRACTOR SHALL REVIEW EQUIPMENT REQUIREMENTS OF OTHER TRADES AND PROVIDE POWER CIRCUITS AND CONNECTIONS TO ELECTRICAL OPERATED EQUIPMENT.
16. CONTRACTOR SHALL DETERMINE EXACT LOCATION OF UNDERGROUND POWER AND TELEPHONE SERVICES FROM SERVING UTILITIES. FIELD ADJUSTMENTS MAY BE REQUIRED IN INDIVIDUAL SERVICE LOCATIONS.
17. THE CONTRACTOR SHALL CONTACT "UNDERGROUND SERVICES ALERT" FOR LOCATION OF EXISTING UTILITIES PRIOR TO COMMENCEMENT OF UNDERGROUND WORK.
18. NEW DUCT ROUTES ARE APPROXIMATE ONLY AND MAY BE ADJUSTED IN THE FIELD TO CLEAR OTHER UNDERGROUND UTILITIES. PROVIDE AS-BUILT DRAWINGS TO INDICATE ACTUAL LOCATION OF CONDUIT ROUTING.
19. EFFECTIVELY BOND ELECTRICAL CABINETS, ENCLOSURES AND CONDUIT RACEWAYS TO CODE APPROVED GROUND AS PART OF THE CONTINUOUS GROUNDING SYSTEM.
20. FROM ALL NEW PANELS, THE CONTRACTOR SHALL STUB UP INTO ACCESSIBLE CEILING SPACE A MINIMUM OF FOUR (4) 3/4" CONDUITS FOR FUTURE USE.
21. UTILITY SERVICE WORK SHALL BE IN ACCORDANCE WITH THE SERVING UTILITY COMPANY'S RULES, REGULATIONS AND STANDARDS, AND SHALL BE VERIFIED WITH UTILITY COMPANY'S ENGINEERING DRAWINGS AND FIELD SUPERVISOR. PRIOR TO COMMENCEMENT OF WORK, THE CONTRACTOR SHALL DETERMINE EXACT LOCATION OF UNDERGROUND POWER, CATV AND TELEPHONE SERVICES FROM SERVING UTILITIES. FIELD ADJUSTMENTS MAY BE REQUIRED IN INDIVIDUAL SERVICE LOCATIONS. THE CONTRACTOR SHALL REMAIN IN CONTACT WITH UTILITY COMPANY ENGINEERING DEPARTMENTS THROUGHOUT PROJECT TO INSURE COORDINATION AND SCHEDULING OF WORK.
22. THE CONTRACTOR SHALL PROVIDE IN EVERY CONDUIT A DRAIN STRING FOR USE IN FUTURE CONSTRUCTION. STRING SHALL BE NYLON PULLSTRING ROPE/STRING.
23. POWER FEEDERS MAY NOT BE SHOWN ON THE DRAWINGS, REFER TO THE SINGLE LINE DIAGRAM FOR CONDUIT AND FEEDER INFORMATION. ALL DRAWINGS ARE DIAGRAMMATIC INDICATING LOCATION OR POSITION OF EQUIPMENT. FIELD VERIFY CONDITIONS PRIOR TO INSTALLATION OF ANY WORK.
24. MANUFACTURER'S RECOMMENDATIONS FOR CONDUCTOR SIZING, CIRCUIT BREAKER OR FUSE PROTECTION OF ELECTRICALLY OPERATED EQUIPMENT MAY DIFFER FROM THOSE INDICATED ON DRAWINGS. CONTRACTOR SHALL CONFIRM RATINGS PRIOR TO ORDERING EQUIPMENT. PROVIDE ELECTRICAL PROTECTION TO EQUIPMENT IN ACCORDANCE TO MANUFACTURER'S SPECIFICATIONS AND PER NATIONAL ELECTRICAL CODE REQUIREMENTS.
25. PROVIDE SEISMIC BRACING FOR ALL PENDANT LIGHT FIXTURES, FREESTANDING ELECTRICAL DISTRIBUTION EQUIPMENT, MOTOR CONTROL CENTERS ETC; AND CONDUIT RACKS PER SEISMIC CRITERIA 2016 CBC REQUIREMENTS INCLUDING ENGINEERED LOAD CALCULATIONS COMPLETE WITH SNAY BRACING CRITERIA.
26. DO NOT SUBSTITUTE SPECIFIED MATERIAL OR EQUIPMENT WITHOUT FIRST OBTAINING APPROVAL FROM THE OWNER OR HIS REPRESENTATIVE.
27. ALL SPACES ON PANELS OR SWITCHBOARDS SHALL BE COMPLETE WITH HARDWARES AND BISSING FOR FUTURE BREAKER OR SWITCH.
28. ALL ELECTRICAL WORK SHALL COMPLY WITH THE 2016 NATIONAL ELECTRICAL CODE AS AMENDED BY THE 2016 CALIFORNIA ELECTRICAL CODE.
29. SPlice GROUND WIRE INSIDE ALL METAL ELECTRICAL PULL BOXES AND BOND TO METAL COVER WITH #6 CU GND.

## SYMBOL LIST:

- PLAN, DETAIL OR SECTION DESIGNATION.
- ROOM NUMBER.
- SHEET REFERENCE SYMBOL - SEE ASSOCIATED NOTE ON SAME SHEET.
- FEEDER SCHEDULE SYMBOL.
- MECHANICAL EQUIPMENT TAG.
- INDICATES FIXTURE TYPE
- LUMINAIRE SYMBOLS**
- LUMINAIRE - SEE SCHEDULE.
- LUMINAIRE - SEE SCHEDULE.
- LUMINAIRE MALL MOUNTED-SEE SCHEDULE.
- EMERGENCY LUMINAIRE - PROVIDE EMERGENCY BATTERY BALLAST
- EMERGENCY LUMINAIRE - PROVIDE EMERGENCY BATTERY BALLAST
- EMERGENCY LUMINAIRE - PROVIDE EMERGENCY BATTERY BALLAST
- EMERGENCY LUMINAIRE - PROVIDE EMERGENCY BATTERY BALLAST
- EMERGENCY LUMINAIRE MALL MOUNTED- PROVIDE EMERGENCY BATTERY BALLAST
- EXIT LIGHT SINGLE FACE - SEE SCHEDULE.
- EXIT LIGHT SINGLE FACE (WITH ARROW)- SEE SCHEDULE.
- EXIT LIGHT (DOUBLE FACED WITH ARROW)- SEE SCHEDULE.
- COMBO EMERGENCY LIGHT/ EXIT LIGHT SINGLE FACE - SEE SCHEDULE.
- EMERGENCY BATTERY PACK EXIT LIGHT INSTALL AS DIRECTED.

### TYPICAL LUMINAIRE NOMENCLATURE

- INDICATES SWITCHING DESIGNATION
- INDICATES CIRCUIT NUMBER

### SWITCH SYMBOLS

- SINGLE POLE SWITCH, + 48" AFF UON.
- SINGLE POLE SWITCH, + 48" AFF UON, α = CIRCUIT CONTROLLED.
- THREE WAY SWITCH + 48" AFF UON.
- FOUR WAY SWITCH + 48" AFF UON.
- MOTOR RATED SWITCH
- OCCUPANCY SENSOR
- OCCUPANCY SENSOR POWER PACK

### RECEPTACLE SYMBOLS

- CONVENIENCE RECEPTACLE - DUPLEX AT + 18" AFF UON.
- 6FCI CONVENIENCE RECEPTACLE - DUPLEX.
- RECEPTACLE DOUBLE DUPLEX AT + 18" AFF UON.
- SINGLE RECEPTACLE - NEMA 5-20R UON, AT + 18" AFF UON.
- SINGLE RECEPTACLE - NEMA L21 - 208 VOLT, THREE PHASE, 3 WIRE, AT + 18" AFF UON.
- FLOOR BOX WITH CONVENIENCE RECEPTACLE, TELEPHONE AND DATA OUTLET.
- FLUSH FLOOR BOX WITH SINGLE CONVENIENCE RECEPTACLE.
- WIRE RACEWAY, INSTALL AT + 36" AFF UON.

### POWER DISTRIBUTION SYMBOLS

- PANELBOARD - SURFACE OR FLUSH MOUNTED.
- JUNCTION BOX - CEILING OR WALL MOUNTED, SIZE TO CODE, TAPE AND TAG WIRES. PROVIDE FLEX AND/OR RECEPTACLE AS REQUIRED TO CONNECT EQUIPMENT.
- DISTRIBUTION PANEL
- MOTOR
- COMBINATION MAGNETIC STARTER FUSED DISCONNECT SWITCH, RATINGS AS INDICATED.
- UNFUSED DISCONNECT SWITCH - RATINGS AS INDICATED.
- FUSED DISCONNECT SWITCH - SIZE FUSES PER MOTOR MANUFACTURER'S RECOMMENDATIONS, RATINGS AS INDICATED.
- MAGNETIC STARTER - NEMA SIZE INDICATED.
- TRANSFORMER - SEE SINGLE LINE FOR SIZE.
- GROUND ROD.

### WIRING & CONDUIT RUN SYMBOLS

- CONDUIT - CONCEALED IN WALLS OR CEILING.
- CONDUIT - EXPOSED.
- CONDUIT - IN OR BELOW FLOOR, 3/4" MIN.
- CONDUIT - HOME RUN TO PANEL, TERMINAL CABINET, ETC. RUNS MARKED WITH CROSSSHATCHES INDICATE NUMBER OF #12 AWG WIRES. CROSSSHATCH WITH SUBSCRIPT "6" INDICATES GREEN GROUND WIRE. SIZE CONDUIT ACCORDING TO SPECIFICATIONS AND ALL CABLE CODE. CROSSSHATCHES WITH "400" INDICATES WIRE SIZE OTHER THAN #12'S.
- FLEX CONDUIT WITH CONNECTION.
- CONDUIT - STUB UP.
- CONDUIT - STUB DOWN.
- CONDUIT EMERGENCY SYSTEM.
- CAPPED CONDUIT.
- CONDUIT CONTINUATION.

### POWER DISTRIBUTION SINGLE LINE SYMBOLS

- CIRCUIT BREAKER.
- "6" #1" METER W/ CURRENT TRANSFORMER.
- TRANSFORMER.

## GENERAL ANCHORAGE NOTES:

### MEP COMPONENT ANCHORAGE NOTE.

ALL MECHANICAL, PLUMBING AND ELECTRICAL COMPONENTS SHALL BE ANCHORED AND INSTALLED PER THE DETAILS ON THE DSA APPROVED CONSTRUCTION DOCUMENTS. WHERE NO DETAIL IS INDICATED, THE FOLLOWING COMPONENTS SHALL BE ANCHORED OR BRACED TO MEET THE FORCE AND DISPLACEMENT REQUIREMENTS PRESCRIBED IN THE 2016 CBC, SECTIONS 1606A.1.8 THRU 1606A.1.26 AND ASCE 7-10 CHAPTER 13, 26 AND 30.

1. ALL PERMANENT EQUIPMENT AND COMPONENTS.
2. TEMPORARY OR MOVABLE EQUIPMENT THAT IS PERMANENTLY ATTACHED (e.g. HARD WIRED) TO THE BUILDING UTILITY SERVICES SUCH AS ELECTRICITY, GAS OR WATER.
3. MOVABLE EQUIPMENT WHICH IS STATIONED IN ONE PLACE FOR MORE THAN 8 HOURS AND HEAVIER THAN 400 POUNDS ARE REQUIRED TO BE ANCHORED WITH TEMPORARY ATTACHMENTS.

THE ATTACHMENT OF THE FOLLOWING MECHANICAL AND ELECTRICAL COMPONENTS SHALL BE POSITIVELY ATTACHED TO THE STRUCTURE BUT NEED NOT BE DETAILED ON THE PLANS. THESE COMPONENTS SHALL HAVE FLEXIBLE CONNECTIONS PROVIDED BETWEEN THE COMPONENT AND ASSOCIATED DUCTWORK, PIPING AND CONDUIT.

- A. COMPONENTS WEIGHING LESS THAN 400 POUNDS AND HAVE A CENTER OF MASS LOCATED 4 FEET OR LESS ABOVE THE ADJACENT FLOOR OR ROOF LEVEL THAT DIRECTLY SUPPORT THE COMPONENT.
- B. COMPONENTS WEIGHING LESS THAN 20 POUNDS, OR IN THE CASE OF DISTRIBUTED SYSTEMS, LESS THAN 5 POUNDS PER FOOT WHICH ARE SUSPENDED FROM A ROOF OR FLOOR OR HANG FROM A WALL.

FOR THOSE ELEMENTS THAT DO NOT REQUIRE DETAILS ON THE APPROVED DRAWINGS, THE INSTALLATION SHALL BE SUBJECT TO THE APPROVAL OF THE STRUCTURAL ENGINEER OF RECORD AND THE DSA DESIGN/STRUCTURAL ENGINEER. THE PROJECT INSPECTOR WILL VERIFY THAT ALL COMPONENTS AND EQUIPMENT HAVE BEEN ANCHORED IN ACCORDANCE WITH ABOVE REQUIREMENTS.

### PIPING, DUCTWORK AND ELECTRICAL DISTRIBUTION SYSTEM BRACING NOTE.

PIPING, DUCTWORK AND ELECTRICAL DISTRIBUTION SYSTEMS SHALL BE BRACED TO COMPLY WITH THE FORCES AND DISPLACEMENTS PRESCRIBED IN ASCE 7-10 SECTION 13.8 AS DEFINED IN ASCE 7-10 SECTION 13.6.8, 13.6.1, 13.6.3.6 AND 2016 CBC, SECTION 1606A.1.23, 1606A.1.24, 1606A.1.25 AND 1606A.1.26.

THE BRACING AND ATTACHMENTS TO THE STRUCTURE SHALL BE DETAILED ON THE APPROVED DRAWINGS OR THEY SHALL COMPLY WITH ONE OF THE COMPD PRE-APPROVALS (CPM) AS MODIFIED TO SATISFY ANCHORAGE REQUIREMENTS OF ACI 308, APPENDIX D.

COPIES OF THE MANUAL SHALL BE AVAILABLE ON THE JOBSITE PRIOR TO THE START OF HANGING AND BRACING OF THE PIPE, DUCTWORK AND ELECTRICAL DISTRIBUTION SYSTEMS. THE STRUCTURAL ENGINEER OF RECORD SHALL VERIFY THE ADEQUACY OF THE STRUCTURE TO SUPPORT THE HANGERS AND BRACE LOADS.

## ABBREVIATIONS:

- AMPERE
- ABV ABOVE
- AFV AMP FRAME OR AMP FUSE
- AFF ABOVE FINISHED FLOOR
- ARCH ARCHITECTURAL
- AS AMP SWITCH
- AT AMP TRIP
- ATS BREAKER
- BLDG BUILDING
- CD CONDUIT
- CATV CABLE TELEVISION
- CB CIRCUIT BREAKER
- CD CABLE CONTROL
- CL CIRCUIT
- CL CENTER LINE
- CLS CEILING
- CONDUIT ONLY
- GTR CENTER
- D DETAIL
- DET DIMENSION
- DISTR DISTRIBUTION
- DWS DRAWINGS
- (E) EXISTING
- EM EMERGENCY
- EQPT EQUIPMENT
- FA FIRE ALARM
- FACP FIRE ALARM CONTROL PANEL
- (F) FUTURE
- FIN FINISH
- FL FLOOR
- G, GND GROUND
- HGT HEIGHT
- HP HORSEPOWER
- IC INTERCOM
- IDF INTERMEDIATE DISTRIBUTION FRAME
- JB JUNCTION BOX
- KAIC KILOAMPERE INTERRUPTING CAPACITY
- KV KILOVOLT
- KVA KILOVOLT AMPERES
- KM KILOWATT
- LTS LIGHTING
- LCP LIGHTING CONTROL PANEL
- MCM THOUSAND CIRCULAR MILS
- MDF MAIN DISTRIBUTION FRAME
- MECH MECHANICAL
- MH MANGOLE
- MTD MOUNTED
- MTS MOUNTING
- (N) NEW
- NC NORMALLY CLOSED
- NG NOT IN CONTRACT
- NEG NOT IN ELECTRICAL CONTRACT
- NUMBER NORMALLY OPEN
- NTS NOT TO SCALE
- O.C. ON CENTER
- POLE CIRCUIT BREAKER
- PA PUBLIC ADDRESS
- PB PULL BOX
- PF POWER FACTOR
- PH PHASE
- PNL PANEL
- (R) EXISTING TO BE RELOCATED
- REQD REQUIRED
- REQT REQUIREMENT(S)
- RM ROOM
- RSC RIGID STEEL CONDUIT
- SHT SHEET
- SN SWITCH
- SHED SHEEDBOARD
- TEL TERMINAL CABINET
- TEC TELEPHONE
- TYPICAL
- UNON UNLESS OTHERWISE NOTED
- V VOLT
- W WATT
- WP WEATHERPROOF
- XFMR TRANSFORMER

## FIXTURE SCHEDULE

| TYPE  | LAMPS   | LAMP QUANTITY | BALLAST | MOUNTING                             | DESCRIPTION   | HEIGHT |
|-------|---------|---------------|---------|--------------------------------------|---|--------|
| AA    | T4W LED | N/A           | N/A     | MOUNTED ON A 15' POLE FLUSH BASE     | SINGLE HEAD POLE MOUNTED LED LUMINAIRE WITH A RECTANGULAR 15' POLE. HOUSING TO HAVE DIE CAST ALUMINUM. FIXTURE TO HAVE LED DRIVER THAT ACCEPTS 277V AT 60HZ. DRIVER OUTPUT IS BASED ON THE LED MATTAGE SELECTED. FINISH TO HAVE A FADE AND ABRASION RESISTANT, ELECTROSTATICALLY APPLIED, THERMALLY CURED, TRISGLYCIDAL ISOCYANURATE (TSGI) TEXTURED POLYESTER POWDERCOAT FINISH. FIXTURE SHALL BE PROVIDED WITH MINIMUM 3-YEAR WARRANTY. SUBMIT DOCUMENTATION OF PRODUCT AT CLOSE OUT. NOTE: FIXTURE USED AT PEDESTRIAN PATHWAY/EGRESS. 6MRDGO - P26-48L-500-NN-62-AR-3-UNV 27TV | 38lbs. |
| AB1   | T4W LED | N/A           | N/A     | MOUNTED ON A 12' POLE 9' RAISED BASE | SINGLE HEAD POLE MOUNTED LED LUMINAIRE WITH A RECTANGULAR 12' POLE. HOUSING TO HAVE DIE CAST ALUMINUM. FIXTURE TO HAVE LED DRIVER THAT ACCEPTS 277V AT 60HZ. DRIVER OUTPUT IS BASED ON THE LED MATTAGE SELECTED. FINISH TO HAVE A FADE AND ABRASION RESISTANT, ELECTROSTATICALLY APPLIED, THERMALLY CURED, TRISGLYCIDAL ISOCYANURATE (TSGI) TEXTURED POLYESTER POWDERCOAT FINISH. FIXTURE SHALL BE PROVIDED WITH MINIMUM 3-YEAR WARRANTY. SUBMIT DOCUMENTATION OF PRODUCT AT CLOSE OUT. NOTE: FIXTURE USED AT PEDESTRIAN PATHWAY/EGRESS. 6MRDGO - P26-48L-500-NN-62-AR-3-UNV 27TV | 38lbs. |
| AB2   | T4W LED | N/A           | N/A     | MOUNTED ON A 12' POLE 9' RAISED BASE | DOUBLE HEAD POLE MOUNTED LED LUMINAIRE WITH A RECTANGULAR 12' POLE. HOUSING TO HAVE DIE CAST ALUMINUM. FIXTURE TO HAVE LED DRIVER THAT ACCEPTS 277V AT 60HZ. DRIVER OUTPUT IS BASED ON THE LED MATTAGE SELECTED. FINISH TO HAVE A FADE AND ABRASION RESISTANT, ELECTROSTATICALLY APPLIED, THERMALLY CURED, TRISGLYCIDAL ISOCYANURATE (TSGI) TEXTURED POLYESTER POWDERCOAT FINISH. FIXTURE SHALL BE PROVIDED WITH MINIMUM 3-YEAR WARRANTY. SUBMIT DOCUMENTATION OF PRODUCT AT CLOSE OUT. NOTE: FIXTURE USED AT PEDESTRIAN PATHWAY/EGRESS. 6MRDGO - P26-48L-500-NN-62-AR-3-UNV 27TV | 38lbs. |
| B     | 40W LED | N/A           | N/A     | BATTING GAGE                         | SINGLE HEAD LED RECTANGULAR LUMINAIRE WITH DIE CAST ALUMINUM ALLOY HOUSING. FIXTURE TO BE EQUIPPED WITH ADJUSTABLE BRACKET AND HARDWARE TO MOUNT BELOW BLEACHER. NORTHSTAR LIGHTING - #AF6L-50-50-3-U-D-1 27TV  | 10lbs. |
| FI-F6 |         |               |         |                                      | SEE MUSCO DRAWINGS  |        |

## DRAWING INDEX

| SHEET NO. | SHEET TITLE   |
|-----------|---|
| E0.1      | ELECTRICAL SYMBOLS, ABBREVIATIONS, NOTES AND SCHEDULES              |
| E1.0      | ELECTRICAL DEMOLITION SITE PLAN                                     |
| E1.1      | ELECTRICAL SITE PLAN - NEW  |
| E1.2      | ENLARGED NEW PARKING LIGHTING PLAN                                  |
| E2.0      | ENLARGED BASEBALL FIELD - ELECTRICAL DEMOLITION SITE PLAN           |
| E2.1      | ENLARGED BASEBALL FIELD - ELECTRICAL NEW SITE PLAN                  |
| E2.2      | ENLARGED CONCESSION FIRST & THIRD BASE DUGOUT ELECTRICAL FLOOR PLAN |
| E3.1      | ELECTRICAL SINGLE LINE DIAGRAM                                      |
| E6.1      | DATA RISER DIAGRAM  |
| E6.2      | TYPICAL PA RISER DIAGRAM (BASEBALL)                                 |
| E6.3      | INVERTER AND LCP WIRING DIAGRAM (TYPICAL)                           |
| E1.1      | ELECTRICAL DETAILS  |
| E1.2      | ELECTRICAL DETAILS  |
| E1.3      | ELECTRICAL DETAILS  |
| E1.4      | ELECTRICAL DETAILS  |

THE CONTRACTOR SHALL BE RESPONSIBLE FOR SITE LOCATING ALL EXISTING UNDERGROUND SYSTEMS IN AREA OF NEW TRENCHING. THE CONTRACTOR SHALL BE RESPONSIBLE FOR REPAIRING ALL DAMAGED SYSTEMS TO OWNERS SATISFACTION. EXTREME CARE SHALL BE MAINTAINED DURING TRENCHING AS EXISTING SYSTEMS ARE KNOWN TO EXIST IN AREA. MODIFICATIONS TO EXISTING SYSTEMS MAY BE REQUIRED TO ACCOMMODATE NEW SYSTEM CONFIGURATION AND SHALL BE MADE BY THE CONTRACTOR WITHOUT EXTRA EXPENSE TO THE OWNER. THE DRAWINGS AND SPECIFICATIONS ARE FOR THE ASSISTANCE AND GUIDANCE OF THE CONTRACTOR. EXACT LOCATIONS, DISTANCES AND ELEVATIONS WILL BE GOVERNED BY ACTUAL CONDITIONS. THE CONTRACTOR SHALL EXAMINE THE CONTRACT DOCUMENTS AND FIELD CONDITIONS TO DETERMINE EXACT ROUTING AND FINAL TERMINATIONS FOR ALL NEW WORK.

IDENTIFICATION STAMP  
DIV. OF THE STATE ARCHITECT  
APP. 02-118017 INC.  
REVIEWED FOR  
DATE: 04/10/2020



**VERDE DESIGN**  
LANDSCAPE ARCHITECTURE  
CIVIL ENGINEERING  
SPORT PLANNING & DESIGN

1843 Iron Point Rd #140  
Folsom, CA 95630  
tel: 916.415.6554  
fax: 408.985.7260  
www.VerdeDesignInc.com

STAMP



CONSULTANT



**American Consulting Engineers**  
**Electrical, Inc.**

1560 The Americas, Suite 200  
San Jose, CA 95128  
JOB # E19148-05 Fax: 408/258-2512

KEYMAP

SHEET TITLE

**ELECTRICAL SYMBOLS,  
ABBREVIATIONS, NOTES  
AND SCHEDULE**

PROJECT NAME

**CHAVEZ HIGH SCHOOL  
STOCKTON USD  
ATHLETIC FACILITY  
IMPROVEMENTS**

PROJECT ADDRESS

**2929 WINDFLOWER LN  
STOCKTON, CA 95212**

SUBMITTAL

DATE

DD/50% SUBMITTAL

10/25/19

DSA SUBMITTAL

12/20/19

DSA BACKCHECK SUBMITTAL

03/27/20

NO.

REVISIONS

DATE



DRAWN BY

MG

CHECKED BY

SB/ SF

DATE ISSUED

SCALE

PROJ. NO.

1910900-1211


SHEET NO.

**E0.1**

OF #



ALL DESIGN, CONSTRUCTION, AND DEMOLITION WORK SHALL BE IN ACCORDANCE WITH THE SPECIFICATIONS OF THE CHAVEZ HIGH SCHOOL STOCKTON USD ATHLETIC FACILITY IMPROVEMENTS PROJECT. NO PART OF THIS DRAWING SHALL BE REPRODUCED, COPIED, OR IN ANY MANNER DISCLOSED TO ANY PERSON, FIRM, OR ORGANIZATION WITHOUT THE WRITTEN PERMISSION OF VERDE DESIGN, INC. CONSULTANTS SHALL BE RESPONSIBLE FOR OBTAINING ALL NECESSARY PERMITS AND APPROVALS FROM THE CITY OF STOCKTON AND THE STOCKTON WATER RECLAMATION DISTRICT.

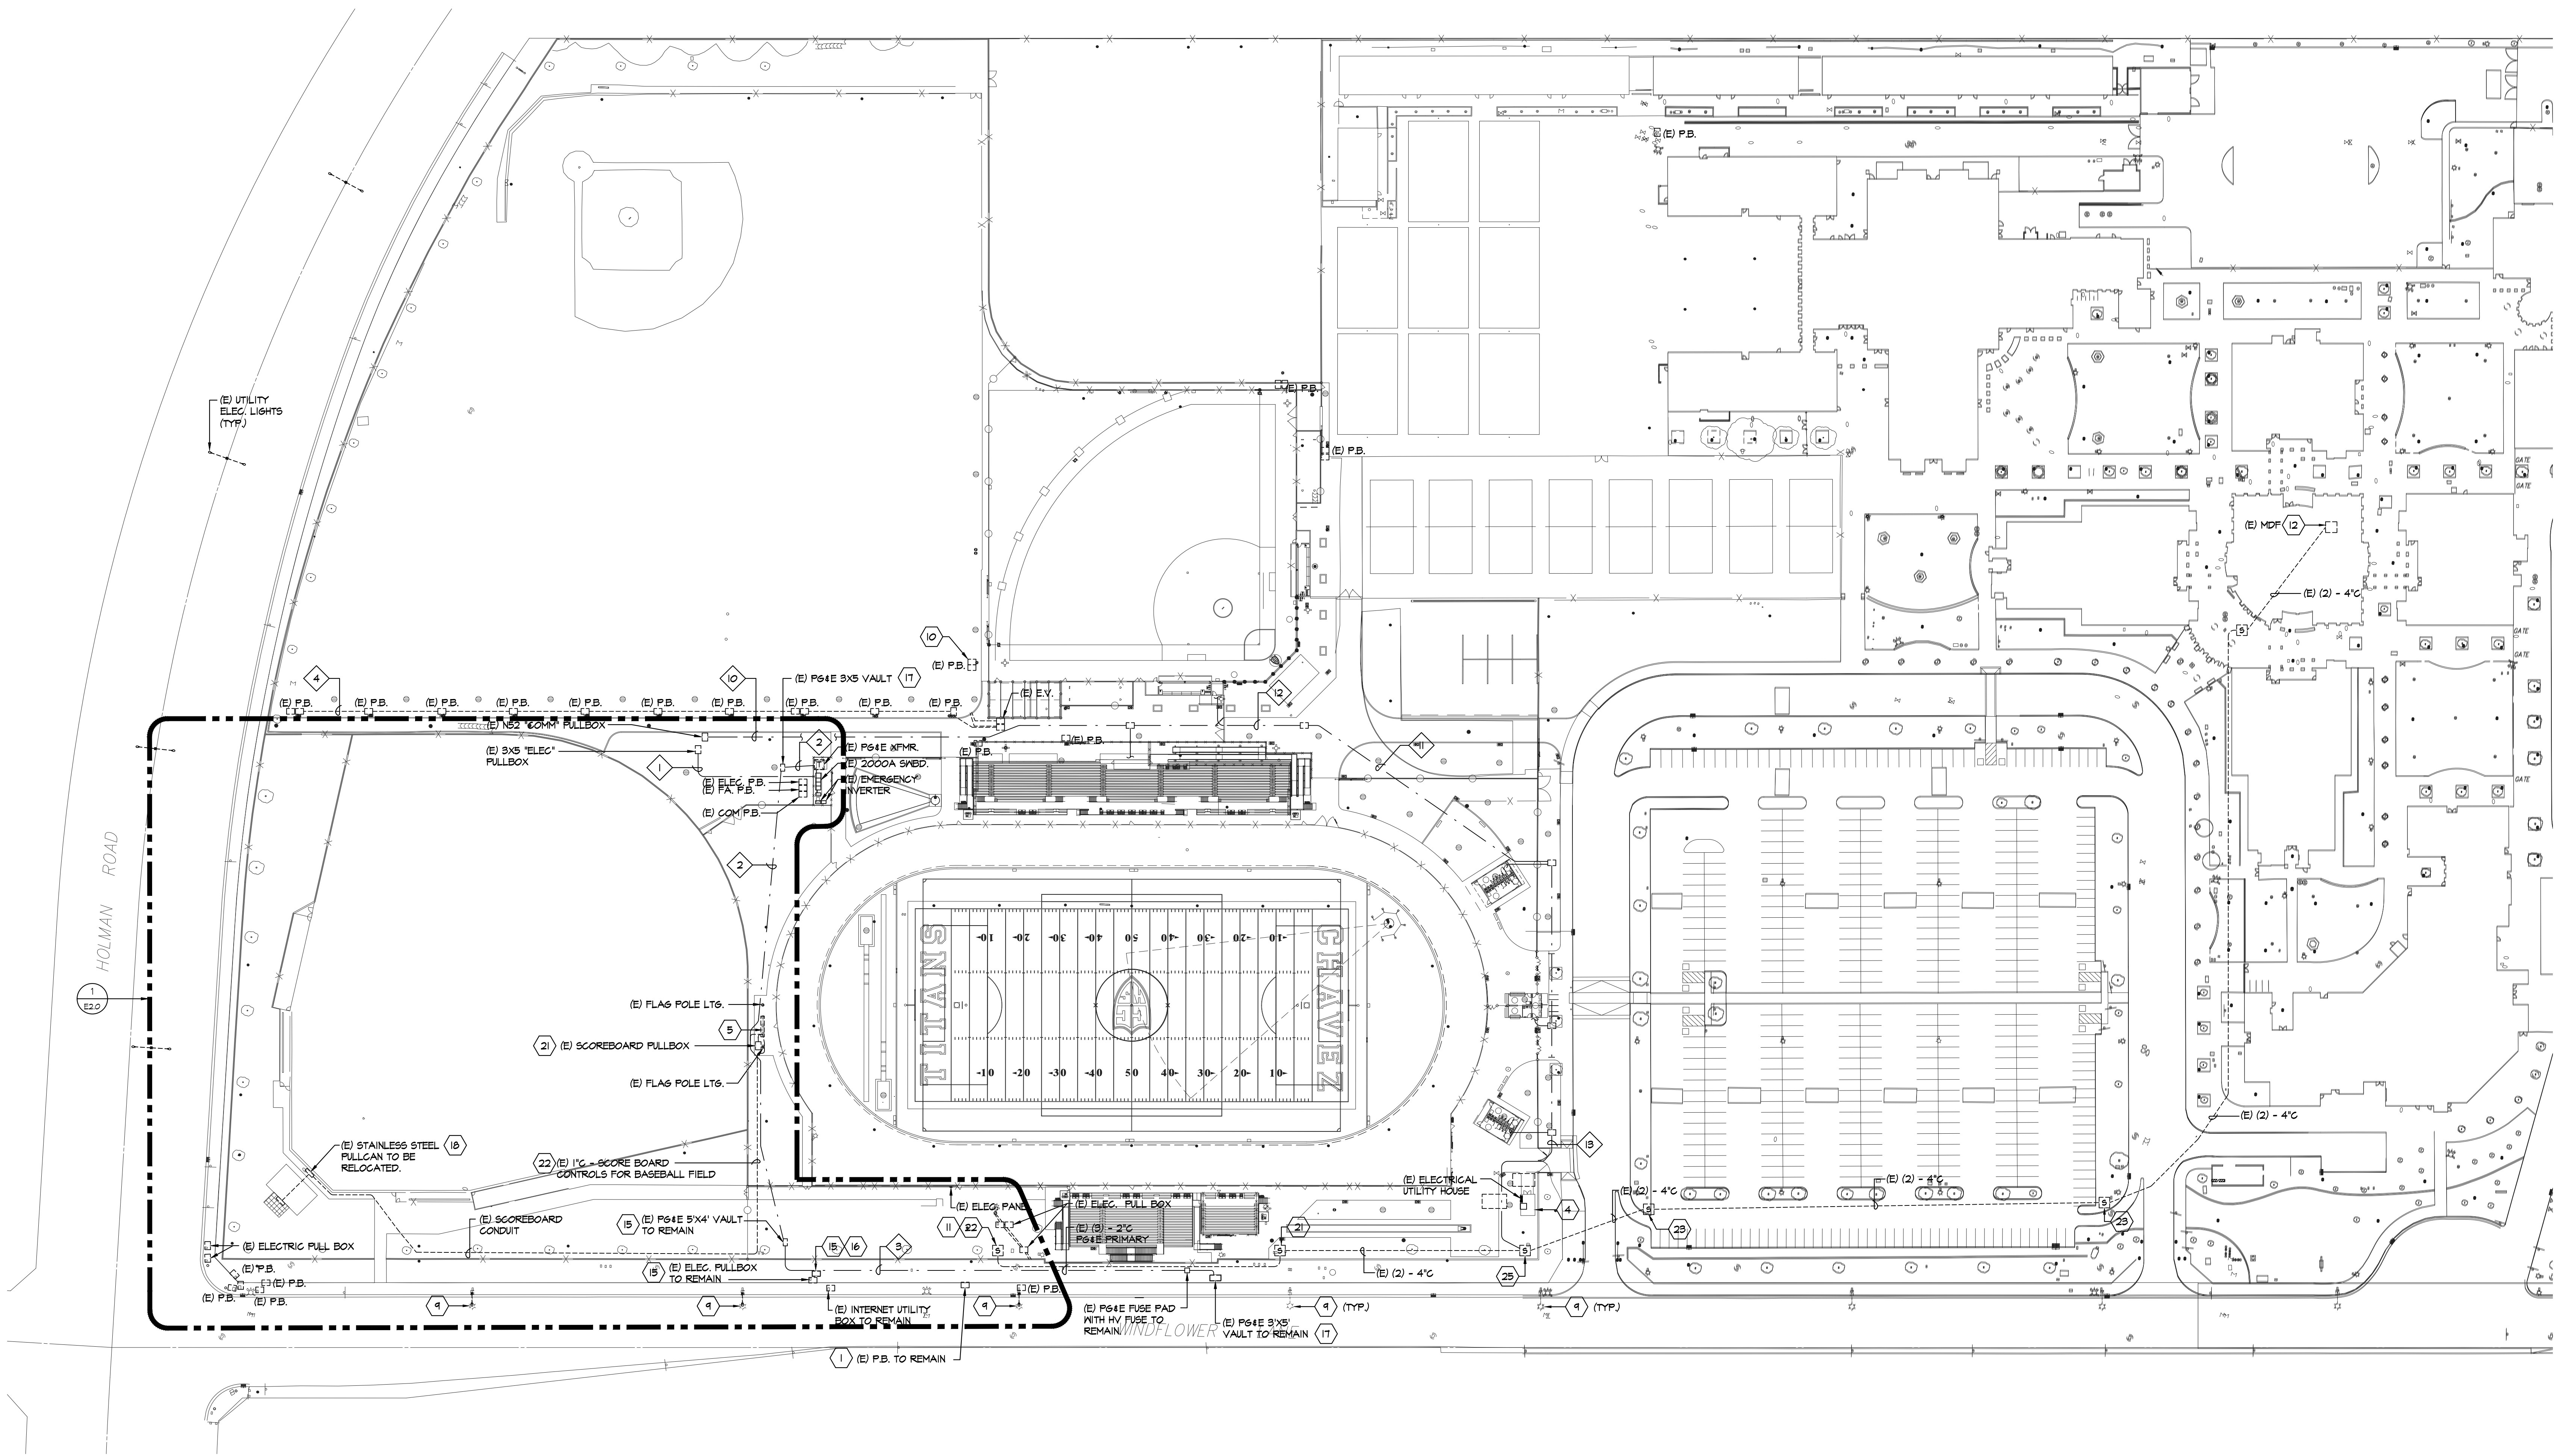

1  
E1.0 ELECTRICAL DEMOLITION SITE PLAN  
SCALE: 1" = 60'-0"

### DEMOLITION SHEETS NOTES:

1. PROTECT AND ADJUST AS NEEDED TO FACILITATE DEMOLITION AND NEW WORK. PROVIDE NEW TRAFFIC RATED LID.
2. EMERGENCY LIGHT FIXTURE AND POLE TO BE DISCONNECTED, REMOVED AND RELOCATED TO FACILITATE FIELD EXPANSION. REMOVE AND REPLACE POWER CABLE BACK TO SOURCE TO FACILITATE DEMOLITION WORK. PROVIDE AND EXTEND CABLE AND CONDUIT TO NEW LOCATION.
3. NOT USED.
4. ELECTRICAL UTILITY TO REMAIN AND BE PROTECTED. (E) EQUIPMENT IN UTILITY ROOM INCLUDES DIST PANELS FOR FOOTBALL FIELD. CONTRACTOR TO VERIFY TO FACILITATE DEMOLITION AND NEW WORK. DIST. PANELS TO REMAIN.
5. SCOREBOARD AND FOOTINGS TO REMAIN AND BE PROTECTED. CONTRACTOR TO REMOVE/REINSTALL AS NEEDED TO FACILITATE DEMOLITION AND NEW WORK. REMOVE POWER AND RECONNECT WITH NEW. SEE SINGLE LINE DIAGRAM. (E) BRANCH CIRCUITRY IN (E) PANEL LOCATED IN (E) ELEC. UTILITY HOUSE.
6. NOT USED.
7. NOT USED.
8. NOT USED.
9. CITY POLE LIGHTS TO REMAIN. (E) UNDERGROUND CONDUITS MAY EFFECT (N) WORK. CONTRACTOR TO LOCATE EXISTING CONDUIT & CABLE TO FACILITATE DEMOLITION AND NEW WORK. RE-CONNECT AS REQUIRED. PROVIDE (N) NM PULLBOX TO INTERCEPT & SPLICE AS NEEDED. PROVIDE AND MATCH WITH (N) CONDUIT AND CABLE. CONTRACTOR SHALL BE RESPONSIBLE TO COORDINATE WITH CITY AND OBTAIN NECESSARY PERMITS TO FACILITATE PROPOSED WORK.
10. POWER PULL BOX TO REMAIN. PROTECT AS NEEDED TO FACILITATE DEMOLITION AND NEW WORK. DAMAGE TO (E) LID SHALL BE REPLACED AT NO COST TO OWNER.
11. COMMUNICATION PULL BOX TO BE RELOCATED TO FACILITATE NEW WORK. (E) CABLE SYSTEMS CONSIST OF SCOREBOARD, TELEPHONE AND DATA. REMOVE CABLES BACK TO SOURCE. (E) COMMUNICATION CABLE FOR (E) BASEBALL FIELD TO REMAIN SUCH THAT BASEBALL FIELD COMMUNICATION SYSTEM IS OPERATIONAL.
12. MDF LOCATED IN BUILDING "A" TO REMAIN.
13. NOT USED.
14. NOT USED.
15. PROTECT AS NEEDED TO FACILITATE DEMOLITION AND NEW WORK. DAMAGE TO (E) LID SHALL BE REPLACED AT NO COST TO OWNER.
16. (E) TELEPHONE UTILITY VAULT TO REMAIN.
17. (E) P64E UTILITY VAULT TO REMAIN.
18. (E) POWER OUTLET IN (E) PULLCAN TO BE RELOCATED. (E) CIRCUITS ARE LOCATED IN (E) ELEC. UTILITY HOUSE.
19. NOT USED.
20. NOT USED.
21. (E) COMMUNICATION PULLBOX TO REMAIN.
22. (E) CONDUIT AND CABLE FOR SCOREBOARD CONTROLS TO REMAIN. (E) UNDERGROUND CONDUITS AND CABLES TO REMAIN OPERATIONAL.
23. (E) COMMUNICATION BOX TO REMAIN.
24. NOT USED.
25. (E) 3"X5" COMMUNICATION BOX TO REMAIN.


### GENERAL DEMOLITION NOTES:

1. CONTRACTOR SHALL COORDINATE UNDERGROUND DEMOLITION REQUIREMENTS WITH ALL OTHER TRADES TO AVOID CONFLICT.
2. ALL DEMOLITION WORK SHALL BE DONE IN ACCORDANCE WITH ARCHITECTURAL PHASING SCHEDULE. CONTRACTOR SHALL REFER TO ARCHITECTURAL AND MECHANICAL DRAWINGS FOR ADDITIONAL DEMOLITION REQUIREMENTS.
3. (E) FULL BOX NOT SHOWN OR IDENTIFIED ON DRAWINGS TO REMAIN AND SHALL NEED TO BE ADJUSTED TO (N) FINISH GRADE. CONTRACTOR TO PROVIDE AND INCLUDE, IN BID, BOX ADJUSTMENTS. ADJUSTMENTS INCLUDE (N) GRAVEL AND ADDITIONAL PULL BOX APRON.
4. ALL (E) CONDUITS SHOWN ON DRAWINGS ARE DIAGRAMMATIC AND MAY NOT REFLECT EXACT ROUTING. CONTRACTORS TO INCLUDE IN BID PROFESSIONAL UNDERGROUND CONDUIT LOCATOR AS NEEDED FOR HEAVY TO BE FAMILIAR WITH THE (E) SITE CONDITIONS AND PROVIDE REQUIRED WORK AND ADJUSTMENTS TO EXTEND/RECONNECT POWER CONDUITS AS NOTED IN DRAWINGS.
5. CONTRACTOR SHALL VERIFY ALL EXISTING ELECTRICAL EQUIPMENT NOTED ON DRAWINGS AND REMOVE TO SOURCE. CONTRACTOR SHALL BE RESPONSIBLE FOR FIELD VERIFYING AND LOCATING POWER AND COMMUNICATION SOURCE AND PROPERLY SAFE-OFF ALL ELECTRICAL EQUIPMENT NOTED TO BE DEMOLISHED.

### CONDUIT SCHEDULE:

| POWER SYSTEMS |   | COMMUNICATION SYSTEMS |   |
|---------------|---|-----------------------|---|
| 1             | (E) (6) 2" CO - FUTURE BASEBALL FIELD LIGHTING<br>(E) (2) 2" CO - FUTURE BASEBALL TICKET BOOTH<br>(E) (1) 1/2" CO - FUTURE BASEBALL SPARE | 10                    | (E) 4" CO - DATA / FIBER (VOIP)<br>(E) 2" CO - SIGNAL   |
| 2             | (E) 4" - P64E PRIMARY   | 11                    | (E) 4" - DATA/ FIBER (VOIP)<br>(E) 4" CO - DATA/ FIBER (VOIP)<br>(E) 2" CO - SIGNAL/ INTRUSION  |
| 3             | (E) (3) 2" - P64E PRIMARY   | 12                    | (E) 4" - FIBER (VOIP) - FOOTBALL PRESS BOX<br>(E) 4" - FIBER (VOIP) - SOFTBALL PRESS BOX<br>(E) 4" CO - DATA / FIBER (VOIP BASEBALL)<br>(E) 2" CO - SIGNAL/ INTRUSION |
| 4             | (E) (2) 2" - EMERGENCY<br>(E) (2) 2" CO - NON-EMERGENCY   | 13                    | (E) 4" - FIBER (VOIP)<br>(E) 4" CO - FIBER<br>(E) 2" CO - SIGNAL/ INTRUSION   |

IDENTIFICATION STAMP  
DIV. OF THE STATE ARCHITECT  
APP. 02-118017 INC.  
REVIEWED FOR  
SS ☐ FLS ☐ ACS ☐  
DATE: 04/10/2020

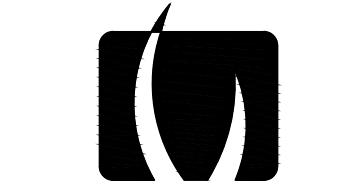

VERDE DESIGN  
LANDSCAPE ARCHITECTURE  
CIVIL ENGINEERING  
SPORT PLANNING & DESIGN

1843 Iron Point Rd #140  
Folsom, CA 95630  
tel: 916.415.6554  
fax: 408.985.7260  
www.VerdeDesignInc.com

STAMP



CONSULTANT



American Consulting Engineers  
Electrical, Inc.

1560 The Hermosa, Suite 200  
San Jose, CA 95128  
JOB # E19146-00

KEYMAP

SHEET TITLE

ELECTRICAL  
DEMOLITION  
SITE PLAN

PROJECT NAME

CHAVEZ HIGH SCHOOL  
STOCKTON USD  
ATHLETIC FACILITY  
IMPROVEMENTS

PROJECT ADDRESS

2929 WINDFLOWER LN  
STOCKTON, CA 95212

| SUBMITTAL               | DATE     |
|-------------------------|----------|
| DD/50% SUBMITTAL        | 10/25/19 |
| DSA SUBMITTAL           | 12/20/19 |
| DSA BACKCHECK SUBMITTAL | 03/27/20 |

| NO. | REVISIONS | DATE |
|-----|-----------|------|
| 1   |           |      |
| 2   |           |      |
| 3   |           |      |
| 4   |           |      |

|                         |                      |
|-------------------------|----------------------|
| DRAWN BY<br>MG          | CHECKED BY<br>SB/ SF |
| DATE ISSUED<br>03/27/20 | SCALE                |


PROJ. NO.  
1910900-1211

SHEET NO.  
E1.0 OF #

ELECTRICAL DEMOLITION SITE PLAN



ALL DESIGN, DRAWING, AND CONSTRUCTION INFORMATION IS THE PROPERTY OF VERDE DESIGN, INC. AND IS NOT TO BE REPRODUCED, COPIED, OR DISCLOSED TO ANY PERSON, FIRM, OR ORGANIZATION WITHOUT THE WRITTEN PERMISSION OF VERDE DESIGN, INC. ANY REUSE OR MODIFICATION OF THIS INFORMATION WITHOUT THE WRITTEN PERMISSION OF VERDE DESIGN, INC. IS PROHIBITED.

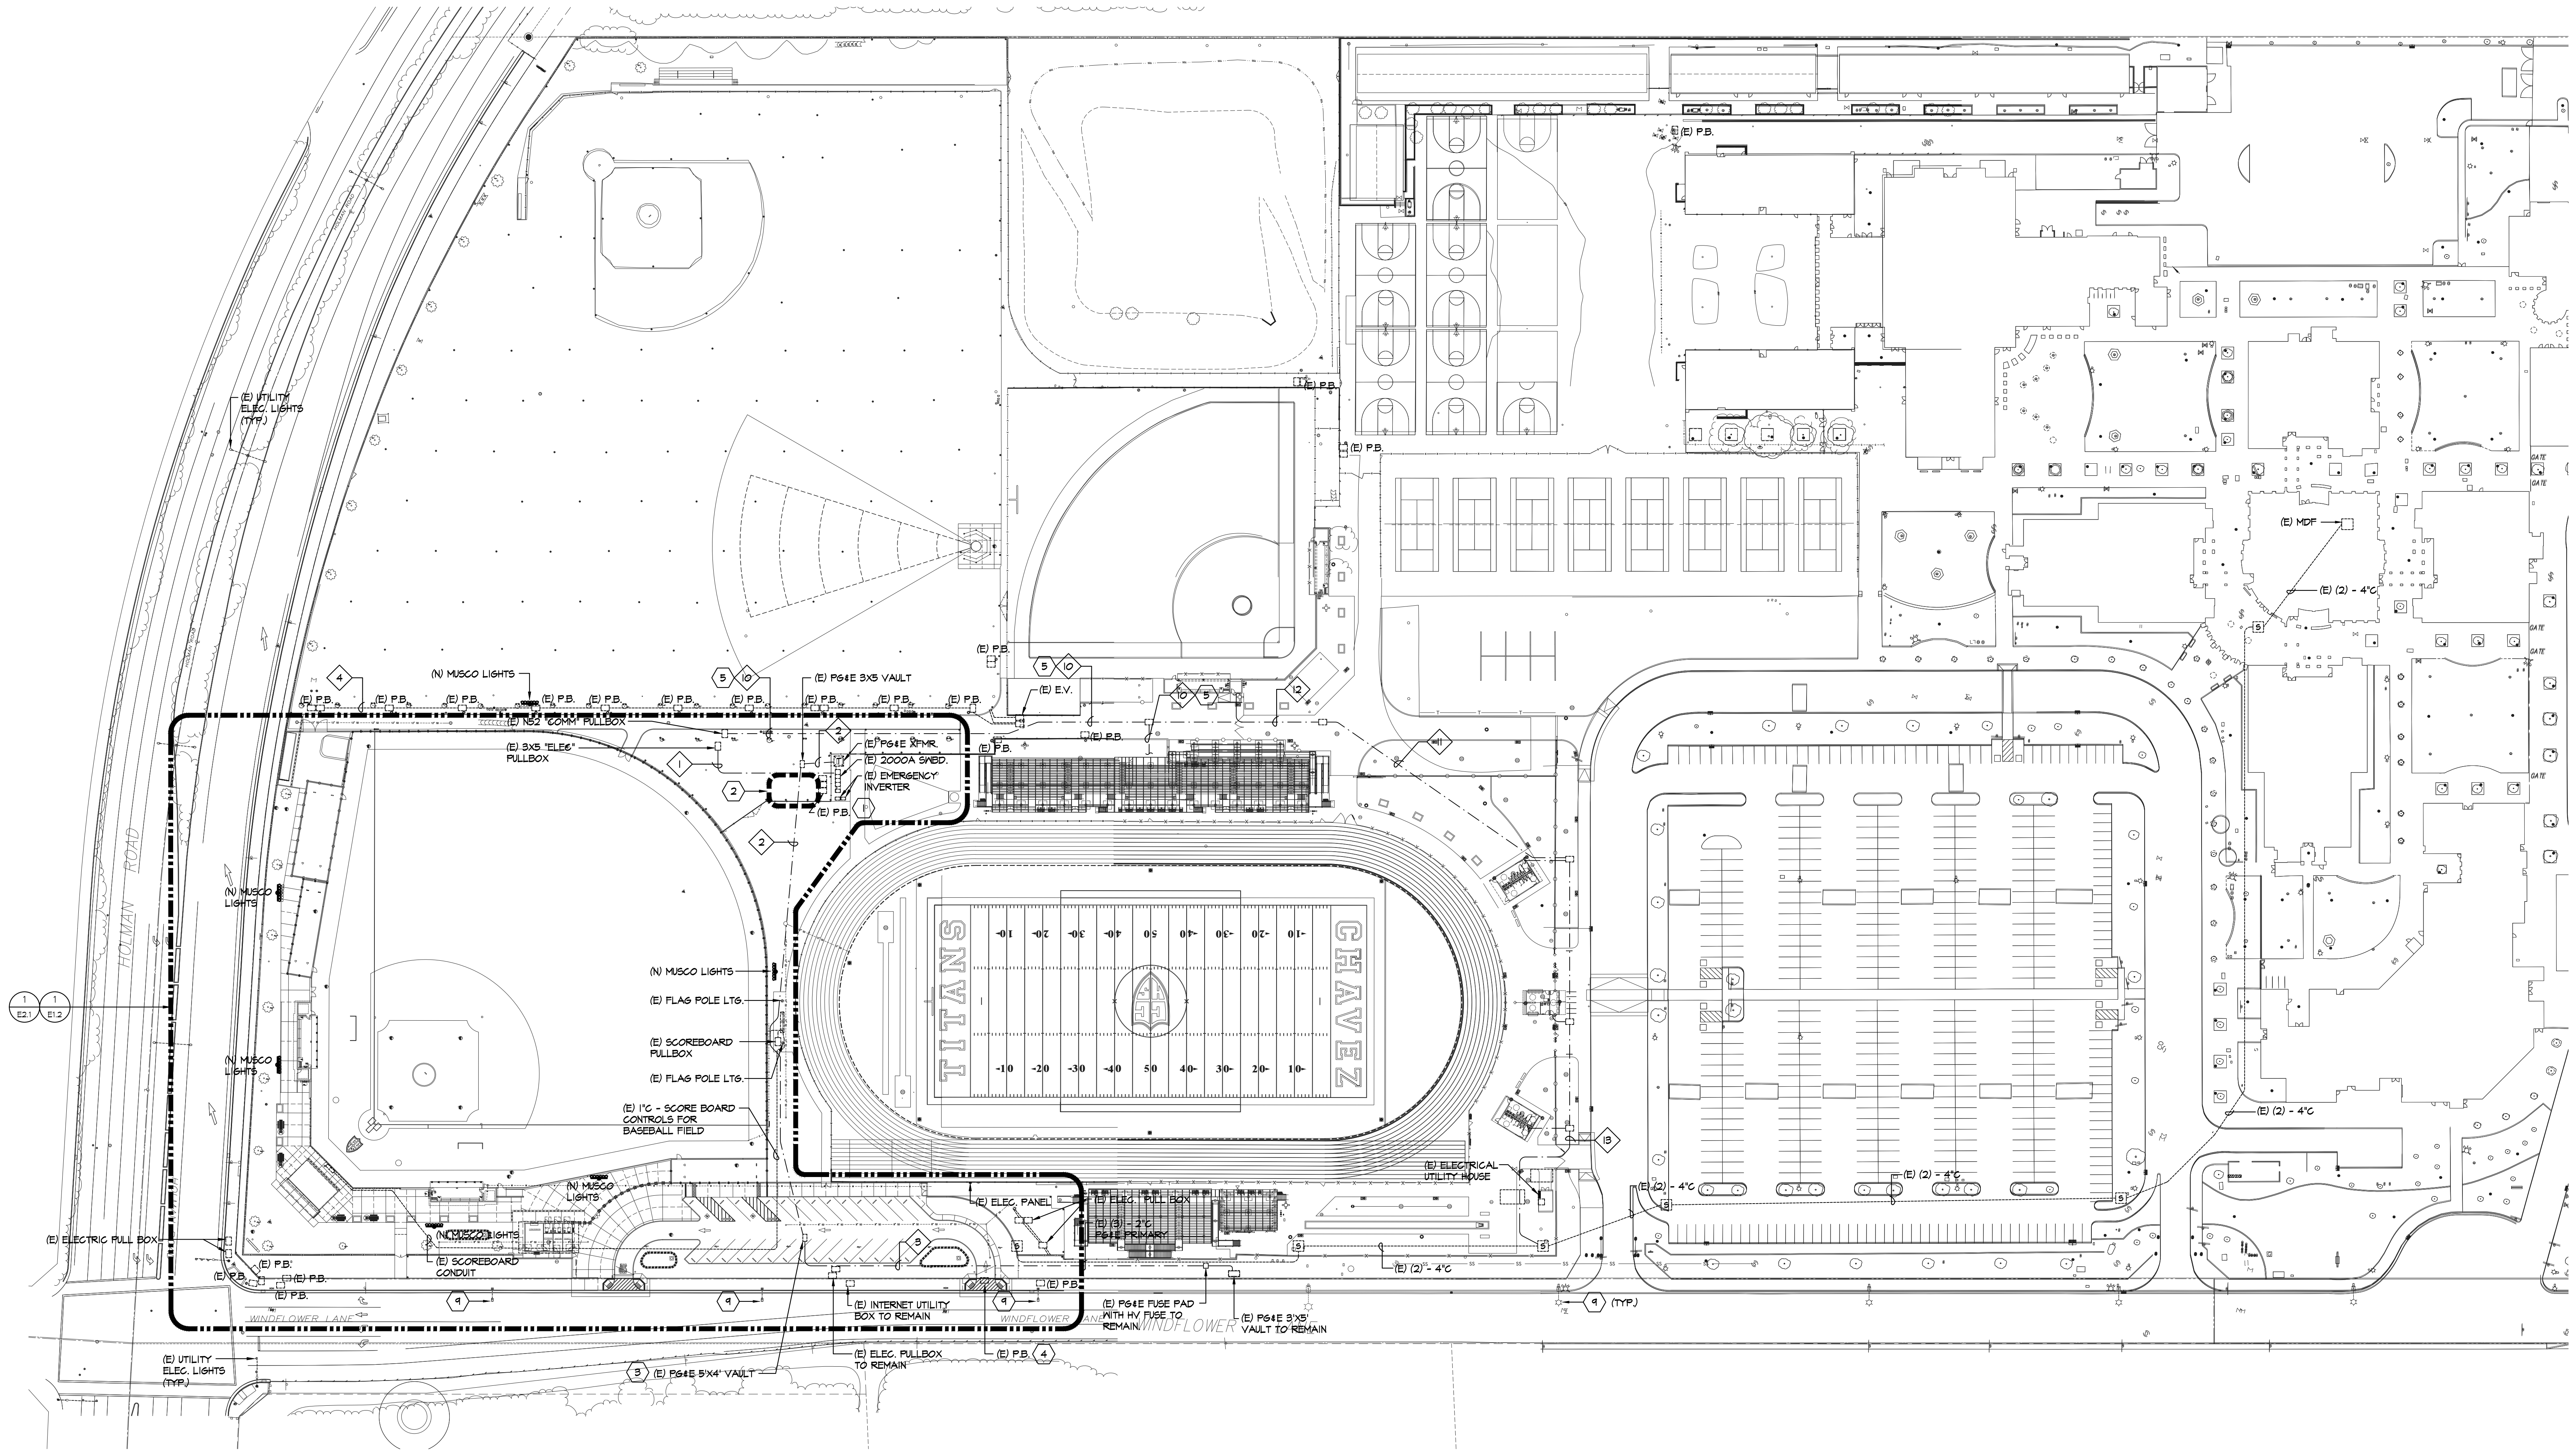

1 **ELECTRICAL SITE PLAN - NEW**  
E1.1 SCALE: 1" = 60'-0"

## GENERAL NOTES.

- CONTRACTOR SHALL COORDINATE UNDERGROUND REQUIREMENTS WITH ALL OTHER TRADES TO AVOID CONFLICT.
- CONTRACTOR TO SITE SURVEY EXISTING CONDITIONS AND LOCATIONS OF EXISTING UNDERGROUND SYSTEMS, WHERE (N) TRENCHWORK OCCURS PRIOR TO BIDDING. CONTRACTOR SHALL TAKE PROPER PRECAUTIONS TO ENSURE (E) UNDERGROUND SYSTEMS/CONDUITS/PIPES ARE NOT DAMAGED DURING INSTALLATION. CONTRACTOR IS RESPONSIBLE FOR ANY REPAIRS REQUIRED IN THE EVENT THE (E) UNDERGROUND SYSTEMS ARE DAMAGED AS A RESULT OF THE (N) ELECTRICAL TRENCHWORK.
- SEE SINGLE LINE DIAGRAM FOR WIRE SIZES AND CONDUIT REQUIREMENTS.
- CONTRACTOR TO COORDINATE SITE PLAN TO COMBINE ALL UNDERGROUND CONDUIT IN COMMON TRENCH AS NECESSARY.
- ALL EMPTY CONDUIT SHALL BE PROVIDED WITH NYLON PULL CORD AS NOTED IN THE SPECIFICATIONS.
- ALL ELECTRICAL WORK SHALL BE INSTALLED PER 2016 NEC.
- PRIOR TO ALL (N) TRENCHES, CONTRACTOR TO USA ALL (E) ELECTRICAL CONDUITS AND OTHER UTILITIES TO FAMILIARIZE THEMSELVES WITH THE FIELD CONDITIONS AND ADJUST (N) TRENCHES ACCORDINGLY.
- IN-GRADE PULL BOX IDENTIFIED WITH 'P' SHALL HAVE LID LABELED 'ELECTRICAL'.
- IN-GRADE PULL BOX IDENTIFIED WITH 'S' SHALL HAVE LID LABELED 'SIGNAL'.
- CONTRACTOR SHALL BE RESPONSIBLE FOR ANY SAN CUTTING AND REMOVAL OF EXISTING SURFACES TO FACILITATE UNDERGROUND SYSTEMS. THE CONTRACTOR SHALL PATCH AND REPAIR ALL DAMAGED AND CUT SURFACES TO MATCH ADJACENT.
- CONTRACTOR SHALL COORDINATE FINAL LOCATION OF ALL IN-GRADE PULL BOX WITH LANDSCAPE ARCHITECT. THE INTENT IS TO VOID RELOCATING PULL BOXES.
- ALL POWER SYSTEM CONDUITS STUB IN 'ELECTRICAL' PULL BOX AND ALL COMMUNICATION SYSTEMS CONDUIT IN 'SIGNAL' BOXES AS REQUIRED BY CODE.

## SHEETS NOTES.

- LOCATE (E) POWER PULL BOX AND STUB NEW CONDUIT AS SHOWN.
- CONTRACTOR TO TRENCH DEEPER TO AVOID (E) 4" P64E PRIMARY. EXISTING P64E IS ROUGHLY 36" DEEP. CONTRACTOR TO VERIFY CONDUITS CAN CROSS. PROVIDE (N) CONDUIT HAS 18" SEPARATION FROM (E) P64E CONDUIT.
- EXISTING P64E VAULT TO BE REPLACED TO FACILITATE NEW PARKING LOT. THE EXISTING SERVICE VAULT IS THE PRIMARY SERVICE BOX FEEDING THE EXISTING 2000A 5-PHASE OUTDOOR SWITCHBOARD FOR THE SPORT FIELD. TWO EXISTING 44C PRIMARY COMES IN AND OUT OF THIS BOX. THE CONTRACTOR SHALL BE RESPONSIBLE AND INCLUDE ALL WORK NECESSARY TO REPLACE THE EXISTING 3X5 P64E VAULT. WORK ALSO INCLUDES THE CONTRACTOR TO SUBMIT A P64E APPLICATION AND SCHEDULE/COORDINATE THE REPLACEMENT WITH P64E AND THEIR INSPECTORS WITHIN THE CONTRACTED COMPLETION DATE OF THE PROJECT. CONTRACTOR SHALL SHUT-OFF EXISTING ELECTRICAL SYSTEMS IN ORDER TO PROPERLY SHUT-DOWN POWER PER SPECIFICATIONS. CONTRACTOR SHALL BE RESPONSIBLE FOR ANY DAMAGE AS A RESULT OF IMPROPER SHUT DOWN EXISTING SYSTEMS THAT ARE ON THE (E) 2000A ARE NOTED ON THE SINGLE LINE DIAGRAM. CONTRACTOR SHALL BE RESPONSIBLE TO PROVIDE A FIRE WATCH WHEN THE FIRE ALARM SYSTEM IS DOWN FOR THE SPORT FIELD BUILDING (PRESS BOX, CONCESSION, RESTROOM ETC.). CONTRACTOR MAY NEED TO PROVIDE A TEMP GENERATOR AS AN OPTION TO KEEP THE FIRE ALARM ACTIVE IN LIEU OF A FIRE WATCH. THE EXISTING FIELD INVERTER WILL NEED TO BE IN SAFE MODE SUCH THAT THE EMERGENCY BATTERIES DO NOT DRAIN. CONTRACTOR SHALL CONFIRM AND OBTAIN APPROVAL WITH THE DISTRICT PRIOR TO PLACEMENT IN SAFE MODE. IN ADDITION, UPS WILL NEED TO BE PROPERLY SHUT-DOWN WITH DISTRICT IT TO ENSURE NO DAMAGE. CONTRACTOR TO PROVIDE AND SCHEDULE PROPER SHUT-DOWN WITH DISTRICT IT AND OBTAIN CONFIRMATION. CONTRACTOR SHALL BE RESPONSIBLE FOR ANY P64E FEES TO FACILITATE AND SCHEDULE 3X5 VAULT REPLACEMENT.
- PROTECT AND ADJUST AS NEEDED TO FACILITATE DEMOLITION AND NEW WORK. PROVIDE NEW TRAFFIC RATED LID.
- ROUTE NEW FIBER AND INTRUSION CABLES IN EXISTING SIGNAL CONDUITS.
- NOT USED.
- NOT USED.
- NOT USED.
- CONTRACTOR TO VERIFY (E) LIGHT POLES ARE OPERATIONAL. REPORT (E) POLES FOR DEFECTIVE LAMPS.

## CONDUIT SCHEDULE.

| POWER SYSTEMS |   |
|---------------|---|
| 1             | (E) 6) 2 1/2" CO - FUTURE BASEBALL FIELD LIGHTING |
|               | (E) 2) 2" CO - FUTURE BASEBALL TICKET BOOTH       |
|               | (E) 1) 1 1/2" CO - FUTURE BASEBALL SFARE          |
| 2             | (E) 4" C - P64E PRIMARY                           |
| 3             | (E) 5) 2" C - P64E PRIMARY                        |
| 4             | (E) 2) 2" C - EMERGENCY                           |
|               | (E) 2) 2" CO - NON-EMERGENCY                      |

| COMMUNICATION SYSTEMS |  |
|-----------------------|--|
| 10                    | (E) 4" CO - DATA / FIBER (VOIP)              |
|                       | (E) 2" CO - SIGNAL                           |
| 11                    | (E) 4" C - DATA/ FIBER (VOIP)                |
|                       | (E) 4" CO - DATA/ FIBER (VOIP)               |
|                       | (E) 2" CO - SIGNAL/ INTRUSION                |
| 12                    | (E) 4" C - FIBER (VOIP) - FOOTBALL PRESS BOX |
|                       | (E) 4" C - FIBER (VOIP) - SOFTBALL PRESS BOX |
|                       | (E) 4" CO - DATA / FIBER (VOIP BASEBALL)     |
|                       | (E) 2" CO - SIGNAL/ INTRUSION                |
| 13                    | (E) 4" C - FIBER (VOIP)                      |
|                       | (E) 4" CO - FIBER                            |
|                       | (E) 2" CO - SIGNAL/ INTRUSION                |

IDENTIFICATION STAMP  
DIV. OF THE STATE ARCHITECT  
APP. 02-118017 INC.  
REVIEWED FOR  
SS ☒ FLS ☒ ACS ☒  
DATE: 04/10/2020



**VERDE DESIGN**  
LANDSCAPE ARCHITECTURE  
CIVIL ENGINEERING  
SPORT PLANNING & DESIGN  
1843 Iron Point Rd #140  
Folsom, CA 95630  
tel: 916.415.6554  
fax: 916.985.7260  
www.VerdeDesignInc.com

STAMP



CONSULTANT



**American Consulting Engineers**  
Electrical, Inc.  
1560 The Hermite, Suite 200  
San Jose, CA 95128  
JOB # E19148-00 Fax: 408.258-1312

KEYMAP

SHEET TITLE

**ELECTRICAL  
SITE PLAN - NEW**

PROJECT NAME

**CHAVEZ HIGH SCHOOL  
STOCKTON USD  
ATHLETIC FACILITY  
IMPROVEMENTS**

PROJECT ADDRESS

**2929 WINDFLOWER LN  
STOCKTON, CA 95212**

| SUBMITTAL               | DATE     |
|-------------------------|----------|
| DD/50% SUBMITTAL        | 10/25/19 |
| DSA SUBMITTAL           | 12/20/19 |
| DSA BACKCHECK SUBMITTAL | 03/27/20 |

| NO. | REVISIONS | DATE |
|-----|-----------|------|
| 1   |           |      |
| 2   |           |      |
| 3   |           |      |
| 4   |           |      |
| 5   |           |      |

|             |            |
|-------------|------------|
| DRAWN BY    | CHECKED BY |
| MG          | SB/ SF     |
| DATE ISSUED | SCALE      |
| 03/27/20    |            |


PROJ. NO. 1910900-1211

SHEET NO. **E1.1** OF #

**ELECTRICAL SITE PLAN - NEW**



ALL DESIGN, CONSTRUCTION, AND/OR INSTALLATION OF ANY KIND OF IMPROVEMENTS OF ANY KIND, INCLUDING BUT NOT LIMITED TO, THE PROPERTY OF VERDE DESIGN, INC. AND WERE CREATED, DEVELOPED, AND DEVELOPED FOR USE ON AND IN CONNECTION WITH THE SPECIFIED PROJECT. NONE OF SUCH IDEAS, DESIGNS, ARRANGEMENTS OR PLANS SHALL BE USED, REPRODUCED, OR PUBLISHED IN WHOLE OR IN PART, OR DISCLOSED TO ANY PERSON, FIRM, OR CORPORATION FOR ANY PURPOSE WITHOUT THE WRITTEN PERMISSION OF VERDE DESIGN, INC.

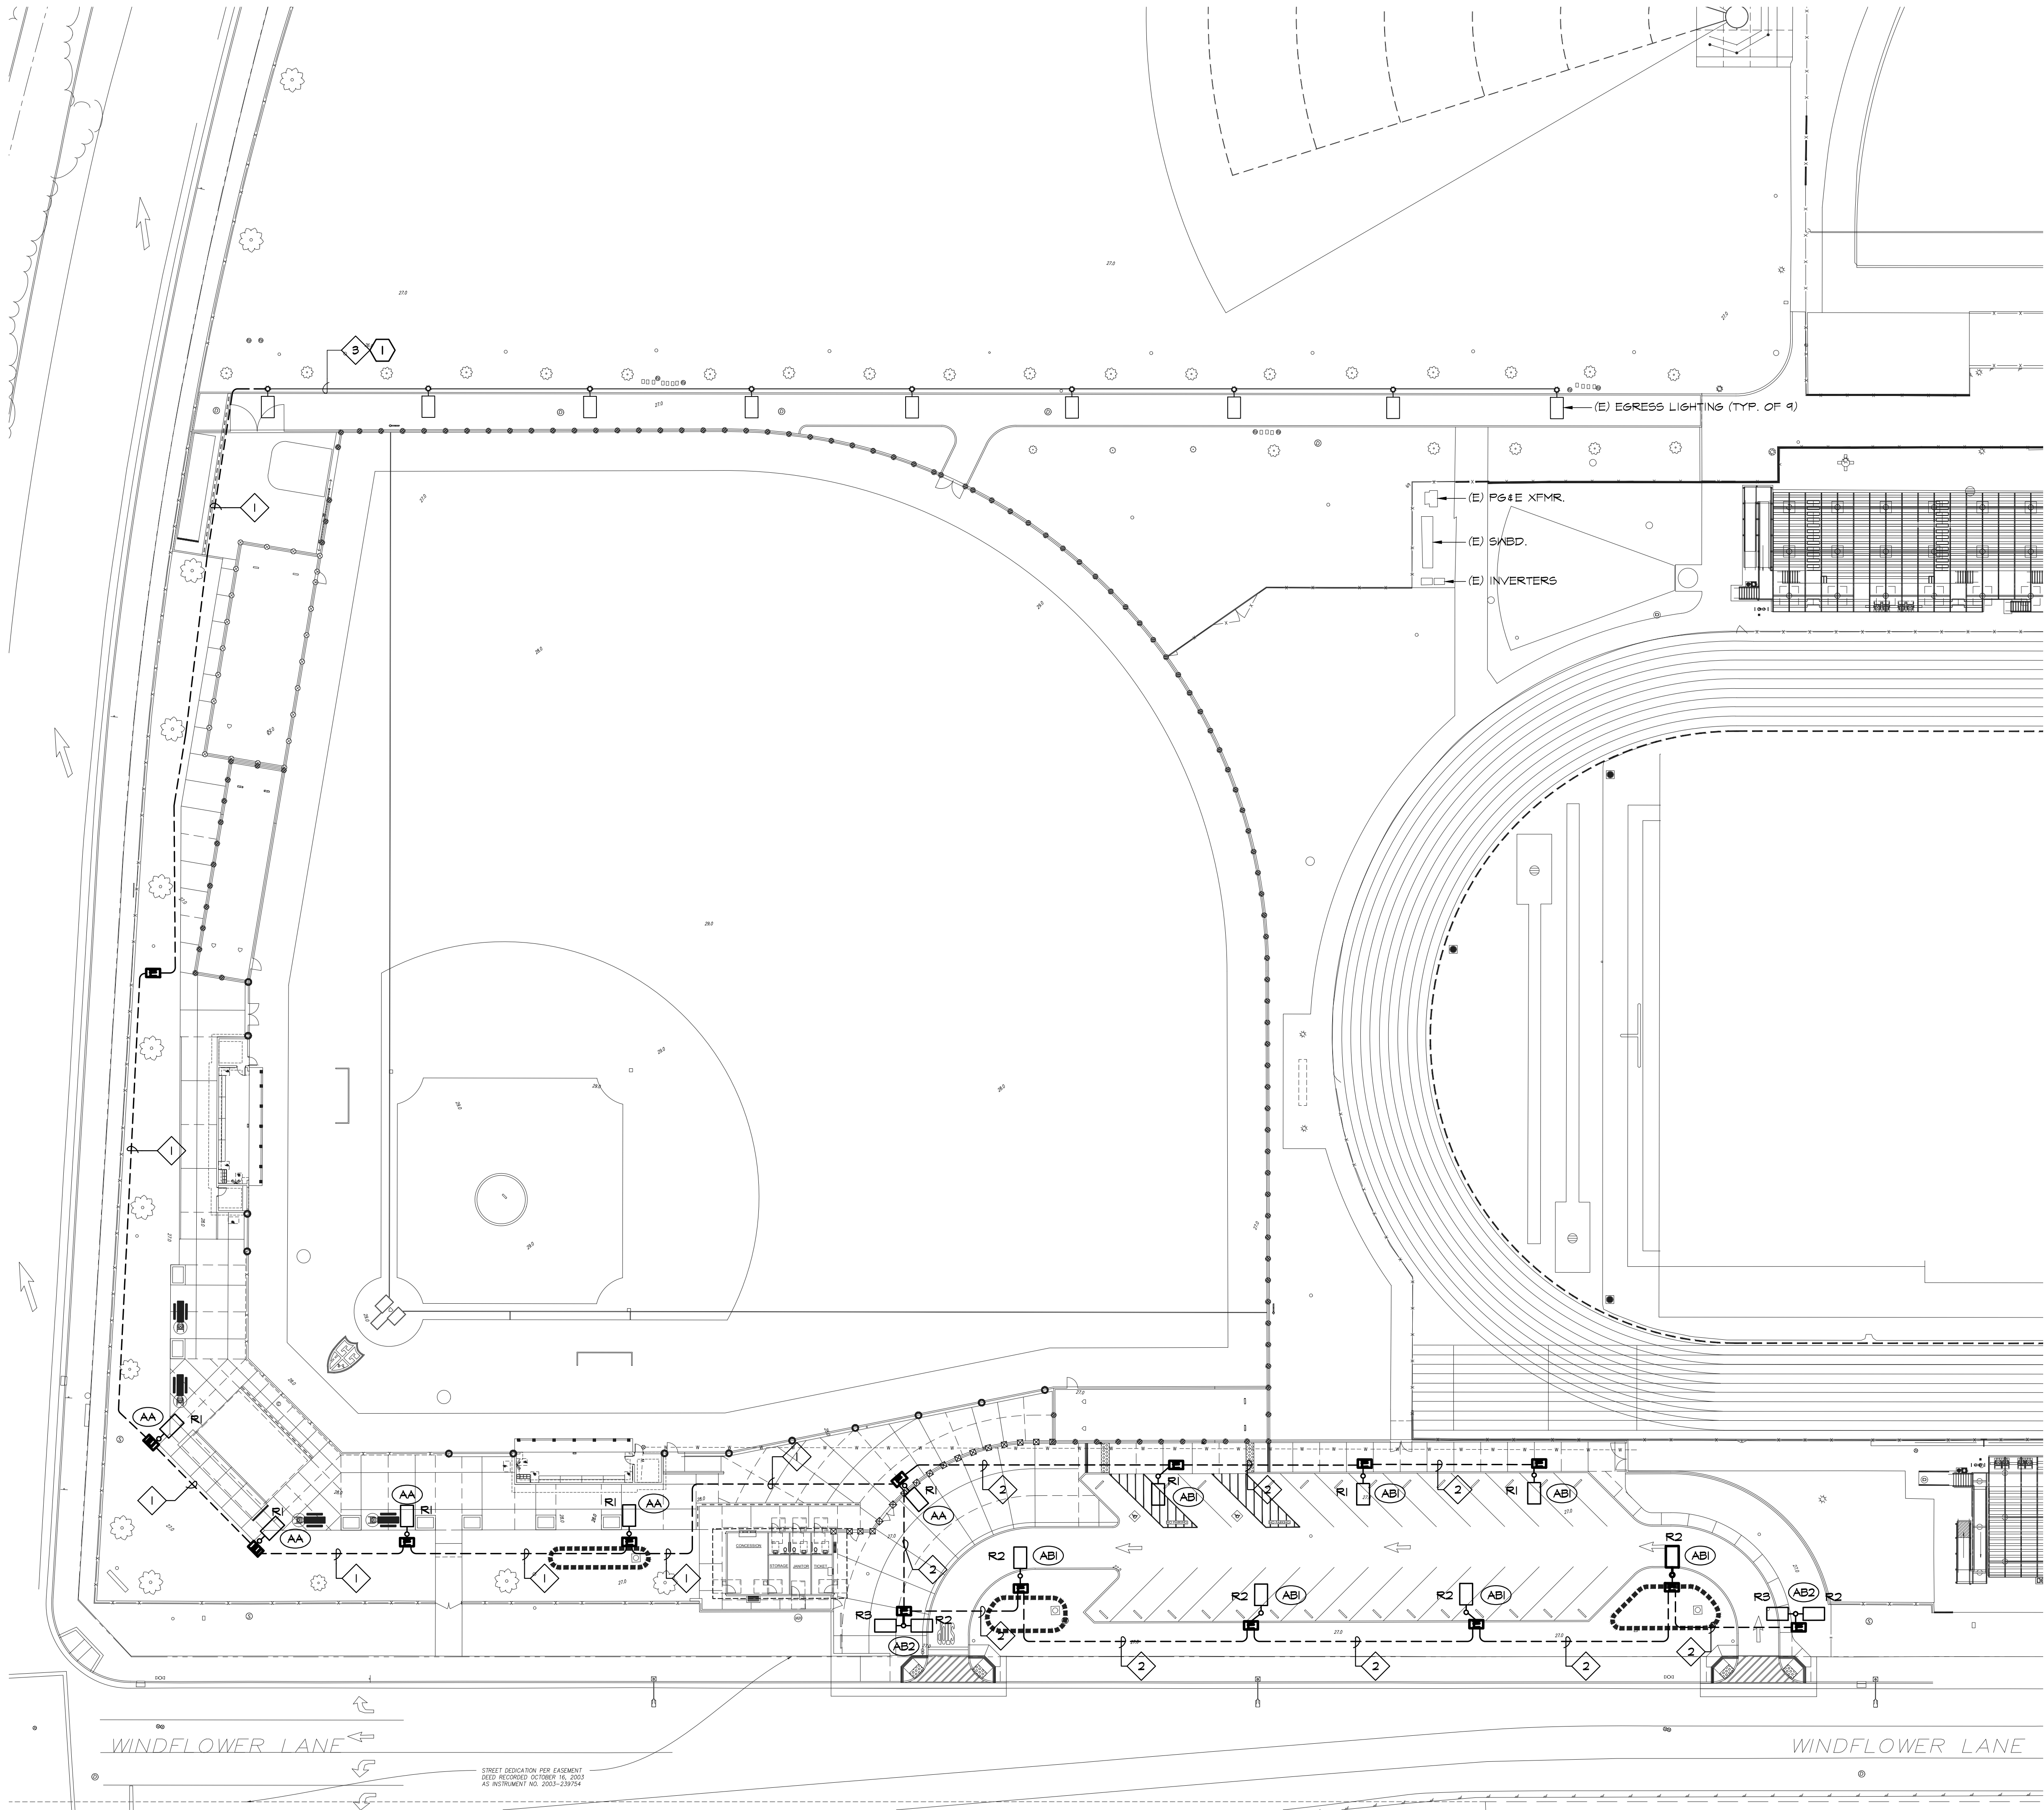

1  
E1.2  
**ENLARGED NEW PARKING LIGHTING PLAN**  
SCALE: 1" = 30'-0"



## GENERAL NOTES:




1. ALL ELECTRICAL WORK SHALL COMPLY WITH THE 2016 CALIFORNIA ELECTRICAL CODE.
2. CONTRACTOR SHALL COORDINATE UNDERGROUND REQUIREMENTS WITH ALL OTHER TRADES TO AVOID CONFLICT.
3. CONTRACTOR SHALL BE RESPONSIBLE FOR ANY SAW CUTTING AND REMOVAL OF EXISTING SURFACES TO FACILITATE UNDERGROUND SYSTEMS. THE CONTRACTOR SHALL PATCH AND REPAIR ALL DAMAGED AND CUT SURFACES TO MATCH ADJACENT.
4. CONTRACTOR TO COORDINATE ELECTRICAL SITE PLAN, FA AND PEDESTRIAN SITE PLAN TO COMBINE ALL UNDERGROUND CONDUITS IN COMMON TRENCH AS NECESSARY. EMERGENCY CIRCUITS SHALL HAVE THEIR PULL BOXES OR PULL CAN AS REQUIRED BY CODE.
5. SEE SHEETS ET.1 THRU ET.4 FOR ADDITIONAL DETAILS.
6. CONTRACTOR TO PROVIDE COMPLETE WORKING EGRESS LIGHTING SYSTEM AND PROVIDE TRAINING WITH DISTRICT FOR PROPER OPERATION AND MAINTENANCE OF SYSTEM.
7. CONTRACTOR TO SITE SURVEY EXISTING CONDITIONS AND LOCATIONS OF EXISTING UNDERGROUND SYSTEMS WHERE (N) TRENCHWORK OCCURS PRIOR TO BIDDING. CONTRACTOR SHALL TAKE PROPER PRECAUTIONS TO ENSURE (E) UNDERGROUND SYSTEMS/CONDUITS/PIPES ARE NOT DAMAGED DURING INSTALLATION. CONTRACTOR IS RESPONSIBLE FOR ANY REPAIRS REQUIRED IN THE EVENT THE (E) UNDERGROUND SYSTEMS ARE DAMAGED AS A RESULT OF THE (N) ELECTRICAL TRENCHWORK.
8. ALL EMPTY CONDUIT SHALL BE PROVIDED WITH NYLON PULL CORD AS NOTED IN THE SPECIFICATIONS.
9. SEE SINGLE LINE DIAGRAM FOR WIRE SIZES AND CONDUIT REQUIREMENTS FOR EMERGENCY LIGHTING.
10. ALL EMERGENCY CIRCUITS SHALL BE PROVIDED WITH IN-GRADE BOXES PER NEG. LABEL LID "EMERGENCY".
11. ALL EXPOSED CONDUIT MOUNTED ON PRESS BOX OR BLEACHER SHALL BE RIGID STEEL.
12. SPLICE GROUND WIRE INSIDE ALL METAL ELECTRICAL PULL BOXES LABELED "EMERGENCY POWER" AND BOND TO METAL COVER WITH #6 CU GND.

## SHEETS NOTES:

- ① ROUTE NEW WIRES FOR NEW EGRESS LIGHTING IN (E) (2) 2" C.

## CONDUIT SCHEDULE:

- ① (2) 1 1/2" C - EMERGENCY LIGHTING  
(1) 1 1/2" CO - SPARE
- ② 1 1/2" C - EMERGENCY LIGHTING  
1 1/2" CO - SPARE
- ③ (E) 2" C - EMERGENCY

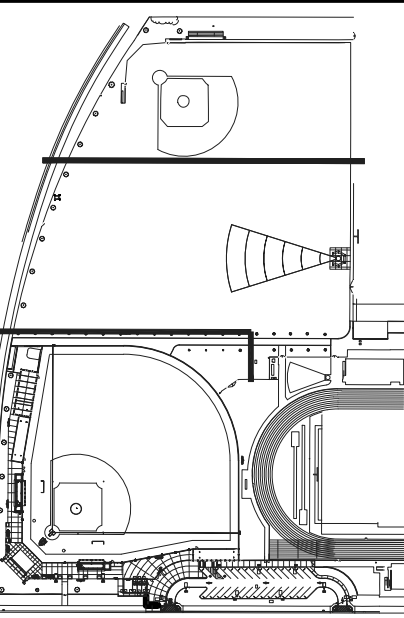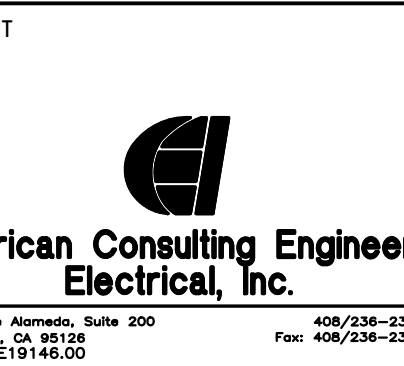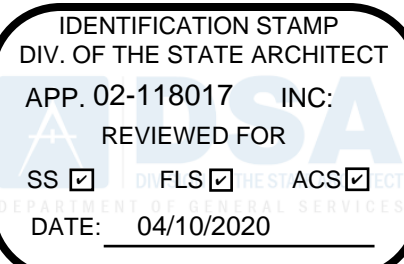

SHEET TITLE

**ENLARGED NEW PARKING  
LIGHTING PLAN**

PROJECT NAME

**CHAVEZ HIGH SCHOOL  
STOCKTON USD  
ATHLETIC FACILITY  
IMPROVEMENTS**

PROJECT ADDRESS

**2929 WINDFLOWER LN  
STOCKTON, CA 95212**

| SUBMITTAL               | DATE     |
|-------------------------|----------|
| DD/50% SUBMITTAL        | 10/25/19 |
| DSA SUBMITTAL           | 12/20/19 |
| DSA BACKCHECK SUBMITTAL | 03/27/20 |

| NO. | REVISIONS | DATE |
|-----|-----------|------|
| △   |           |      |
| △   |           |      |
DRAWN BY: MG  
DATE ISSUED: 03/27/20

CHECKED BY: SB/ SF  
SCALE:

PROJ. NO.: 1910900-1211


SHEET NO.: **E1.2**

OF #

ENLARGED NEW PARKING LIGHTING PLAN



ALL DESIGN INFORMATION, INCLUDING BUT NOT LIMITED TO, THE DESIGN OF THE PROJECT, IS THE PROPERTY OF VERDE DESIGN, INC. AND WILL BE KEPT CONFIDENTIAL. NO PART OF THIS DESIGN SHALL BE REPRODUCED, COPIED, OR DISCLOSED TO ANY PERSON, FIRM, OR CORPORATION FOR ANY PURPOSE WITHOUT THE WRITTEN PERMISSION OF VERDE DESIGN, INC.

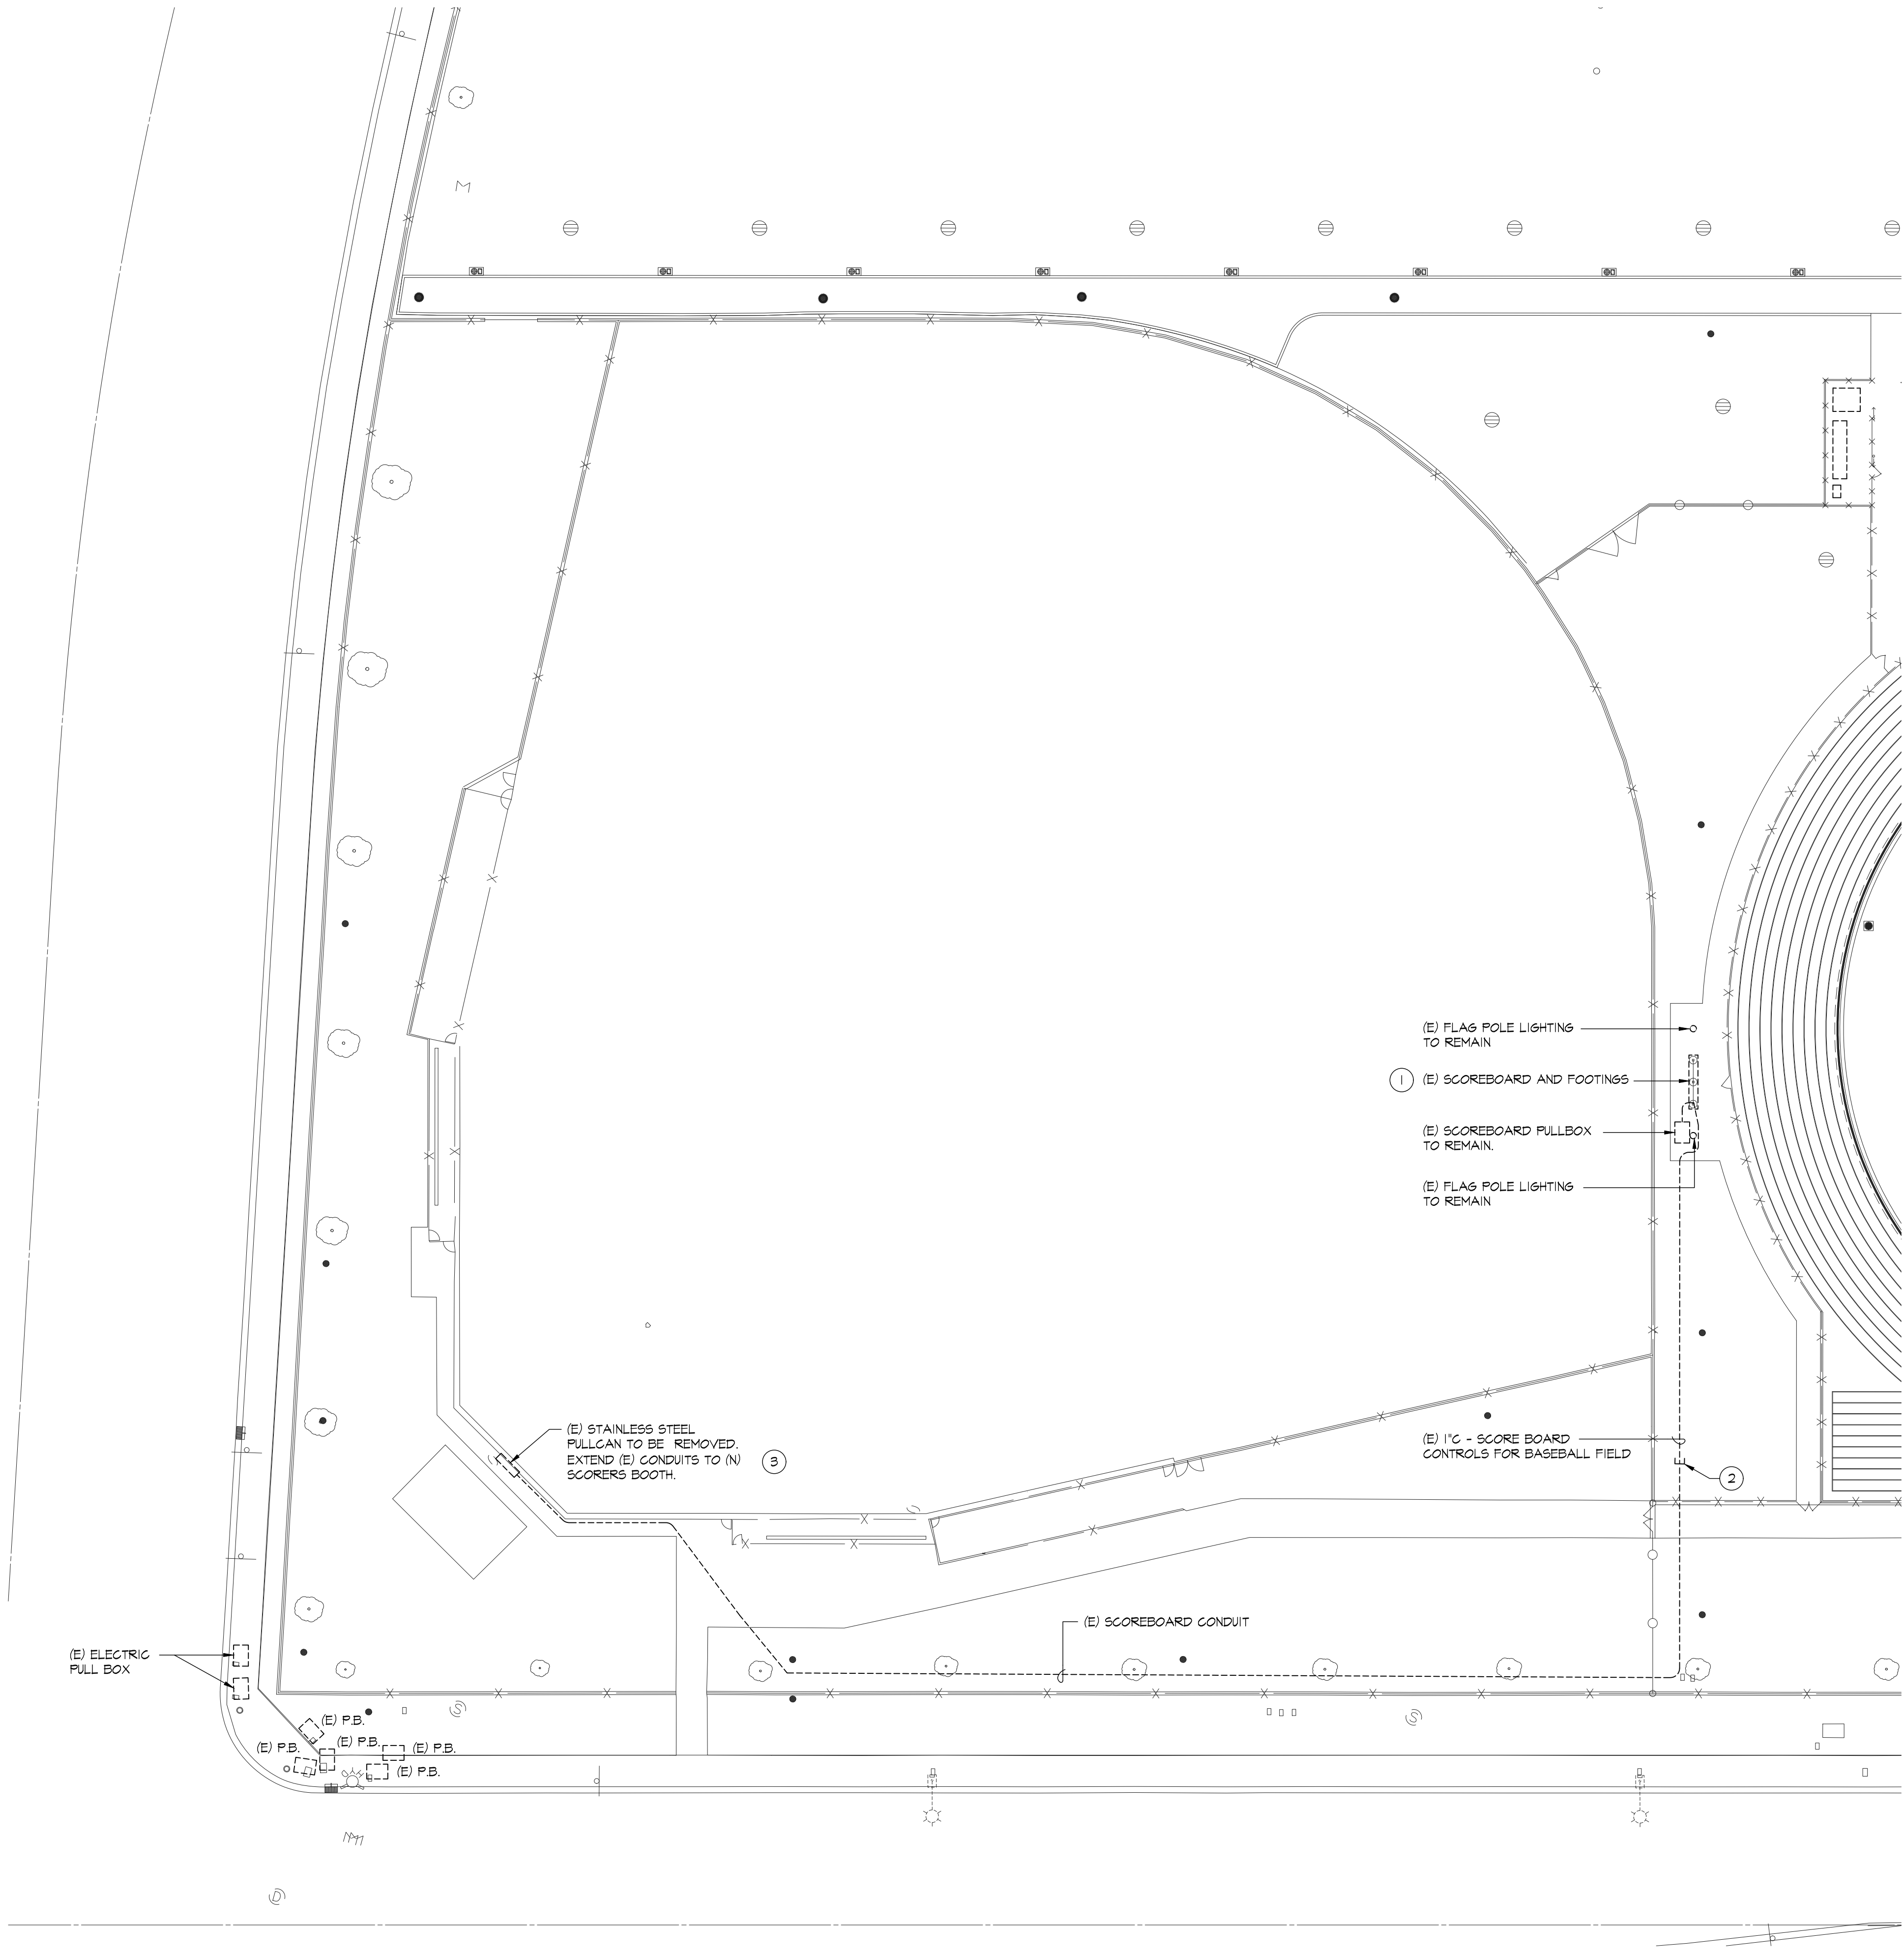

1  
E2.0  
**ENLARGED BASEBALL FIELD - ELECTRICAL DEMOLITION SITE PLAN**  
SCALE: 1" = 30'-0"



### GENERAL DEMOLITION NOTES:

1. CONTRACTOR SHALL COORDINATE UNDERGROUND DEMOLITION REQUIREMENTS WITH ALL OTHER TRADES TO AVOID CONFLICT.
2. ALL DEMOLITION WORK SHALL BE DONE IN ACCORDANCE WITH ARCHITECTURAL PHASING SCHEDULE. CONTRACTOR SHALL REFER TO ARCHITECTURAL AND MECHANICAL DRAWINGS FOR ADDITIONAL DEMOLITION REQUIREMENTS.
3. (E) PULL BOX NOT SHOWN OR IDENTIFIED ON DRAWINGS TO REMAIN AND SHALL NEED TO BE ADJUSTED TO (N) FINISH GRADE. CONTRACTOR TO PROVIDE AND INCLUDE, IN BID, BOX ADJUSTMENTS. ADJUSTMENTS INCLUDE (N) GRAVEL AND ADDITIONAL PULL BOX APRON.
4. ALL (E) CONDUITS SHOWN ON DRAWINGS ARE DIAGRAMMATIC AND MAY NOT REFLECT EXACT ROUTING. CONTRACTORS TO INCLUDE IN BID PROFESSIONAL UNDERGROUND CONDUIT LOCATOR AS NEEDED FOR HE/SHE TO BE FAMILIAR WITH THE (E) SITE CONDITIONS AND PROVIDE REQUIRED WORK AND ADJUSTMENTS TO EXTEND/RECONNECT POWER CONDUITS AS NOTED IN DRAWINGS.


### DEMOLITION SHEETS NOTES:

- 1 (E) SCOREBOARD IS DOUBLE-SIDED AND SERVES BASEBALL & FOOTBALL. CONTRACTOR TO IDENTIFY AND CONFIRM CABLES FOR SCORE KEEPER CONTROLS. (E) SCORE KEEPER SIGNAL CONTROL CABLES TO BE REROUTED TO (N) SCORE KEEPERS BOOTH.
- 2 LOCATE (E) UNDERGROUND 1"Ø AND EXTEND TO (N) SCORER'S BOOTH.
- 3 (E) PULL CAN WITH 120V OUTLET AND SCOREBOARD CONTROLS. (E) SCOREBOARD CONTROLS TO BE EXTENDED TO (N) SCORER'S BOOTH. (E) 120V BRANCH CIRCUIT TO BE REMOVED BACK TO SOURCE.

|                             |   |
|-----------------------------|---|
| IDENTIFICATION STAMP        |   |
| DIV. OF THE STATE ARCHITECT |   |
| APP. 02-118017              | INC.  |
| REVIEWED FOR                |   |
| SS <input type="checkbox"/> | FLS <input type="checkbox"/> ACS <input type="checkbox"/> |
| DATE: 04/10/2020            |   |

|                         |  |
|-------------------------|--|
|                         |  |
| <b>VERDE DESIGN</b>     |  |
| LANDSCAPE ARCHITECTURE  |  |
| CIVIL ENGINEERING       |  |
| SPORT PLANNING & DESIGN |  |
| 1843 Iron Point Rd #140 |  |
| Folsom, CA 95630        |  |
| tel: 916.415.6554       |  |
| fax: 408.985.7260       |  |
| www.VerdeDesignInc.com  |  |


STAMP

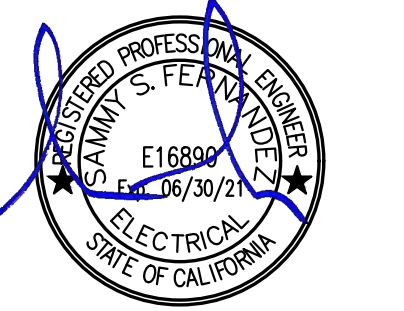

CONSULTANT

|                                      |  |
|--------------------------------------|--|
|                                      |  |
| <b>American Consulting Engineers</b> |  |
| <b>Electrical, Inc.</b>              |  |
| 1560 The Armada, Suite 200           |  |
| San Jose, CA 95128                   |  |
| JOB # E19148.00                      |  |
| Rev: 03/28-2019                      |  |

KEYMAP

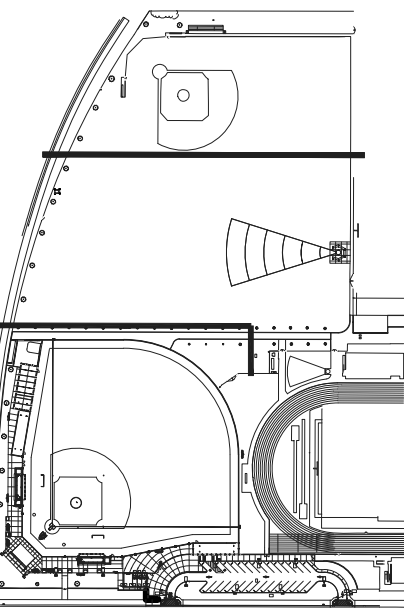

SHEET TITLE

**ENLARGED BASEBALL FIELD  
ELECTRICAL DEMOLITION  
SITE PLAN**

PROJECT NAME

**CHAVEZ HIGH SCHOOL  
STOCKTON USD  
ATHLETIC FACILITY  
IMPROVEMENTS**

PROJECT ADDRESS

**2929 WINDFLOWER LN  
STOCKTON, CA 95212**


| SUBMITTAL               | DATE     |
|-------------------------|----------|
| DD/50% SUBMITTAL        | 10/25/19 |
| DSA SUBMITTAL           | 12/20/19 |
| DSA BACKCHECK SUBMITTAL | 03/27/20 |

| NO. | REVISIONS | DATE |
|-----|-----------|------|
| △   |           |      |
| △   |           |      |
|              |            |
|--------------|------------|
| DRAWN BY     | CHECKED BY |
| MG           | SB/ SF     |
| DATE ISSUED  | SCALE      |
| 03/27/20     |            |
| PROJ. NO.    |            |
| 1910900-1211 |            |
| SHEET NO.    |            |
| E2.0         | OF #       |



ALL DESIGN, CONSTRUCTION, AND/OR INSTALLATION OF IMPROVEMENTS OF THIS PROJECT ARE OWNED BY AND THE PROPERTY OF VERDE DESIGN, INC. AND WERE CREATED, DEVELOPED, AND DELETED FOR USE ON AND IN CONNECTION WITH THE SPECIFIED PROJECT. NONE OF SUCH IDEAS, DESIGNS, ARRANGEMENTS OR PLANS SHALL BE USED, REPRODUCED, OR PUBLISHED IN WHOLE OR IN PART, OR DISCLOSED TO ANY PERSON, FIRM, OR CORPORATION FOR ANY PURPOSE WITHOUT THE WRITTEN PERMISSION OF VERDE DESIGN, INC.

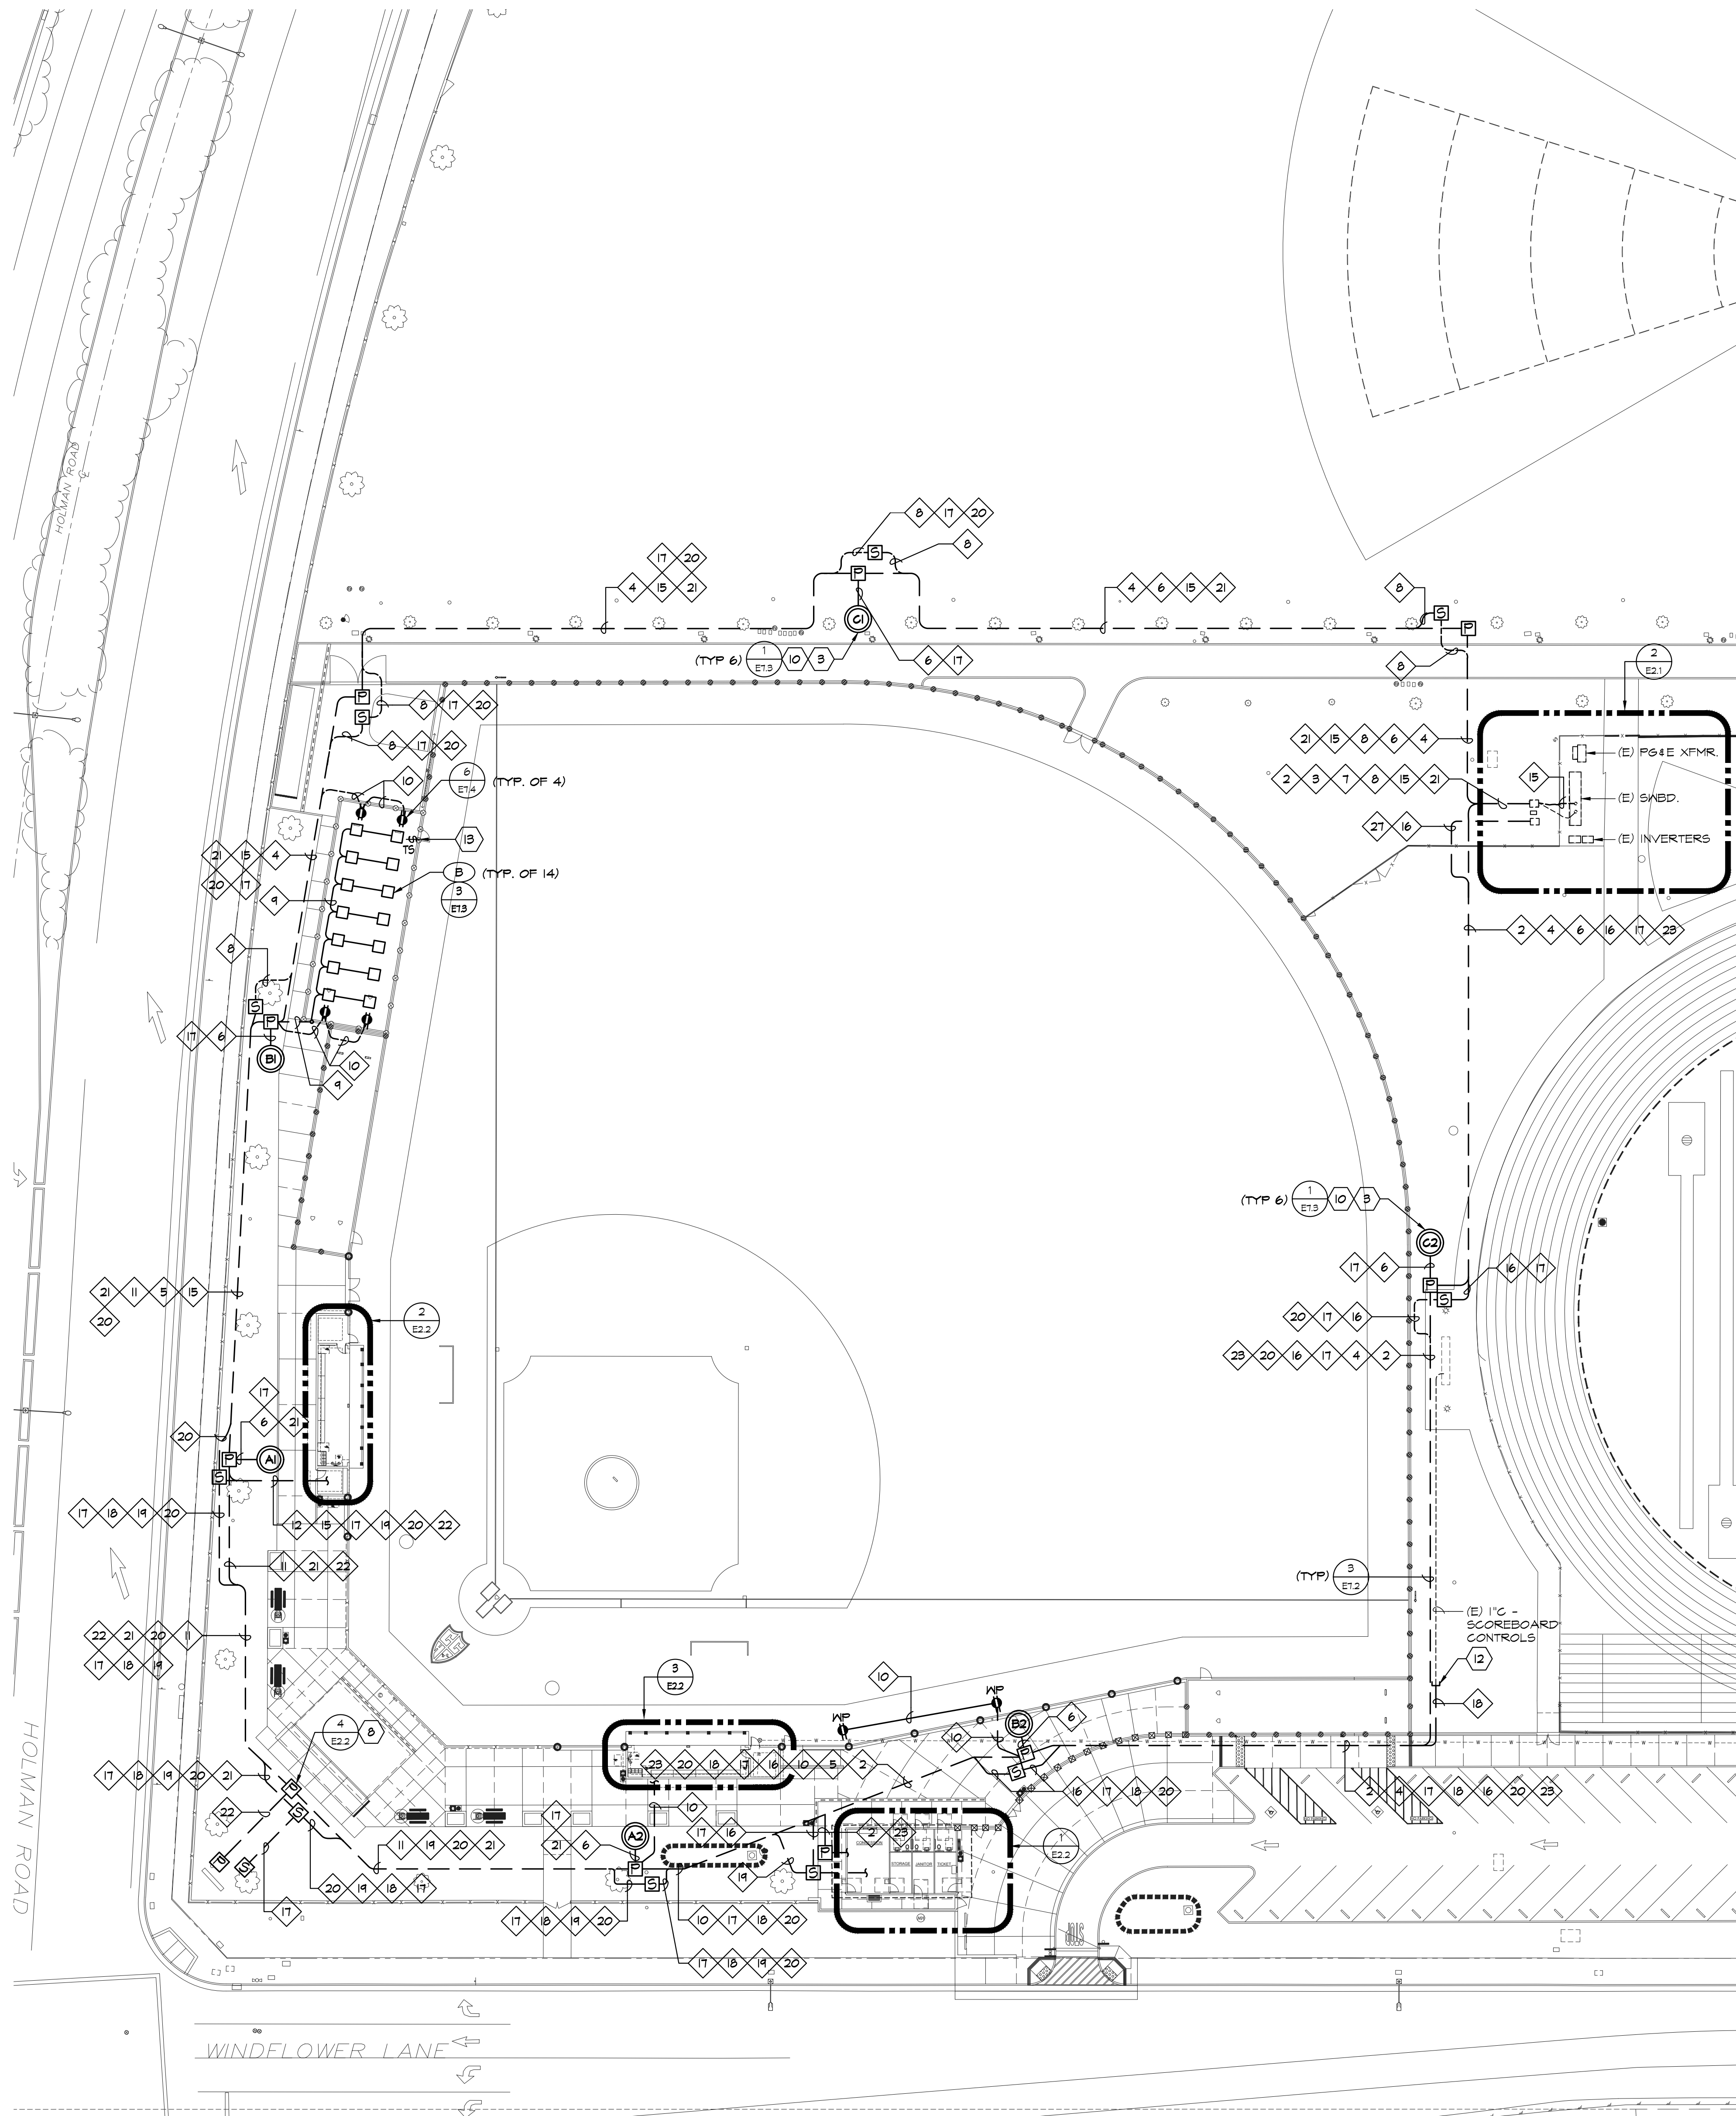

1  
E2.1  
ENLARGED BASEBALL FIELD - ELECTRICAL NEW SITE PLAN  
SCALE: 1" = 30'-0"



## GENERAL NOTES:


1. CONTRACTOR SHALL COORDINATE UNDERGROUND REQUIREMENTS WITH ALL OTHER TRADES TO AVOID CONFLICT.
2. CONTRACTOR TO SITE SURVEY EXISTING CONDITIONS AND LOCATIONS OF EXISTING UNDERGROUND SYSTEMS, WHERE (N) TRENCHWORK OCCURS PRIOR TO BIDDING. CONTRACTOR SHALL TAKE PROPER PRECAUTIONS TO ENSURE (E) UNDERGROUND SYSTEMS/CONDUIT/PIPES ARE NOT DAMAGED DURING INSTALLATION. CONTRACTOR IS RESPONSIBLE FOR ANY REPAIRS REQUIRED IN THE EVENT THE (E) UNDERGROUND SYSTEMS ARE DAMAGED AS A RESULT OF THE (N) ELECTRICAL TRENCHWORK.
3. SEE SINGLE LINE DIAGRAM FOR WIRE SIZES AND CONDUIT REQUIREMENTS.
4. CONTRACTOR TO COORDINATE SITE PLAN TO COMBINE ALL UNDERGROUND CONDUIT IN COMMON TRENCH AS NECESSARY.
5. ALL EMPTY CONDUIT SHALL BE PROVIDED WITH NYLON PULL CORD AS NOTED IN THE SPECIFICATIONS.
6. ALL ELECTRICAL WORK SHALL BE INSTALLED PER 2016 CEC.
7. PRIOR TO ALL (N) TRENCHES, CONTRACTOR TO USE ALL (E) ELECTRICAL CONDUITS AND OTHER UTILITIES TO FAMILIARIZE THEMSELVES WITH THE FIELD CONDITIONS AND ADJUST (N) TRENCHES ACCORDINGLY.
8. IN-GRADE PULL BOX IDENTIFIED WITH 'P' SHALL HAVE LID LABELED 'ELECTRICAL'.
9. IN-GRADE PULL BOX IDENTIFIED WITH 'S' SHALL HAVE LID LABELED 'SIGNAL'.
10. CONTRACTOR SHALL BE RESPONSIBLE FOR ANY SAW CUTTING AND REMOVAL OF EXISTING SURFACES TO FACILITATE UNDERGROUND SYSTEMS. THE CONTRACTOR SHALL PATCH AND REPAIR ALL DAMAGED AND CUT SURFACES TO MATCH ADJACENT.
11. CONTRACTOR SHALL COORDINATE FINAL LOCATION OF ALL IN-GRADE PULL BOX WITH LANDSCAPE ARCHITECT. THE INTENT IS TO VOID RELOCATING PULL BOXES.
12. ALL POWER SYSTEM CONDUITS STUB IN 'ELECTRICAL' PULL BOX AND ALL COMMUNICATION SYSTEMS CONDUIT IN 'SIGNAL' BOXES AS REQUIRED BY CODE.
13. ALL PULL BOXES SHALL BE TRAFFIC RATED B2406 UNLESS OTHERWISE NOTED. SEE DETAIL FOR SPECIFICS.
14. COORDINATE PULL BOX ORIENTATION WITH LANDSCAPE ARCHITECT TO BE SQUARE WITH SURFACE CURB, CONCRETE WALKWAY, DRAINAGE, ETC.
15. IN-GRADE PULL BOX IDENTIFIED WITH 'L' SHALL HAVE LID LABELED 'LIGHTING'.

## SHEETS NOTES:

1. NSO ELECTRICAL PULLBOX. LABEL LID 'ELECTRICAL'.
2. NSO COMMUNICATION PULLBOX. LABEL LID 'COMMUNICATION'.
3. (N) MUSCO SPORTS FIELD LIGHT. SEE MUSCO DRAWINGS FOR ADDITIONAL INFORMATION.
4. TO (N) SWITCHBOARD 271/400V SECTION VIA LIGHTING CONTACTOR. SEE SINGLE LINE DIAGRAM.
5. TO (N) SWITCHBOARD 120/208V SECTION. SEE SINGLE LINE DIAGRAM.
6. FLUSH J-BOX AND CONDUIT STUB TO CEILING BY MODULAR MANUFACTURER. POWER RECEPTACLES BY MODULAR MANUFACTURER, UNLESS OTHERWISE NOTED.
7. ROUTE (N) CONDUCTORS AND CONDUITS PER SINGLE LINE DIAGRAM.
8. NSO ELECTRICAL PULL BOX. LABEL LID 'ELECTRICAL'.
9. PROVIDE DEDICATED OUTLET TO NEAREST ELECTRICAL PANEL. PROVIDE 20A/1P GROUND BREAKER IN PANEL AND CONNECT AS REQUIRED.
10. MUSCO SPORTS FIELD LIGHT WITH SPEAKER.
11. ROUTE AND EXTEND SIGNAL CONDUIT TO PRESS BOX. ROUTE NEW INTRUSION AND DATA FIBER IN EXISTING CONDUITS.
12. LOCATE POWER AND SIGNAL CONDUIT ENTRY TO SCOREBOARD. PROVIDE AND SIZE NEMA-3R PULL CAN AND EXTEND CONDUIT AS SHOWN TO SUCCESSFULLY PROVIDE CONDUIT PATH FOR POWER AND SIGNAL.
13. PROVIDE (N) TIMER SWITCH IN HEAVY DUTY, NEMA-3R, LOCKABLE, GASKET BOX. TIMER SHALL BE WATSTOPPER TS-400 TIME SWITCH. CONTRACTOR SHALL PROVIDE ALL REQUIRED ACCESSORIES, CONDUIT, CABLES, ETC. FOR COMPLETE INSTALLATION.
14. REPLACE EXISTING PULL BOX WITH (N) TRAFFIC RATED 3'X3' PULL BOX. LABEL LID ELECTRICAL.

## CONDUIT SCHEDULE:

| POWER SYSTEMS                             | COMMUNICATION SYSTEMS    |
|---|--------------------------|
| 1 NOT USED                                | 16 (N) 4" - FIBER (VOIP) |
| 2 (N) (2) 2 1/2" - SPARE                  | 17 (N) 2" - SIGNAL       |
| 3 (N) (4) 2 1/2" - MUSCO                  | 18 (N) 1" - SCOREBOARD   |
| 4 (N) (2) 2 1/2" - MUSCO                  | 19 (N) 2 1/2" - DATA     |
| 5 (N) (1) 2 1/2" - MUSCO                  | 20 (N) 2 1/2" - SPEAKER  |
| 6 (N) (1) 2" - MUSCO                      |                          |
| 7 (N) (2) 2" - MUSCO                      |                          |
| 8 (N) (1) 1 1/2" - SPARE                  |                          |
| 9 (N) (1) 1" - BATTING CAGE LIGHT         |                          |
| 10 (N) (1) 1" - RECEPTACLE                |                          |
| 11 (N) (2) 1" - RECEPTACLE                |                          |
| 12 (N) (3) 1" - RECEPTACLE                |                          |
| 13 (N) (4) 1" - RECEPTACLE                |                          |
| 14 (N) (5) 1" - RECEPTACLE                |                          |
| 15 (N) (2) 2 1/2" - POWER (SCORERS BOOTH) |                          |
| 21 (N) 1 1/4" - POWER (MUSCO EGRESS)      |                          |
| 22 (N) 1 1/4" - POWER (MESSAGE BOARD)     |                          |
| 23 (N) (2) 3 1/2" - POWER (CONCESSION)    |                          |
| 24 (N) (3) 2 1/2" - MUSCO                 |                          |
| (N) (4) 2" - MUSCO                        |                          |
| (E) CONDUIT                               |                          |
| 26 (N) (1) 1" - MUSCO CONTROL PANEL       |                          |

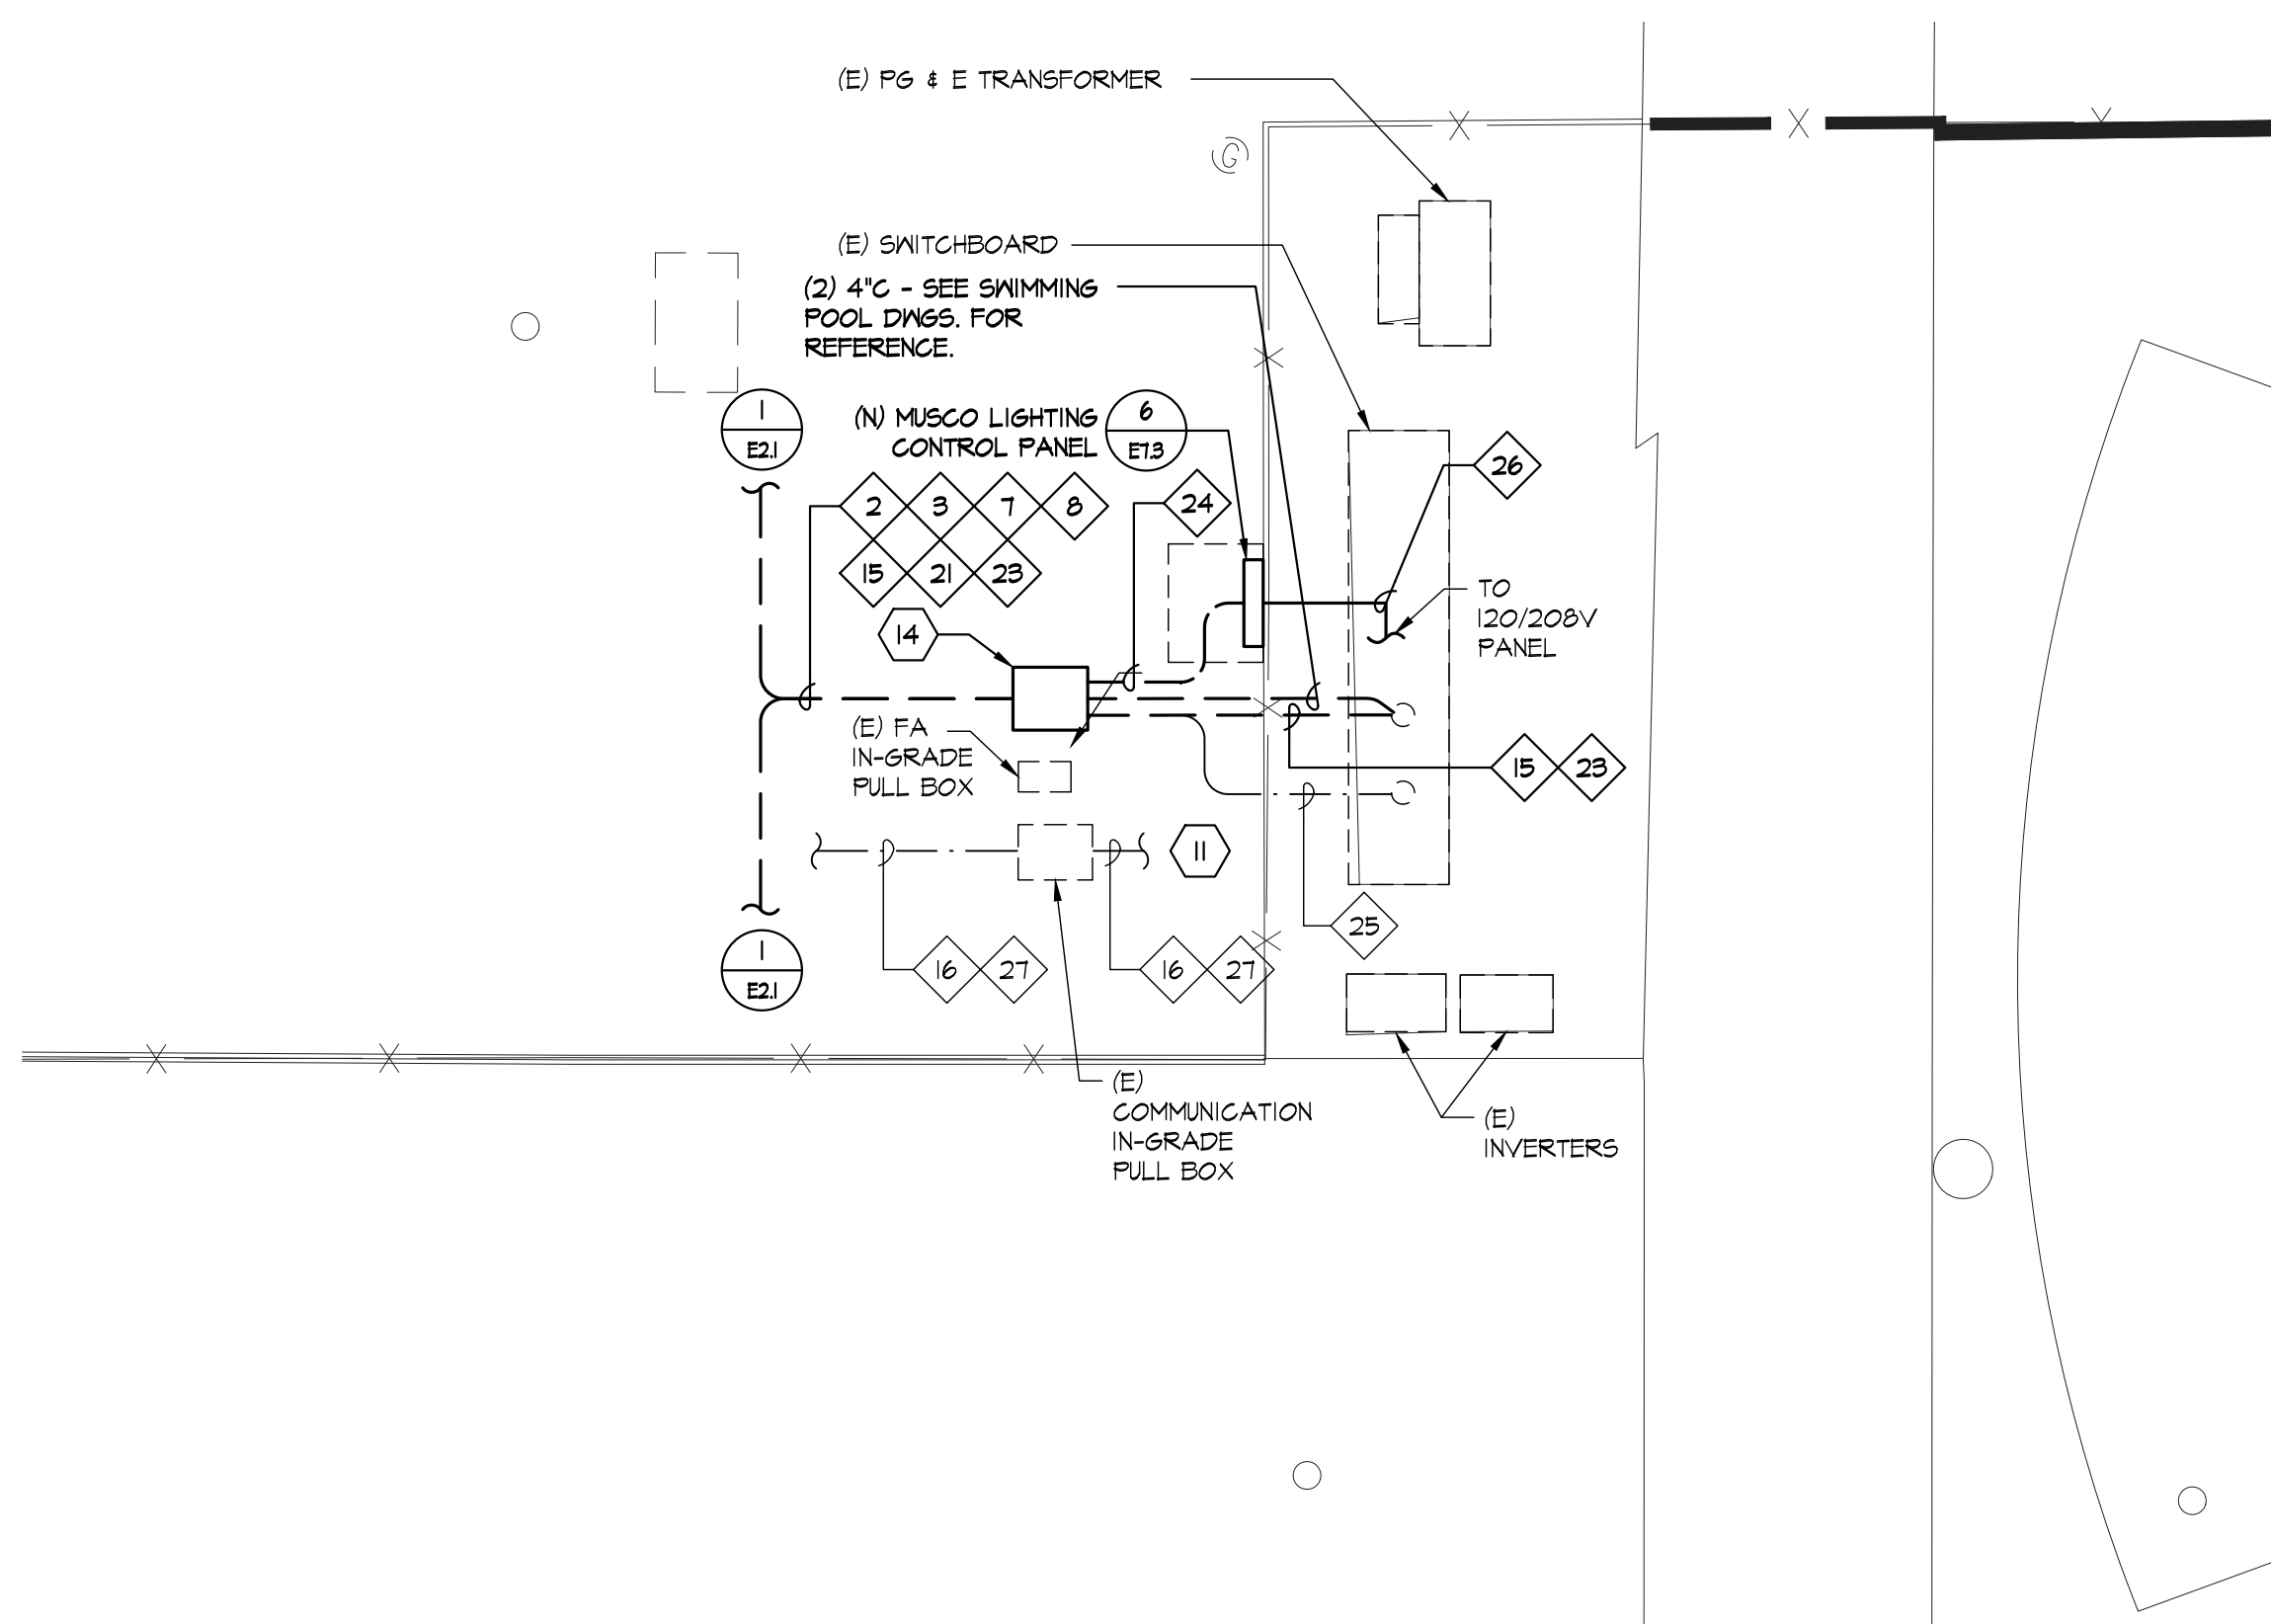

2  
E2.1  
ENLARGED ELECTRICAL NEW EQUIPMENT PAD LAYOUT  
SCALE: 1/8" = 1'-0"




IDENTIFICATION STAMP  
DIV. OF THE STATE ARCHITECT  
APP. 02-118017 INC.  
REVIEWED FOR  
SS ☐ FLS ☐ ACS ☐  
DATE: 04/10/2020

**VERDE DESIGN**  
LANDSCAPE ARCHITECTURE  
CIVIL ENGINEERING  
SPORT PLANNING & DESIGN  
1843 Iron Point Rd #140  
Folsom, CA 95630  
tel: 916.415.6554  
fax: 408.988.7260  
www.VerdeDesignInc.com



**American Consulting Engineers Electrical, Inc.**  
1560 The Armistice, Suite 200  
San Jose, CA 95128  
JOB # E19146-00  
From 408/234-2312  
Fax 408/234-2319

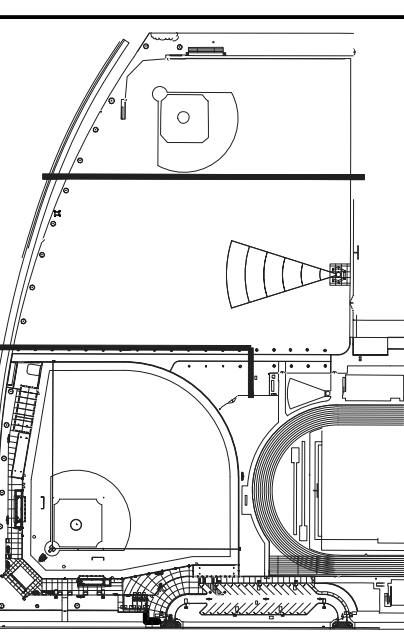

SHEET TITLE  
**ENLARGED BASEBALL FIELD  
ELECTRICAL NEW SITE PLAN**

PROJECT NAME  
**CHAVEZ HIGH SCHOOL  
STOCKTON USD  
ATHLETIC FACILITY  
IMPROVEMENTS**

PROJECT ADDRESS  
**2929 WINDFLOWER LN  
STOCKTON, CA 95212**


| SUBMITTAL               | DATE     |
|-------------------------|----------|
| DD/50% SUBMITTAL        | 10/25/19 |
| DSA SUBMITTAL           | 12/20/19 |
| DSA BACKCHECK SUBMITTAL | 03/27/20 |

| NO. | REVISIONS | DATE |
|-----|-----------|------|
| 1   |           |      |
| 2   |           |      |
| 3   |           |      |
| 4   |           |      |
| 5   |           |      |
| 6   |           |      |
| 7   |           |      |
| 8   |           |      |
| 9   |           |      |
| 10  |           |      |


DRAWN BY: MG  
CHECKED BY: SB/SF  
DATE ISSUED: 03/27/20  
SCALE:  
PROJ. NO.: 1910900-1211  
SHEET NO.: **E2.1**  
OF #





ALL DESIGN, CONSTRUCTION, AND FINISHES OF THIS PROJECT ARE THE PROPERTY OF VERDE DESIGN, INC. AND WILL BE PROVIDED TO THE CLIENT FOR THE PROJECT ONLY. NO PART OF THIS PROJECT SHALL BE REPRODUCED, COPIED, OR TRANSMITTED IN ANY FORM OR BY ANY MEANS, WITHOUT THE WRITTEN PERMISSION OF VERDE DESIGN, INC.

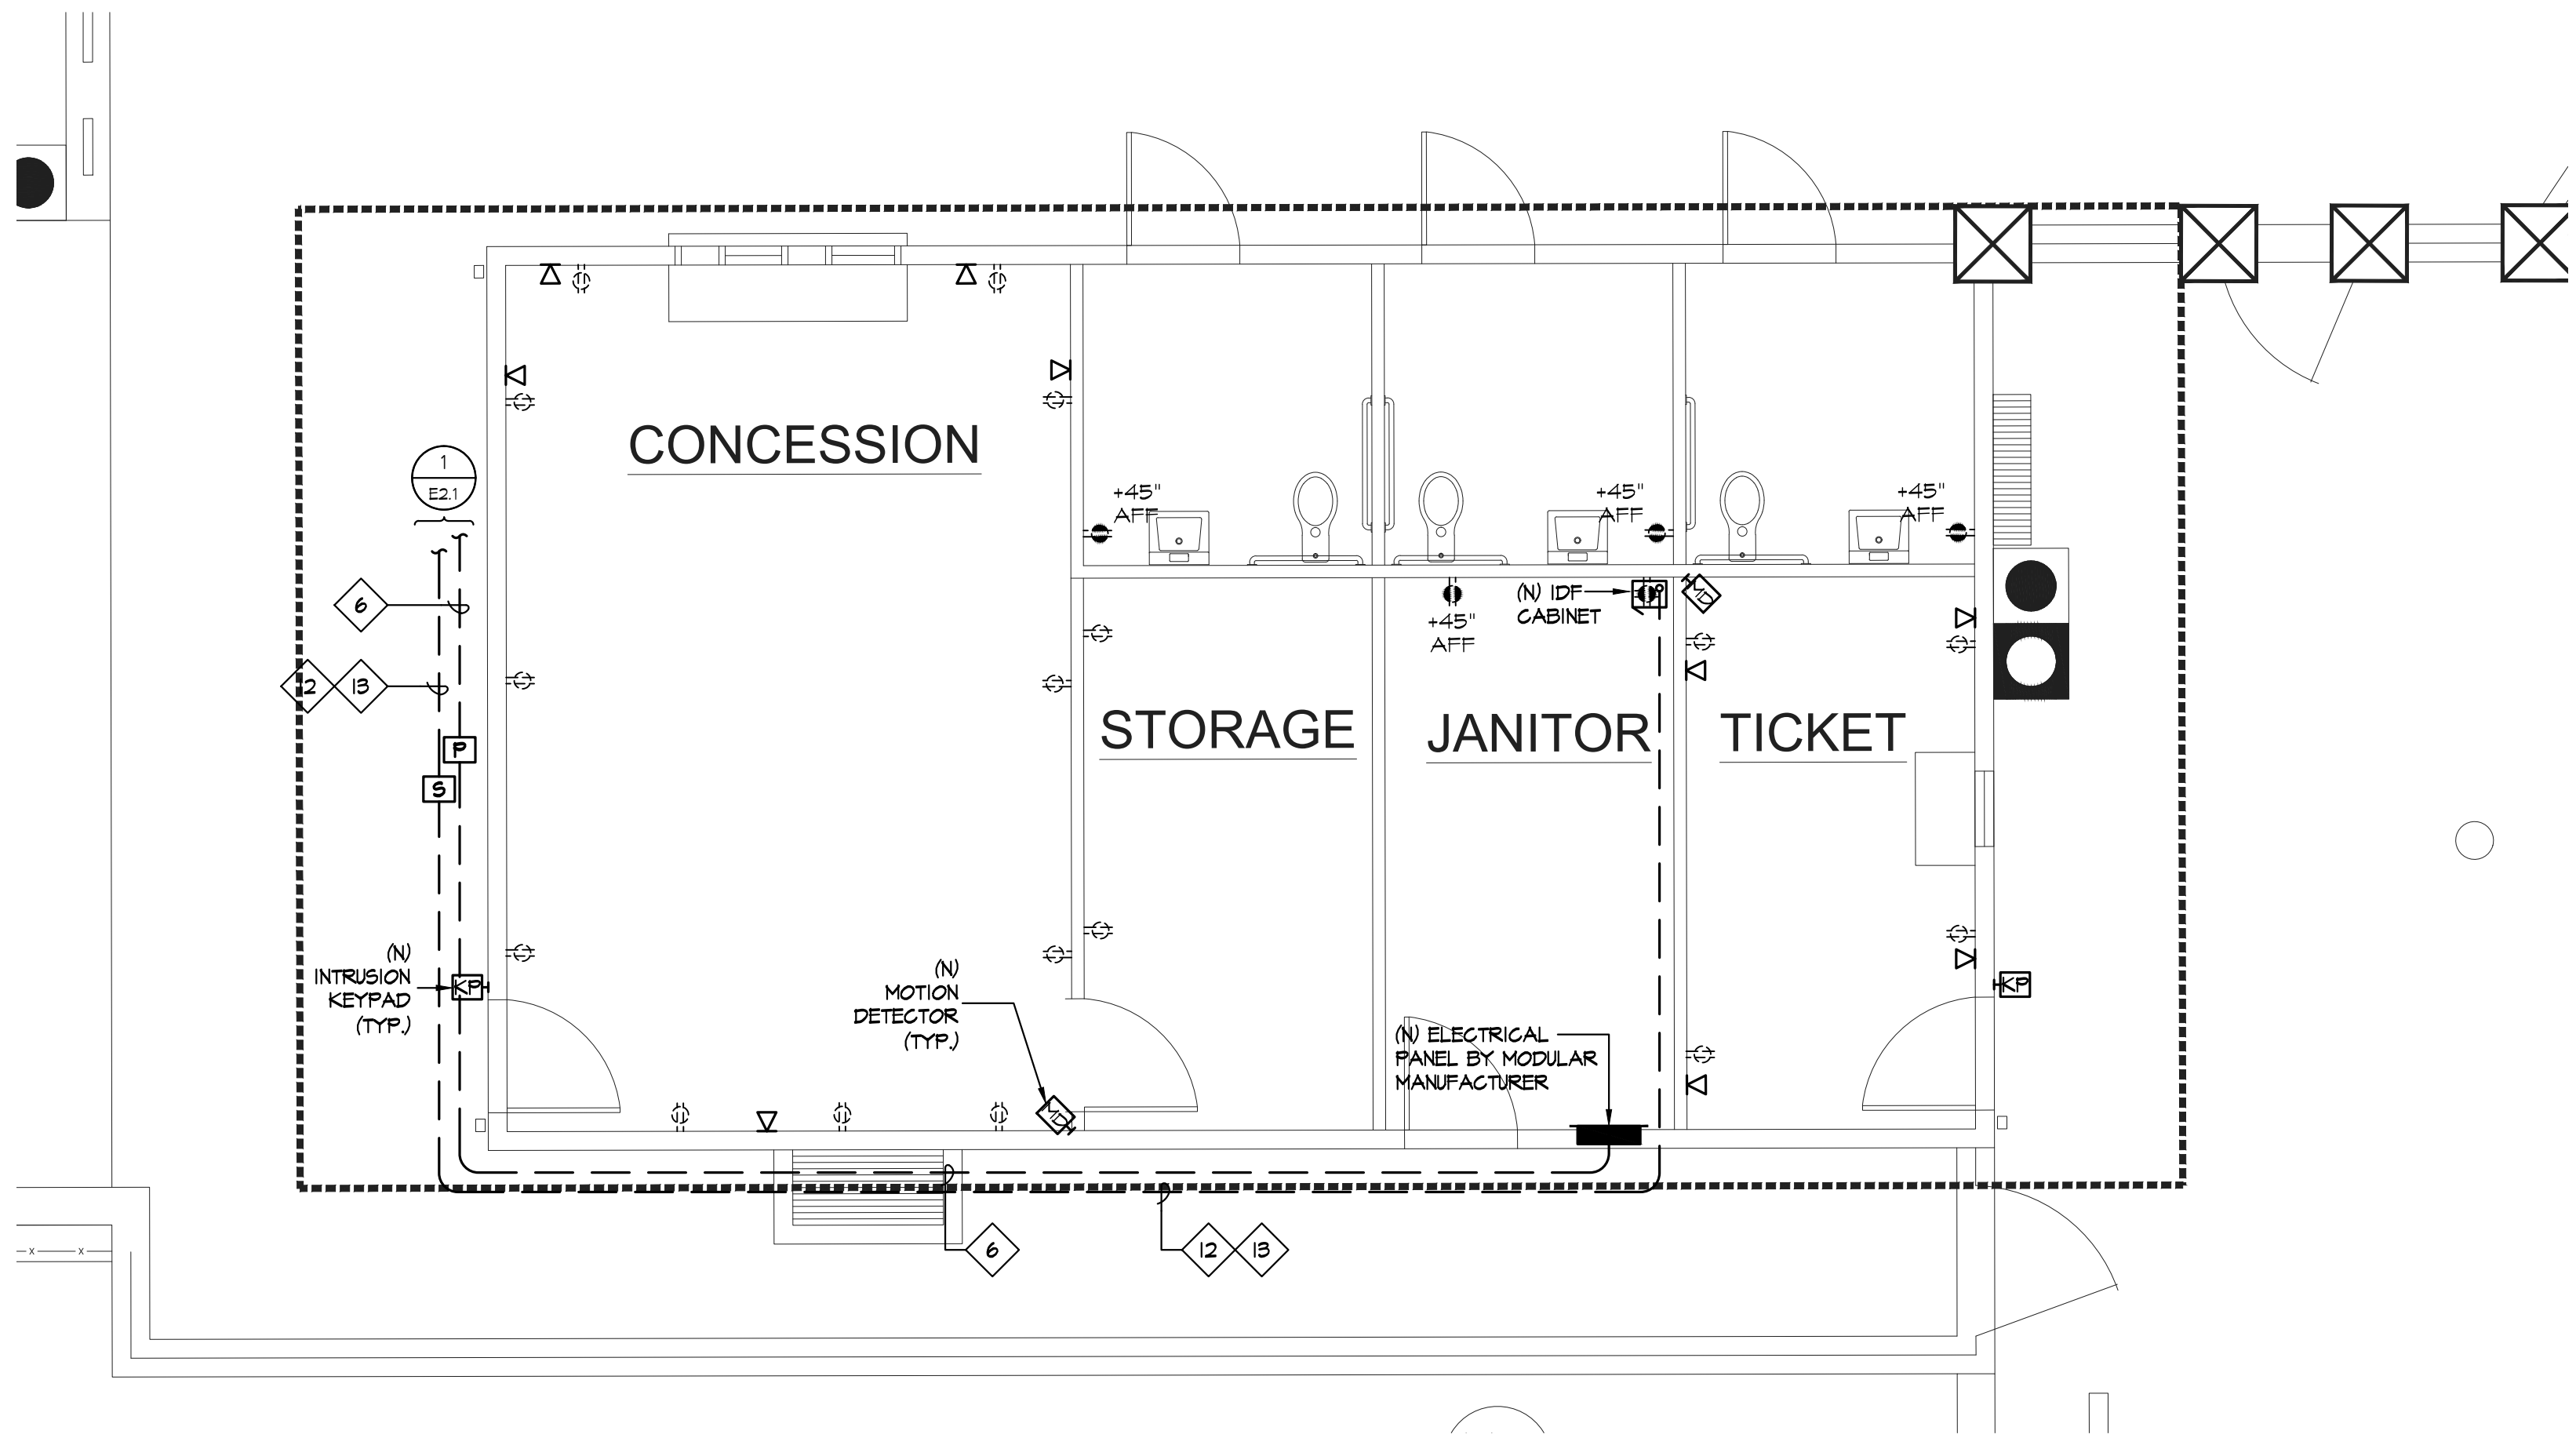

1  
E2.2  
**CONCESSION / STORAGE ELECTRICAL FLOOR PLAN**  
SCALE: 1/4" = 1'-0"

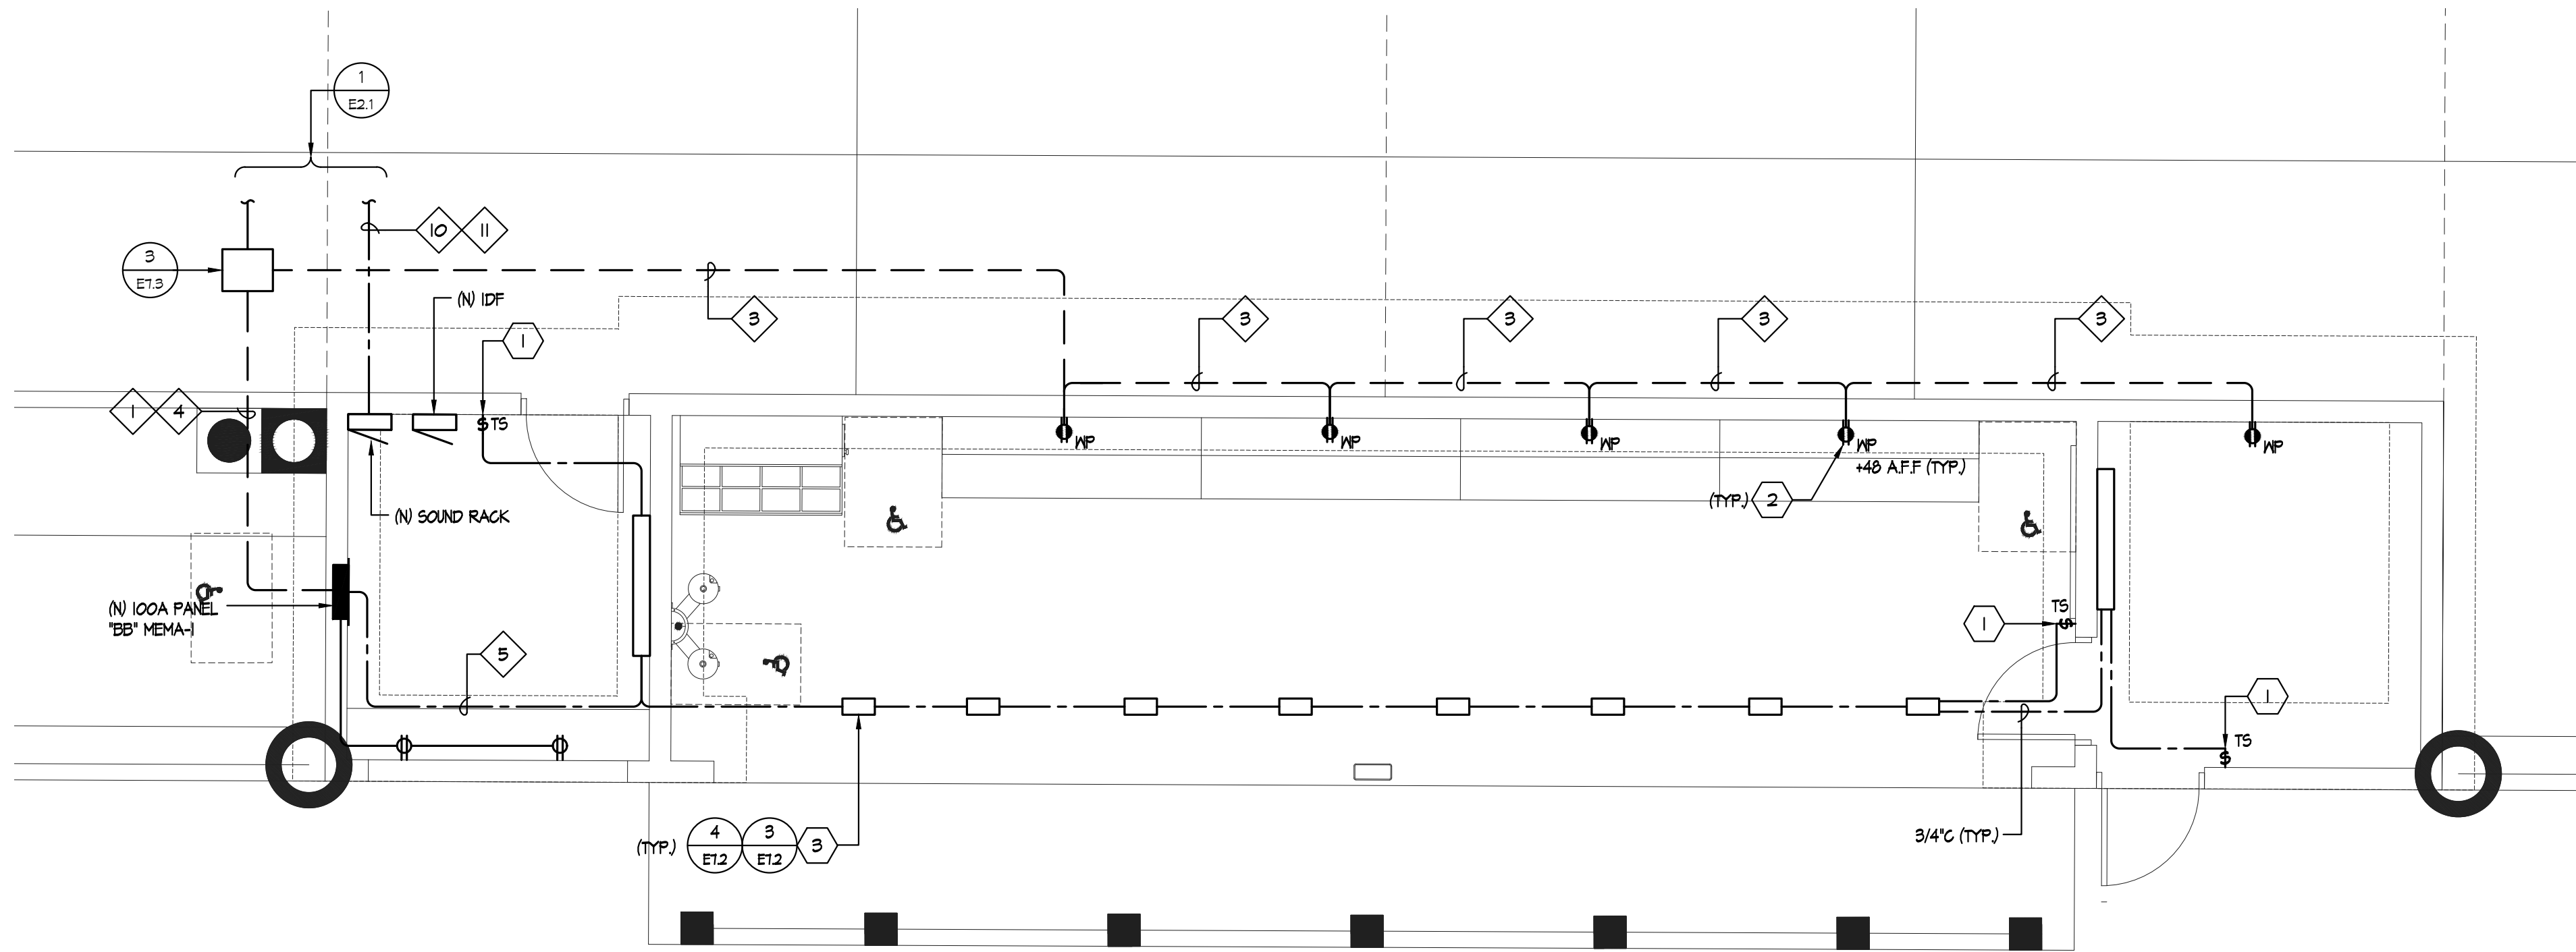

2  
E2.2  
**ELECTRICAL DUGOUT FLOOR PLAN - THIRD BASE**  
SCALE: 1/4" = 1'-0"

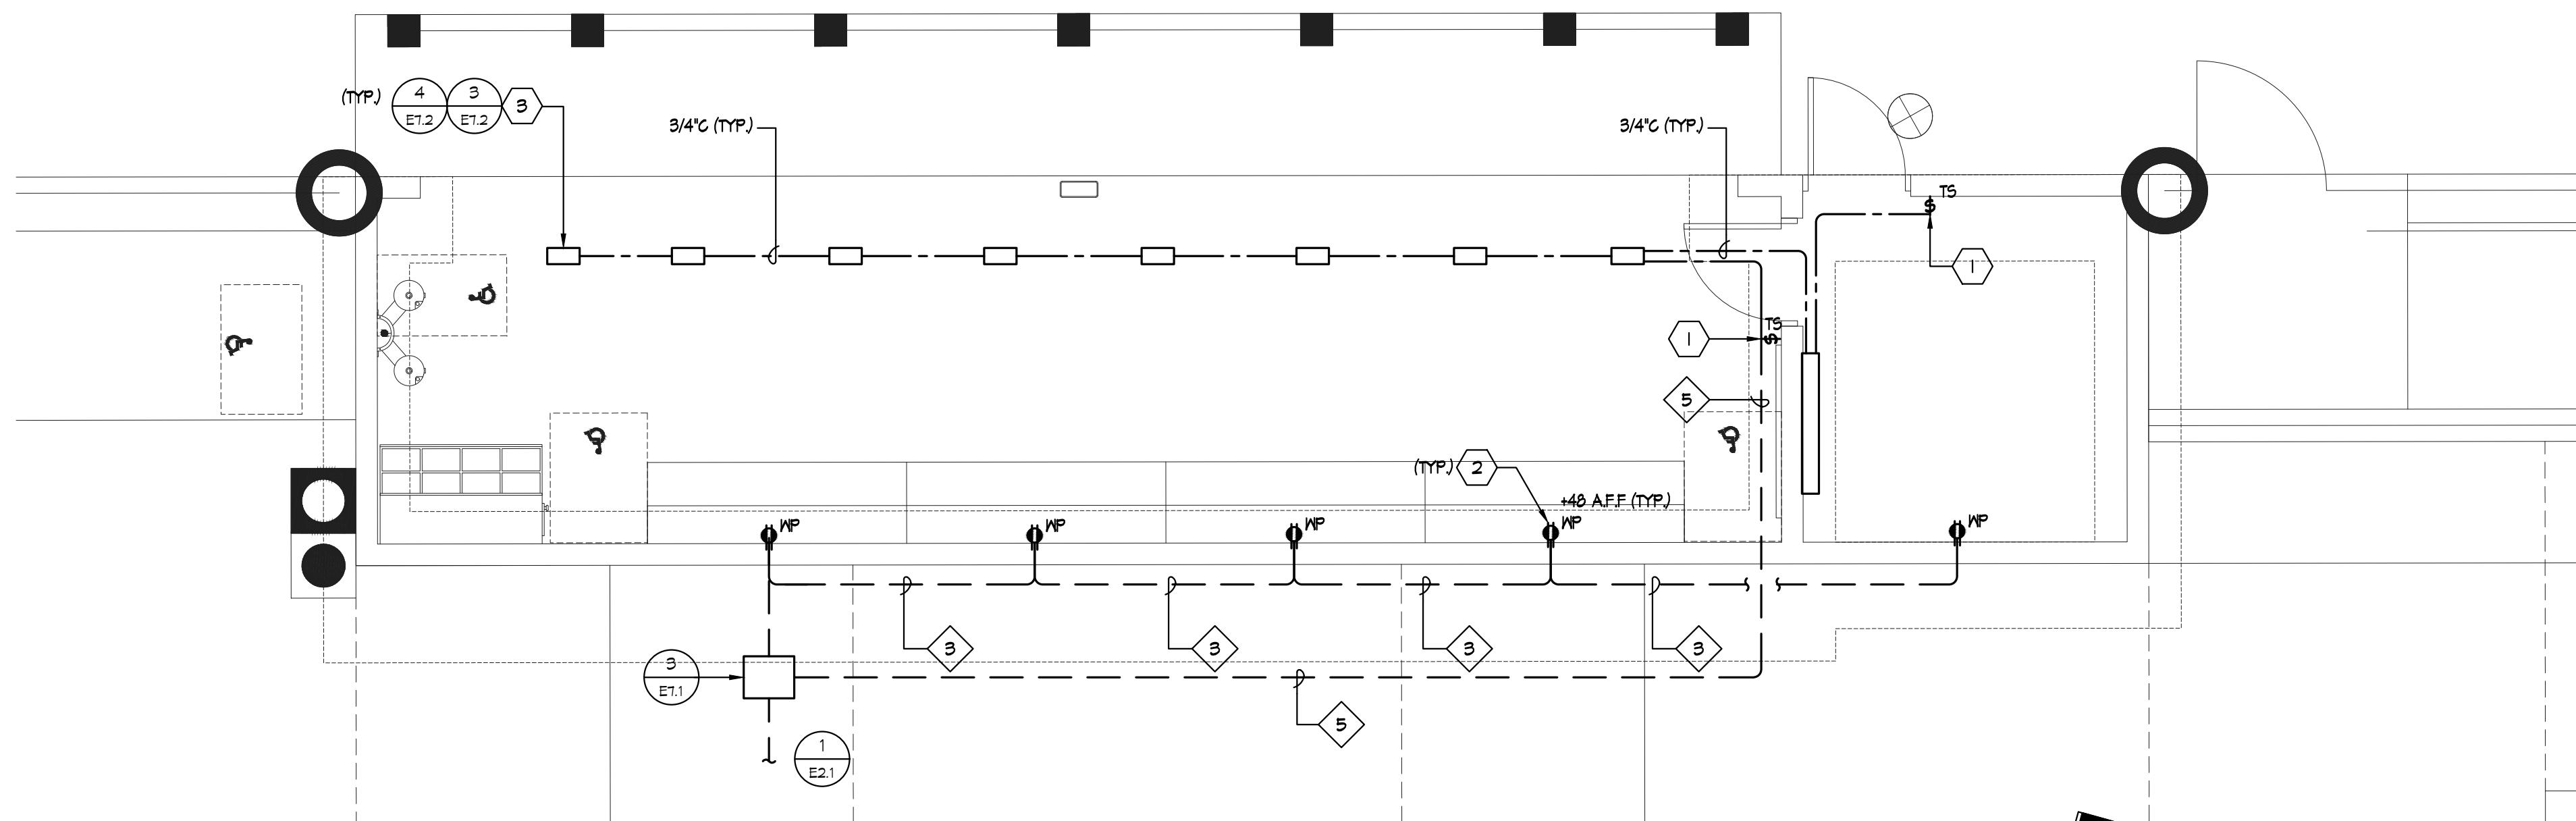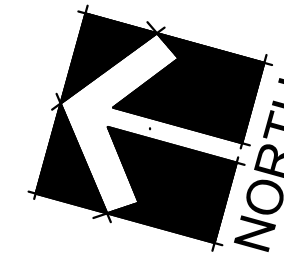

3  
E2.2  
**ELECTRICAL DUGOUT FLOOR PLAN - FIRST BASE**  
SCALE: 1/4" = 1'-0"



## GENERAL NOTES:

- CONTRACTOR SHALL COORDINATE UNDERGROUND REQUIREMENTS WITH ALL OTHER TRADES TO AVOID CONFLICT.
- CONTRACTOR TO SITE SURVEY EXISTING CONDITIONS AND LOCATIONS OF EXISTING UNDERGROUND SYSTEMS, WHERE (N) TRENCHWORK OCCURS PRIOR TO BIDDING. CONTRACTOR SHALL TAKE PROPER PRECAUTIONS TO ENSURE (E) UNDERGROUND SYSTEMS/CONDUITS/PIPES ARE NOT DAMAGED DURING INSTALLATION. CONTRACTOR IS RESPONSIBLE FOR ANY REPAIRS REQUIRED IN THE EVENT THE (E) UNDERGROUND SYSTEMS ARE DAMAGED AS A RESULT OF THE (N) ELECTRICAL TRENCHWORK.
- LIGHTING AND RECEPTACLE CONDUIT SHALL BE IN SAME TRENCH.
- SEE SINGLE LINE DIAGRAM FOR WIRE SIZES AND CONDUIT REQUIREMENTS.
- CONTRACTOR TO COORDINATE SITE PLAN TO COMBINE ALL UNDERGROUND CONDUIT IN COMMON TRENCH AS NECESSARY.
- ALL EMPTY CONDUIT SHALL BE PROVIDED WITH NYLON PULL CORD AS NOTED IN THE SPECIFICATIONS.
- SEE DETAIL 6/ES.1 FOR TRENCHING REQUIREMENTS.
- SEE DETAIL 9/ES.1 FOR SPORTS LIGHTING PULLBOX CONDUIT ROUTING DETAIL.
- CONTRACTOR TO PROVIDE ALL MATERIALS, EQUIPMENT, SPORT FIELD LIGHTS, CONTROL CABINETS, WIRING, CONDUITS, ETC. TO SUCCESSFULLY INSTALL NEW SPORTFIELD LIGHTING.
- ALL ELECTRICAL WORK SHALL BE INSTALLED PER 2016 NEC.
- ALL CONDUITS FOR OUTLETS AND DATA SHALL BE CONCEALED IN WALL. CONTRACTOR SHALL BE RESPONSIBLE TO COORDINATE WITH DUGOUT CONTRACTOR IN ADVANCE TO ENSURE THEY ARE AWARE OF CONDUITS TO BE CONCEALED IN CMU WALL.
- IN-GRADE PULL BOX IDENTIFIED WITH 'F' SHALL HAVE LID LABELED 'ELECTRICAL'.
- IN-GRADE PULL BOX IDENTIFIED WITH 'S' SHALL HAVE LID LABELED 'SIGNAL'.

## SHEET NOTES:

- PROVIDE (N) TIMER SWITCH IN NEMA-3R, LOCKABLE, GASKET BOX. TIMER SHALL BE MATSTOPPER 'TS-400' TIME SWITCH. CONTRACTOR SHALL PROVIDE ALL REQUIRED ACCESSORIES, CONDUIT, CABLES, ETC. FOR COMPLETE INSTALLATION.
- PROVIDE AND INSTALL WEATHERPROOF (6FG), EXTERIOR OUTLET FOR DUGOUT. OUTLET SHALL BE PROVIDED WITH RAIN-TIGHT 'WHILE-IN-USE' LOCKABLE COVER PER C.E.C. REQUIREMENTS. OUTLET SHALL BE INSTALLED FLUSH IN CMU WALL. CONTRACTOR SHALL COORDINATE EXACT LOCATION WITH ARCHITECT.
- LIGHT FIXTURES AND CONDUIT SHALL BE ROUTED ALONG STRUCTURAL BEAM. CONTRACTOR SHALL COORDINATE THE INSTALLATION WITH THE ARCHITECT AND STRUCTURAL.
- PROVIDE (N) MOTION SENSOR, HEAVY DUTY SWITCH, OUTLETS TO BE FLUSH MOUNTED ON WALL. CONNECT TO PANEL 'EB' AS REQUIRED.

## CONDUIT SCHEDULE:


| POWER SYSTEMS |                                      | COMMUNICATION SYSTEMS |                      |
|---------------|--------------------------------------|-----------------------|----------------------|
| 1             | (N) (4) 1" - RECEPTACLE              | 10                    | (N) 2 1/2" - DATA    |
| 2             | (N) (2) 1" - RECEPTACLE              | 11                    | (N) 2 1/2" - SPEAKER |
| 3             | (N) (1) 1/2" - RECEPTACLE            | 12                    | (N) 4" - DATA        |
| 4             | (N) (1) 2 1/2" - POWER (LOAD CENTER) | 13                    | (N) 2" - SIGNAL      |
| 5             | (N) (1) 3/4" - LIGHTING              |                       |                      |
| 6             | (N) (2) 2 1/2" - POWER CONCESSION    |                       |                      |

| SYMBOL   | DESCRIPTION           | ROUGH-IN PROVIDED BY PORTABLE MANUFACTURER  | NOTES  | ELEVATION   |
|----------|-----------------------|---|--|---|
| (2)<br>1 | (2) DATA OUTLETS      | 4 1/16" BOX WITH 1-GANG COVER PLATE, AND 1 1/2" EXTENSION RING AND (1) 1/4" FROM BOX TO ACCESSIBLE CEILING SPACE. | CONTRACTOR PROVIDED. SEE RISER DIAGRAM OUTLET DETAIL FOR OUTLET AND WIRING REQUIREMENTS. | +18" AFF  |
| A/V<br>2 | AUDIO/ VIDEO OUTLET   | 4 1/16" BOX WITH 1-GANG COVER PLATE, AND 1 1/2" EXTENSION RING AND (1) 1/4" FROM BOX TO ACCESSIBLE CEILING SPACE. | A/V WIRING BY DISTRICT   | +48" AFF U.O.N.   |
| (N)<br>3 | DUPLEX, DOUBLE DUPLEX | 1-GANG WITH (1) 3/4" FROM BOX TO ACCESSIBLE CEILING SPACE FOR DUPLEX. 2-GANG FOR DOUBLE DUPLEX.                   | CONTRACTOR PROVIDED. INSTALLED OUTLET WITH BRANCH CIRCUITRY PER NEG.                     | +18" AFF  |
| (N)<br>4 | DUPLEX, DOUBLE DUPLEX | 1-GANG WITH (1) 3/4" FROM BOX TO ACCESSIBLE CEILING SPACE FOR DUPLEX. 2-GANG FOR DOUBLE DUPLEX.                   | PROVIDED BY MODULAR MANUFACTURER.  | +18" AFF U.O.N.<br>CEILING OUTLET MOUNTED ON CEILING JOISTS |
| 5        | INTERIOR PANEL        | -   | PROVIDED BY MODULAR MANUFACTURER.  | PER NEG   |

\* MODULAR MANUFACTURER SHALL PROVIDE AND INSTALL PULL STRING ON ALL EMPTY CONDUITS.

### NOTES:

- SEE MODULAR PLANS FOR LOCATION OF LIGHT SWITCHES, LIGHT FIXTURES, HVAC EQUIPMENT, EXHAUST FAN, AND PANELS.
- OF01 - OWNER FURNISH OWNER INSTALL.

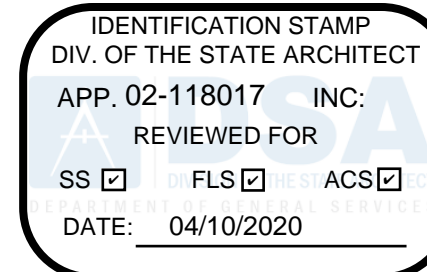


STAMP



CONSULTANT



KEYMAP

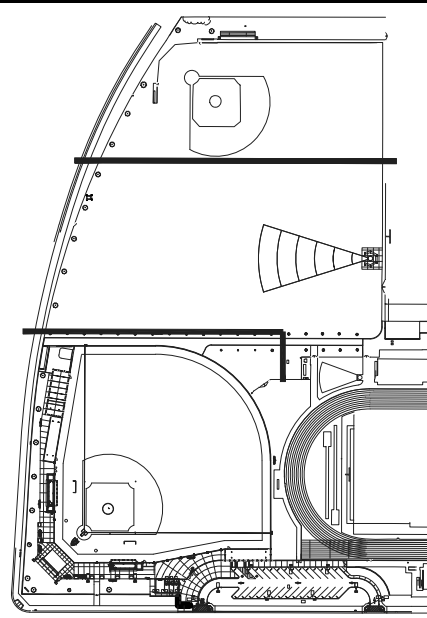

SHEET TITLE

ENLARGED CONCESSION  
FIRST & THIRD DUGOUT  
ELECTRICAL FLOOR PLAN

PROJECT NAME

CHAVEZ HIGH SCHOOL  
STOCKTON USD  
ATHLETIC FACILITY  
IMPROVEMENTS

PROJECT ADDRESS


2929 WINDFLOWER LN  
STOCKTON, CA 95212

| SUBMITTAL               | DATE     |
|-------------------------|----------|
| DD/50% SUBMITTAL        | 10/25/19 |
| DSA SUBMITTAL           | 12/20/19 |
| DSA BACKCHECK SUBMITTAL | 03/27/20 |

| NO. | REVISIONS | DATE |
|-----|-----------|------|
| 1   |           |      |
| 2   |           |      |
| 3   |           |      |
| 4   |           |      |
| 5   |           |      |

|                           |                      |
|---------------------------|----------------------|
| DRAWN BY<br>MG            | CHECKED BY<br>SB/ SF |
| DATE ISSUED<br>03/27/20   | SCALE                |
| PROJ. NO.<br>1910900-1211 |                      |
| SHEET NO.<br>E2.2         | OF #                 |



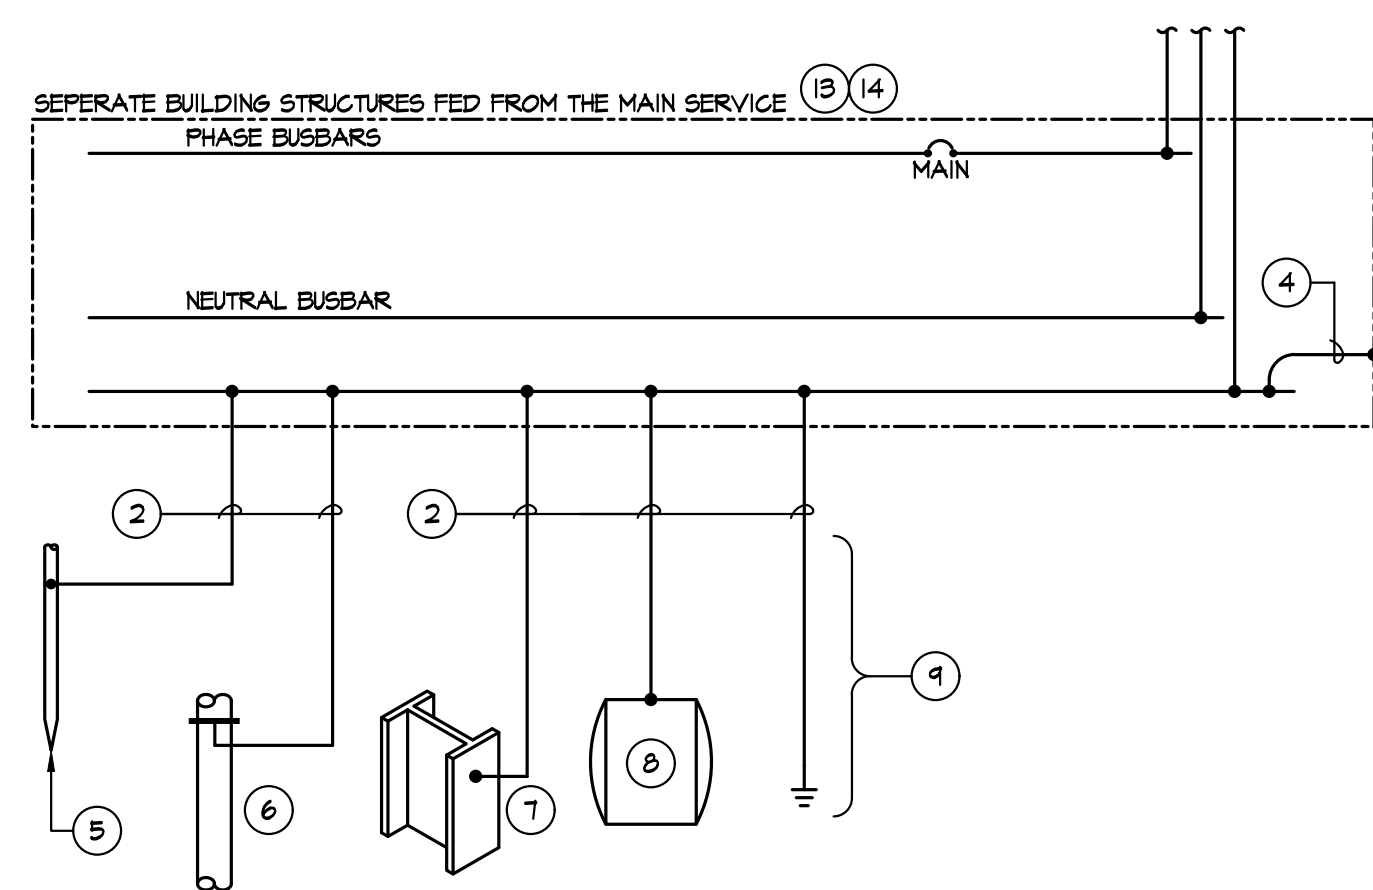

**NOTES:**


- ① THE EQUIPMENT GROUNDING CONDUCTOR SHALL BE USED FOR GROUNDING OR BONDING OF EQUIPMENT, STRUCTURES OR FRAMES REQUIRED TO BE GROUNDED OR BONDED (250.252(B)). PROVIDE ALL OF THE CONNECTIONS BELOW AND BOND TO THE EQUIPMENT GROUNDING CONDUCTOR.
- ② GROUNDING ELECTRODE CONDUCTOR. GROUNDING ELECTRODE CONDUCTOR SHALL BE BARE OR INSULATED COPPER AND SHALL BE SIZED PER TABLE 250.66.
- ③ NOT USED.
- ④ EQUIPMENT BONDING JUMPER. EQUIPMENT BONDING JUMPER SHALL BE INSULATED COPPER AND SHALL BE SIZED PER TABLE 250.122.
- ⑤ PROVIDE A MINIMUM OF (1) GROUND ROD. GROUND ROD SHALL BE 10' LONG BY 3/4" DIAMETER CONFORMING TO GROUNDING ELECTRODE CONDUCTOR SHALL BE BONDED TO GROUND ROD VIA DOWNSTREAM WELD. GROUND RODS SHALL BE INSTALLED IN A ROUND BOX. SEE DETAIL FOR BOX/INSTALLATION REQUIREMENTS. (PROVIDE FOR ALL NEW BUILDINGS, FOR EXISTING BUILDINGS PROVIDE WHEN ALL OTHER GROUNDING ELECTRODES ARE NOT AVAILABLE.)
- ⑥ PROVIDE GROUNDING ELECTRODE CONDUCTOR CONNECTION TO THE NEAREST UNDERGROUND WATER PIPE IN DIRECT CONTACT WITH EARTH FOR A MINIMUM OF 10 FEET. WATER PIPE SHALL BE ELECTRICALLY CONTINUOUS TO POINTS OF CONNECTION OF THE GROUNDING ELECTRODE CONDUCTOR. CONNECTION POINT SHALL NOT BE GREATER THAN 5' FROM THE POINT OF ENTRANCE OF THE UNDERGROUND WATER PIPE. (PROVIDE FOR ALL NEW AND EXISTING BUILDINGS WHERE UNDERGROUND WATER PIPE IS AVAILABLE)
- ⑦ PROVIDE GROUNDING ELECTRODE CONDUCTOR CONNECTION TO THE NEAREST METAL FRAME OR STRUCTURAL STEEL. (PROVIDE FOR ALL NEW AND EXISTING BUILDINGS WHERE METAL FRAME OR STRUCTURAL STEEL IS AVAILABLE)
- ⑧ PROVIDE GROUNDING ELECTRODE CONDUCTOR CONNECTION TO ALL OTHER LOCAL METAL UNDERGROUND SYSTEMS OR STRUCTURES, AS REQUIRED WHEN AVAILABLE.
- ⑨ PROVIDE A CONCRETE ENCASED ELECTRODE (FER) IN AND NEAR THE BOTTOM OF THE STRUCTURAL FOOTINGS OR SLAB ON GRADE THAT IS IN DIRECT CONTACT WITH EARTH. THE ELECTRODE SHALL BE A MINIMUM OF 20 FEET LONG INSIDE THE PAD, FOOTING OR SLAB. THE ELECTRODE CONDUCTOR SHALL BE BARE COPPER AND SIZED PER TABLE 250.66 BUT SHALL NOT BE LESS THAN #4S. (PROVIDE ONLY FOR NEW BUILDINGS)
- ⑩ INCOMING SERVICE FROM THE MAIN SWITCHBOARD. SEE SINGLE LINE DIAGRAM FOR PHASE, NEUTRAL, AND EQUIPMENT GROUNDING CONDUCTOR SIZING.
- ⑪ NOT USED.
- ⑫ PROVIDE GROUNDING ELECTRODE CONDUCTOR CONNECTION TO THE SECONDARY SIDE OF ALL WYE CONNECTED BUILDING TRANSFORMERS. GROUNDING ELECTRODE CONDUCTOR MAY BE CONNECTED TO THE NEAREST STRUCTURAL STEEL OR THE MAIN SERVICE GROUNDING ELECTRODE ONLY. SEE TRANSFORMER GROUNDING DETAIL FOR ADDITIONAL REQUIREMENTS.
- ⑬ THE CONTRACTOR SHALL BE RESPONSIBLE FOR PROVIDING ALL GROUNDING AND BONDING AS REQUIRED PER THE CEC.
- ⑭ SEE SPECIFICATIONS FOR ADDITIONAL REQUIREMENTS.

**2 SEPARATE BUILDING STRUCTURES GROUNDING DETAIL**

E5.1 NOT TO SCALE



ALL DESIGN, CONSTRUCTION, AND/OR INSTALLATION OF THIS PROJECT IS THE PROPERTY OF VERDE DESIGN, INC. AND WILL BE USED, REPRODUCED, OR PUBLISHED BY ANY METHOD, IN WHOLE OR IN PART, OR DISCLOSED TO ANY PERSON, FIRM, OR ORGANIZATION WITHOUT THE WRITTEN PERMISSION OF VERDE DESIGN, INC. CONSULTANT FOR ANY PURPOSES WITHOUT THE WRITTEN PERMISSION OF VERDE DESIGN, INC.

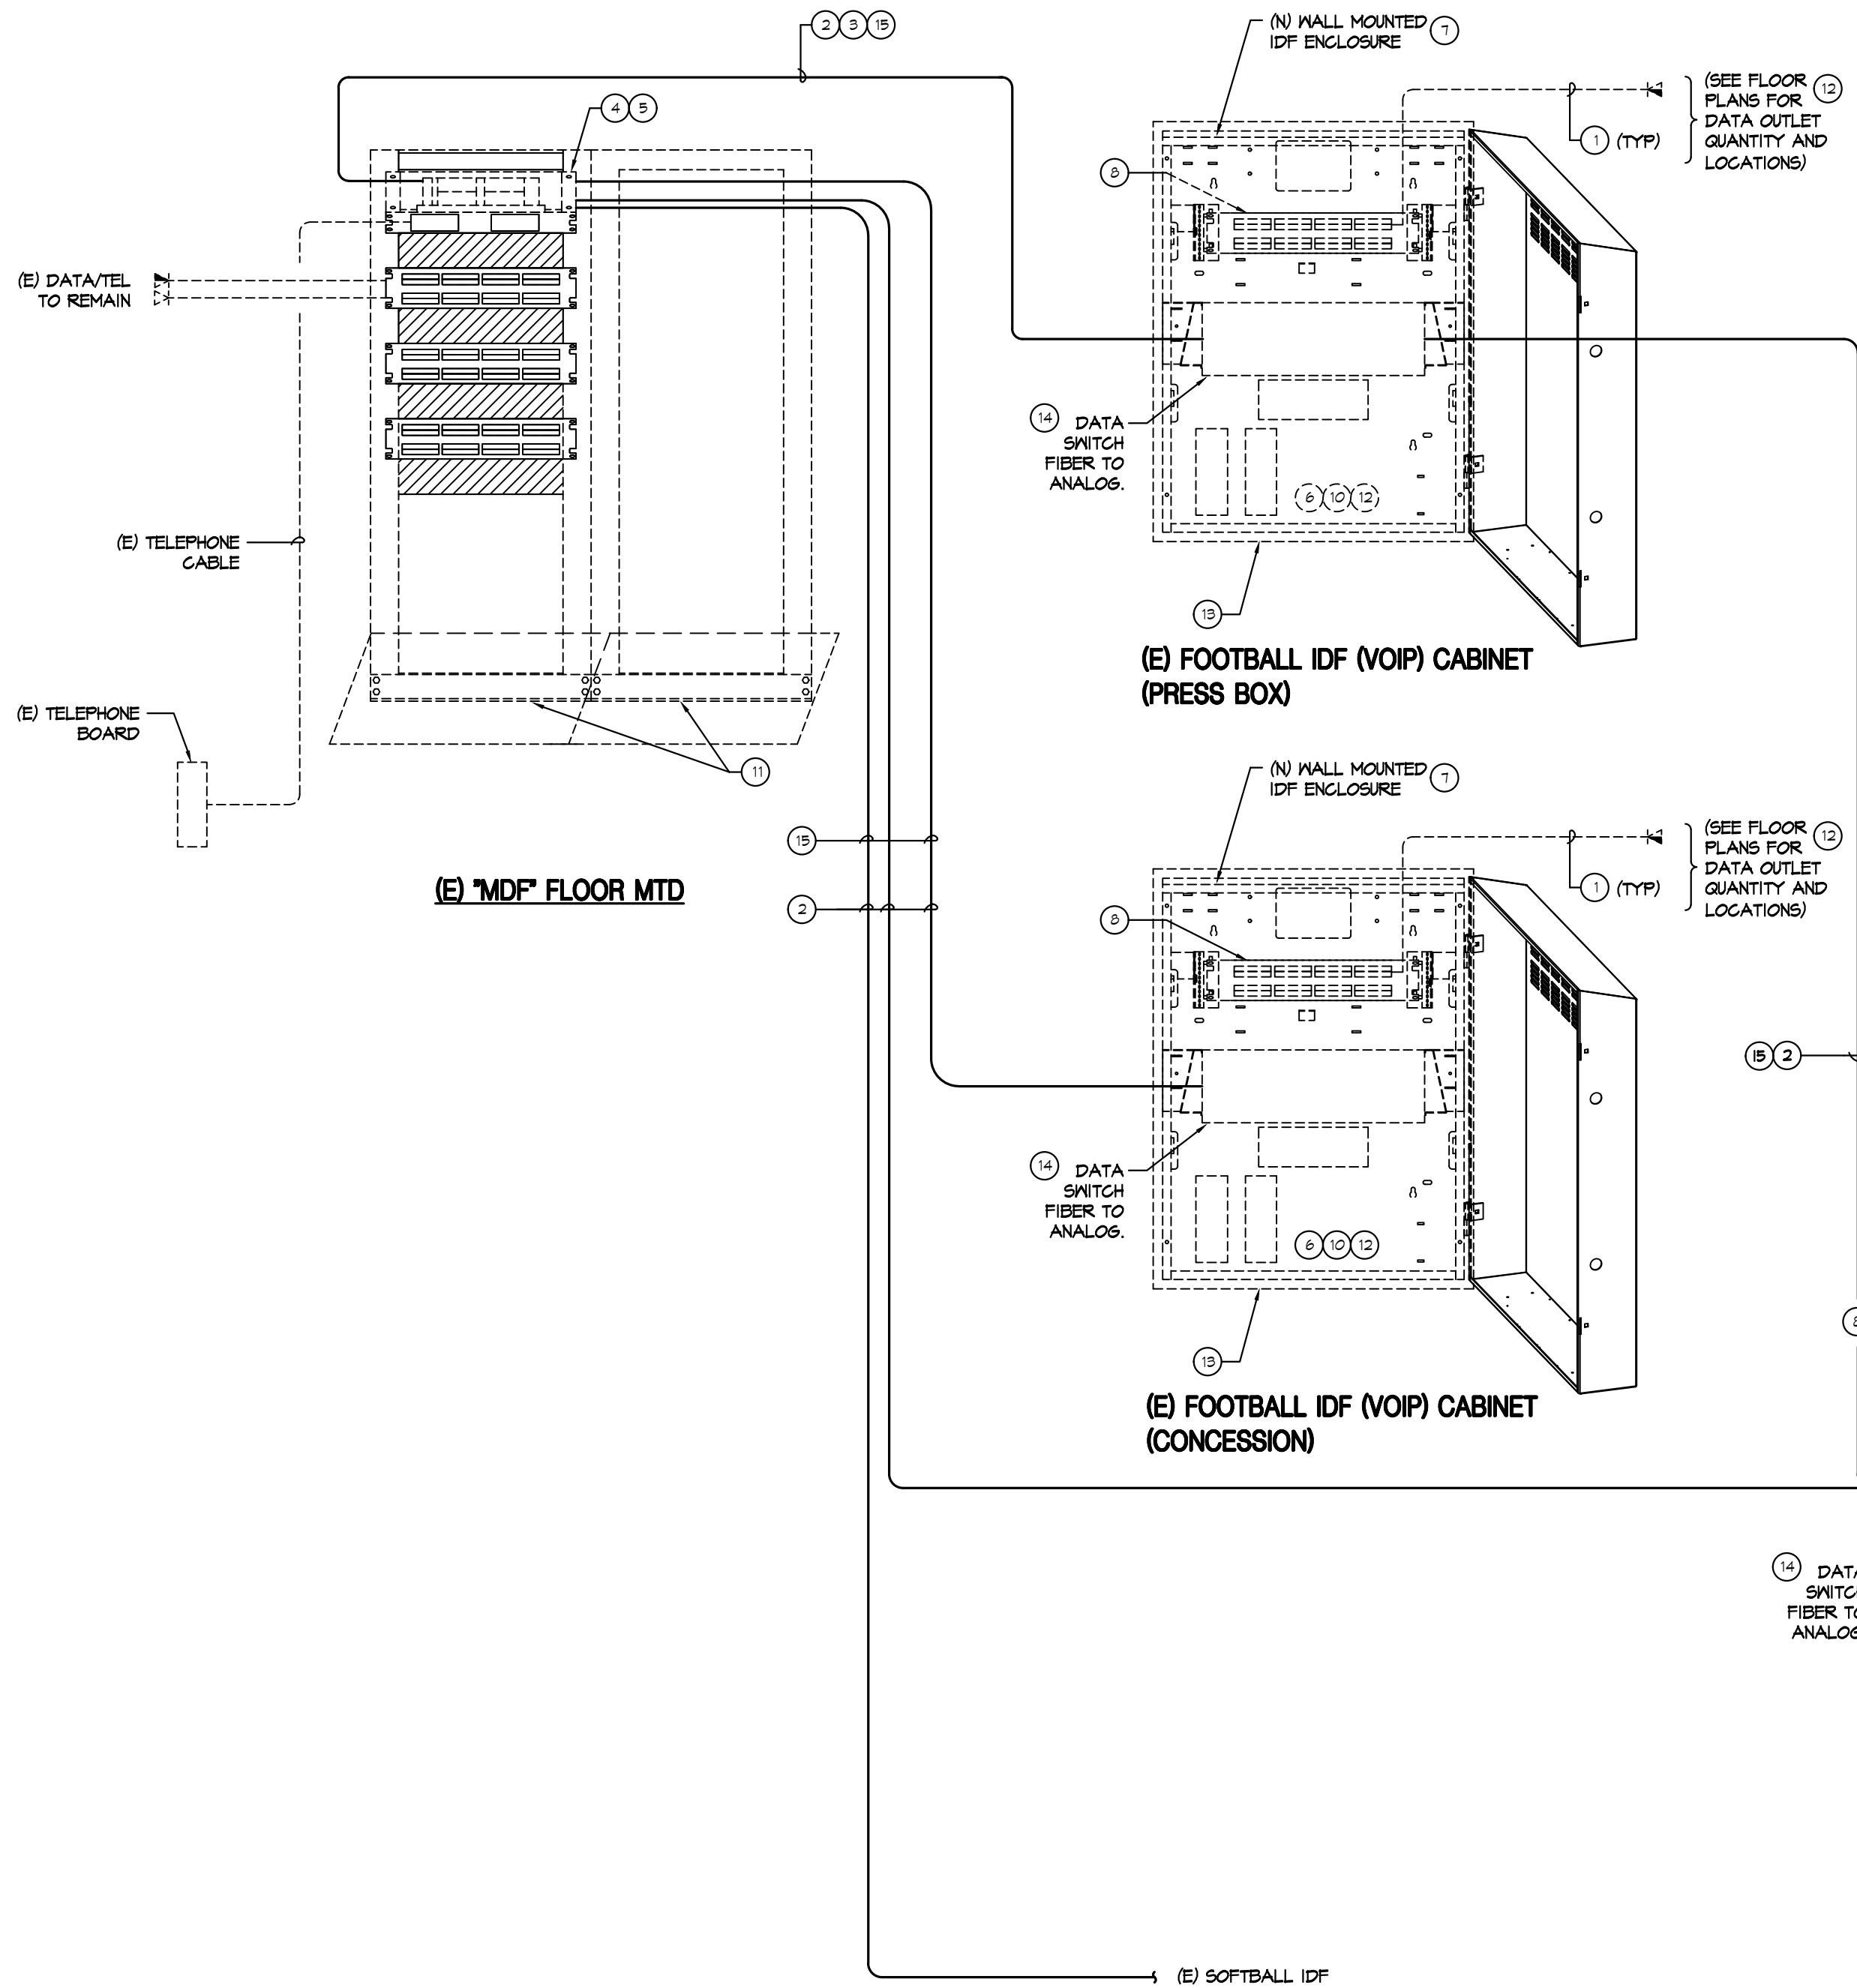


#### GENERAL NOTES:

1. ALL LOW VOLTAGE CABLES SHALL BE ROUTED IN CONDUIT IN NON ACCESSIBLE CONCEALED CEILING SPACES. PROVIDE J-HOOKS AT 40' OC. AS REQUIRED FOR ROOM AREAS WITH ACCESSIBLE T-BAR CEILING SPACES. SEE DETAIL FOR J-HOOK MOUNTING REQUIREMENTS.
2. (E) SYSTEM IS VOIP. CONTRACTOR SHALL HAVE MINIMUM 5 YEARS EXPERIENCE IN INSTALLING AND TESTING VOIP SYSTEMS. CONTRACTOR SHALL BE RESPONSIBLE FOR A FULLY COMPLETE OPERATIONAL SYSTEM.

#### DATA SYSTEM NOTES:

1. DATA JACK / PORT REQUIREMENTS TO INTERMEDIATE DISTRIBUTION FRAME (IDF) OR MAIN DISTRIBUTION FRAME (MDF)
1. INSTALL CATEGORY 6 CABLE IN CONDUIT AND/OR J-HOOKS FROM EACH PORT DATA LOCATION SHOWN ON PLANS TO THE NEAREST DESIGNATED ID/MP LOCATION. MAKE TERMINATIONS AT BOTH DATA OUTLET AND ID/MP LOCATION.
1. ROUTE CABLE DIRECTLY FROM STATION TO ID/ / MPF LOCATION WITHOUT SPLICE OR INTERRUPTION.
2. ALL DATA STATION CABLES TERMINATED IN THE ID/ / MPF WILL BE PLACED INTO MODULAR 48 PORT CAT. 6 PATCH PANELS.
3. PROVIDE CAT 6 568B RJ45 MODULAR JACK (QUANTITY AS REQUIRED)
4. MAKE TERMINATIONS AT ID/ / MPF LOCATION ON (N) PANTRY 568B PATCH PORT PANEL. PROVIDE ALL ADDITIONAL HARDWARE AS REQUIRED.
5. LEAVE 36 INCHES OF EXCESS CABLE AT THE ID/ LOCATION BEFORE MAKING TERMINATIONS. FOR USE AS A SERVICE LOOP. SECURE EXCESS CABLE IN A NEAT WORKMANLIKE MANNER.
6. ALL CAT 6 CABLES ARE TO BE TESTED FOR COMPLIANCE WITH CAT 6, USING A HAND HELD NETWORK SCANNER. HARD COPY AND SOFT COPY RESULTS ARE TO BE PROVIDED FOR ALL JACKS TESTED. NETWORK ANALYZER IS TO BE A FLUKE DSP 4800 OR OWNER APPROVED EQUIVALENT. SOFT COPY RESULTS TO BE PROVIDED ON A MINION 10 OR LATER COMPATIBLE DISK.
5. ANY EMPTY RJ45 JACK OPENING ON THE FACE PLATE WILL BE COVERED WITH BLANK INSERT, LEVITON DEVICE.
6. SEE SPECIFICATIONS FOR ADDITIONAL REQUIREMENTS.
3. INTERMEDIATE DISTRIBUTION FRAME (IDF) TO MAIN DISTRIBUTION FRAME (MDF)
1. INSTALL FIBER OPTIC CABLE IN CONDUIT FROM IDF LOCATIONS TO MDF LOCATION. MAKE TERMINATIONS AT BOTH ENDS OF CABLE WITH SC TYPE CONNECTORS.
1. ROUTE CABLE DIRECTLY FROM IDF TO MDF LOCATION WITHOUT SPLICE OR INTERRUPTION.
2. CONDUIT SHALL HAVE NO MORE THAN (2) 90 DEGREE BENDS. PROVIDE PULL BOXES WHERE NECESSARY TO LIMIT THE NUMBER OF CONDUIT BENDS AND ASSIST IN PULLING CABLE.
3. FIBER OPTIC CABLE SHALL BE (2) STRAND MULTI-MODE FIBER, OUTSIDE PLANT DISTRIBUTION, LOOSE TUBE, GEL FILLED, MANUFACTURED, SERVICED, OPTIC-48890/025 568ALITE FIBER OPTIC OR SEICORE/COMBINE 020KM-4480A20 ALLOS # ALL-DIELECTRIC OR EQUAL.
4. MAKE TERMINATIONS AT THE IDF LOCATION ON LEVITON RACK MOUNTED FIBER OPTIC PATCH PANEL. MAKE TERMINATIONS AT THE MDF ON (N) LEVITON RACK MOUNTED FIBER OPTIC PATCH PANEL.
5. LEAVE 18" OF THE EXCESS FIBER OPTIC CABLE AT THE IDF AND 18" OF EXCESS FIBER OPTIC CABLE AT THE MDF LOCATIONS BEFORE MAKING TERMINATIONS. FOR USE AS A SERVICE LOOP. SECURE EXCESS CABLE IN A NEAT WORKMANLIKE MANNER. ALL TERMINATED FIBER OPTIC CABLES IN IDF SHALL NOT EXCEED 12 STRANDS OR 6 PAIRS.
6. T.O. TERMINATION OF VOIP SHALL BE TERMINATED TO A 60 RACK MOUNT FIBER ENCLOSURE - LEVITON PART #18R60-CON WITH SC CONNECTIONS/INSERTS.

3. INSTALL (2) 25 PAIR CAT 5 6EL FILLED CABLES FOR TELEPHONE. SEE SPECIFICATIONS FOR ADDITIONAL REQUIREMENTS.
1. ALL MULTI-PAIR COPPER CABLE RIGS WILL BE TESTED AND DOCUMENTED.
2. CONTRACTOR MUST SHOW RESULTS FOR THE FOLLOWING TESTS:
  - a. CONTINUITY FOR ALL WIRES IN THE CABLE.
  - b. CORRECT PAIR ORDER FOR ALL PAIRS TERMINATED OR REPLACED.
3. ANY CABLES NOT PASSING MUST BE REPAIRED OR REPLACED.
4. THE CATEGORY 5 VOICE FIBER CABLES BETWEEN THE (E) SSC TELEPHONE RACK AND VOIP RACK SHALL BE UNSHIELDED TRISTED PAIR, 25 PAIR, 24 AWG SOLID CONDUCTORS CABLES FROM ESSEX OR EQUIVALENT AS APPROVED BY OWNER. COIL ABOUT 10' OF CABLE IN EACH END.
4. ADJUST (E) FIBER PATCH PANELS AS NEEDED TO FIT NEW FIELD LOCATE AND PROVIDE MODIFICATIONS AS NEEDED TO EXTEND VOIP SYSTEM.
3. PROVIDE (N) FIBER OPTIC PATCH PANEL TO TERMINATE NEW FIBER OPTIC CABLE.
3. PROVIDE GROUNDING CONNECTION TO BUILDING STEEL AND/OR NEAREST GROUND WATER PIPE. MINIMUM GROUNDING CONDUCTOR SHALL BE #4 CU BND.
3. TYPICAL IDF RACK. IDF RACK IN BLDGS SHALL BE WALL MOUNTED CABINET RACK HUBBEL #RE4XB.
3. PROVIDE (N) CAT 6 MODULAR PATCH PANEL. QUANTITY AS REQUIRED TO TERMINATE ALL DATA OUTLETS 100% SPARE. PATCH PANELS SHALL BE A 48 PORTS PANEL.
3. PROVIDE (N) HORIZONTAL WIRE MANAGER MODULE.
3. SEE SPECIFICATIONS FOR ADDITIONAL REQUIREMENTS FOR (N) CAT 6 WALL RACK PATCH PORTS.
3. EXISTING FLOOR MOUNTED RACK WITH (E) LADDER RACK.
3. PROVIDE (N) VOIP SWITCHES AND HANDSETS. CONTRACTOR IS RESPONSIBLE FOR A COMPLETE OPERATIONAL SYSTEM. COORDINATE WITH DISTRICT IT REPRESENTATIVE ALL REQUIREMENTS NEEDED TO PROVIDE A COMPLETE OPERATIONAL VOIP SYSTEM.
3. 1/2" PLYWOOD TO MOUNT NEW IDF ENCLOSURE. INSTALL PER MANUFACTURES RECOMMENDATIONS.
3. PROVIDE GSSCO SWITCH #750 SERIES.
3. PROVIDE A 100% TELEPHONE CABLE FOR FUTURE SECURITY USE. TELEPHONE CABLE SHALL BE OUTDOOR RATED. USE FOR MET LOCATIONS. CAT 5. ROUTE THE NEW IDF RACK CABLE IN THE NEW 4"X ALONG WITH FIBER. PROVIDE TELEPHONE CABLE FOR EACH IDF CABINET TO THE (E) VOIP ROOM ON EACH BOOM. ON EACH BOOM OF THE TELEPHONE CABLE. COIL ABOUT 10FT. IN LENGTH IN EACH IDF. AT THE (E) VOIP, COIL 10FT. IN LENGTH AT THE TELEPHONE #6 BLOCK TERMINALS.

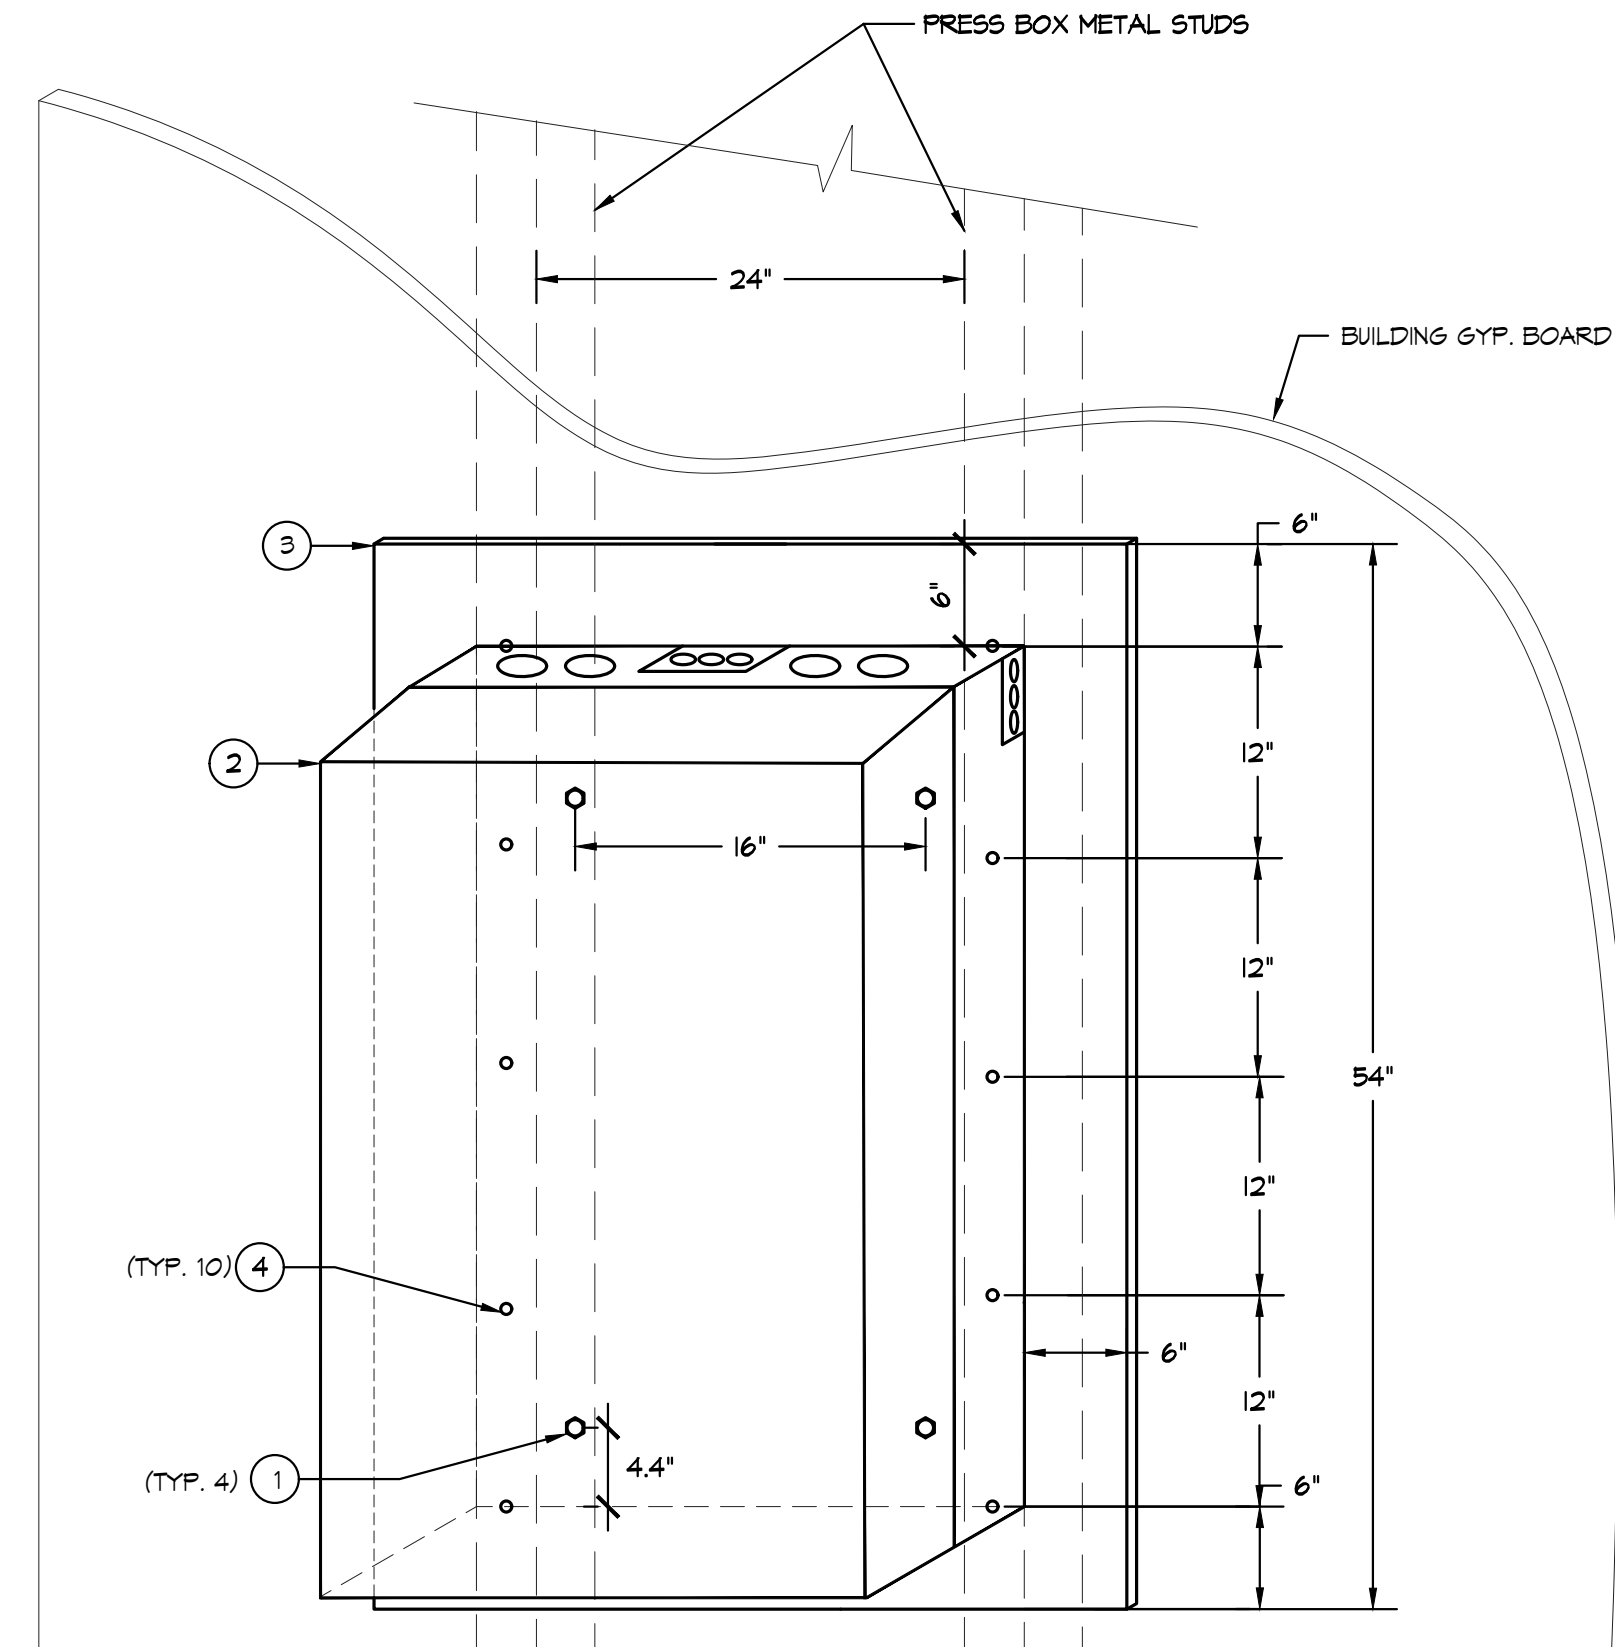


#### NOTES:

1. (4) 3/8" DIAMETER MACHINE SCREWS THROUGH CABINET BACK AND PLYWOOD WITH STD. CUT WASHERS UNDER ALL BOLT HEADS AND NUTS. USE LOCK-NUTS OR LOCK-WASHER UNDER NUTS.
2. (N) IDF CABINET. 42"H X 24.2"W X 10"D. VERIFY DIMENSIONS WITH MANUFACTURER. (MAX HEIGHT 180 LBS)
3. 5/8" PLYWOOD
4. (5) #12 X 2" SELF-DRILLING/TAPPING SCREWS THROUGH PLYWOOD AND GYP. BOARD INTO FLANGES OF TWO STUDS. (10 SCREWS TOTAL). ENSURE SCREWS ARE OF SUFFICIENT LENGTH TO EXTEND AT LEAST THREE THREADS PAST STUD FLANGE.

### 3 IDF INSTALLATION - METAL STUDS

E6.1 NOT TO SCALE

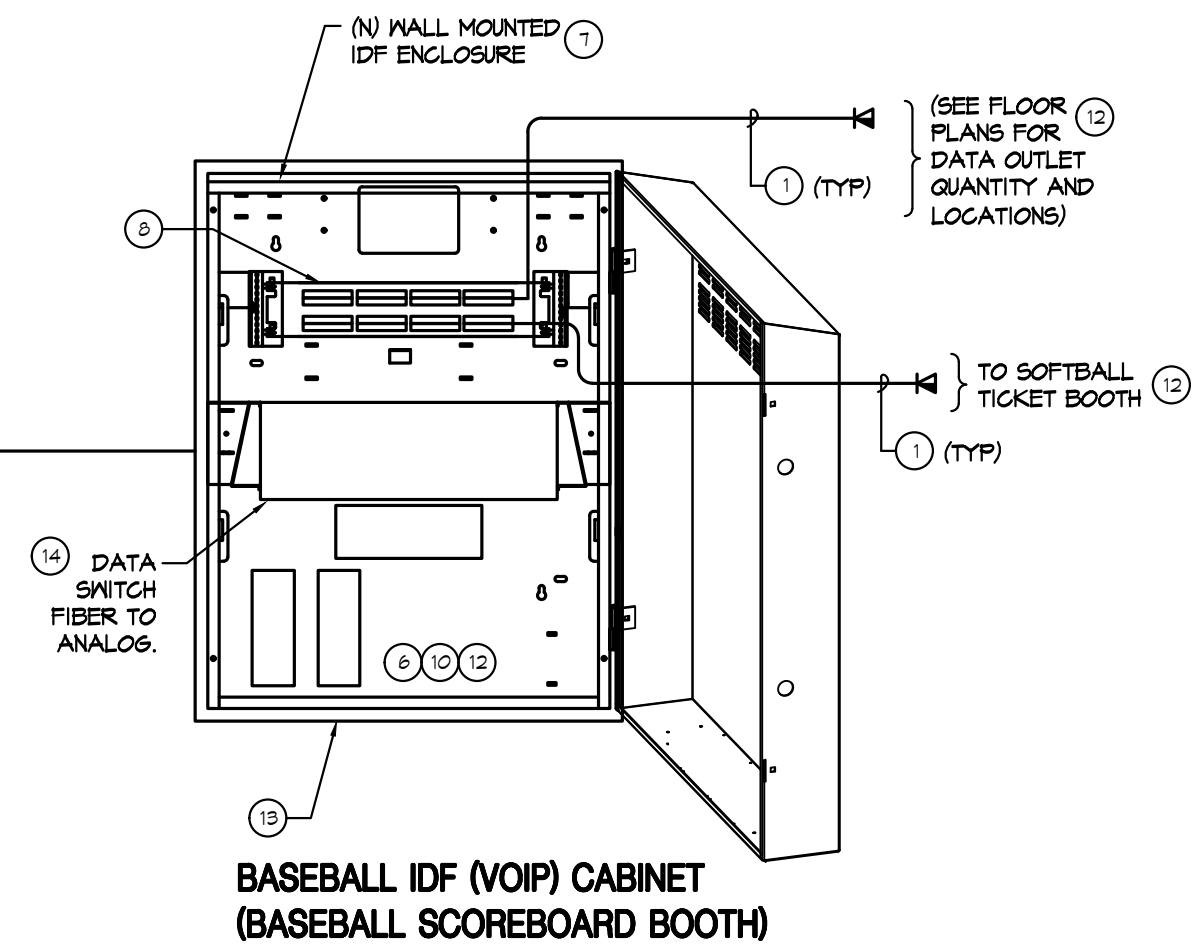


#### INTRUSION SYSTEM NOTES:

1. PROVIDE DEDICATED OUTLET FOR INTRUSION ALARM CONTROL. PANEL EQUIPMENT TO NEAREST ELECTRICAL PANEL. PROVIDE 20A/1P CIRCUIT BREAKER IN PANEL AND CONNECT AS REQUIRED. UPDATE PANEL DIRECTORY.

### 1 TYPICAL DATA RISER DIAGRAM BASEBALL


E6.1 NOT TO SCALE

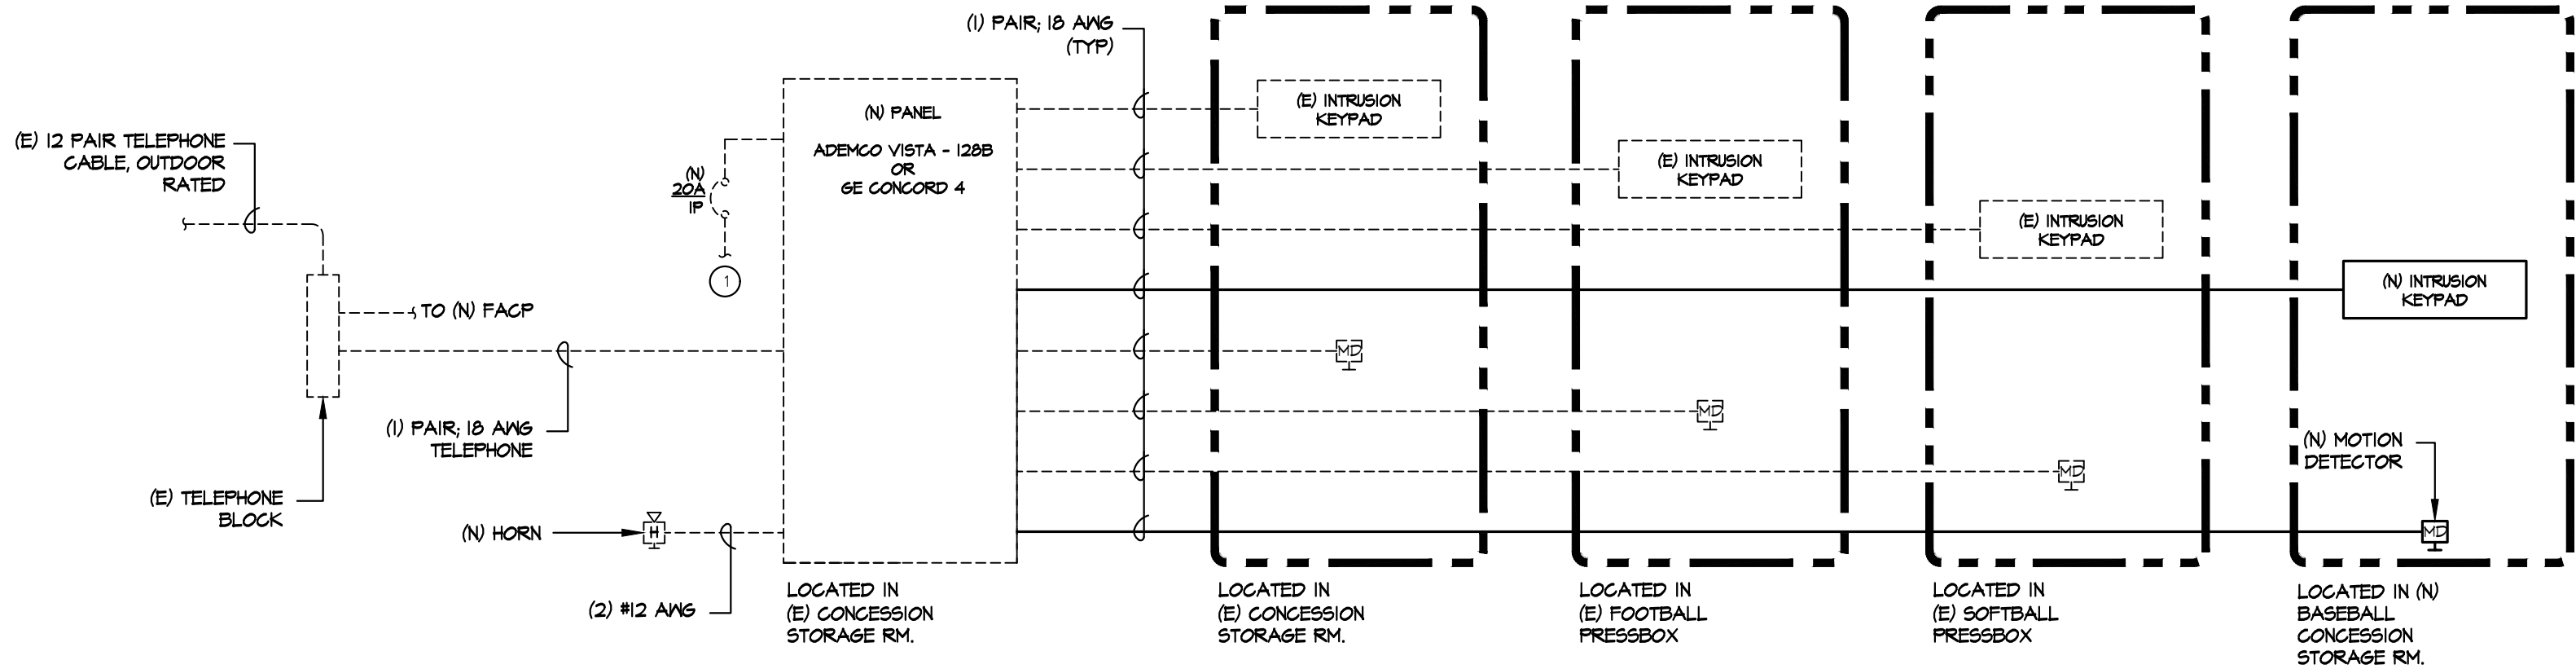






STAMP

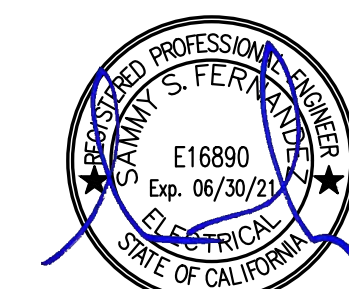

CONSULTANT



KEYMAP

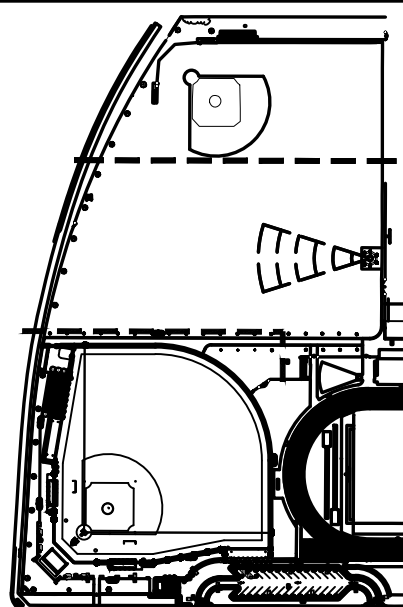

SHEET TITLE

TYPICAL PA RISER DIAGRAM  
(BASEBALL)

PROJECT NAME

CHAVEZ HIGH SCHOOL  
STOCKTON USD  
ATHLETIC FACILITY  
IMPROVEMENTS

PROJECT ADDRESS

2929 WINDFLOWER LN  
STOCKTON, CA 95212



| SUBMITTAL               | DATE     |
|-------------------------|----------|
| DD/50% SUBMITTAL        | 10/25/19 |
| DSA SUBMITTAL           | 12/20/19 |
| DSA BACKCHECK SUBMITTAL | 03/27/20 |

[illegible]

|                         |                      |
|-------------------------|----------------------|
| DRAWN BY<br>MG          | CHECKED BY<br>SB/ SF |
| DATE ISSUED<br>03/27/20 | SCALE                |

|           |              |
|-----------|--------------|
| PROJ. NO. | 1910900-1211 |
|-----------|--------------|

SHEET NO. **E6.2** OF #

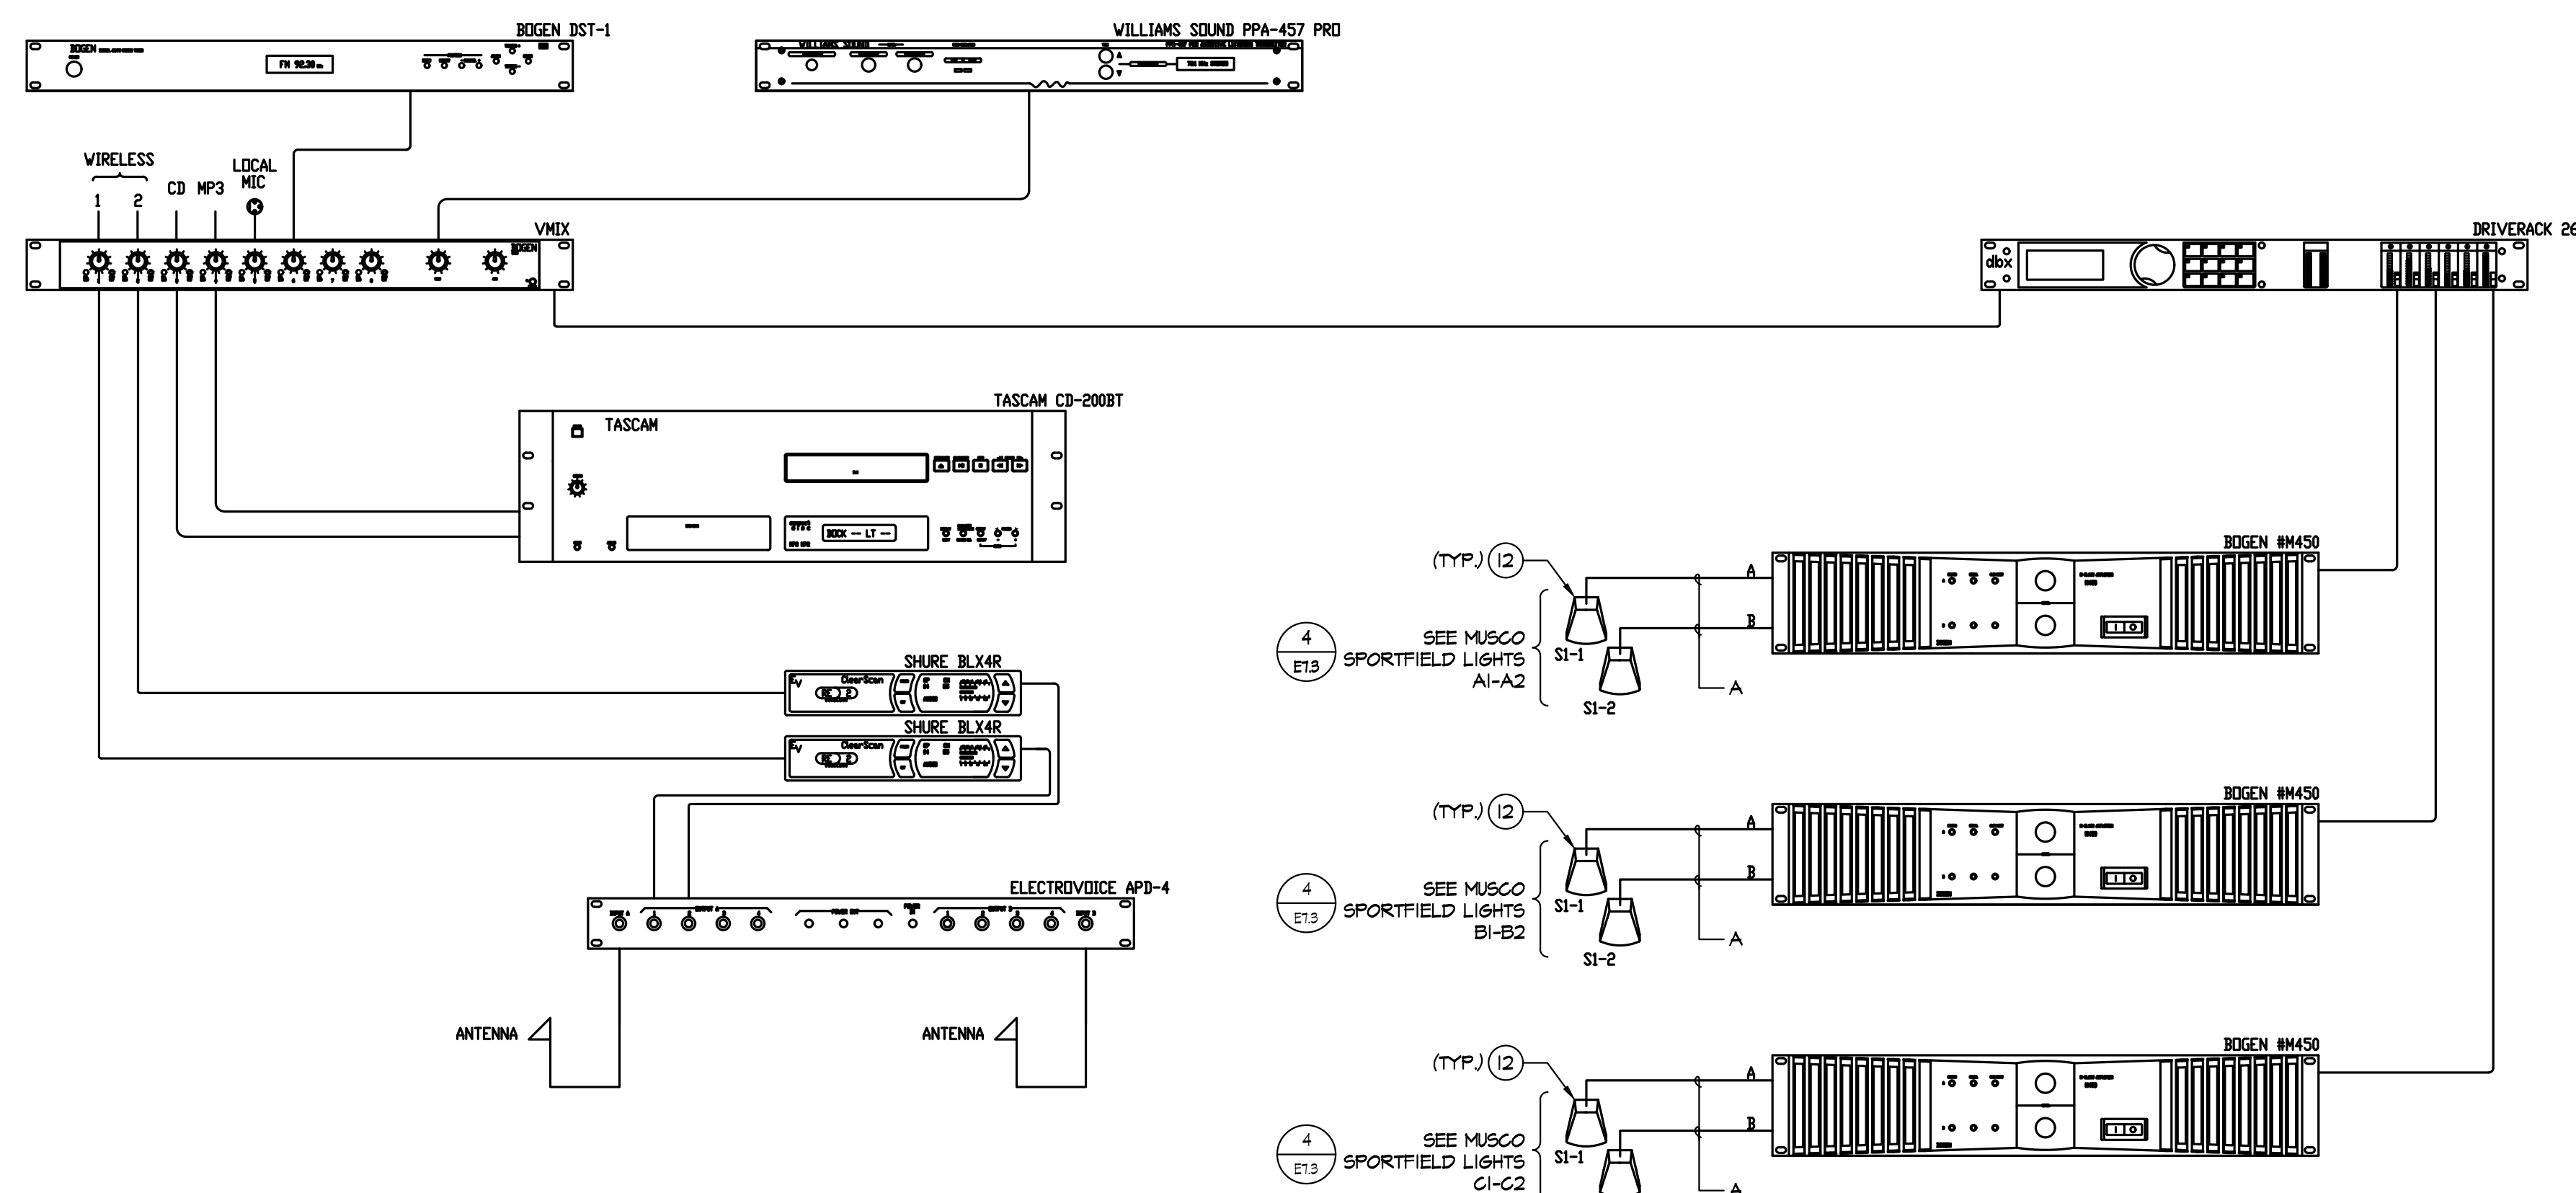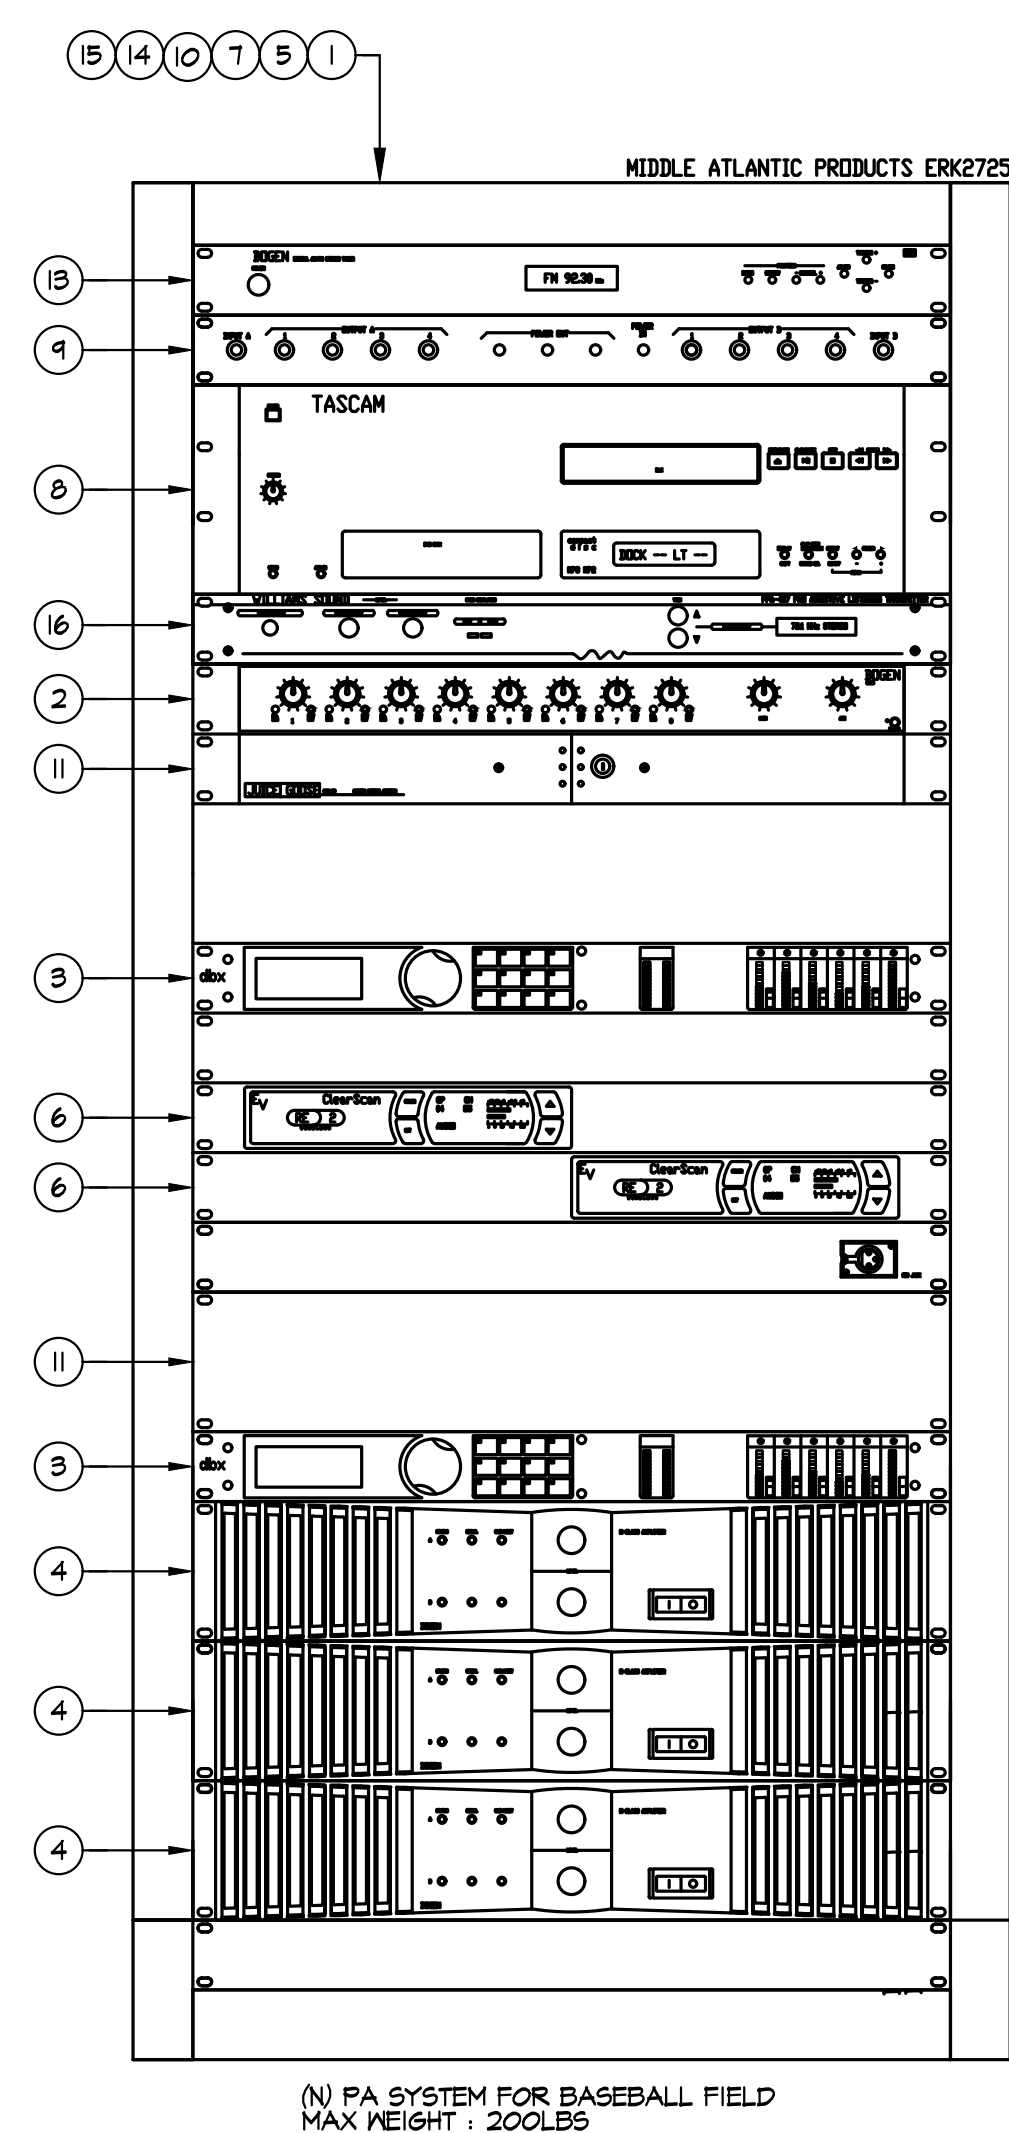

**P.A. RISER DIAGRAM NOTES:**

- (1) NEW FLOOR MOUNTED PA RACK, MIDDLE ATLANTIC PRODUCTS ERK 2125 OR APPROVED EQUAL.
- (2) NEW BOSEN VMX MIXER, OR APPROVED EQUAL.
- (3) NEW dex PDRIVERACK 260 EQUALIZER, OR APPROVED EQUAL.
- (4) NEW BOSEN M4850 AMPLIFIER, OR APPROVED EQUAL.
- (5) NEW BOSEN #DDU250 DESK MICROPHONE, QUANTITY (1), OR APPROVED EQUAL.
- (6) NEW SHURE #BLXAR WIRELESS MICROPHONE RECEIVER, OR APPROVED EQUAL.
- (7) NEW SHURE #SM58 HANDHELD WIRELESS MICROPHONE, QUANTITY (2), OR APPROVED EQUAL.
- (8) NEW TASCAM #CD-200BT CD/BLUETOOTH DECK, OR APPROVED EQUAL.
- (9) NEW SHURE WIRELESS MICROPHONE AMPLIFIER/ANTENNA SYSTEM, OR APPROVED EQUAL.

- 10 NEW MIDDLE ATLANTIC WFD-41SR POWER STRIP, OR APPROVED EQUAL.
- 11 NEW MIDDLE ATLANTIC RD-3 SLIDING DRAWER, OR APPROVED EQUAL.
- 12 NEW APOGEE 9AH4-12ST KEATHER PROOF SPEAKER, QUANTITY (2), OR APPROVED EQUAL.
- 13 NEW BOWEN DST-1 RADIO TOWER DECK, OR APPROVED EQUAL.
- 14 SEE SPECIFICATION FOR ADDITIONAL REQUIREMENTS.
- 15 PROVIDE QUANTITY OF CABLES AS REQUIRED BY THE SYSTEM. THE CONTRACTOR SHALL BE RESPONSIBLE FOR PROVIDING AND PROPERLY SIZING ALL CABLES PER THE PA SYSTEM MANUFACTURERS REQUIREMENTS.
- 16 ASSISTIVE LISTENING SYSTEM. SEE SPECS FOR REQUIREMENTS.


## CABLE SCHEDULE.

A- WESTPENN #AQ296 (2 CONDUCTOR #12 AWG OUTDOOR RATED SPEAKER CABLE

### TYPICAL PA RISER DIAGRAM (BASEBALL)

NOT TO SCALE






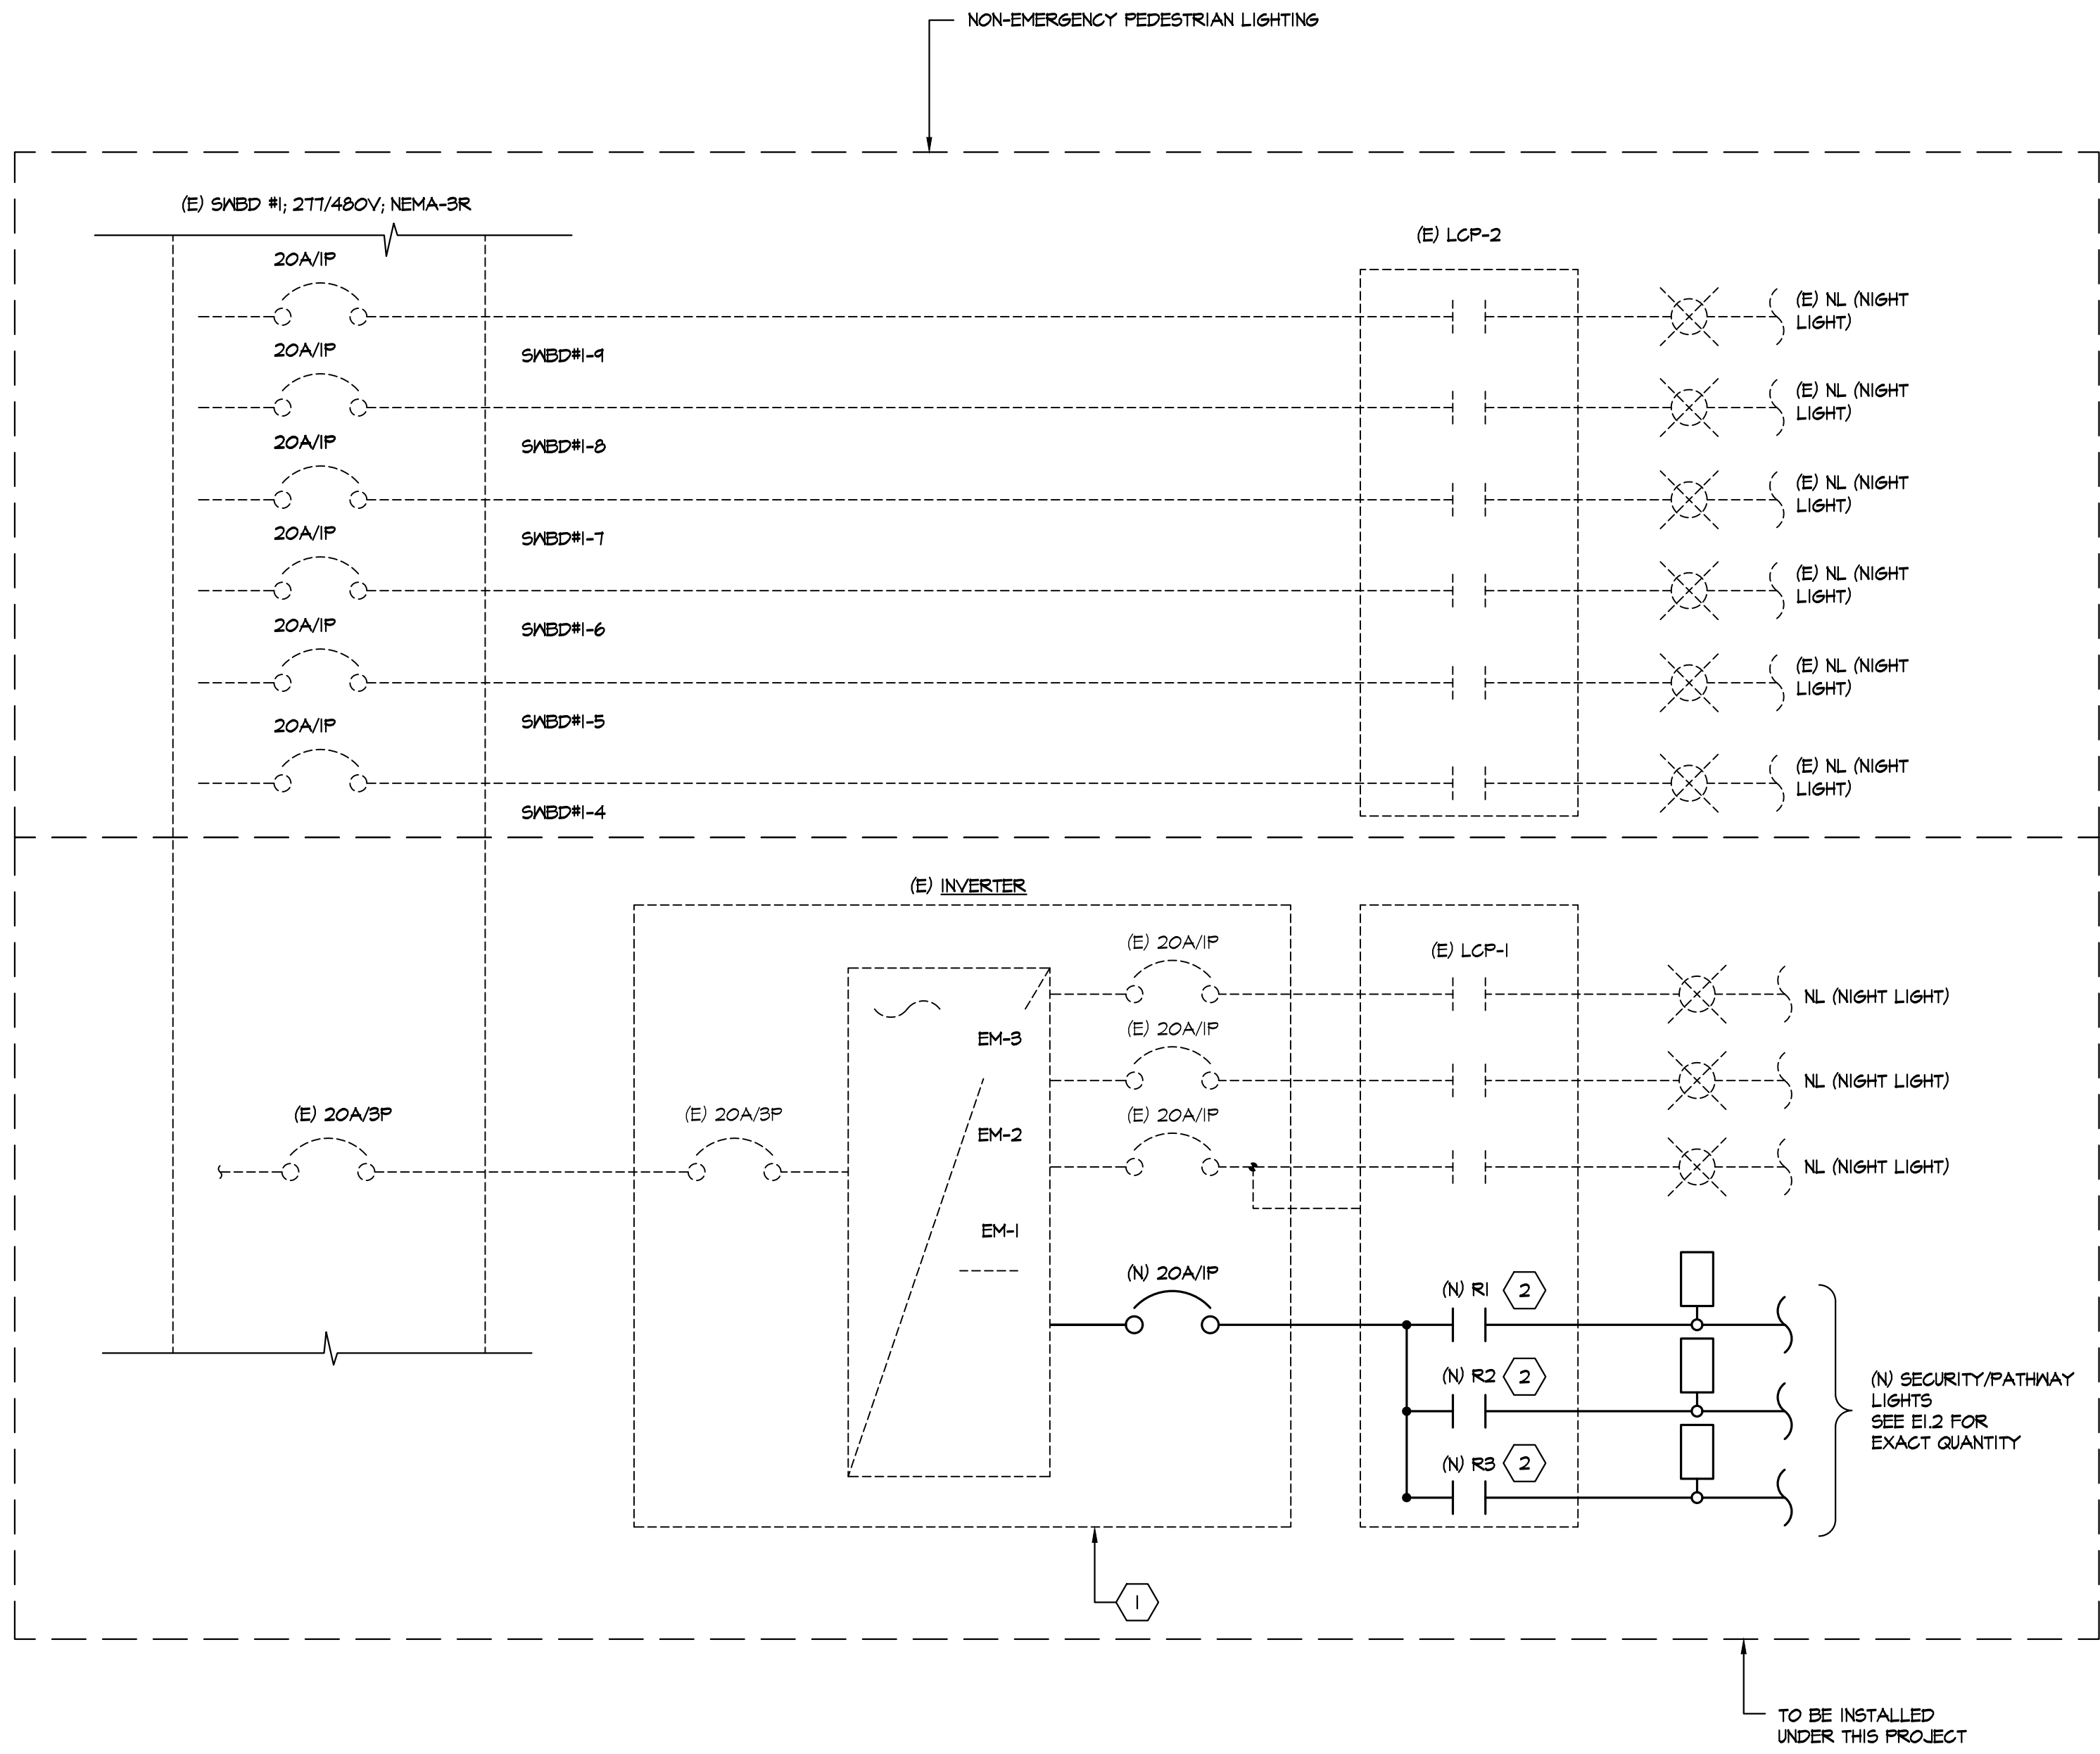

1  
E6.3 INVERTER AND LCP WIRING DIAGRAM (TYPICAL)  
NOT TO SCALE

## SHEET NOTES

- CONTRACTOR SHALL TEST EXISTING BATTERIES WITH NEW LOADS. CONTRACTOR SHALL CHANGE BATTERIES AND SHALL BE MYERS RECOMMENDED BATTERIES.
- PROVIDE NEW CONTACTOR IS (E) LCP. CONTRACTOR SHALL MATCH (E) CONTACTORS

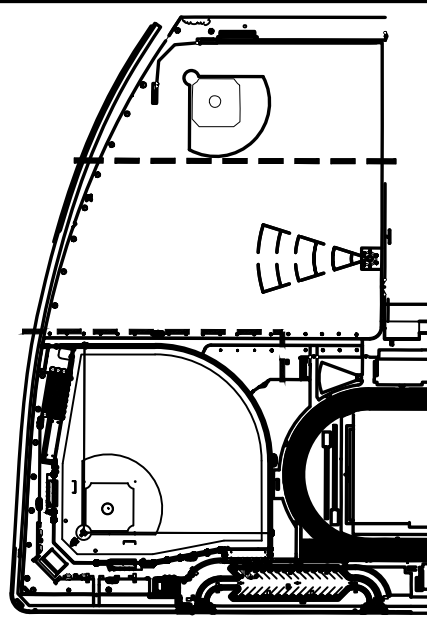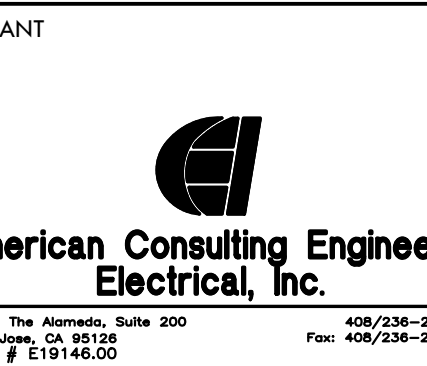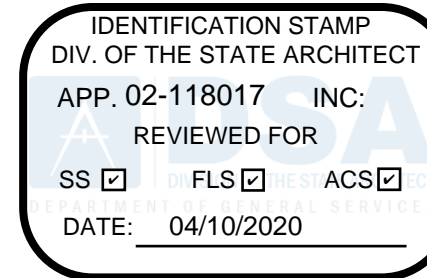

SHEET TITLE  
INVERTER AND LCP WIRING  
DIAGRAM (TYPICAL)

PROJECT NAME  
CHAVEZ HIGH SCHOOL  
STOCKTON USD  
ATHLETIC FACILITY  
IMPROVEMENTS

PROJECT ADDRESS  
2929 WINDFLOWER LN  
STOCKTON, CA 95212

| SUBMITTAL               | DATE     |
|-------------------------|----------|
| DD/50% SUBMITTAL        | 10/25/19 |
| DSA SUBMITTAL           | 12/20/19 |
| DSA BACKCHECK SUBMITTAL | 03/27/20 |


| NO. | REVISIONS | DATE |
|-----|-----------|------|
| 1   |           |      |
| 2   |           |      |
| 3   |           |      |
| 4   |           |      |
| 5   |           |      |

|                         |                      |
|-------------------------|----------------------|
| DRAWN BY<br>MG          | CHECKED BY<br>SB/ SF |
| DATE ISSUED<br>03/27/20 | SCALE                |


PROJ. NO.  
1910900-1211

SHEET NO.  
E6.3 OF #



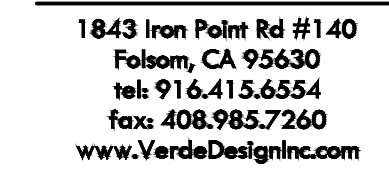

1890 The Alamedas, Suite 200 408/238-2312  
San Jose, CA 95126 Fax: 408/238-2318  
JDR # F19146.00

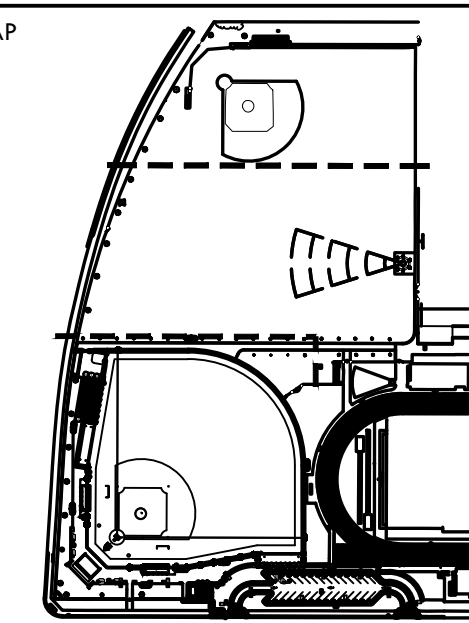

## ELECTRICAL DETAILS





CHAVEZ HIGH SCHOOL  
STOCKTON USD  
ATHLETIC FACILITY  
IMPROVEMENTS

2929 WINDFLOWER LN  
STOCKTON, CA 95212


[illegible]

|           |              |
|-----------|--------------|
| PROJ. NO. | 1910900-1211 |
|-----------|--------------|

## ELECTRICAL DETAILS

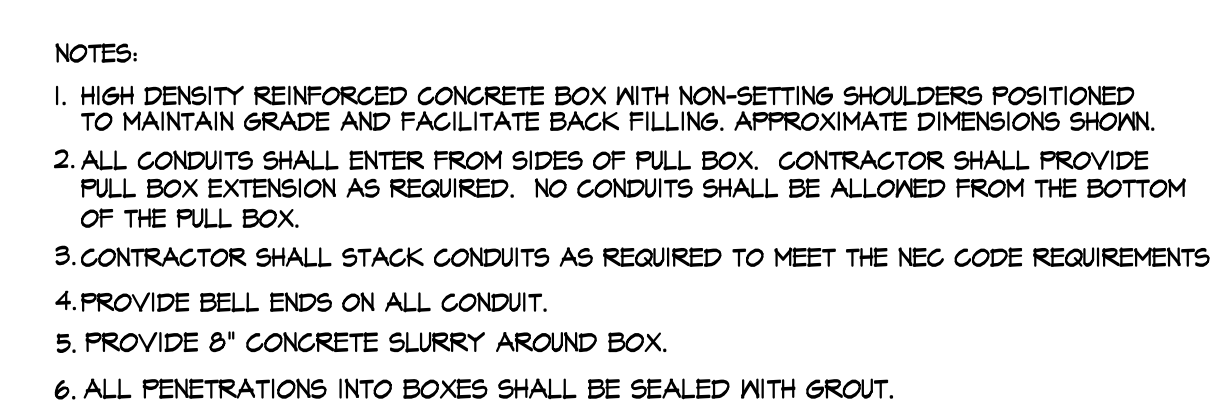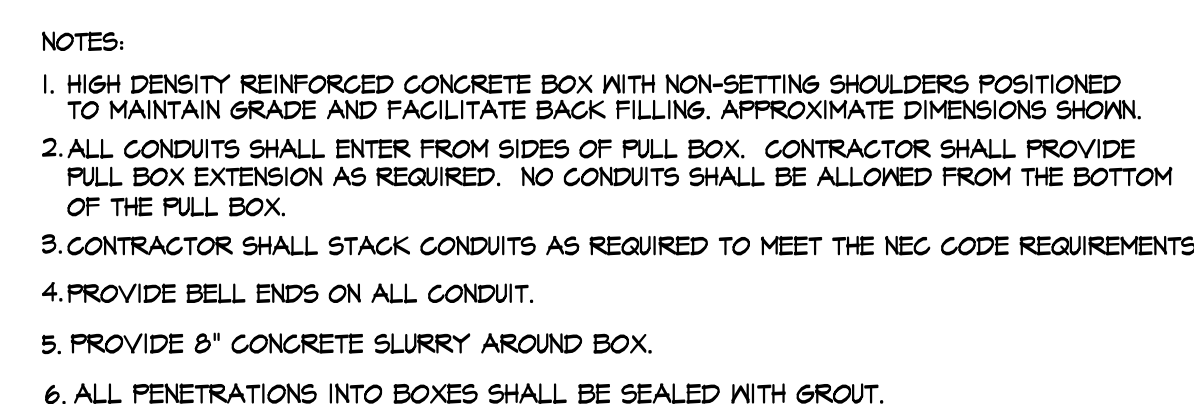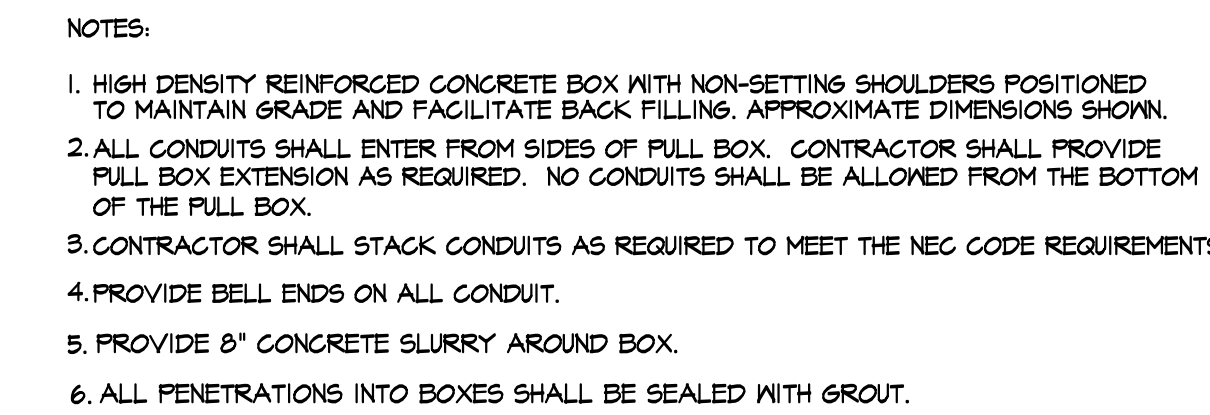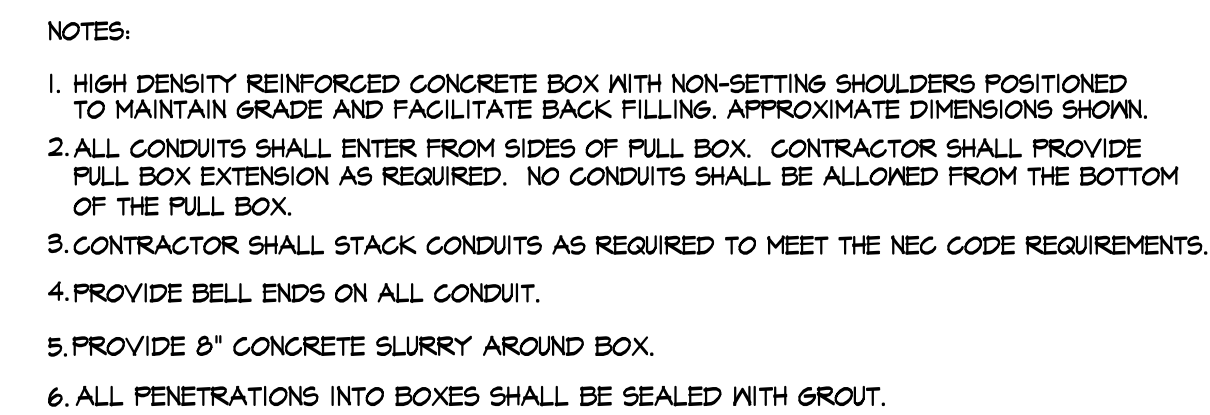




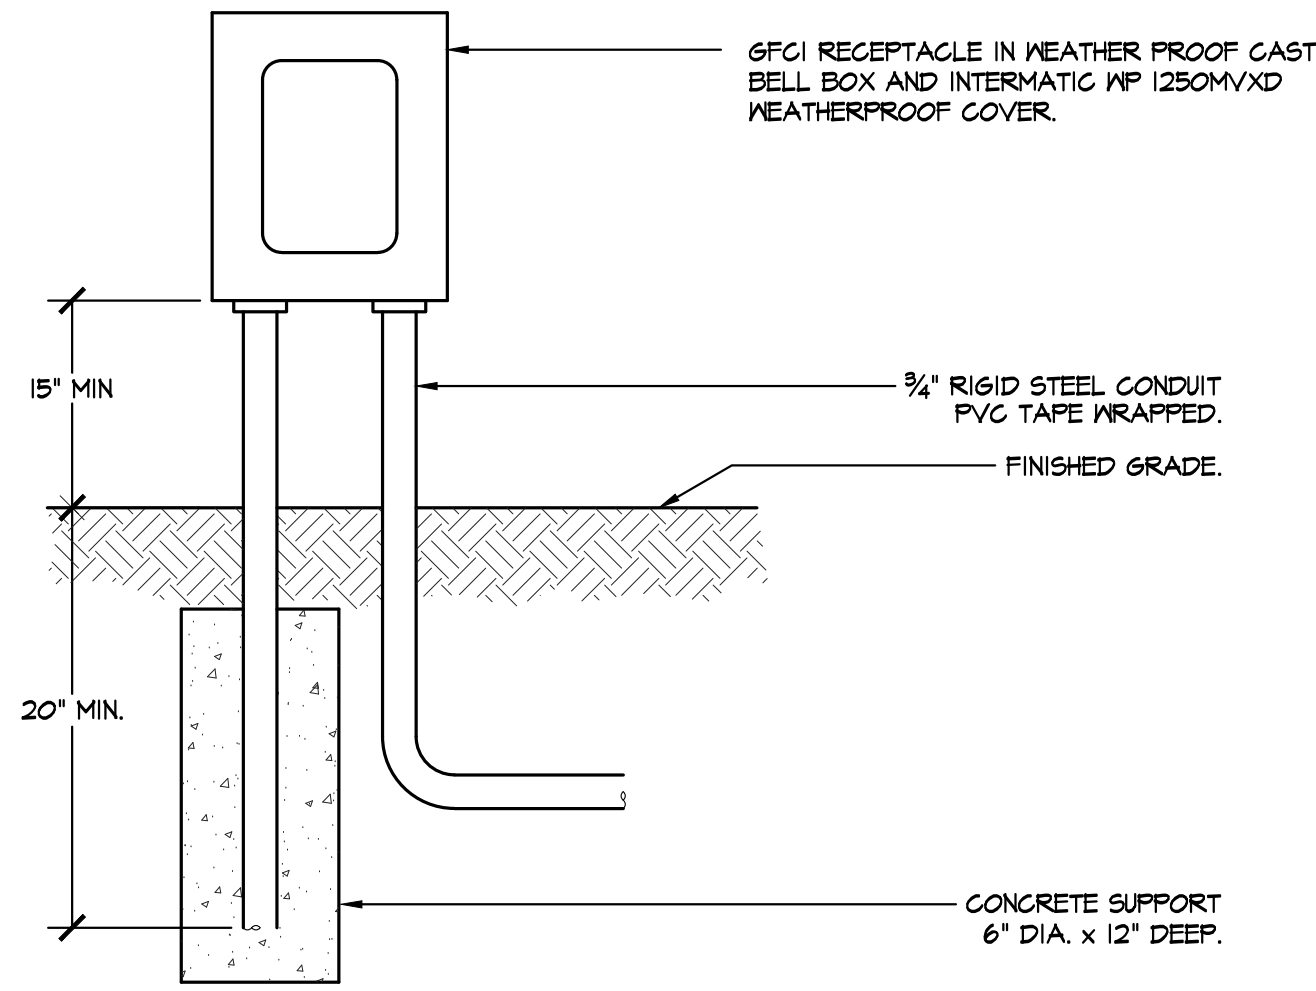

**RECEPTACLE PEDESTAL DETAIL**

1  
E7.2

NOT TO SCALE

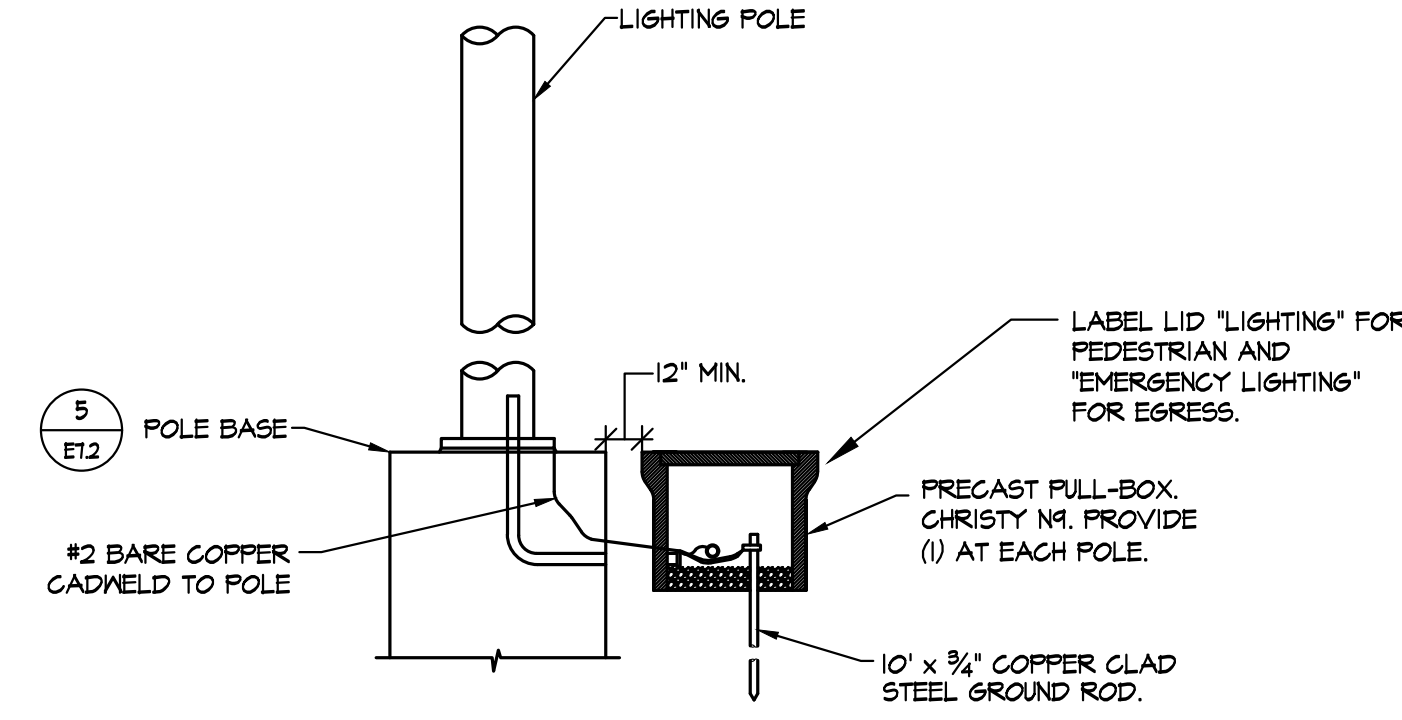


**TYPICAL WALKWAY LIGHTING  
POLE BASE GROUNDING DETAIL**

2  
E7.2

NOT TO SCALE

"EXEMPT FROM DSA  
REVIEW PER DSA IR-22"


"EXEMPT FROM DSA  
REVIEW PER DSA IR-22"

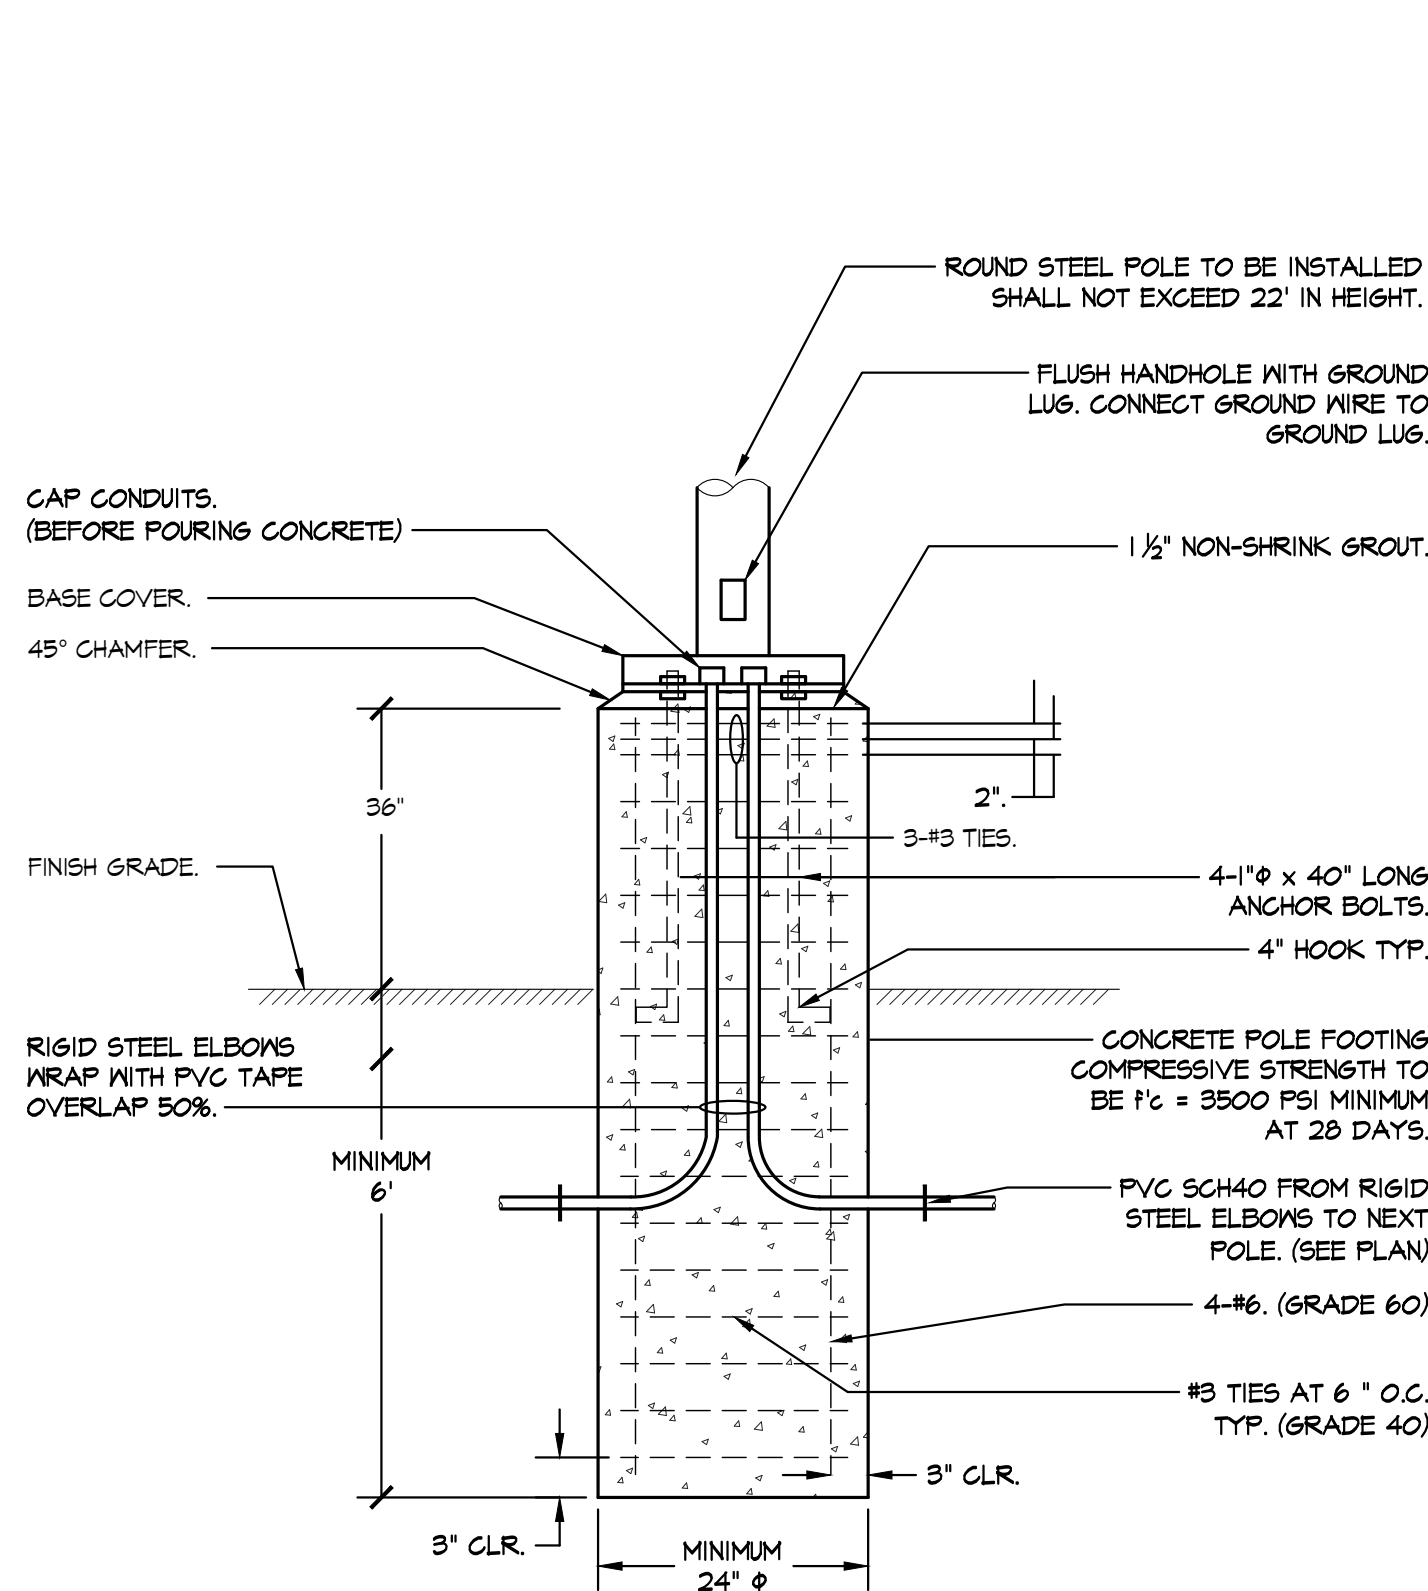

**TYPICAL RAISED POLE BASE DETAIL**

5  
E7.2


NOT TO SCALE

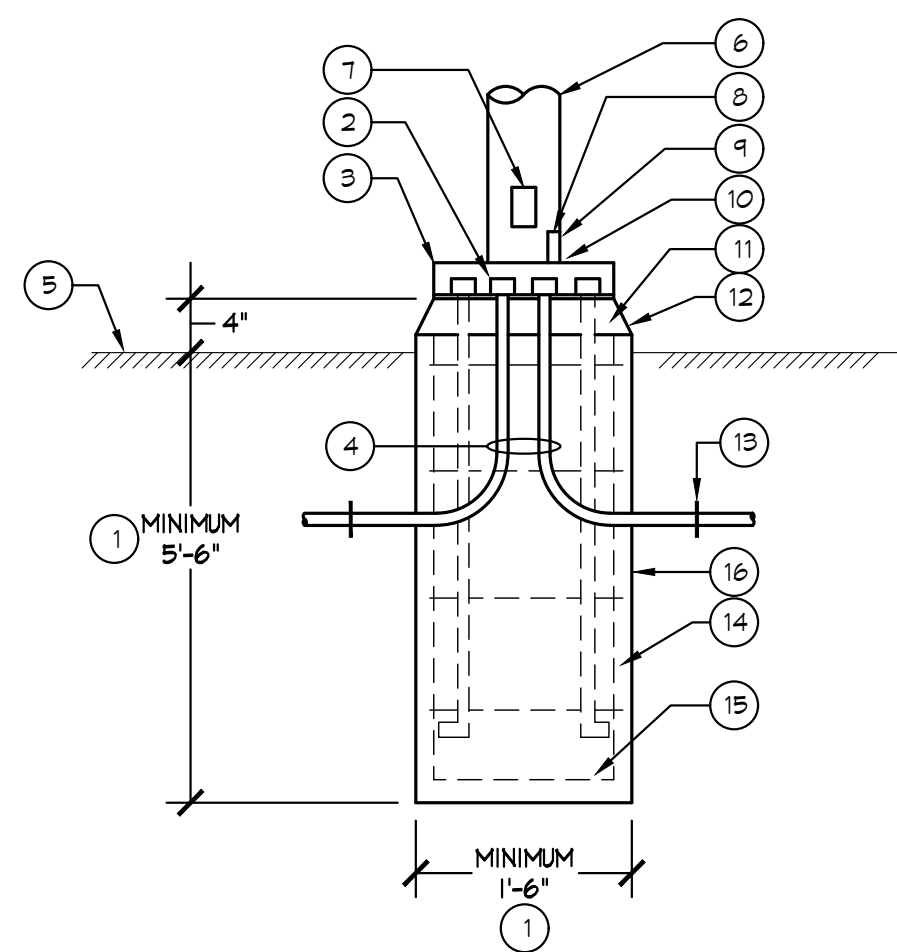

**FLUSH POLE BASE DETAIL**

6  
E7.2

NOT TO SCALE

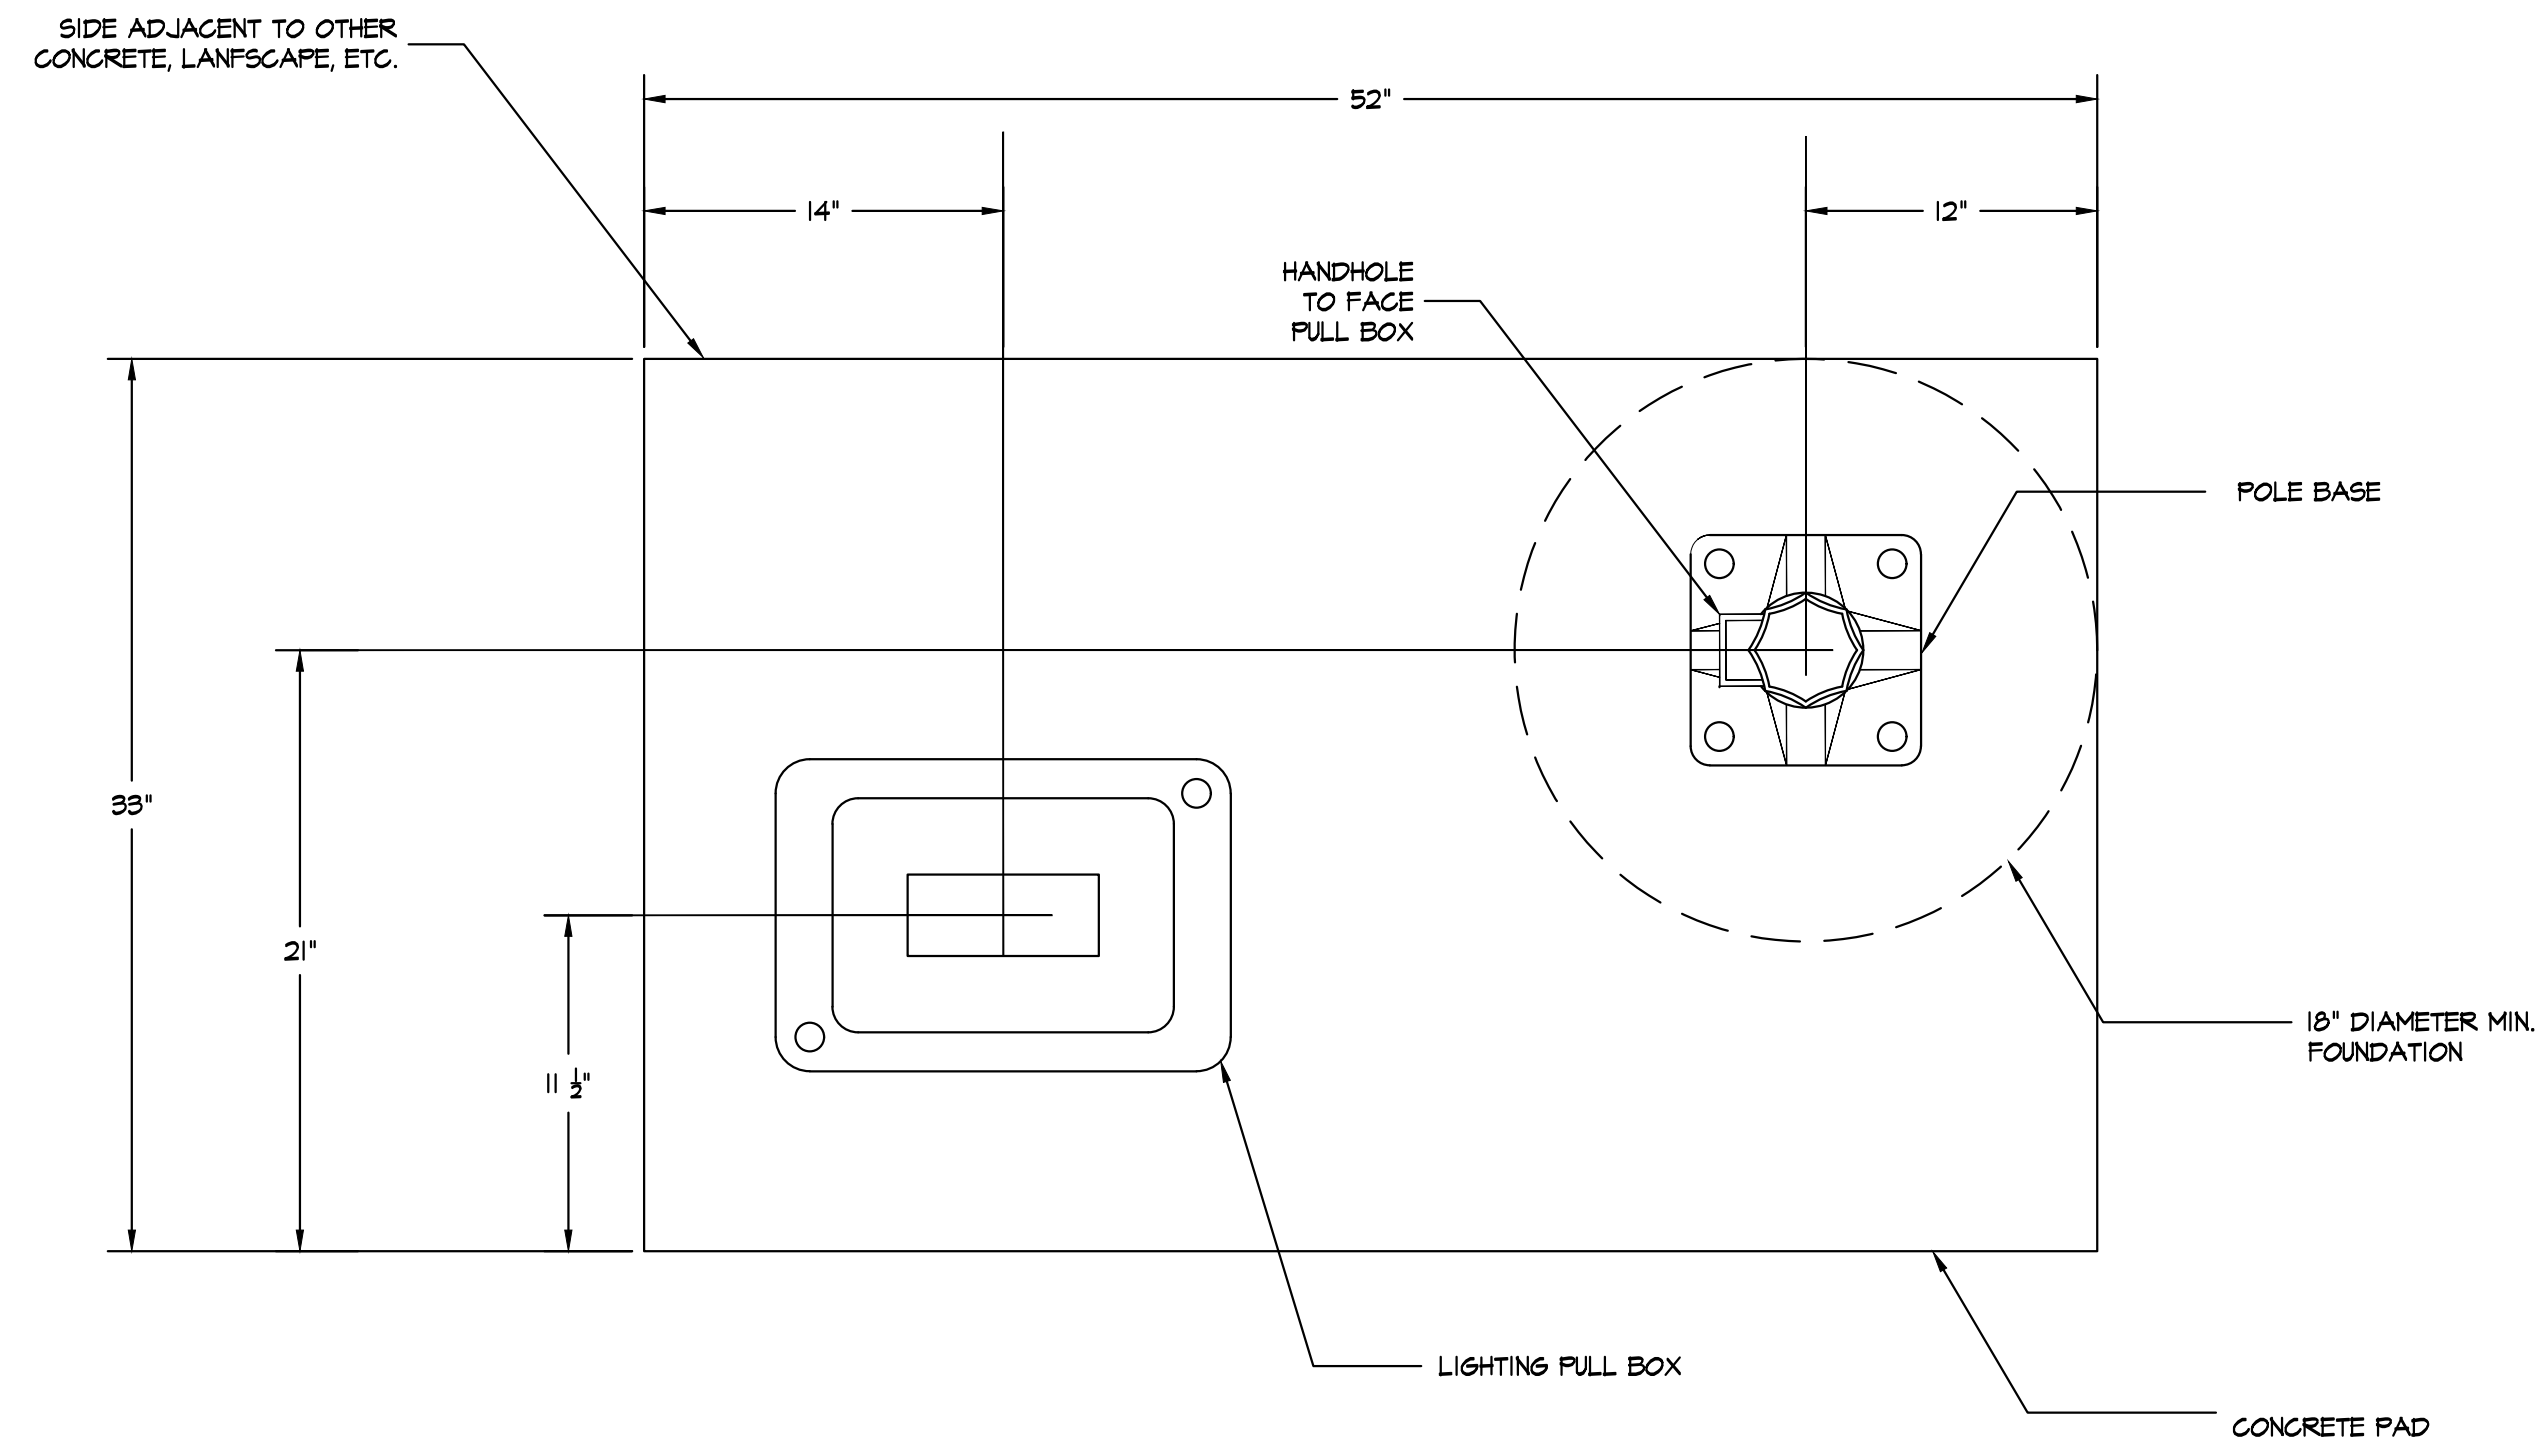

**CONCRETE PAD FOR LIGHT POLE AND PULL BOX**

7  
E7.2


NOT TO SCALE

IDENTIFICATION STAMP  
DIV. OF THE STATE ARCHITECT  
APP. 02-118017 INC.  
REVIEWED FOR  
SS ☒ FLS ☒ ACS ☒  
DATE: 04/10/2020



**VERDE DESIGN**  
LANDSCAPE ARCHITECTURE  
CIVIL ENGINEERING  
SPORT PLANNING & DESIGN  
1843 Iron Point Rd #140  
Folsom, CA 95630  
tel: 916.415.6554  
fax: 408.985.7260  
www.VerdeDesignInc.com

STAMP

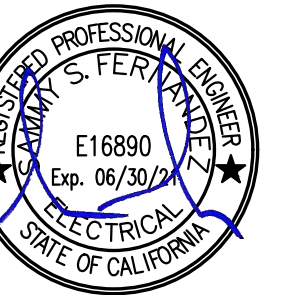


CONSULTANT



**American Consulting Engineers  
Electrical, Inc.**  
1990 The Armory, Suite 200  
San Jose, CA 95131  
JOB # E19148.00  
Date: 03/28/2019

KEYMAP

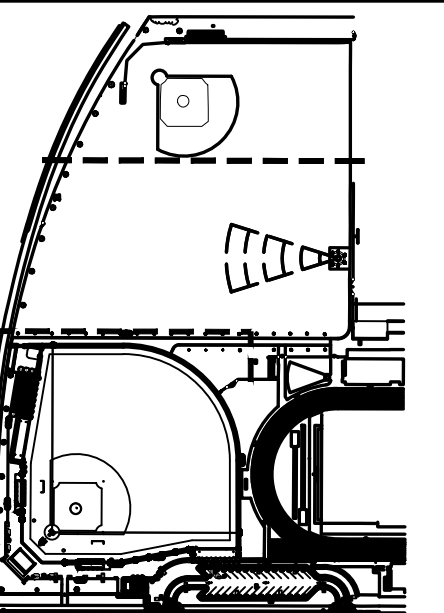

SHEET TITLE

**ELECTRICAL DETAILS**

PROJECT NAME

**CHAVEZ HIGH SCHOOL  
STOCKTON USD  
ATHLETIC FACILITY  
IMPROVEMENTS**

PROJECT ADDRESS

**2929 WINDFLOWER LN  
STOCKTON, CA 95212**

| SUBMITTAL               | DATE     |
|-------------------------|----------|
| DD/50% SUBMITTAL        | 10/25/19 |
| DSA SUBMITTAL           | 12/20/19 |
| DSA BACKCHECK SUBMITTAL | 03/27/20 |

| NO. | REVISIONS | DATE |
|-----|-----------|------|
| 1   |           |      |
| 2   |           |      |
| 3   |           |      |
| 4   |           |      |
| 5   |           |      |

|                         |                      |
|-------------------------|----------------------|
| DRAWN BY<br>MG          | CHECKED BY<br>SB/ SF |
| DATE ISSUED<br>03/27/20 | SCALE                |

PROJ. NO.  
1910900-1211

SHEET NO.  
**E7.2** OF #

**ELECTRICAL DETAILS**

ALL DESIGN, CONSTRUCTION, AND ANY OTHER INFORMATION CONTAINED HEREIN IS THE PROPERTY OF VERDE DESIGN, INC. AND IS NOT TO BE REPRODUCED, COPIED, OR IN ANY MANNER DISCLOSED TO ANY PERSON, FIRM, OR CORPORATION WITHOUT THE WRITTEN PERMISSION OF VERDE DESIGN, INC.




ALL DESIGN, CONSTRUCTION, AND/OR MATERIALS OF THIS PROJECT ARE OWNED BY AND THE PROPERTY OF VERDE DESIGN, INC. AND WERE CREATED, DEVELOPED, AND DEVELOPED FOR USE ON AND IN CONNECTION WITH THE SPECIFIED PROJECT. NONE OF SUCH IDEAS, DESIGNS, ARRANGEMENTS OR PLANS SHALL BE USED, REPRODUCED, OR PUBLISHED IN WHOLE OR IN PART, OR DISCLOSED TO ANY PERSON, FIRM, OR CORPORATION FOR ANY PURPOSE WITHOUT WRITTEN PERMISSION OF VERDE DESIGN, INC.


IDENTIFICATION STAMP  
DIV. OF THE STATE ARCHITECT  
APP. 02-118017 INC.  
REVIEWED FOR  
SS ☒ FLS ☒ ACS ☒  
DATE: 04/10/2020



**VERDE DESIGN**  
LANDSCAPE ARCHITECTURE  
CIVIL ENGINEERING  
SPORT PLANNING & DESIGN  
1843 Iron Point Rd #140  
Folsom, CA 95630  
tel: 916.415.6554  
fax: 408.985.7260  
www.VerdeDesignInc.com

STAMP  


CONSULTANT  
  
**American Consulting Engineers  
Electrical, Inc.**  
1960 The Armada, Suite 200  
San Jose, CA 95131  
JOB # E19148-00  
Fax: 408/284-2212  
Fax: 408/284-2212

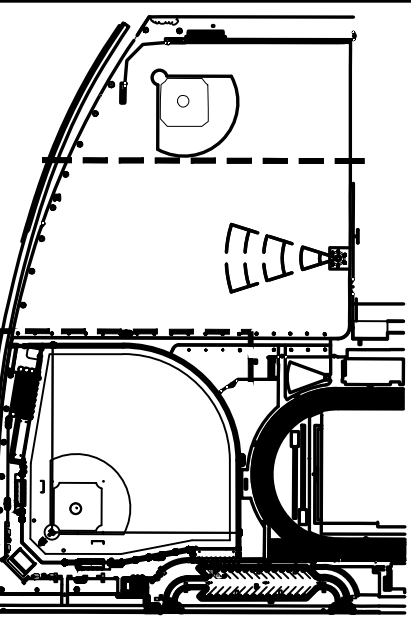KEYMAP  


SHEET TITLE

ELECTRICAL DETAILS

PROJECT NAME  
CHAVEZ HIGH SCHOOL  
STOCKTON USD  
ATHLETIC FACILITY  
IMPROVEMENTS

PROJECT ADDRESS  
2929 WINDFLOWER LN  
STOCKTON, CA 95212


| SUBMITTAL               | DATE     |
|-------------------------|----------|
| DD/50% SUBMITTAL        | 10/25/19 |
| DSA SUBMITTAL           | 12/20/19 |
| DSA BACKCHECK SUBMITTAL | 03/27/20 |

| NO. | REVISIONS | DATE |
|-----|-----------|------|
| 1   |           |      |
| 2   |           |      |
| 3   |           |      |
| 4   |           |      |
| 5   |           |      |
| 6   |           |      |

|                         |                      |
|-------------------------|----------------------|
| DRAWN BY<br>MG          | CHECKED BY<br>SB/ SF |
| DATE ISSUED<br>03/27/20 | SCALE                |

PROJ. NO.  
1910900-1211

SHEET NO.  
**E7.3** OF #  
ELECTRICAL DETAIL

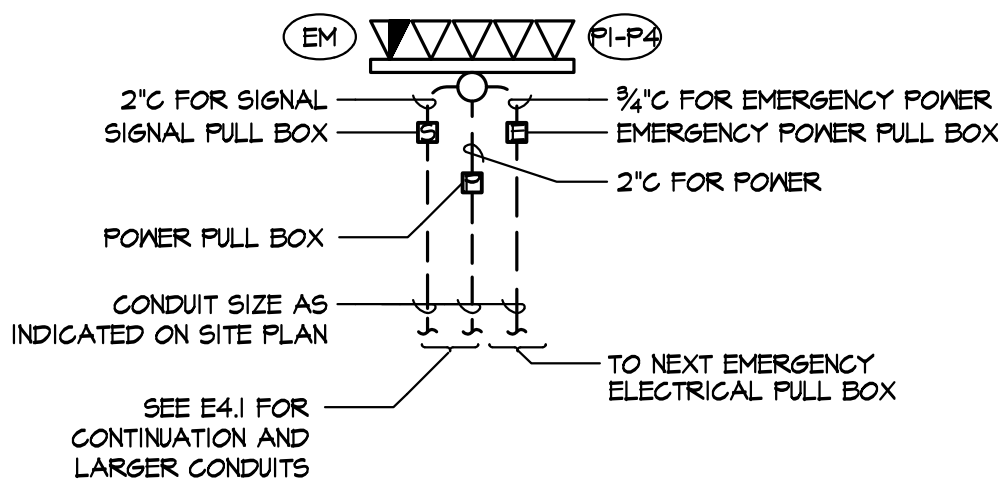


## POLE BASE CONDUIT ENTRY DETAIL

1  
E7.3 NOT TO SCALE


NOTE:

IN GRADE BOXES NEED TO BE COORDINATED WITH LANDSCAPE CONTRACTOR AND ARCHITECT TO ENSURE FLAT SURFACE DUE TO LOCATION BOXES NOTED TO BE IN RIGHT ANGLE WITH CONCRETE PAVING. SEE LANDSCAPE DRAWINGS FOR REQUIREMENTS.

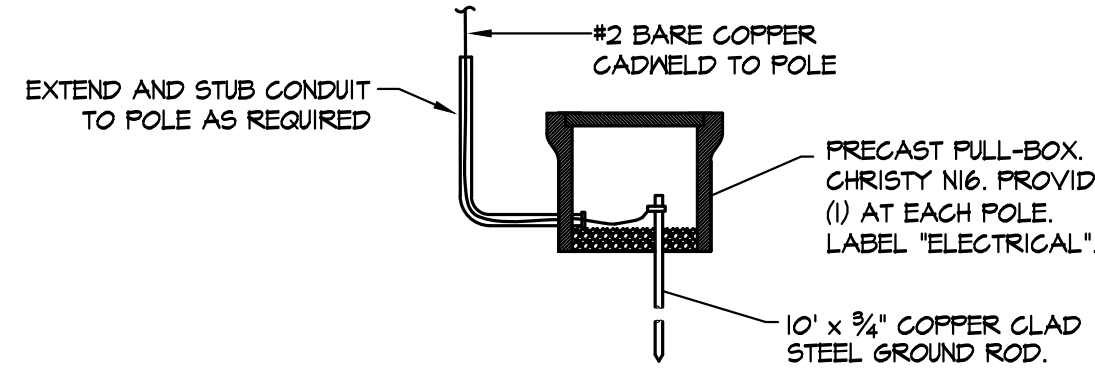

## FIELD LIGHTING GROUNDING BOX DETAIL

2  
E7.3 NOT TO SCALE

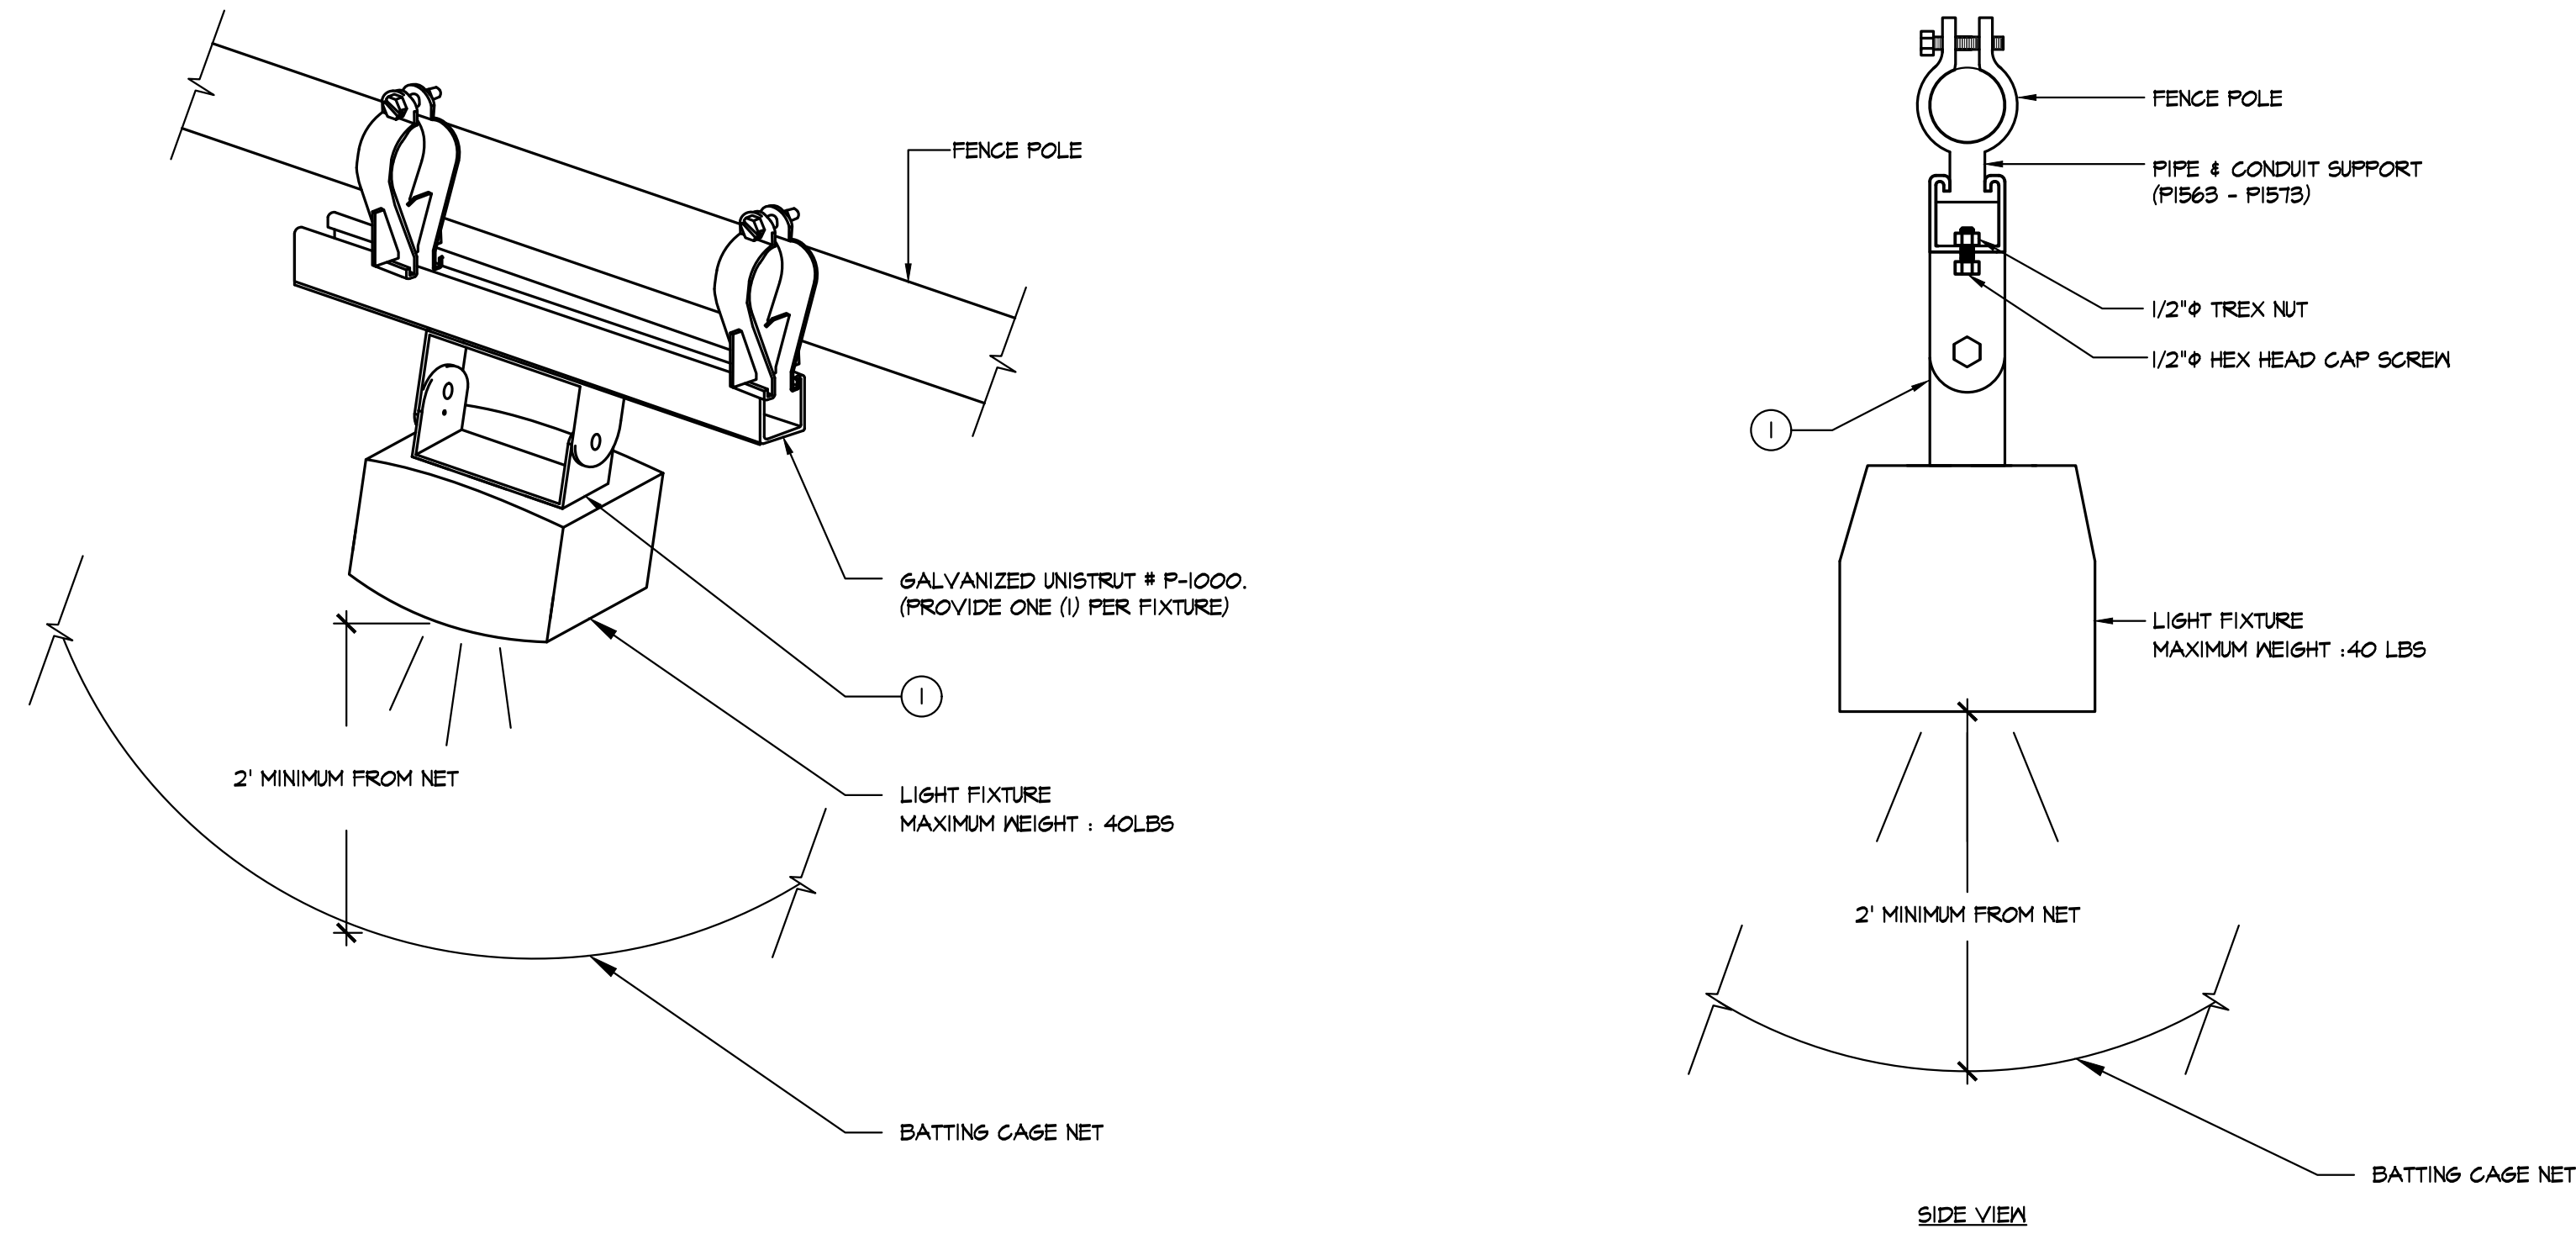


## FIXTURE MOUNTING NOTES:

1 THE G BRACKETS' ROTATION AND ANGLES OF INSTALLATION SHALL BE ADJUSTED TO MAKE THE LIGHT FIXTURE STRAIGHT OR LEVEL TO THE GROUND.

## 3 E7.3 FIXTURE MOUNTING ON BATTING CAGE


NOT TO SCALE

NOTE: FUTURE BLEACHER UNDER INCREMENT #2 OF THIS PROJECT

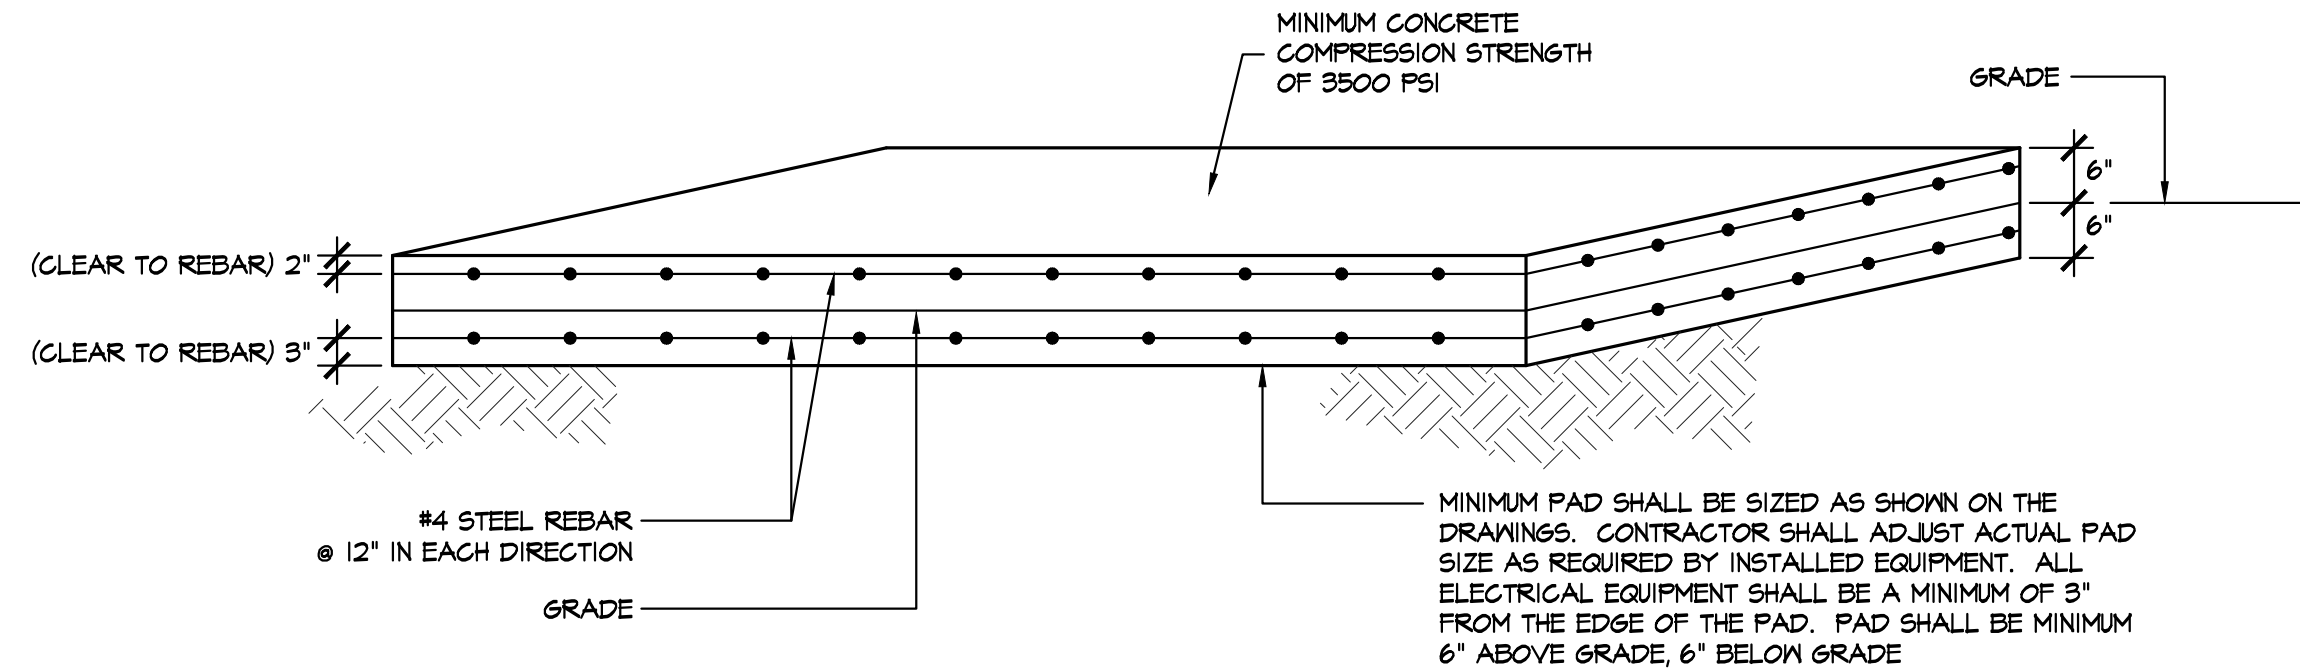

## 5 E7.3 CONCRETE ELECTRICAL EQUIPMENT PAD


NOT TO SCALE

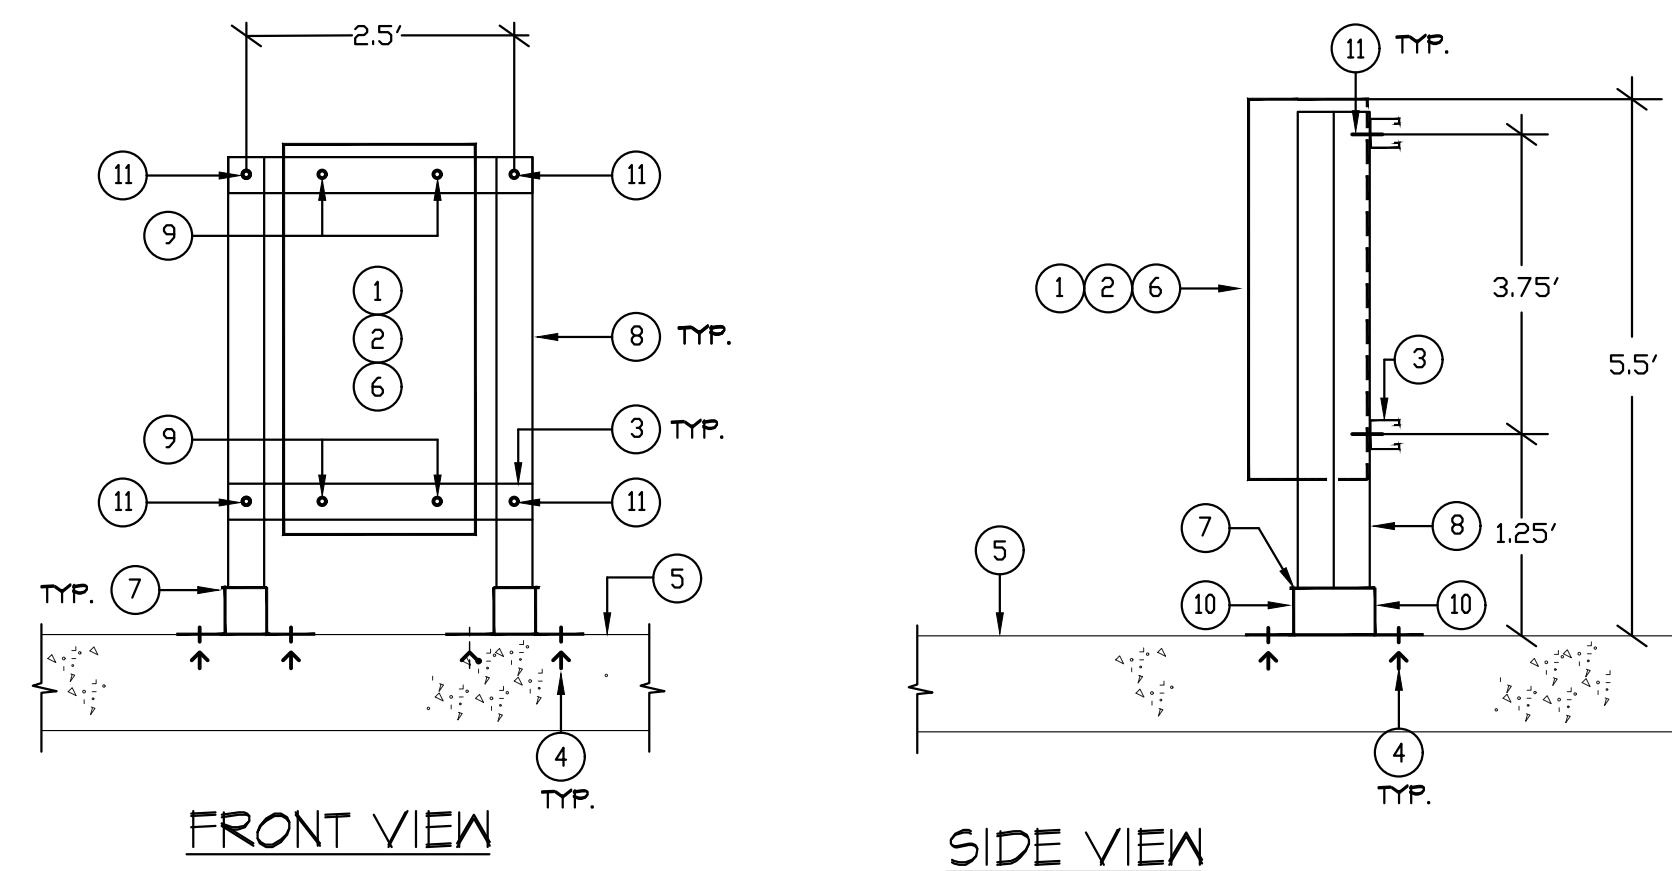

## MUSCO CONTROL PANEL INSTALLATION ON UNISTRUT DETAIL

6  
E7.3 NOT TO SCALE

- MUSCO CONTROL PANEL (MAX WEIGHT : 200 LBS.)
- LIGHTING CODE PANEL WITH 24"x30"x8" NEMA 3R ENCLOSURE. ENCLOSURE SHALL BE LOCATED.
- PROVIDE UNISTRUT P1000 MINIMUM 12 GA GALV STEEL.
- PROVIDE STAINLESS STEEL 1/2"x2-3/8" MINIMUM EMBEDMENT Kwik BOLT T2 WEDGE ANCHOR (CC-ES-ESR 1417), IN MINIMUM 2-3/8" DEEP HOLE. (4) ANCHOR BOLTS PER POST BASE.
- CONCRETE PAD. SEE 5/E1.9 FOR ADDITIONAL INFORMATION.
- DIMENSIONS OF PANEL 48"H x 24"W x 10"D
- PROVIDE UNISTRUT FLOOR SUPPORT P2073A POST BASE.
- PROVIDE DOUBLE UNISTRUT P1001 HS MINIMUM 12 GA GALV STEEL.
- PROVIDE HEX HEAD CAP SCREWS 5/8"x2" WITH HEX NUTS AND WASHERS. (4) CAP SCREWS ARE FOR ATTACHMENT OF PANEL TO REAR STRUTS.
- PROVIDE (2) 1/2" GALV BOLTS FROM P2073A POST BASE INTO VERTICAL UNISTRUT P1001. PROVIDE EACH BOLT WITH P1010 NUT INSIDE STRUT. TYPICAL FOR BOTH P2073A POST BASE.
- PROVIDE 1/2"x GALV BOLT FASTENERS AT EACH INTERSECTION.

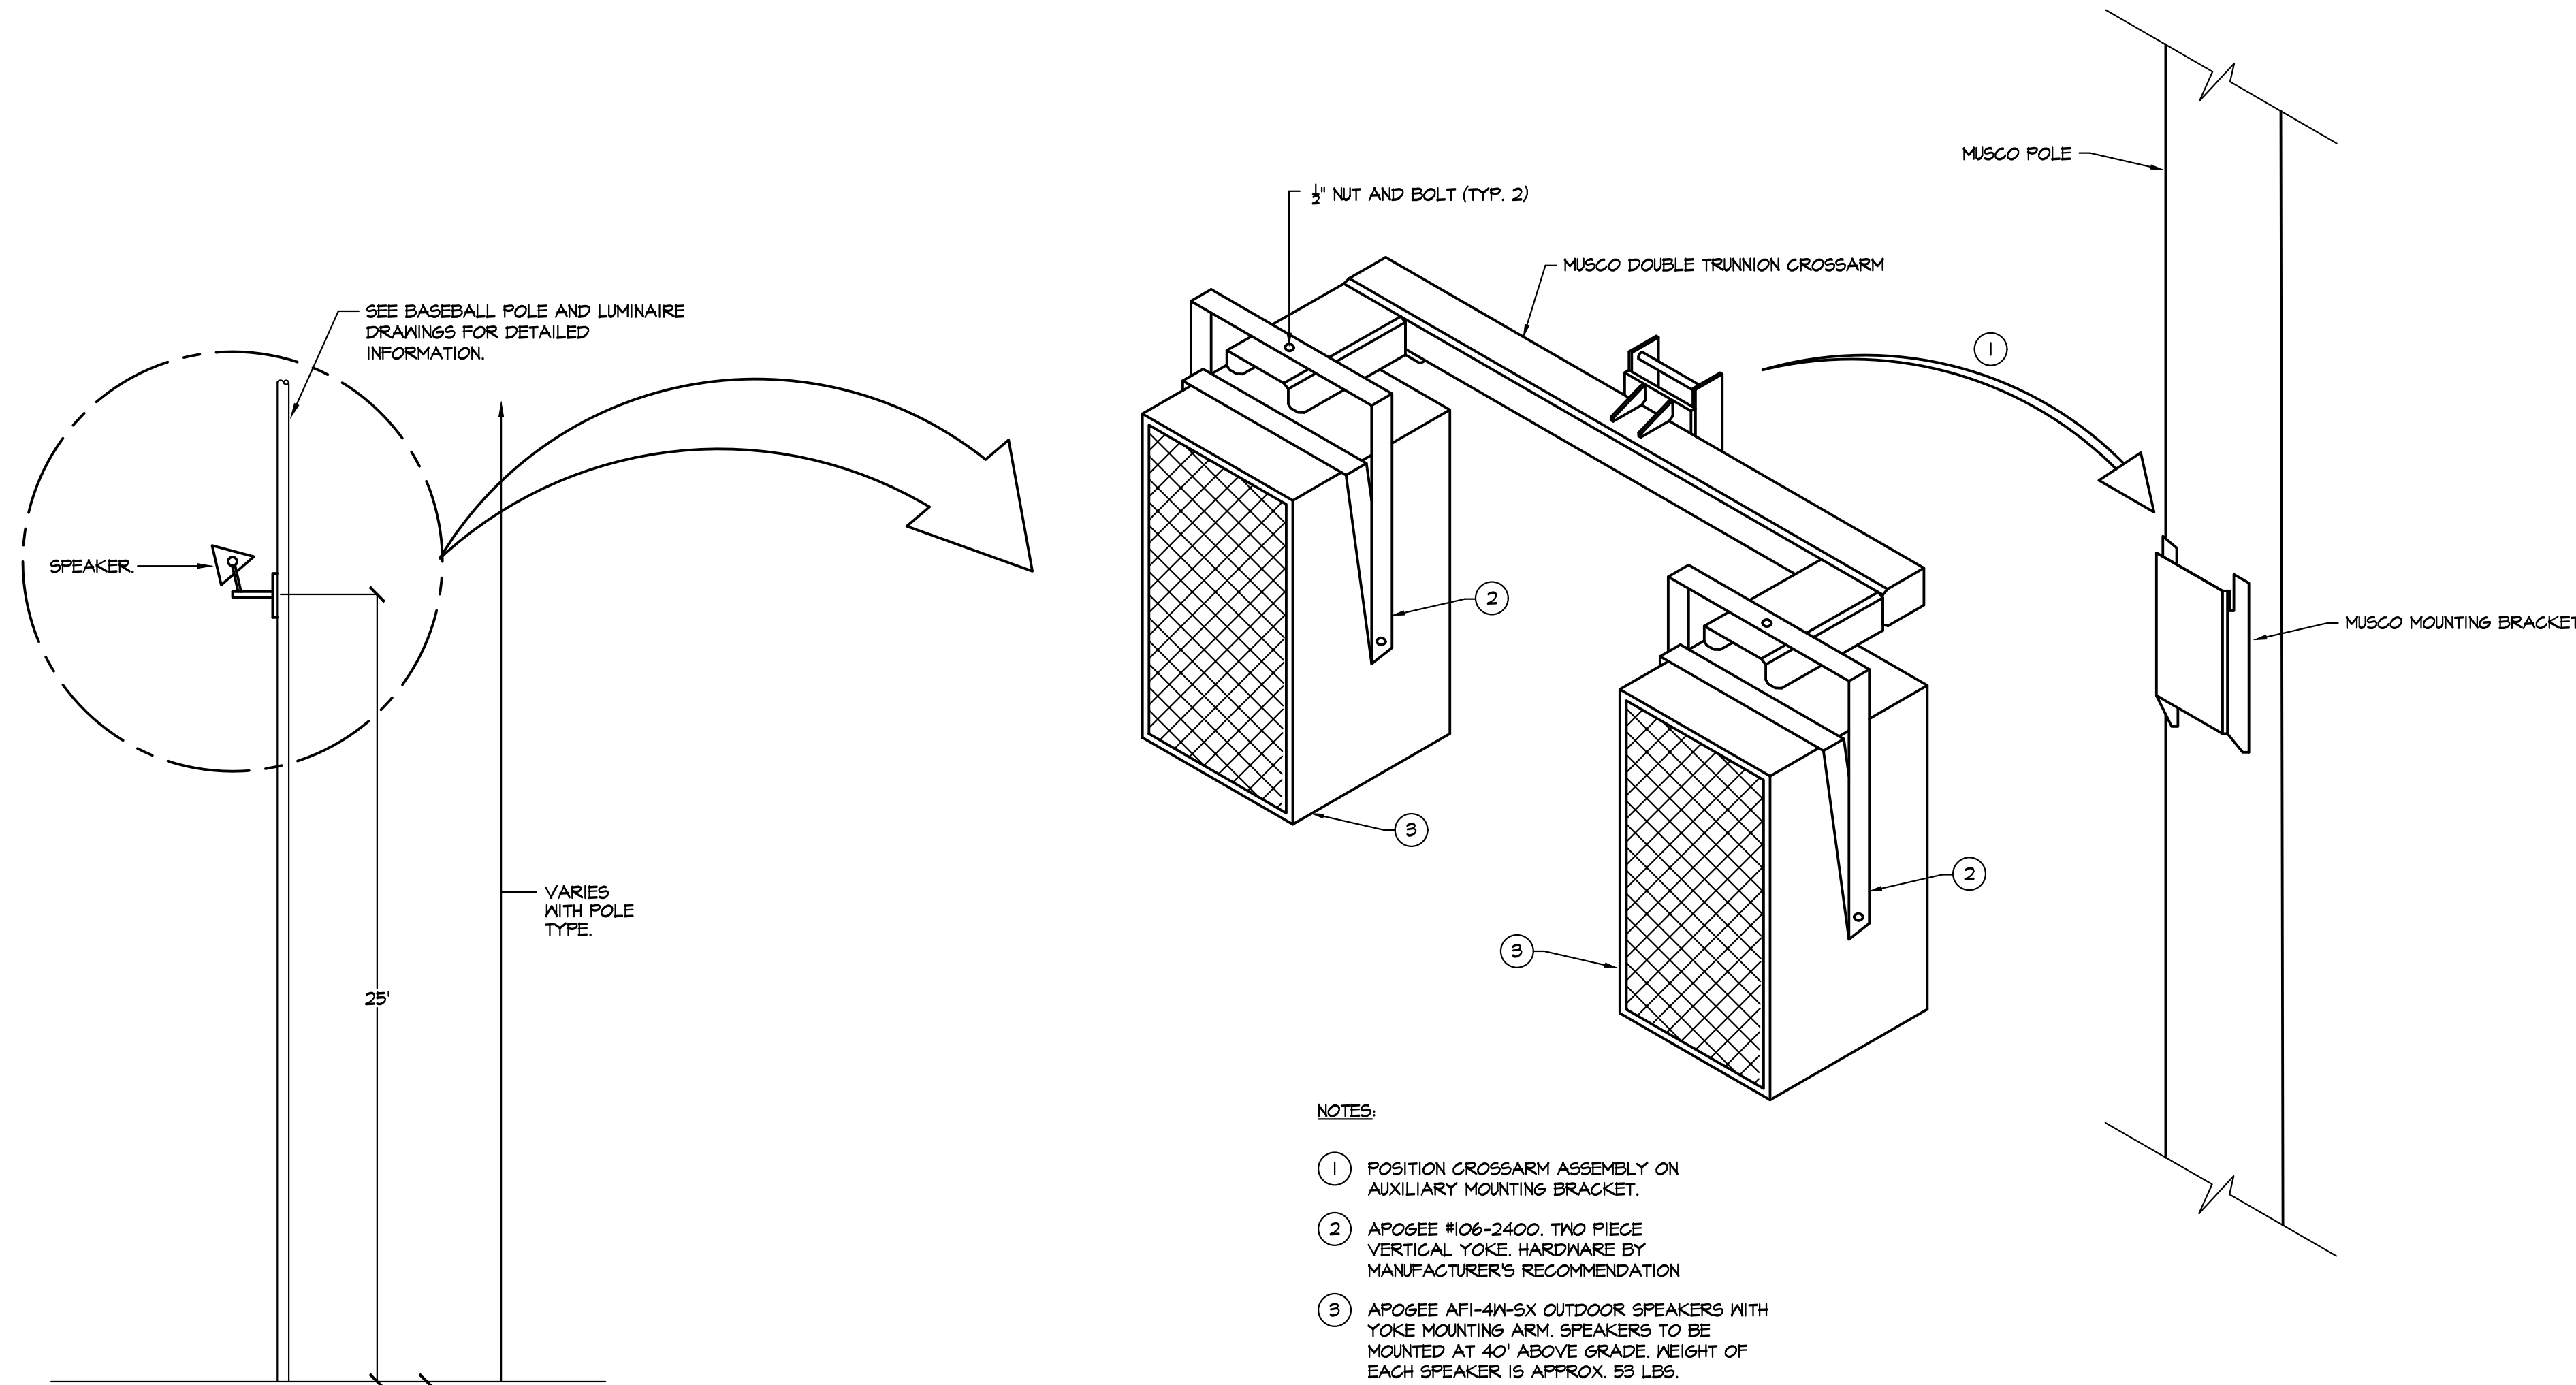

NOTES:


- POSITION CROSSARM ASSEMBLY ON AUXILIARY MOUNTING BRACKET.
- APOSEE #106-2400. TWO PIECE VERTICAL YOKE. HARDWARE BY MANUFACTURER'S RECOMMENDATION
- APOSEE AFI-4M-SX OUTDOOR SPEAKERS WITH YOKE MOUNTING ARM. SPEAKERS TO BE MOUNTED AT 40' ABOVE GRADE. HEIGHT OF EACH SPEAKER IS APPROX. 55 LBS.

## 4 E7.3 TYPICAL ELEVATION DETAIL

NOT TO SCALE



ALL DESIGN, CONSTRUCTION, AND/OR MATERIALS OF THIS PROJECT ARE THE PROPERTY OF VERDE DESIGN, INC. AND WERE CREATED, DEVELOPED, AND DISCLOSED FOR USE ON AND IN CONNECTION WITH THE SPECIFIED PROJECT. NONE OF SUCH DESIGN, CONSTRUCTION, OR MATERIALS SHALL BE USED, REPRODUCED, OR PUBLISHED BY ANY METHOD, IN WHOLE OR IN PART, OR DISCLOSED TO ANY PERSON, FIRM, OR CORPORATION FOR ANY PURPOSE WITHOUT THE WRITTEN PERMISSION OF VERDE DESIGN, INC.

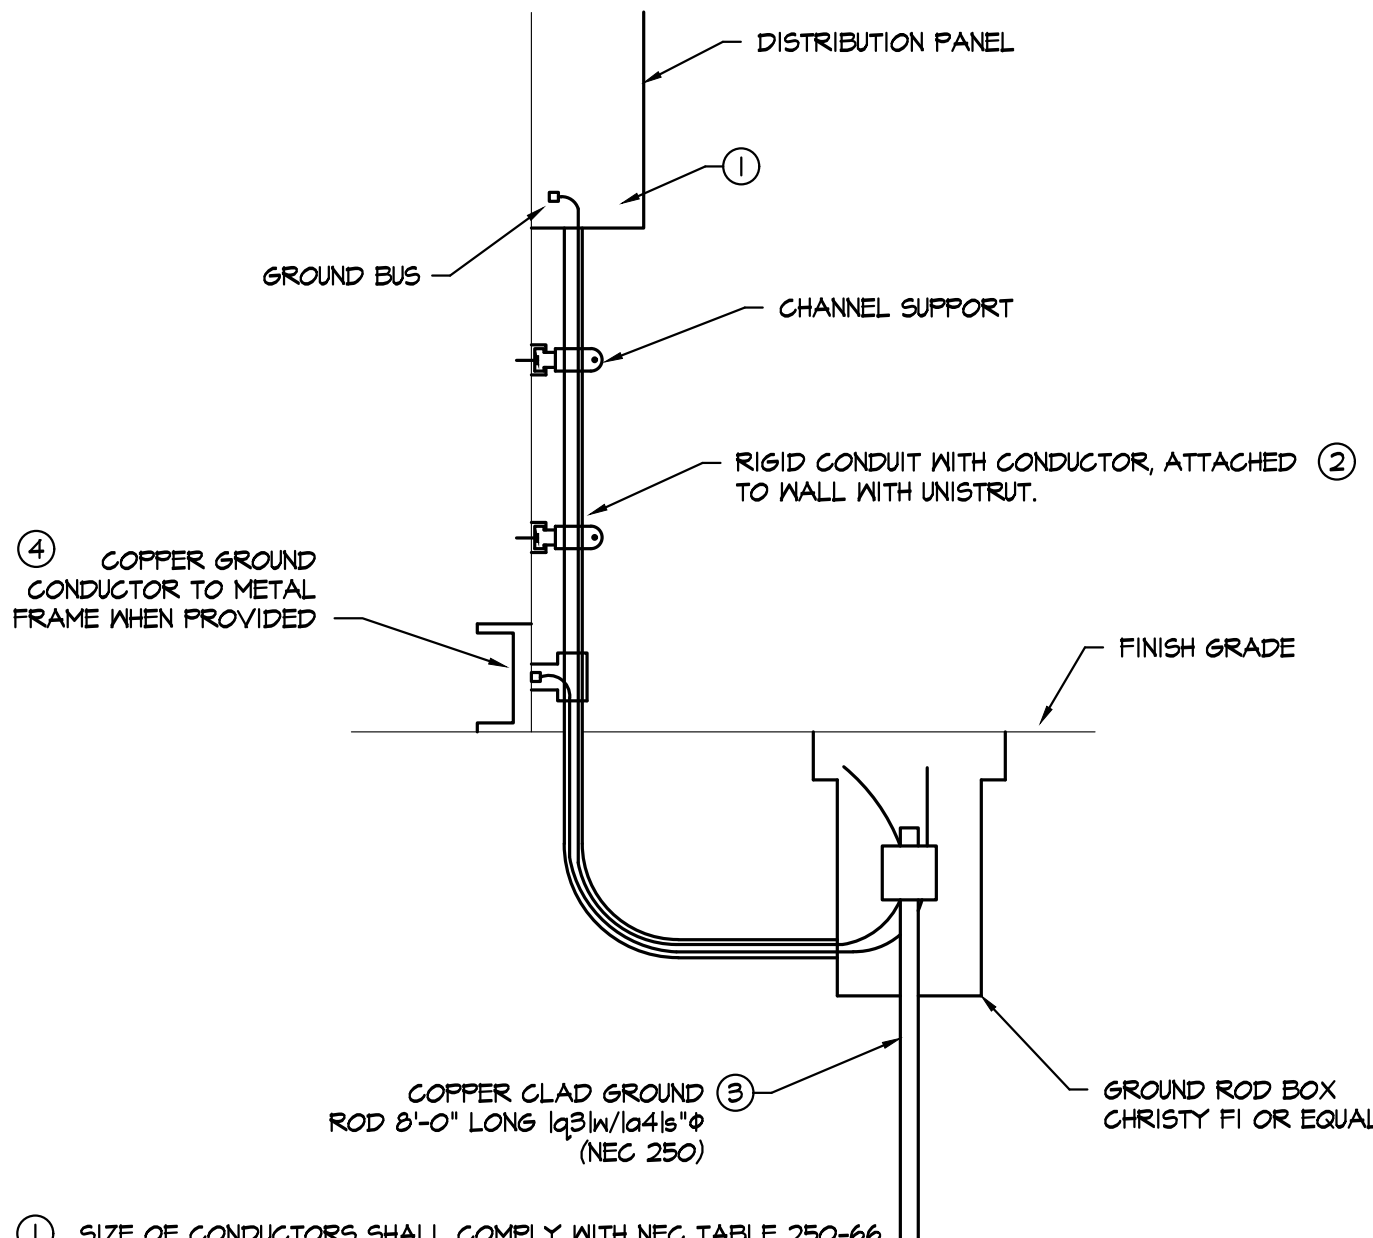


1. SIZE OF CONDUCTORS SHALL COMPLY WITH NEG TABLE 250-66
2. BOND SEPARATE CONDUCTORS FROM GROUND ROD TO ELECTRICAL PANEL AND TO METAL BUILDING FRAME (NEG 250-50). IN ADDITION TO DETAIL ABOVE, BOND THE ELECTRICAL GROUND TO NEAREST METALLIC COLD WATER PIPE. (NEG 250-50)
3. CHECK RESISTANCE TO GROUND. IF RESISTANCE EXCEEDS 25 OHMS, INSTALL ADDITIONAL GROUND RODS AS REQUIRED. (NEG 250-56)
4. ALL MODULES OF METAL FRAME BUILDINGS SHALL BE ELECTRICALLY BONDED TOGETHER. (BOLTING ONLY IS NOT ACCEPTABLE BONDING)

### 1 TYPICAL GROUND INSTALLATION

1  
E7.4 NOT TO SCALE


NOTE: GROUNDING TEST MUST BE BY INDEPENDENT LICENSED ELECTRICAL CONTRACTOR OR TESTING LABORATORY.

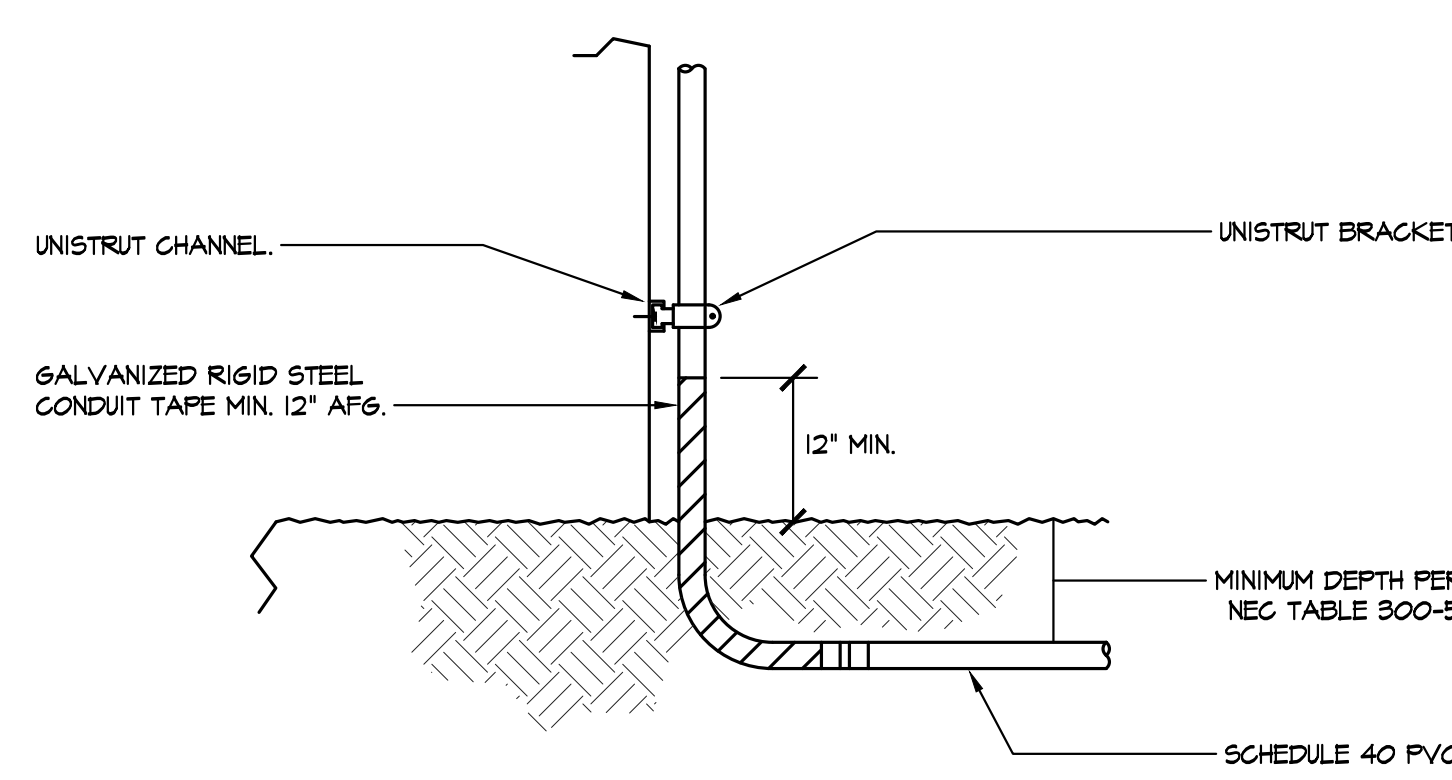

- NOTE:
1. FOR WOOD STUD WALL: USE 1/2" x 1/4" x 1/4" LAG BOLT WITH MIN. 1/2" x 1/4" x 1/4" EMBEDMENT INTO STUDS. (ONE AT EACH END OF BRACKET)
  2. FOR CONCRETE WALL: 1/2" x 1/4" x 1/4" HILTI Kwik-Bolt TZ STAINLESS STEEL ANCHOR (ICC ESR-1917) WITH MINIMUM EMBEDMENT OF 3-1/2" x 1/4" x 1/4" IN 4" DEEP HOLE. 1/2" x 1/4" x 1/4" ANCHORS SHALL BE TORQUE-TESTED TO 40 FT-LBS, WHICH MUST BE ATTAINED WITHIN ONE-HALF TURN OF NUT AFTER FIRM CONTACT WITH ANCHOR WASHER. INSTALL ANCHOR PER CBC 1918A.7 AND RECOMMENDATIONS IN MANUFACTURER'S ESR REPORT. ANCHOR INSTALLATIONS REQUIRE SPECIAL INSPECTION (TYPICAL OF (4) PER SECTION)

### 2 UNDERGROUND CONDUIT RISER DETAIL


2  
E7.4 NOT TO SCALE

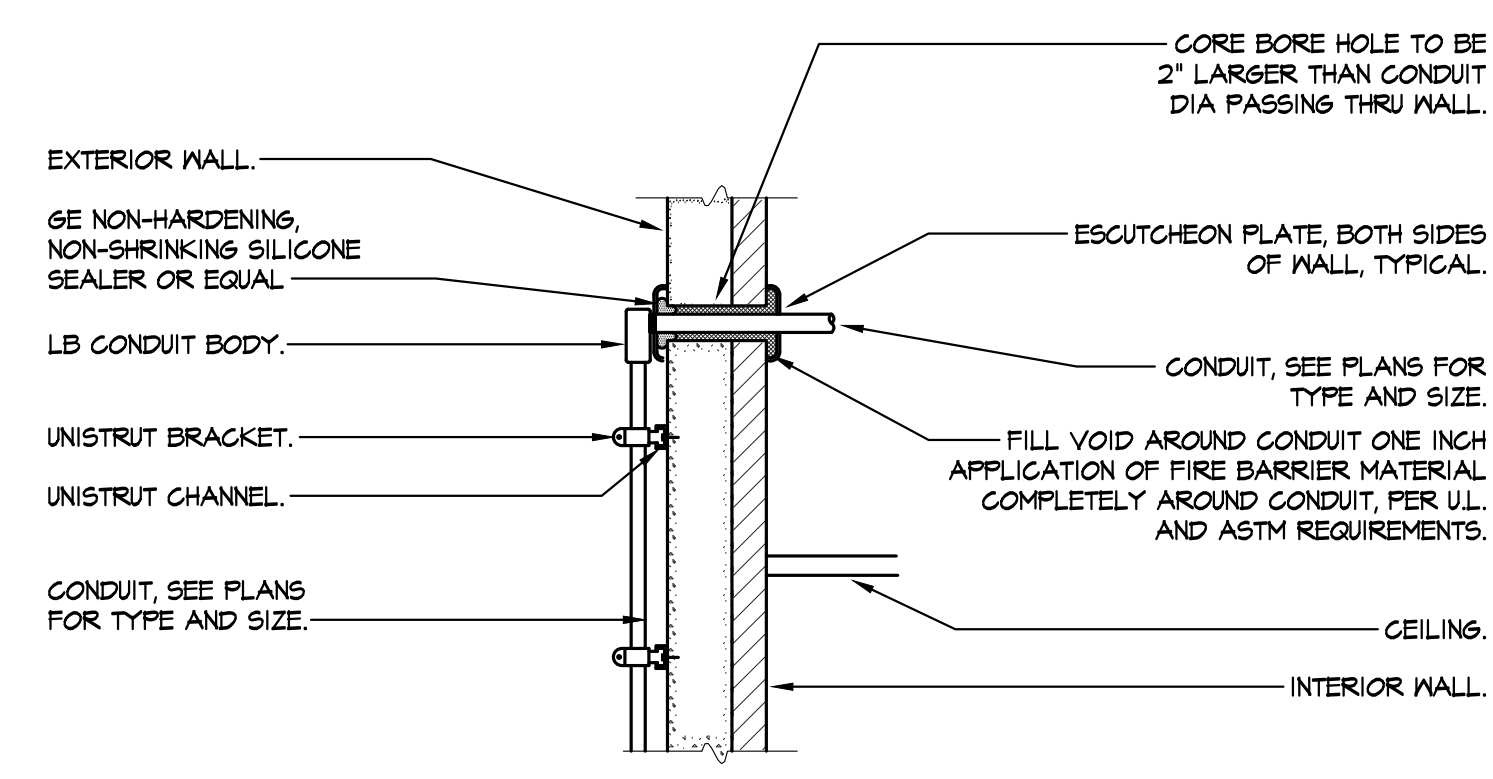

NOTE:  
PER UL FIRE RESISTANCE DIRECTORY  
SYSTEM N1002

### 3 CONDUIT WALL PENETRATION DETAIL


3  
E7.4 NOT TO SCALE

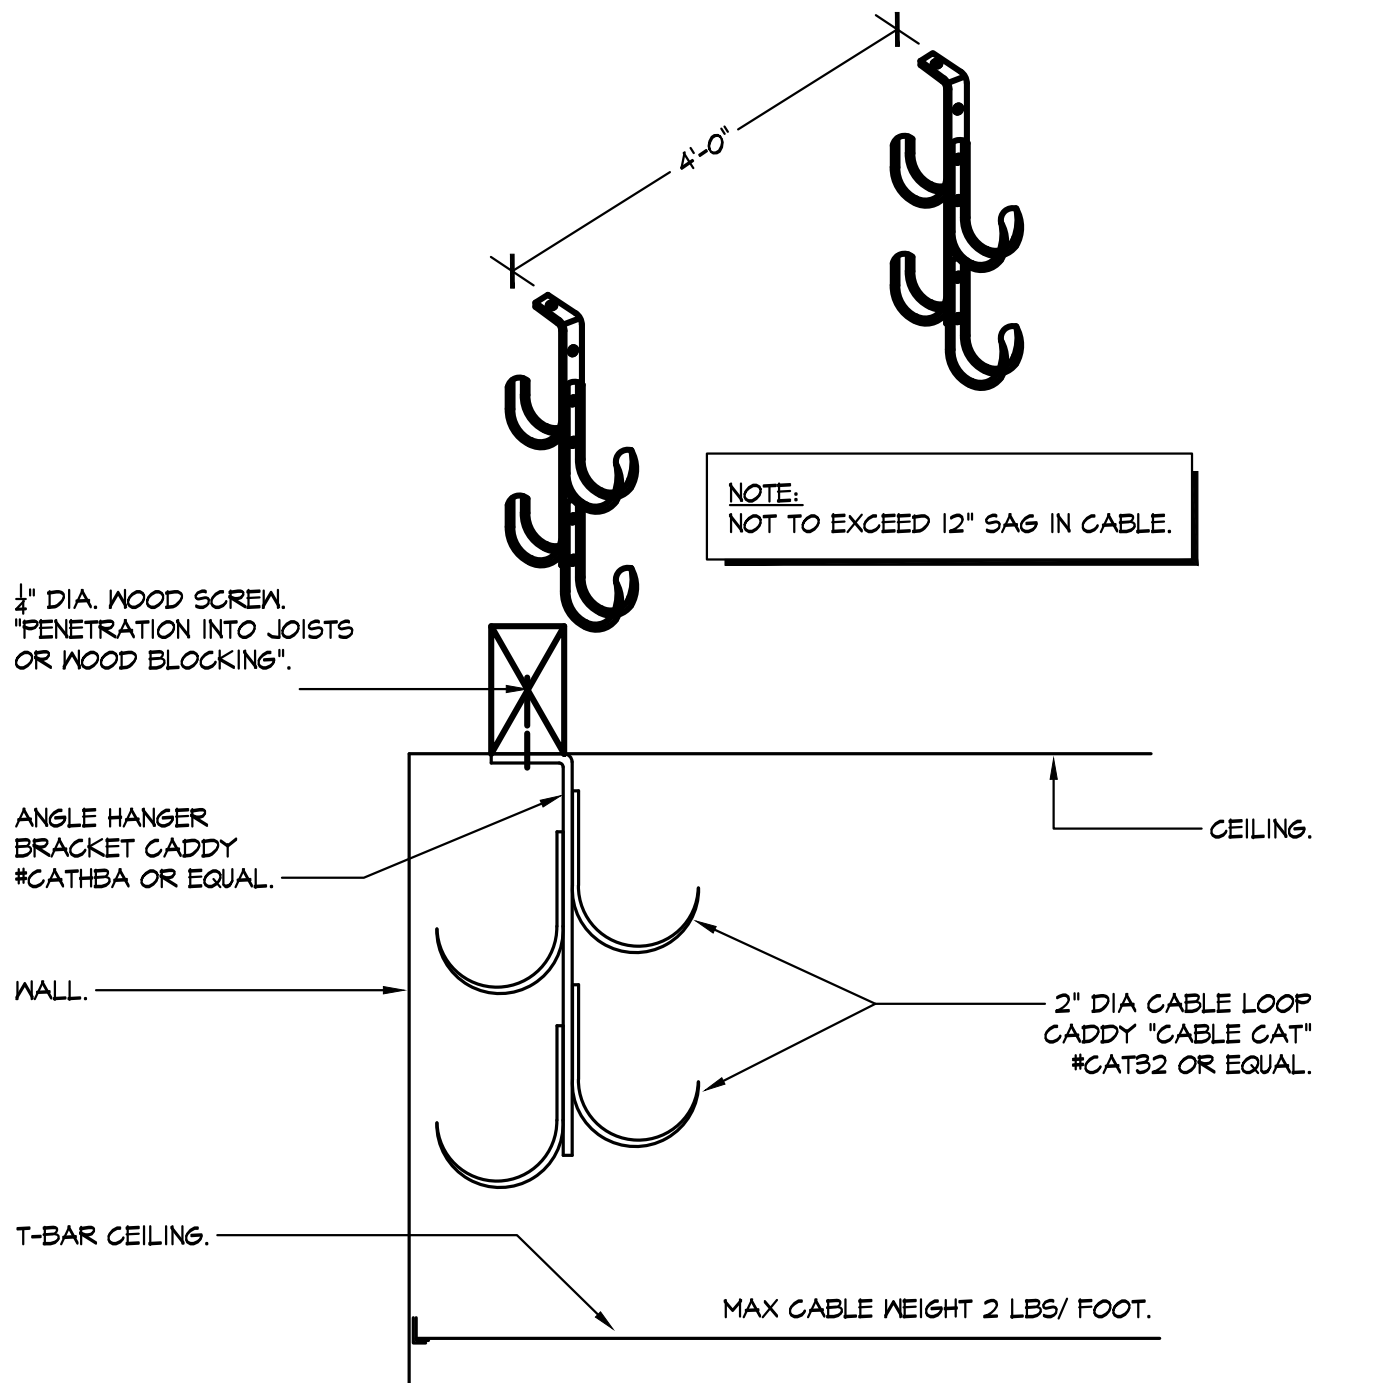

NOTE:  
EACH SYSTEM (DATA, TEL, CATV, PA/LOCK, SEC, EMS) SHALL HAVE A DEDICATED HOOK SUPPORT. NO CONDUIT THROUGH NON-ACCESSIBLE CEILING AND PENETRATION THROUGH WALL SHALL BE PROVIDED AS REQUIRED, UN.

### 4 LOW VOLTAGE CABLE SUPPORT DETAIL


4  
E7.4 NOT TO SCALE

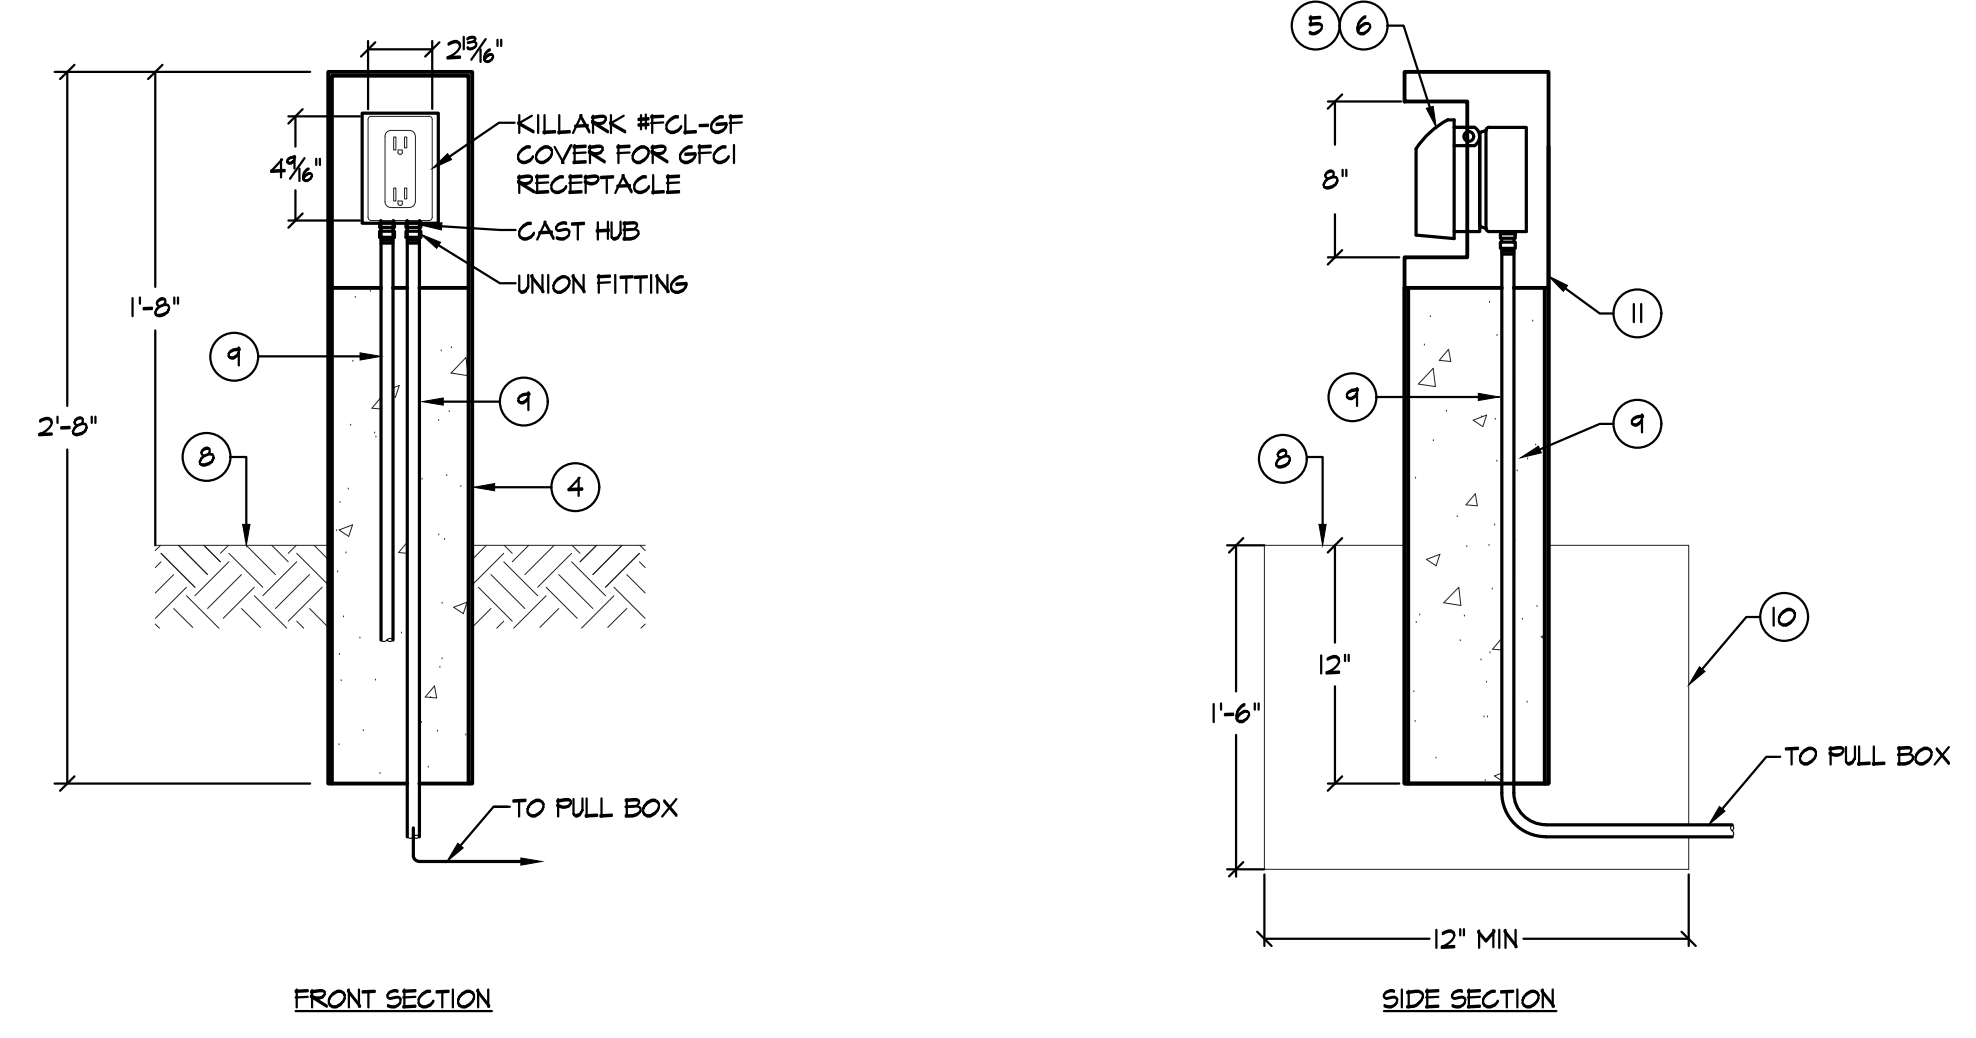

- NOTES:
1. HASER #1941 EXTRA DUTY HINGE, WELD TO TUBE.
  2. STAPLE WELD TO TUBE.
  3. 6" x 6" x 0.188" PLATE STEEL TOP, WELD, GROUND SMOOTH.
  4. 6" x 6" x 0.188" THICK WALL STEEL TUBE.
  5. 6FCI DUPLEX RECEPTACLE, FS SINGLE GANG CAST OUTLET BOX AND INTERMATIC WPI010MXD
  6. PROVIDE LABEL OF CIRCUIT NUMBER AND PANEL ON FACE OF COVER PLATE PER NEG.
  7. 1/4" DIA WEEP HOLE.
  8. FINISHED GRADE.
  9. 3/4" RSC.
  10. CONCRETE FOOTING.
  11. PAINT INTERIOR AND EXTERIOR: 1 COAT PRIME, 1 COAT FINISH PAINT OF INDUSTRIAL MAINTENANCE COATINGS M20 DTM ACRYLIC BLACK ENAMEL FINISH COAT. COORDINATE WITH ARCHITECT PAINT FINISHES.

### 5 RECEPTACLE PEDESTAL DETAIL

5  
E7.4 SCALE: NOT TO SCALE

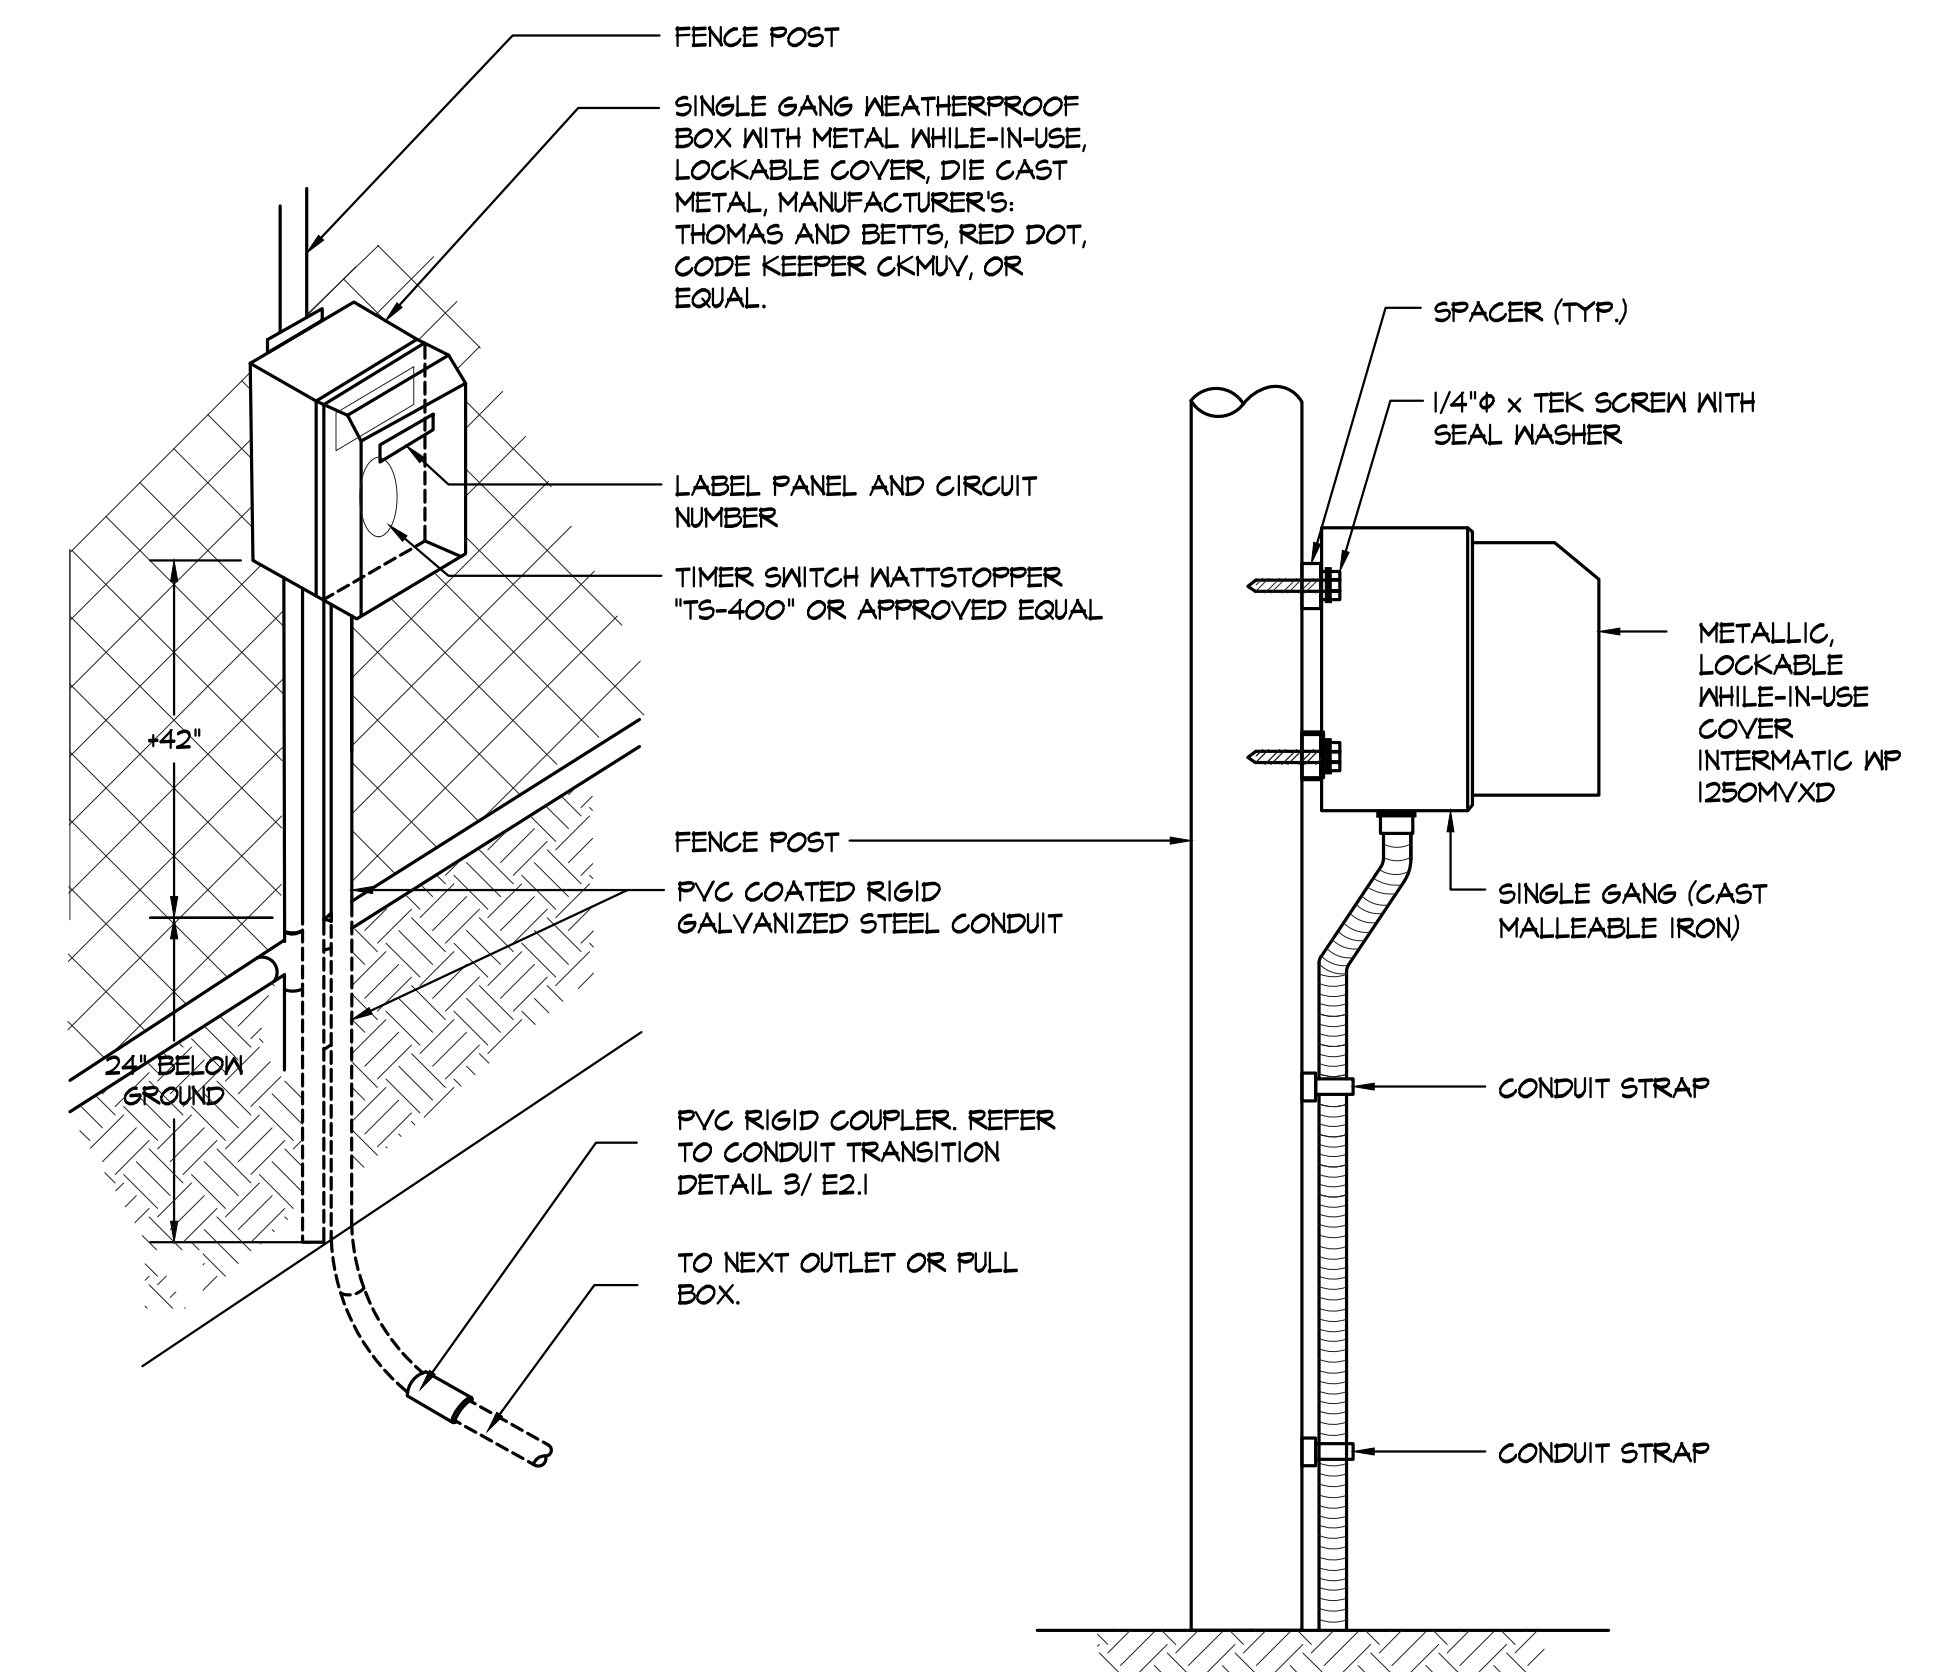

### 6 RECEPTACLE MOUNTING

6  
E7.4 NOT TO SCALE

IDENTIFICATION STAMP  
DIV. OF THE STATE ARCHITECT  
APP. 02-118017 INC.  
REVIEWED FOR  
SS ☐ FLS ☐ ACS ☐  
DATE: 04/10/2020

**VERDE DESIGN**  
LANDSCAPE ARCHITECTURE  
CIVIL ENGINEERING  
SPORT PLANNING & DESIGN  
1843 Iron Point Rd #140  
Folsom, CA 95630  
tel: 916.415.6554  
fax: 408.985.7260  
www.VerdeDesignInc.com

STAMP

CONSULTANT  
  
American Consulting Engineers  
Electrical, Inc.  
1950 The Armada, Suite 200  
San Jose, CA 95131  
JOB # E19148-00 Fax 408/284-1314

KEYMAP

### ELECTRICAL DETAILS

PROJECT NAME  
**CHAVEZ HIGH SCHOOL  
STOCKTON USD  
ATHLETIC FACILITY  
IMPROVEMENTS**

PROJECT ADDRESS  
**2929 WINDFLOWER LN  
STOCKTON, CA 95212**

| SUBMITTAL               | DATE     |
|-------------------------|----------|
| DD/50% SUBMITTAL        | 10/25/19 |
| DSA SUBMITTAL           | 12/20/19 |
| DSA BACKCHECK SUBMITTAL | 03/27/20 |

| NO. | REVISIONS | DATE |
|-----|-----------|------|
| 1   |           |      |
| 2   |           |      |
| 3   |           |      |
| 4   |           |      |
| 5   |           |      |
| 6   |           |      |

DRAWN BY  
MG

CHECKED BY  
SB/ SF

DATE ISSUED  
03/27/20

SCALE

PROJ. NO.  
1910900-1211

SHEET NO.  
**E7.4** OF #

**ELECTRICAL DETAILS**



ALL DESIGN, CONSTRUCTION, AND FINISH DETAILS OF IMPROVEMENTS OF CHAVEZ HS ARE OWNED BY AND THE PROPERTY OF VERDE DESIGN, INC. AND WERE CREATED, DEVELOPED, AND DEVELOPED FOR USE ON AND IN CONNECTION WITH THE SPECIFIED PROJECT. NONE OF SUCH IDEAS, DESIGNS, ARRANGEMENTS OR PLANS SHALL BE USED, REPRODUCED, OR PUBLISHED IN WHOLE OR IN PART, OR DISCLOSED TO ANY PERSON, FIRM, OR CORPORATION FOR ANY PURPOSE WITHOUT WRITTEN PERMISSION OF VERDE DESIGN, INC.

PUBLIC SCHOOL  
FIRE ALARM SYSTEM  
GENERAL NOTES:

- 1
- THE FIRE ALARM SYSTEM SHALL CONFORM TO ARTICLE 160, CA ELEC. CODE. WIRING MUST BE LISTED FOR USE AS REQUIRED BY TITLE 24/CEC, ARTICLE 160. MINIMUM WIRE SHALL BE TWO (2) #16 AWG FOR INITIATING CIRCUITS AND TWO (2) #12 AWG FOR INDICATING CIRCUITS.
- 2
- WIRE USED IN WET LOCATIONS SHALL BE OF AN APPROVED TYPE IN ACCORDANCE WITH 3-910-8, T24/CEC (I.e. THHN OR EQUAL).
- 3
- UNDER GROUND AND EXTERIOR CONDUITS TO HAVE WATERTIGHT FITTINGS AND WIRES APPROVED FOR WET LOCATION.
- 4
- ALL CONDUCTORS SHALL BE ROUTED IN CONDUIT UNLESS SPECIFICALLY NOTED OTHERWISE ON PLANS. MINIMUM CONDUIT SIZE SHALL BE 3/4."
- 5
- THE CONDUIT AND WIRE SHOWN ON THESE PLANS ARE SHOWN DIAGRAMMATICALLY. EXACT LOCATIONS SHALL BE DETERMINED IN THE FIELD TO SUIT FIELD CONDITIONS. "AS-BUILT" PLANS SHALL BE MAINTAINED AND BE PROVIDED AS REQUIRED BY THE PROJECT INSPECTOR OF RECORD.
- 6
- PENETRATIONS OF FIRE RATED WALLS SHALL BE PROTECTED IN ACCORDANCE WITH CALIFORNIA BUILDING CODE, CHAPTER 7, TITLE 24.
- 7
- ALL DEVICES SHALL BE "CSFM" LISTED.
- 8
- EXTERIOR DEVICES SHALL BE LISTED FOR EXTERIOR USE BY "CSFM."
- 9
- AUDIBLE ALARM PRODUCED BY THE FIRE ALARM SYSTEM SHALL BE CAPABLE OF PRODUCING A DISTINCTIVE THREE-PULSE TEMPORAL PATTERN FIRE ALARM EVACUATION SIGNAL.
- 10
- AUDIBLE DEVICES TO BE AT LEAST 15 dBA ABOVE THE EQUIVALENT SOUND LEVEL BUT NOT LESS THAN 75 dBA AT 10 FEET OR MORE THAN 110 dBA IN TOTAL, &OUTTHROUGHOUT&.
- 11
- WHERE VISUAL DEVICES ARE REQUIRED, VISUAL DEVICE SHOULD NOT EXCEED 2 FLASHES PER SECOND AND SHOULD NOT BE SLOWER THAN 1 FLASH EVERY SECOND. THE DEVICE SHALL HAVE A PULSING LIGHT SOURCE NOT LESS THAN 15 CANDELA. NO PLACE IN ANY ROOM SHALL BE MORE THAN 30 FEET FROM A DEVICE.
- 12
- CONTRACTOR SHALL PROVIDE COPIES OF APPROVED PLANS TO THE PROJECT INSPECTOR OF RECORD PRIOR TO BEGINNING WORK. THE CONTRACTOR SHALL SUBMIT SUBMITTAL BOOKLET TO ENGINEER PRIOR TO PURCHASE FOR REVIEW. THE FIRE PROTECTION SYSTEM SHALL NOT BE INSTALLED UNTIL SUBMITTAL BOOKLETS HAVE BEEN SUBMITTED TO AND APPROVED BY THE ENGINEER OF RECORD.
- 13
- FINAL TEST SHALL BE MADE WITH DSA INSPECTOR OF RECORD (IOR), LOCAL FIRE AUTHORITY HAVING JURISDICTION SHALL BE NOTIFIED OF DATE AND TIME OF FIRE ALARM TESTING AND SHALL ASSIST/WITNESS SUCH TESTING WHEN ABLE. CONTRACTOR SHALL REPEAT TESTING AS NECESSARY UNTIL SATISFACTORY RESULTS ARE ACHIEVED.
- 14
- FIRE ALARM CONTRACTOR SHALL PROVIDE A "RECORD OF COMPLETION" TO THE INSPECTOR OF RECORD (IOR)/DSA AFTER COMPLETION OF OPERATIONAL ACCEPTANCE TESTS.
- 15
- POWER SERVICE SHALL BE ON A DEDICATED BRANCH CIRCUIT WITH A RED MARKING AND IDENTIFIED AS "FIRE ALARM CIRCUIT CONTROL."
- 16
- ALL ALARM SIGNALS ARE TO BE TRANSMITTED TO AN APPROVED & LISTED SUPERVISING STATION AND SHALL COMPLY WITH SB 575 POLICY. FINAL TEST SHALL INCLUDE ALL INFO PER NFPA 72 - 14.6.2.4 READ OUT VERIFICATION FORM FROM CENTER STATION.
- 17
- THE MAXIMUM SPACING OF SMOKE AND HEAT DETECTORS SHALL BE 30 FEET OF SEPARATION. IN THE EVENT AN ACCESSIBLE CEILING SPACE IS DISCOVERED DURING THE COURSE OF THE PROJECT, THE CONTRACTOR SHALL PROVIDE ADDITIONAL HEAT DETECTORS.
- 18
- PROJECT INSPECTOR SHALL FIELD VERIFY CANDELA SETTING ON STROBES DUE TO FIELD ADJUSTABILITY.
- 19
- EACH SIGNALING LINE CIRCUIT FOR FACP IS CAPABLE OF SERVING 154 DETECTORS AND 154 MODULES.
- 20
- PROVIDE A PERMANENT SIGN ON THE EXTERIOR DOOR STATING "FIRE ALARM PANEL" FOR ALL ROOMS WITH REMOTE POWER SUPPLIES OR FACPS. CONTRACTOR TO PROVIDE FABRICATED NAMEPLATE SIGN, PROVIDE AND OBTAIN APPROVED STANDARDS FROM DISTRICT. PROVIDE SUBMITTALS FOR ARCHITECTS APPROVAL.
- 21
- PROJECT INSPECTOR SHALL VERIFY THAT THERE ARE NO ACCESSIBLE CEILING SPACES FOR THE ROOMS IN THE SCOPE OF WORK.

PROJECT DESCRIPTION:

1.
- OCCUPANCY: E, A5, HIGH SCHOOL ATHLETIC FIELD.
2.
- TYPE OF SYSTEM: (N) FULLY AUTOMATIC FIRE ALARM SYSTEM FOR (N) STADIUM PRESSBOX PORTABLE BUILDINGS AND CONCESSION/RESTROOM PORTABLE BUILDINGS. UL CERTIFIED CENTRAL STATION MONITORING.
3.
- SCOPE OF WORK: PROVIDE NEW STAND ALONE FIRE ALARM CONTROL PANEL AND FIRE ALARM FIELD DEVICES FOR (N) STADIUM PRESSBOX AND CONCESSION/RESTROOM PORTABLE BUILDINGS. TELEPHONE WILL BE AVAILABLE AS A MEANS OF COMMUNICATION.
4.
- FIRE ALARM SYSTEM SIGNALING LINE CIRCUIT IS CLASS B, STYLE 4. INITIATION DEVICE CIRCUIT IS CLASS B, STYLE B. NOTIFICATION CIRCUIT IS CLASS B, STYLE Y.

APPLICABLE FIRE ALARM  
CODES, STANDARDS AND GUIDES:

CODES:

1.
- 2016 CALIFORNIA BUILDING STANDARDS ADMINISTRATIVE CODE, PART 1, TITLE 24 C.C.R.
2.
- 2016 CALIFORNIA BUILDING CODE (CBC), PART 2, TITLE 24 C.C.R.
3.
- 2016 CALIFORNIA ELECTRICAL CODE (CEC), PART 3, TITLE 24 C.C.R.
4.
- 2016 CALIFORNIA MECHANICAL CODE (CMC), PART 4, TITLE 24 C.C.R.
5.
- 2016 CALIFORNIA PLUMBING CODE (CPC), PART 5, TITLE 24 C.C.R.
6.
- 2016 CALIFORNIA ENERGY CODE.
7.
- 2016 CALIFORNIA FIRE CODE.
8.
- TITLE 19 C.C.R., PUBLIC SAFETY, STATE FIRE MARSHAL REGULATIONS.

STANDARDS AND GUIDES:

1.
- NFPA 72, NATIONAL FIRE ALARM CODE, 2016 EDITION WITH CALIFORNIA AMENDMENTS.

SYMBOL LIST:

- 1

FM

201

1

PLAN, DETAIL OR SECTION DESIGNATION.

ROOM NUMBER.

SHEET REFERENCE SYMBOL - SEE ASSOCIATED NOTE ON SAME SHEET.

WIRING & CONDUIT RUN SYMBOLS

CONDUIT - CONCEALED IN WALLS OR CEILING.

CONDUIT - EXPOSED.

CONDUIT - IN OR BELOW FLOOR. 3/4" MIN.

NO

CONDUIT - HOME RUN TO PANEL, TERMINAL CABINET, ETC. RUNS MARKED WITH CROSSSHATCHES INDICATE NUMBER OF #12 AWG WIRES. CROSSSHATCH WITH SUBSCRIPT "6" INDICATES GREEN GROUND WIRE. SIZE CONDUIT ACCORDING TO SPECIFICATIONS AND APPLICABLE CODE. CROSSSHATCHES WITH "10" INDICATES WIRE SIZE OTHER THAN #12'S.

FLEX CONDUIT WITH CONNECTION.

CONDUIT - STUB UP.

CONDUIT - STUB DOWN.

CAPPED CONDUIT.

CONDUIT CONTINUATION.

POWER DISTRIBUTION SINGLE LINE SYMBOLS

CIRCUIT BREAKER.

FA EQUIPMENT DEVICE

END OF LINE RESISTOR

FIRE ALARM CABLE SCHEDULE:

A - (2) #12 FOR NOTIFICATION APPLIANCE CIRCUITS (NAC)

B - (1) #14 UNSHEILED TWISTED PAIR FOR SIGNALING LINE CIRCUITS (SLC)

EQUIPMENT SCHEDULE:

|      |   |
|------|---|
| 15cd | FIRE ALARM: HORN/STROBE 15 CANDELA<br>MODEL: 6E (EDWARDS SYSTEM TECHNOLOGY) 6HRF-VM (GENESIS)<br>CSFM: 1125-1651.218                |
| 30cd | FIRE ALARM: HORN/STROBE 30 CANDELA<br>MODEL: 6E (EDWARDS SYSTEM TECHNOLOGY) 6HRF-VM (GENESIS)<br>CSFM: 1125-1651.218                |
| 10A  | FIRE ALARM: ATTIC HEAT DETECTOR WITH BASE (184")<br>MODEL: 6E (EDWARDS SYSTEM TECHNOLOGY) 282B-PL<br>CSFM: 1210-1651.104            |
| 10   | FIRE ALARM: SMOKE DETECTOR WITH BASE<br>MODEL: 6E (EDWARDS SYSTEM TECHNOLOGY) 516A-PS<br>CSFM: 1212-1651.126                        |
| M    | FIRE ALARM: MONITOR MODULE<br>MODEL: 6E (EDWARDS SYSTEM TECHNOLOGY) 516A-CTHT<br>CSFM: 1300-1651.121                                |
| 61M  | FIRE ALARM: SYNC MODULE<br>MODEL: 6E (EDWARDS SYSTEM TECHNOLOGY) 1064<br>CSFM: 1165-1651.244  |
| FACP | (E) FIRE ALARM: FIRE ALARM CONTROL PANE IV SA-DACT OPTION CARD<br>MODEL: 6E (EDWARDS SYSTEM TECHNOLOGY) 1064<br>CSFM: 1165-1651.244 |
| RPS  | FIRE ALARM: FIRE ALARM REMOTE POWER SUPPLY<br>MODEL: 6E MIREP66A<br>CSFM: 1300-1651.229   |

| FIRE ALARM SYSTEM OPERATIONAL MATRIX             |        |        |        |        |        |        |        |        |        |        |        |        |        |        |        |         |
|--|--------|--------|--------|--------|--------|--------|--------|--------|--------|--------|--------|--------|--------|--------|--------|---------|
| CAUSE  | EFFECT | EFFECT | EFFECT | EFFECT | EFFECT | EFFECT | EFFECT | EFFECT | EFFECT | EFFECT | EFFECT | EFFECT | EFFECT | EFFECT | EFFECT | REMARKS |
|  |        |        |        |        |        |        |        |        |        |        |        |        |        |        |        |         |
| MANUAL PULL STATIONS                             | *      | *      | *      | *      | *      | *      | *      | *      | *      | *      | *      | *      | *      | *      | *      |         |
| SMOKE DETECTORS                                  | *      | *      | *      | *      | *      | *      | *      | *      | *      | *      | *      | *      | *      | *      | *      |         |
| HEAT DETECTORS                                   | *      | *      | *      | *      | *      | *      | *      | *      | *      | *      | *      | *      | *      | *      | *      |         |
| ATTIC HEAT DETECTORS                             | *      | *      | *      | *      | *      | *      | *      | *      | *      | *      | *      | *      | *      | *      | *      |         |
| AC POWER FAILURE                                 |        |        |        |        |        | *      |        |        | *      |        |        |        |        |        |        |         |
| SIGNAL SILENCE                                   |        |        |        |        |        |        |        |        |        |        | *      | *      | *      | *      | *      |         |
| SYSTEM RESET                                     |        |        |        |        |        |        |        |        |        |        |        |        |        |        |        |         |
| FIRE ALARM TROUBLE (OPEN, SHORTS, OR GROUNDS) ON |        |        |        |        | *      | *      |        |        |        |        |        |        |        |        |        |         |

| DRAWING INDEX |  |
|---------------|--|
| SHEET NO.     | SHEET TITLE                                      |
| FA0.1         | FIRE ALARM SYMBOLS, NOTES AND EQUIPMENT SCHEDULE |
| FA1.1         | FIRE ALARM SITE PLAN - NEW                       |
| FA2.1         | ENLARGED BASEBALL FIELD FIRE ALARM NEW SITE PLAN |
| FA2.2         | FIRE ALARM FLOOR PLAN CONCESSION/STORAGE         |
| FA3.1         | FIRE ALARM RISER DIAGRAM                         |
| FA4.1         | FIRE ALARM DETAILS                               |


DRAWING NAME: L:\projects\Year 2019\19146 Chavez HS Additional Athletic Improvement\ATHLETIC FACILITY\FA0.1\_FA Cover Sheet.dwg  
PLOT DATE: 03-27-20 PLOTTED BY: sbuhay

FIRE ALARM SYMBOLS, NOTES AND EQUIPMENT SCHEDULE



[illegible]

|           |              |
|-----------|--------------|
| PROJ. NO. | 1910900-1211 |
|-----------|--------------|

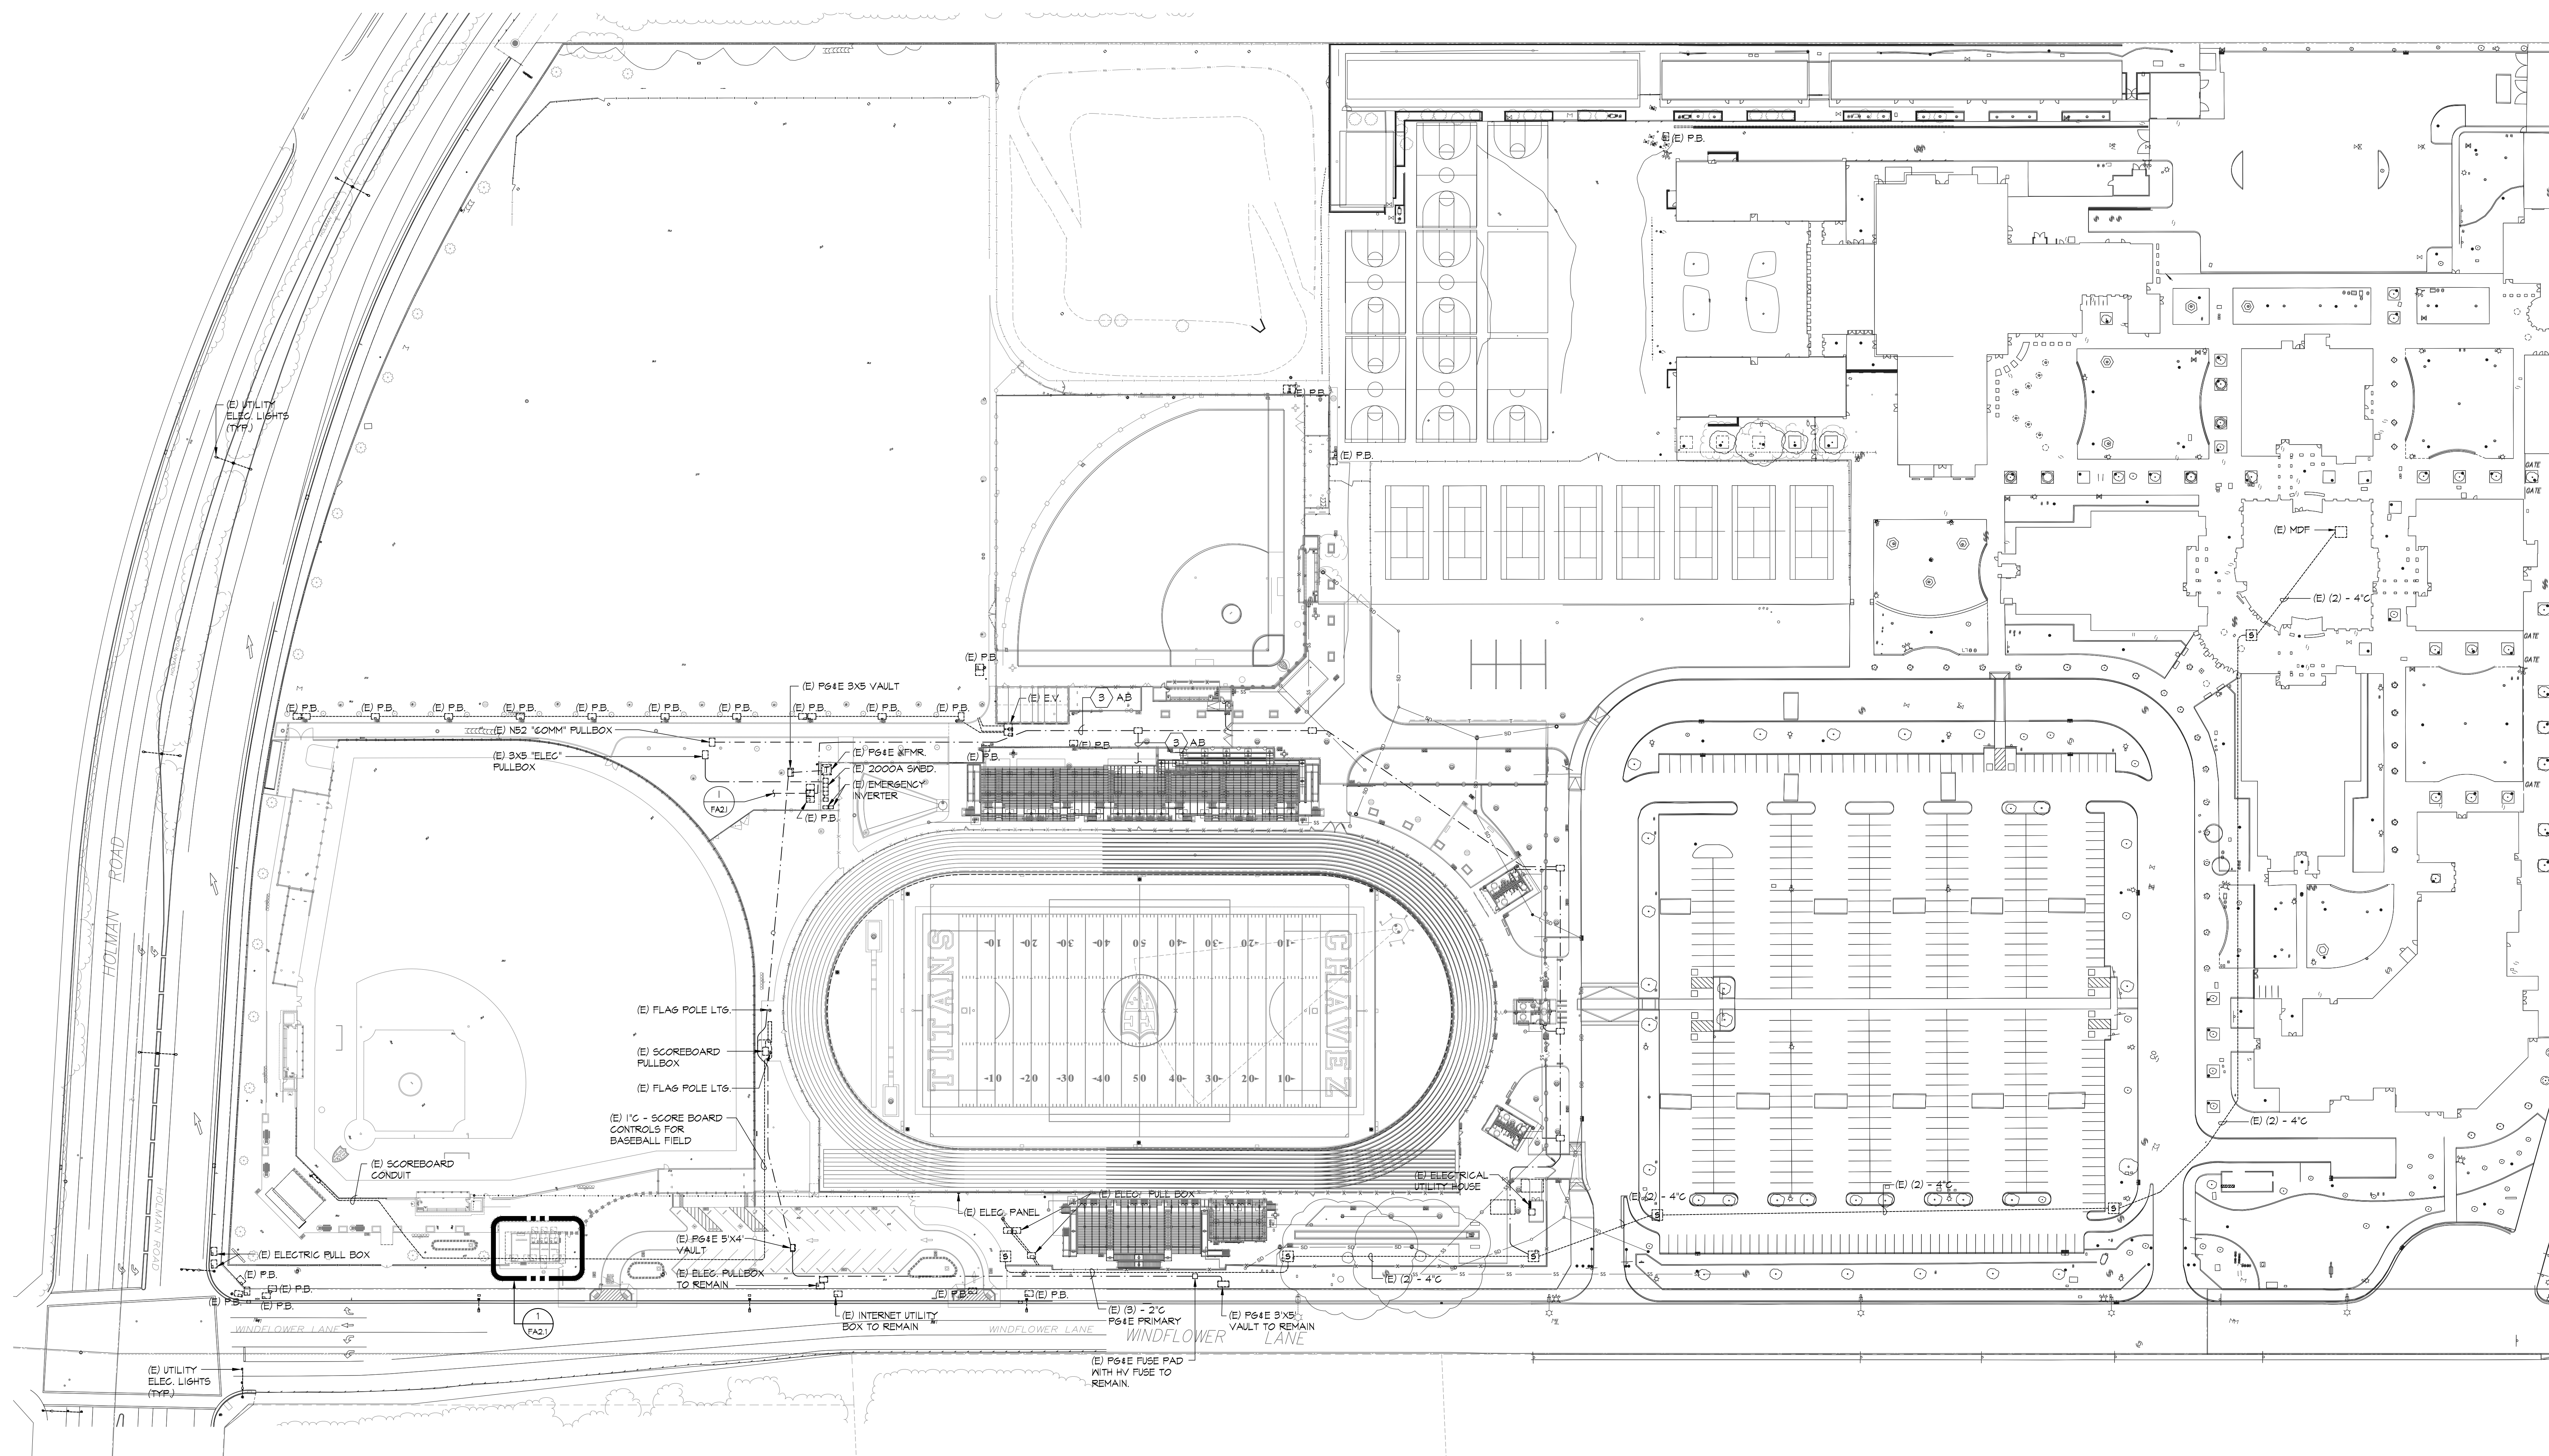

# FIRE ALARM SITE PLAN - NEW

FA1.1 SCALE: 1" = 60'-0"

## GENERAL NOTES:

1. ALL FIRE ALARM CABLING SHALL BE NEW.
2. SEE FIRE ALARM DRAWINGS FOR ADDITIONAL CONDUIT REQUIREMENTS.
3. SEE FLOOR PLAN AND FIRE ALARM RISER DIAGRAM FOR ADDITIONAL REQUIREMENTS.
4. COORDINATE NEW TRENCHWORK WITH ELECTRICAL DRAWINGS.
5. ALL INGRADE PULL BOX SHOWN ARE NEW. PROVIDE TRAFFIC RATED LIDS.

**SHEET NOTES:**

- 1 (N) FIRE ALARM CONTROL PANEL. FULLSTATION AND SMOKE DETECTOR LOCATED IN THE SAME ROOM.
- 2 (N) FIRE ALARM PULLBOX. LABEL LID "FIRE ALARM". CONTRACTOR TO LOCATE N#1 PULL BOX NEXT TO ELECT PULL BOX THAT ARE FEEDING MODULAR BLDGS. SEE E2.1 DRAWING FOR ELECT PULL BOX LOCATION.
- 3 UTILIZE EXISTING CONDUIT TO ROUTE FIRE ALARM WIRING.

**FA CABLE SCHEDULE:**


- A - (2) #12 FOR NOTIFICATION APPLIANCE CIRCUITS (NAC)  
B - (1) #4 UNSHEILDED TWISTED PAIR FOR SIGNALING LINE CIRCUITS (SLC)

### CONDUIT SCHEDULE.

- 1 (N) (I) "C - FIRE ALARM



ALL DESIGN, CONSTRUCTION, AND/OR INSTALLATION OF ANY KIND OF IMPROVEMENTS OF THE PROPERTY OF VERDE DESIGN, INC. AND WERE CREATED, DEVELOPED, AND DEVELOPED FOR USE ON AND IN CONNECTION WITH THE SPECIFIED PROJECT. NONE OF SUCH IDEAS, DESIGNS, ARRANGEMENTS OR PLANS SHALL BE USED, REPRODUCED, OR PUBLISHED BY ANY METHOD, IN WHOLE OR IN PART, OR DISCLOSED TO ANY PERSON, FIRM, OR CORPORATION FOR ANY PURPOSE WITHOUT THE WRITTEN PERMISSION OF VERDE DESIGN, INC.

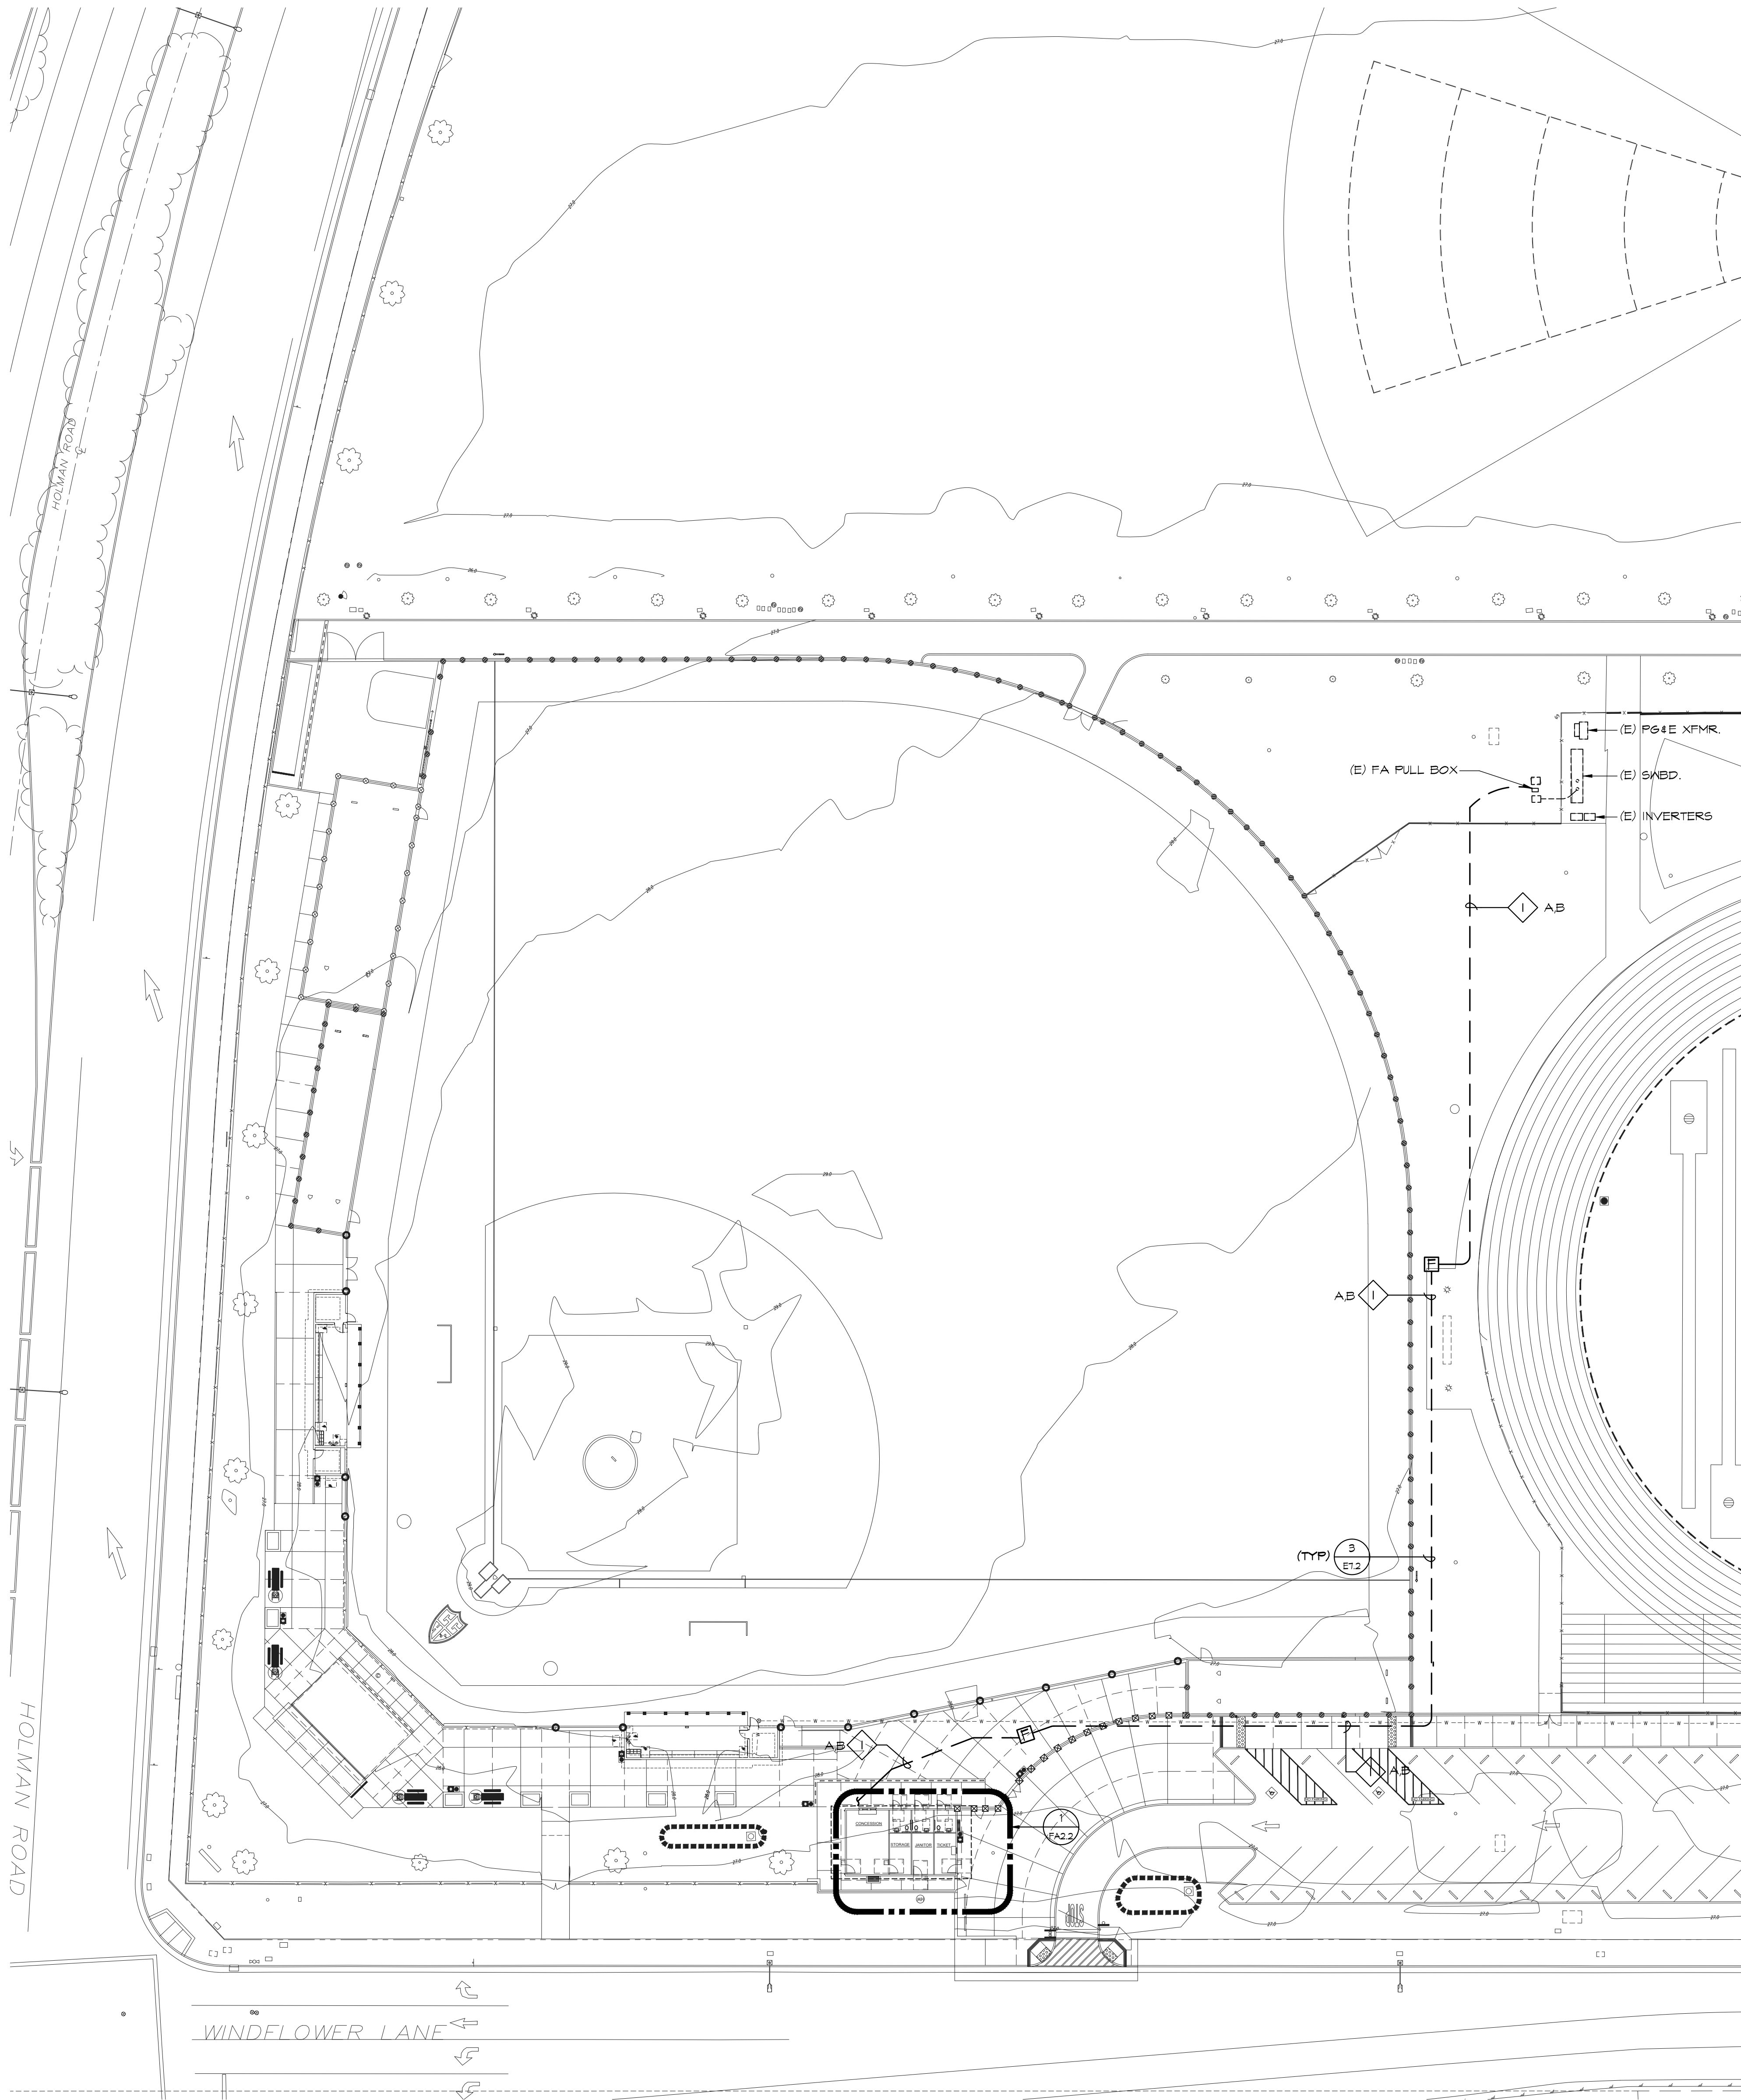

1  
FA2.1 SCALE: 1" = 30'-0"

## ENLARGED BASEBALL FIELD - ELECTRICAL NEW SITE PLAN



### GENERAL NOTES:





1. ALL FIRE ALARM CABLING SHALL BE NEW.
2. SEE FIRE ALARM DRAWINGS FOR ADDITIONAL CONDUIT REQUIREMENTS.
3. SEE FLOOR PLAN AND FIRE ALARM RISER DIAGRAM FOR ADDITIONAL REQUIREMENTS.
4. COORDINATE NEW TRENCHWORK WITH ELECTRICAL DRAWINGS.
5. ALL INGRADE PULL BOX SHOWN ARE NEW. PROVIDE TRAFFIC RATED LIDS. LABEL LID "FIRE ALARM".

### FA CABLE SCHEDULE:

- A - (2) #12 FOR NOTIFICATION APPLIANCE CIRCUITS (NAC)  
B - (1) #14 UNSHELD TWISTED PAIR FOR SIGNALING LINE CIRCUITS (SLC)

### CONDUIT SCHEDULE:

- FIRE ALARM  
1 (N) 1" - FIRE ALARM

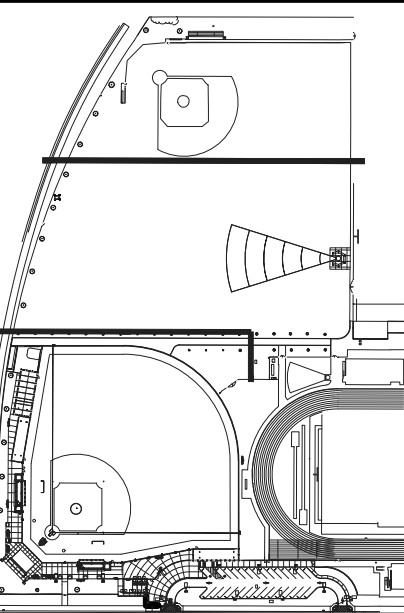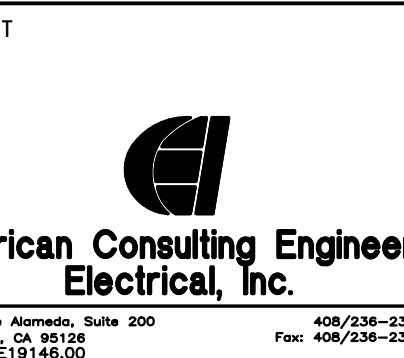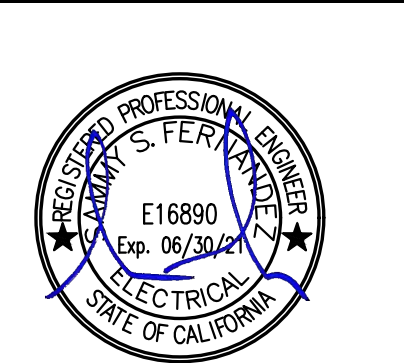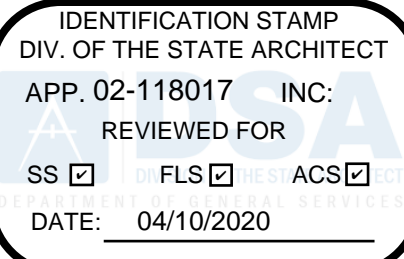

### ENLARGED BASEBALL FIELD FIRE ALARM NEW SITE PLAN

### CHAVEZ HIGH SCHOOL STOCKTON USD ATHLETIC FACILITY IMPROVEMENTS

### 2929 WINDFLOWER LN STOCKTON, CA 95212


| SUBMITTAL               | DATE     |
|-------------------------|----------|
| DD/50% SUBMITTAL        | 10/25/19 |
| DSA SUBMITTAL           | 12/20/19 |
| DSA BACKCHECK SUBMITTAL | 03/27/20 |

| NO. | REVISIONS | DATE |
|-----|-----------|------|
| 1   |           |      |
| 2   |           |      |
| 3   |           |      |
| 4   |           |      |
| 5   |           |      |


|                           |                      |
|---------------------------|----------------------|
| DRAWN BY<br>MG            | CHECKED BY<br>SB/ SF |
| DATE ISSUED<br>03/27/20   | SCALE                |
| PROJ. NO.<br>1910900-1211 |                      |
| SHEET NO.<br>FA2.1        | OF #                 |



ALL DESIGN, CONSTRUCTION, AND/OR INSTALLATION OF IMPROVEMENTS BY THE DRAWING ARE OWNED BY AND THE PROPERTY OF VERDE DESIGN, INC. AND WERE CREATED, DEVELOPED, AND DEVELOPED FOR USE ON AND IN CONNECTION WITH THE SPECIFIED PROJECT. NONE OF SUCH IDEAS, DESIGNS, ARRANGEMENTS OR PLANS SHALL BE USED, REPRODUCED, OR PUBLISHED BY ANY METHOD, IN WHOLE OR IN PART, OR DISCLOSED TO ANY PERSON, FIRM, OR CORPORATION FOR ANY PURPOSE WITHOUT THE WRITTEN PERMISSION OF VERDE DESIGN, INC.

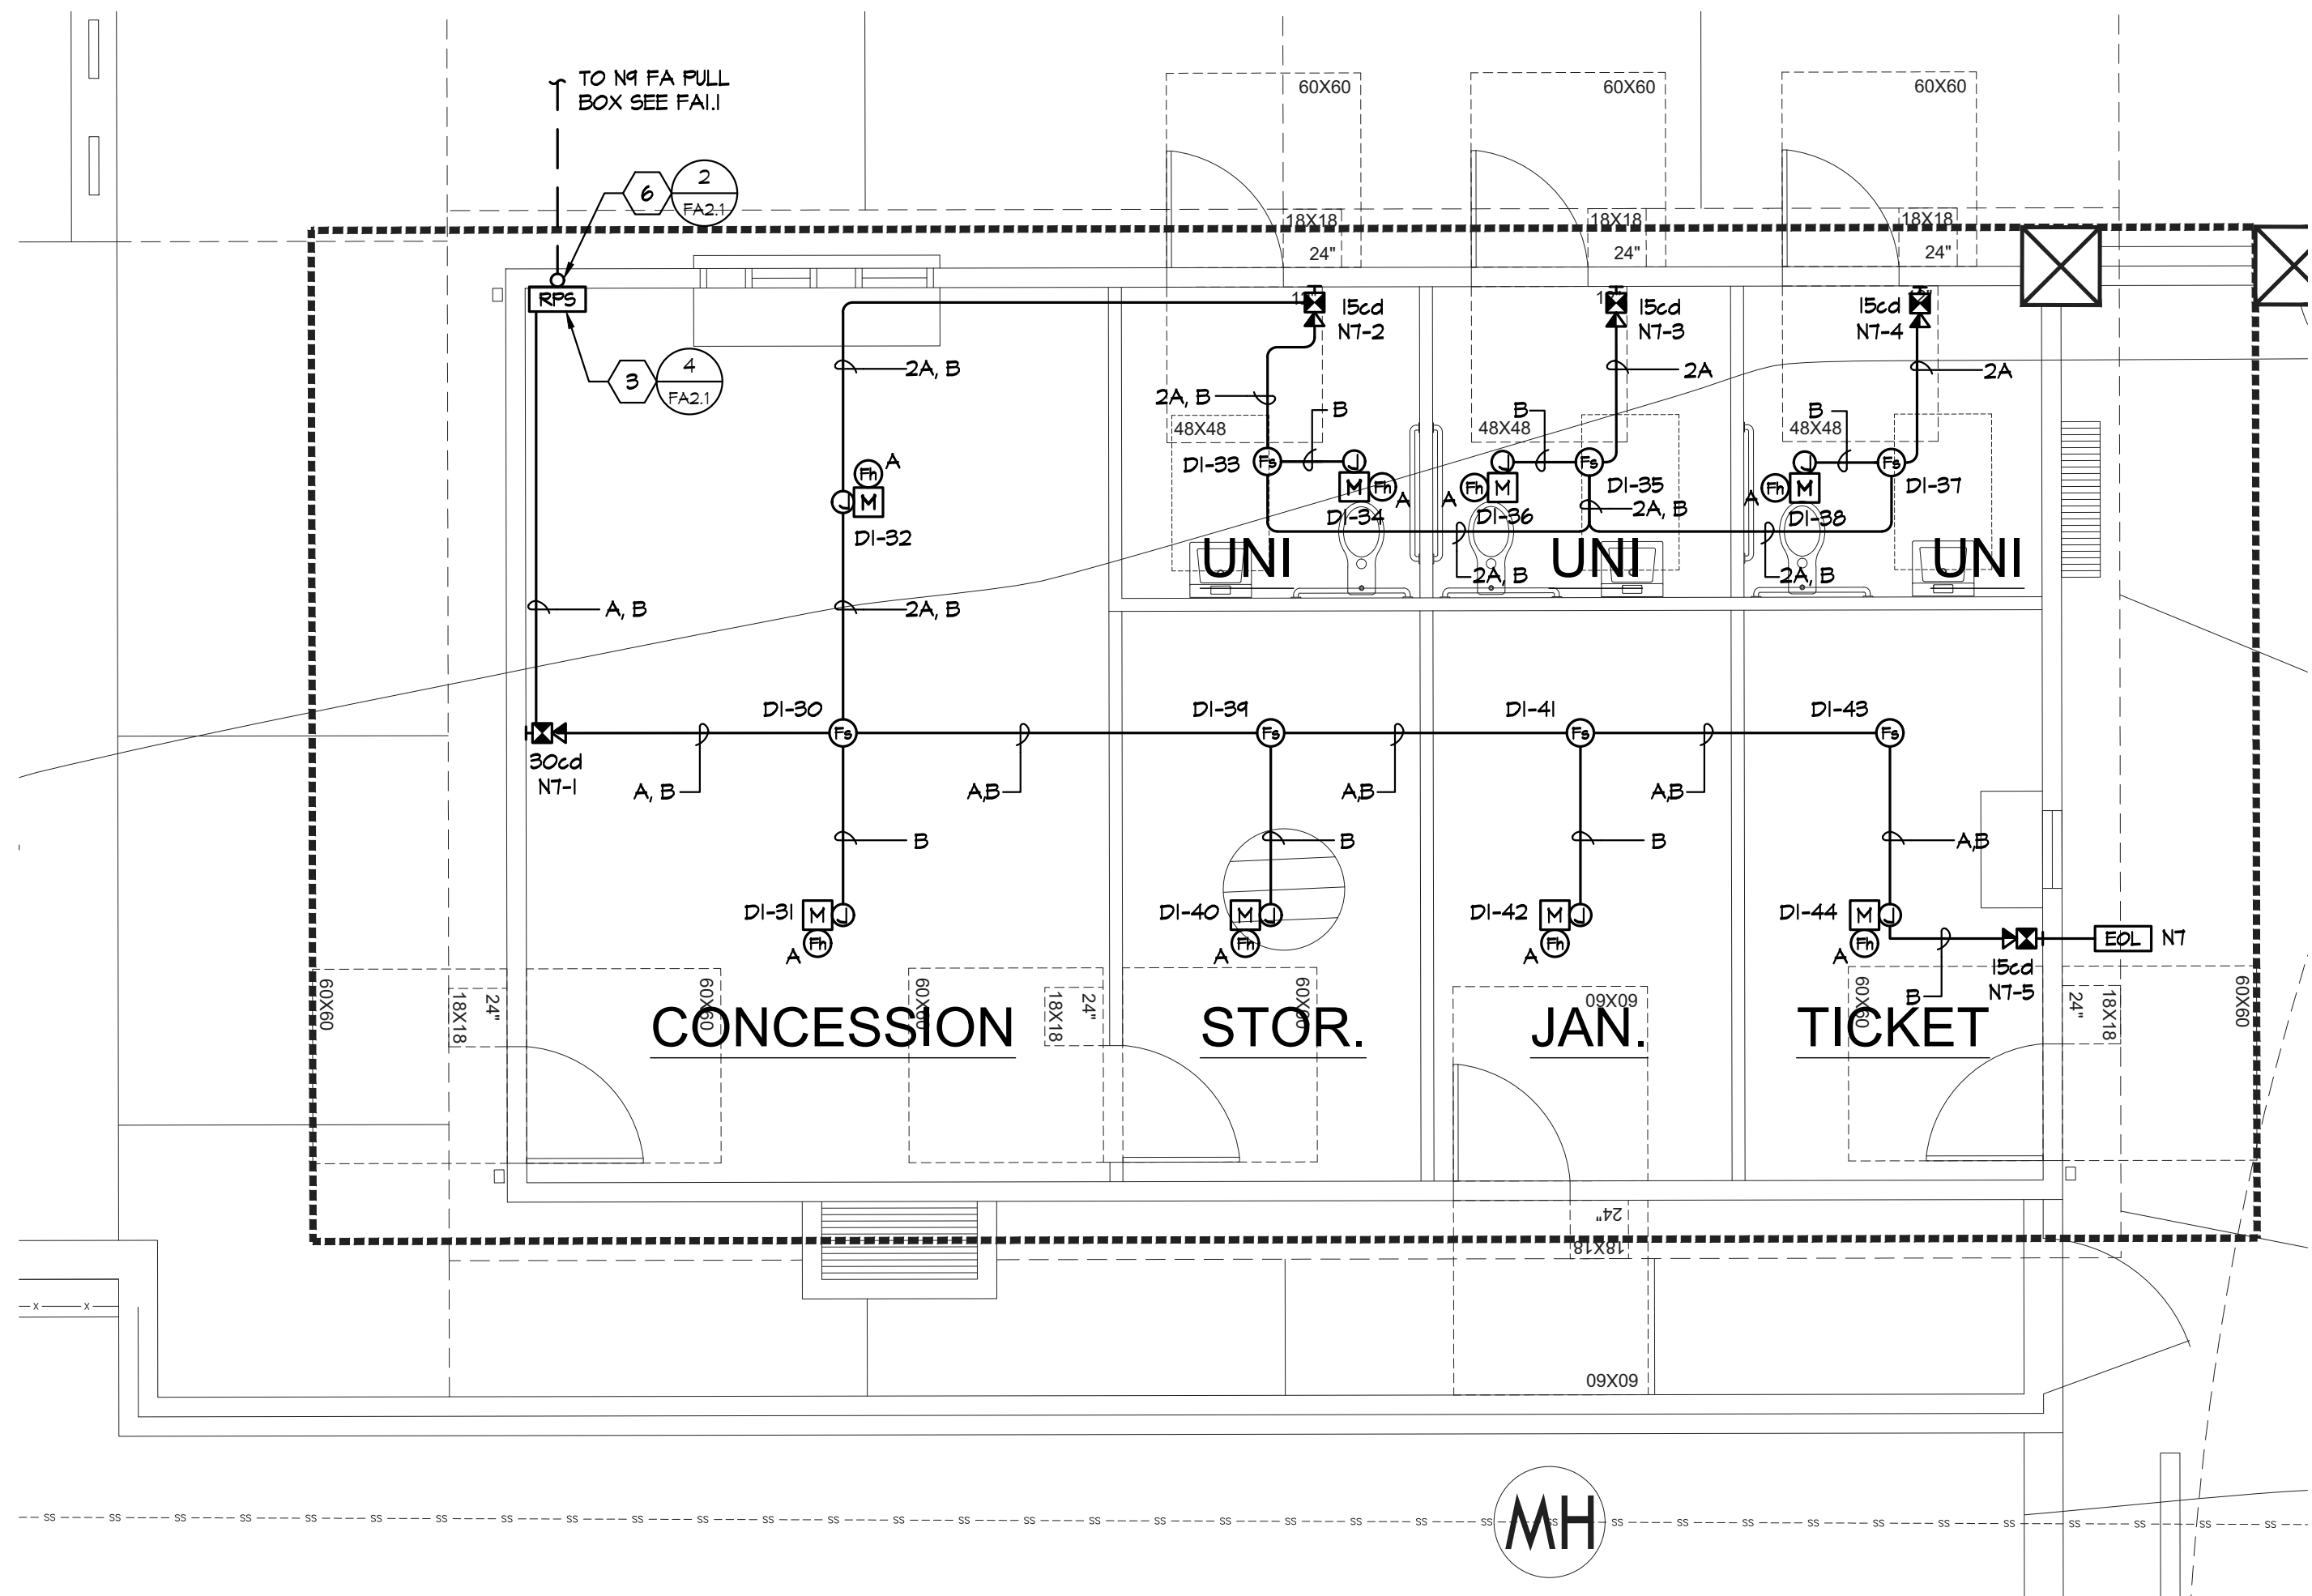

1 FIRE ALARM FLOOR PLAN - CONCESSION / STORAGE  
FA2.2 SCALE: 1/4" = 1'-0"

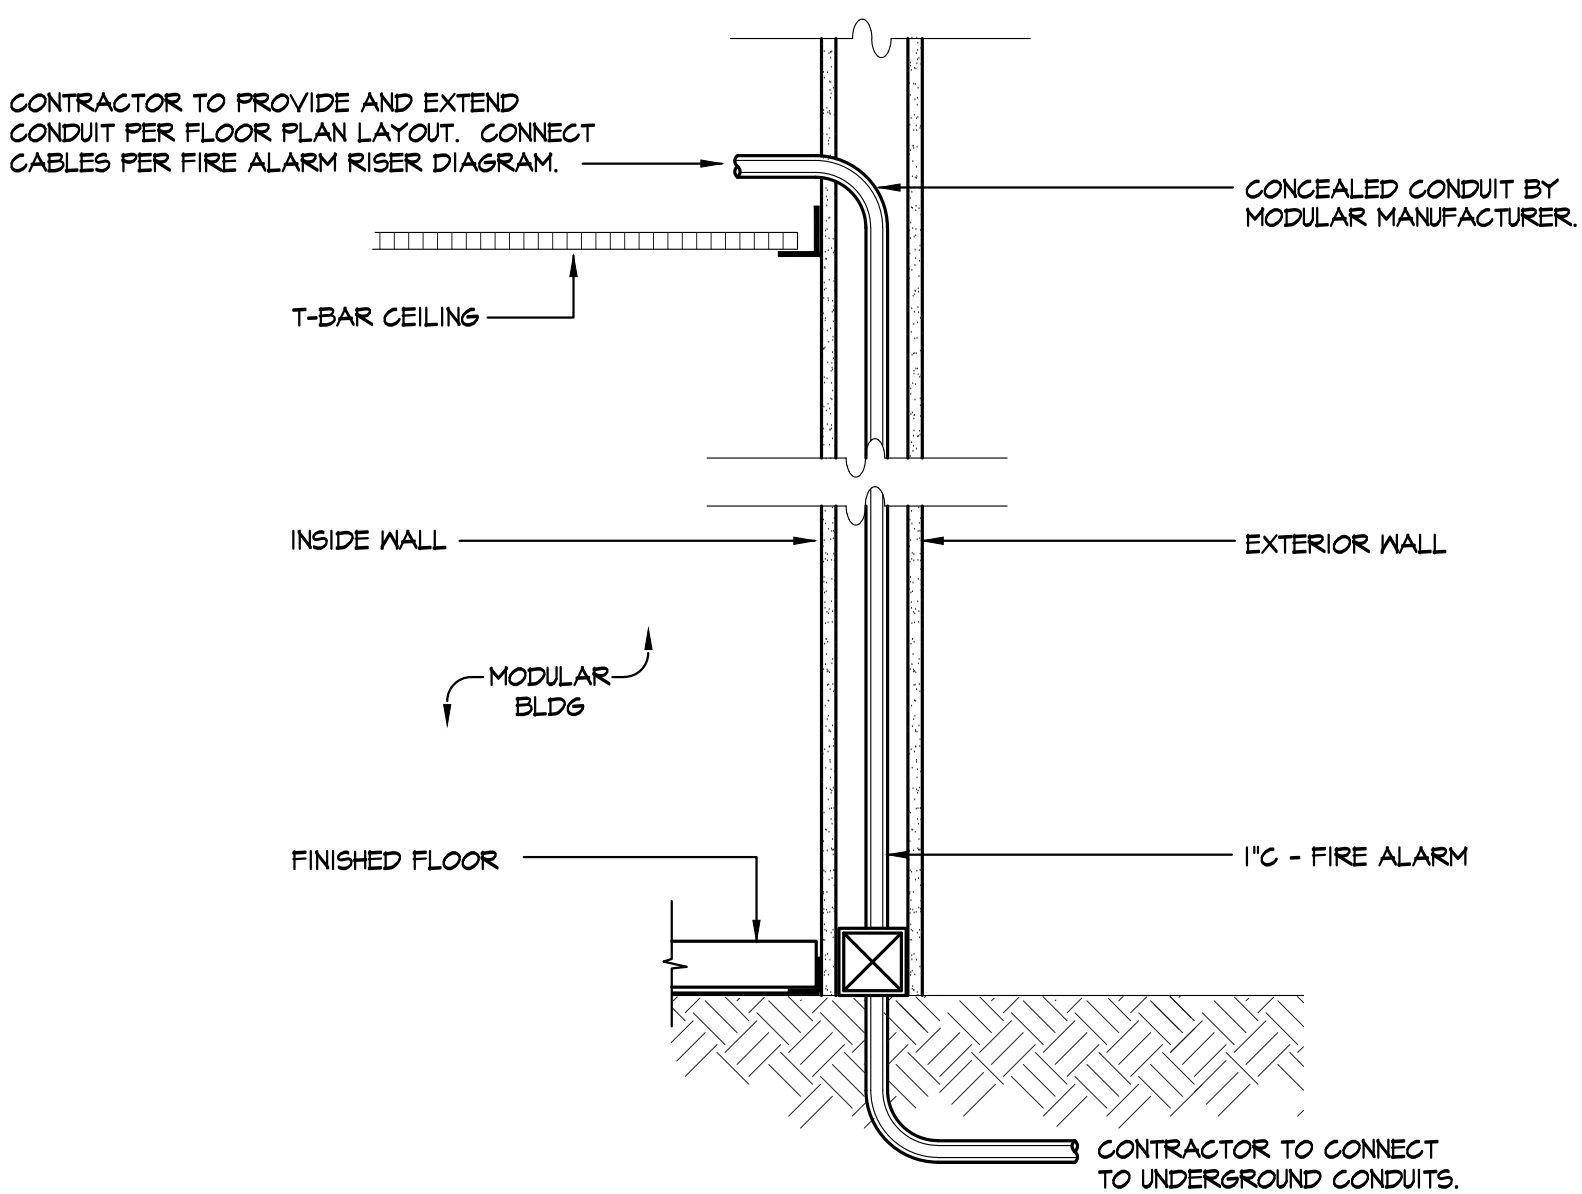

2 CONDUIT/PULLCAN DETAIL  
FA2.2 NOT TO SCALE

## GENERAL NOTES:

- SEE FIRE RISER DIAGRAM FOR ADDITIONAL REQUIREMENTS.
- ALL CABLES AND CONDUITS/SURFACE RACENWAYS SHALL BE NEW UNLESS OTHERWISE NOTED.
- PROVIDE SMOKE DETECTOR GUARDS. SEE FIRE ALARM SPECIFICATIONS FOR ADDITIONAL REQUIREMENTS.

## SHEET NOTES:

- (N) FIRE ALARM CONTROL PANEL.
- (N) NEMA 3R PULLCAN TO BE INSTALLED OVER FLUSH J-BOX (J-BOX PROVIDED BY MODULAR MANUFACTURER). CONTRACTOR TO COORDINATE AND SIZE AS REQUIRED.
- (N) NEW REMOTE POWER SUPPLY.
- (N) 1'x4' - FA; ROUTE (N) CABLES PER RISER DIAGRAM.
- PROVIDE (N) NEMA-1 4"x4"x4" PULL CAN IN T-BAR CEILINGS. PROVIDE AND CONNECT CABLE AND CONDUIT PER RISER DIAGRAM.
- CONTRACTOR TO COORDINATE WITH MODULAR MANUFACTURER TO CONCEAL CONDUIT IN WALL. PROVIDE ALL MEANS AND METHODS TO SUCCESSFULLY INSTALL CONDUIT CONCEALED IN WALLS.

## FA CABLE SCHEDULE:


A - (2) #12 FOR NOTIFICATION APPLIANCE CIRCUITS (NAC)

B - (1) #14 UNSHIELDED TWISTED PAIR FOR SIGNALING LINE CIRCUITS (SLC)

IDENTIFICATION STAMP  
DIV. OF THE STATE ARCHITECT  
APP. 02-118017 INC.  
REVIEWED FOR  
SS ☐ FLS ☐ ACS ☐  
DATE: 04/10/2020

**VERDE DESIGN**  
LANDSCAPE ARCHITECTURE  
CIVIL ENGINEERING  
SPORT PLANNING & DESIGN  
1843 Iron Point Rd #140  
Folsom, CA 95630  
tel: 916.415.6554  
fax: 408.985.7260  
www.VerdeDesignInc.com


STAMP

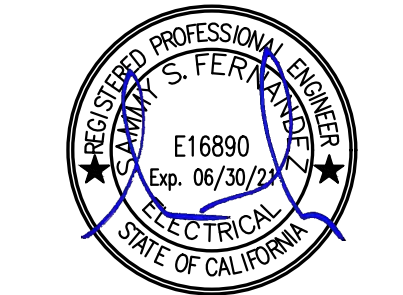

CONSULTANT

**American Consulting Engineers  
Electrical, Inc.**  
1560 The Armory, Suite 200  
San Jose, CA 95128  
JOB # E19148.00  
Date: 03/28/2019

KEYMAP

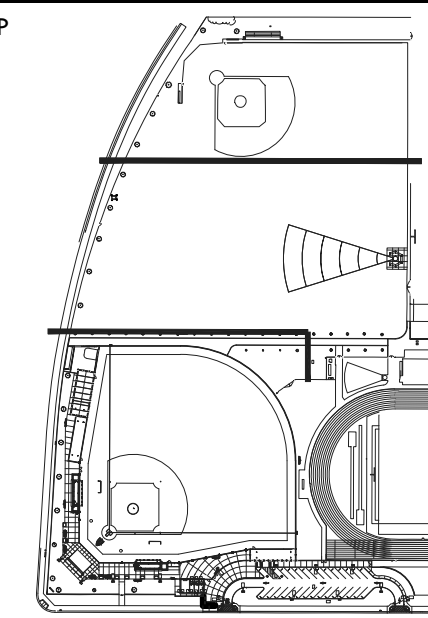

SHEET TITLE

FIRE ALARM FLOOR PLAN -  
CONCESSION / STORAGE

PROJECT NAME

CHAVEZ HIGH SCHOOL  
STOCKTON USD  
ATHLETIC FACILITY  
IMPROVEMENTS

PROJECT ADDRESS

2929 WINDFLOWER LN  
STOCKTON, CA 95212

| SUBMITTAL               | DATE     |
|-------------------------|----------|
| DD/50% SUBMITTAL        | 10/25/19 |
| DSA SUBMITTAL           | 12/20/19 |
| DSA BACKCHECK SUBMITTAL | 03/27/20 |

| NO. | REVISIONS | DATE |
|-----|-----------|------|
| 1   |           |      |
| 2   |           |      |
| 3   |           |      |
| 4   |           |      |
| 5   |           |      |

|                         |                      |
|-------------------------|----------------------|
| DRAWN BY<br>MG          | CHECKED BY<br>SB/ SF |
| DATE ISSUED<br>03/27/20 | SCALE                |

PROJ. NO.  
1910900-1211

SHEET NO.  
FA2.2 OF #



BATTERY CALCULATION:

| (E) FIRE ALARM CONTROL PANEL - BATTERY CALCULATION  |                  |                                      |                                       |                     |                    |                     |
|---|------------------|--------------------------------------|---------------------------------------|---------------------|--------------------|---------------------|
| QUANTITY  | MODEL #          | DEVICE                               | SUPV. CURRENT PER                     | TOTAL SUPV. CURRENT | ALARM CURRENT PER  | TOTAL ALARM CURRENT |
| (E) FIRE ALARM DEVICES INSTALLED UNDER THIS PROJECT |                  |                                      |                                       |                     |                    |                     |
| 1   | CPU              | (N) FACP CENTRAL PROCESSING UNIT     | 0.1550                                | 0.1550              | 0.2040             | 0.2040              |
| 2   | 61M              | SYNC MODULE                          | 0.0000                                | 0.0000              | 0.0330             | 0.0660              |
| 1   | INT-T            | (N) HORN (WEATHERPROOF)              | 0.0000                                | 0.0000              | 0.0550             | 0.0550              |
| 3   | 4MS-TA           | (N) STROBE 15/75CD                   | 0.0000                                | 0.0000              | 0.2040             | 0.6120              |
| 1   | MIRBPS6A         | REMOTE POWER BOOSTER PANEL           | 0.0000                                | 0.0000              | 0.0060             | 0.0060              |
| 1   | SIGA-270         | (N) PULL STATION                     | 0.0003                                | 0.0003              | 0.0003             | 0.0004              |
| 4   | SIGA-HRS         | (N) HEAT DETECTOR/BASE               | 0.0001                                | 0.0004              | 0.0180             | 0.0720              |
| 11  | SIGA-MM1/280B-PL | (N) MONITOR MODULE (ATTIC HEAT DET.) | 0.0003                                | 0.0023              | 0.0004             | 0.0044              |
| 13  | SIGA-PS          | (N) SMOKE DETECTOR/BASE              | 0.0001                                | 0.0013              | 0.0180             | 0.2340              |
| 1   | SIGA-MM1         | (N) MONITOR MODULE                   | 0.0003                                | 0.0003              | 0.0004             | 0.0004              |
| (N) FIRE ALARM DEVICES INSTALLED UNDER THIS PROJECT |                  |                                      |                                       |                     |                    |                     |
| 1   | MIRBPS6A         | REMOTE POWER BOOSTER PANEL           | 0.0000                                | 0.0000              | 0.0060             | 0.0060              |
| 3   | SIGA-HRS         | (N) HEAT DETECTOR/BASE               | 0.0001                                | 0.0003              | 0.0180             | 0.1440              |
| 3   | SIGA-MM1/280B-PL | (N) MONITOR MODULE (ATTIC HEAT DET.) | 0.0003                                | 0.0009              | 0.0004             | 0.0032              |
| 7   | SIGA-PS          | (N) SMOKE DETECTOR/BASE              | 0.0001                                | 0.0007              | 0.0180             | 0.1260              |
| 1   | SIGA-MM1         | (N) MONITOR MODULE                   | 0.0003                                | 0.0003              | 0.0004             | 0.0004              |
| 4   | 61-VM            | (N) HORN/STROBE 15CD                 | 0.0000                                | 0.0000              | 0.0540             | 0.2160              |
| 1   | 61-VM            | (N) HORN/STROBE 30CD                 | 0.0000                                | 0.0000              | 0.0820             | 0.0820              |
|   |                  |                                      | Max. Supv. Current                    | 0.16                | Max. Alarm Current | 1.05                |
|   |                  |                                      | Maximum Supervisory Current: 0.16     |                     |                    |                     |
|   |                  |                                      | Standby Period 24 hour: 24            |                     |                    |                     |
|   |                  |                                      | Total Supervisory Reserve: 3.93 (A)   |                     |                    |                     |
|   |                  |                                      | Maximum Alarm Current: 1.05           |                     |                    |                     |
|   |                  |                                      | Alarm Period (5 minute): 0.08         |                     |                    |                     |
|   |                  |                                      | Total Alarm Reserve: 0.15 (B)         |                     |                    |                     |
|   |                  |                                      | Total Reserve Current: ( A + B ) 4.08 |                     |                    |                     |
|   |                  |                                      | Safety Margin (20%): 1.2              |                     |                    |                     |
|   |                  |                                      | Total Ampere Hours Required: 4.90     |                     |                    |                     |
|   |                  |                                      | (N) Battery: 2- 12V 10 Ampere Hour    |                     |                    |                     |

| (N) RPS #2 - BATTERY CALCULATION |          |                      |                                       |                     |                    |                     |
|----------------------------------|----------|----------------------|---------------------------------------|---------------------|--------------------|---------------------|
| QUANTITY                         | MODEL #  | DEVICE               | SUPV. CURRENT PER                     | TOTAL SUPV. CURRENT | ALARM CURRENT PER  | TOTAL ALARM CURRENT |
| 1                                | MIRBPS6A | (N) MAIN PC BOARD    | 0.0700                                | 0.0700              | 0.0700             | 0.0700              |
| 1                                | 61M      | SYNC MODULE          | 0.0000                                | 0.0000              | 0.0330             | 0.0330              |
| 4                                | 61-VM    | (N) HORN/STROBE 15CD | 0.0000                                | 0.0000              | 0.0540             | 0.2160              |
| 1                                | 61-VM    | (N) HORN/STROBE 30CD | 0.0000                                | 0.0000              | 0.0820             | 0.0820              |
|                                  |          |                      | Max. Supv. Current                    | 0.07                | Max. Alarm Current | 0.42                |
|                                  |          |                      | Maximum Supervisory Current: 0.07     |                     |                    |                     |
|                                  |          |                      | Standby Period 24 hour: 24.00         |                     |                    |                     |
|                                  |          |                      | Total Supervisory Reserve: 1.68 (A)   |                     |                    |                     |
|                                  |          |                      | Maximum Alarm Current: 0.42           |                     |                    |                     |
|                                  |          |                      | Alarm Period (5 minute): 0.08         |                     |                    |                     |
|                                  |          |                      | Total Alarm Reserve: 0.03 (B)         |                     |                    |                     |
|                                  |          |                      | Total Reserve Current: ( A + B ) 1.71 |                     |                    |                     |
|                                  |          |                      | Safety Margin (20%): 1.20             |                     |                    |                     |
|                                  |          |                      | Total Ampere Hours Required: 2.06     |                     |                    |                     |
|                                  |          |                      | (N) Battery: 2- 12V 7.2 Ampere Hour   |                     |                    |                     |


VOLTAGE DROP:

| NOTIFICATION CIRCUIT # 7 |                   |      | AMPS OF DEVICE                         | TOTAL AMPS @ DEVICE | VOLTAGE DROP @ DEVICE |
|--------------------------|-------------------|------|--|---------------------|-----------------------|
| DEVICE #                 | DEVICE TYPE       | (FT) |  |                     |                       |
| NT-1                     | HORN/STROBE 30 CD | 15   | 0.096                                  | 0.420               | 0.021                 |
| NT-2                     | HORN/STROBE 15 CD | 35   | 0.091                                  | 0.324               | 0.030                 |
| NT-3                     | HORN/STROBE 15 CD | 25   | 0.091                                  | 0.243               | 0.020                 |
| NT-4                     | HORN/STROBE 15 CD | 25   | 0.091                                  | 0.162               | 0.013                 |
| NT-5                     | HORN/STROBE 15 CD | 40   | 0.091                                  | 0.081               | 0.024                 |
|                          |                   |      | TOTAL CIRCUIT AMPS: 0.420              |                     |                       |
|                          |                   |      | TOTAL VOLTAGE DROP: 0.116              |                     |                       |
|                          |                   |      | CIRCUIT VOLTAGE: 20.4                  |                     |                       |
|                          |                   |      | % VOLTAGE DROP 0.57%                   |                     |                       |
|                          |                   |      | VOLTAGE @ END OF LINE 20.28            |                     |                       |
|                          |                   |      | MIN. OPERATIONAL VOLTAGE OF DEVICES 17 |                     |                       |

WIRE GAUGE 12

\*\* FORMULA\*\*  
(1x FEET x 216)  
CIRCULAR MILS

| WIRE SIZE | RES PER MFT. | CIRCULAR MILS |
|-----------|--------------|---------------|
| 10        | 1.24         | 10380         |
| 12        | 1.59         | 6530          |
| 14        | 2.52         | 4110          |
| 16        | 4.02         | 2580          |
| 18        | 6.39         | 1620          |
| 20        | 10.1         | 1020          |
| 22        | 16.2         | 640           |

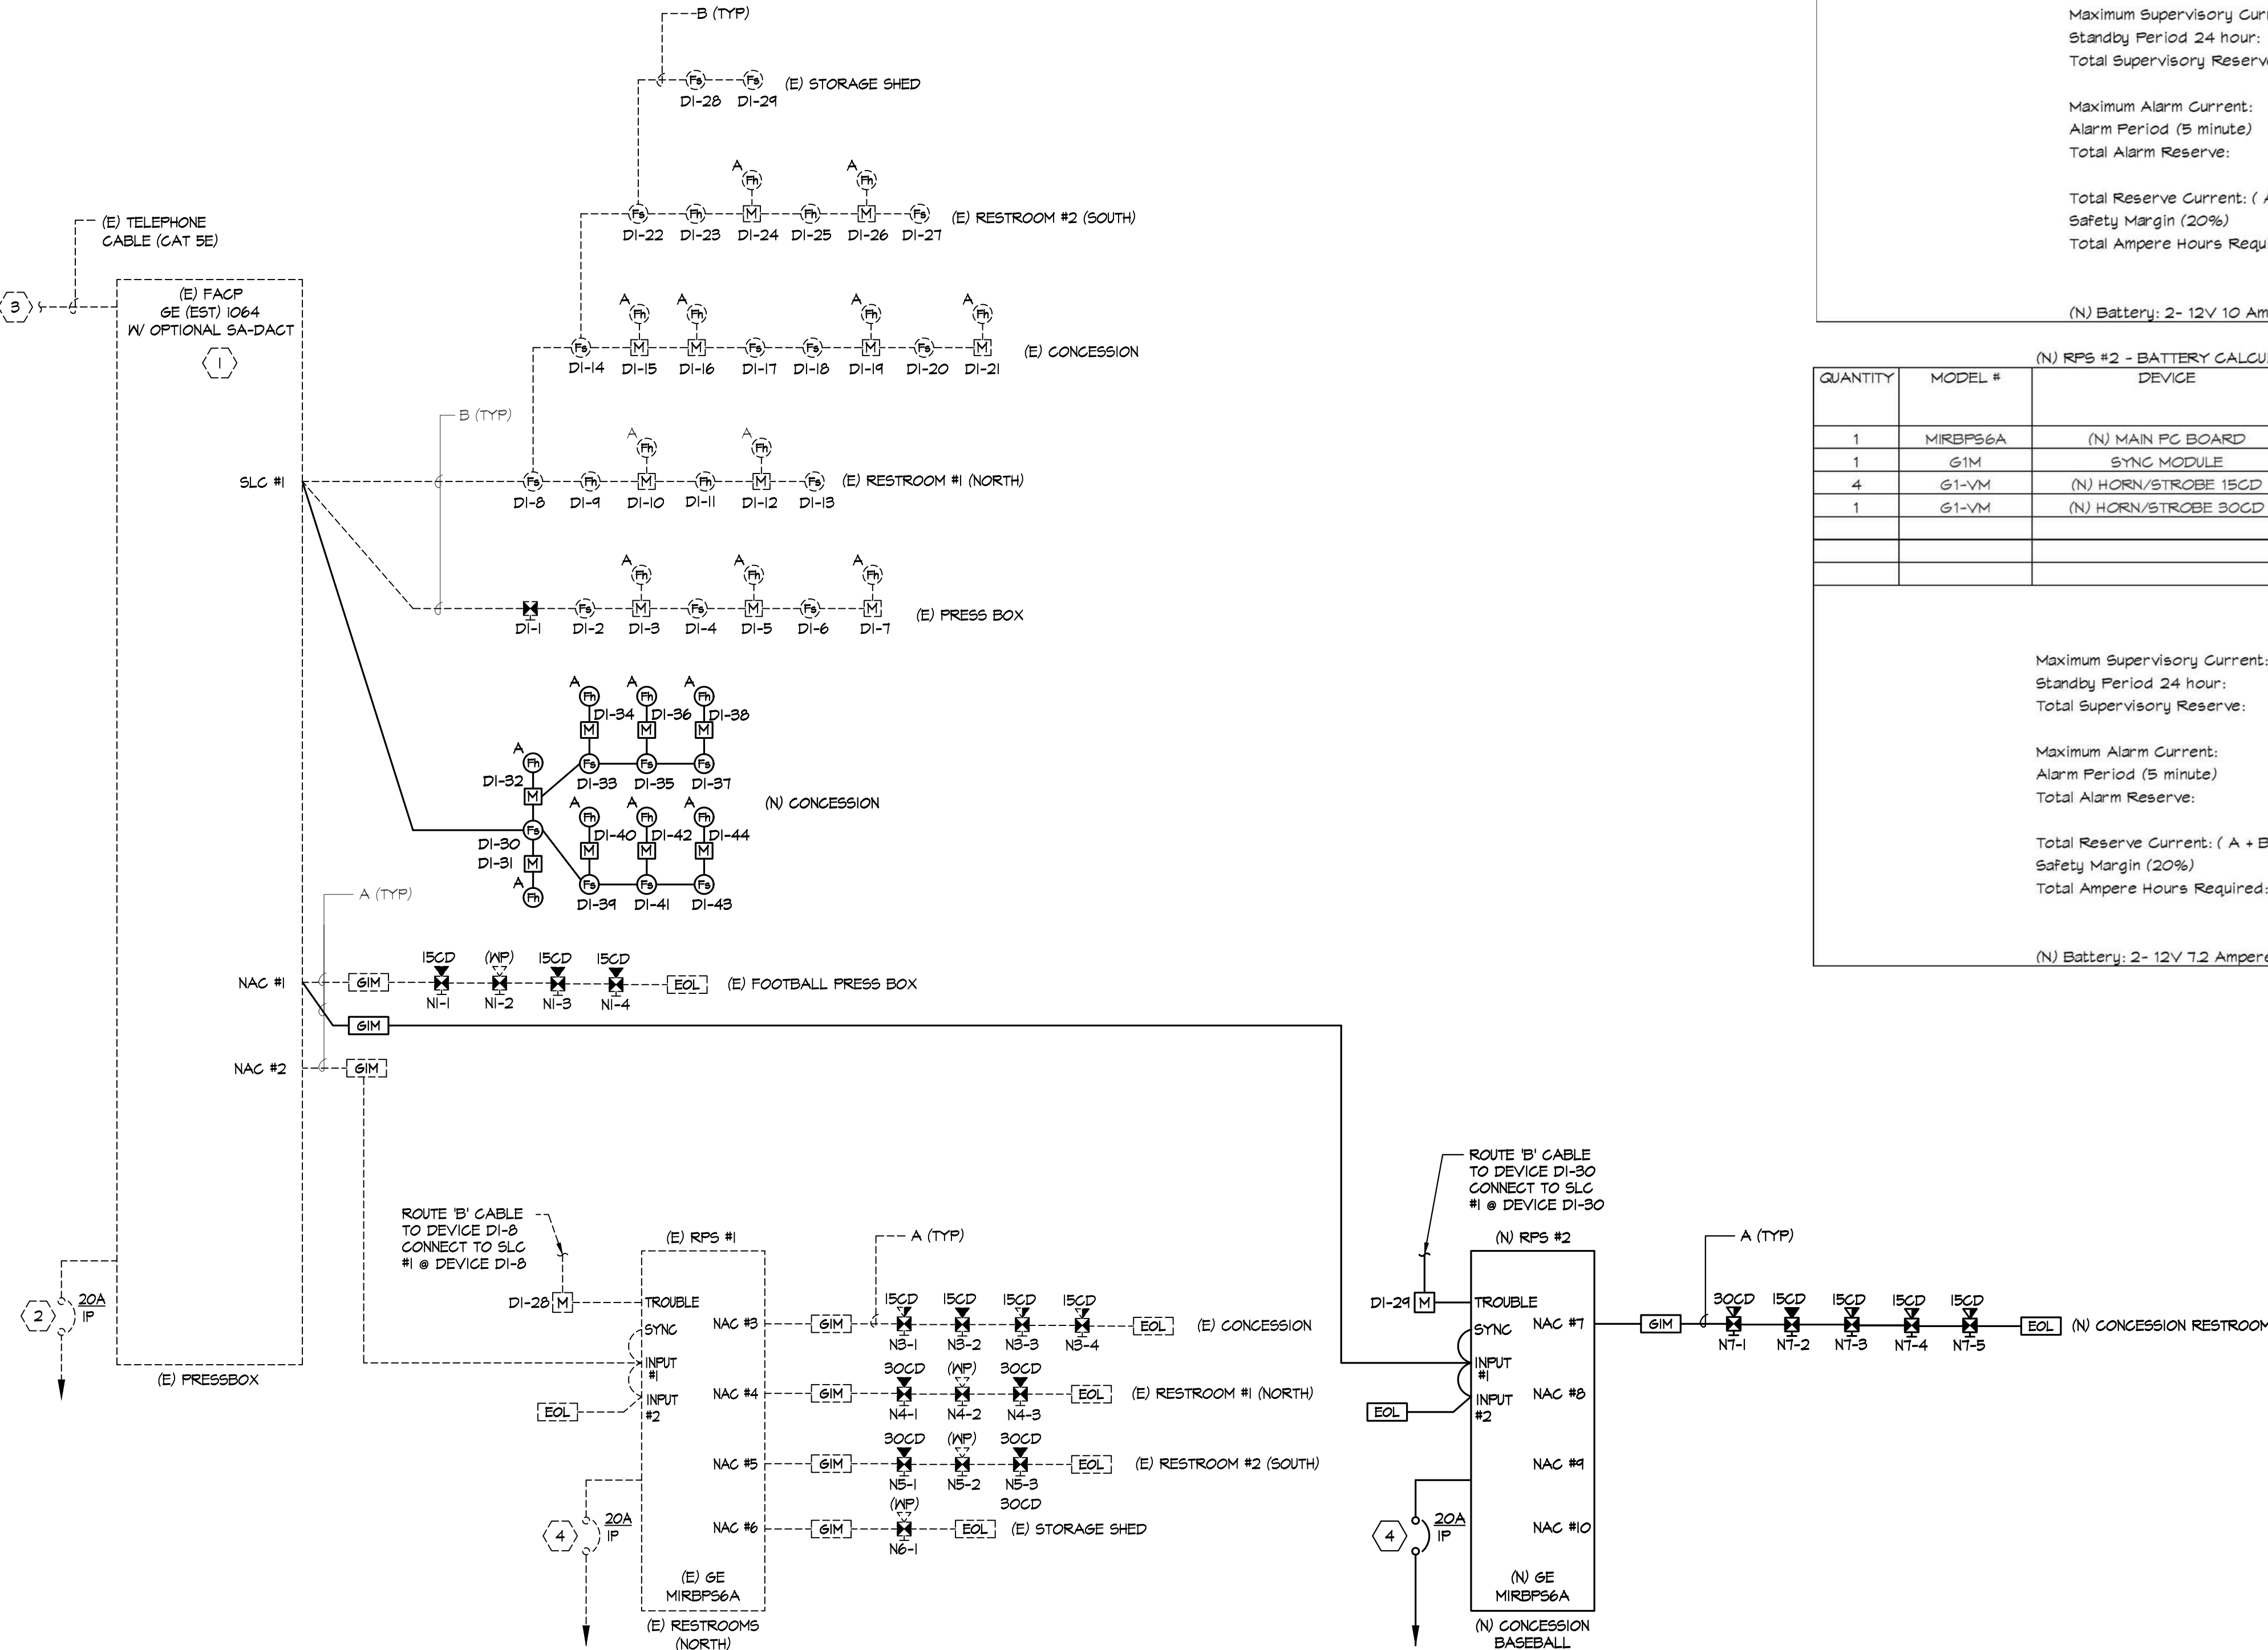

1 FIRE ALARM RISER DIAGRAM  
FA3.1 N.T.S.

GENERAL NOTES:




- SEE FIRE ALARM FLOOR PLANS FOR ADDITIONAL INFORMATION.
- ALL FIRE ALARM EQUIPMENT SHALL BE NEW.
- ALL CONDUITS/SURFACE RACEMATS SHALL BE NEW UNLESS OTHERWISE NOTED.
- THERE SHALL BE NO SPLICING OF FIRE ALARM CONDUCTORS BETWEEN TERMINATIONS OF FIRE ALARM DEVICES. FIRE ALARM CONDUCTORS SHALL BE CONTINUOUS FROM DEVICE TO DEVICE.

FA CABLE SCHEDULE:

- A - (2) #12 FOR NOTIFICATION APPLIANCE CIRCUITS (NAC)  
B - (1) #14 UNSHEILD TWISTED PAIR FOR SIGNALING LINE CIRCUITS (SLC)

SHEET NOTES:

- PROVIDE AND INSTALL NEW SE (EDWARD'S SYSTEMS TECHNOLOGY) 1064 FIRE ALARM CONTROL PANEL. PROVIDE OPTIONAL SA-DAC1 DIALER AND CONNECT TO PHONE LINES AS REQUIRED.
- PROVIDE AND INSTALL DEDICATED POWER CONNECTION. ROUTE HOMERUN CONDUIT WITH (3) #12S TO (N) MODULAR PRESSBOX BUILDING'S ELECTRICAL PANEL. CONNECT TO (N) 20A-IP DEDICATED CIRCUIT BREAKER. CONTRACTOR SHALL PROVIDE ALL NECESSARY HARDWARE FOR A COMPLETE INSTALLATION. UPDATE PANEL SCHEDULE ACCORDINGLY. PROVIDE CIRCUIT BREAKER LOCKOUT TO PREVENT UNAUTHORIZED TAMPERING.
- TWO LINES ARE REQUIRED PER NFPA AND ALL ALARM SIGNALS ARE TO BE TRANSMITTED TO AN APPROVED UL LISTED SUPERVISING STATION. COORDINATE WITH DISTRICT DEDICATED LINES. CONTRACTOR TO LOCATE TELEPHONE BOARD. PROVIDE CABLE AND CONNECT AS REQUIRED. NOTE: TELEPHONE SYSTEM IS VOIP. CONTRACTOR TO PROVIDE NECESSARY ANALOG CABLE FROM (E) DEMARK TO (E) MD# TO COMPLETE A DEDICATED TELEPHONE LINE. SEE DATA RISER DIAGRAM FOR FIBER FROM (E) MD# TO (N) IDF IN PRESS BOX. PROVIDE (2) 12 PAIR OUTDOOR NOTED TELEPHONE CABLE. ONE FOR FA SYSTEM THE OTHER IS SPARE. ROUTE TELEPHONE IN (N) 4" NOTED AS DATA. CONNECT TELEPHONE LINES PER NFPA AND COIL SPARE CABLE IN (N) IDF CABINET. PROVIDE 20' OF COILED CABLE.
- NEW REMOTE POWER SUPPLY RPS #1. PROVIDE AND INSTALL NEW SE MIRBPS6A. PROVIDE AND INSTALL DEDICATED POWER CONNECTION. ROUTE HOMERUN CONDUIT WITH (3) #12S TO (N) CONCESSION RESTROOMS BUILDING'S ELECTRICAL PANEL. CONNECT TO (N) 20A-IP DEDICATED CIRCUIT BREAKER. CONTRACTOR SHALL PROVIDE ALL NECESSARY HARDWARE FOR A COMPLETE INSTALLATION. UPDATE PANEL SCHEDULE ACCORDINGLY. PROVIDE CIRCUIT BREAKER LOCKOUT TO PREVENT UNAUTHORIZED TAMPERING.

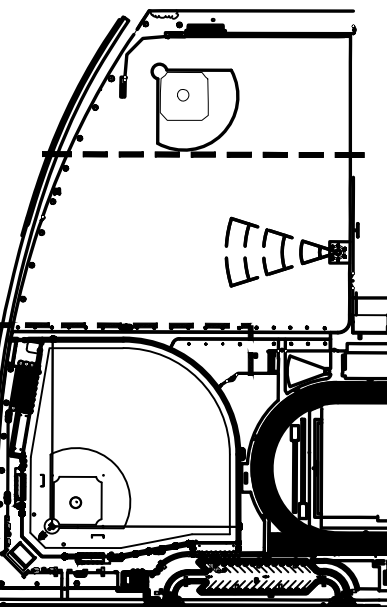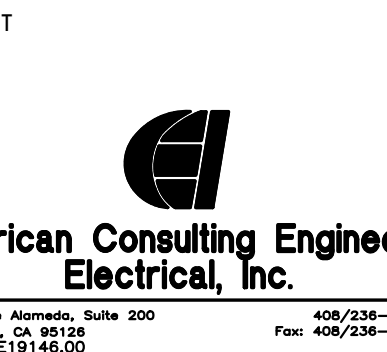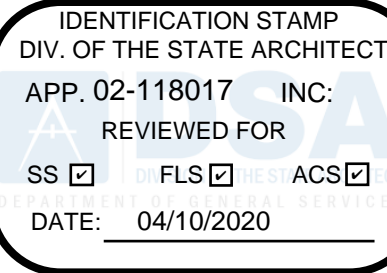

FIRE ALARM  
RISER DIAGRAM

CHAVEZ HIGH SCHOOL  
STOCKTON USD  
ATHLETIC FACILITY  
IMPROVEMENTS

2929 WINDFLOWER LN  
STOCKTON, CA 95212

| SUBMITTAL               | DATE     |
|-------------------------|----------|
| DD/50% SUBMITTAL        | 10/25/19 |
| DSA SUBMITTAL           | 12/20/19 |
| DSA BACKCHECK SUBMITTAL | 03/27/20 |


| NO. | REVISIONS | DATE |
|-----|-----------|------|
| 1   |           |      |
| 2   |           |      |
| 3   |           |      |
| 4   |           |      |
| 5   |           |      |
| 6   |           |      |
| 7   |           |      |
| 8   |           |      |
| 9   |           |      |
| 10  |           |      |

|                           |                      |
|---------------------------|----------------------|
| DRAWN BY<br>MG            | CHECKED BY<br>SB/ SF |
| DATE ISSUED<br>03/27/20   | SCALE                |
| PROJ. NO.<br>1910900-1211 |                      |
| SHEET NO.<br>FA3.1        | OF #                 |


FIRE ALARM RISER DIAGRAM



ALL DESIGN, CONSTRUCTION, AND/OR INSTALLATION OF ANY PART OF THIS DRAWING ARE OWNED BY AND THE PROPERTY OF VERDE DESIGN, INC. AND WERE CREATED, DEVELOPED, AND DEVELOPED FOR USE ON AND IN CONNECTION WITH THE SPECIFIED PROJECT. NONE OF SUCH DESIGN, CONSTRUCTION, OR INSTALLATION OF ANY PART OF THIS DRAWING SHALL BE USED, REPRODUCED, OR PUBLISHED IN WHOLE OR IN PART, OR DISCLOSED TO ANY PERSON, FIRM, OR CORPORATION FOR ANY PURPOSE WITHOUT THE WRITTEN PERMISSION OF VERDE DESIGN, INC.

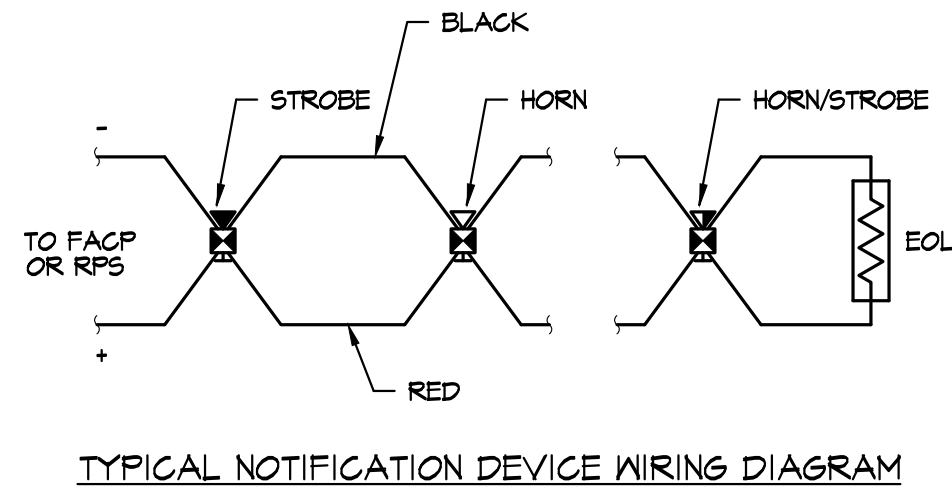


TYPICAL NOTIFICATION DEVICE WIRING DIAGRAM

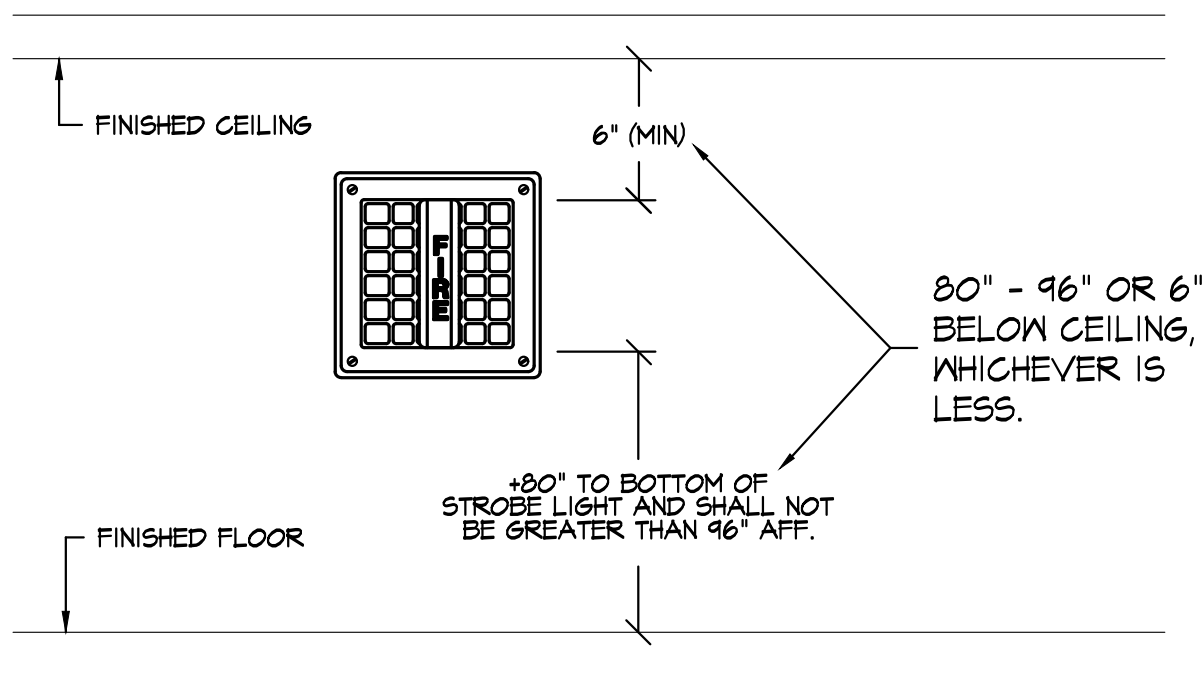


NOTE: SURFACE MOUNTED DEVICES SHALL BE PROVIDED WITH THE MANUFACTURERS RECOMMENDED SURFACE MOUNTED BACKBOX.

### 1 AUDIBLE/VISUAL DEVICE INSTALLATION DETAIL

FA4.1 NOT TO SCALE

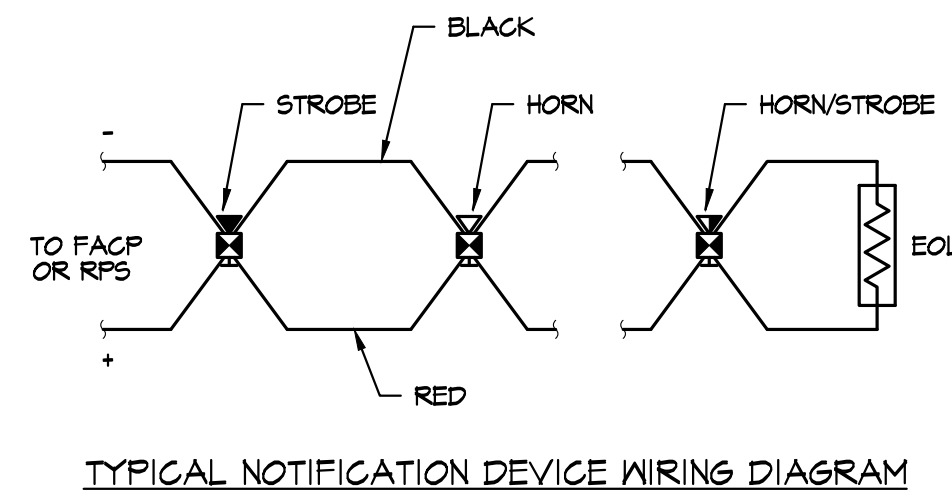


TYPICAL NOTIFICATION DEVICE WIRING DIAGRAM

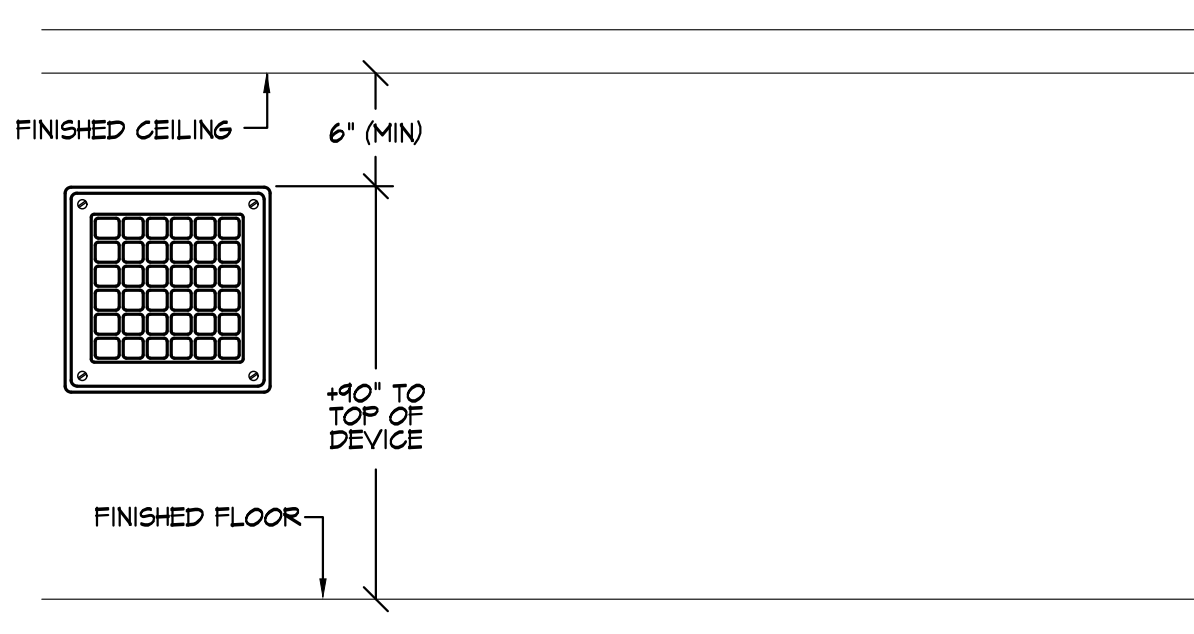


NOTE: SURFACE MOUNTED HORN SHALL BE PROVIDED WITH THE MANUFACTURERS RECOMMENDED SURFACE MOUNTED BACKBOX. OUTSIDE BACKBOXES SHALL BE RATED FOR SUCH USE.

### 2 AUDIBLE DEVICE INSTALLATION DETAIL

FA4.1 NOT TO SCALE

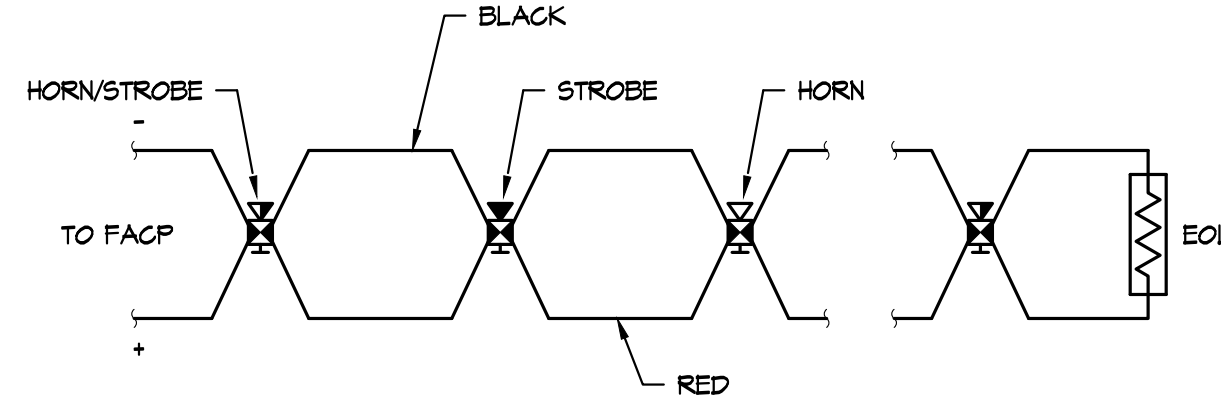


TYPICAL STROBE WIRING DIAGRAM

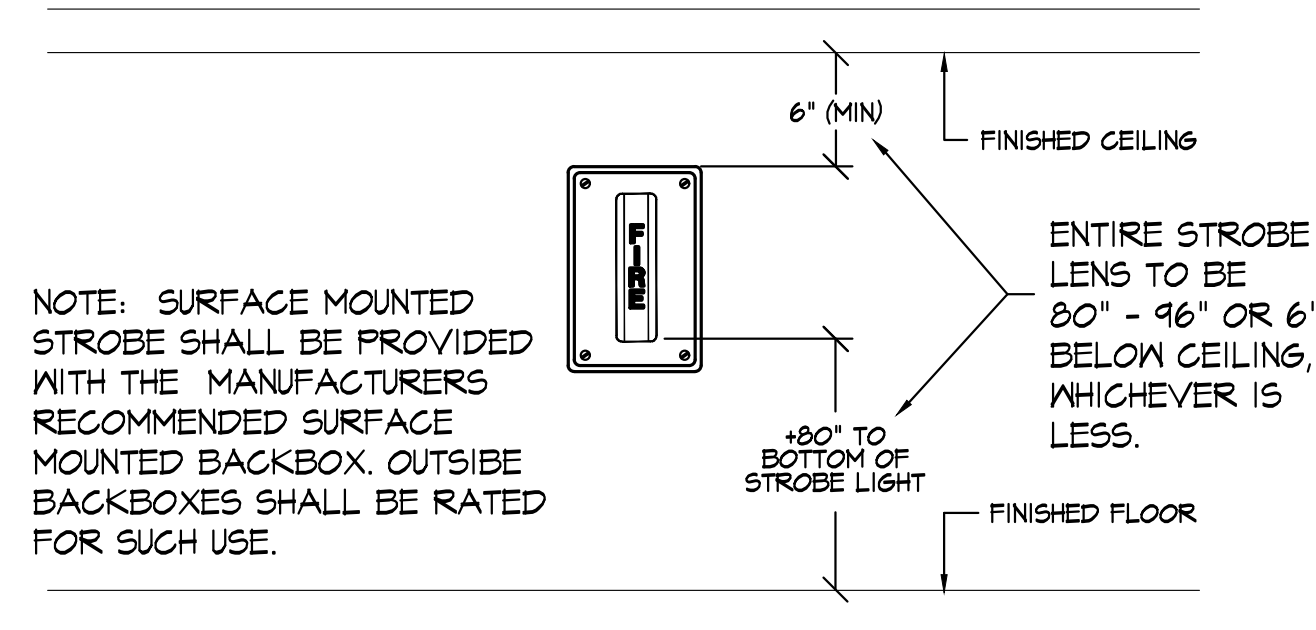


NOTE: SURFACE MOUNTED STROBE SHALL BE PROVIDED WITH THE MANUFACTURERS RECOMMENDED SURFACE MOUNTED BACKBOX. OUTSIDE BACKBOXES SHALL BE RATED FOR SUCH USE.

### 3 VISUAL DEVICE INSTALLATION DETAIL

FA4.1 NOT TO SCALE

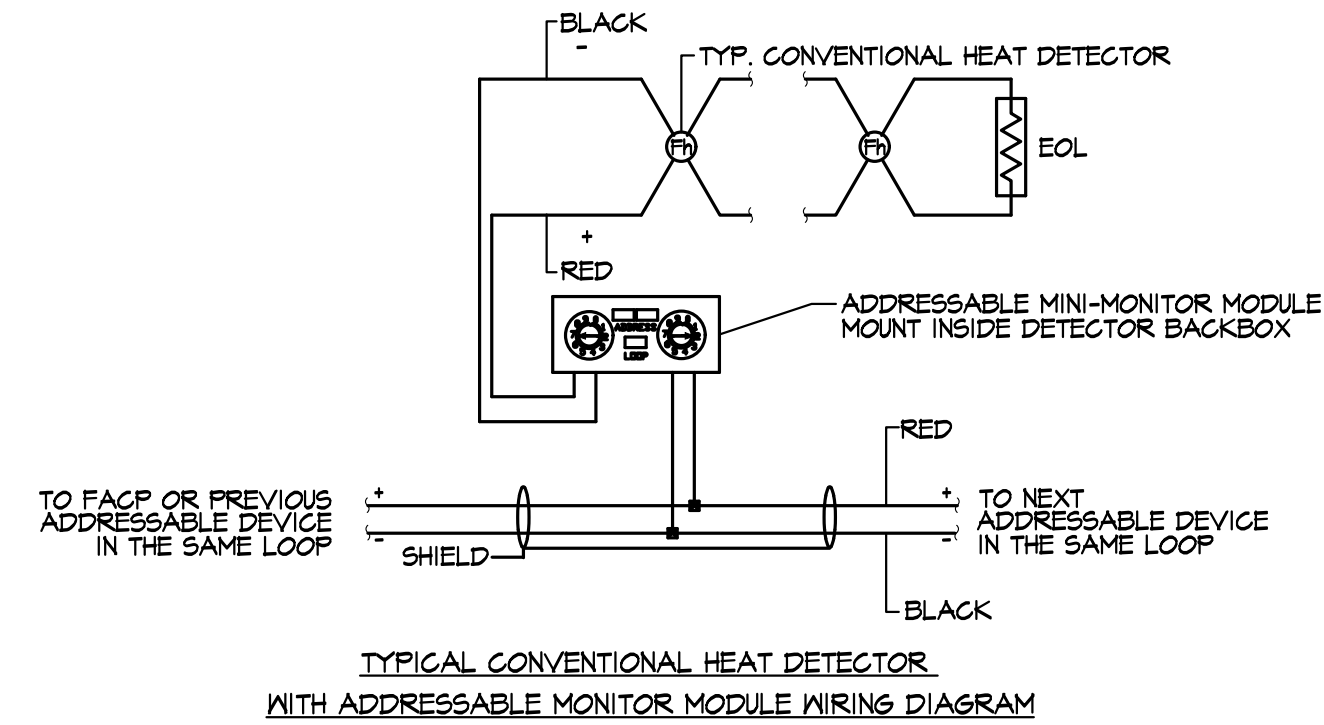


TYPICAL CONVENTIONAL HEAT DETECTOR WITH ADDRESSABLE MONITOR MODULE WIRING DIAGRAM

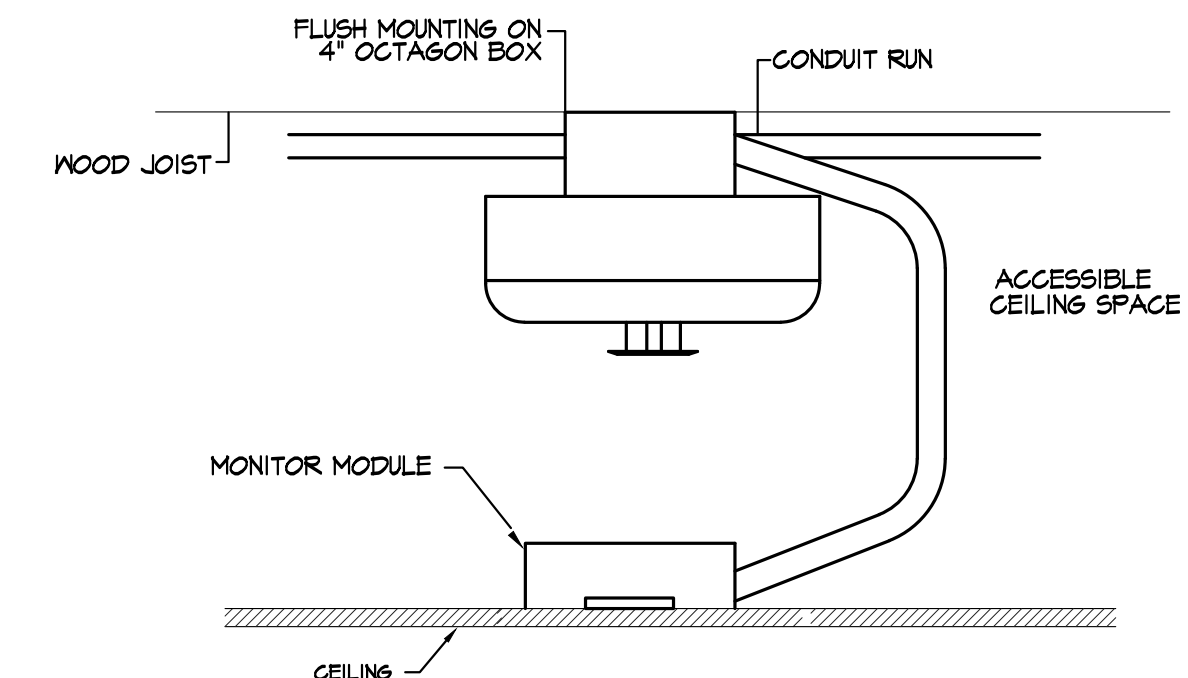


### 4 HEAT DETECTOR MOUNTING DETAIL (ABOVE CEILING)

FA4.1 NOT TO SCALE

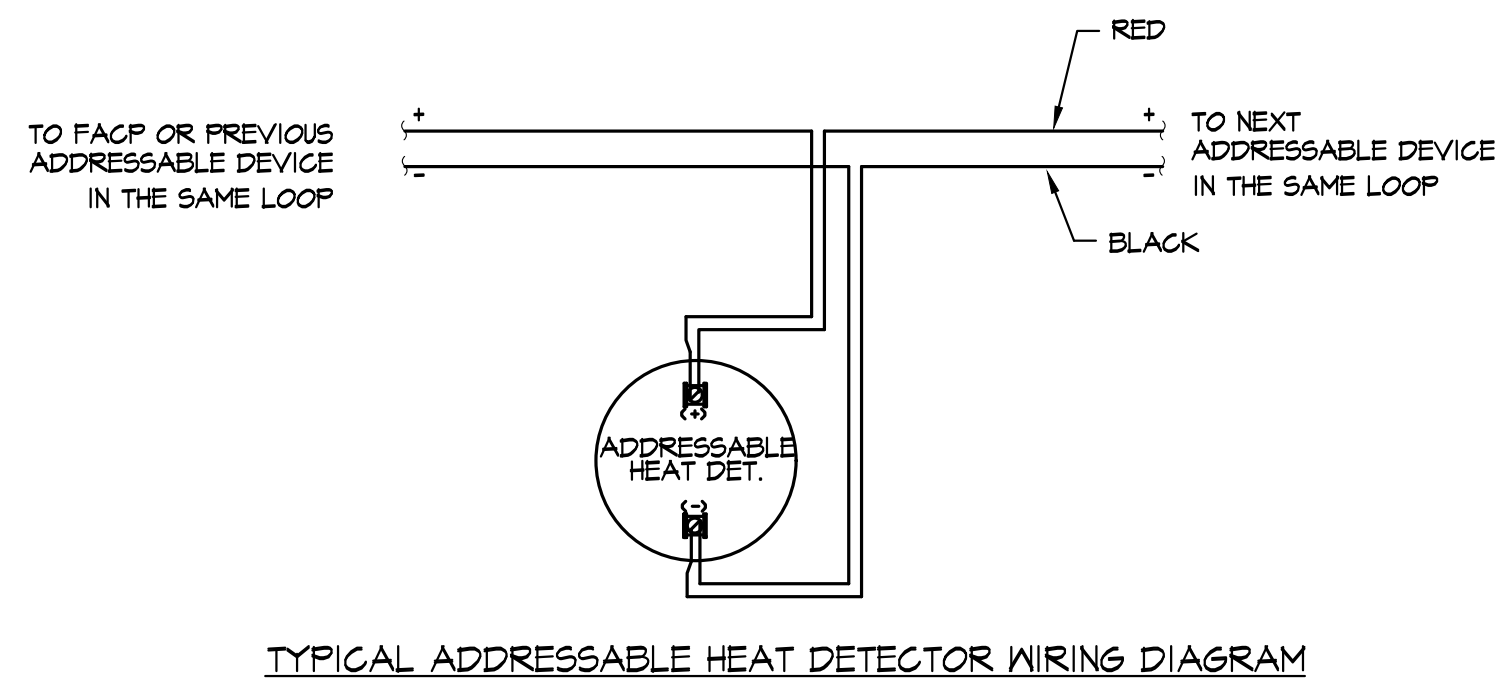


TYPICAL ADDRESSABLE HEAT DETECTOR WIRING DIAGRAM

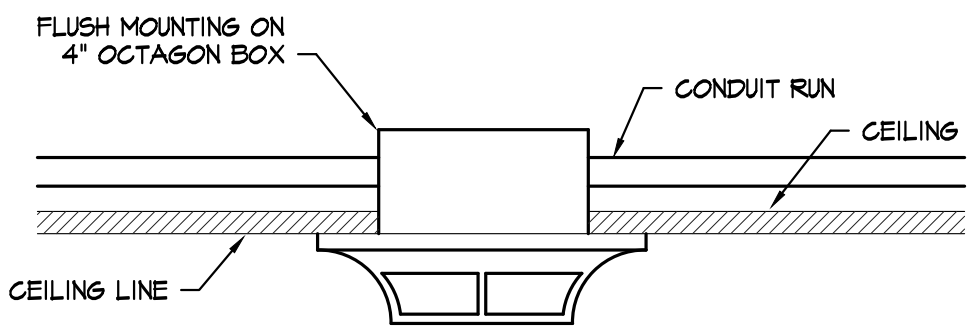


### 5 HEAT DETECTOR MOUNTING DETAIL

FA4.1 NOT TO SCALE

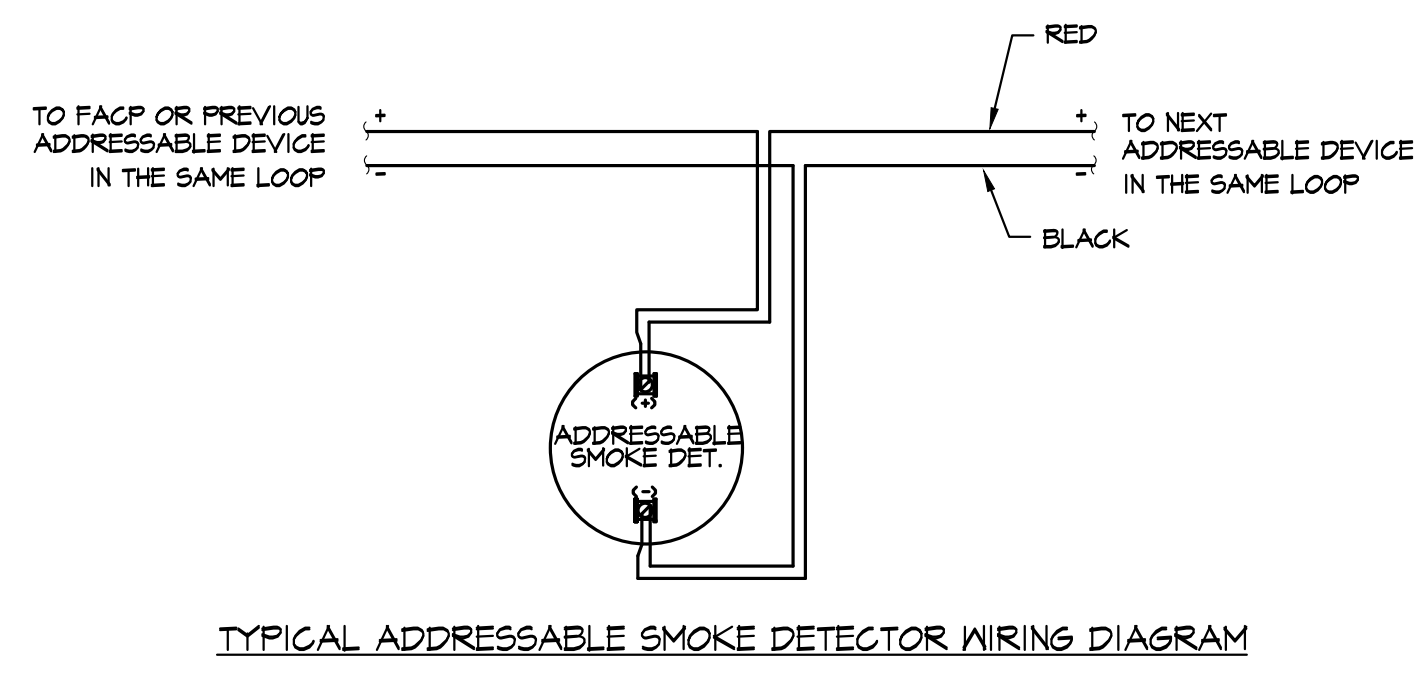


TYPICAL ADDRESSABLE SMOKE DETECTOR WIRING DIAGRAM

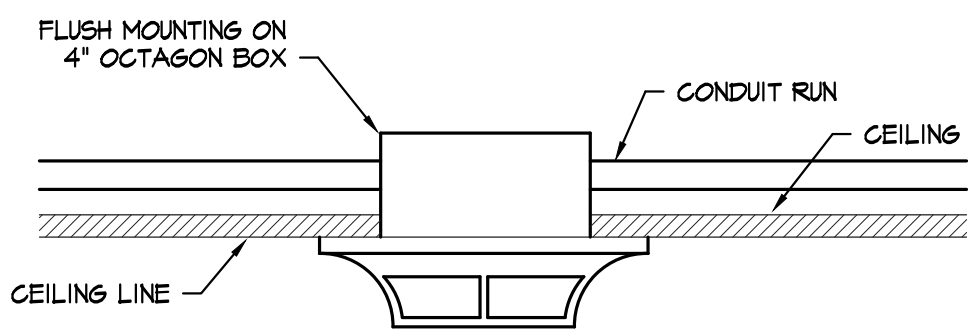


### 6 SMOKE DETECTOR MOUNTING DETAIL

FA4.1 NOT TO SCALE

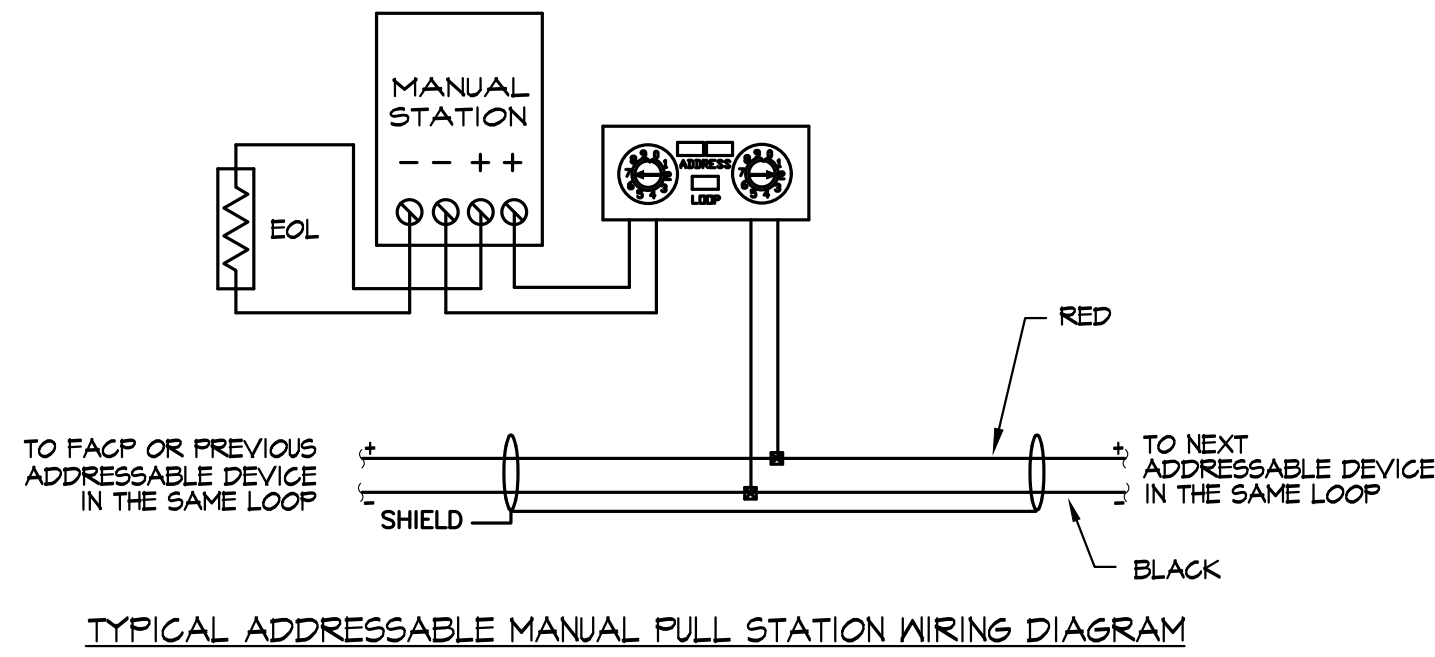


TYPICAL ADDRESSABLE MANUAL PULL STATION WIRING DIAGRAM

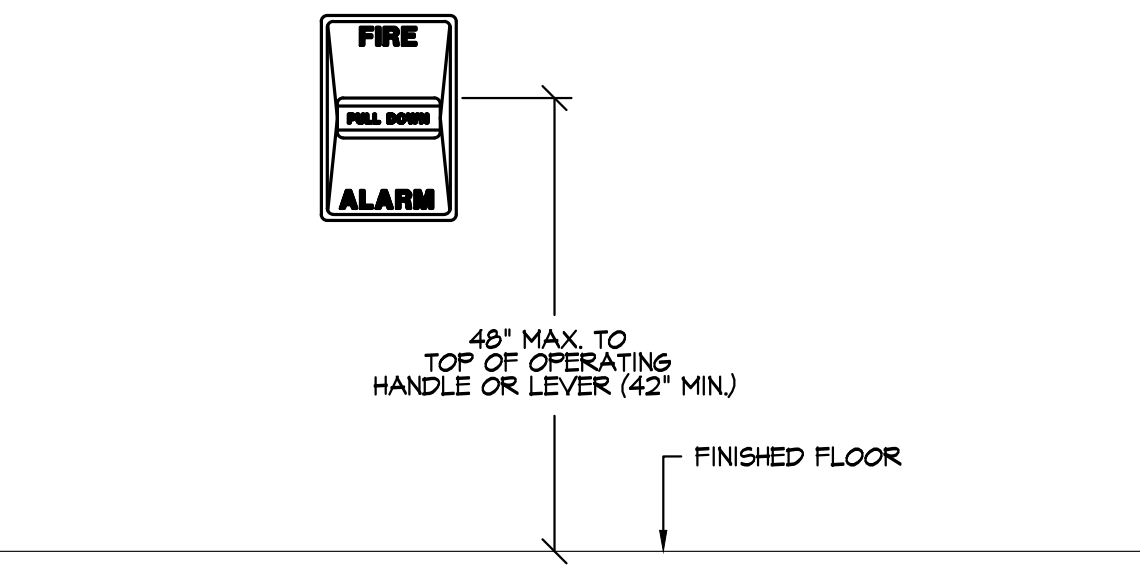

### 7 MANUAL PULL STATION INSTALLATION DETAIL


FA4.1 NOT TO SCALE

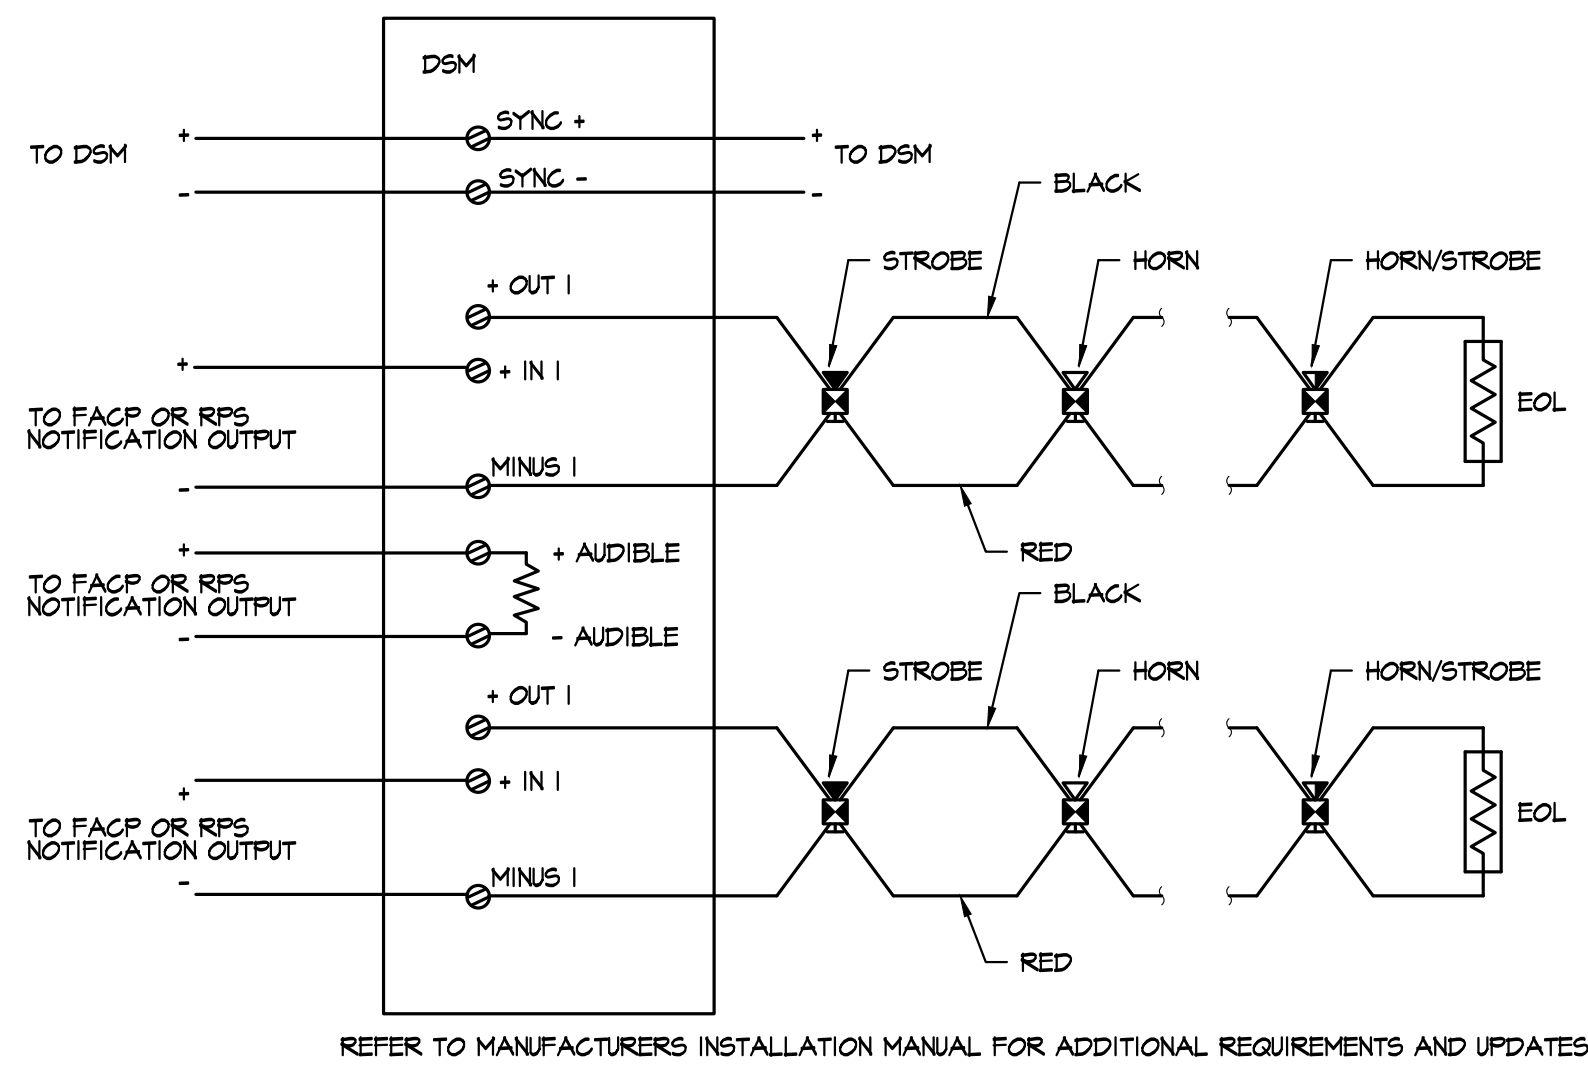

REFER TO MANUFACTURERS INSTALLATION MANUAL FOR ADDITIONAL REQUIREMENTS AND UPDATES

### 8 SYNC MODULE TYPICAL CONNECTION

FA4.1 NOT TO SCALE

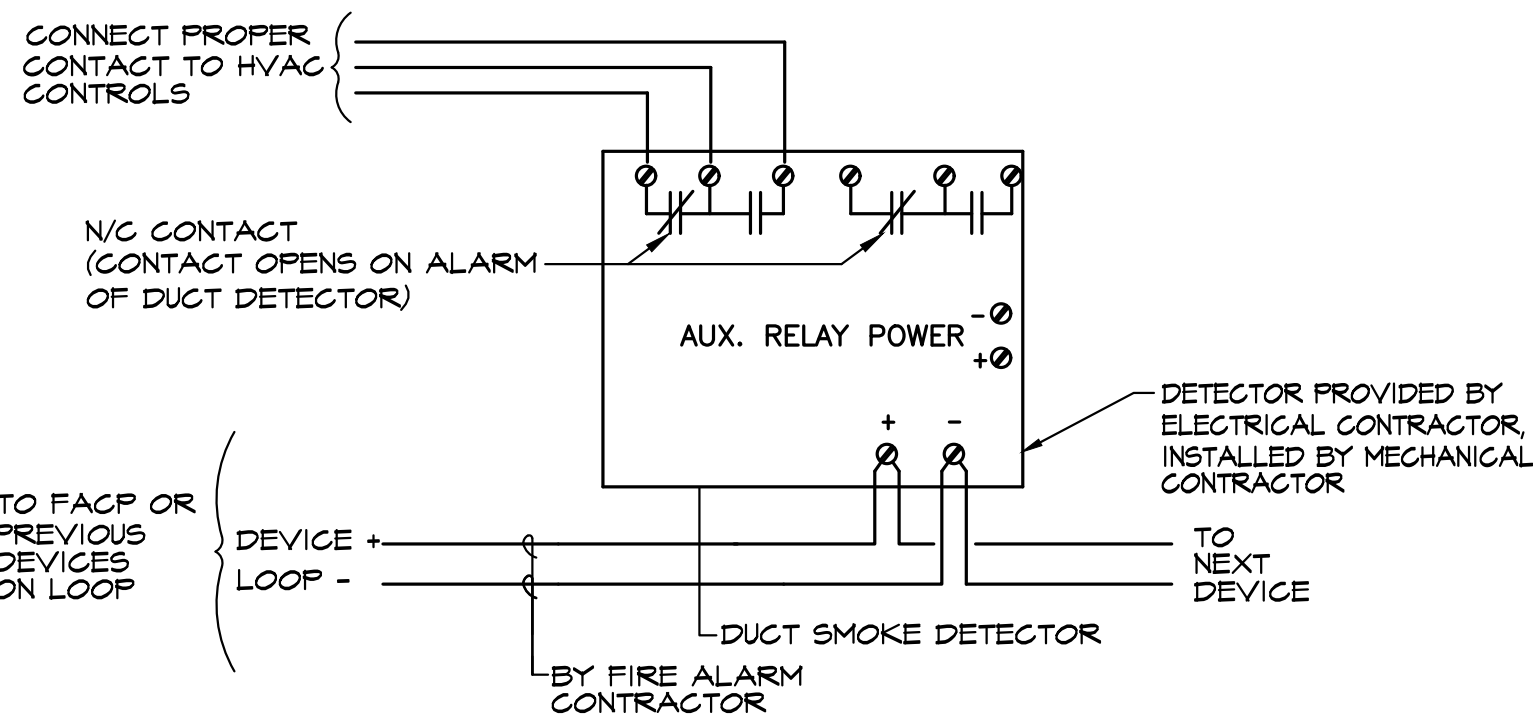

### 9 DUCT SMOKE DETECTOR TYPICAL CONNECTION


FA4.1 NOT TO SCALE

IDENTIFICATION STAMP  
DIV. OF THE STATE ARCHITECT  
APP. 02-118017 INC.  
REVIEWED FOR  
SS ☐ FLS ☐ ACS ☐  
DATE: 04/10/2020



VERDE DESIGN  
LANDSCAPE ARCHITECTURE  
CIVIL ENGINEERING  
SPORT PLANNING & DESIGN  
1843 Iron Point Rd #140  
Folsom, CA 95630  
tel: 916.415.6554  
fax: 408.985.7260  
www.VerdeDesignInc.com

STAMP

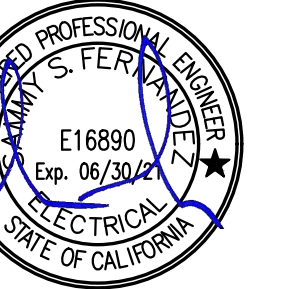


CONSULTANT



American Consulting Engineers  
Electrical, Inc.  
1560 The Hermosa, Suite 200  
San Jose, CA 95128  
JOB # E19148-00

KEYMAP

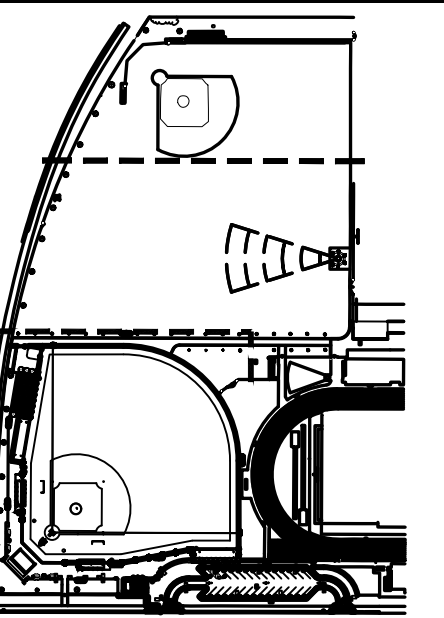

SHEET TITLE

FIRE ALARM  
DETAILS

PROJECT NAME

CHAVEZ HIGH SCHOOL  
STOCKTON USD  
ATHLETIC FACILITY  
IMPROVEMENTS

PROJECT ADDRESS

2929 WINDFLOWER LN  
STOCKTON, CA 95212

| SUBMITTAL               | DATE     |
|-------------------------|----------|
| DD/50% SUBMITTAL        | 10/25/19 |
| DSA SUBMITTAL           | 12/20/19 |
| DSA BACKCHECK SUBMITTAL | 03/27/20 |

| NO. | REVISIONS | DATE |
|-----|-----------|------|
| 1   |           |      |
| 2   |           |      |
| 3   |           |      |
| 4   |           |      |
| 5   |           |      |

|                         |                      |
|-------------------------|----------------------|
| DRAWN BY<br>MG          | CHECKED BY<br>SB/ SF |
| DATE ISSUED<br>03/27/20 | SCALE                |

PROJ. NO.  
1910900-1211

SHEET NO.  
FA4.1 OF #

FIRE ALARM DETAILS



ALL DESIGN, CONSTRUCTION, AND/OR MANUFACTURING INFORMATION IS THE PROPERTY OF VERDE DESIGN, INC. AND WILL BE USED, REPRODUCED, OR PUBLISHED IN WHOLE OR IN PART, OR DISCLOSED TO ANY PERSON, FIRM, OR CORPORATION FOR ANY PURPOSE WITHOUT WRITTEN PERMISSION OF VERDE DESIGN, INC.

## GENERAL NOTES:

### APPLICABLE BUILDING CODE

All construction and workmanship shall conform to the 2016 California Building Code, California Code of Regulations - Title 24, Parts 1 & 2.

This pole and foundation standard has been designed for lateral loads on the completed structure as follows:

- Wind Design Data:
  - Vult = 110 MPH (Exposure C); Vasd = 85 MPH (Exposure C)
  - Risk Category = II
  - See Pole Foundation Schedule for maximum pole wind forces.

### Seismic Design Data:

- le = 1.0
- Risk Category = II (Self Supporting Poles)
- Se = 0.631
- Si = 0.317
- Site Class = D
- Se = 0.647
- Se = 0.374
- Seismic Design Category = D
- Basic Seismic-Force-Resisting System = Non-Building Structure, not similar to buildings
- Cs = 0.390 for 50C, 0.260 for 50D, 0.123 for 70C, 0.153 for 70D, 0.134 for 80C (STRENGTH LEVEL)
- R = 1.5
- D = 1.5
- Analyze Procedure = Equivalent Lateral Force Procedure
- See Pole Foundation Schedule for maximum pole seismic forces.

### GENERAL CONSTRUCTION

These notes shall be used in conjunction with the plans and any discrepancies shall be brought to the attention of the Registered Design Professional (RDP) in Responsible Charge.

Contractor must check all dimensions, clearances and job conditions before starting work. The RDP in Responsible Charge shall be notified immediately of any discrepancies or possible deficiencies.

The drawings and specifications represent the finished structure. All bracing, temporary supports, shoring, etc., is the sole responsibility of the Contractor. Observation visits to the job site by the RDP in Responsible Charge do not include inspection of construction procedures. The Contractor is solely responsible for all construction methods and for safety conditions at the worksite. These visits by RDP in Responsible Charge shall not be construed as continuous and detailed inspections.

Design, material, equipment, and products other than those described below or indicated on the drawings may be considered for use, provided prior approval is obtained from the School District, the RDP in Responsible Charge, and DSA.

All changes to the approved plans after a contract for construction has been awarded, affecting structural, access or life-safety portions of the project, shall be made by means of construction change documents (CCD) approved by DSA, as required by Section 4-338, Part 1, Title 24, CCR. All CCD shall be prepared and signed by the RDP in general Responsible Charge.

Substitutions shall be considered as a CCD and shall be approved by DSA prior to fabrication or use.

A Class 1 or Class 2 Project Inspector employed by the School District (Owner) and approved by DSA shall provide continuous inspection of the work, the duties of the Inspector are defined in Section 4-342, Part 1, Title 24, CCR.

All Tests And Inspections shall be performed by an independent lab employed by the School District and approved by DSA.

Reference pole location on the Architectural, Structural, and/or Electrical drawings for actual pole placement and site location. Pole shall be located 5'-0" min. from adjacent structures below 50'-0" A.G.L., unless noted otherwise.

### LIGHT POLE FOUNDATIONS

Reference geotechnical report prepared by Wallace Kuhl & Associates, Dated September 11, 2019; Project no. 12435-01P.

Allowable Vertical soil Capacity - 3,000 PSF (End Bearing).

Allowable Lateral Bearing capacity: 250 PSF/FT. Upper 12 inches of soil should be neglected.

A representative of Wallace Kuhl & Associates should be available at the time of the foundation installation to verify the soil design parameters and to provide assistance if any problems arise in foundation installation.

The Contractor must familiarize himself with the complete geotechnical report, and borings and contact the above firm to understand the soil conditions and the possibility of ground water pumping and excavation stabilization or bracing during the foundation installation and placement of concrete.

Soil formations that will require special design considerations or excavation procedures may exist. Pole foundations may need to be redesigned according to the soil conditions that exist.

If any discrepancies or inconsistencies arise, notify the RDP in Responsible Charge of such discrepancies.

All piers and concrete must bear on and against firm undisturbed soil as determined by the Geotechnical Engineer.

Place plywood collar around perimeter at the top of foundation excavation to prevent soil from entering.

All excavations must be free of loose soil, and debris prior to foundation installation and placement of concrete. Coating or drilling slurry may be required if caving occurs. Review and approval of the Geotechnical Engineer and DSA is required.

All excavations must be free of water or concrete shall be placed by the Tremie Method in accordance with ACI standard 336. Concrete placed by the Tremie Method shall have a minimum ultimate strength of 1,000 PSI greater than required under "Concrete Cast-in-Place" and a maximum slump of 8".

### CONCRETE (CAST-IN-PLACE)

Concrete backfill without steel reinforcement shall attain a minimum ultimate compressive strength at 28 day test of 3,000 psi. Batch plant inspection not required.

All concrete shall attain a minimum strength of 2,500 psi prior to steel pole erection.

Use Type II/IV Portland cement or as directed by the Geotechnical Engineer.

Portland Cement ASTM C-150.

Aggregate ASTM C-33. 1" maximum aggregate size. 3/8" max agg. size acceptable where pump mixes are used at unreinforced concrete backfill.

Mix in conformance with ASTM C-94, ACI 318 SECTIONS 19.2 and 26.4.

Place concrete immediately after completion of excavation and inspection by the Geotechnical Engineer and the DSA Inspector. Under no circumstances shall piers be allowed to remain open for more than 12 hours without the approval of the Geotechnical Engineer. Excavations shall be covered and protected until filled with concrete.

Concrete shall be placed in one continuous operation (no construction joint) with special equipment to assure a maximum freal of 5 ft and to prevent concrete from striking the sides of the excavation. Freefall of concrete is unacceptable through water or drilling slurry.

Vibrate concrete full depth, except for concrete with slump greater than 6", then vibrate only upper 10'-0". Concrete placed under water shall have a slump of 6"-8".

### STEEL POLE

Steel pole sections conform to the California Code of Regulations T.24, Part 2, Chapter 22A.

All steel conforms to referenced ASTM specifications. (See Pole Data Table for each pole type).

All weldment conforms with AWS D1.1-10 specification for GMAW fillet utilizing E70S-X filler metal or SAW fillet utilizing E7XX-EXXX or F8XX-EXXX filler metal. GMAW procedure conforms to AWS A5.18. SAW procedure conforms to AWS A5.23.

Longitudinal seam welds for pole sections shall have 60% minimum penetration; Except longitudinal seam welds on the female section of telescopic field splices shall be full penetration groove welds for a length equal to the minimum splice length plus 6 inches. See drawing number MD1 for seam weld details.

Pole sections hot dipped galvanized to ASTM A123 latest standards.

All miscellaneous structural steel items conform to AISC 360-10.

Steel pole sections shall be assembled in the field by attaching two 1.5 ton "come alongs" to jacking ears, using full effort on each simultaneously, to ensure minimum overlaps as indicated on the "MS" sheet(s) and detail G/MD1.

### PRECAST BASE

The precast concrete base conforms to California Code of Regulations, T.24, part 2, Chapter 19A and to Building Code Requirements for Reinforced Concrete, ACI 318-14.

See detail "A" on "MS" sheet(s) for material strengths and specifications.

### TESTING AND INSPECTION

Testing and inspection in accordance with Title 24, Part 1 & Part 2.

EXCAVATIONS & FOUNDATIONS:  
Inspection of cast-in-place deep foundations - 1705A.8 & Table 1705A.8

CONCRETE MATERIALS: 1903A.1  
Portland cement - 1910A.1  
Concrete aggregates - 1903A.5  
Prestressing steel and anchorages - 1910A.3

CONCRETE QUALITY:  
Proportions of concrete - Reference ACI 318 Section 26.4.3.1 Through 26.4.4.1.  
Strength tests of concrete - 1905A.1.6 and ACI 318 Section 26.12 & 26.5.3.2.

CONCRETE INSPECTION: 1705A.3 & Table 1705A.3  
Job site - Reference ACI 318 Section 26.5.1, 26.5.2.1(a) & (b), 26.6.1.2(d), 26.11.1.1(a).  
Batch Plant Inspection Not Required - 1705A.3.3.2 & 1705A.3.3.1.  
Prestressed concrete - 1704A.2.5, 1705A.3.4.

STEEL MATERIALS:  
Structural steel - 2203A.1 & 2205A.1  
Cold formed steel - 2210A.1  
Identification - 2203A.1  
High strength bolt identification - table 1705A.2.1 & DSA IR 17-9


STEEL QUALITY:  
Tests of structural steel & cold formed steel - 2203A.1  
Tests of high strength bolts, nuts, & washers - 2213A.1 & DSA IR 17-8  
Non-destructive weld tests - 1705A.2.5 & DSA IR-17-2

STRUCTURAL STEEL INSPECTIONS: Table 1705A.2.1  
Shop fabrication inspection - 1704A.2.5  
Welding - 1705A.2.5, DSA IR 17-3 and AWS D1.1.  
High strength bolt installation - Table 1705A.2.1 & DSA IR 17-9  
(Including Skidmore-Wilhelm bolt tension pre-installation verification testing)  
(NOTE: ALL WELDING SHALL BE CONTINUOUSLY INSPECTED BY AN AWS CW CERTIFIED INSPECTOR APPROVED BY DSA)

These plans are for construction approval. An application number and approval of these drawings by the Division of The State Architect of California must be secured to build from these plans.

## INDEX OF SHEETS

|     |                          |
|-----|--------------------------|
| MT1 | NOTES, FOUNDATION DETAIL |
| MS1 | 70C POLE DETAILS         |
| MS2 | 70D POLE DETAILS         |
| MS3 | 80C POLE DETAILS         |
| MD1 | ATTACHMENT DETAILS       |
| MD2 | ATTACHMENT DETAILS       |
| MD3 | ATTACHMENT DETAILS       |

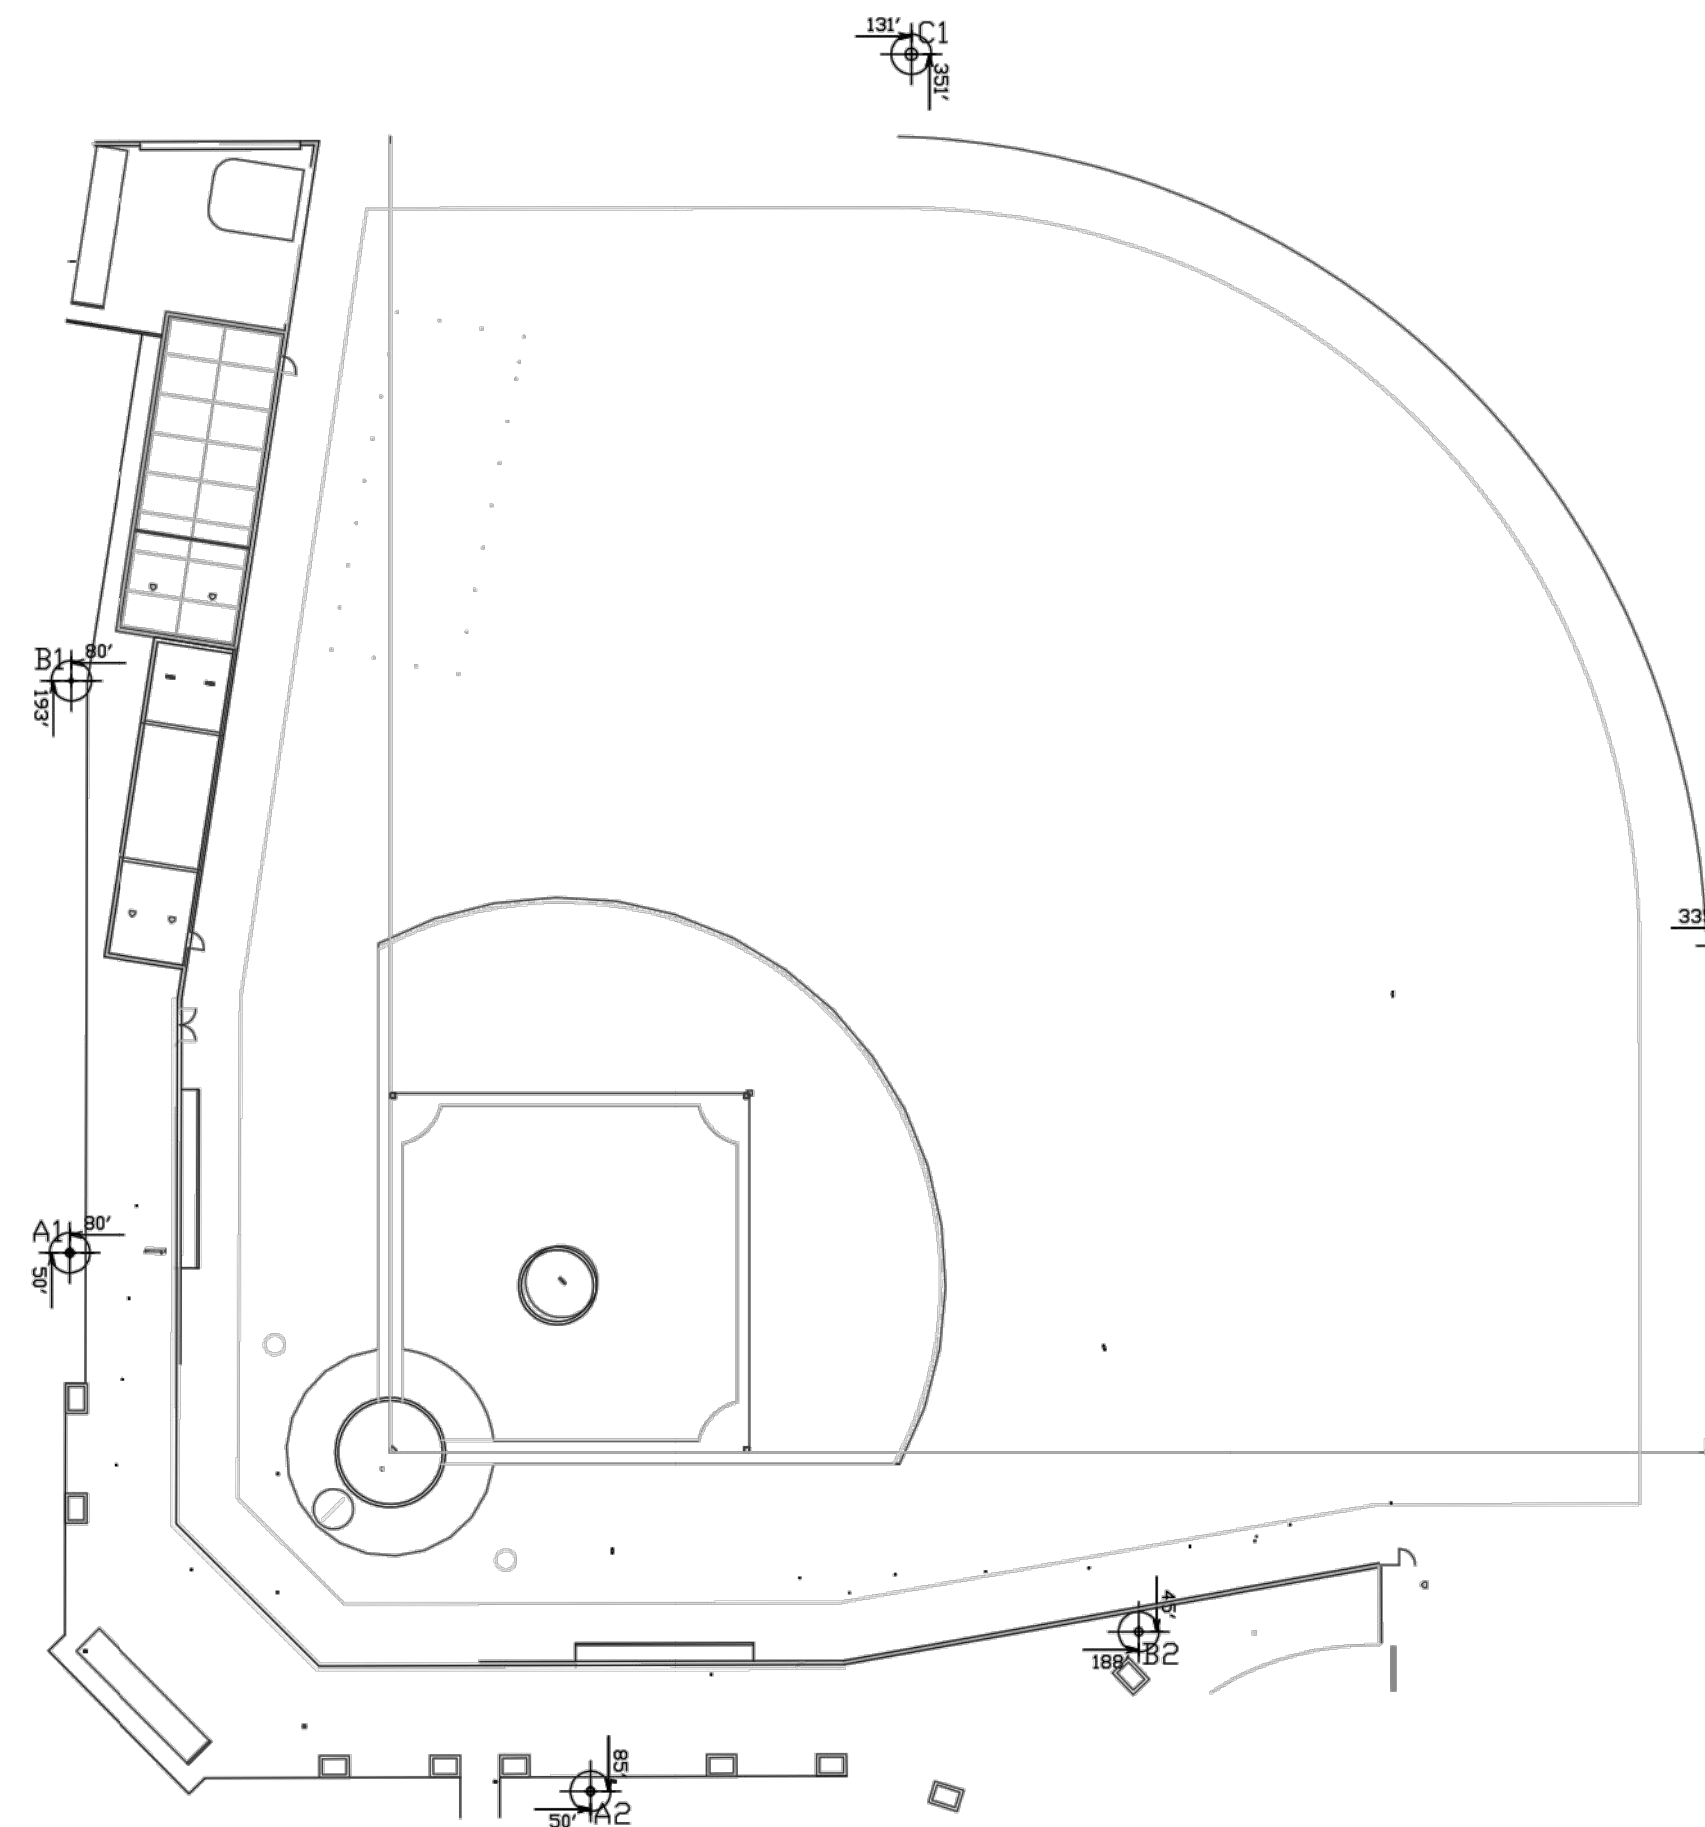


POLE ORIENTATION PLAN  
N.T.S.

NOTE: THIS PLAN IS A PICTORIAL REPRESENTATION OF THE SITE LAYOUT.  
REFERENCE APPROPRIATE ARCHITECTURAL SITE PLAN FOR ALL  
NECESSARY INFORMATION.

Information contained herein is the confidential property of Musco Sports Lighting, LLC and/or its parent companies, affiliates, successors and assigns. Reproduction, distribution, or use of the information other than its limited, intended purpose without express written permission is prohibited.

Musco products referenced or shown are protected by one or more of the following patents. U.S. Patents: 4947303; 4994718; 5075828; 5134557; 5161883; 5211473; 5229681; 5377611; 5398478; 5423281; 5426577; 5600537; 5794387; 5856721; 6026338; 6203176; 6250596; 6340790; 6398392; 6681110; 6833675; 6929385; 6969034; 6988697; 7059572; D337168; D353797; D353911; D411096. Other patents pending.

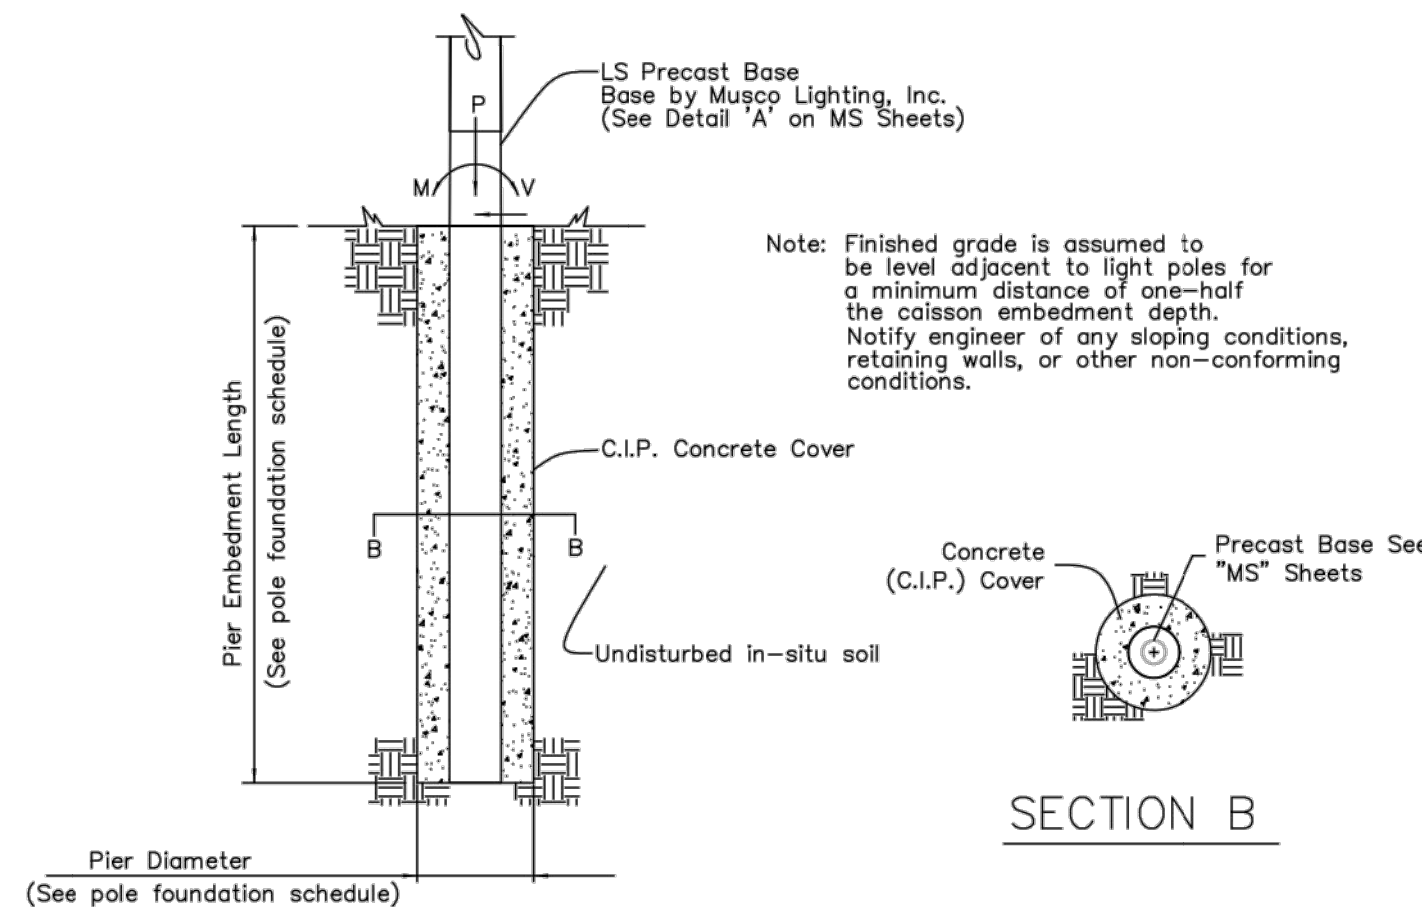

FOUNDATION DETAIL  
N.T.S.

## POLE FOUNDATION SCHEDULE

| POLE TYPE-# OF FIXTURES (MAX) (LSS=LIGHT STRUCTURE) | MARK (SEE POLE ORIENTATION PLAN) | WIND OR SEISMIC (SEISMIC FORCE INCLUDES OVERSTRENGTH FACTOR=1.5) | ASD LEVEL FORCES (MAX) |               |                    | C.I.P. DEEP FOUNDATION |                | PRECAST BASE |
|---|----------------------------------|--|------------------------|---------------|--------------------|------------------------|----------------|--------------|
|   |                                  |  | MOMENT (M) FT-LBS*     | SHEAR (V) LBS | VERTICAL (P) LBS** | DIAMETER INCHES        | EMBEDMENT FEET |              |
| LSS70C-4  | A1, A2                           | SEISMIC  | 22,100                 | 468           | 3,634              | 30"                    | 14'-6"         | 14'-6"       |
|   |                                  | WIND   | 78,200                 | 1,709         | 2,243              |                        |                |              |
| LSS70D-6  | C1, C2                           | SEISMIC  | 37,800                 | 797           | 4,979              | 36"                    | 16'-0"         | 16'-0"       |
|   |                                  | WIND   | 93,600                 | 2,047         | 3,217              |                        |                |              |
| LSS80C-7  | B1, B2                           | SEISMIC  | 48,700                 | 940           | 6,699              | 36"                    | 18'-0"         | 18'-0"       |
|   |                                  | WIND   | 140,900                | 2,704         | 4,119              |                        |                |              |

\*Moment (M) computed below grade at Shear (V) = 0.

\*\*Vertical (P) load includes steel pole, light fixtures, and attachments. Vertical (P) load for wind is the dressed pole weight for erection purposes. Vertical (P) load for seismic also includes weight of precast base above groundline. Reference Detail "A" on MS Sheet(s) for precast base weight.

Cesar Chavez HS Baseball  
FIELD LIGHTING  
Stockton, CA



**MUSCO**  
Lighting  
CORPORATE OFFICE:  
P.O. Box 808  
100 1st Avenue West  
Oskaloosa, Iowa 52577  
800/825-6020

DRAWING TITLE:  
NOTES, FOUNDATION DETAIL

PROJECT NO.  
201787

DATE:  
03/20/2020


DRAWN BY:  
K.Butterbaugh

DRAWING NO.  
1 OF 7

MT1

DSA-TITLE1\_E

IDENTIFICATION STAMP  
DIV. OF THE STATE ARCHITECT  
APP. 02-118017 INC.  
REVIEWED FOR  
SS ☐ FLS ☐ ACS ☐  
DATE: 04/10/2020

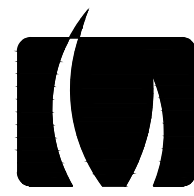

**VERDE DESIGN**  
LANDSCAPE ARCHITECTURE  
CIVIL ENGINEERING  
SPORT PLANNING & DESIGN

1843 Iron Point Rd #140  
Folsom, CA 95630  
tel: 916.415.6554  
fax: 408.985.7260  
www.VerdeDesignInc.com

STAMP

CONSULTANT

KEYMAP

SHEET TITLE  
**NOTES,  
FOUNDATION DETAIL**

PROJECT NAME  
**CHAVEZ HIGH SCHOOL  
STOCKTON USD  
ATHLETIC FACILITY  
IMPROVEMENTS**

PROJECT ADDRESS  
**2929 WINDFLOWER LN  
STOCKTON, CA 95212**

| SUBMITTAL               | DATE     |
|-------------------------|----------|
| DD/50% SUBMITTAL        | 10/25/19 |
| DSA SUBMITTAL           | 12/20/19 |
| DSA BACKCHECK SUBMITTAL | 03/27/20 |

| NO. | REVISIONS | DATE |
|-----|-----------|------|
| △   |           |      |
| △   |           |      |
|                           |                    |
|---------------------------|--------------------|
| DRAWN BY:<br>-            | CHECKED BY:<br>CS  |
| DATE ISSUED:<br>03/27/20  | SCALE:<br>AS NOTED |
| PROJ. NO.<br>1910900-1211 |                    |
| SHEET NO.<br>MT1          | # OF #             |

NOTES, FOUNDATION DETAIL



[illegible]

|                           |                   |
|---------------------------|-------------------|
| DRAWN BY<br>-             | CHECKED BY<br>CS  |
| DATE ISSUED<br>03/27/20   | SCALE<br>AS NOTED |
| PROJ. NO.<br>1910900-1211 |                   |
| SHEET NO.<br>MS1          |                   |



PROJECT NO. 201787

DATE: 03/20/2020

DRAWN BY: K.Butterbaugh

DRAWING NO. MS1  
2 OF 7












ALL DESIGN, CONSTRUCTION, AND/OR INSTALLATION OF THIS PROJECT OR ANY PART THEREOF IS THE PROPERTY OF VERDE DESIGN, INC. AND WILL BE USED, REPRODUCED, OR PUBLISHED IN WHOLE OR IN PART, OR DISCLOSED TO ANY PERSON, FIRM, OR CORPORATION FOR ANY PURPOSE WITHOUT WRITTEN PERMISSION OF VERDE DESIGN, INC. VERDE DESIGN, INC. IS NOT RESPONSIBLE FOR ANY DAMAGE TO PERSONS OR PROPERTY CAUSED BY THE USE OF THIS PROJECT OR ANY PART THEREOF.

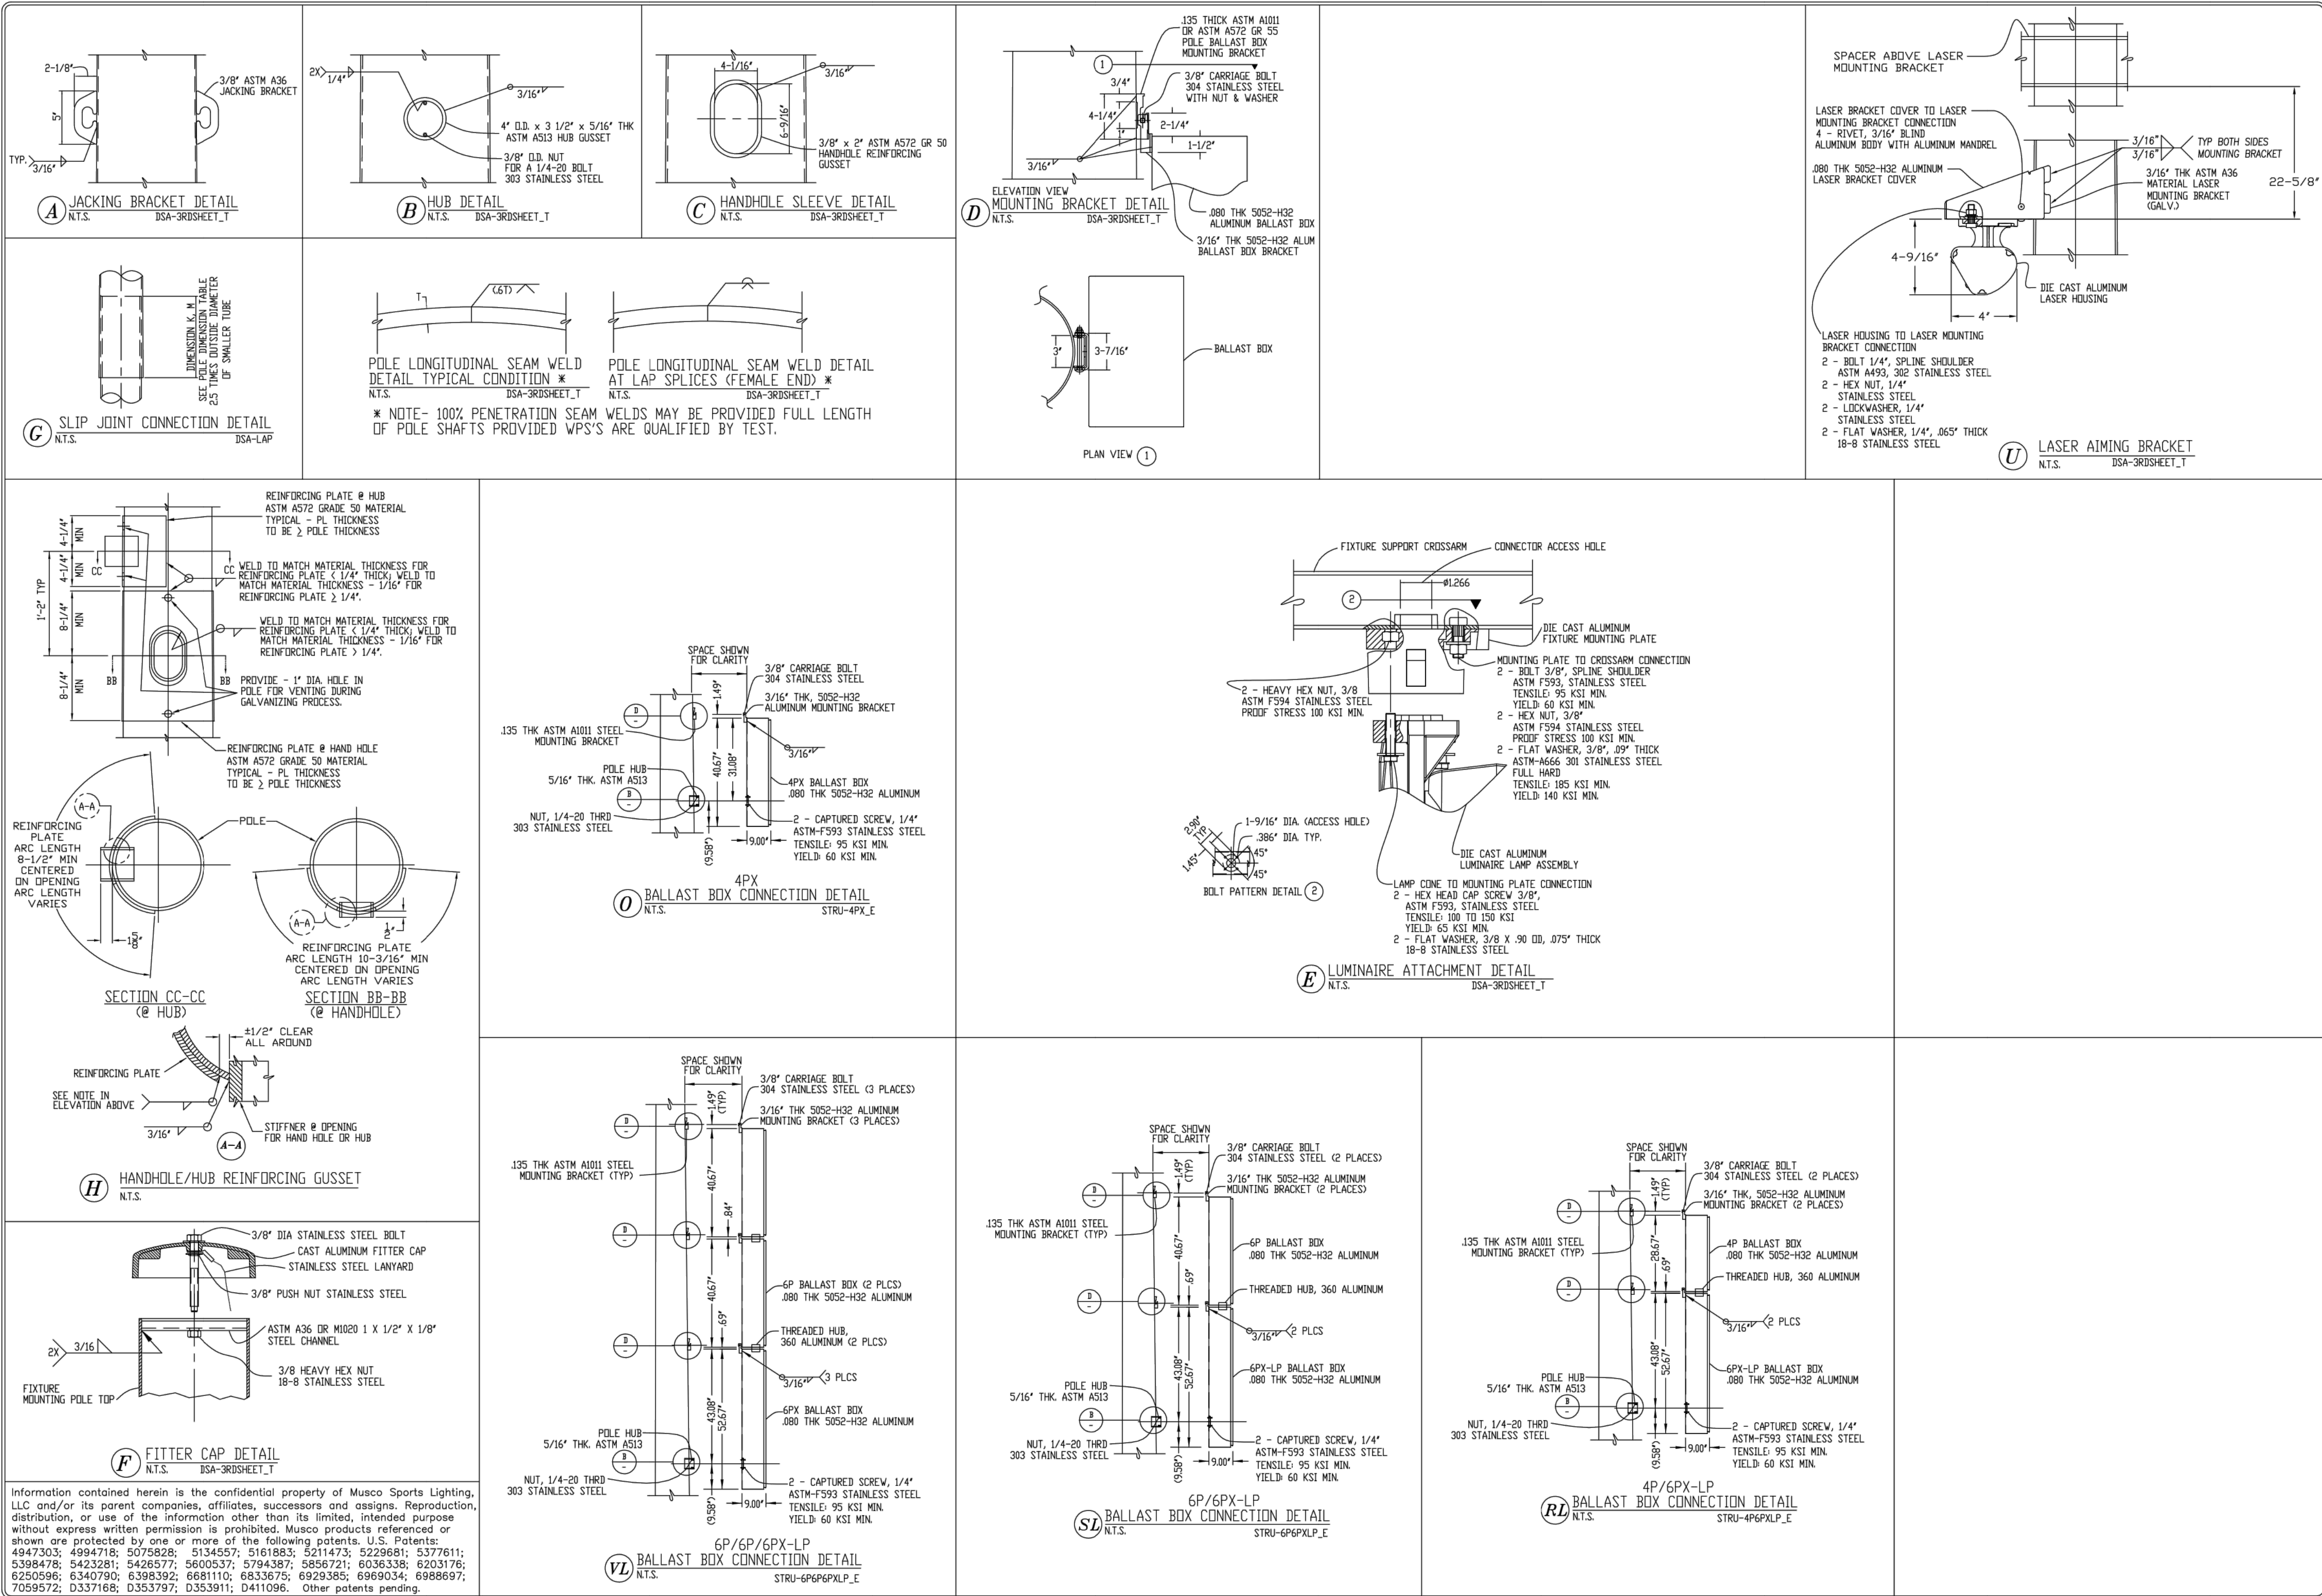

IDENTIFICATION STAMP  
DIV. OF THE STATE ARCHITECT  
APP. 02-118017 INC.  
REVIEWED FOR  
SS ☐ FLS ☐ ACS ☐  
DATE: 04/10/2020

**VERDE DESIGN**  
LANDSCAPE ARCHITECTURE  
CIVIL ENGINEERING  
SPORT PLANNING & DESIGN  
1843 Iron Point Rd #140  
Folsom, CA 95630  
tel: 916.415.6554  
fax: 916.985.7260  
www.VerdeDesignInc.com

STAMP

CONSULTANT

KEYMAP

SHEET TITLE  
ATTACHMENT DETAILS

PROJECT NAME  
CHAVEZ HIGH SCHOOL  
STOCKTON USD  
ATHLETIC FACILITY  
IMPROVEMENTS

PROJECT ADDRESS  
2929 WINDFLOWER LN  
STOCKTON, CA 95212

| SUBMITTAL               | DATE     |
|-------------------------|----------|
| DD/50% SUBMITTAL        | 10/25/19 |
| DSA SUBMITTAL           | 12/20/19 |
| DSA BACKCHECK SUBMITTAL | 03/27/20 |

| NO. | REVISIONS | DATE |
|-----|-----------|------|
| △   |           |      |
| △   |           |      |
| DRAWN BY | CHECKED BY |
|----------|------------|
| -        | CS         |

| DATE ISSUED | SCALE    |
|-------------|----------|
| 03/27/20    | AS NOTED |

| PROJ. NO.    | SHEET NO. |
|--------------|-----------|
| 1910900-1211 | MD1       |

# OF #

SCALE: SEE PLAN

BRANING TITLES  
ATTACHMENT DETAILS

REVISIONS

REFERENCE


PROJECT NO.  
201787

DATE  
03/20/2020

DRAWN BY  
K.Butterbaugh

DRAWING NO.  
MD1



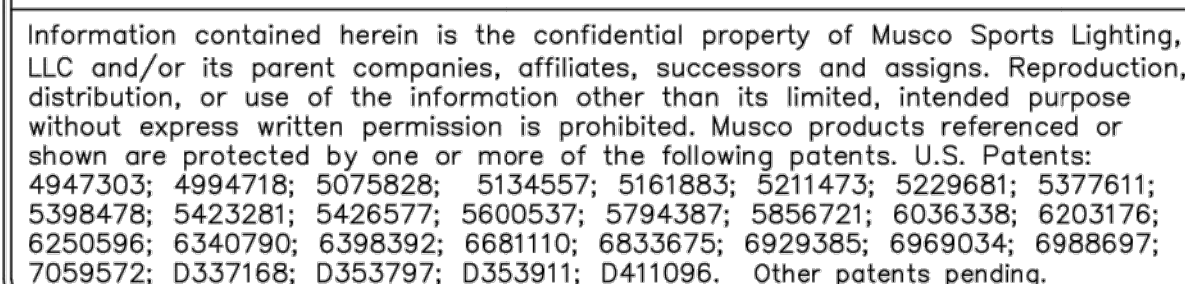

| FORMING TITLE      |  | COALES        | SEE PLAN |
|--------------------|--|---------------|----------|
| ATTACHMENT DETAILS |  |               |          |
| REV/ISSUING        |  |               |          |
| REFERENCE          |  |               |          |
| PROJECT NO.        |  | 201787        |          |
| DATE               |  | 03/20/2020    |          |
| DRAWN BY           |  | K.Butterbaugh |          |
| DRAWING NO.        |  | MD2           |          |
| 6 OF 7             |  |               |          |

|             |               |
|-------------|---------------|
| PROJECT NO. | 201787        |
| DATE:       | 03/20/2020    |
| DRAWN BY:   | K.Butterbaugh |
| DRAWING NO. | MD2           |
| 6 OF 7      |               |



STAMP

CONSULTANT

## KEYMAI

SHEET TITLE

ATTACHMENT DETAILS

PROJECT NAME

CHAVEZ HIGH SCHOOL  
STOCKTON USD  
ATHLETIC FACILITY  
IMPROVEMENTS

PROJECT ADDRESS



2929 WINDFLOWER LN  
STOCKTON, CA 95212

[illegible]

|                         |                   |
|-------------------------|-------------------|
| DATE ISSUED<br>03/27/20 | SCALE<br>AS NOTED |
|-------------------------|-------------------|


PROJ. NO. 1910900-1211

SHEET NO. **MD3** # OF #

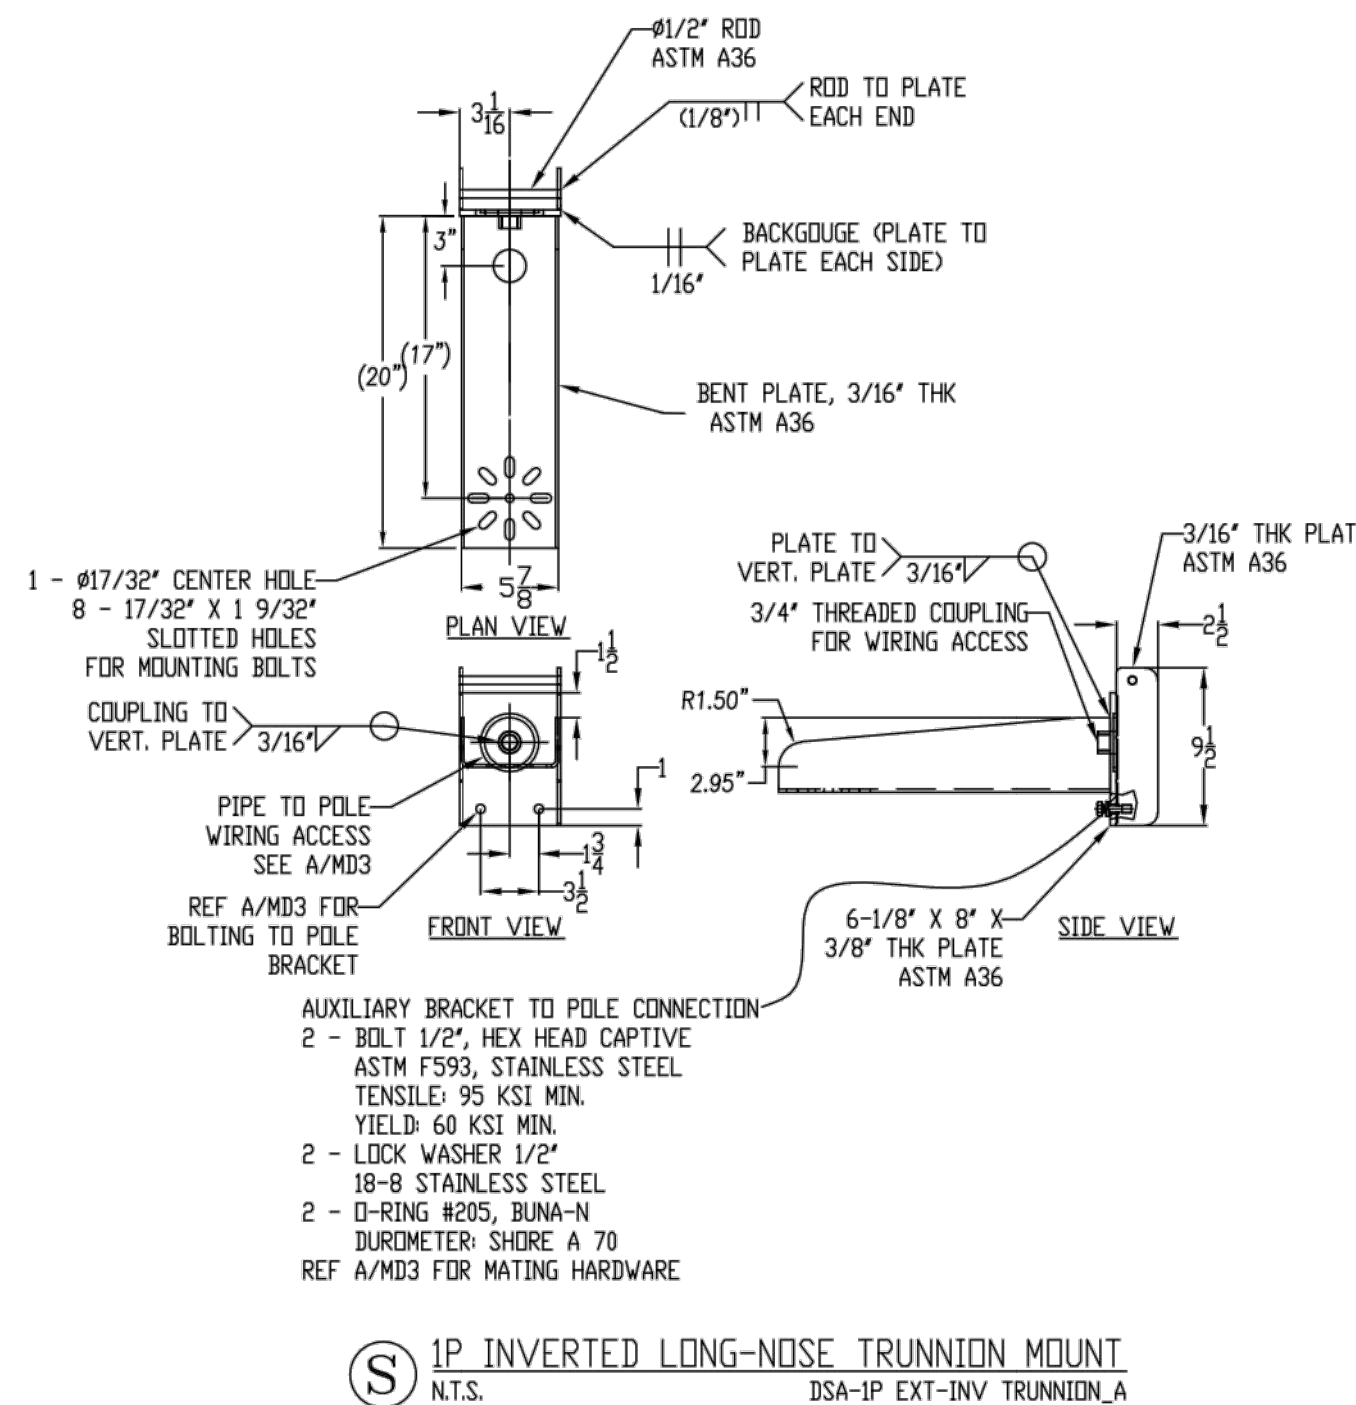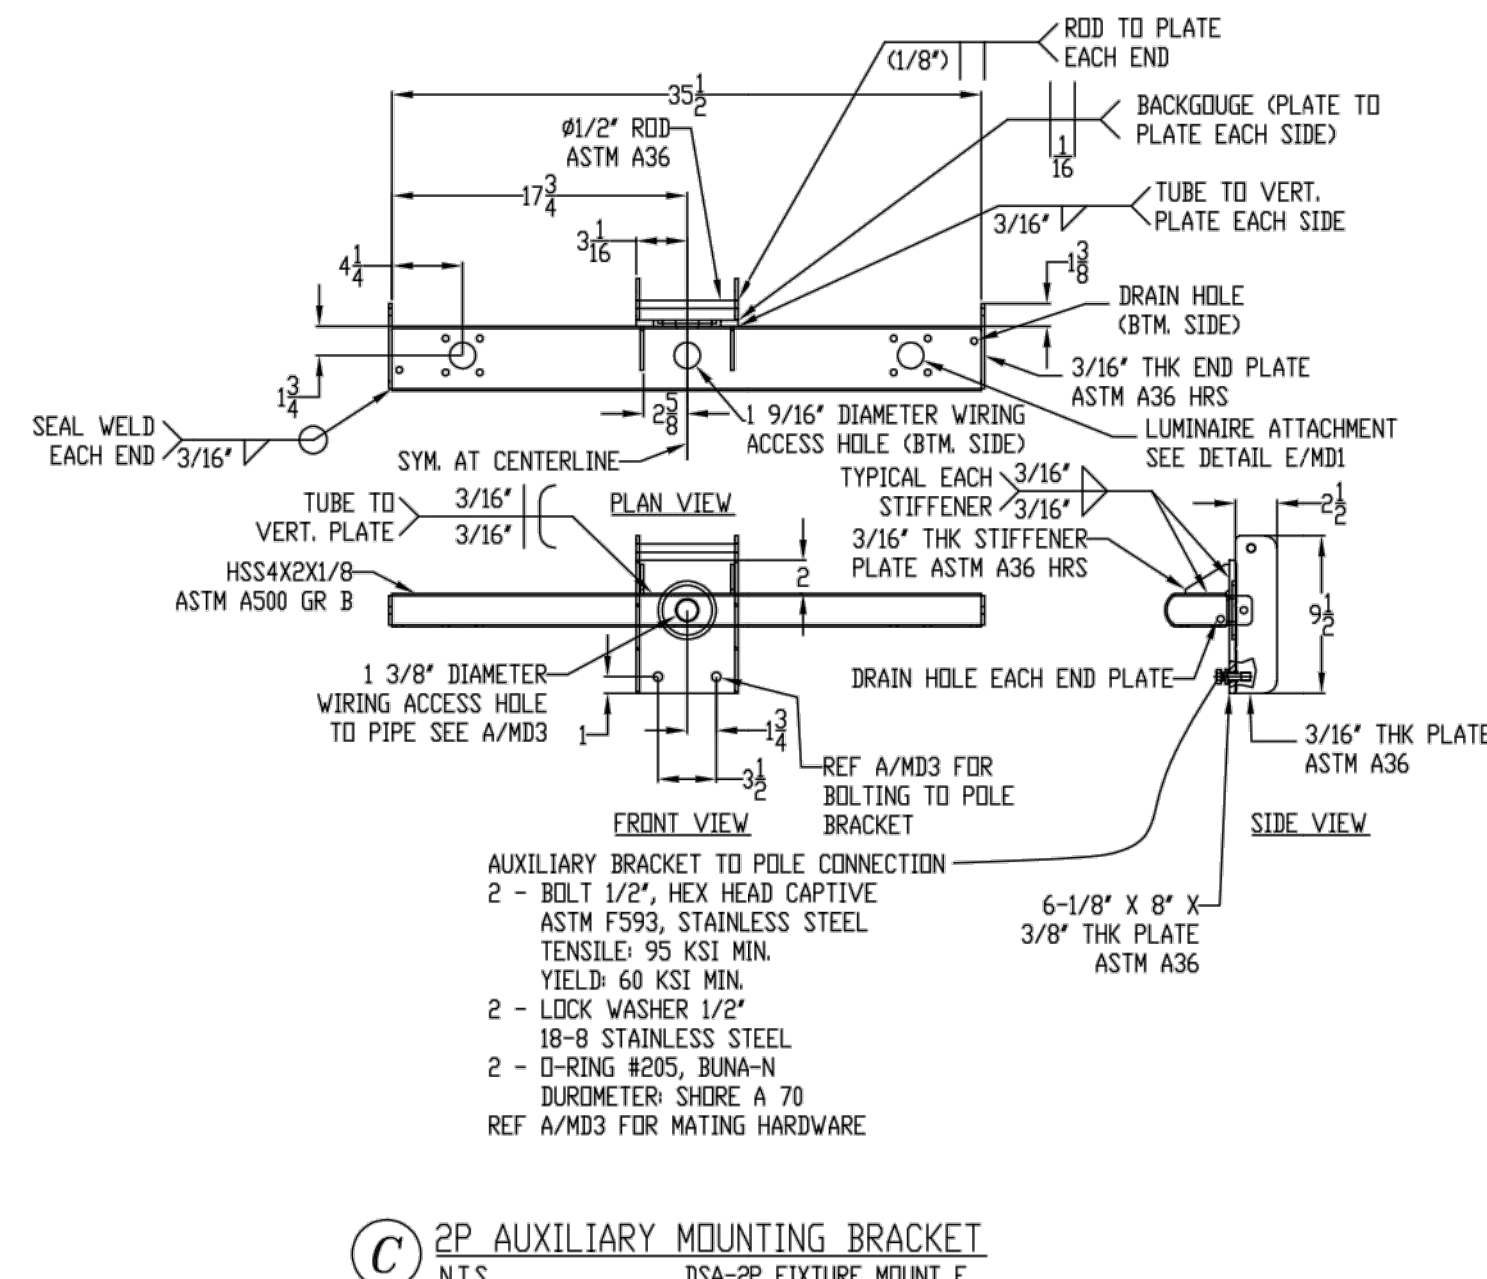

Information contained herein is the confidential property of Musco Sports Lighting, LLC and/or its parent companies, affiliates, successors and assigns. Reproduction, distribution, or use of the information other than its limited, intended purpose without express written permission is prohibited. Musco products referenced or shown are protected by one or more of the following patents, U.S. Patents: 49947303; 49947618; 5075828; 5134587; 5161883; 5214743; 5229681; 5377611; 5424232; 5424233; 5424234; 5424669; 5424

Cesar Chavez HS Baseball  
FIELD LIGHTING  
Stockton, CA

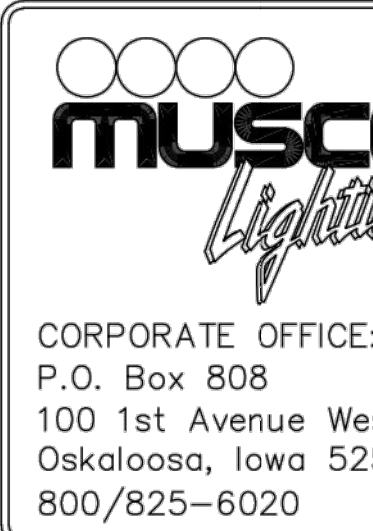

DRAWING TITLE: SCALE: SEE PLAN  
ATTACHMENT DETAILS

PROJECT NO. 201787

DATE: 03/20/2020

DRAWN BY: K. Butterbaugh


DRAWING NO. M









SCOREBOARD & WORKSHEET EXAMPLES

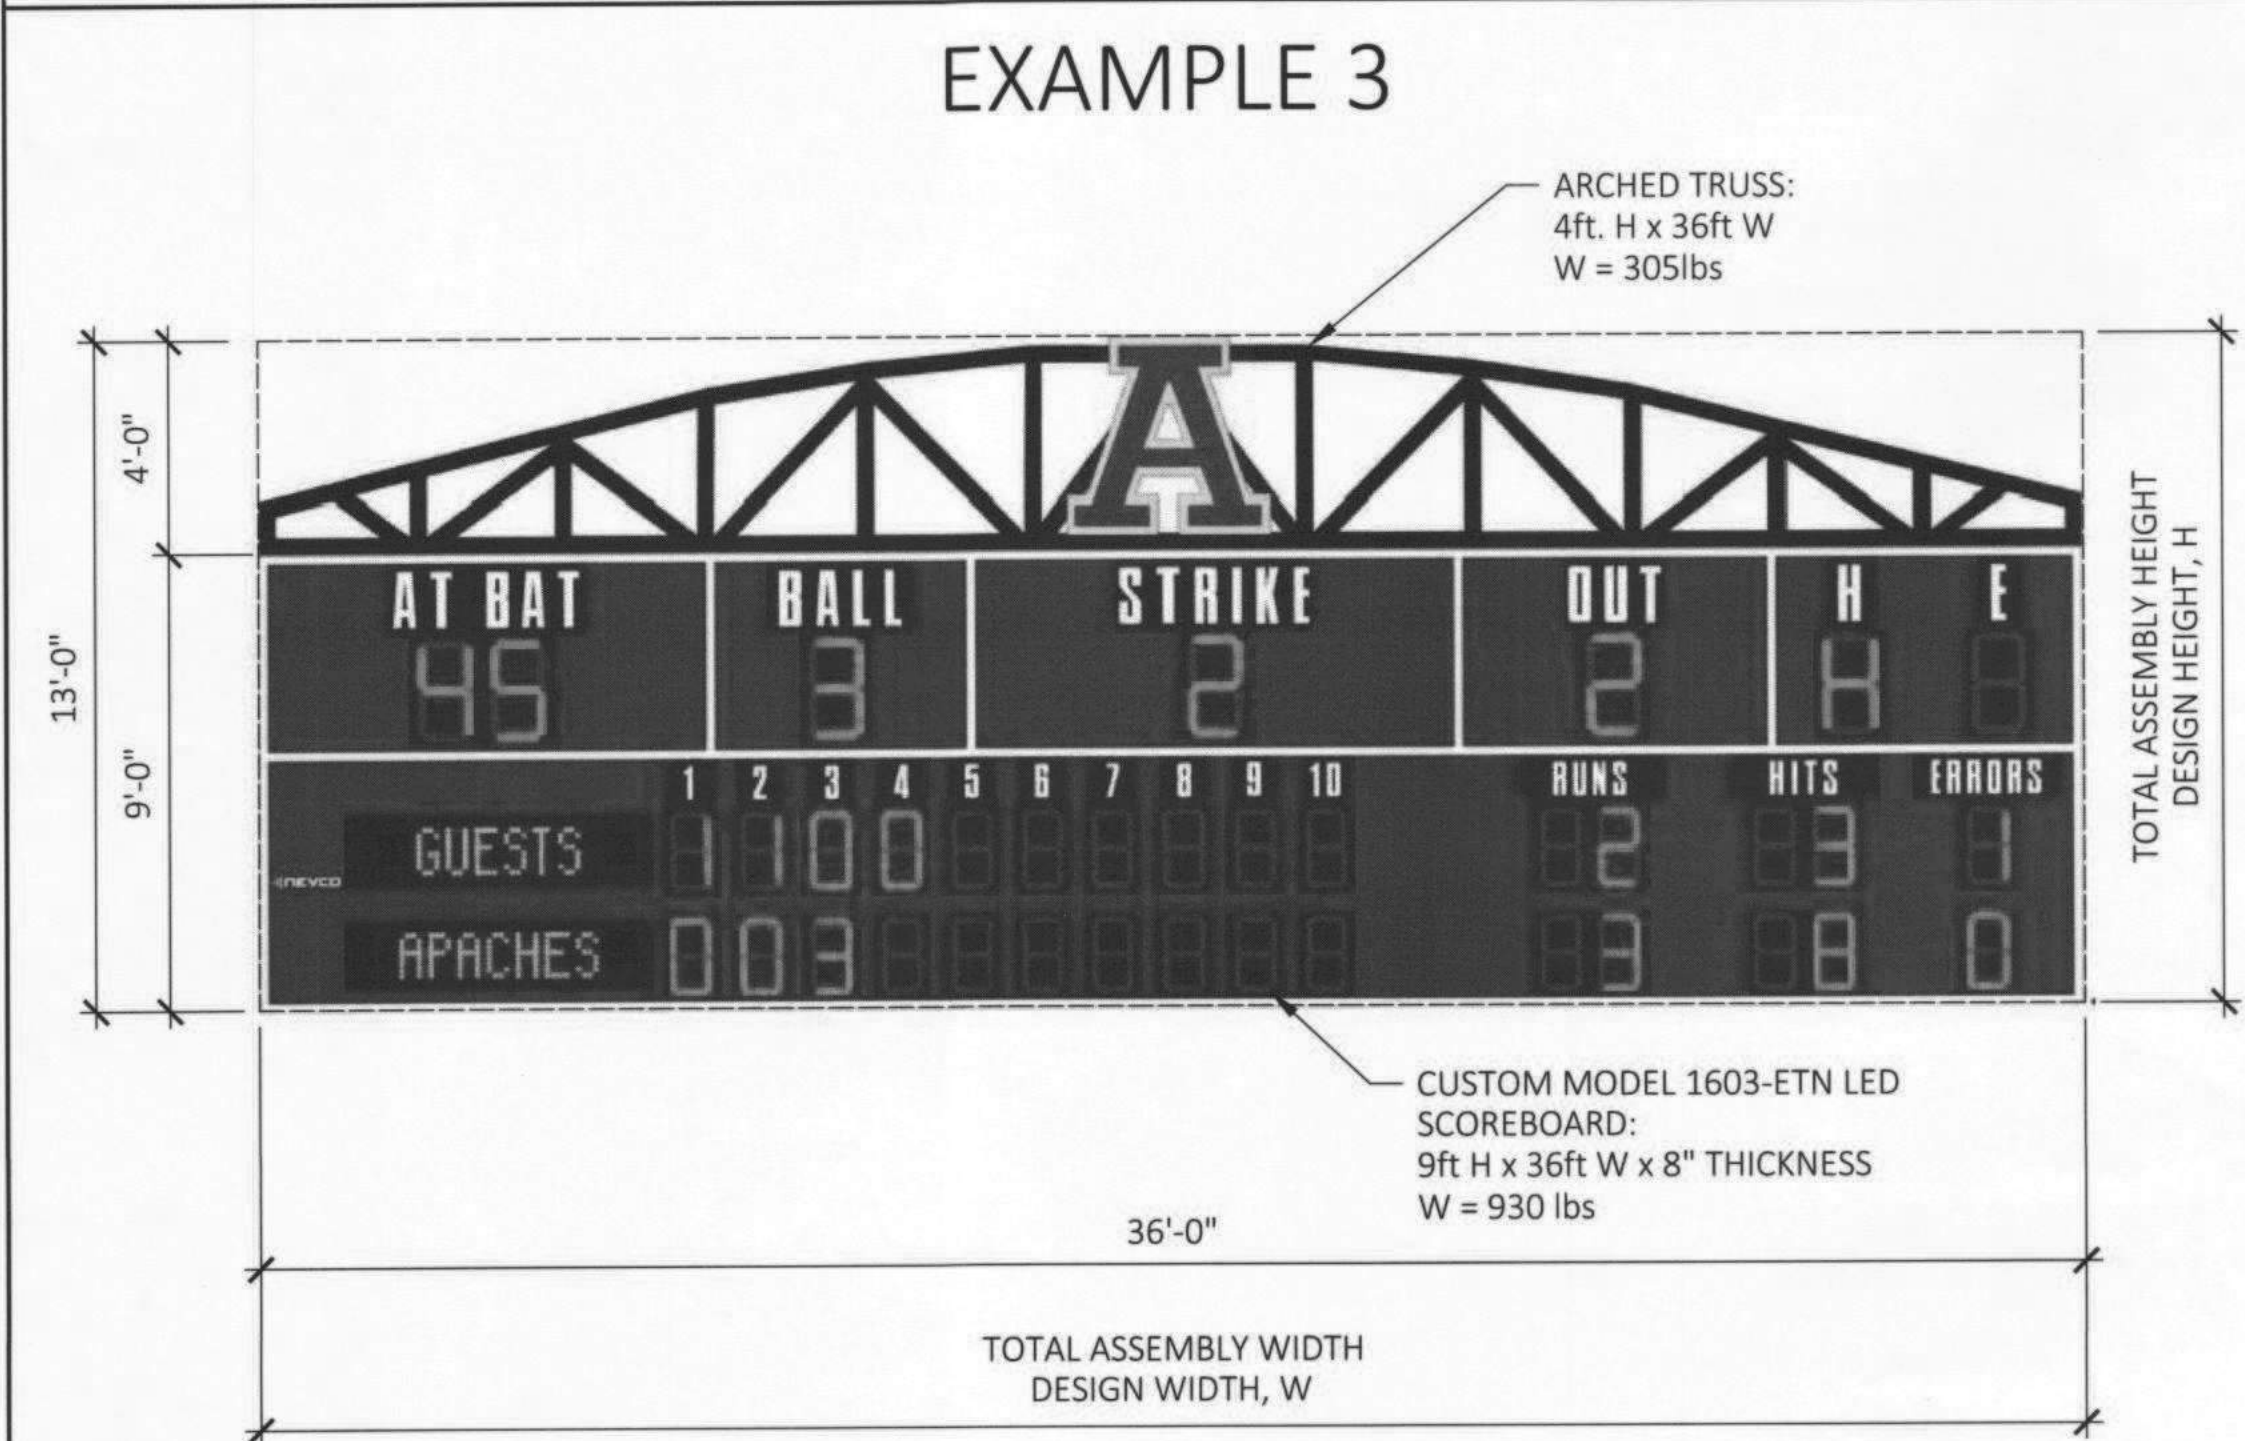

| SCOREBOARD ASSEMBLY WORKSHEET <sup>(1)</sup> - EXAMPLE 3    |                   |   |                  |
|---|-------------------|---|------------------|
| Nevco Part No. or Description                               | Part Height [ft.] | Part Width [ft]   | Part Weight [lb] |
| ARCHED TRUSS  | 4 ft              | 36 ft   | 305 lbs.         |
| MODEL 1603-ETN LED SCOREBORD                                | 9 ft              | 36 ft   | 930 lbs.         |
|   |                   |   |                  |
|   |                   |   |                  |
|   |                   |   |                  |
| Total   | 13 ft             | 36 ft   | 1235 lbs.        |
| TOTAL ASSEMBLY DIMENSIONS & WEIGHT <sup>(2)</sup>           |                   |   |                  |
| Total Assembly Height =                                     | 13 ft. 0in.       |   |                  |
| Total Assembly Width =                                      | 36 ft. 0in.       |   |                  |
| Total Assembly Weight =                                     | 1235 lbs.         |   |                  |
| Distance from Finish Grade to Bottom of Sign =              | 10 ft. 0in.       | Total Height = Total Assembly Height + Distance from Finish Grade to Bottom of Sign = | 23 ft. 0in.      |
| SCOREBOARD ASSEMBLY FOOTNOTES                               |                   |   |                  |
| 1. Verify part number, dimensions, and weight with Nevco    |                   |   |                  |
| 2. See Step 3 of Scoreboard Assembly Worksheet Instructions |                   |   |                  |

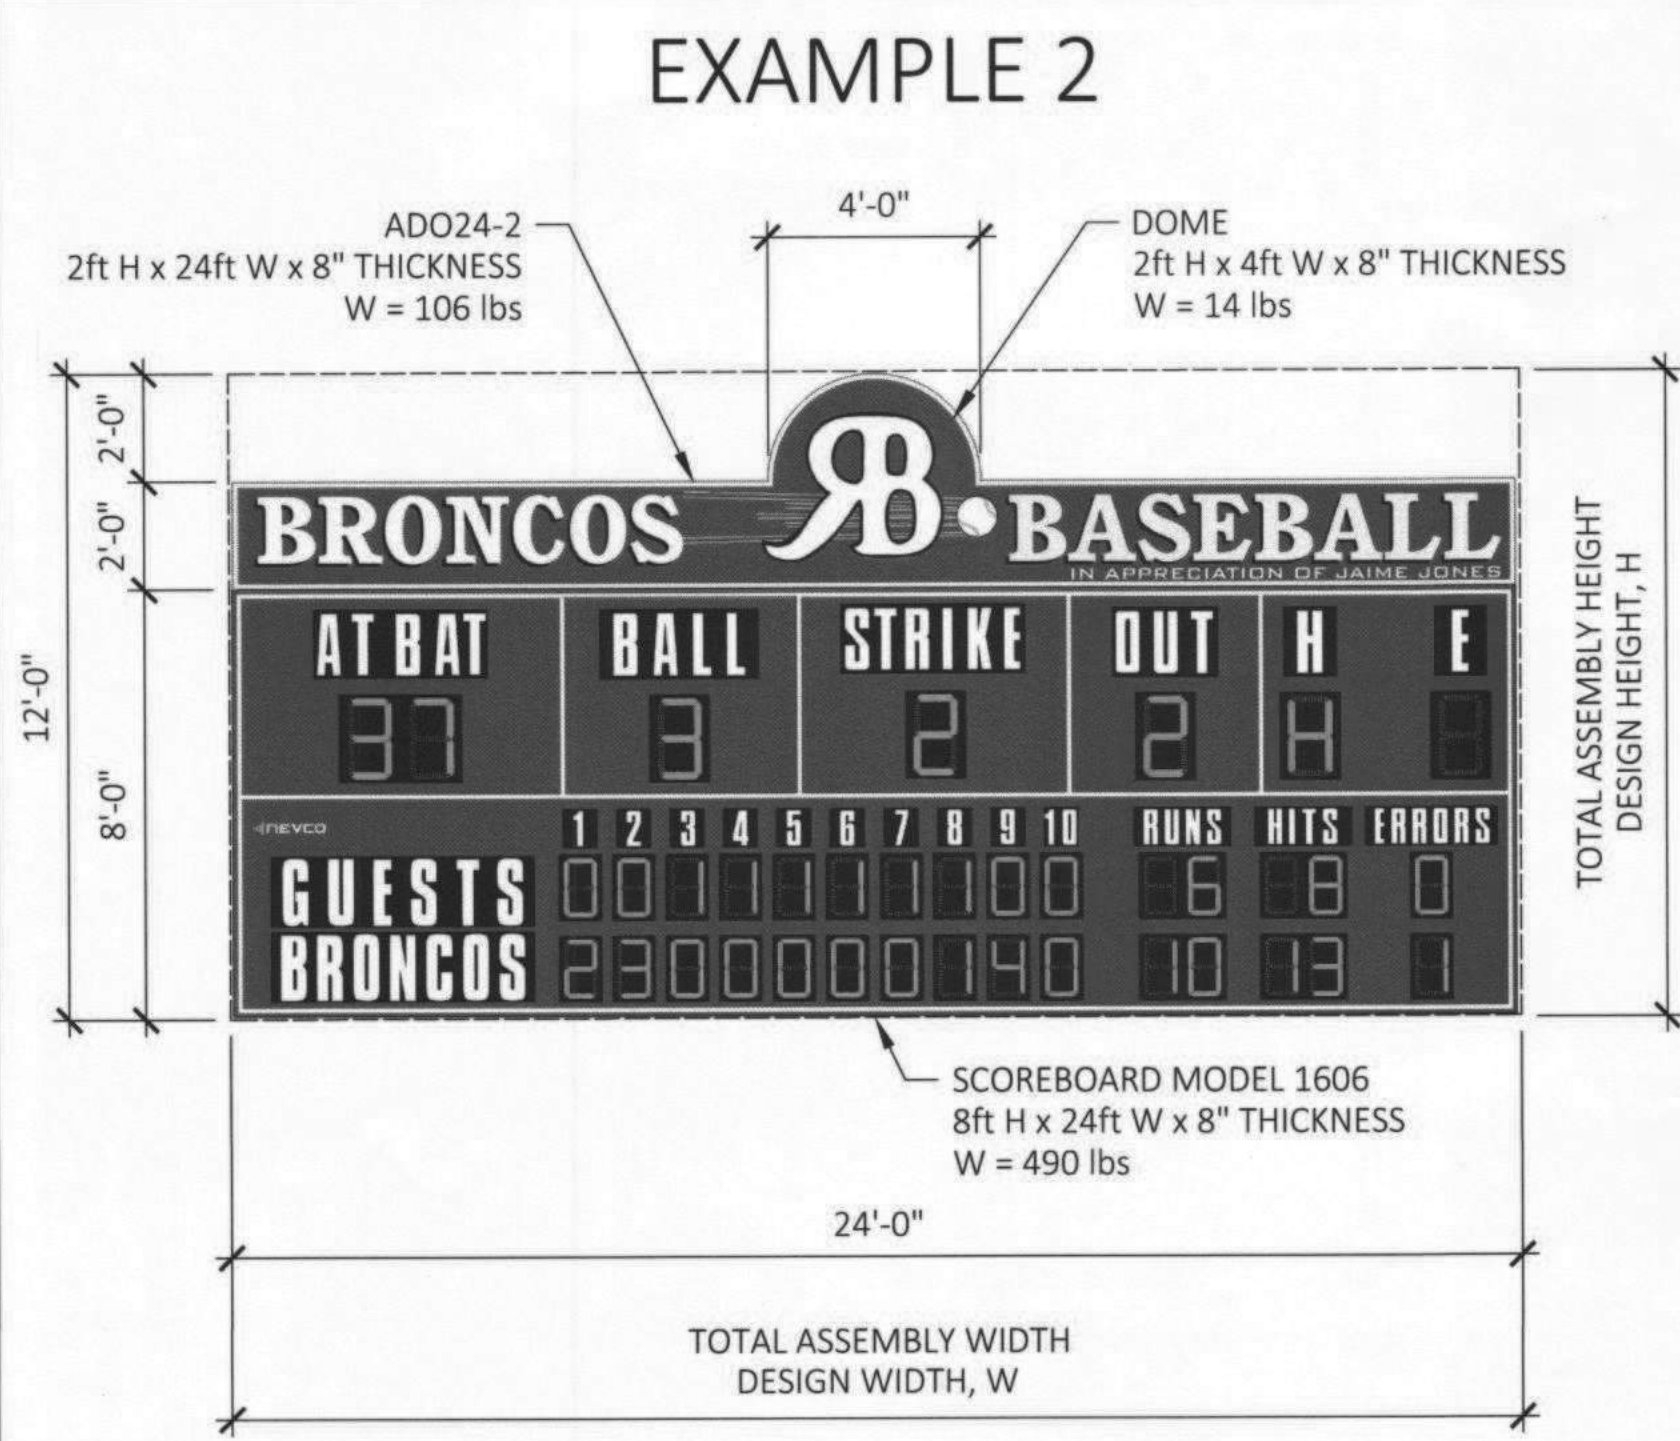

| SCOREBOARD ASSEMBLY WORKSHEET <sup>(1)</sup> - EXAMPLE 2    |                   |   |                  |
|---|-------------------|---|------------------|
| Nevco Part No. or Description                               | Part Height [ft.] | Part Width [ft]   | Part Weight [lb] |
| DOME  | 2 ft              | 4 ft  | 14 lbs.          |
| ADO24-2   | 2 ft              | 24 ft   | 106 lbs.         |
| MODEL 1606  | 8 ft              | 24 ft   | 490 lbs.         |
|   |                   |   |                  |
|   |                   |   |                  |
| Total   | 12 ft             | 24ft  | 610 lbs.         |
| TOTAL ASSEMBLY DIMENSIONS & WEIGHT <sup>(2)</sup>           |                   |   |                  |
| Total Assembly Height =                                     | 12 ft. 0in.       |   |                  |
| Total Assembly Width =                                      | 24 ft. 0in.       |   |                  |
| Total Assembly Weight =                                     | 610 lbs.          |   |                  |
| Distance from Finish Grade to Bottom of Sign =              | 8 ft. 6in.        | Total Height = Total Assembly Height + Distance from Finish Grade to Bottom of Sign = | 20 ft. 6in.      |
| SCOREBOARD ASSEMBLY FOOTNOTES                               |                   |   |                  |
| 1. Verify part number, dimensions, and weight with Nevco    |                   |   |                  |
| 2. See Step 3 of Scoreboard Assembly Worksheet Instructions |                   |   |                  |

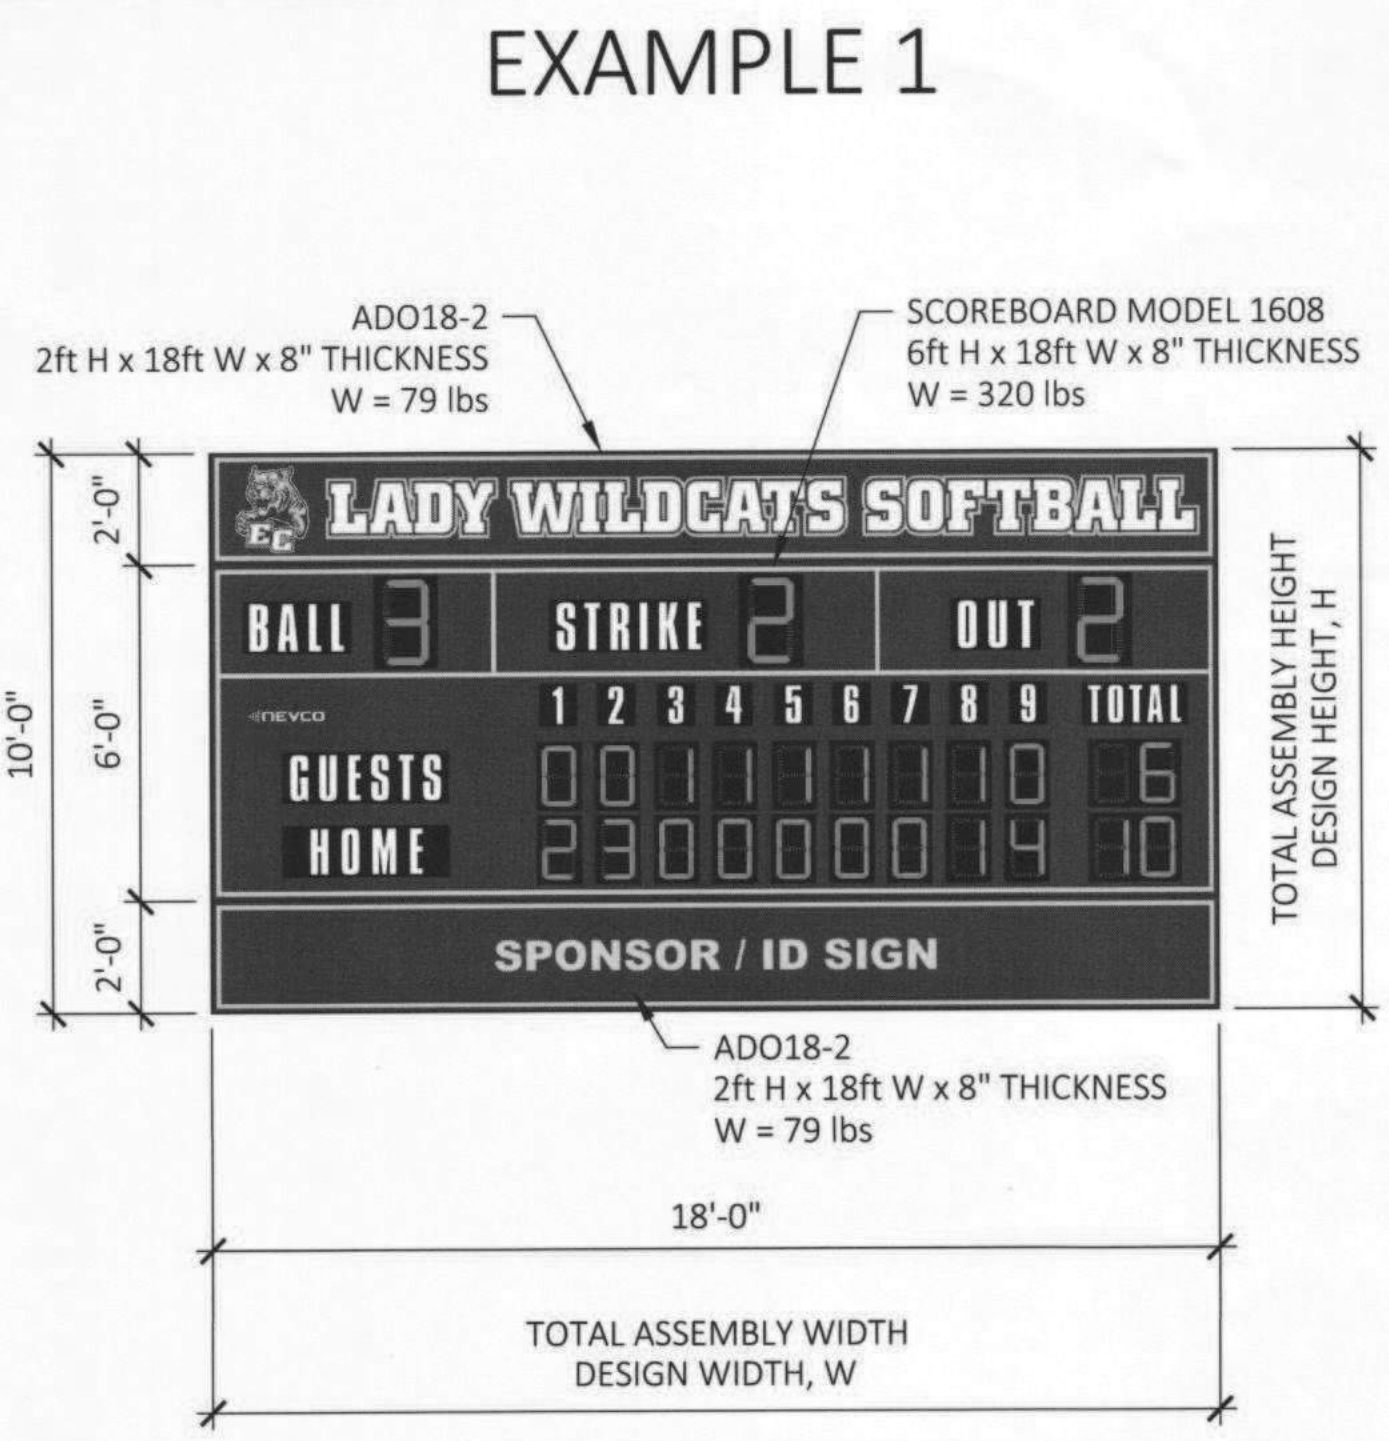

| SCOREBOARD ASSEMBLY WORKSHEET <sup>(1)</sup> - EXAMPLE 1    |                   |   |                  |
|---|-------------------|---|------------------|
| Nevco Part No. or Description                               | Part Height [ft.] | Part Width [ft]   | Part Weight [lb] |
| ADO18-2   | 2 ft              | 18 ft   | 79 lbs.          |
| Model 1608  | 6ft               | 18 ft   | 320 lbs.         |
| ADO18-2   | 2 ft              | 18 ft   | 79 lbs.          |
|   |                   |   |                  |
|   |                   |   |                  |
| Total   | 10 ft             | 18ft  | 478 lbs.         |
| TOTAL ASSEMBLY DIMENSIONS & WEIGHT <sup>(2)</sup>           |                   |   |                  |
| Total Assembly Height =                                     | 10 ft. 0in.       |   |                  |
| Total Assembly Width =                                      | 18 ft. 0in.       |   |                  |
| Total Assembly Weight =                                     | 478 lbs.          |   |                  |
| Distance from Finish Grade to Bottom of Sign =              | 6 ft. 8in.        | Total Height = Total Assembly Height + Distance from Finish Grade to Bottom of Sign = | 16 ft. 8in.      |
| SCOREBOARD ASSEMBLY FOOTNOTES                               |                   |   |                  |
| 1. Verify part number, dimensions, and weight with Nevco    |                   |   |                  |
| 2. See Step 3 of Scoreboard Assembly Worksheet Instructions |                   |   |                  |

- SCOREBOARD ASSEMBLY WORKSHEET INSTRUCTIONS
- STEP 1: DETERMINE DESIRED SCOREBOARD ASSEMBLY. FILL OUT SCOREBOARD ASSEMBLY TABLE. PROVIDE NEVCO PART NUMBERS, PART HEIGHT, PART WIDTH, AND PART WEIGHTS.
- STEP 2: DETERMINE TOTAL ASSEMBLY HEIGHT, WIDTH, AND WEIGHT
- STEP 3: BASED ON TOTAL ASSEMBLY WIDTH, DETERMINE THE NUMBER OF REQUIRED COLUMNS. SEE SHEETS SB1.X FOR 1 COLUMN ASSEMBLY OPTIONS, SB2.X FOR 2 COLUMN ASSEMBLY OPTIONS, SB3.X FOR 3 COLUMN ASSEMBLY OPTIONS, SB4.X FOR 4 COLUMN ASSEMBLY OPTIONS
- STEP 4: PICK FOUNDATION TYPE (CAISSON WITH EMBEDDED COLUMN, CAISSON WITH BOLTED COLUMN, OR MAT FOOTING) AND BRACED OR UNBRACED COLUMN OPTION. MARK APPLICABLE SHEET ON SHEET INDEX, SB0.1
- STEP 5: MARK APPLICABLE CHECK BOX ON DETAIL 'A' OF SELECTED COLUMN/FOUNDATION OPTION
- STEP 6: FILL IN SITE SPECIFIC SEISMIC AND WIND VALUES TABLE C ON SB0.1.
- STEP 7: FILL IN SITE SPECIFIC SOIL EXPOSURE CLASS TABLE D ON SB0.1 (OPTIONAL)
- STEP 8: FILL IN SITE SPECIFIC FLOOD ZONE AS REQUIRED, TABLE E ON SB0.1
- STEP 9: VERIFY ALL APPLICABLE SHEETS ARE MARKED ON SHEET INDEX, SB0.1. INCLUDE ALL MARKED SHEETS AS PART OF DSA SUBMITTAL

NEVCO PART NUMBERS

| SCOREBOARD PART NUMBERS |                   |                 |                 |                  |
|-------------------------|-------------------|-----------------|-----------------|------------------|
| Nevco Model No.         | Part Height [ft.] | Part Width [ft] | Part Depth [in] | Part Weight [lb] |
| 1600                    | 5 ft              | 16 ft           | 8 in            | 260 lbs.         |
| 1603                    | 9 ft              | 36 ft           | 8 in            | 930 lbs.         |
| 1604                    | 8 ft              | 28 ft           | 8 in            | 570 lbs.         |
| 1606                    | 8 ft              | 24 ft           | 8 in            | 490 lbs.         |
| 1608                    | 6 ft              | 18 ft           | 8 in            | 320 lbs.         |
| 1609                    | 6 ft              | 16 ft           | 8 in            | 290 lbs.         |
| 1610                    | 4 ft              | 10 ft           | 8 in            | 130 lbs.         |
| 1612                    | 5 ft              | 10 ft           | 8 in            | 160 lbs.         |
| 1615                    | 7 ft              | 16 ft           | 8 in            | 350 lbs.         |
| 1617                    | 7 ft              | 16 ft           | 8 in            | 350 lbs.         |
| 1620                    | 4 ft              | 10 ft           | 8 in            | 130 lbs.         |
| 1625                    | 5 ft              | 10 ft           | 8 in            | 160 lbs.         |
| 1630                    | 8 ft              | 18 ft           | 8 in            | 410 lbs.         |
| 1632                    | 5 ft              | 12 ft           | 8 in            | 180 lbs.         |
| 1635                    | 6 ft              | 16 ft           | 8 in            | 290 lbs.         |
| 1640                    | 8 ft              | 18 ft           | 8 in            | 410 lbs.         |
| 1650                    | 3 ft              | 8 ft            | 8 in            | 90 lbs.          |
| 3600                    | 8 ft              | 18 ft           | 8 in            | 420 lbs.         |
| 3602                    | 5 ft              | 12 ft           | 8 in            | 150 lbs.         |
| 3604                    | 10 ft             | 30 ft           | 8 in            | 535 lbs.         |
| 3614                    | 8 ft              | 18 ft           | 8 in            | 420 lbs.         |
| 3615                    | 8 ft              | 24 ft           | 8 in            | 570 lbs.         |
| 3616                    | 10 ft             | 36 ft           | 8 in            | 1020 lbs.        |
| 3617                    | 8 ft              | 24 ft           | 8 in            | 570 lbs.         |
| 3618                    | 8 ft              | 24 ft           | 8 in            | 570 lbs.         |
| 3619                    | 8 ft              | 24 ft           | 8 in            | 270 lbs.         |
| 3620                    | 8 ft              | 32 ft           | 8 in            | 760 lbs.         |
| 3621                    | 8 ft              | 20 ft           | 8 in            | 585 lbs.         |
| 3625                    | 9 ft              | 18 ft           | 8 in            | 460 lbs.         |
| 3634                    | 8 ft              | 18 ft           | 8 in            | 420 lbs.         |
| 3650                    | 4 ft              | 10 ft           | 8 in            | 130 lbs.         |
| 3655                    | 5 ft              | 16 ft           | 8 in            | 250 lbs.         |
| 3656                    | 8 ft              | 18 ft           | 8 in            | 420 lbs.         |

| SCOREBOARD PART NUMBERS |                   |                 |                 |                  |
|-------------------------|-------------------|-----------------|-----------------|------------------|
| Nevco Model No.         | Part Height [ft.] | Part Width [ft] | Part Depth [in] | Part Weight [lb] |
| 3657                    | 10 ft             | 32 ft           | 8 in            | 665 lbs.         |
| 3658                    | 5 ft              | 16 ft           | 8 in            | 250 lbs.         |
| 3680                    | 8 ft              | 18 ft           | 8 in            | 555 lbs.         |
| 3682                    | 8 ft              | 20 ft           | 8 in            | 690 lbs.         |
| 3685                    | 8 ft              | 24 ft           | 8 in            | 640 lbs.         |
| 3688                    | 8 ft              | 32 ft           | 8 in            | 830 lbs.         |
| 5625                    | 8 ft              | 12 ft           | 8 in            | 280 lbs.         |
| 5632                    | 4 ft              | 18 ft           | 8 in            | 240 lbs.         |
| 5633                    | 2 ft              | 18 ft           | 8 in            | 150 lbs.         |
| 5634                    | 6 ft              | 18 ft           | 8 in            | 405 lbs.         |
| 5635                    | 8 ft              | 18 ft           | 8 in            | 555 lbs.         |
| 5642                    | 3 ft              | 24 ft           | 8 in            | 200 lbs.         |
| 5643                    | 5 ft              | 24 ft           | 8 in            | 350 lbs.         |
| 7604                    | 10.5 ft           | 18 ft           | 8 in            | 590 lbs.         |
| 7605                    | 10.5 ft           | 24 ft           | 8 in            | 790 lbs.         |
| 7614                    | 10.5 ft           | 18 ft           | 8 in            | 590 lbs.         |
| 7615                    | 10.5 ft           | 24 ft           | 8 in            | 790 lbs.         |
| 7616                    | 10 ft             | 36 ft           | 8 in            | 1220 lbs.        |
| 7620                    | 8 ft              | 32 ft           | 8 in            | 820 lbs.         |
| 7624                    | 10.5 ft           | 18 ft           | 8 in            | 590 lbs.         |
| 7625                    | 10.5 ft           | 24 ft           | 8 in            | 790 lbs.         |
| 7630                    | 8 ft              | 24 ft           | 8 in            | 650 lbs.         |
| 7631                    | 8 ft              | 24 ft           | 8 in            | 650 lbs.         |
| 7632                    | 8 ft              | 24 ft           | 8 in            | 650 lbs.         |
| 7680                    | 10.5 ft           | 18 ft           | 8 in            | 610 lbs.         |
| 7685                    | 8 ft              | 24 ft           | 8 in            | 670 lbs.         |
| 7688                    | 8 ft              | 32 ft           | 8 in            | 930 lbs.         |
| 9605                    | 3 ft              | 6 ft            | 8 in            | 60 lbs.          |
| 9620                    | 3.5 ft            | 4 ft            | 8 in            | 45 lbs.          |
| 9650                    | 10 ft             | 16 ft           | 8 in            | 430 lbs.         |
| 9651                    | 4 ft              | 5 ft            | 8 in            | 60 lbs.          |
| 9652                    | 4 ft              | 9 ft            | 8 in            | 110 lbs.         |
| 9660                    | 6 ft              | 10 ft           | 8 in            | 235 lbs.         |

| TRUSSES - HEIGHT AND WIDTH TO BE SPECIFIED BY USER |                      |                    |                 |                        |   |
|--|----------------------|--------------------|-----------------|------------------------|---|
| Nevco Model No.                                    | Part Height, h [ft.] | Part Width, w [ft] | Part Depth [in] | Part Weight [lbs/s.f.] | Part Weight [lbs] = Part Weight lb/s.f. x h x w |
|  | _____ ft             | _____ ft           | 4 in            | 2.5 lbs./s.f.          | _____ lbs.                                      |
|  | _____ ft             | _____ ft           | 4 in            | 2.5 lbs./s.f.          | _____ lbs.                                      |

| DELAY OF GAME PART NUMBERS |                   |                 |                 |                  |
|----------------------------|-------------------|-----------------|-----------------|------------------|
| Nevco Model No.            | Part Height [ft.] | Part Width [ft] | Part Depth [in] | Part Weight [lb] |
| DGT                        | 4 ft              | 4 ft            | 8 in            | 50 lbs.          |
| DGT-T14                    | 5 ft              | 4 ft            | 8 in            | 60 lbs.          |

| FIELD TIMER PART NUMBERS |                   |                 |                 |                  |
|--------------------------|-------------------|-----------------|-----------------|------------------|
| Nevco Model No.          | Part Height [ft.] | Part Width [ft] | Part Depth [in] | Part Weight [lb] |
| FT-24                    | 4 ft              | 4 ft            | 8 in            | 55 lbs.          |
| FT-30                    | 4 ft              | 4 ft            | 8 in            | 55 lbs.          |
| FT-T14                   | 5 ft              | 4 ft            | 8 in            | 65 lbs.          |

| PITCH COUNT PART NUMBERS |                   |                 |                 |                  |
|--------------------------|-------------------|-----------------|-----------------|------------------|
| Nevco Model No.          | Part Height [ft.] | Part Width [ft] | Part Depth [in] | Part Weight [lb] |
| PCD-1                    | 3 ft              | 5 ft            | 8 in            | 50 lbs.          |
| PCD-08-1                 | 1.5 ft            | 8 ft            | 8 in            | 50 lbs.          |
| PCD-10-1                 | 2 ft              | 10 ft           | 8 in            | 80 lbs.          |
| PCD-16-1                 | 2 ft              | 16 ft           | 8 in            | 130 lbs.         |
| PCD-18-1                 | 2 ft              | 18 ft           | 8 in            | 150 lbs.         |

| PITCH SPEED PART NUMBERS |                   |                 |                 |                  |
|--------------------------|-------------------|-----------------|-----------------|------------------|
| Nevco Model No.          | Part Height [ft.] | Part Width [ft] | Part Depth [in] | Part Weight [lb] |
| PSD                      | 4 ft              | 4 ft            | 8 in            | 50 lbs.          |

| SOUND SYSTEM PART NUMBERS |                   |                 |                 |                  |
|---------------------------|-------------------|-----------------|-----------------|------------------|
| Nevco Model No.           | Part Height [ft.] | Part Width [ft] | Part Depth [in] | Part Weight [lb] |
| SP-1000                   | 4 ft              | 9 ft            | 43 in           | 710 lbs.         |
| SP-2000                   | 4 ft              | 19 ft           | 43 in           | 1420 lbs.        |


| CUSTOM PART     |                   |                 |                 |                  |
|-----------------|-------------------|-----------------|-----------------|------------------|
| Nevco Model No. | Part Height [ft.] | Part Width [ft] | Part Depth [in] | Part Weight [lb] |
|                 |                   |                 |                 |                  |
|                 |                   |                 |                 |                  |

| SIGNS - HEIGHT AND WIDTH TO BE SPECIFIED BY USER |                      |                    |                 |                        |   |
|--|----------------------|--------------------|-----------------|------------------------|---|
| Nevco Model No.                                  | Part Height, h [ft.] | Part Width, w [ft] | Part Depth [in] | Part Weight [lbs/s.f.] | Part Weight [lbs] = Part Weight lb/s.f. x h x w |
|  | _____ ft             | _____ ft           | 8 in            | 3.2 lbs./s.f.          | _____ lbs.                                      |
|  | _____ ft             | _____ ft           | 8 in            | 3.2 lbs./s.f.          | _____ lbs.                                      |


| ADO SIGN PART NUMBERS |                   |                 |                 |                  |
|-----------------------|-------------------|-----------------|-----------------|------------------|
| Nevco Model No.       | Part Height [ft.] | Part Width [ft] | Part Depth [in] | Part Weight [lb] |
| ADO8-1                | 1 ft              | 8 ft            | 8 in            | 18 lbs.          |
| ADO6-2                | 2 ft              | 6 ft            | 8 in            | 26 lbs.          |
| ADO8-2                | 2 ft              | 8 ft            | 8 in            | 35 lbs.          |
| ADO10-2               | 2 ft              | 10 ft           | 8 in            | 44 lbs.          |
| ADO12-2               | 2 ft              | 12 ft           | 8 in            | 53 lbs.          |
| ADO14-2               | 2 ft              | 14 ft           | 8 in            | 62 lbs.          |
| ADO16-2               | 2 ft              | 16 ft           | 8 in            | 70 lbs.          |
| ADO18-2               | 2 ft              | 18 ft           | 8 in            | 79 lbs.          |
| ADO20-2               | 2 ft              | 20 ft           | 8 in            | 88 lbs.          |
| ADO22-2               | 2 ft              | 22 ft           | 8 in            | 97 lbs.          |
| ADO24-2               | 2 ft              | 24 ft           | 8 in            | 106 lbs.         |
| ADO28-2               | 2 ft              | 28 ft           | 8 in            | 123 lbs.         |
| ADO30-2               | 2 ft              | 30 ft           | 8 in            | 132 lbs.         |
| ADO32-2               | 2 ft              | 32 ft           | 8 in            | 140 lbs.         |
| ADO6-3                | 3 ft              | 6 ft            | 8 in            | 40 lbs.          |
| ADO8-3                | 3 ft              | 8 ft            | 8 in            | 53 lbs.          |
| ADO10-3               | 3 ft              | 10 ft           | 8 in            | 66 lbs.          |
| ADO12-3               | 3 ft              | 12 ft           | 8 in            | 80 lbs.          |
| ADO14-3               | 3 ft              | 14 ft           | 8 in            | 93 lbs.          |
| ADO16-3               | 3 ft              | 16 ft           | 8 in            | 106 lbs.         |
| ADO18-3               | 3 ft              | 18 ft           | 8 in            | 120 lbs.         |
| ADO20-3               | 3 ft              | 20 ft           | 8 in            | 132 lbs.         |
| ADO22-3               | 3 ft              | 22 ft           | 8 in            | 146 lbs.         |
| ADO24-3               | 3 ft              | 24 ft           | 8 in            | 160 lbs.         |
| ADO28-3               | 3 ft              | 28 ft           | 8 in            | 185 lbs.         |
| ADO30-3               | 3 ft              | 30 ft           | 8 in            | 200 lbs.         |
| ADO32-3               | 3 ft              | 32 ft           | 8 in            | 212 lbs.         |
| ADO36-3               | 3 ft              | 36 ft           | 8 in            | 239 lbs.         |

| MESSAGE CENTERS - HEIGHT AND WIDTH TO BE SPECIFIED BY USER |                      |                    |                 |                        |   |
|--|----------------------|--------------------|-----------------|------------------------|---|
| Nevco Model No.  | Part Height, h [ft.] | Part Width, w [ft] | Part Depth [in] | Part Weight [lbs/s.f.] | Part Weight [lbs] = Part Weight lb/s.f. x h x w |
|  | _____ ft             | _____ ft           | 8 in            | 8.5 lbs./s.f.          | _____ lbs.                                      |
|  | _____ ft             | _____ ft           | 8 in            | 8.5 lbs./s.f.          | _____ lbs.                                      |

| VIDEO BOARDS - HEIGHT AND WIDTH TO BE SPECIFIED BY USER |                      |                    |                 |                        |   |
|---|----------------------|--------------------|-----------------|------------------------|---|
| Nevco Model No.   | Part Height, h [ft.] | Part Width, w [ft] | Part Depth [in] | Part Weight [lbs/s.f.] | Part Weight [lbs] = Part Weight lb/s.f. x h x w |
|   | _____ ft             | _____ ft           | 8 in            | 9.5 lbs./s.f.          | _____ lbs.                                      |
|   | _____ ft             | _____ ft           | 8 in            | 9.5 lbs./s.f.          | _____ lbs.                                      |

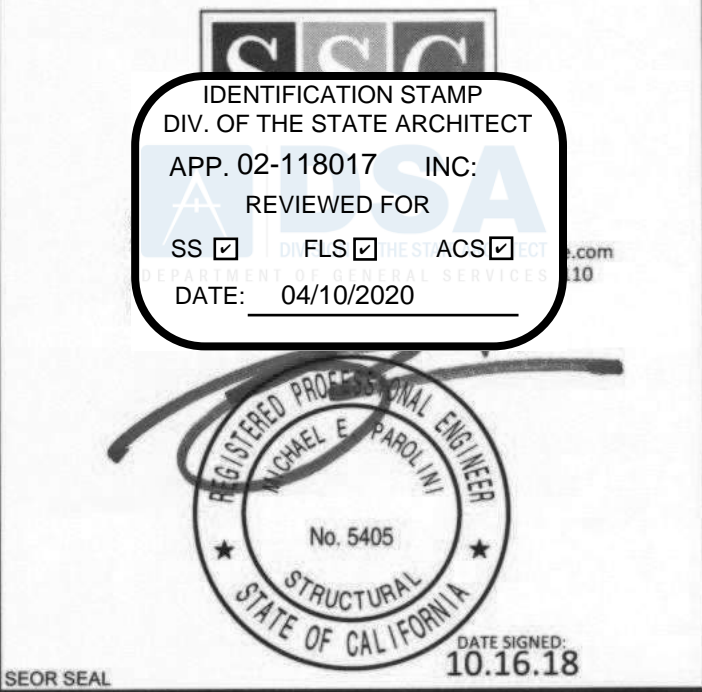

THESE DRAWINGS, NOTES AND DETAILS ARE INSTRUMENTS OF SERVICE AND ARE THE PROPERTY OF SMITH STRUCTURAL GROUP, LLP. ALL DRAWINGS, INFORMATION, SPECIFICATIONS, IDEAS, DESIGNS AND ARRANGEMENTS REPRESENTED WITHIN THESE DOCUMENTS SHALL REMAIN THE PROPERTY OF THE ENGINEER. NO PART THEREOF SHALL BE COPIED, DISCLOSED TO OTHERS OR USED IN CONNECTION WITH ANY WORK OR PROJECT OTHER THAN THE SPECIFIC PROJECT FOR WHICH THEY HAVE BEEN PREPARED AND DEVELOPED WITHOUT THE EXPRESSED WRITTEN CONSENT OF THE ENGINEER. COPYRIGHT 2018. THANK YOU FOR YOUR INTEREST IN NEVCO SCOREBOARD PRODUCTS.

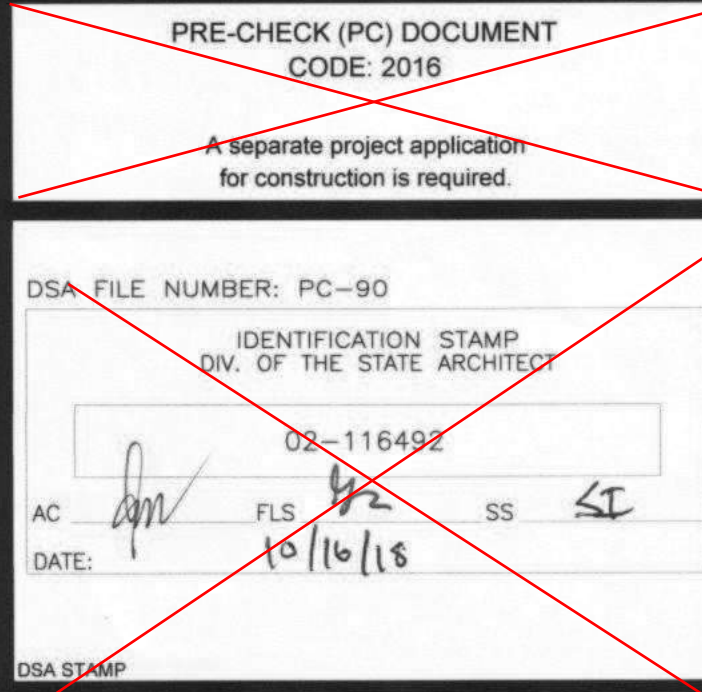

| EXAMPLE SCOREBOARD WORKSHEET & NEVCO PART NUMBERS |           |
|---|-----------|
| SHEET INFORMATION                                 |           |
| DATE  | 10.16.18  |
| DRAWN   | JMK / JMM |
| CHECKED   | JMM / MEP |
| SSG JOB #   | S17015    |
| SHEET   | SB0.2     |



| STRUCTURAL NOTES   |                      | ABBREVIATIONS   |   | SPECIAL INSPECTION  | |
|---|
| <p><b>GENERAL NOTES</b></p> <p>1. The following notes, typical details and schedules shall apply to all phases of this project unless otherwise shown or noted.</p> <p>2. Specific notes and details shall take precedence over general notes and typical details.</p> <p>3. All materials and workmanship shall conform to the minimum standards of the 2016 edition Title 24 of the California Building Code (CBC) and such other regulating agencies exercising authority over any portion of the work. The contractor shall have a current copy of the CBC on the job site.</p> <p>4. The "Contract or Construction Documents" shall consist of these notes, details, schedules, plans, and drawings, as well as attached specifications.</p> <p>5. All specifications, including but not limited to materials and products, shall be those put forth in the "Contract or Construction Documents". No substitutions shall be permitted to be used or assumed to be used in the bidding or construction process without written approval by the Structural Engineer of Record.</p> <p>6. The contractor shall examine the "Contract or Construction Documents" and shall notify the Architect or Structural Engineer of Record of any discrepancies he may find before proceeding with the work.</p> <p>7. All information on existing conditions shown on drawings are based on best present knowledge available, but without guarantee of accuracy. The Contractor shall verify and be responsible for all dimensions and conditions at the site and shall notify the Architect or Structural Engineer of Record of any discrepancies between actual site conditions and information shown on or in the "Contract or Construction Documents" before proceeding with work.</p> <p>8. The Contractor shall immediately notify the Architect or Structural Engineer of Record of any condition which in his opinion might endanger the stability of the structure or cause distress of the structure.</p> <p>9. All work shall conform to the best practice prevailing in the various trades comprising work. The Contractor shall be responsible for coordinating the work of all trades.</p> <p>10. These "Contract or Construction Documents" represent the finished structure, and do not indicate the method of construction. The Contractor shall supervise and direct the work and shall be solely responsible for construction means, methods, techniques, sequences and procedures.</p> <p>11. Inspection and approval for fabricator's shops used for fabrication of structural load bearing members, components, materials or assemblies shall conform to CBC Section 170A4.2.5.</p> <p>A. Labeling (as required or specified) shall be provided in accordance with CBC Section 170A3.5.</p> <p>B. Evaluation and follow-up inspection services (as required or specified), shall conform to CBC Section 170A3.6.</p> <p>12. The Contractor shall refer to the specifications for information not covered by these drawings and General Notes.</p> <p>13. The Contractor shall provide temporary bracing and shoring for all structural members as required for structural stability of the structure during all phases of construction.</p> <p>14. The Contractor shall take all steps necessary to ensure proper alignment of the structure after the installation of all structural and finish materials. This shall include any necessary preloading of the structure to determine final position of the completed work.</p> <p>15. Observation visits to the project site by field representatives of Architect and/or Structural Engineer of Record (support services) shall not include inspections of safety or protective measures, nor construction procedures, techniques or methods. Any support services performed by Architect or Structural Engineer of Record during any phase of construction, shall be distinguished from continuous and detailed inspection services (as required by any regulating governmental agency, e.g. the Authority Having Jurisdiction) provided by others, these support services, whether of material or work, are performed solely for the purpose of assisting in quality control and in achieving conformance with contract documents, but do not guarantee Contractor's performance and shall not be construed as supervision of construction.</p> <p>16. Provide openings and supports as required per typical details and notes for mechanical, plumbing, and electrical equipment, vents, ducts, piping, etc. All mechanical, plumbing and electrical equipment shall be properly "sway braced" against lateral forces.</p> <p>17. These notes, details, drawings and specifications (Contract or Construction Documents) do not carry necessary provisions for construction safety. These documents and all phases of construction hereby contemplated are to be governed, at all times, by applicable provisions of the current California Occupational Safety and Health Act.</p> <p>18. Where any conflict occurs between the requirements of federal, state and local laws, codes, ordinances, rules and regulations, the most stringent shall govern.</p> <p>19. Written dimensions shall have precedence over scaled dimensions.</p> <p>20. Drawings (notes, schedules, details and plans) shall have precedence over Structural Calculations.</p> <p>21. In the event that certain features of the construction are not fully shown on the drawings or called for in the General Notes or Specifications, then their construction shall be of the same character as for similar conditions that are shown or called for.</p> <p>22. ASTM designation and all standards refer to the latest amendments.</p> <p>23. These structural "Contract or Construction Documents" shall not be modified without prior written approval of the Structural Engineer of Record.</p> <p>24. Only structural working drawings approved by the Authority Having Jurisdiction are permitted to be used for construction on this project. All other drawings or documents are obsolete and are not permitted on the job site, nor shall they be used for any construction purposes. Contractors using unapproved drawings or documents are solely responsible for all work not performed in accordance with the "approved" drawings.</p> <p>25. A Division of the State Architect certified project inspector employed by the District (Owner) and approved by the Division of the State Architect shall provide continuous inspection of the work. The duties of the inspector are defined in Section 4-342, Part 1, Title 24 California Code of Regulations.</p> <p><b>FOUNDATION NOTES</b></p> <p>1. Basis: See Structural Design Values Chart, Sheet SB0.1 Table B</p> <p>2. Unexpected soil conditions: Allowable values and foundation design are based upon the minimum values provided in Table 1806A.2 of the 2016 California Building Code. See SB0.1 for values.</p> <p>3. Excavate to required depths and dimensions (as indicated in drawings), cut square and smooth with firm level bottoms. Care shall be taken not to over-excavate foundation at lower elevation and prevent disturbing of soils around higher elevation.</p> <p>4. Footings shall be poured in neat excavations, without side forms whenever possible.</p> <p>5. Carry all foundations to required depths into compacted fill or natural soil (as per Structural Plans and Details).</p> <p>6. All foundation excavations shall be inspected and approved by the Inspector of Record or Geotechnical Engineer prior to forming and placement of reinforcing or concrete.</p> <p>7. Foundations shall not be poured until all required reinforcing steel, sleeves, inserts, conduits, pipes, etc. and formwork is properly placed and inspected by the Authority having Jurisdiction.</p> <p>8. The sides and bottoms of excavations which are to have concrete contact must be moistened several times just prior to pouring upon them.</p> <p>9. De-water footings, as required, to maintain dry working conditions.</p> <p><b>REINFORCING STEEL</b></p> <p>1. All reinforcing steel shall be deformed intermediate grade bars conforming to ASTM A615, Grade 60 (f<sub>y</sub> = 60 ksi) unless noted otherwise.</p> <p>A. Grade 40 (f<sub>y</sub> = 40 ksi) may be used for #3 bars and smaller.</p> <p>2. Reinforcing steel shall not be welded, unless specifically noted otherwise.</p> <p>3. Welding of reinforcing steel (where specifically noted or detailed) shall conform to ACI 318-14, Section 26.6.4 and AWS D1.4. Welded rebar shall be low-alloy steel conforming to ASTM A706.</p> <p>4. To hold reinforcing bars in their true position and prevent displacement, standard tie and anchorage devices must be provided. Placing of reinforcement shall conform to ACI 318-14 Section 26.6.2.</p> <p>5. Shop drawings for fabrication of any reinforcing steel shall be approved by Contractor and submitted to Project Specific Architect or Project Specific Structural Engineer of Record, for their review, prior to fabrication.</p> <p>6. Refer to typical details for minimum splice length and minimum radius of bend of reinforcing steel.</p> <p>7. All reinforcing steel splices shall be staggered 24", unless specifically noted or detailed otherwise.</p> <p>8. All reinforcing bar bends shall be made cold.</p> <p>9. Fabrication, erection and placement of reinforcing steel shall conform to Concrete Reinforcing Steel Institute of Standard Practice.</p> <p>10. All welded wire mesh shall conform to ASTM A185. Lap all wire mesh two modules.</p> <p>11. Reinforcing steel shall be clean of rust, grease or other material likely to impair bond.</p> <p>12. Epoxy-coated reinforcement (where specifically noted or detailed) shall conform to ASTM A775.</p> |                      | <p><b>CONCRETE</b></p> <p>1. All concrete shall have a minimum ultimate compressive strength (f'<sub>c</sub>) as outlined below at 28 days. All concrete shall be regular weight (unless specifically noted otherwise).</p> <p>A. Concrete for footings: 4,500 psi w/c = 0.45 max. (see note 2)</p> <p>2. For sites subject to soil with exposure class F0, S0, W0, C0, and C1 per ACI 318 19.3.1.1, the following design strength is permissible. The Geotechnical Engineer shall provide written verification of the soil exposure class. Provide exposure class in Table D on SB0.1.</p> <p>A. Concrete for footings: 3,000 psi w/c = 0.45 max.</p> <p>3. Maximum Fly Ash content shall be 15%, by weight, of total cementitious materials and shall conform to ASTM C618.</p> <p>4. All concrete work shall comply with CBC Chapter 19A and ACI 318-14 and latest edition of ACI Manual of Concrete Practice.</p> <p>5. Special Inspection (as required or specified) shall conform to CBC Chapter 17A.</p> <p>6. Cement shall be portland cement Type V and shall conform to ASTM C150.</p> <p>7. Aggregates shall conform to ASTM C33, provide aggregates from a single source.</p> <p>8. Water shall conform to ASTM C94 and be potable.</p> <p>9. All splices are to be Class B unless specifically noted otherwise.</p> <p>10. Where not specifically detailed, the minimum concrete cover on reinforcing steel shall be:</p> <p>A. Concrete cast against and permanently exposed to earth or weather: 3"</p> <p>11. Reinforcing bars larger than #8 are not permitted unless specifically detailed or noted otherwise.</p> <p>12. Location of all construction joints, other than specified, shall be approved by Architect/Structural Engineer of Record prior to pouring. Construction joints shall be thoroughly air and water cleaned and heavily roughened so as to expose coarse aggregates. All surfaces to receive concrete shall be maintained continuously wet at least three hours in advance of pouring.</p> <p>13. All reinforcing steel, anchor bolts, dowels, inserts and any other hardware to be set in concrete shall be well secured in position prior to pouring of concrete.</p> <p>14. Vibrate all concrete as it is placed, with a mechanical vibrator operated by experienced personnel. The vibrator shall be used to consolidate the concrete, not transport it. Reinforcing and forms shall not be vibrated.</p> <p>15. Formwork design and removal shall conform to ACI 318-14 Section 26.11. Remove forms in accordance with the following minimum schedule:</p> <p>A. Side forms of footings: Minimum 48 hours</p> <p>B. Column and pier forms: 72 hours &amp; 70% of design strength</p> <p>16. Concrete shall not free fall more than six feet. Use tremie, pump or other approved methods.</p> <p>17. Concrete shall be maintained in a moist condition for a minimum of 5 days after placement.</p> <p>18. The Contractor may use concrete admixtures as a construction means and methods to execute "Contract or Construction Documents". Use of admixture is solely the responsibility of the Contractor.</p> <p>19. Mix designs shall be prepared by an approved testing laboratory, signed by a licensed engineer and shall be submitted to the Project Specific Structural Engineer of Record for approval.</p> <p>20. Only one grade of concrete shall be allowed on project site at any one time</p> <p>21. Concrete strength shall be verified by standard cylinder tests (in accordance with CBC Section 1905A.1.16) made by an approved testing laboratory.</p> <p>22. Concrete placed when the air temperature has fallen to, or is expected to fall below 40° shall conform to ACI 318-14 Section 26.5.4, and ACI 308R-16.</p> <p>23. Concrete placed during hot weather shall conform to ACI 318-14 Section 26.5.5, and ACI 308R-14.</p> <p>24. Conduits and sleeves placed within structural concrete shall not be tied directly to structural reinforcement.</p> <p>A. 1" concrete cover shall be maintained around all reinforcement.</p> <p>25. No stakes shall be permitted within the footing section.</p> <p><b>DRILLED CAISSON/PIER AND GRADE BEAM NOTES</b></p> <p>1. Excavations for drilled caissons/pier shall be performed in compliance with local grading codes and ordinances as well as CBC Chapters 18A and 33A.</p> <p>2. Provide Special Inspection in accordance with CBC Section 1705A.8 and Table 1705A.8.</p> <p>3. Excavations for all drilled caissons/piers shall be approved by the Project Geotechnical Engineer prior to placing of concrete.</p> <p>4. Reinforcement for drilled caissons/pier shall be approved by the Structural Engineer of Record prior to placing in caisson/pier excavation.</p> <p>5. De-water caisson/pier footings and building excavation as required to maintain dry working conditions.</p> <p>6. Caisson/piers are to be poured by end of day after completion of drilling operation. All concrete for a particular caisson/pier shall be on the job site prior to drilling the pile hole.</p> <p>7. The Contractor shall be responsible for all shoring, bracing, etc. necessary to support cut and/or fill banks, and existing structures during excavation, and the forming and placement of concrete.</p> <p>8. Bottom of caissons/piers shall be thoroughly cleaned prior to placement of concrete.</p> <p>9. Grade beam reinforcement:</p> <p>A. Stagger splices in horizontal reinforcement.</p> <p>B. Locate splices between the 1/4 and 3/4 spans (between caissons/piers) of grade beams, unless noted otherwise.</p> <p><b>STRUCTURAL STEEL AND WELDING</b></p> <p>1. All structural steel construction shall conform to AISC 360-10 and AISC 341-10.</p> <p>A. Fabrication of all structural steel shall be done in the shop of an approved fabricator. Inspection and approval for fabricator's shops used for fabrication of structural load bearing members, components, materials or assemblies shall conform to CBC Section 170A4.2.5.</p> <p>2. All structural steel shall conform to the following specifications:</p> <p>A. Angles, channels, plates, bars, rounds, and other miscellaneous shapes: Shall conform to ASTM A36 and shall have a minimum yield stress (F<sub>y</sub>) of 36 ksi.</p> <p>B. Wide-flange shapes: Shall conform to ASTM A992 and shall have a minimum yield stress (F<sub>y</sub>) of 50 ksi.</p> <p>C. Structural tubes: Shall be ASTM A500, Grade B, and shall have a min. yield stress (F<sub>y</sub>) of 46 ksi.</p> <p>3. All structural steel fasteners shall conform to the following specifications:</p> <p>A. Bolts shall conform to ASTM A307</p> <p>B. Anchor Bolts shall conform to ASTM F1554, Grade as noted in drawings</p> <p>C. Carbon steel nuts shall conform to ASTM A563</p> <p>D. Stainless steel nuts shall conform to ASTM F594</p> <p>E. Washers shall conform to ASTM F436</p> <p>4. Special Inspection shall be provided for all structural steel and welding, in accordance with CBC Chapter 17A.</p> <p>5. All structural steel shall be fabricated, erected and welded in accordance with AISC Specifications for Structural Steel Buildings (AISC 360-10) and Code of Standard Practice for Steel Buildings and Bridges (AISC 303-10).</p> <p>6. All welding shall be done by qualified and certified welders.</p> <p>7. No field welding permitted, unless specifically noted otherwise.</p> <p>8. Shop drawings for the fabrication of any structural steel shall be approved by the Contractor and submitted to Project Specific Architect or Project Specific Structural Engineer of Record for their review, prior to fabrication.</p> <p>9. No holes other than those specifically detailed shall be allowed through structural steel members. Burning of holes is not permitted.</p> <p>10. All welding shall conform to 'AWS D1.1' specifications for welding. (E-70XX Electrodes).</p> <p>11. Where fillet weld size is not indicated, use 'AWS' minimum size based on the thickness of the thinner part being welded, as specified in AISC Specifications for Structural Steel Buildings (AISC 360-10), Section J2.2.</p> <p>12. All butt welds to be complete joint penetration, unless specifically noted otherwise.</p> <p>13. Welder qualification requirements, welding procedure and welding electrodes for all structural steel (except structural sheet steel, see steel decking) shall conform to CBC Sections 1705A.2.1 and 2204A.1.</p> <p>14. Provide 3" minimum concrete cover around all structural steel below grade.</p> <p>15. Structural steel embedded into concrete shall be uncoated.</p> <p>16. Structural steel shall be hot-dip galvanized (minimum ASTM A123 or A153 Class D) or painted with zinc-rich primer, undercoat, and finish coat; or equivalent paint system.</p> <p>17. All exposed steel fasteners, including cast-in-place anchor bolts/rods, shall be stainless steel (Type 304 minimum), hot-dip galvanized (ASTM A153, Class D minimum or ASTM F2329), or protected with corrosion-preventive coating that demonstrated no more than 2% of red rust in minimum 1,000 hours of exposure in salt spray test per ASTM B117. Zinc plated fasteners do not comply with this requirement.</p> | <p>A.B. Anchor Bolt<br/>ABV. Above<br/>ACI. American Concrete Institute<br/>ADJ. Adjacent<br/>AHJ. Authority Having Jurisdiction<br/>AISC. American Institute of Steel Construction<br/>AOR. Architect of Record<br/>APPROX. Approximately<br/>ASCE. American Society of Civil Engineers<br/>ARCH. Architect, Architecture<br/>ASTM. American Society of Testing and Materials<br/>ATR. All Thread Rod<br/>AWS. American Welding Society<br/>B.O. Bottom of<br/>BOT. Bottom<br/>b/c. Between<br/>C. California Administrative Code<br/>CBC. California Building Code<br/>CIP. Cast-in-place<br/>CJP. Complete Joint Penetration<br/>CL. Centerline<br/>CLR. Clear<br/>COL. Column<br/>CONC. Concrete<br/>CONN. Connection<br/>CONST. Construction<br/>CONT. Continue, Continuous<br/>Ø. Diameter<br/>DBL. Double<br/>DET. Detail<br/>DL. Dead Load<br/>DSA. Division of State Architect<br/>DWGS. Drawings<br/>EA. Each<br/>E.F. Each Face<br/>ELEC. Electric, Electrical<br/>ELEV. Elevation<br/>EMBED. Embedded, Embedment<br/>EOR. Engineer of Record<br/>EQ. Equal<br/>E.S. Each Side<br/>E.W. Each Way<br/>EXT. Exterior<br/>FAB. Fabricated<br/>FDN. Foundation<br/>F.G. Finish Grade<br/>F.O. Face of<br/>FRMG. Framing<br/>FT. Foot<br/>FTG. Footing<br/>GA. Gauge<br/>GALV. Galvanized<br/>GEOR. Geotechnical Engineer of Record</p> <p>HORIZ. Horizontal<br/>HSS. Hollow Steel Section<br/>HT. Height<br/>ICC. International Building Code<br/>ICC. International Code Council<br/>ID. Inside Diameter<br/>IN. Inch, Inches<br/>INT. Interior<br/>ksi. Kips per Square Inch<br/>LL. Live Load<br/>MAX. Maximum<br/>MB. Machine Bolt<br/>MFR. Manufactured, Manufacturer<br/>MIN. Minimum<br/>MPH. Miles per Hour<br/>N/R. Not Required<br/>N.T.S. Not to Scale<br/>o.c. On Center<br/>o. Over<br/>OD. Outside Diameter<br/>PEN. Penetration<br/>PL. Plate<br/>PJP. Partial Joint Penetration<br/>psi. Pounds per Square Inch<br/>PSF. Pounds per Square Foot<br/>REBAR. Reinforcing Bar<br/>REINF. Reinforcement<br/>REQD. Required<br/>S.F. Square Feet<br/>SHT. Sheet<br/>SIM. Similar<br/>SMS. Sheet Metal Screw<br/>SQ. Square<br/>STAGGTD. Staggered<br/>STD. Standard<br/>STL. Steel<br/>SEOR. Structural Engineer of Record<br/>T&amp;B. Top and bottom<br/>THRD. Threaded<br/>T.O. Top of<br/>TYP. Typical<br/>U.N.O. Unless Noted Otherwise<br/>VERT. Vertical<br/>VIF. Verify in Field<br/>w/. With<br/>w/c. Water/Cement Ratio<br/>WSS. Welded Steel Stud<br/>WT. Weight</p> | <p><b>GENERAL NOTES</b></p> <p>1. All Special Inspection shall be provided in accordance with CBC Section 170A4 and 1705A.</p> <p>2. Where Special Inspection is required, all inspection or testing shall be provided by an approved Special Inspection Agency in accordance with CBC Section 1702A.1, 1703A.1 and 1704A.1.</p> <p>3. A Division of the State Architect accepted testing laboratory directly employed by the District (Owner) shall conduct all the required tests and inspections for the project.</p> <p>4. Special Inspectors shall keep records of inspections. The Special Inspector shall furnish inspection reports to the Division of the State Architect, and to the Architect or Engineer of Record. Reports shall indicate the work inspected was done in conformance to approved construction documents. Discrepancies shall be brought to the immediate attention of the contractor for correction. If the discrepancies are not corrected, the discrepancies shall be brought to the attention of the Division of the State Architect and to the Architect or Engineer of Record prior to the completion of that phase of work. A final report documenting required Special Inspections and correction of any discrepancies noted in the inspections shall be submitted at a point in time agreed upon by the permit applicant and the Division of the State Architect prior to the start of work.</p> <p>5. Special Inspectors shall be approved by the Division of the State Architect in accordance with CBC Section 170A4.2.1 and CAC Section 4-335(f)</p> <p><b>CAST-IN-PLACE DEEP FOUNDATIONS<sup>9</sup></b></p> <table><thead><tr><th>Verification and Inspection</th><th>Continuous</th><th>Periodic</th></tr></thead><tbody><tr><td>1. Inspect drilling operations and maintain complete and accurate records for each element.</td><td>✓</td><td></td></tr><tr><td>2. Verify placement locations and plumbness, confirm element diameters, bell diameters (if applicable), lengths, embedment into bedrock (if applicable) and adequate end bearing strata capacity. Record concrete or grout volumes.</td><td>✓</td><td></td></tr><tr><td>3. For concrete elements, perform additional inspections and see Concrete Construction chart, this sheet, in accordance with CBC Section 1705A.3.</td><td></td><td>✓</td></tr></tbody></table> <p>Notes: Cast-in-place Deep Foundations<br/>a. CBC Section 1705A.8 and Table 1705A.8</p> <p><b>CONCRETE CONSTRUCTION<sup>9</sup></b></p> <table><thead><tr><th>Verification and Inspection</th><th>Continuous</th><th>Periodic</th></tr></thead><tbody><tr><td>1. Inspection of reinforcing steel including prestressing tendons, and placement.<sup>9</sup></td><td></td><td>✓</td></tr><tr><td>2. Inspection of reinforcing steel welding in accordance with Table 1705A.2.2. Item 5b.<sup>9</sup></td><td></td><td>✓</td></tr><tr><td>3. Inspection of anchors cast in concrete.<sup>9</sup></td><td></td><td>✓</td></tr><tr><td>4. Verifying use of required design mix.<sup>9</sup></td><td></td><td>✓</td></tr><tr><td>5. At the time fresh concrete is sampled to fabricate specimens for strength tests, perform slump and air content tests, and determine the temperature of the concrete.<sup>1</sup></td><td>✓</td><td></td></tr><tr><td>6. Inspection of concrete placement for proper application techniques.<sup>9</sup></td><td>✓</td><td></td></tr><tr><td>7. Inspection for maintenance of specified curing temperature and techniques.<sup>1</sup></td><td></td><td>✓</td></tr><tr><td>8. Inspect formwork for shape, location and dimensions of the concrete member being formed.<sup>9</sup></td><td></td><td>✓</td></tr><tr><td>9. Batch Plant Inspection.<sup>9</sup></td><td>✓</td><td></td></tr></tbody></table> <p>Notes: Concrete Construction<br/>a. Where applicable, see also CBC Section 1705A.12, Special Inspections for seismic resistance<br/>b. Specific requirements for Special Inspection shall be included in the research report for the anchor issued by an approved source in accordance with ACI 318-14 Section 17.8.2 or other requirements. Where specific requirements are not provided, Special Inspection requirements shall be specified by the Registered Design Professional and shall be approved by the Building Official prior to the commencement of the work.<br/>c. ACI 318: Ch. 20, 25.2, 25.3, 26.5.1-26.5.3, CBC: 1908.4<br/>d. AWS D1.4, ACI 318: 26.5.4<br/>e. ACI 318: 17.8.2<br/>f. ACI 318: 17.8.2.4, 17.8.2<br/>g. ACI 318: Ch. 19, 26.4.3, 26.4.4, CBC: 1904.1, 1904.2<br/>h. ASTM C172, ASTM C31, ACI 318: 26.4.5, 26.12, CBC: 1908.10, 1908.2, 1908.3<br/>i. ACI 318: 26.4.5, CBC: 1908.6, 1908.7, 1908.8<br/>j. ACI 318: 26.4.7, 26.4.9, CBC: 1908.9<br/>k. ACI 318: 26.9.2.1, 26.9.2.3<br/>l. ACI 318: Ch. 26.8<br/>m. ACI 318: 26.10.2<br/>n. ACI 318: 26.10.1 (b)<br/>o. CBC Section 1705A.3 and Table 1705A.3<br/>p. See Special Cases Special Inspection for more requirements<br/>q. Continuous batch plant inspection may be waived by the Authority Having Jurisdiction, subject to the enforcement agency under the following condition:<br/>The concrete plant complies fully with the requirements of ASTM C94, Sections 9 and 10, and has a current certificate from the National Ready Mixed Concrete Association or another agency acceptable to the enforcement agency. The certification shall indicate that the plan has automatic batching and recording capabilities<br/>When continuous batch plant inspection is waived, the following requirements shall apply:<br/>1. An approved agency shall check the first batch at the start of the day to verify materials and proportions conform to the approved mix design.<br/>2. A licensed weighmaster shall positively identify quantity of materials and certify each load by a batch ticket.<br/>3. Batch tickets, including material quantities and weights shall accompany the load shall be transmitted to the inspector of record by the truck driver with load identified thereon. The load shall not be placed without a batch ticket identifying the mix. The inspector of record shall keep a daily record of placements, identifying each truck, its load, and time of receipt at the jobsite, and approximate location of deposit in the structure and shall maintain a copy of the daily record as required by enforcement agency.</p> | Verification and Inspection | Continuous | Periodic | 1. Inspect drilling operations and maintain complete and accurate records for each element. | ✓ |  | 2. Verify placement locations and plumbness, confirm element diameters, bell diameters (if applicable), lengths, embedment into bedrock (if applicable) and adequate end bearing strata capacity. Record concrete or grout volumes. | ✓ |  | 3. For concrete elements, perform additional inspections and see Concrete Construction chart, this sheet, in accordance with CBC Section 1705A.3. |  | ✓ | Verification and Inspection | Continuous | Periodic | 1. Inspection of reinforcing steel including prestressing tendons, and placement. <sup>9</sup> |  | ✓ | 2. Inspection of reinforcing steel welding in accordance with Table 1705A.2.2. Item 5b. <sup>9</sup> |  | ✓ | 3. Inspection of anchors cast in concrete. <sup>9</sup> |  | ✓ | 4. Verifying use of required design mix. <sup>9</sup> |  | ✓ | 5. At the time fresh concrete is sampled to fabricate specimens for strength tests, perform slump and air content tests, and determine the temperature of the concrete. <sup>1</sup> | ✓ |  | 6. Inspection of concrete placement for proper application techniques. <sup>9</sup> | ✓ |  | 7. Inspection for maintenance of specified curing temperature and techniques. <sup>1</sup> |  | ✓ | 8. Inspect formwork for shape, location and dimensions of the concrete member being formed. <sup>9</sup> |  | ✓ | 9. Batch Plant Inspection. <sup>9</sup> | ✓ |  |
| Verification and Inspection  | Continuous           | Periodic  | |
| 1. Inspect drilling operations and maintain complete and accurate records for each element.  | ✓                    | |
| 2. Verify placement locations and plumbness, confirm element diameters, bell diameters (if applicable), lengths, embedment into bedrock (if applicable) and adequate end bearing strata capacity. Record concrete or grout volumes.  | ✓                    | |
| 3. For concrete elements, perform additional inspections and see Concrete Construction chart, this sheet, in accordance with CBC Section 1705A.3.  |                      | ✓   | |
| Verification and Inspection  | Continuous           | Periodic  | |
| 1. Inspection of reinforcing steel including prestressing tendons, and placement. <sup>9</sup>   |                      | ✓   | |
| 2. Inspection of reinforcing steel welding in accordance with Table 1705A.2.2. Item 5b. <sup>9</sup>   |                      | ✓   | |
| 3. Inspection of anchors cast in concrete. <sup>9</sup>  |                      | ✓   | |
| 4. Verifying use of required design mix. <sup>9</sup>  |                      | ✓   | |
| 5. At the time fresh concrete is sampled to fabricate specimens for strength tests, perform slump and air content tests, and determine the temperature of the concrete. <sup>1</sup>   | ✓                    | |
| 6. Inspection of concrete placement for proper application techniques. <sup>9</sup>  | ✓                    | |
| 7. Inspection for maintenance of specified curing temperature and techniques. <sup>1</sup>   |                      | ✓   | |
| 8. Inspect formwork for shape, location and dimensions of the concrete member being formed. <sup>9</sup>   |                      | ✓   | |
| 9. Batch Plant Inspection. <sup>9</sup>  | ✓                    | |
| <b>STEEL CONSTRUCTION<sup>9</sup></b>  | |
| Verification and Inspection  | Continuous           | Periodic  | |
| Required verification and inspection of steel construction   | |
| 1. Material verification of structural steel, cold-formed steel deck, high-strength bolts, nuts and washers:<br>a. For structural steel, identification markings to conform to AISC 360, or ASTM Standards Specified in approved Construction Documents. Manufacturer's certificate of compliance required.  |                      | ✓   | |
| 2. Material verification of structural steel:<br>a. Identification markings to conform to ASTM standards specified in the approved construction documents.<br>b. Manufacturer's certified test reports.  |                      | ✓   | |
| 3. Material verification of weld filler materials:<br>a. Identification markings to conform to AWS specification in the approved Construction Documents<br>b. Manufacturer's certificate of compliance required  |                      | ✓   | |
| 4. Inspection of welding:<br>a. Structural steel and cold formed steel deck:<br>1) Complete and partial joint penetration groove welds<br>2) Multi-pass fillet welds<br>3) Single-pass fillet welds > 3/8"<br>5) Single-pass fillet welds < 3/8"   | ✓                    | ✓   | |
| 5. Inspection of steel frame joint details for compliance:<br>a. Details such as bracing and stiffening<br>b. Member locations<br>c. Application of joint details at each connection   | ✓                    | ✓   | |
| Inspection tasks prior to welding  | |
| 1. Welding procedure specifications (WSPs) available   | ✓                    | |
| 2. Manufacturer certifications for welding consumables available   | ✓                    | |
| 3. Material identification (type/grade)  | ✓                    | |
| 4. Welder identification system <sup>9</sup>   | ✓                    | |
| 5. Fit-up of groove welds (including joint geometry)<br>Joint preparation, dimensions, cleanliness, tacking, backing type and fit  | ✓                    | |
| 6. Configuration and finish of access holes  | ✓                    | |
| 7. Fit-up of fillet welds<br>Dimensions, cleanliness, tacking  | ✓                    | |
| 8. Check welding equipment   | |
| Inspection tasks during welding  | |
| 1. Use of qualified welders  |                      | ✓   | |
| 2. Control and handling of welding consumables<br>Packaging, exposure control  | ✓                    | |
| 3. No welding over cracked tack welds  |                      | ✓   | |
| 4. Environmental conditions<br>Wind speed within limits, precipitation and temperature   | ✓                    | |
| 5. WPS followed<br>Settings on welding equipment, travel speed, selected welding materials, shielding gas type/flow rate, preheat applied, interpass temperature maintained min./max., proper position (F, V, H, OH)   | ✓                    | |
| 6. Welding techniques<br>Interpass and final cleaning, each pass within profile limitations  | ✓                    | |
| Inspection tasks after welding   | |
| 1. Welds cleaned   |                      | ✓   | |
| 2. Size, length and location of welds  | ✓                    | |
| 3. Welds meet visual acceptance criteria<br>Crack prohibition, weld/beta-metal fusion, crater cross section, weld profiles, weld size, undercut, porosity  | ✓                    | |
| 4. Arc strikes   | ✓                    | |
| 5. k-Area <sup>9</sup>   | ✓                    | |
| 6. Backing removed and weld tabs removed (if required)   | ✓                    | |
| 7. Repair activities   | ✓                    | |
| 8. Document acceptance or rejection of welded joint or member  | ✓                    | |
| Verification and Inspection  | Continuous           | Periodic  | |
| Inspection tasks prior to bolting <sup>9</sup>   | |
| 1. Manufacturer's certifications available for fastener materials  | ✓                    | |
| 2. Fasteners marked in accordance with ASTM requirements   |                      | ✓   | |
| 3. Proper fasteners selected for the joint detail (grade, type, bolt length if threads are to be excluded from shear plane)  |                      | ✓   | |
| 4. Proper bolting procedure selected for joint detail  |                      | ✓   | |
| 5. Connecting elements, including the appropriate laying surface condition and hole preparation, if specified, meet applicable requirements  |                      | ✓   | |
| 6. Pre-installation certification testing by installation personnel observed and documented for fastener assemblies and methods used   |                      | ✓   | |
| 7. Proper storage provided for bolts, nuts, washer and other fastener components   |                      | ✓   | |
| Inspection tasks during bolting  | |
| 1. Fastener assemblies, of suitable condition, placed in all holes and washers (if required) are positioned as required  |                      | ✓   | |
| 2. Joint brought to the snug-tight condition prior to the pretensioning operation  |                      | ✓   | |
| 3. Fastener component not turned by the wrench prevented from rotating   |                      | ✓   | |
| 4. Fasteners are pretensioned in accordance with the RSCS specification, progressing systematically from the most rigid point toward the free edges, see Minimum Bolt Pretension table below   |                      | ✓   | |
| Inspection tasks after bolting   | |
| 1. Document acceptance or rejection of bolted connections  | ✓                    | |
| Notes: Steel Construction<br>a. CBC Section 1705A.2 and Table 1705A.2.2<br>b. CBC Section 1707A.11.1<br>c. AWS D1.3<br>d. AWS D1.4, ACI 318: Section 3.5.2<br>e. The fabricator or erector, as applicable, shall maintain a system by which a welder who has welded a joint or member can be identified. Stamps, if used, shall be the low-stress type<br>f. When welding of doubler plates, continuity plates or stiffeners has been performed in the k-area, visually inspect the web k-area for cracks within 3 inches of the weld<br>g. All methods of installation for high strength bolts shall require verification of pre-tension by a Skidmore-Welch callibrator for each batch or source of bolts used (see minimum pre-tension chart below).  | |
| Minimum Bolt Pretension (kips)   | |
| Bolt size, inches  | Group A (A325, etc.) | Group B (A490, etc.)  | |
| 1/2" Diameter  | 12                   | 15  | |
| 3/4" Diameter  | 19                   | 24  | |
| 1" Diameter  | 28                   | 35  | |
| 1 1/4" Diameter  | 39                   | 49  | |
| 1 1/2" Diameter  | 51                   | 64  | |
| 1 3/4" Diameter  | 56                   | 80  | |
| 2" Diameter  | 71                   | 102   | |
| 2 1/4" Diameter  | 85                   | 121   | |
| 2 1/2" Diameter  | 103                  | 148   | |

IDENTIFICATION STAMP  
DIV. OF THE STATE ARCHITECT  
APP. 02-118017 INC.  
REVIEWED FOR  
DATE: 04/10/2020

REGISTERED PROFESSIONAL ENGINEER  
No. 5405  
STATE OF CALIFORNIA  
STRUCTURAL

SEAL NO. 10.16.18

THESE DRAWINGS, NOTES AND DETAILS ARE INSTRUMENTS OF SERVICE AND ARE THE PROPERTY OF SMITH STRUCTURAL GROUP, LLP. ALL DRAWINGS, INFORMATION, SPECIFICATIONS, IDEAS, DESIGN AND ARRANGEMENTS REPRESENTED WITHIN THESE DOCUMENTS SHALL REMAIN THE PROPERTY OF THE ENGINEER. NO PART THEREOF SHALL BE COPIED, REPRODUCED OR USED IN CONNECTION WITH ANY WORK OR PROJECT OTHER THAN THE SPECIFIC PROJECT FOR WHICH THEY HAVE BEEN PREPARED AND DEVELOPED WITHOUT THE EXPRESS WRITTEN CONSENT OF THE ENGINEER. COPYRIGHT 2018. THANK YOU FOR YOUR INTEREST IN NEVCO SCHEDULED PRODUCTS

NEVCO

301 East Harris Avenue, Greenville, Illinois 62246  
Phone: (618) 664-0360  
www.nevco.com

PRE-CHECK (PC) DOCUMENT  
CODE: 2016  
A separate project application for construction is required.

DSA FILE NUMBER: PC-90  
IDENTIFICATION STAMP  
DIV. OF THE STATE ARCHITECT  
APP. 02-118017 INC.  
REVIEWED FOR  
DATE: 04/10/2020


SEALED

SHEET INFORMATION  
DATE: 10.16.18  
DRAWN: JMK / JMM  
CHECKED: JMM / MEP  
BSO JOB #: S17015  
SHEET: SB0.3



| ONE COLUMN ASSEMBLY |                               |             |                    |                       |                  |          |                             |
|---------------------|-------------------------------|-------------|--------------------|-----------------------|------------------|----------|-----------------------------|
| ASSEMBLY CRITERIA   |                               |             |                    | PIER FOOTING CRITERIA |                  |          |                             |
| ASSEMBLY WIDTH, W   | CHECK OPTION THIS APPLICATION | MAX. WEIGHT | ASSEMBLY HEIGHT, H | COLUMN SIZE           | PIER DIAMETER, d | DEPTH, D | TRANS. REINF. (1)           |
| 8'-0"               |                               | 570 lbs.    | ≤ 4'-0"            | HSS8x8x $\frac{1}{2}$ | 30"Ø             | 6'-6"    | #4 @ 4 $\frac{1}{2}$ " o.c. |
| 10'-0"              |                               | 1,535 lbs.  | ≤ 8'-0"            | HSS8x8x $\frac{1}{2}$ | 30"Ø             | 9'-0"    | #4 @ 4 $\frac{1}{2}$ " o.c. |

NOTES: (H)  
1. CONTRACTOR OPTION TO PROVIDE SPIRAL REINFORCING IN LIEU OF TIES. SPIRAL PITCH SHALL MATCH TIE SPACING.  
2. CONTRACTOR IS RESPONSIBLE FOR CASING PIERS AND DRILLING SEQUENCING TO PROTECT PIER EXCAVATION

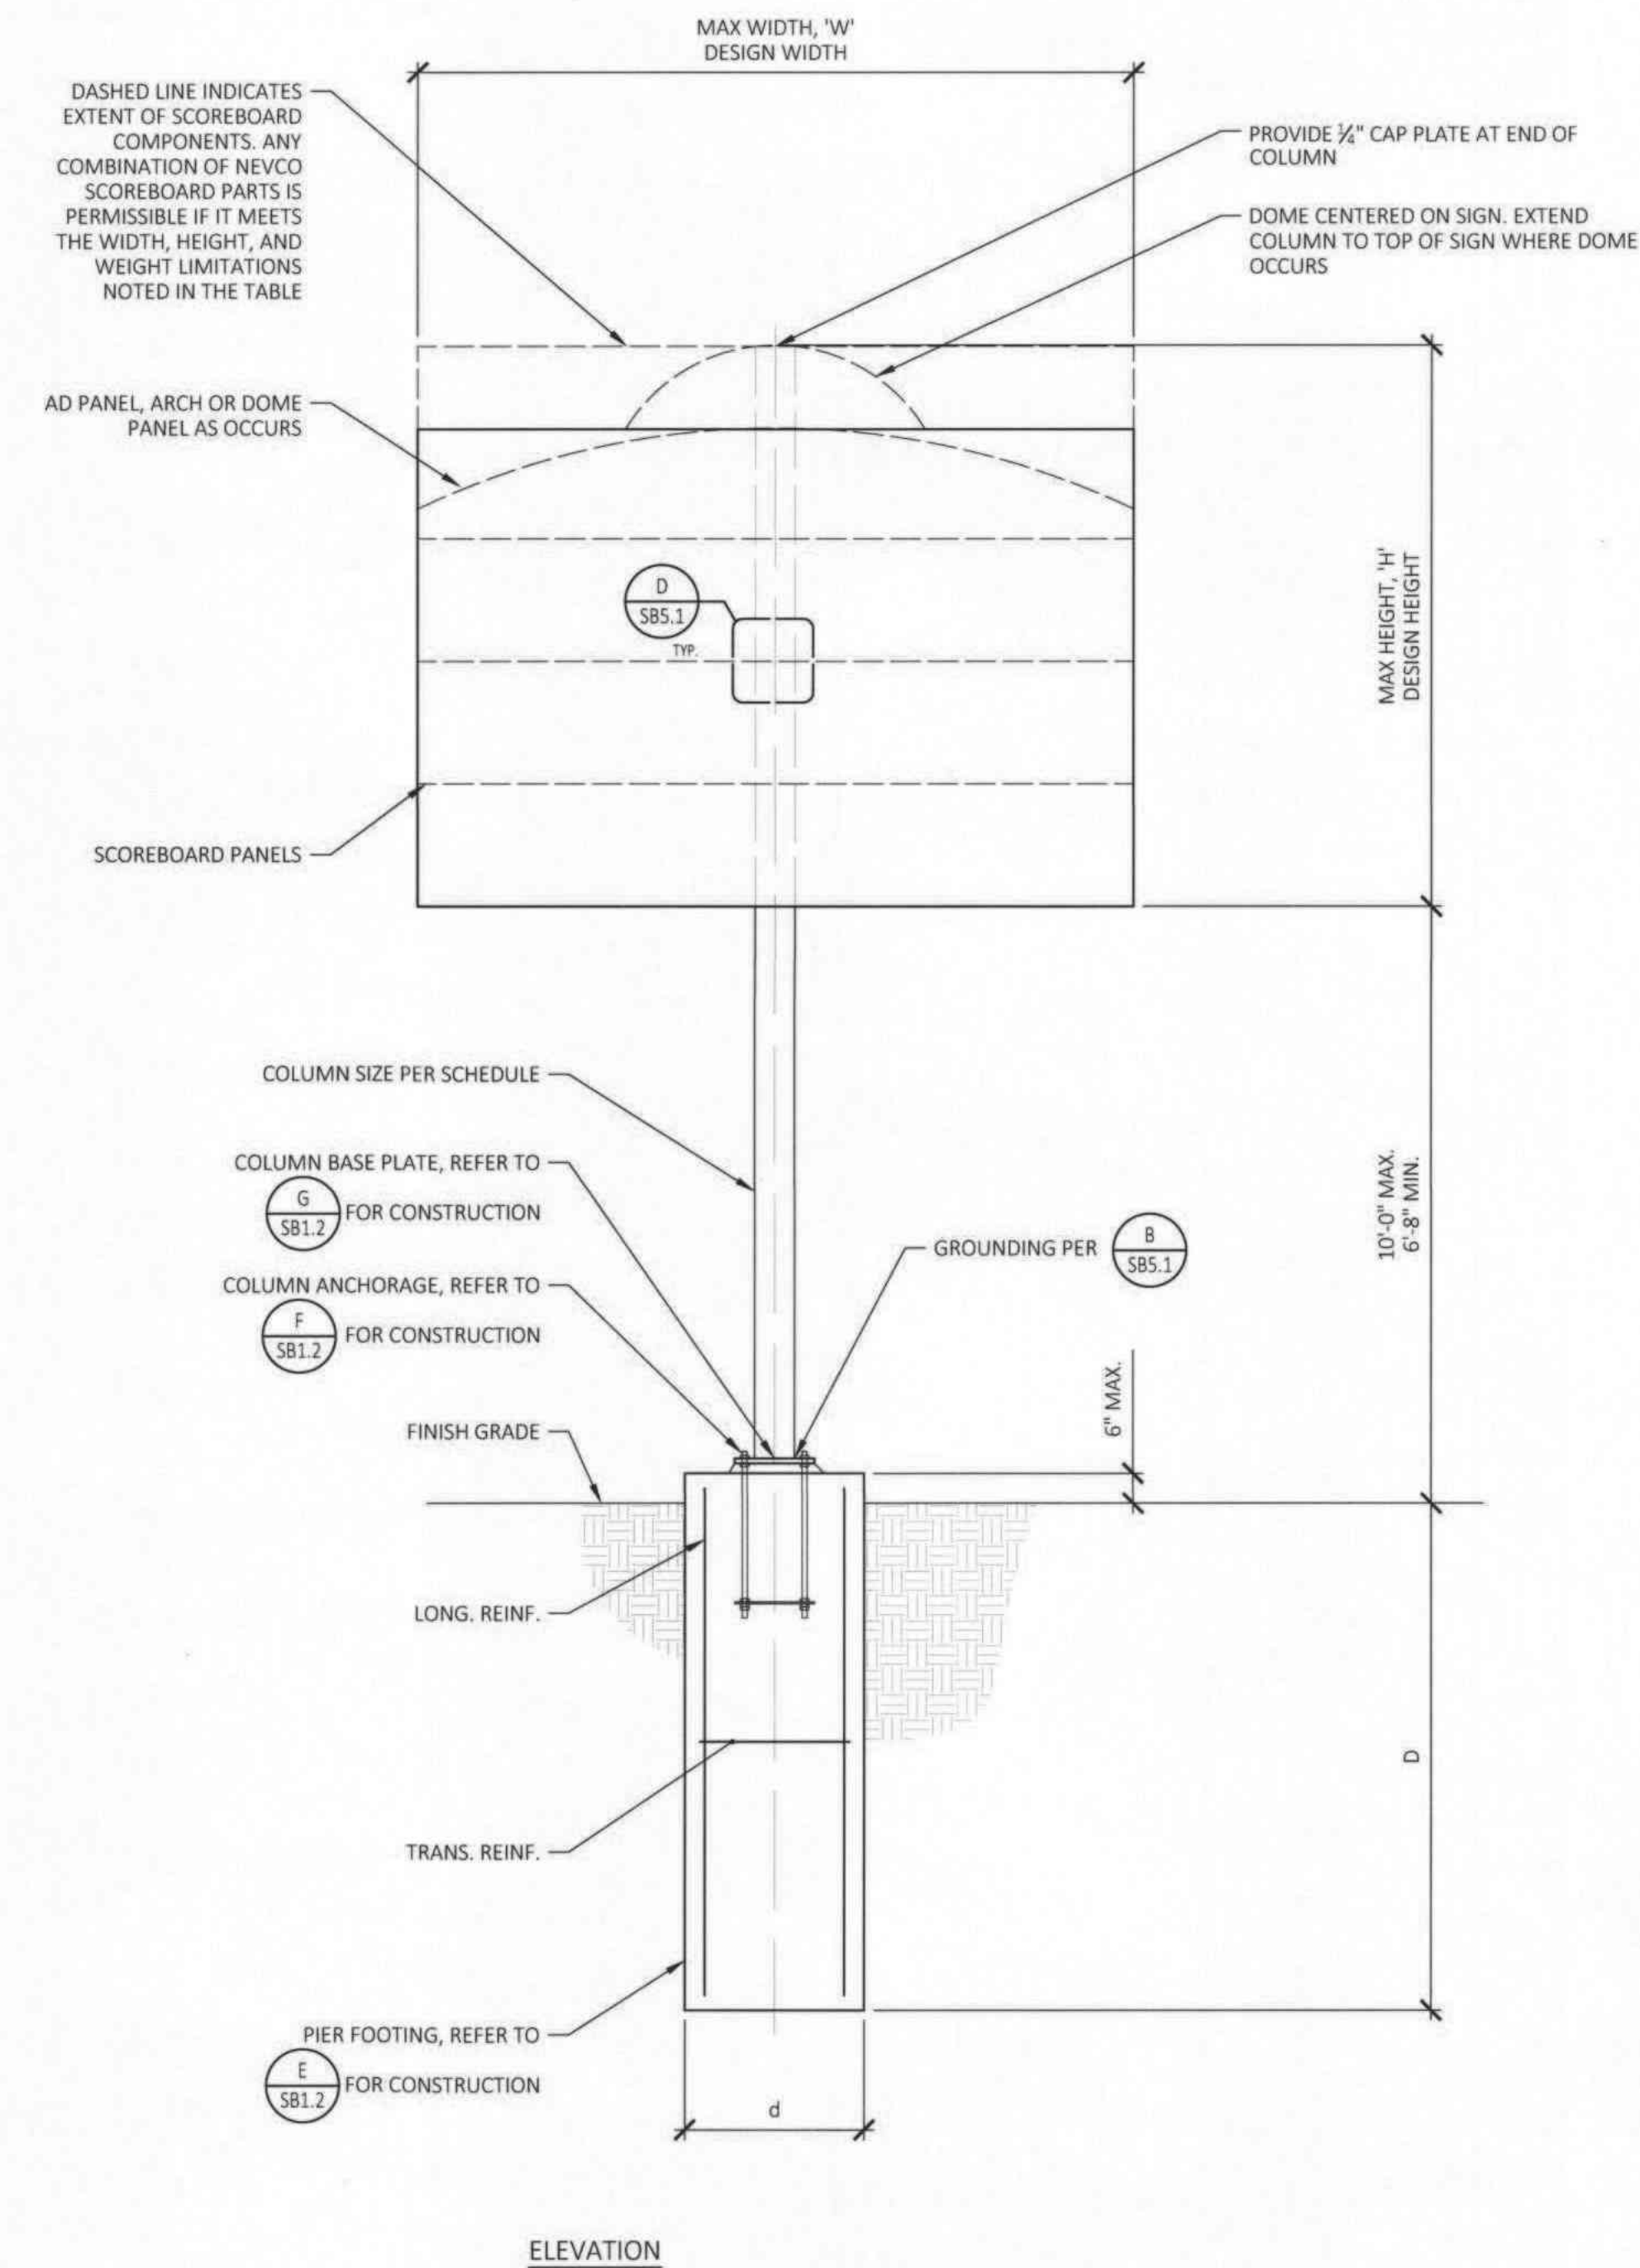

## ONE COLUMN SCOREBOARD INSTALLATION




N.T.S.

| BASE PLATE SCHEDULE   |              |          |           |                        |                      |             |                   |                   |        |
|-----------------------|--------------|----------|-----------|------------------------|----------------------|-------------|-------------------|-------------------|--------|
| COLUMN SIZE           | BASE PLATE   |          |           |                        | ANCHOR ROD           |             |                   |                   |        |
|                       | THICKNESS, t | WIDTH, B | LENGTH, L | WELD                   | QUANTITY & DIAMETER  | GRADE       | EDGE DISTANCE, X  | GROUT HEIGHT      | EMBED. |
| HSS8x8x $\frac{1}{2}$ | 1"           | 16"      | 16"       | $\frac{3}{8}$ " FILLET | 4-1 $\frac{1}{2}$ "Ø | F1554 Gr.36 | 2 $\frac{1}{2}$ " | 1 $\frac{1}{2}$ " | 48"    |

NOTES: (H)  
1. SEE SCOREBOARD ELEVATION, A/SB1.2

### BASE PLATE


N.T.S.

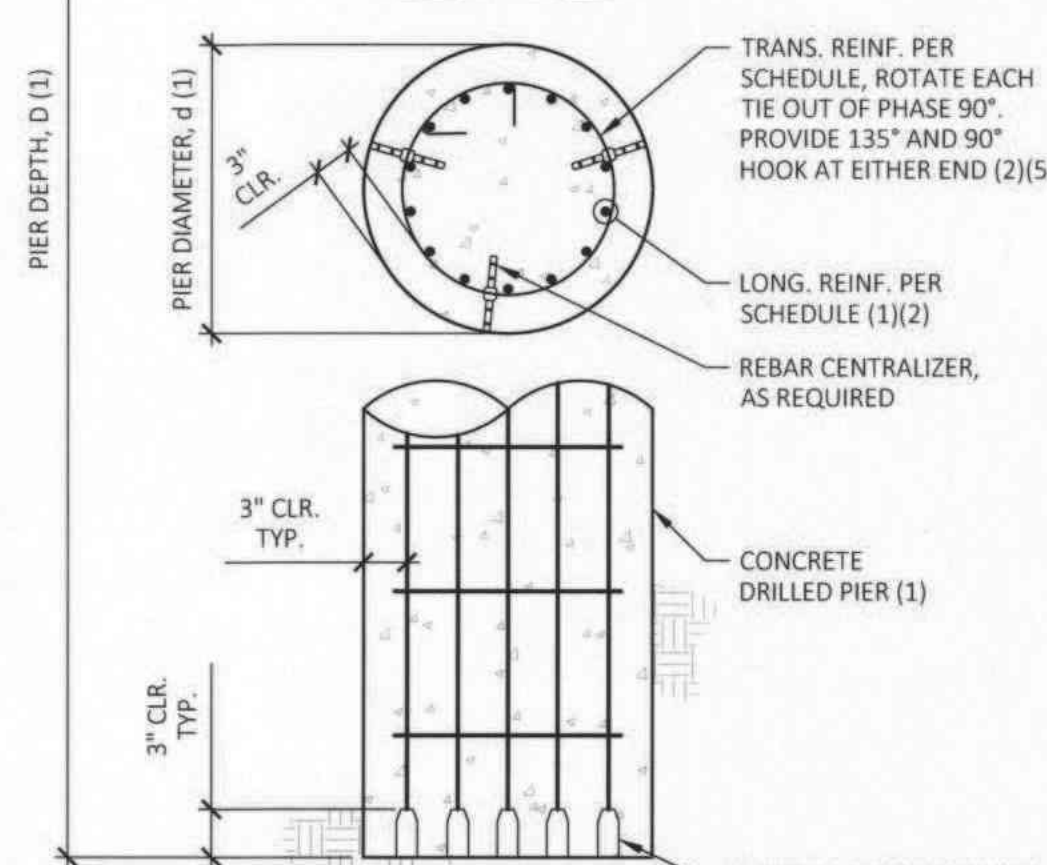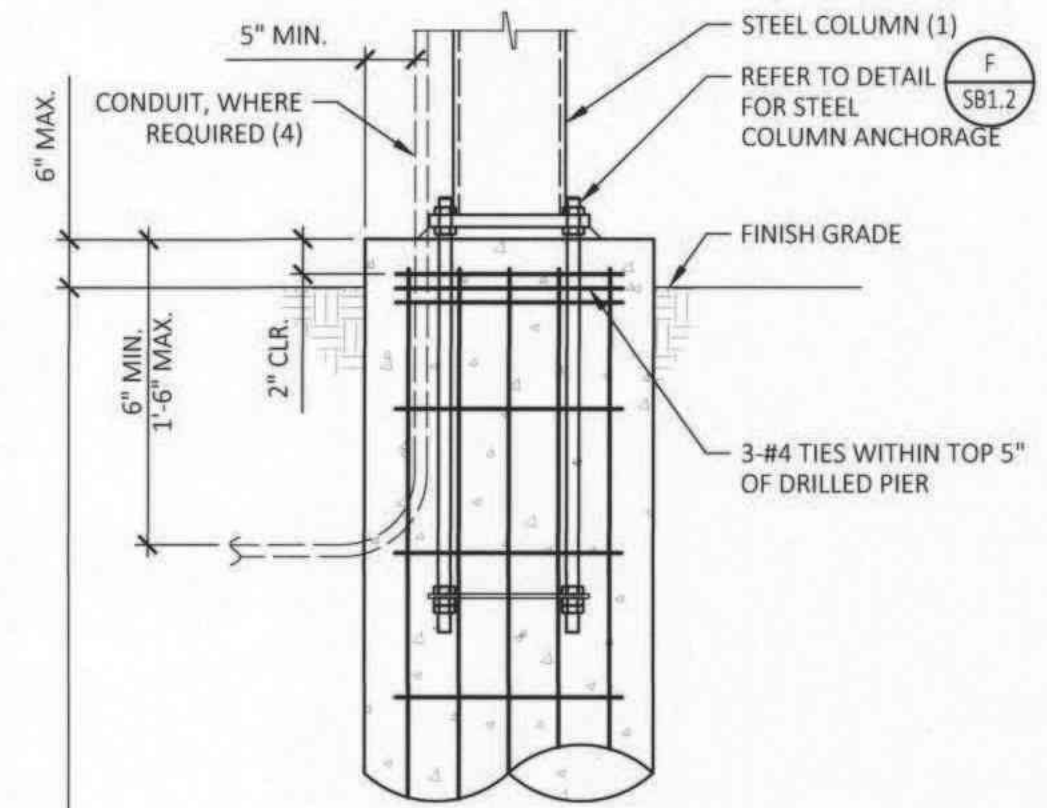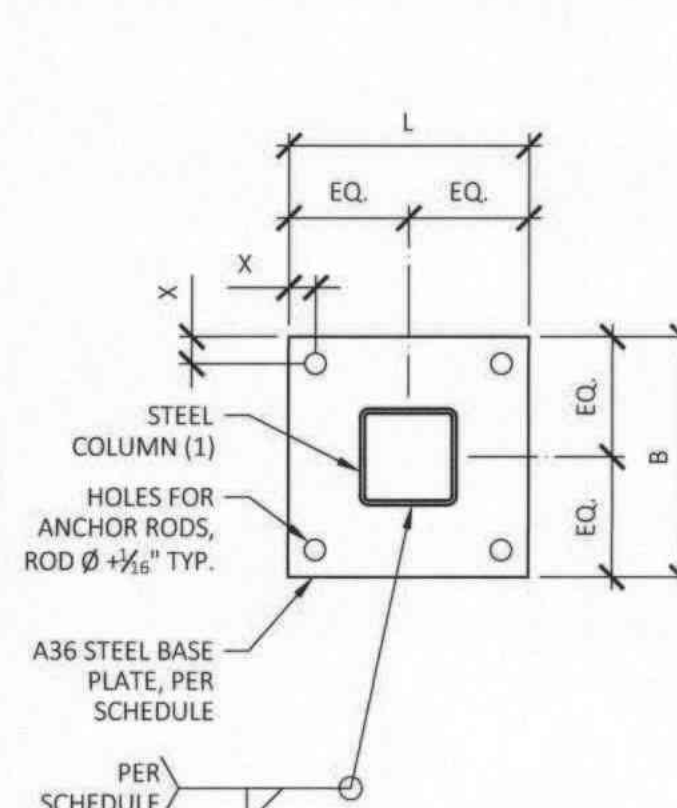

NOTES: (H)  
1. SEE ELECTRONIC SIGN ELEVATION, A/SB1.2  
2. SEE DETAILS C/SB1.2 & D/SB1.2 FOR REINFORCEMENT BEND & TIE REQUIREMENTS  
3. SPLICE REINFORCEMENT PER B/SB1.2 AS REQUIRED. ALL SPLICES ARE TO BE CLASS B.  
4. LOCATION OF CONDUIT APPROACH SHOWN GRAPHICALLY ONLY FOR REFERENCE. VERIFY ACTUAL CONDITIONS IN FIELD.  
5. TIE SHALL OVERLAP ITSELF A MINIMUM OF 6\"/>

## CONCRETE DRILLED PIER


N.T.S.

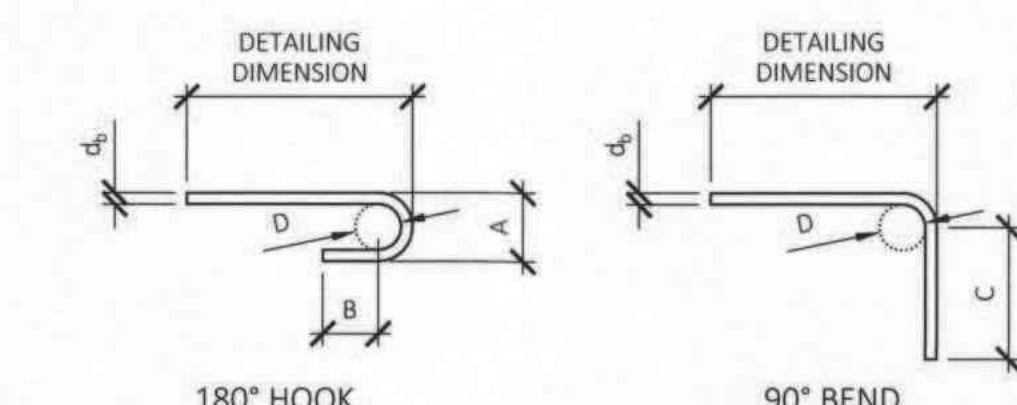

| Bar Size | D                  | A                  | B (4d <sub>b</sub> ) [2 $\frac{1}{2}$ " min.] | C (12d <sub>b</sub> ) |
|----------|--------------------|--------------------|---|-----------------------|
| #3       | 2 $\frac{1}{2}$ "Ø | 3"                 | 2 $\frac{1}{2}$ "                             | 4 $\frac{1}{2}$ "     |
| #4       | 3"Ø                | 4"                 | 2 $\frac{1}{2}$ "                             | 6"                    |
| #5       | 3 $\frac{1}{2}$ "Ø | 5"                 | 2 $\frac{1}{2}$ "                             | 7 $\frac{1}{2}$ "     |
| #6       | 4 $\frac{1}{2}$ "Ø | 6"                 | 3"  | 9"                    |
| #7       | 5 $\frac{1}{2}$ "Ø | 7"                 | 3 $\frac{1}{2}$ "                             | 10 $\frac{1}{2}$ "    |
| #8       | 6"Ø                | 8"                 | 4"  | 12"                   |
| #9       | 9"Ø                | 11 $\frac{1}{2}$ " | 4 $\frac{1}{2}$ "                             | 13 $\frac{1}{2}$ "    |
| #10      | 10"Ø               | 12 $\frac{1}{2}$ " | 5"  | 15"                   |

## REBAR HOOKS & BENDS

N.T.S.

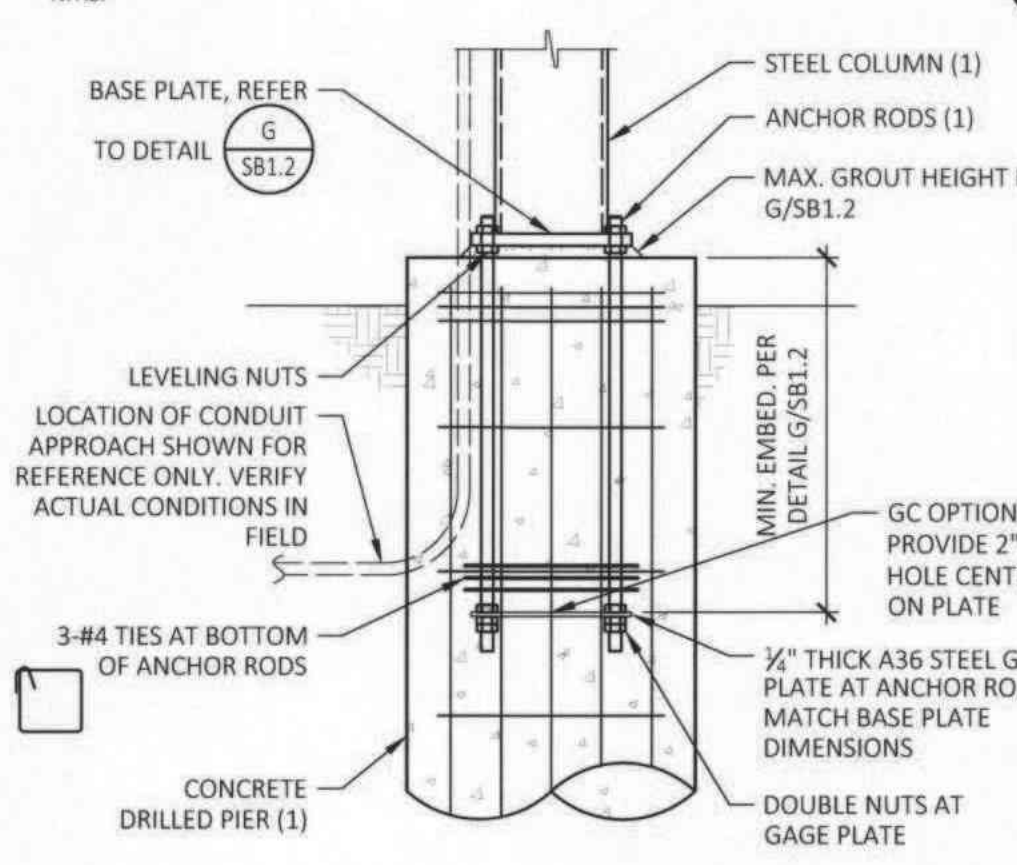

NOTES: (H)  
1. SEE SCOREBOARD ELEVATION, A/SB1.2

## STEEL COLUMN ANCHORAGE


N.T.S.

| Bar Size | Concrete Reinforcing Splices (1)(2) |                    |  | f <sub>y</sub> (Min.) |
|----------|-------------------------------------|--------------------|--|-----------------------|
|          | Class A (3) Splice                  | Class B (3) Splice |  |                       |
| #3       | 16"                                 | 21"                |  | 40 ksi                |
| #4       | 21"                                 | 27"                |  | 60 ksi                |
| #5       | 40"                                 | 51"                |  | 60 ksi                |
| #6       | 47"                                 | 61"                |  | 60 ksi                |
| #7       | 55"                                 | 71"                |  | 60 ksi                |
| #8       | 64"                                 | 82"                |  | 60 ksi                |
| #9       | 71"                                 | 92"                |  | 60 ksi                |
| #10      | 80"                                 | 103"               |  | 60 ksi                |


NOTES: (H)  
1. LAP LENGTHS LISTED APPLY TO VERTICAL REINFORCEMENT  
2. WHERE BARS OF A DIFFERENT SIZE ARE LAPPED, THE LAP LENGTH SHALL BE THE LENGTH REQUIRED BY THE LARGER BAR  
3. ALL SPLICES SHALL BE CONSIDERED CLASS B UNLESS SPECIFICALLY NOTED OTHERWISE

## TYPICAL LAP SPLICES


N.T.S.

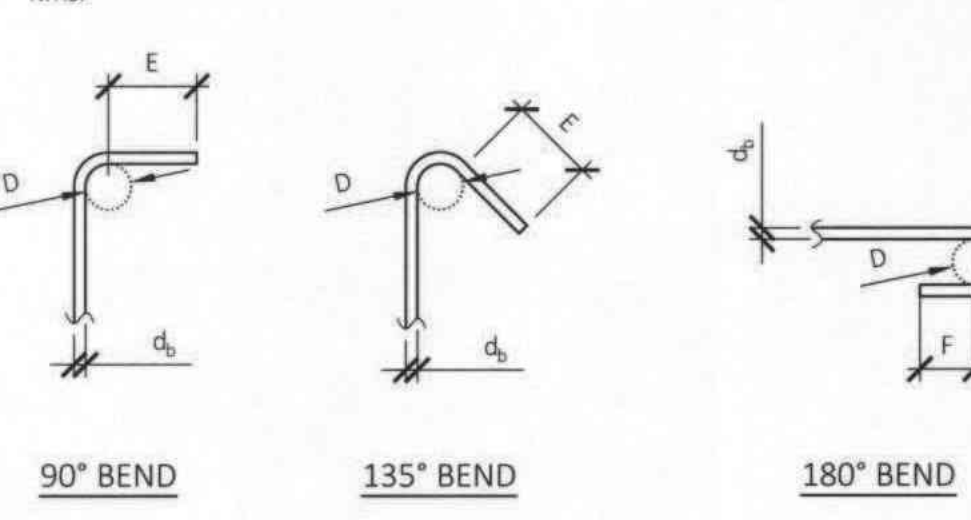




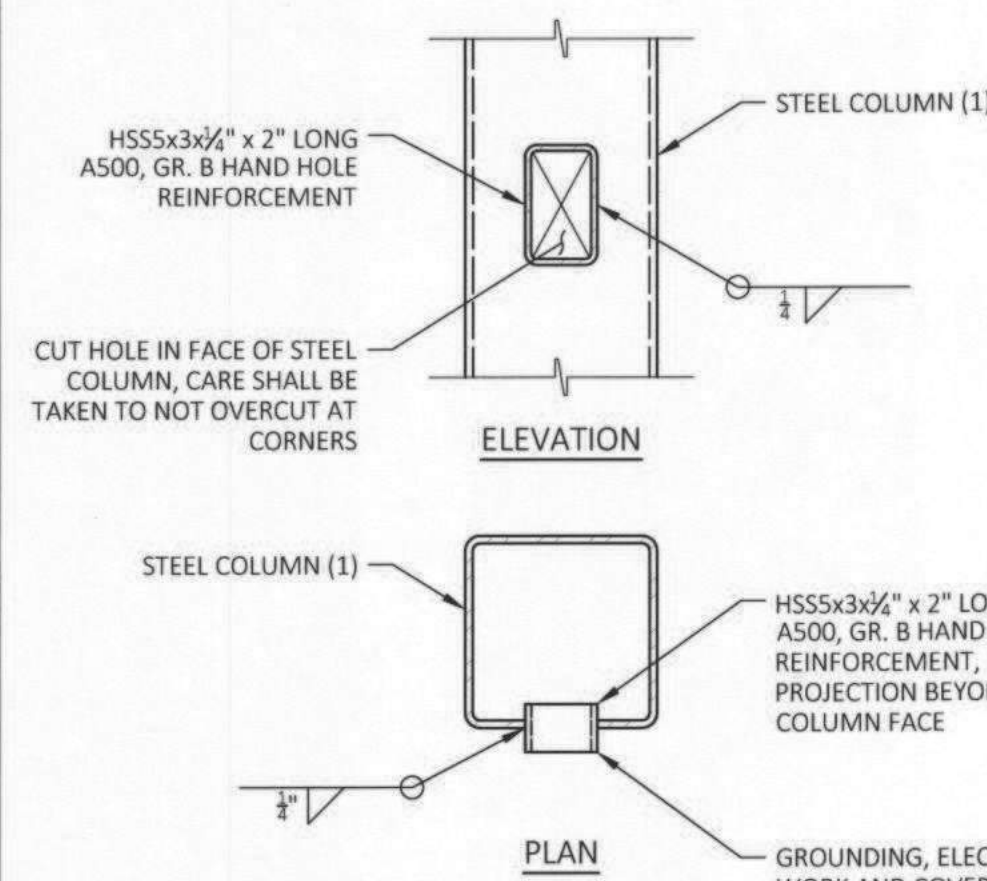


CONDUIT HAND HOLE  
N.T.S.

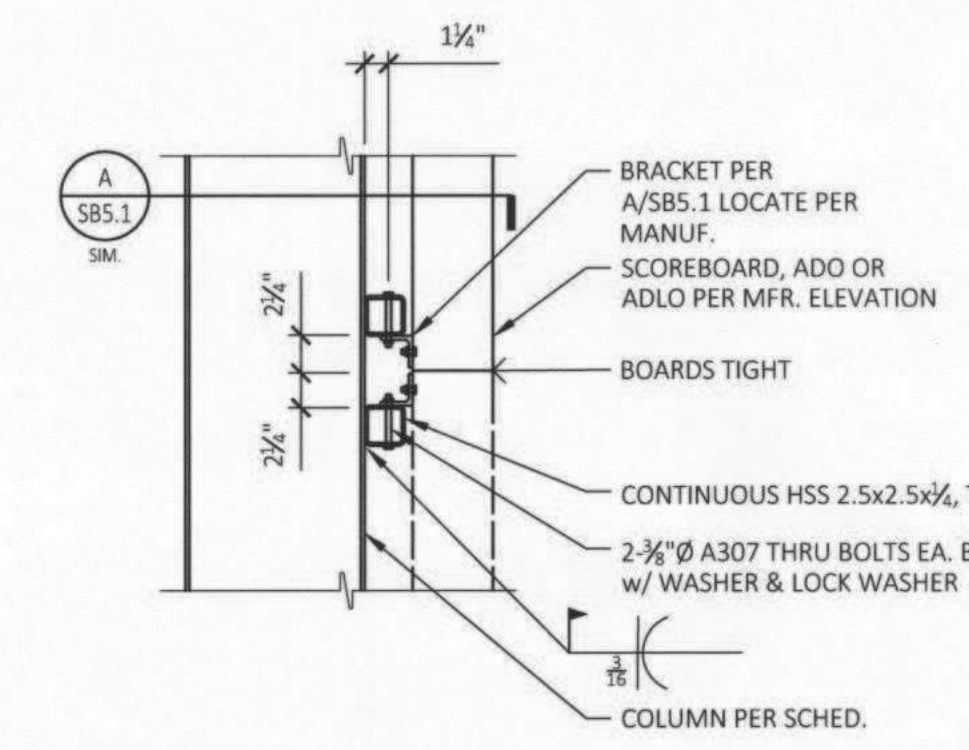


ALT. BOARD ATTACHMENT  
N.T.S.

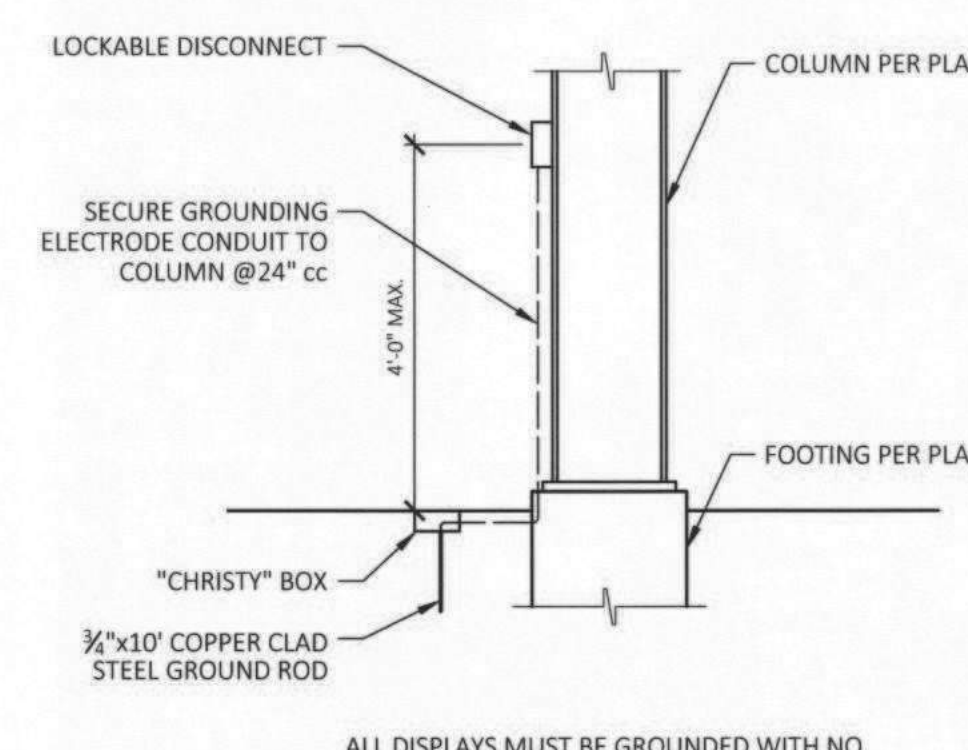


GROUNDING DETAIL  
N.T.S.

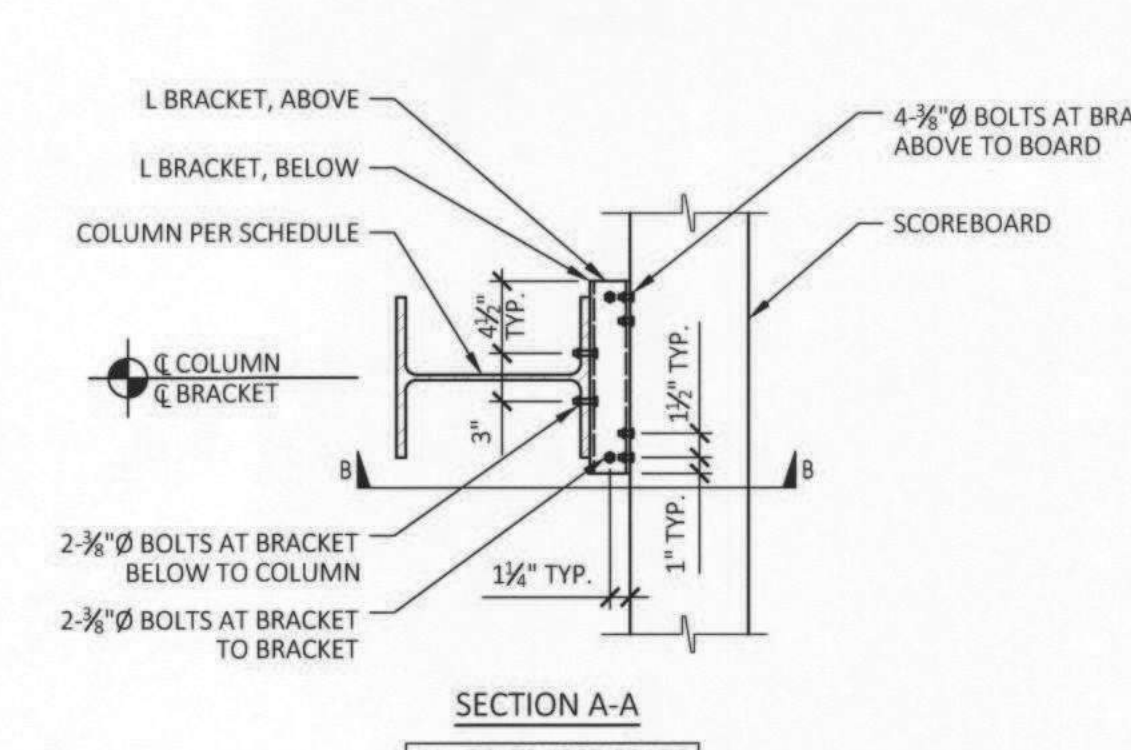


SCOREBOARD, ADO AND ADLO ATTACHMENTS  
N.T.S.

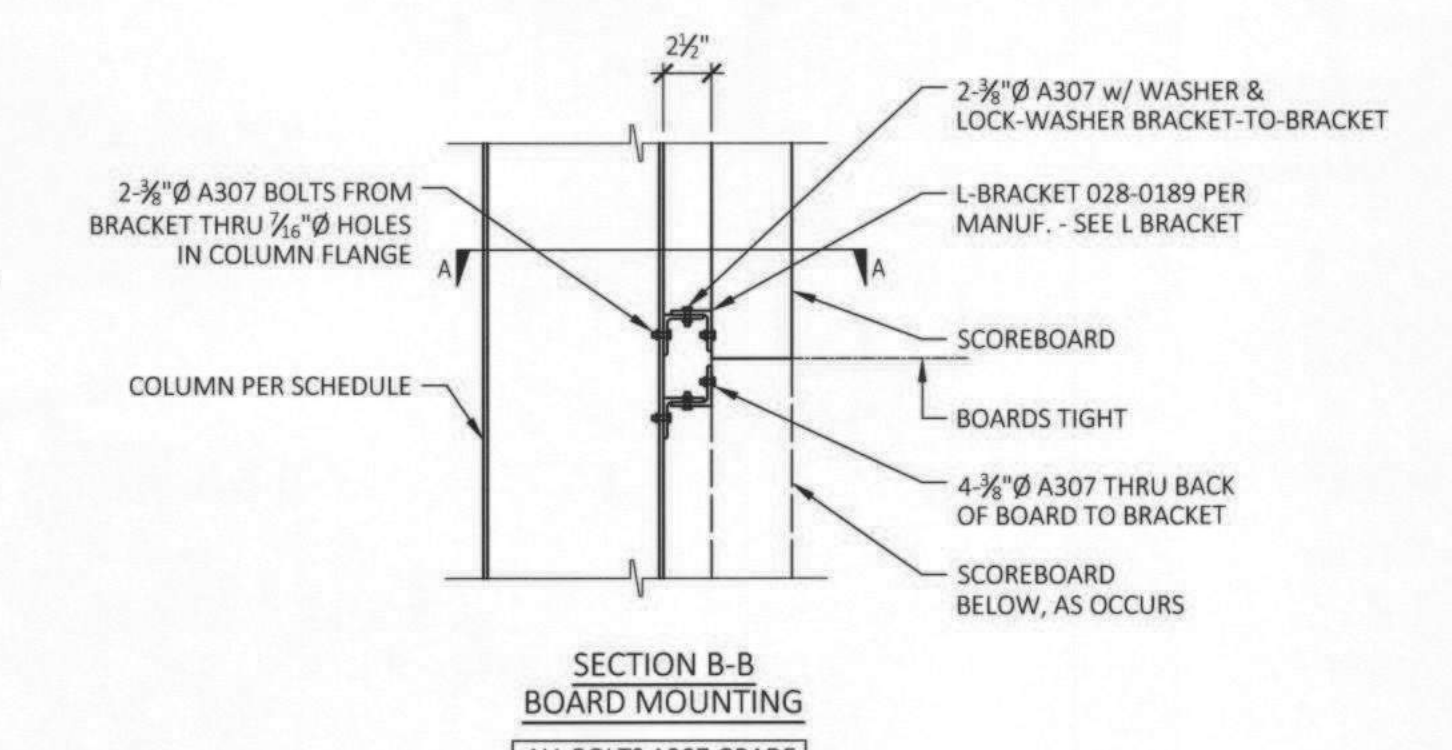


SCOREBOARD, ADO AND ADLO ATTACHMENTS  
N.T.S.

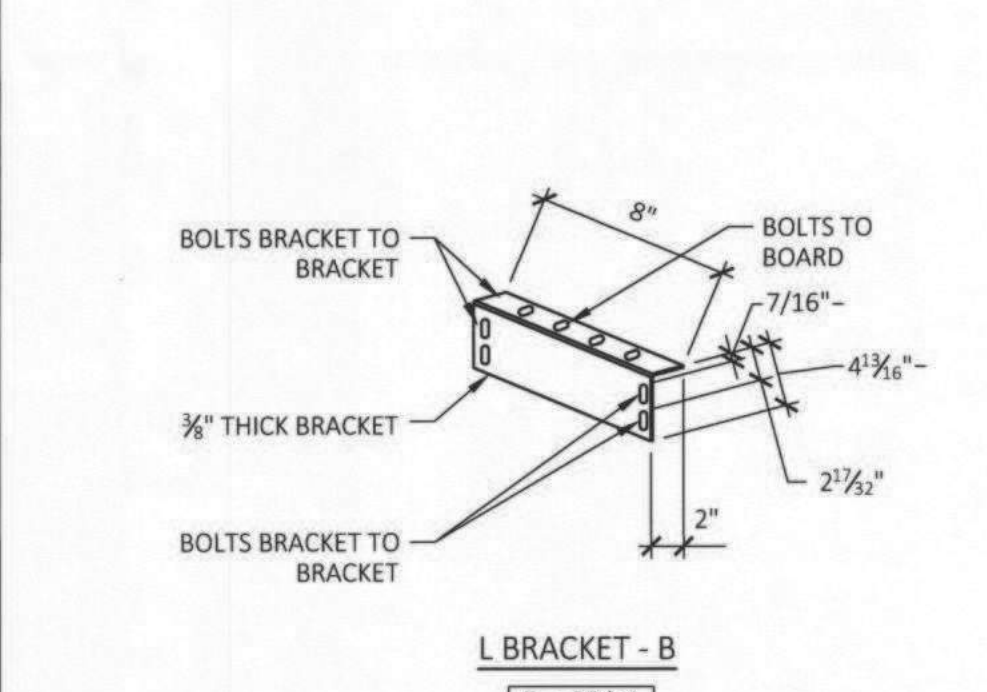


L BRACKET - B  
Fy = 50 ksi

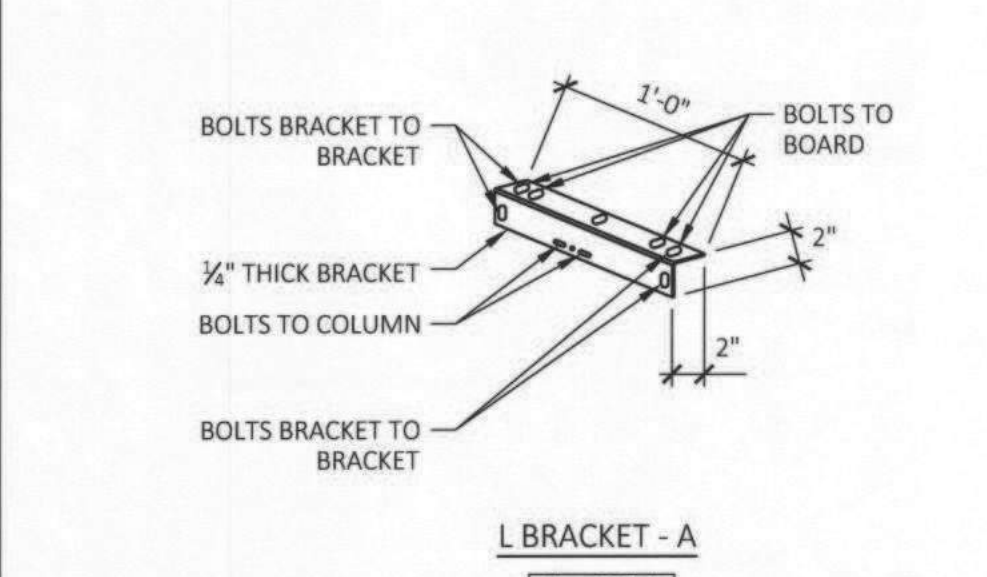


L BRACKET - A  
Fy = 50 ksi

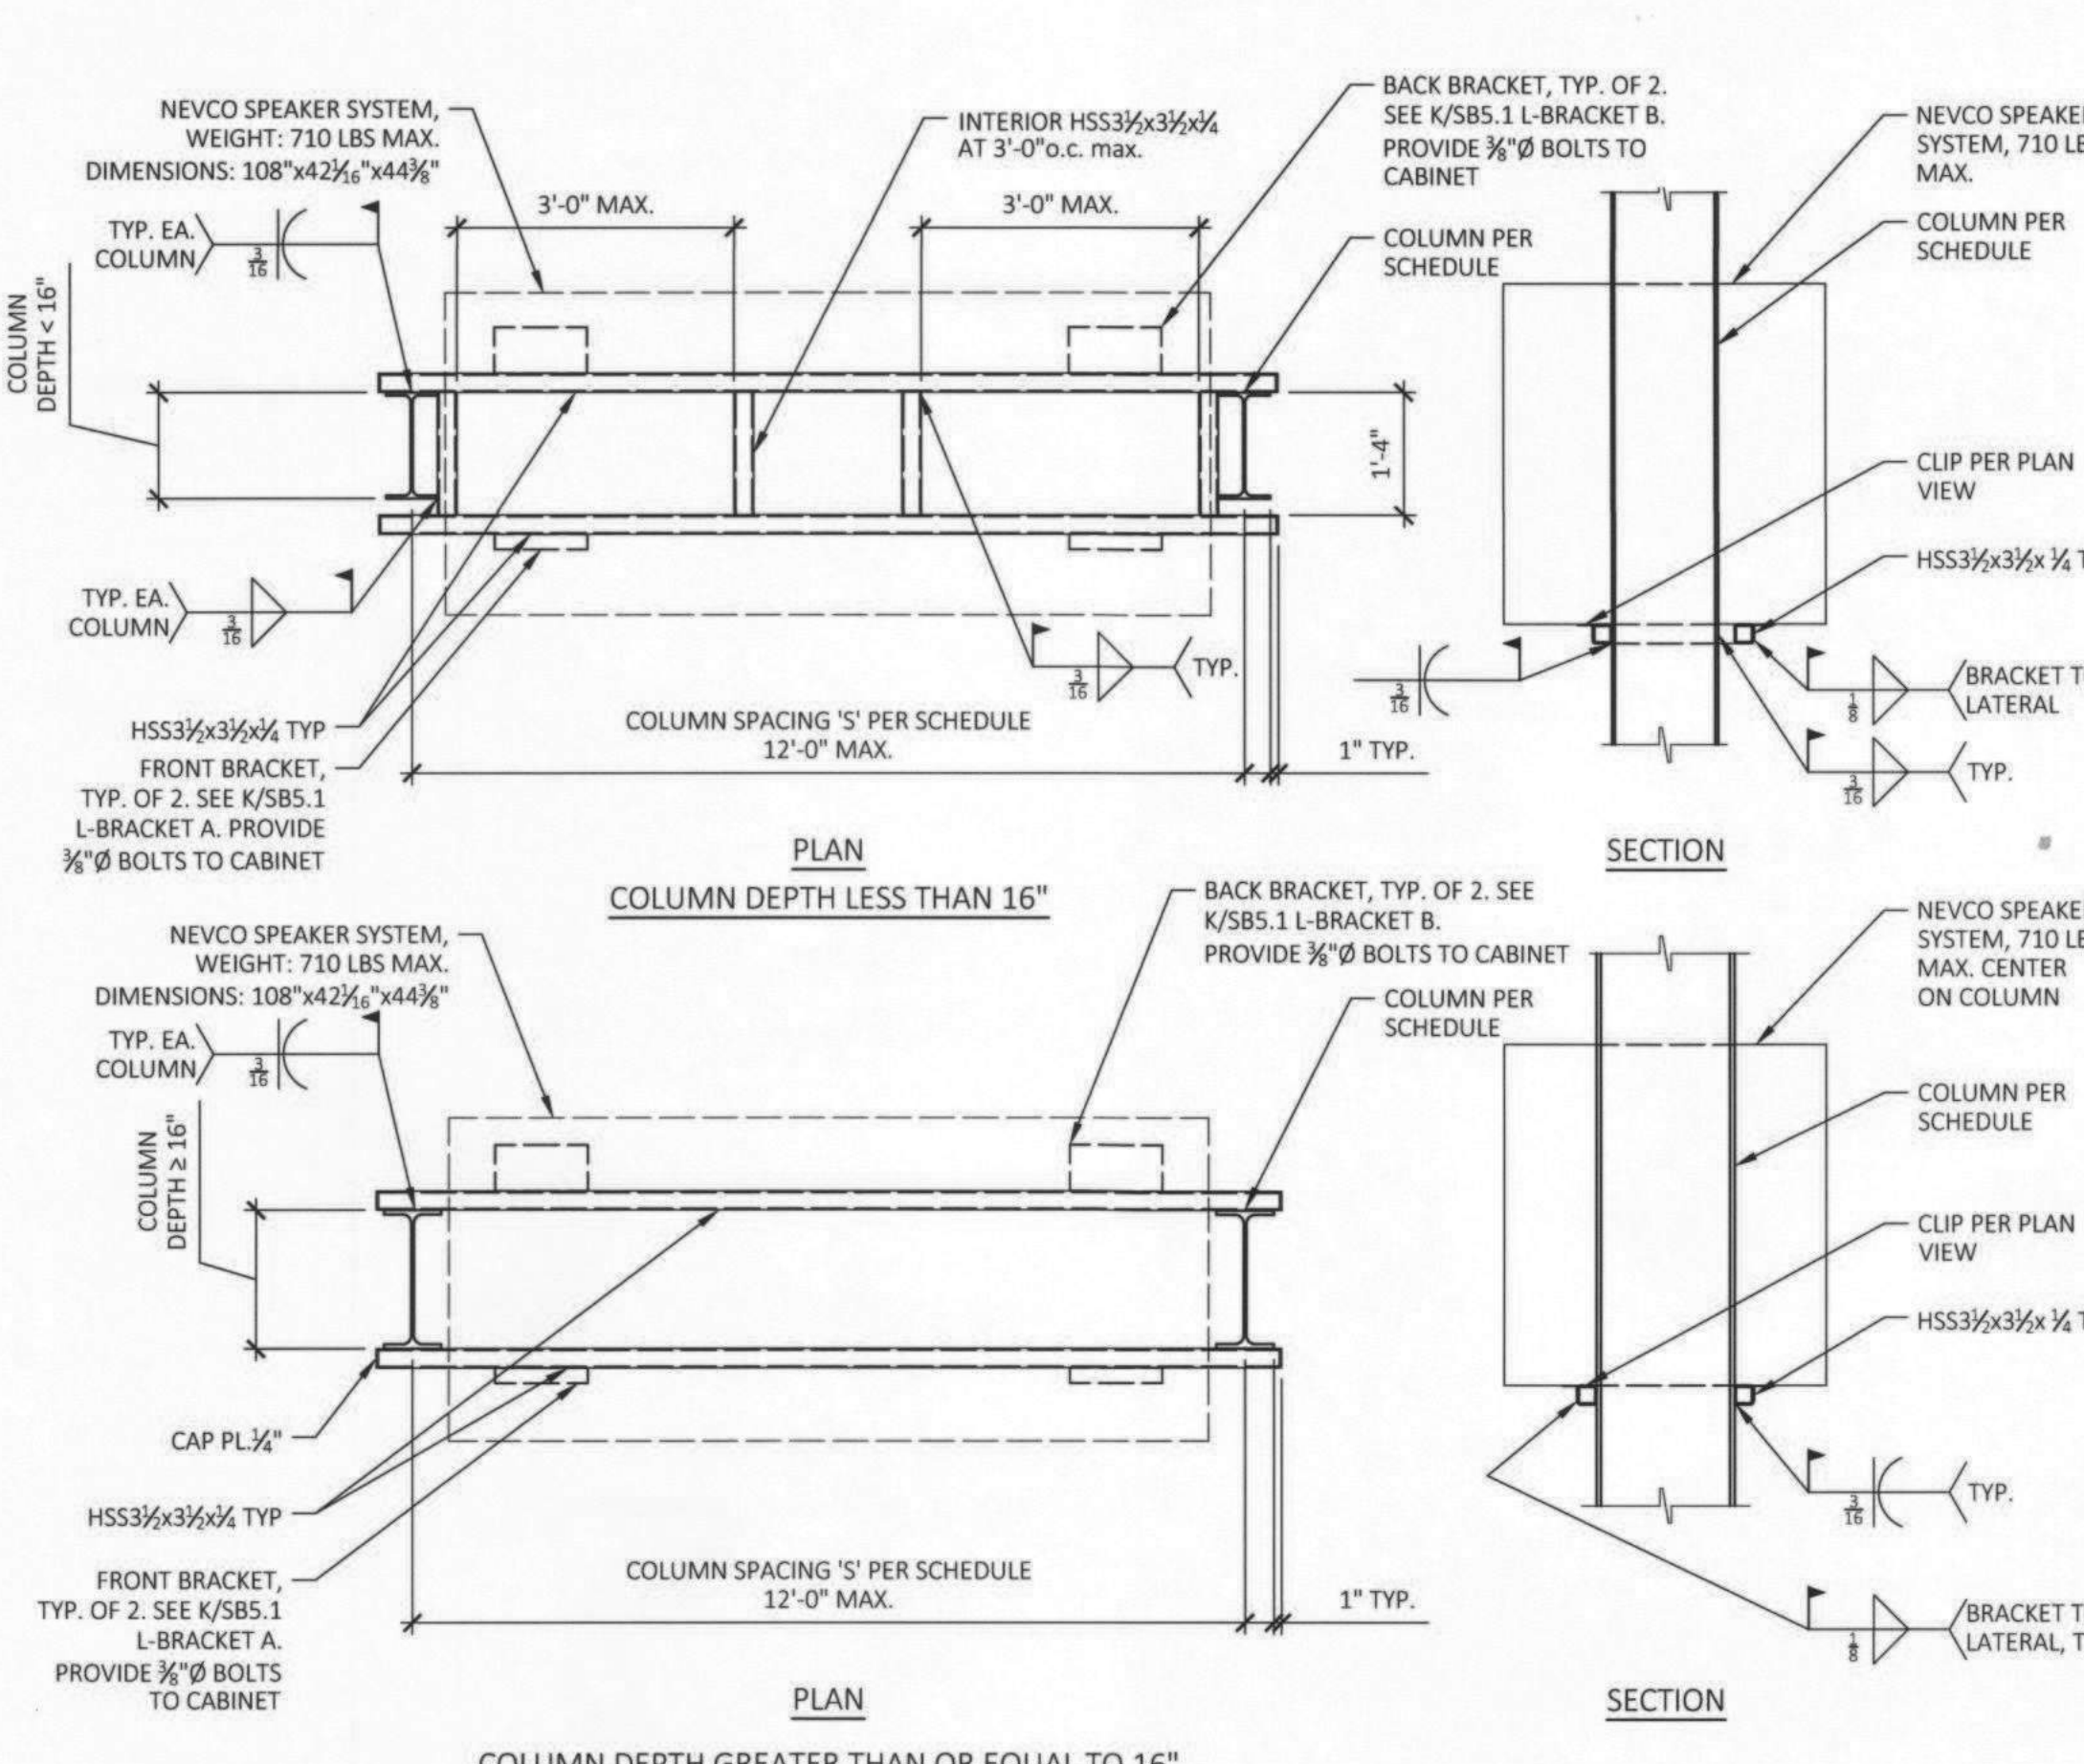


SPEAKER ATTACHMENT  
N.T.S.

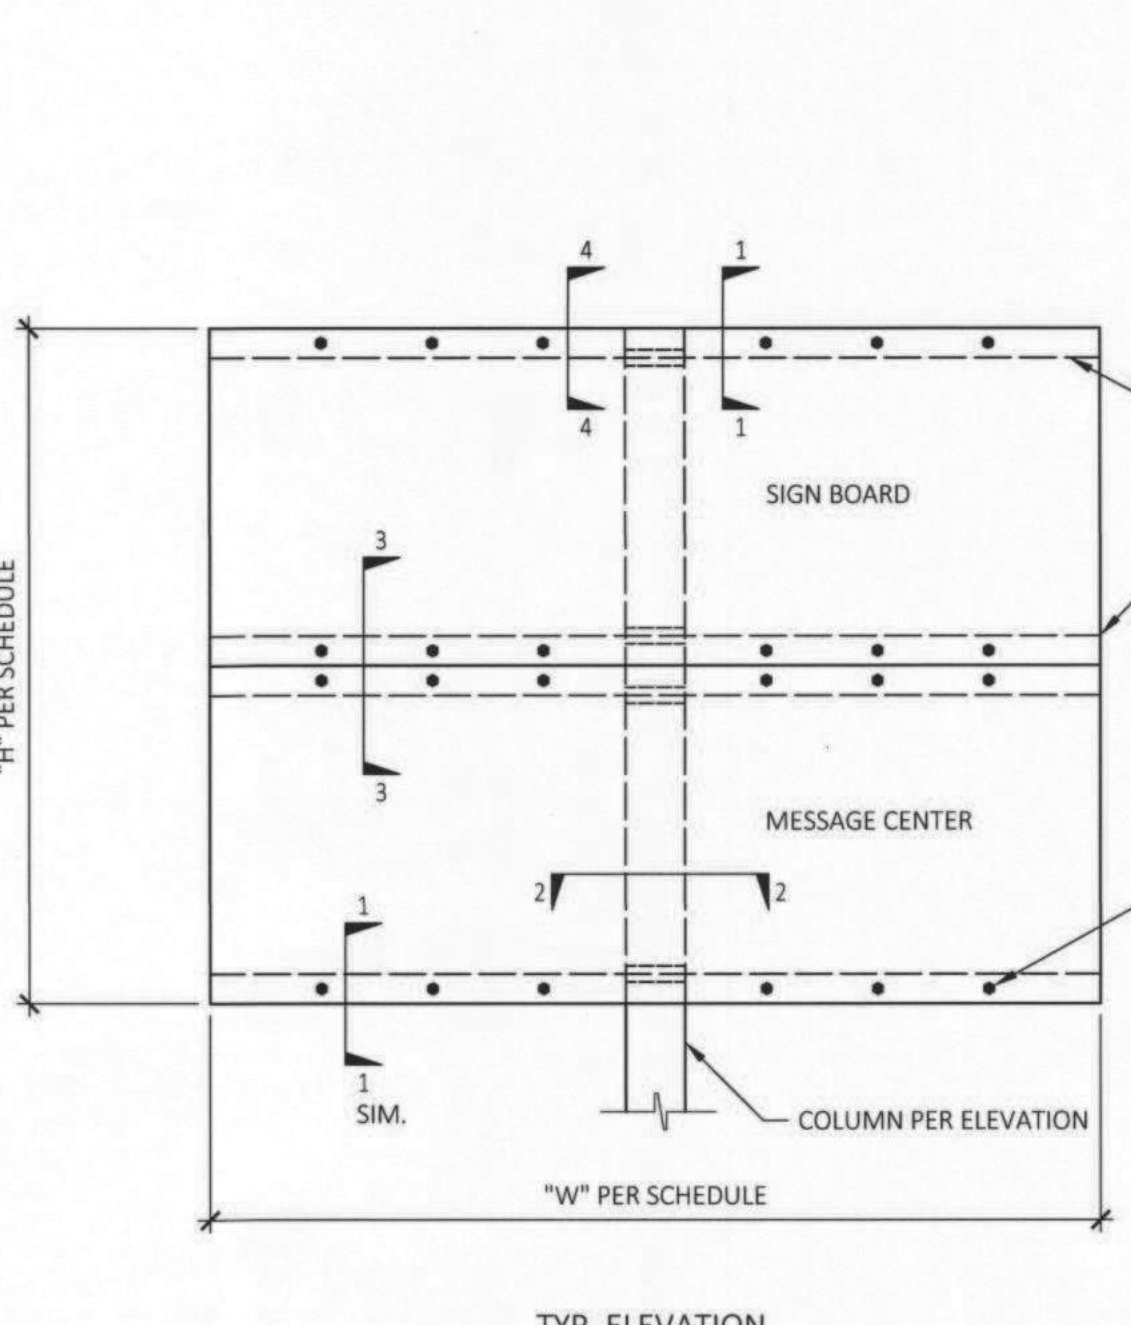


SIGN/MESSAGE CENTER INSTALLATION  
N.T.S.

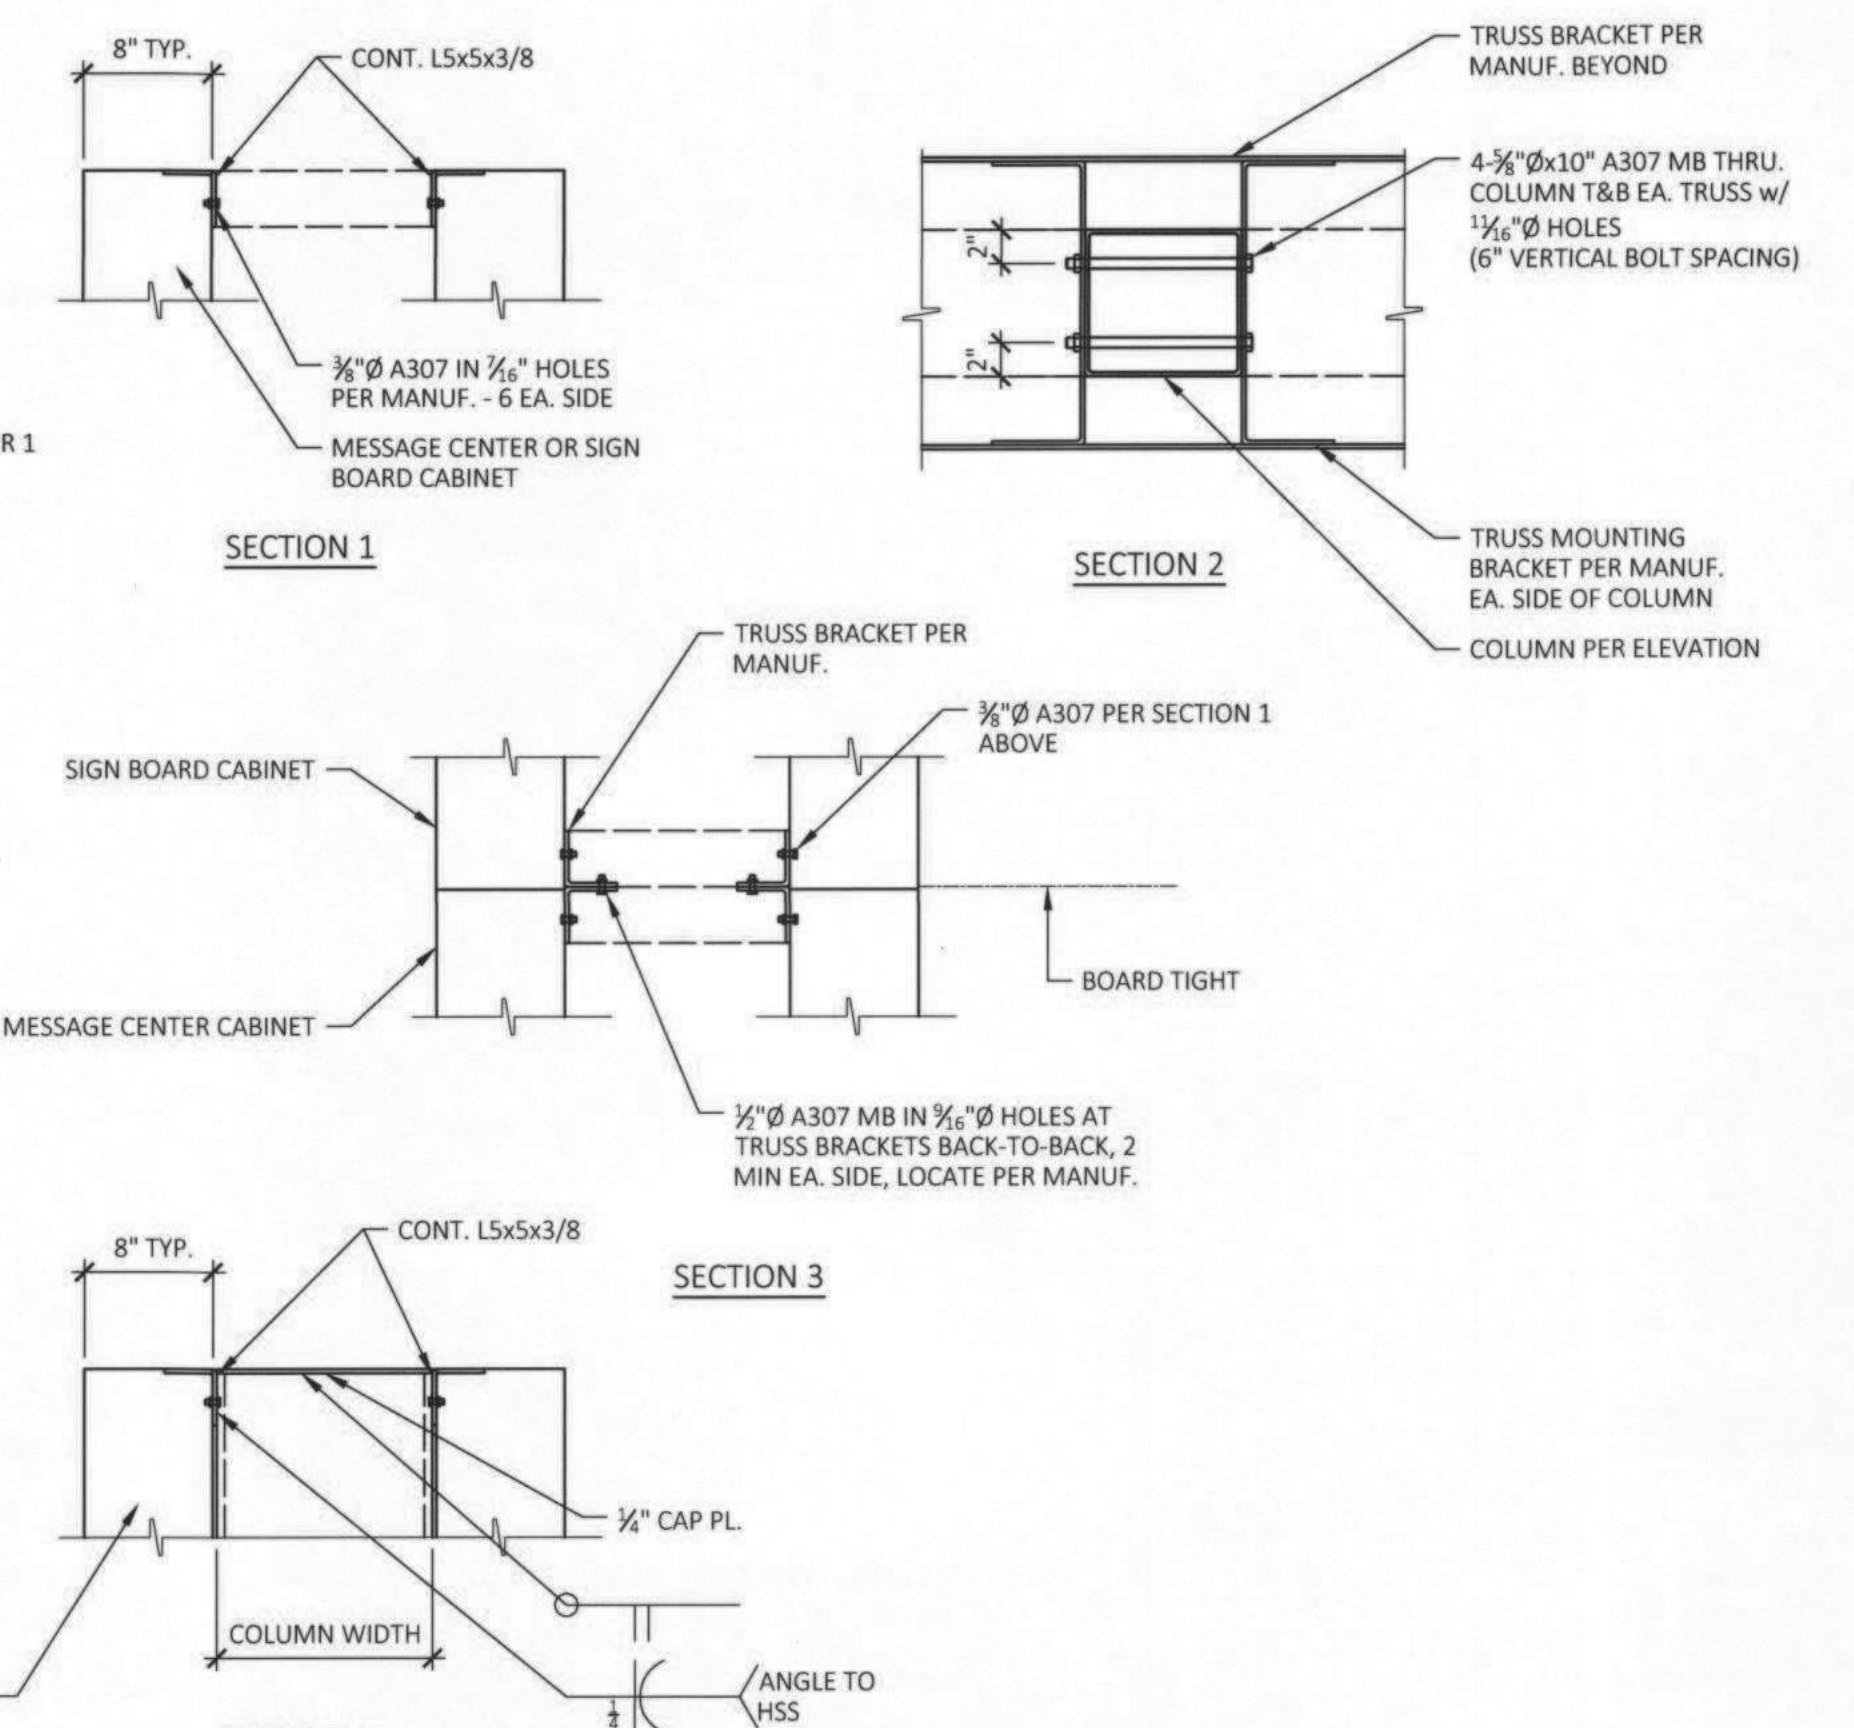


SIGN/MESSAGE CENTER INSTALLATION  
N.T.S.

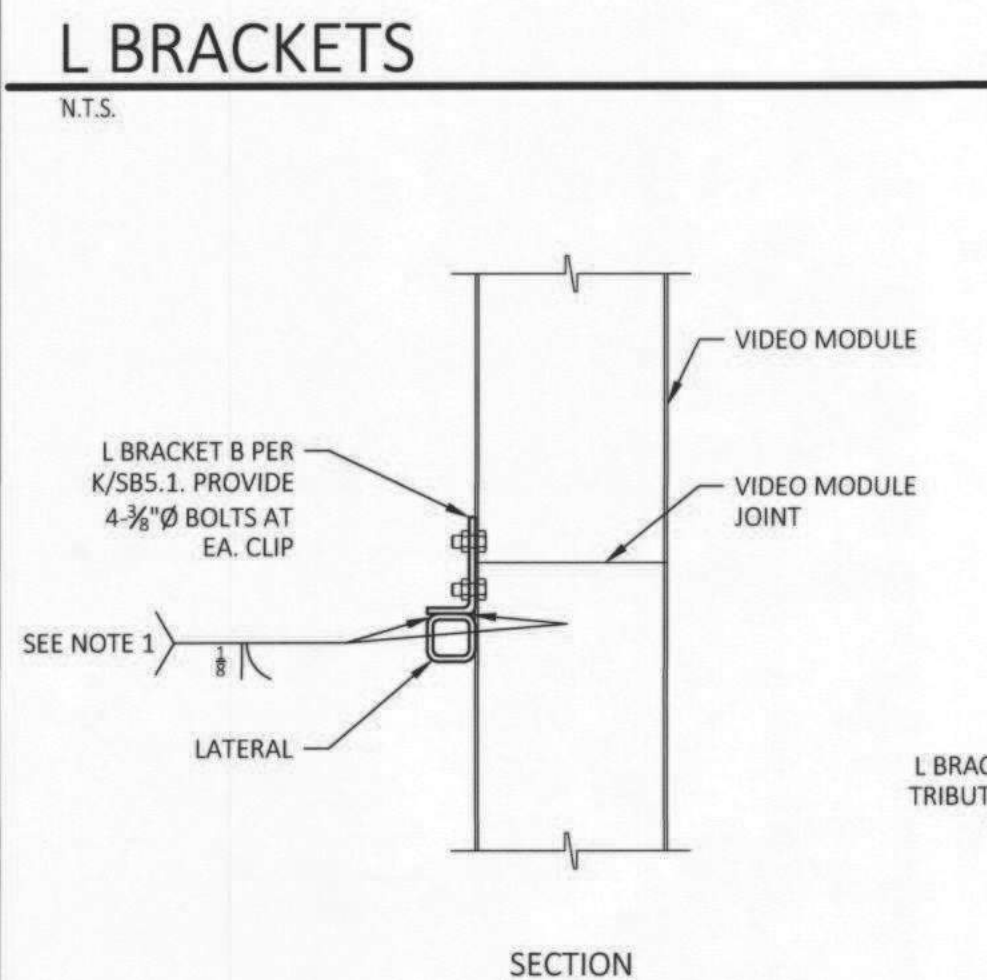


VIDEO BRACKET ATTACHMENT  
N.T.S.

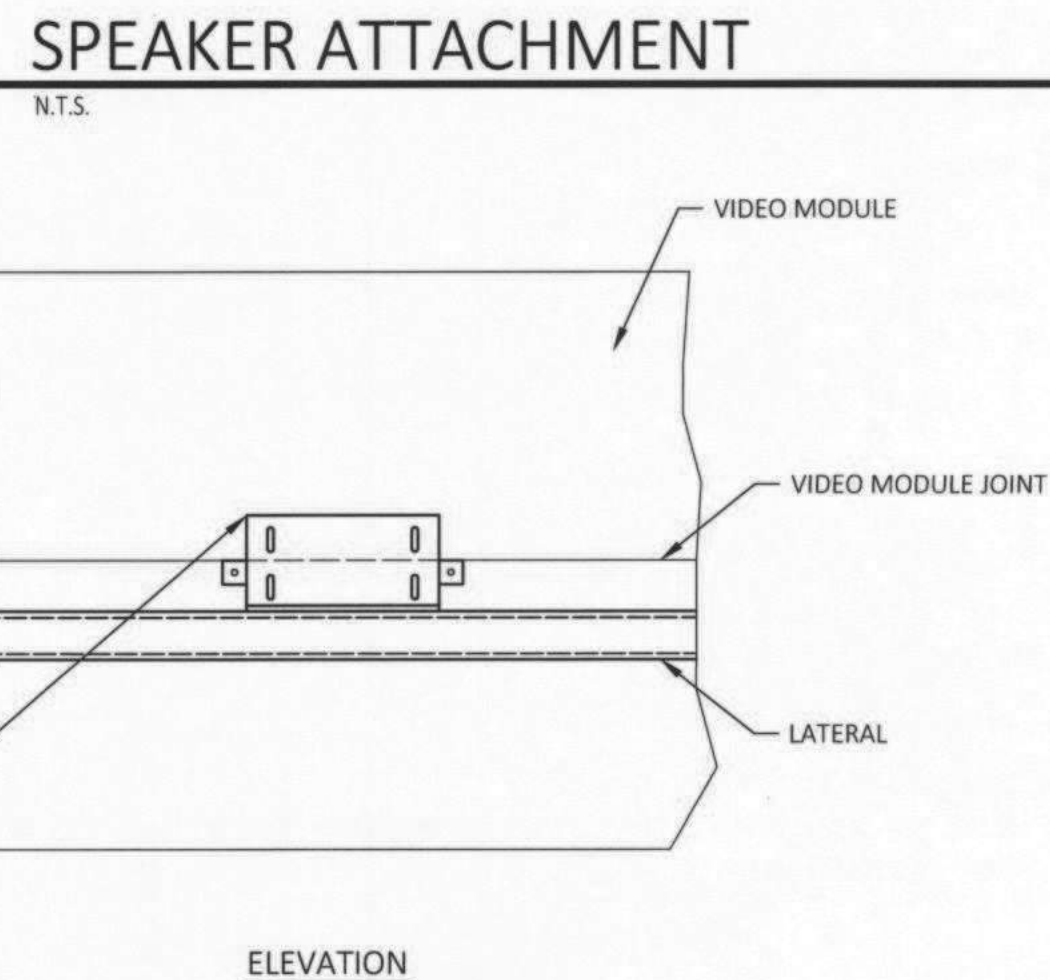


VIDEO BRACKET ATTACHMENT  
N.T.S.

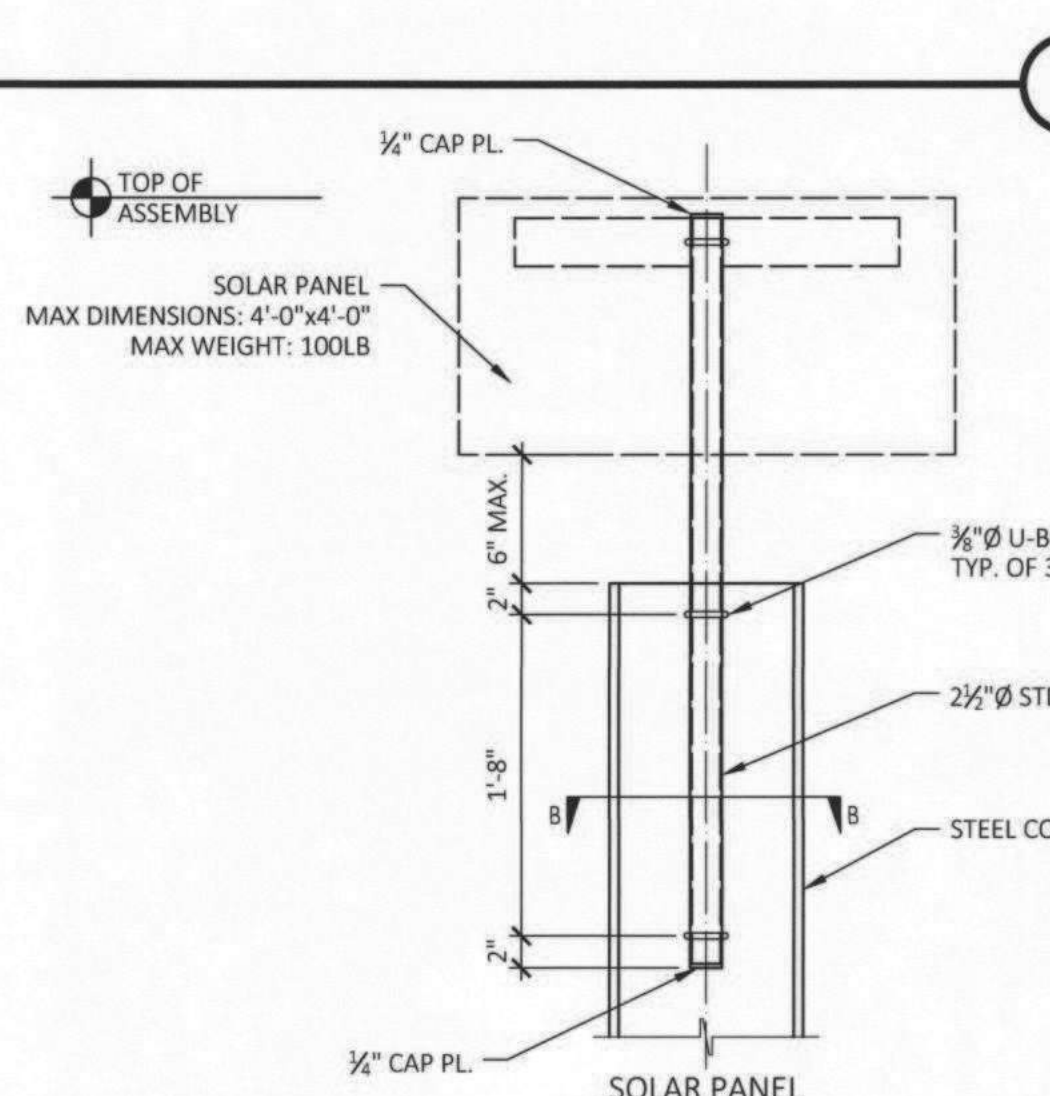


SOLAR PANEL/BATTERY/ INVERTER/RECEIVER ATTACHMENT  
N.T.S.

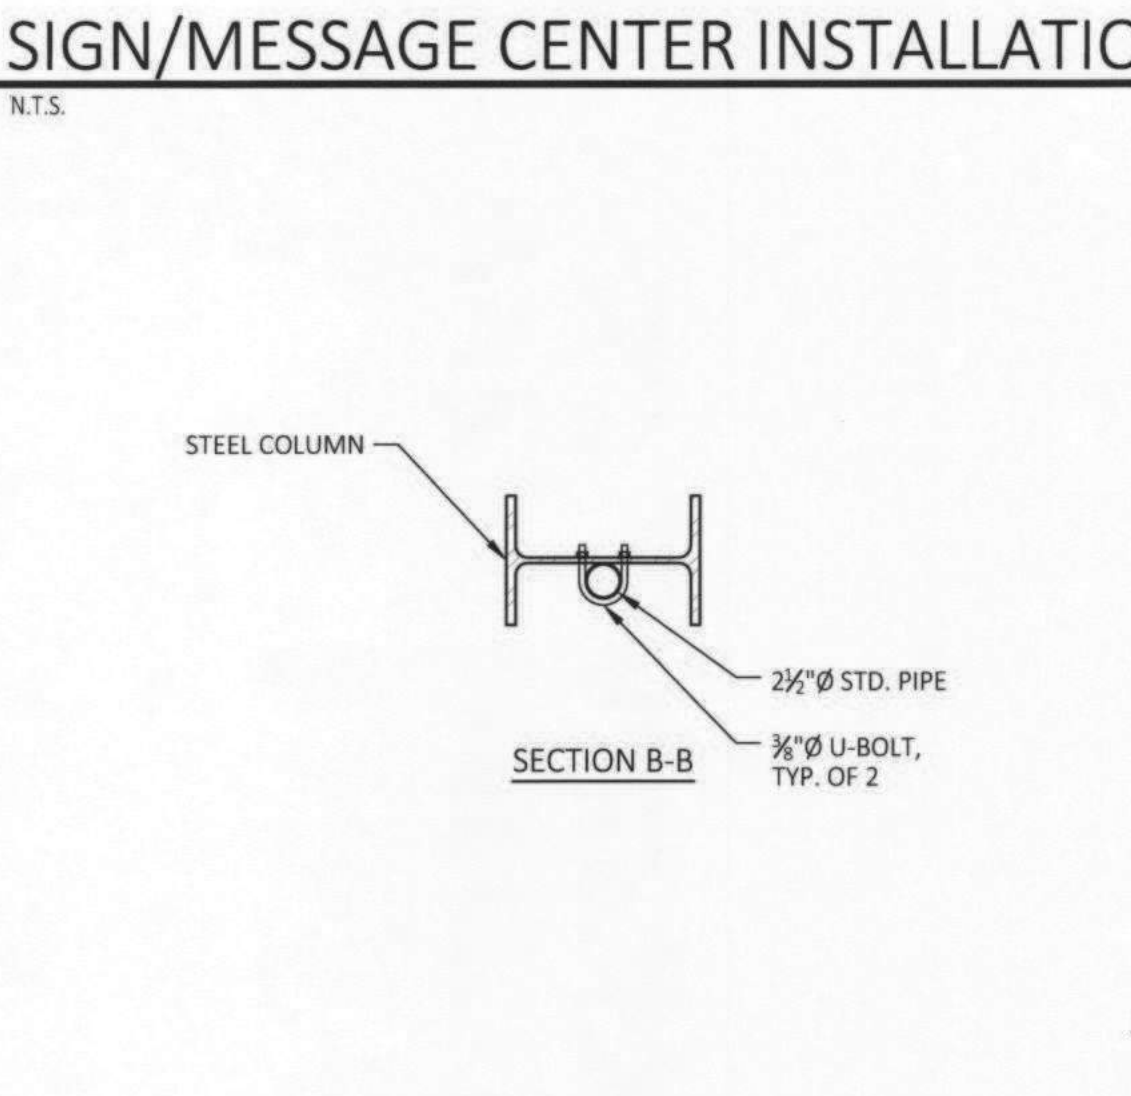


SOLAR PANEL/BATTERY/ INVERTER/RECEIVER ATTACHMENT  
N.T.S.

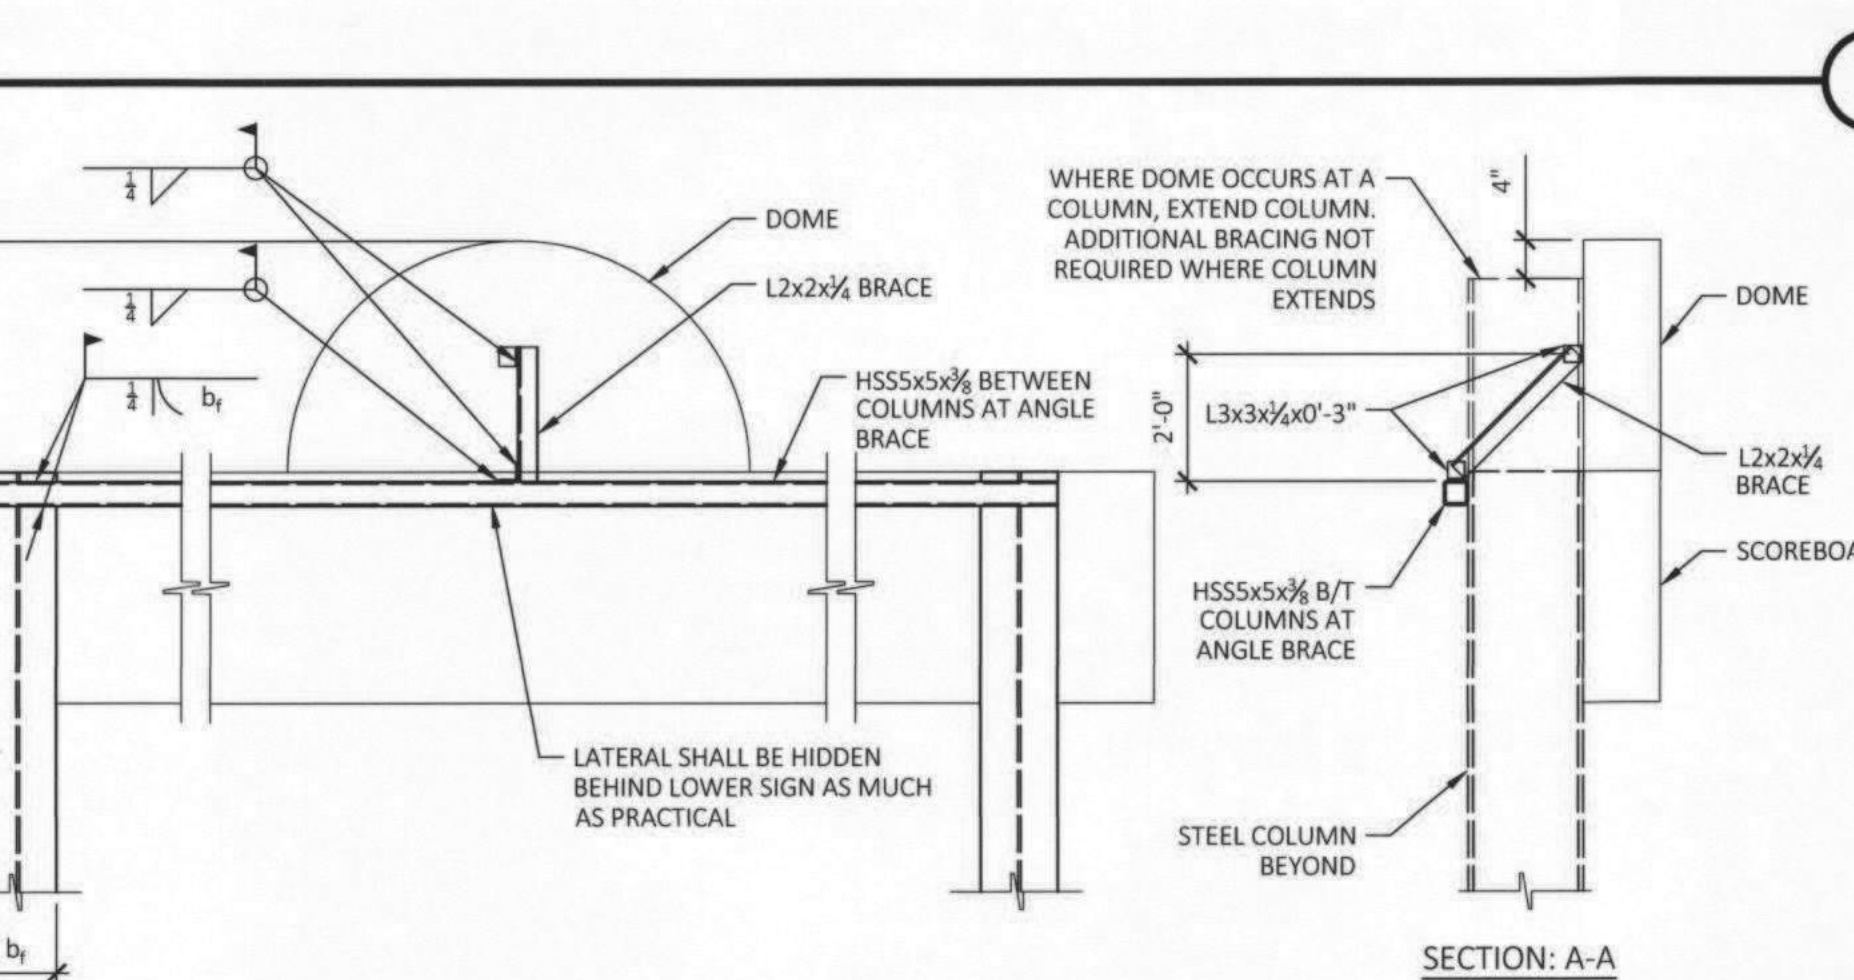


DOME BRACING  
N.T.S.

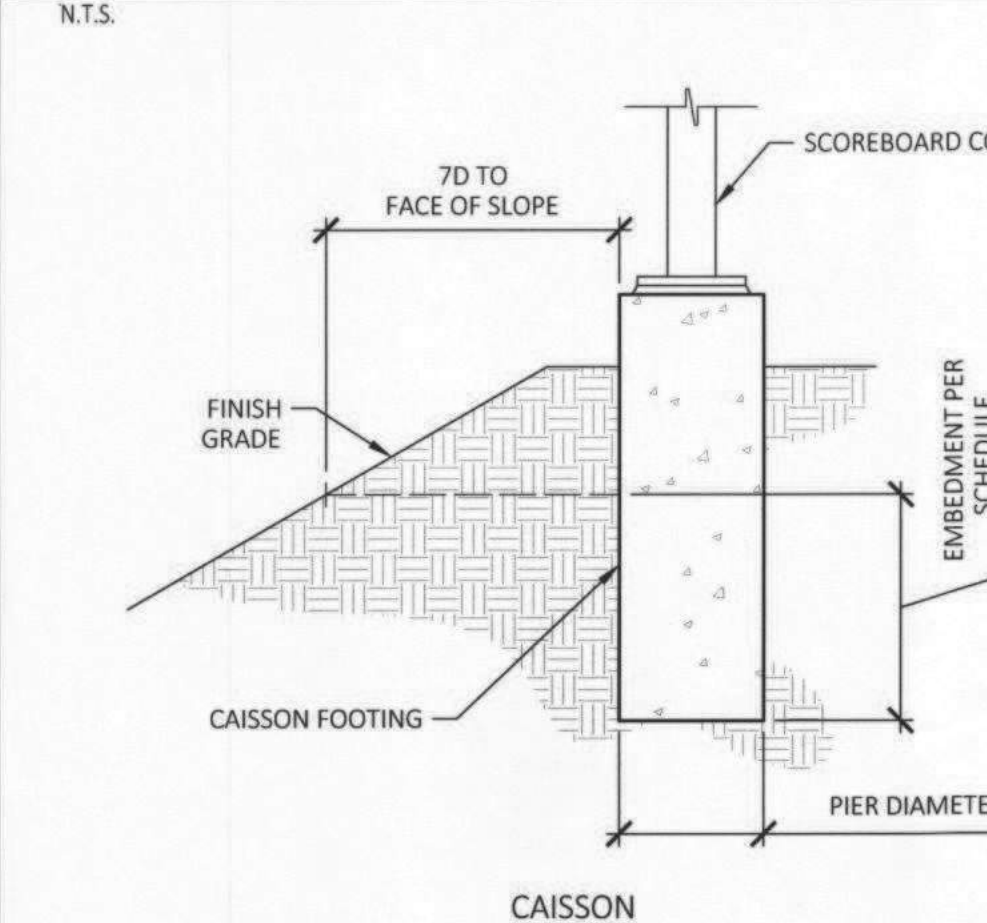


DISTANCE TO SLOPE  
N.T.S.

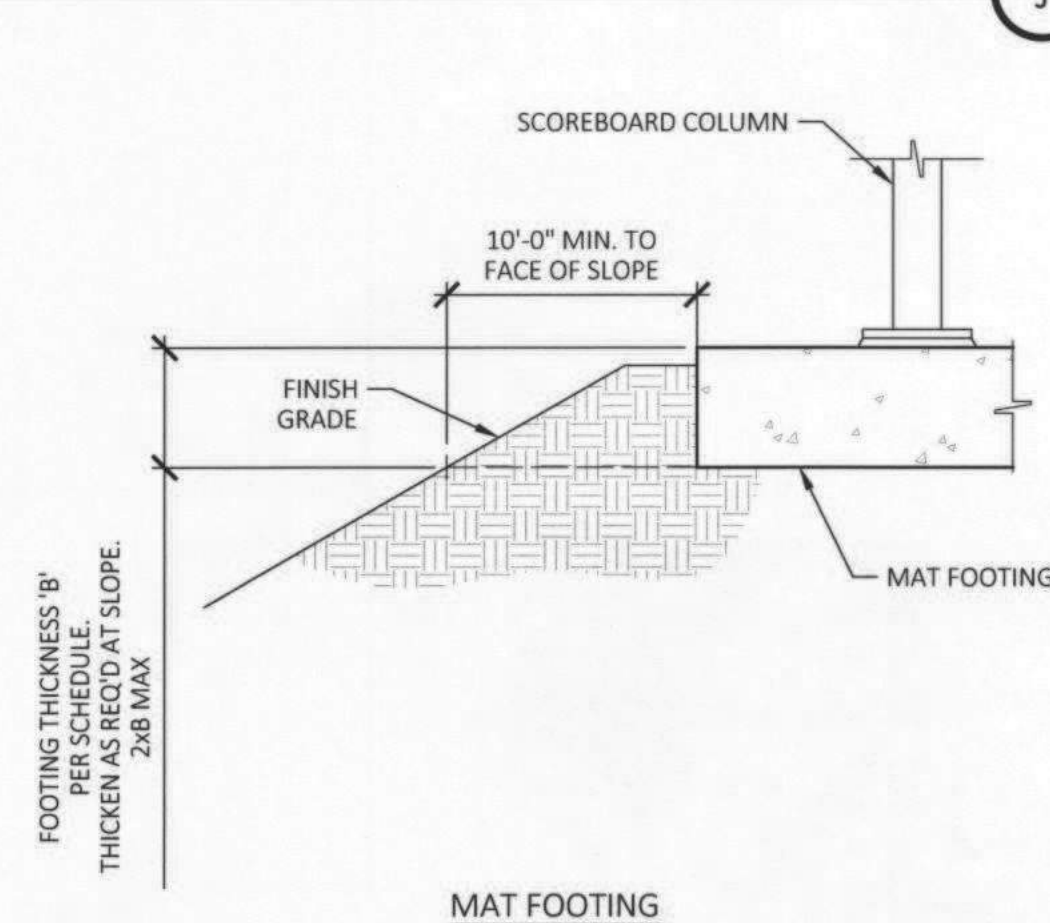

DISTANCE TO SLOPE  
N.T.S.

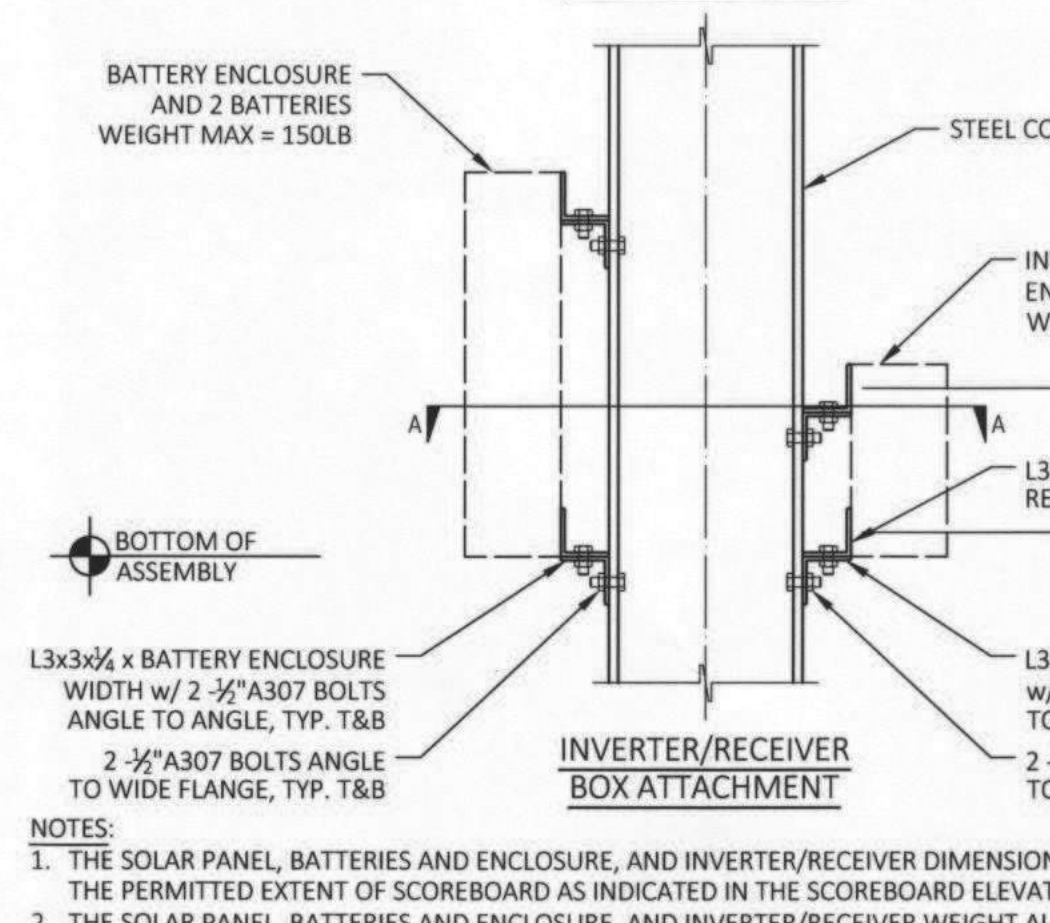

SOLAR PANEL/BATTERY/ INVERTER/RECEIVER ATTACHMENT  
N.T.S.

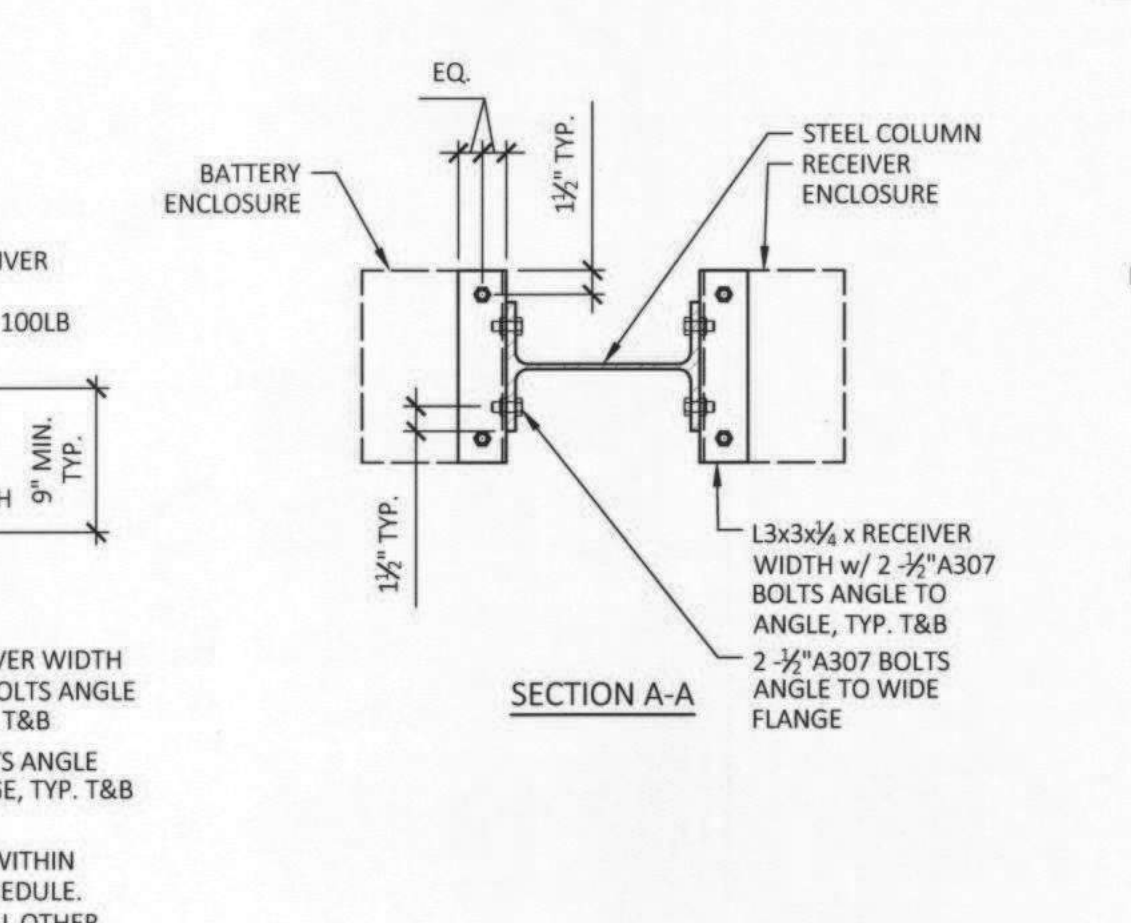

TRUSS ATTACHMENT  
N.T.S.

TRUSS ATTACHMENT CHART

| TRUSS WIDTH (A) | TRUSS HEIGHT (B) | LATERAL HEIGHT (C) | LATERAL HEIGHT (D) | COLUMN SPACING (S) | ESTIMATED WEIGHT | NUMBER OF COLUMNS |
|-----------------|------------------|--------------------|--------------------|--------------------|------------------|-------------------|
| 18'-0"          | 3'-0"            | 28 1/2"            | 31 3/4"            | 10'-0"             | 145 lbs.         | 2                 |
| 18'-0"          | 3'-8 1/2"        | 34 1/2"            | 34 1/2"            | 8'-0"              | 136 lbs.         | 2                 |
| 18'-0"          | 4'-0"            | 38 3/4"            | 40 3/4"            | 10'-0"             | 165 lbs.         | 2                 |
| 12'-0"          | 2'-6"            | 18 1/2"            | 20 1/2"            | 8'-0"              | 90 lbs.          | 2                 |
| 10'-0"          | 2'-6"            | 18 1/2"            | 20 1/2"            | 8'-0"              | 64 lbs.          | 2                 |
| 8'-0"           | 2'-6"            | 18 1/2"            | 20 1/2"            | 6'-0"              | 58 lbs.          | 2                 |
| 14'-0"          | 2'-0"            | 18 1/2"            | 20 1/2"            | 8'-0"              | 78 lbs.          | 2                 |
| 28'-0"          | 4'-0"            | 30 1/2"            | 42 1/2"            | 10'-0"             | 257 lbs.         | 3                 |
| 24'-0"          | 4'-0"            | 27 1/2"            | 42 1/2"            | 8'-0"              | 220 lbs.         | 3                 |
| 24'-0"          | 3'-0"            | 19 1/2"            | 30 1/2"            | 8'-0"              | 185 lbs.         | 3                 |
| 20'-0"          | 4'-0"            | 25 1/2"            | 44 3/4"            | 9'-0"              | 110 lbs.         | 3                 |
| 32'-0"          | 4'-0"            | 24 1/2"            | 41 1/2"            | 8'-0"              | 294 lbs.         | 4                 |
| 36'-0"          | 4'-0"            | 15 1/2"            | 39 3/4"            | 10'-0"             | 331 lbs.         | 4                 |
| 40'-0"          | 4'-0"            | 28 1/2"            | 41 1/2"            | 10'-0"             | 367 lbs.         | 4                 |

TRUSS ATTACHMENT  
N.T.S.

IDENTIFICATION STAMP  
DIV. OF THE STATE ARCHITECT  
APP. 02-118017 INC.  
REVIEWED FOR  
SS □ FLS □ ACS □  
DATE: 04/10/2020

PROFESSIONAL SEAL  
No. 5405  
STATE OF CALIFORNIA  
DATE ISSUED: 10.16.18

THESE DRAWINGS, NOTES AND DETAILS ARE INSTRUMENTS OF SERVICE AND ARE THE PROPERTY OF SMITH STRUCTURAL GROUP, LLP. ALL DRAWINGS, INFORMATION, SPECIFICATIONS, IDEAS, DESIGNS AND ARRANGEMENTS REPRESENTED WITHIN THESE DOCUMENTS SHALL REMAIN THE PROPERTY OF THE ENGINEER. NO PART THEREOF SHALL BE COPIED, DISCLOSED TO OTHERS OR USED IN CONNECTION WITH ANY WORK OR PROJECT OTHER THAN THE SPECIFIC PROJECT FOR WHICH THEY HAVE BEEN PREPARED AND DEVELOPED WITHOUT THE EXPRESSED WRITTEN CONSENT OF THE ENGINEER. COPYRIGHT 2018. THANK YOU FOR YOUR INTEREST IN NEVCO SCOREBOARD PRODUCTS.

**nevco**

301 East Harris Avenue, Greenville, Illinois 62246  
Phone: (618) 664-0360  
www.nevco.com

PRE-CHECK (PC) DOCUMENT  
CODE: 2016

A separate project application for construction is required.

DSA FILE NUMBER: PC-90  
IDENTIFICATION STAMP  
DIV. OF THE STATE ARCHITECT  
02-116492  
AC FLS SS  
DATE: 10/18/18

ATTACHMENT DETAILS

SHEET INFORMATION  
DATE: 10.16.18  
DRAWN: JMK / JMM  
CHECKED: JMM / MEP  
SSG JOB #: S17015  
SHEET: SB5.1





SN: 23844 - 23845

IDENTIFICATION STAMP  
DIV. OF THE STATE ARCHITECT  
APP. 02-118017 INC:  
REVIEWED FOR  
SS ☒ FLS ☒ ACS ☒  
DATE: 04/10/2020

REGISTERED PROFESSIONAL ENGINEER  
ARTHUR ERNEST ROSS  
No. S2030  
STRUCTURAL  
STATE OF CALIFORNIA

**ENVIROPLEX, INC.**  
 4777 E. CARPENTER ROAD STOCKTON, CA. 95215, (209) 466-8000  
 CESAR CHAVEZ HIGH SCHOOL - ATHLETIC FACILITY  
 STOCKTON UNIFIED SCHOOL DISTRICT  
 2020 WINDFLOWER LANE STOCKTON, CA 95212

11

COVER SHEET,  
G CODES, C.B.C. DATA,  
SHEET INDEXCOVER SHEET,  
G CODES, C.B.C.  
SHEET INDEX

|           |     |
|-----------|-----|
| W / DATE: | BY: |
|-----------|-----|

|     |  |  |
|-----|--|--|
| BY: |  |  |
|-----|--|--|

IDENTIFICATION STAMP

IDENTIFICATION STAMP  
OF THE STATE ARCHITECT

PC-012

02-116094

~~FLS. 102 SS. 65~~

9-6-2018

40

40

AU

**DECLARATION OF INTEREST**

TYPE OF MODULAR STEEL MOMENT FRAME BUILDING PROJECT

1. THIS PC IS NOT APPROVED FOR "A" OCCUPANCY USES AND CANNOT BE REVIEWED OVER THE COUNTER (OTC).
2. PC BUILDING APPROVED ONLY FOR OCCUPANCY B, or E WITH OCCUPANT LOAD LESS THAN 250.  
(2016 CBC TABLE 1604A.5 RISK CATEGORY I & II).
3. PC BUILDING EXITING IS BASED ON THE USE OR OCCUPANCY AND WILL BE REVIEWED AS SITE SPECIFIC.
4. PC BUILDING LOCATED IN FIRE HAZARD SEVERITY ZONES PER WILDLAND URBAN INTERFACE FIRE AREAS (WUI) SHALL CONFORM TO CBC CHAPTER 7A.
5. THIS PC IS NOT APPROVED FOR FIRE HAZARD SEVERITY ZONES PER C.B.C. CHAPTER 7A.
6. SITE AND USE SPECIFIC REQUIREMENT FOR FIRE ALARM SYSTEM MIGHT BE REQUIRED BUT NOT INCLUDED IN THIS PC APPROVAL.
7. THIS BUILDING IS STRUCTURALLY DESIGNED TO SUPPORT THE WEIGHT OF A FUTURE FIRE SPRINKLER SYSTEM (EQUIVALENT TO 1.5 psf MAXIMUM), IF REQUIRED.
8. THIS PC IS APPROVED FOR CLIMATE ZONES 1 THROUGH 16.
9. THIS PC IS NOT APPROVED FOR OCCUPANCY E USED AS SPECIAL HAZARD USE OR STORE SUCH AS LIBRARIES, VOCATIONAL SHOPS & DAYCARE CANNOT BE REVIEWED OVER THE COUNTER (OTC).
10. DRAFTSTOPS REQUIRED FOR CONCEALED SPACES OVER 3000 SQ.FT. (C.B.C. 718)
11. SOLAR READY SITE ADOPTED PC BUILDINGS:  
IF ROOF PITCH IS GREATER THAN 2:12, WHEN A PC BUILDING IS SITE ADAPTED, THE BUILDING SHALL BE ORIENTED PER SOLAR READY DIAGRAM ON SHEET A1D AND SOLAR READY REQUIREMENTS ON SHEET AG6.
12. ENVIRONMENTAL COMFORT FOR SITE ADOPTED PC BUILDINGS:  
SOLAR RADIATION SHALL NOT BE PLACED IN LOCATIONS WITH EXTERIOR NOISE EQUIVALENT LEVEL OF 65 CNEL OR GREATER.  
PC BUILDING INTERIOR WALLS BETWEEN CLASSROOMS, TEACHER WORK SPACES, BREAK OUT ROOMS, OR OTHER OCCUPIED SPACES SHALL HAVE A MINIMUM STC OF AT LEAST 40.
13. AUTOMATIC FIRE SPRINKLER SYSTEM IS NOT DESIGNED NOR APPROVED AS PART OF THIS PC. IF REQUIRED, A COMPLETE FIRE SPRINKLER DESIGN SHALL BE SUBMITTED FOR CSA APPROVAL FOR THE SITE SPECIFIC APPLICATION.

1. ALL MATERIALS & WORKMANSHIP SHALL CONFORM TO THE 2016 CALIFORNIA BUILDING CODE (C.B.C.). A COPY OF THE CALIFORNIA BUILDING CODE SHALL BE KEPT ON THE SITE AT ALL TIMES.
2. CHANGES TO THE APPROVED DRAWINGS & SPECIFICATIONS SHALL BE MADE BY ADDENDA OR CONSTRUCTION CHANGE DOCUMENT (CCD) APPROVED BY DSA, AS REQUIRED BY C-4338, PART 1, TITLE 24, CCR.
3. A PROJECT INSPECTOR EMPLOYED BY THE DISTRICT (OWNER) & APPROVED BY THE ARCHITECT OF RECORD & THE DIVISION OF THE STATE ARCHITECT SHALL PROVIDE CONTINUOUS INSPECTION OF THE WORK. THE DUTIES OF THE INSPECTOR ARE DEFINED IN SECTION 4-4333(b) OF 2016 TITLE 24, PART 1.
4. MATERIAL TESTING AS NOTED IN THE STRUCTURAL TESTS & INSPECTIONS AT THE LEFT SHALL BE PERFORMED AS REQ. PER SECTION 1704A & 2212A, & 1913A FOR CONCRETE OF 2016 C.B.C.  
MATERIAL TESTING REQUIRED BY FIRE REGULATIONS SHALL BE PERFORMED BY A NATIONALLY RECOGNIZED TESTING LABORATORY.
5. VERIFIED REPORTS (DSA/SSS FORM 6) SHALL BE SUBMITTED PER SECTION 4-436, 4-341(f), 342(b)(9), AND 4-343 (G) BY THE MANUFACTURER, INSPECTOR, STRUCTURAL ENGINEER.
6. A SEPARATE DSA APPLICATION NUMBER MUST BE OBTAINED BEFORE MANUFACTURING ANY ENVIROPLEX UNIT IN ACCORDANCE WITH THESE DRAWINGS.
7. GRADING PLANS, DRAINAGE IMPROVEMENTS, ROAD & ACCESS REQUIREMENTS & ENVIRONMENTAL HEALTH CONSIDERATIONS SHALL COMPLY WITH ALL LOCAL ORDINANCES.
8. SPECIAL INSPECTIONS PER CHAPTER 17A, 2016 C.B.C.
9. SITE SPECIFIC APPLICATION SHALL CLEARLY INDICATE THE SCOPE OF WORK ON COVER SHEET OR GENERAL NOTE SHEET OF THE DRAWINGS.

| Option combination table<br>24'x40' to 120'x40' PC  |   | Roof     |      |                |                 | Foundation |                          |                          |                           |
|---|---|----------|------|----------------|-----------------|------------|--------------------------|--------------------------|---------------------------|
|   |   | Br-Pitch | Shed | Variable Pitch | Plant on fascia | Concrete   | 50# wood (2160 sf. max.) | 55# wood (2160 sf. max.) | 125# wood (2160 sf. max.) |
| <input checked="" type="checkbox"/>                 | applicable option selected for site specific project<br>(to be marked/checked by PC manufacturer and<br>verified by the design professional of the site<br>specific project). |          |      |                |                 |            |                          |                          |                           |
| <input type="checkbox"/>                            | available option not used.  |          |      |                |                 |            |                          |                          |                           |
| <input checked="" type="checkbox"/>                 | not applicable / not allowed.   |          |      |                |                 |            |                          |                          |                           |
| Exterior finish                                     | Standard MDO w/ vertical grooves,<br>cement board siding,<br>lap siding, wood clad siding   |          |      |                |                 |            |                          |                          |                           |
|   | Stucco-a-flex   |          |      |                |                 |            |                          |                          |                           |
|   | 3-coat stucco   |          |      |                |                 |            |                          |                          |                           |
| Roof slope  | Br-pitch  |          |      |                |                 |            |                          |                          |                           |
|   | Shed  |          |      |                |                 |            |                          |                          |                           |
|   | Variable pitch  |          |      |                |                 |            |                          |                          |                           |
| Roof facades  | Plant on fascia (all ext. finishes allowed)   |          |      |                |                 |            |                          |                          |                           |
| Roof overhangs                                      | Transverse endwalls/<br>Longitudinal sidewalls  |          |      |                |                 |            |                          |                          |                           |
| Roof skylights                                      | Sol-a-tubes   |          |      |                |                 |            |                          |                          |                           |
| Suspended canopies                                  |   |          |      |                |                 |            |                          |                          |                           |
| Awnings   |   |          |      |                |                 |            |                          |                          |                           |
| Floor load<br>(see framing plans for joist spacing) | 50 psf  |          |      |                |                 |            |                          |                          |                           |
|   | 65 psf  |          |      |                |                 |            |                          |                          |                           |
|   | 125 psf   |          |      |                |                 |            |                          |                          |                           |
|   | 150 psf   |          |      |                |                 |            |                          |                          |                           |
| Floor construction                                  | 1 1/8" plywood sheathing  |          |      |                |                 |            |                          |                          |                           |
|   | Concrete poured in pan  |          |      |                |                 |            |                          |                          |                           |
|   | Level rock over plywood sheathing   |          |      |                |                 |            |                          |                          |                           |
| Wall construction                                   | 2x4 wood studs  |          |      |                |                 |            |                          |                          |                           |
|   | 2x6 wood studs  |          |      |                |                 |            |                          |                          |                           |
| Fire rated const.                                   | NR/Sprinklered  |          |      |                |                 |            |                          |                          |                           |
|   | Fire barriers (int & ext., multiple walls)  |          |      |                |                 |            |                          |                          |                           |
| HVAC  | Wall mount  |          |      |                |                 |            |                          |                          |                           |
|   | Interior  |          |      |                |                 |            |                          |                          |                           |
|   | Roof mount  |          |      |                |                 |            |                          |                          |                           |

2016 CALIFORNIA ADMINISTRATIVE CODE (CAC) (PART 1, TITLE 24, CCR)

2016 CALIFORNIA BUILDING CODE (CBC), VOLUMES 1 AND 2 (PART 2, TITLE 24, CCR)  
(2015 INTERNATIONAL BUILDING CODE WITH 2016 CALIFORNIA AMENDMENTS)

2016 CALIFORNIA ELECTRICAL CODE (PART 3, TITLE 24, CCR)  
(2014 NATIONAL ELECTRICAL CODE WITH 2016 CALIFORNIA AMENDMENTS)

2016 CALIFORNIA MECHANICAL CODE (CMC) (PART 4, TITLE 24, CCR)  
(2015 UNIFORM MECHANICAL CODE WITH 2016 CALIFORNIA AMENDMENTS)

2016 CALIFORNIA PLUMBING CODE (CPC) (PART 5, TITLE 24, CCR)  
(2015 UNIFORM PLUMBING CODE WITH 2016 CALIFORNIA AMENDMENTS)

2016 CALIFORNIA ENERGY CODE (PART 6, TITLE 24, CCR).

2016 CALIFORNIA FIRE CODE (CFC) (PART 9, TITLE 24, CCR).  
(2015 INTERNATIONAL FIRE CODE WITH 2016 CALIFORNIA AMENDMENTS)

2016 CALIFORNIA GREEN BUILDING STANDARDS CODE (PART 11, TITLE 24, CCR)

2016 CALIFORNIA REFERENCED STANDARDS CODE (PART 12, TITLE 24, CCR)

|   |  |
|---|--|
| FLOOR: LIVE LOAD -<br><br><hr/> FLOOR: DEAD LOAD -<br><div style="display: flex; align-items: center; margin-top: 5px;"> <div style="font-size: 2em; margin-right: 10px;">✗</div> <div>             PLYWOOD<br/> <input type="checkbox"/> PLYWOOD + LEVEL ROCK<br/> <input type="checkbox"/> CONCRETE           </div> <div style="margin-left: 20px; text-align: right;">             50.0 PSF<br/> <div style="display: flex; align-items: center;"> <div style="font-size: 1.5em; margin-right: 5px;">✗</div> <div>45.0 PSF</div> </div>             125.0 PSF<br/>             150.0 PSF           </div> </div> <div style="margin-top: 10px;"> <div style="display: flex; justify-content: space-between;"> <div> <b>NOT ALLOWED</b><br/>             ROOF: LIVE LOAD -<br/>             ROOF: DEAD LOAD -           </div> <div style="text-align: right;">             5.0 PSF<br/>             8.25 PSF<br/>             31.0 PSF<br/><br/> <b>NOT PERMITTED</b><br/>             20.0 PSF<br/>             8.5 PSF           </div> </div> </div> |  |
| <h2 style="margin: 0;">ALLOWABLE SOIL PRESSURE</h2>   |  |
| <input type="checkbox"/> WOOD FOOTING<br><br><div style="font-size: 2em; margin-top: 10px;">✗</div> CONCRETE FOOTING  | 1000 PSF (DL + LL + LATERAL)<br><br>2000 PSF (DL + LL)<br>2667 PSF (DL + LL + LATERAL)                                       |
| <h2 style="margin: 0;">FLOOD DESIGN</h2>  |  |
| BUILDINGS IN THIS PC AREA ARE NOT DESIGNED TO BE LOCATED IN A FLOOD HAZARD AREA   |  |
| <h2 style="margin: 0;">WIND DESIGN</h2>   |  |
| BASIC WIND SPEED (3 SECOND GUST), V <span style="float: right;">110 MPH</span><br>WIND EXPOSURE CATEGORY <span style="float: right;">C</span><br>CHAPTER 28, PART 2, ASCE 7-10, SEC 28.6 - SIMPLIFIED DESIGN WIND PRESSURES<br>$I = 1.21$<br>RISK CATEGORY = II<br>$K_{zt} = 1.0$   |  |
| <h2 style="margin: 0;">LOW SEISMIC DESIGN CRITERIA (Site specific <math>S_s \leq 2.142</math>)</h2>   |  |
| LATERAL FORCE RESISTING SYSTEM<br>ANALYSIS PROCEDURE<br>SEISMIC DESIGN CATEGORY (SDC)<br><br>SEISMIC IMPORTANCE FACTOR, $I_h$<br>$V = C_s W = 0.286W$<br>$C_s = \frac{S_{ds}}{(R_u)}$   | ORDINARY STEEL MOMENT FRAMES<br>EQUIVALENT LATERAL FORCE PROCEDURE<br>$D_s (\leq 0.75)$<br>$E (0.75 < S_s < 1.5)$<br><br>1.0 |
| <div style="display: flex; justify-content: space-between;"> <div>             BASIC SEISMIC FORCE RESISTING SYSTEM<br/> <math>R = 3.5</math><br/> <math>p_u = 1.0</math><br/> <math>I_p = 1.0</math><br/> <math>\Omega = 3.0</math> </div> <div>             SITE CLASS: D<br/> <math>S_{ds} = 2.142</math><br/> <math>S_{1s} = 1.5</math><br/> <math>F_v = 1.5</math> </div> <div>             ORDINARY STEEL MOMENT FRAMES<br/> <math>S_{ds} = 1.0</math><br/> <math>S_{1s} = 1.5</math><br/> <math>F_v = 1.5</math> </div> </div>   |  |

CONSTRUCTION TYPE: VB  
OCCUPANCY: "B" OR "E"  
BUILDING AREA: 960 TO 1000 S.F. NOMINAL  
NUMBER OF STORIES: 1


CONFIDENTIAL MATERIAL-THESE DOCUMENTS ARE THE PROPERTY OF AND ARE NOT TO BE REPRODUCED OR DISTRIBUTED WITHOUT FULL KNOWLEDGE AND WRITTEN CONSENT FROM ENVIROPLEX, INC.  
© COPYRIGHT ENVIROPLEX, INC. (ALL DRAWINGS PREPARED BY ENVIROPLEX, INC.)

AO







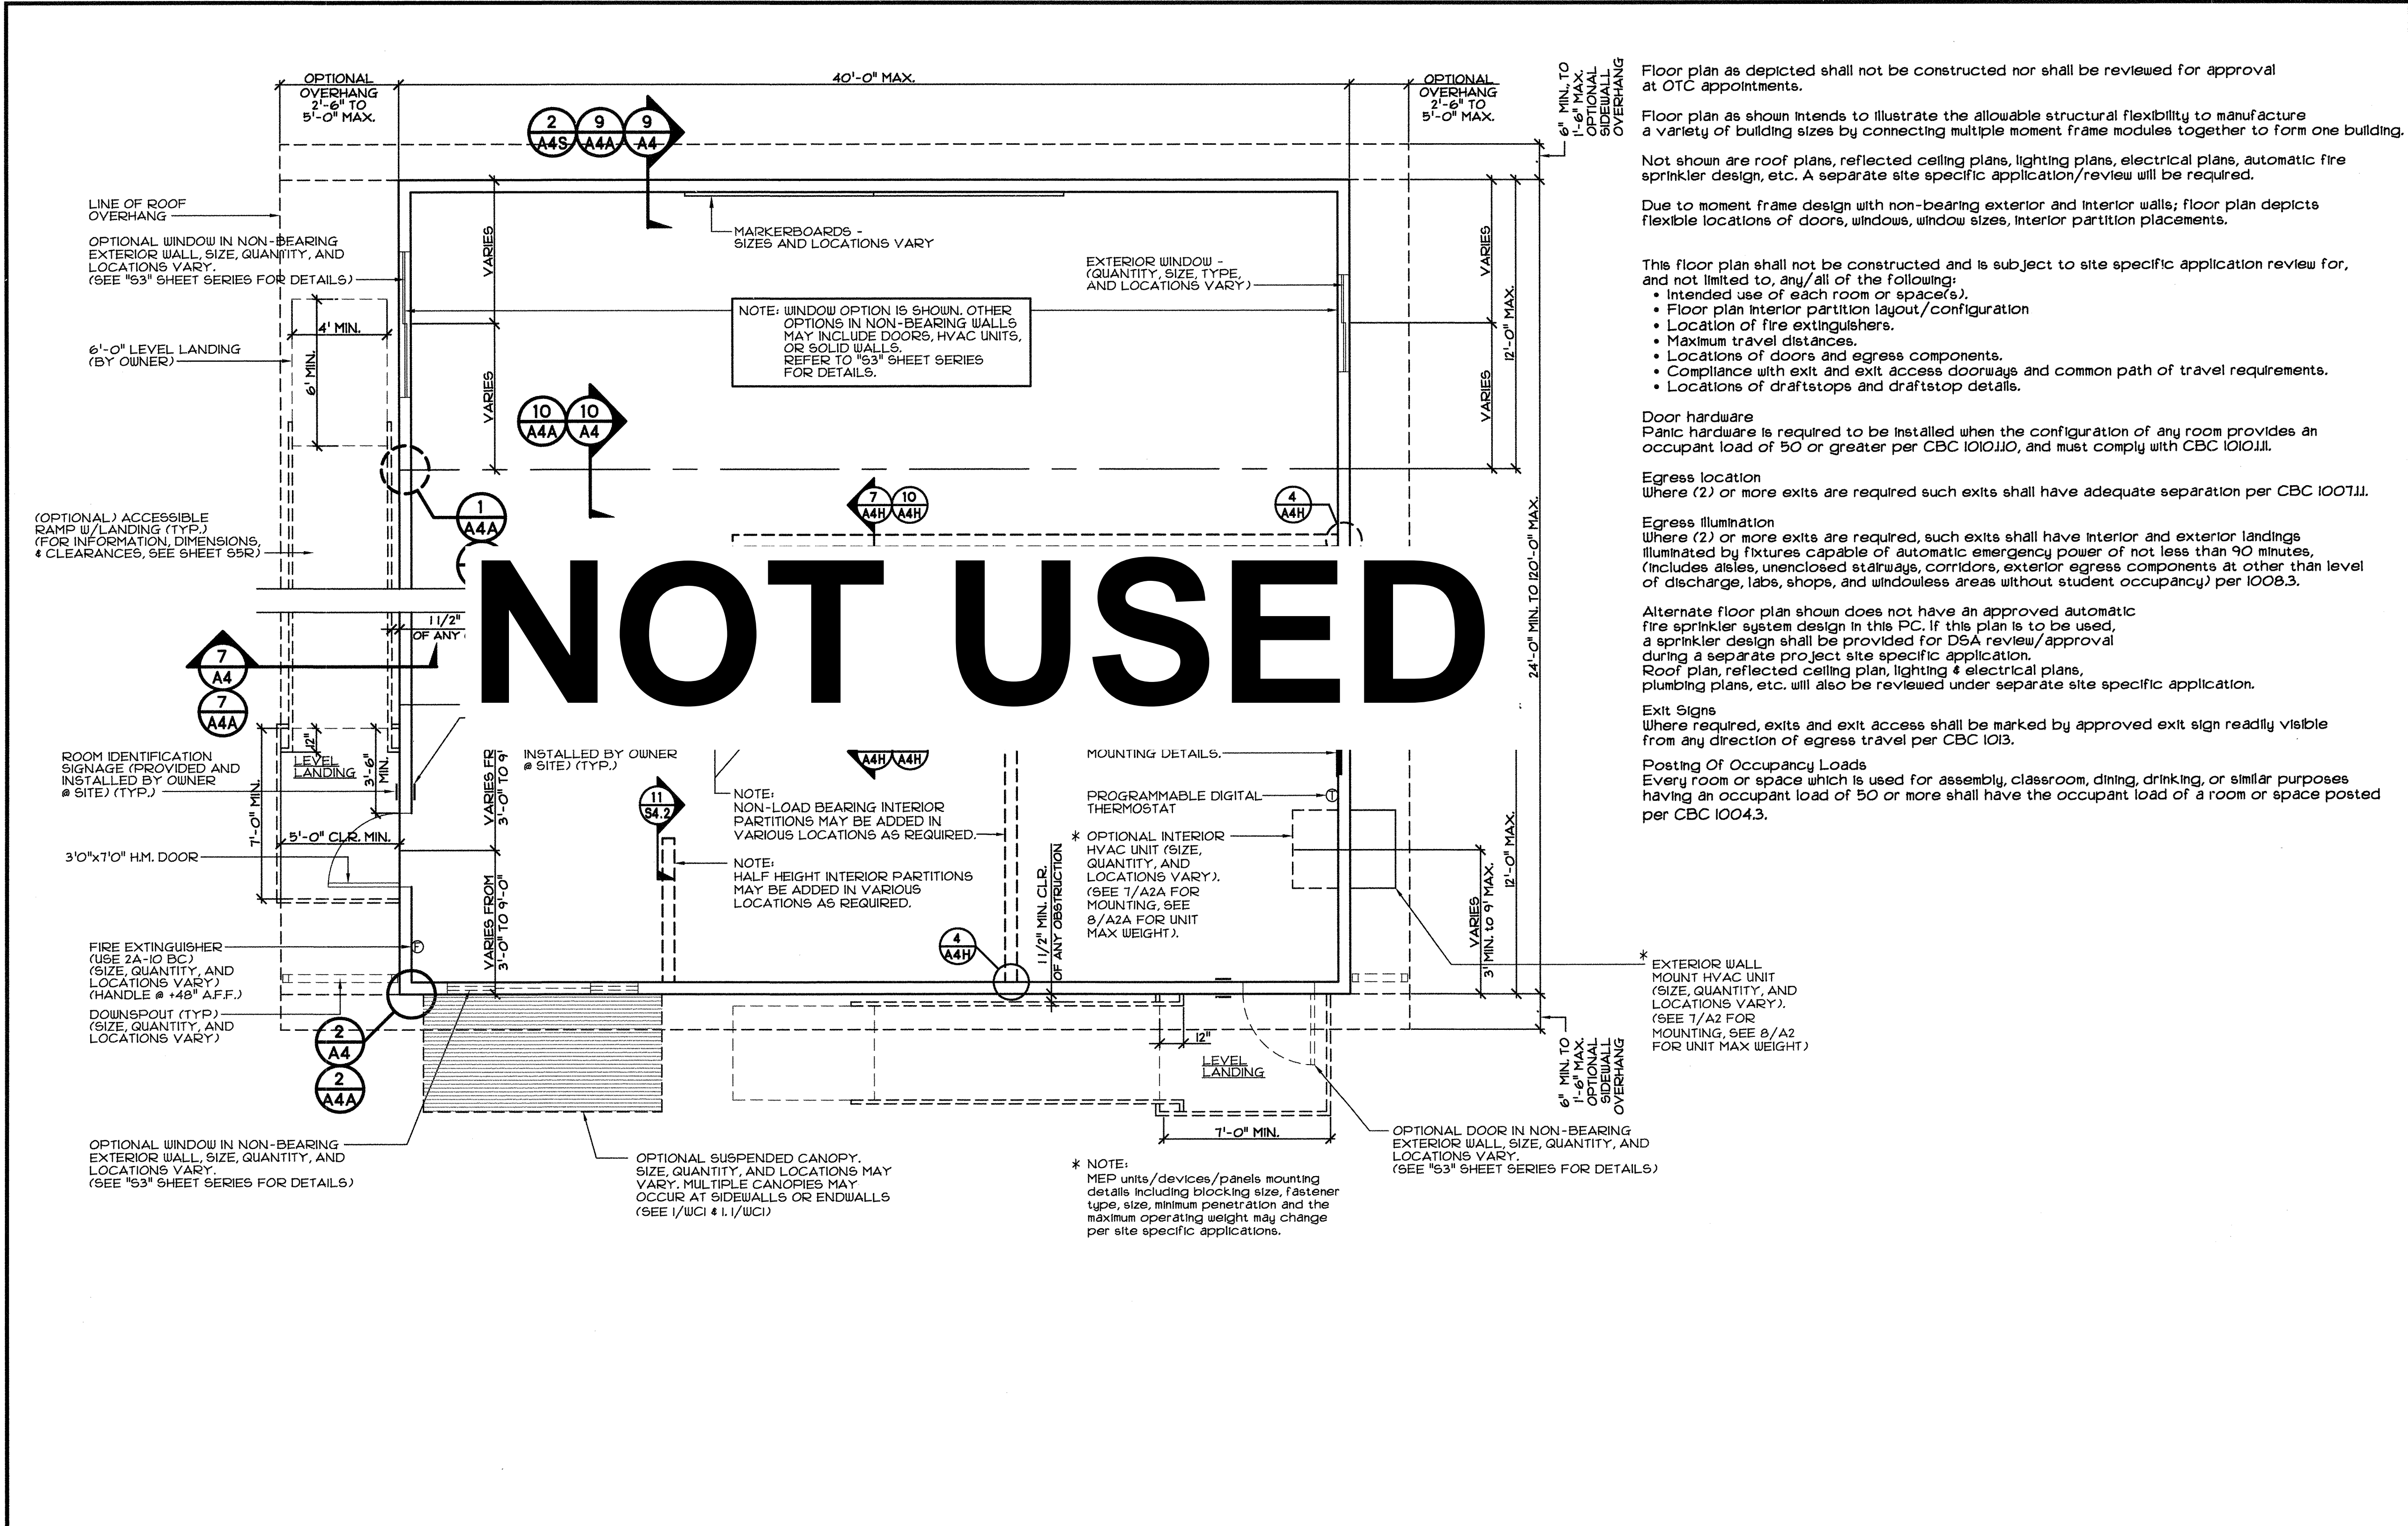

IDENTIFICATION STAMP  
DIV. OF THE STATE ARCHITECT  
APP. 02-118017 INC.  
REVIEWED FOR  
SS ☐ FLS ☐ ACS ☐  
DATE: 04/10/2020

03/26/2020

REGISTERED PROFESSIONAL ENGINEER  
No. 52030  
STATE OF CALIFORNIA  
Cesar Chavez High School - Athletic Facility  
Stockton Unified School District  
2929 Windflower Lane Stockton, CA 95212

ENVIROPLEX, INC.  
4777 E. CARPENTER ROAD STOCKTON, CA. 95215, (209) 466-8000

24'x40' to 180'x40' PC  
BUILDING LONGITUDINAL DIM. = 40'-0" MAX.  
QTY. (MIN.)  
EXTERIOR UNIT  
INTERIOR UNIT  
ROOF MT. UNIT

|     |   |   |   |
|-----|---|---|---|
| 24' | 1 | 1 | 1 |
| 36' | 1 | 1 | 1 |

NOT USED

NOTE:  
1) TYPICAL HVAC UNIT QUANTITIES ARE SHOWN. QUANTITIES MAY BE ADJUSTED FOR SITE SPECIFIC CONDITIONS & BUILDING PLAN LAYOUT.  
2) 5 TON UNITS MUST INCLUDE ECONOMIZER AND CONTROLS.

3 TYP. HVAC QTY. PER BUILDING SIZE

RAIN WATER LEADERS MINIMUM QUANTITIES

| BUILDING TRANSVERSE DIMENSION | QTY. (MIN.)    |               |
|-------------------------------|----------------|---------------|
|                               | FRONT OVERHANG | REAR OVERHANG |
| 24'                           | 1              | 1             |
| 36'                           | 2              | 1             |
| 48'                           | 3              | 2             |
| 60'                           | 4              | 3             |
| 72'                           | 5              | 4             |
| 84'                           | 6              | 5             |
| 96'                           | 7              | 6             |
| 108'                          | 8              | 7             |
| 120'                          | 9              | 8             |

RAIN WATER LEADERS MINIMUM QUANTITIES

| BUILDING TRANSVERSE DIMENSION | QTY. (MIN.)    |               |
|-------------------------------|----------------|---------------|
|                               | FRONT OVERHANG | REAR OVERHANG |
| 24'                           | 1              | 1             |
| 36'                           | 2              | 1             |
| 48'                           | 3              | 2             |
| 60'                           | 4              | 3             |
| 72'                           | 5              | 4             |
| 84'                           | 6              | 5             |
| 96'                           | 7              | 6             |
| 108'                          | 8              | 7             |
| 120'                          | 9              | 8             |

4 DOWNSPOUT QTY. PER BUILDING SIZE

1

ALTERNATE ADJUSTABLE FLOOR PLAN - (FOR STRUCTURAL REFERENCE ONLY)  
SCALE: 1/4" = 1'-0"

5

SMALL GROUP CLASSROOM OPTION - (FOR STRUCTURAL REFERENCE ONLY)  
SCALE: 1/4" = 1'-0"

CONFIDENTIAL MATERIAL—THESE DOCUMENTS ARE THE PROPERTY OF AND ARE NOT TO BE REPRODUCED OR DISTRIBUTED WITHOUT FULL KNOWLEDGE AND WRITTEN CONSENT FROM ENVIROPLEX, INC.  
© COPYRIGHT ENVIROPLEX, INC. (ALL DRAWINGS PREPARED BY ENVIROPLEX, INC.)

PRE-CHECK (PC) DOCUMENT  
Code: 2016-CBC  
A separate project application for construction is required.

AC 02-118017 FLS 02-118017 ACS 02-118017  
DATE: 7-6-2018

FLOOR PLAN OPTIONS

A1.0

24'x40' TO 120'x40' P.C.

I:\CAD\2016 PC\2016 - 24x40\Drawings\2016 - 24x40 - A1-0.dwg, 7/9/2018 11:39:56 AM



0-1/2 FIN.


19" CLEAR FLOOR SPACE CENTERED ON LOW PICTURE

30°

RAIL TO WALKWAY ATTACHMENT SEE DETAIL 6/A5

NOTE: DRINKING FOUNTAIN HANDRAILS SHALL BE PROVIDED AND INSTALLED BY OTHERS ON-SITE.


NOTE:  
EXHAUST VENTING IS REQUIRED,  
SEE NOTE 2/B, SHEETS A2, A2A, OR  
A2B.

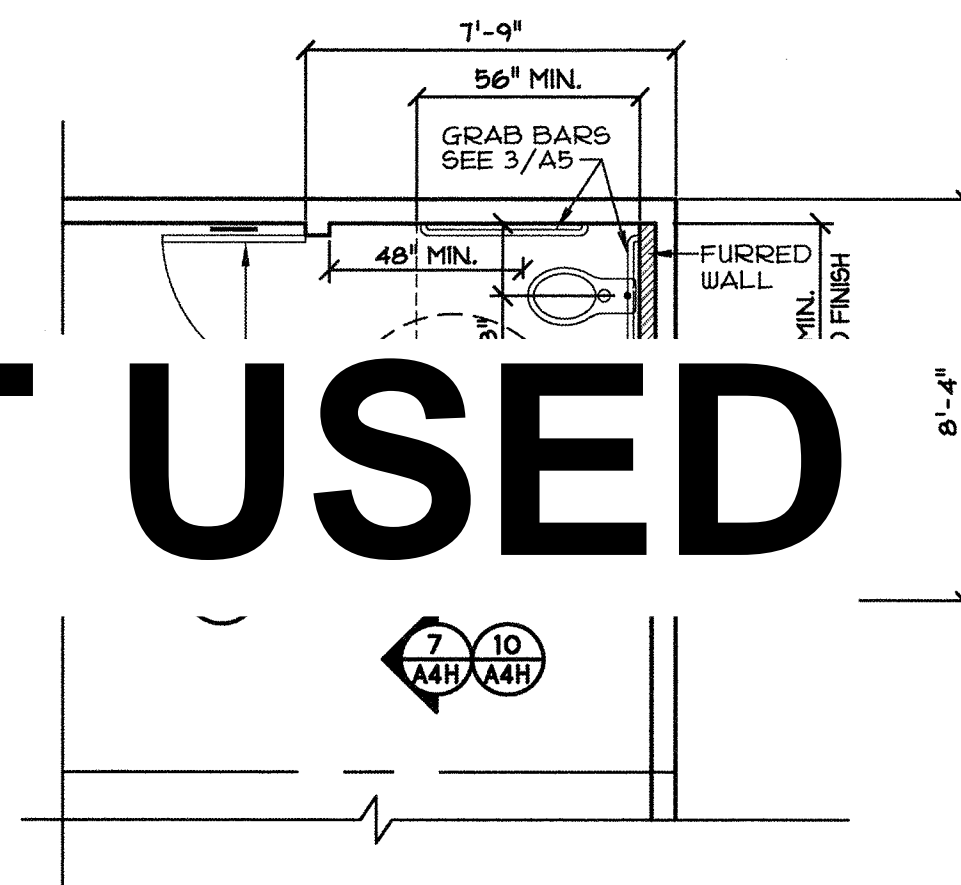

Alternate have an fire sprin If this pla a sprinkl for DSA during a specific application.

**NOT USED**

NOTE:  
EXHAUST VENTING IS REQUIRED.  
SEE NOTE 8/8, SHEETS A2, A2A,  
OR A2B.

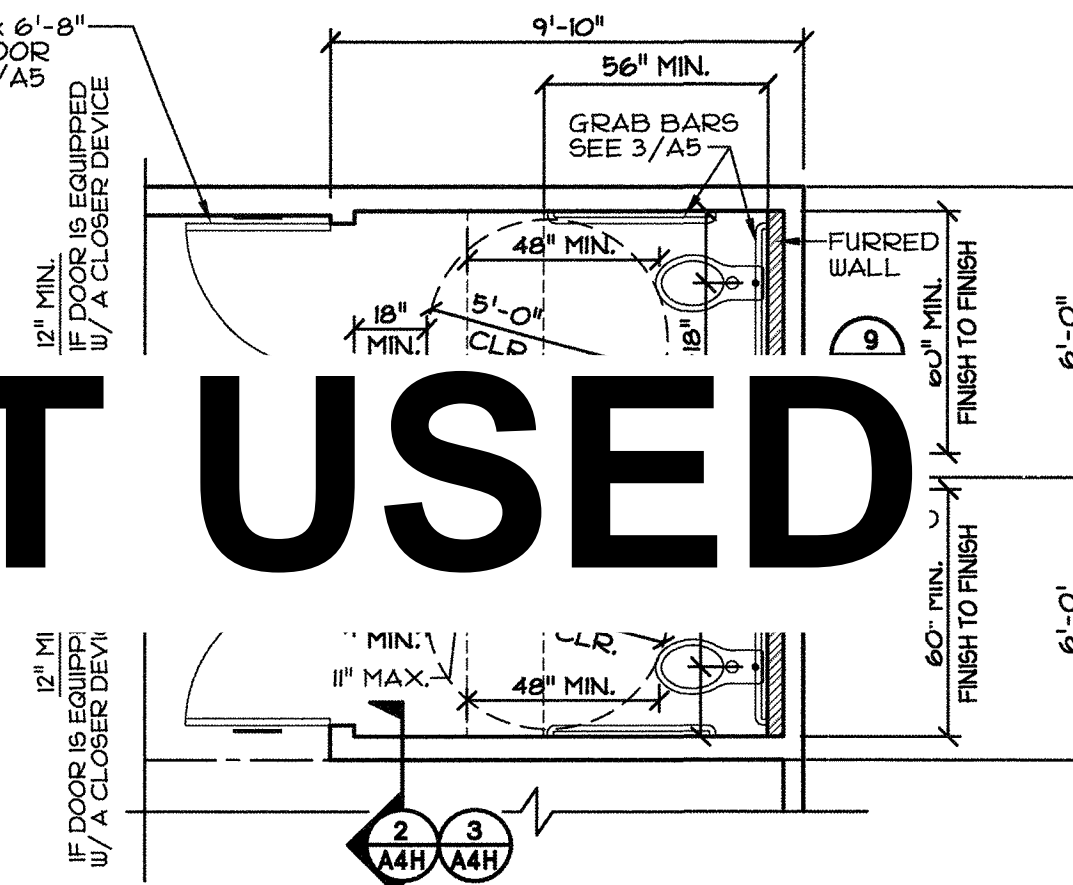

Alternate fire sprinkler system. If the plan is for a fire sprinkler system, the fire department will require a specific application. Roof plan, reflected ceiling plan, lighting & electrical plans, plumbing plans, etc. will also be reviewed under separate site specific application.

**NOT USED**

2 SINGLE TOILET OPTION  
SCALE: 1/4"=1'-0"

NOTE:  
EXHAUST VENTING IS REQUIRED.  
SEE NOTE 9/B, SHEETS A2, A2A,  
OR A2B.

TYPICAL LAYOUT SHOWN.  
ROOM CONFIGURATION,  
FIXTURE QUANTITIES AND  
ARRANGEMENTS MAY VARY.  
ALTERNATE LAYOUTS SHALL  
MEET ACCESSIBILITY  
REQUIREMENTS.

NOTE:  
INTERIOR WALLS AND CEILING  
FINISHES SHALL COMPLY WITH  
CBC TABLE 803.11

NOTE:  
INTERIOR DIMENSIONS SHOWN  
ARE FINISH TO FINISH.

Alternate floor plan shown does not have an approved automatic fire sprinkler system design in this PC. If this plan is to be used, a sprinkler design shall be provided for DSA review/approval during a separate project site specific application.

Roof plan, reflected ceiling plan, lighting & electrical plans, plumbing plans, etc. will also be reviewed under separate site specific application.

3 DOUBLE TOILET OPTION  
SCALE: 1/4"=1'-0"

Technical drawing of a mobile office unit. The drawing shows a side profile of the unit with a curved front end. Dimensions include a maximum length of 40'-0" and a minimum clearance of 18" for the front door. A label 'ED TYPE' is visible near the front door. The word 'USED' is prominently displayed in large, bold, black letters across the bottom of the drawing.

— 4' MIN DEPTH WATER PROTECTION ABOVE DOORS, AWNING (SEE SHEET AWI), CANOPY (SEE WCI), OR FREE STANDING SITE BUILT WALKWAY COVER BY OTHERS

9 DRINK. FOUNTAIN WING WALLS  
SCALE: NONE

CBC TABLE 11B-604.9  
SUGGESTED DIMENSIONS FOR CHILDREN'S USE

|                            | AGES 3 AND 4 | AGES 5 THRU 8 | AGES 9 THRU 12 |
|----------------------------|--------------|---------------|----------------|
| WATER CLOSET CENTERLINE    | 12"          | 12" TO 15"    | 15" TO 18"     |
| TOILET SEAT HEIGHT         | 11" TO 12"   | 12" TO 15"    | 15" TO 17"     |
| GRAB BAR HEIGHT            | 18" TO 20"   | 20" TO 25"    | 25" TO 27"     |
| DISPENSER HEIGHT TO OUTLET | 14"          | 14" TO 17"    | 17" TO 19"     |

### DIMENSIONS FOR ADULT USE

|                            |  |
|----------------------------|--|
| WATER CLOSET CENTERLINE    | 17" TO 18"   |
| TOILET SEAT HEIGHT         | 17" TO 19"   |
| GRAB BAR HEIGHT            | 33" TO 36" (TO TOP OF GRIP SURFACE)                            |
| DISPENSER HEIGHT TO OUTLET | 19" TO OUTLET (7" TO 9"<br>FROM FRONT OF TOILET TO CENTERLINE) |

Alternate floor plan shown does not have an approved automatic fire sprinkler system design in this PC. If this plan is to be used, a sprinkler design shall be provided for DSA review/approval during a separate project site specific application. Roof plan, reflected ceiling plan, lighting & electrical plans, plumbing plans, etc. will also be reviewed under separate site specific application.

OPTIONAL WINDOW IN  
EXTERIOR WALL, SIZE,  
LOCATIONS VARY.  
(SEE "S3" SHEET SERIES FOR DETAILS.)

TYPICAL LAYOUT SHOWN.  
ROOM CONFIGURATION,  
CASEWORK QUANTITIES AND  
ARRANGEMENTS MAY VARY.  
ALTERNATE LAYOUTS SHALL  
MEET ACCESSIBILITY  
REQUIREMENTS

VARIES


34" HIGH COUNTER  
@ ACCESSIBLE LOCATIONS  
(5%, BUT NEVER LESS THAN  
ONE, MUST BE ACCESSIBLE)

**NOT USED**


— 34" HIGH COUNTER  
 @ ACCESSIBLE LOCATIONS  
 (5%, BUT NEVER LESS THAN  
 ONE, MUST BE ACCESSIBLE.  
 SEE DETAIL 12/A5 —

OPTIONAL WINDOW IN NON-F  
 EXTERIOR WALL, SIZE, QUAN  
 LOCATIONS VARY.  
 (SEE "63" SHEET SERIES FOR

|   |                                  |
|---|----------------------------------|
| 9 | TYPICAL FIXTURE MOUNTING HEIGHTS |
|---|----------------------------------|

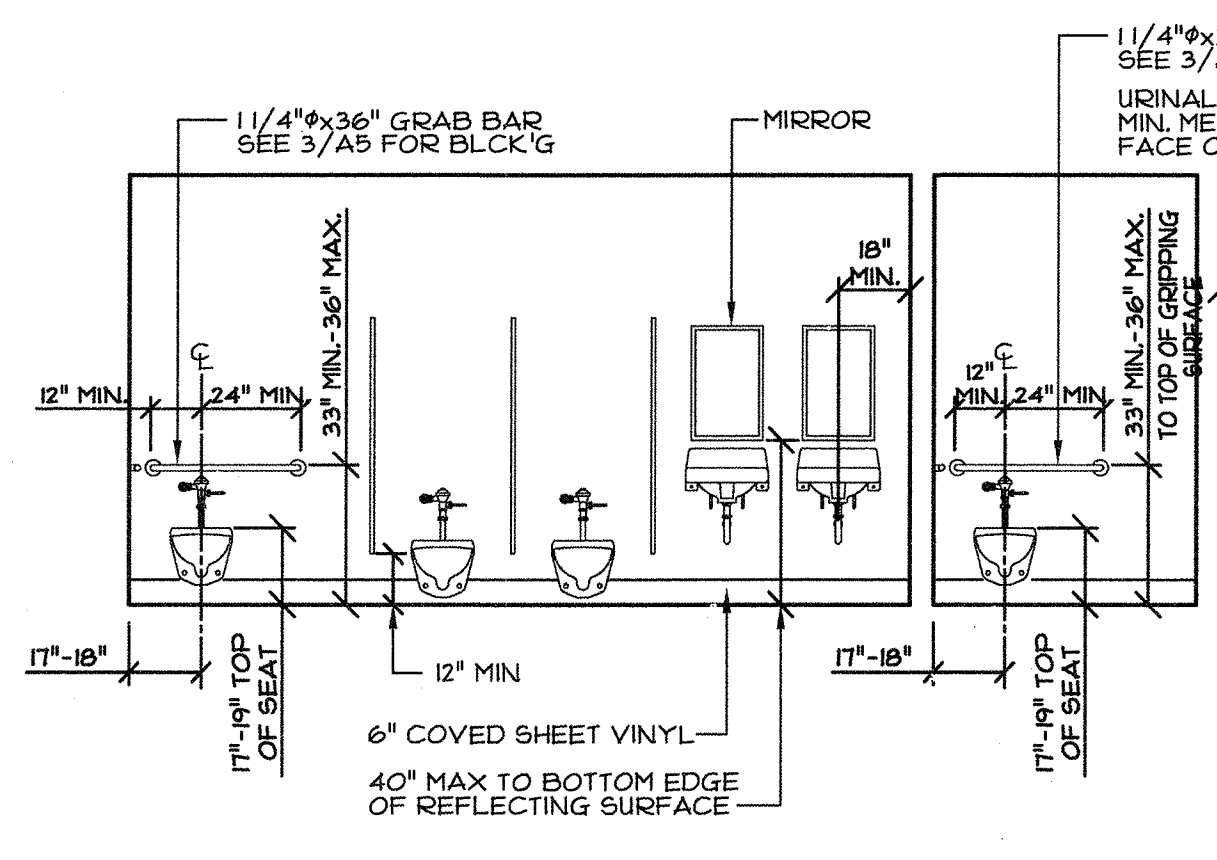

|   |                          |
|---|--------------------------|
| 6 | KITCHEN / CABINET OPTION |
|---|--------------------------|

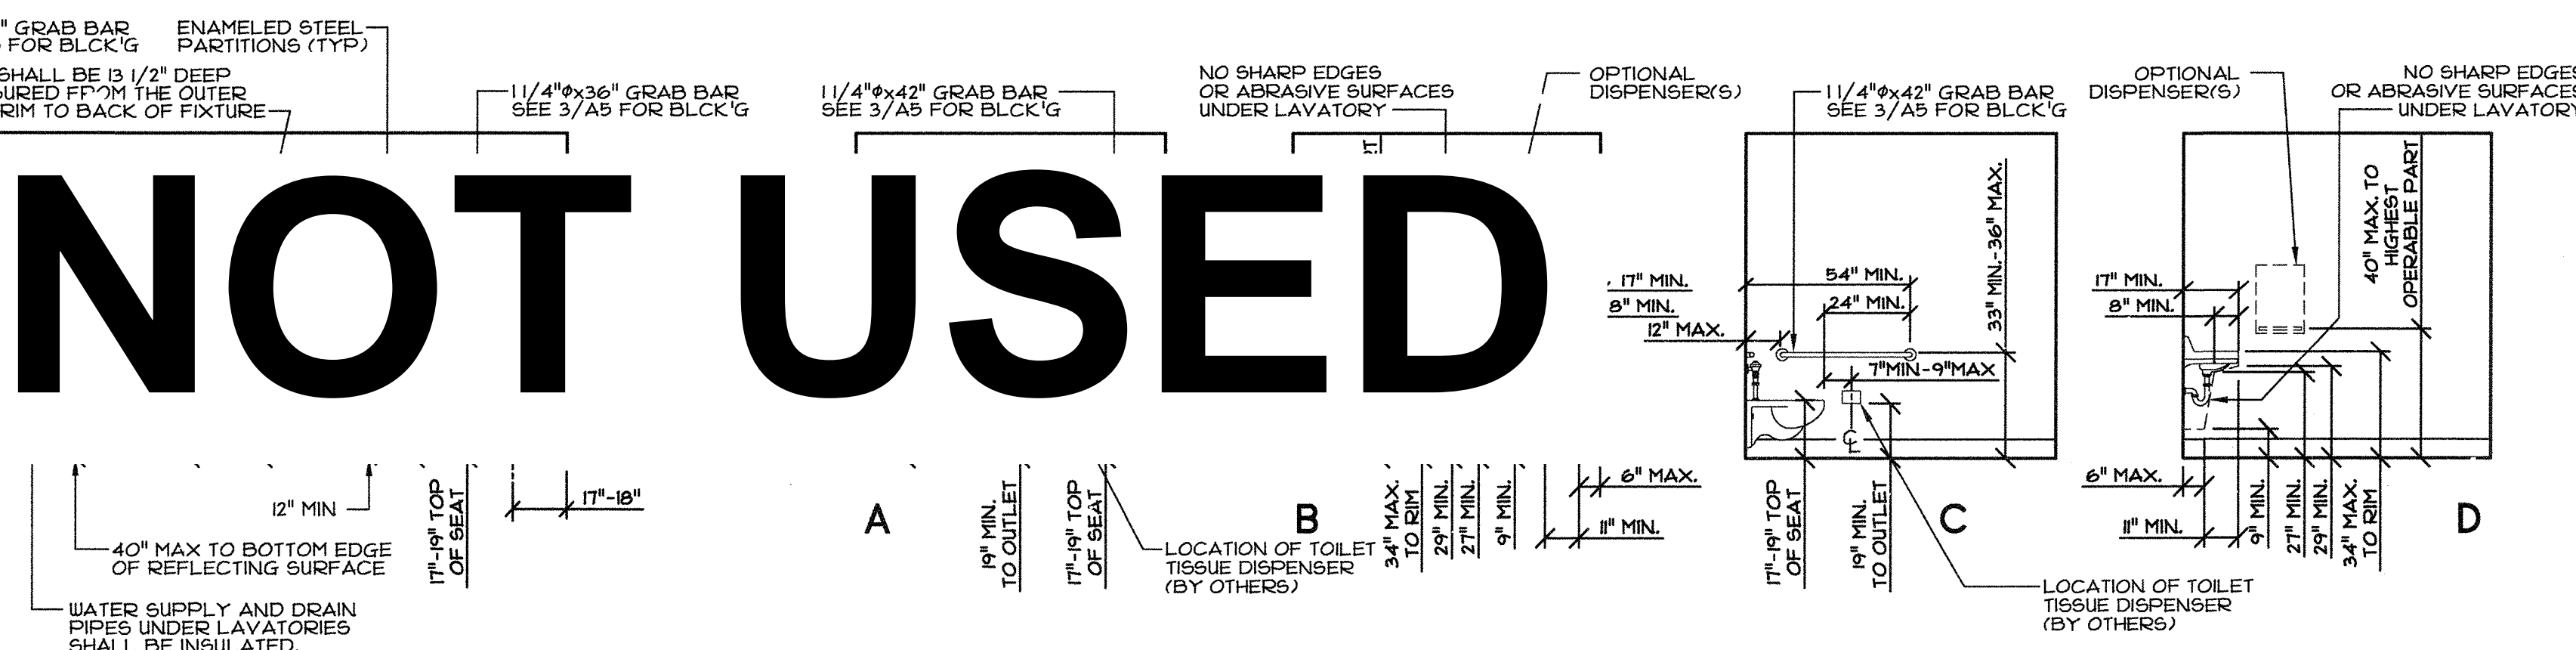


8 TYPICAL TOILET ROOM ELEVATIONS  
SCALE: 1/4"=1'-0"

FOR MATERIAL SPECIFICATIONS & NOTES, SEE SHEET AIN

IDENTIFICATION STAMP  
DIV. OF THE STATE ARCHITECT  
APP. 02-118017 INC:  
REVIEWED FOR  
SS ☒ FLS ☒ ACS ☒  
DATE: 04/10/2020

03/26/2020

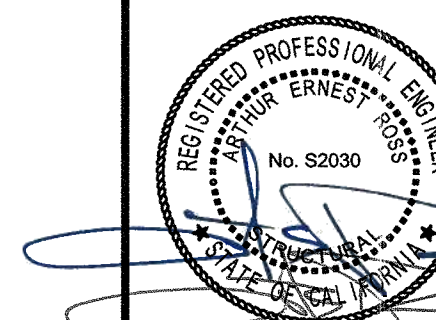

THESE DRAWINGS ARE PRELIMINARY  
AND NOT FOR CONSTRUCTION  
UNLESS STAMPED & SIGNED  
BY THE ENGINEER OF RECORD

**ENVIROPLEX, INC.**  
 4777 E. CARPENTER ROAD STOCKTON, CA. 95215, (209) 486-8000

---

SAR CHAVEZ HIGH SCHOOL - ATHLETIC FACILITY  
 STOCKTON UNIFIED SCHOOL DISTRICT  
 2929 WINDFLOWER LANE STOCKTON, CA 95212

## FLOOR PLAN OPTIONS

THIS SHEET NOT USED FOR O.T.C. APPLICATION

|             |  |
|-------------|--|
| REV / DATE: |  |
|             |  |
|             |  |
|             |  |
|             |  |
| JOB No.:    |  |
| DRAWN BY:   |  |
| DATE:       |  |

IDENTIFICATION STAMP  
DIVISION OF THE STATE ARCHIVES

02-116094

AC [signature] FLS [signature] SS [signature]  
DATE 9-6-2018

A1.01

~~PRE CHECK (PC) DOCUMENT~~  
~~Code: 2016 CBC~~  
~~A separate project application for~~  
~~construction is required.~~

CONFIDENTIAL MATERIAL--THESE DOCUMENTS ARE THE PROPERTY OF AND ARE NOT TO BE REPRODUCED OR DISTRIBUTED WITHOUT FULL KNOWLEDGE AND WRITTEN CONSENT FROM ENVIROPLEX, INC.  
© COPYRIGHT ENVIROPLEX, INC. (ALL DRAWINGS PREPARED BY ENVIROPLEX, INC.)



FINISHES:

1. CARPETS -

NOT USED

- 1.1 RESILIENT BASE COVE -  
BEST QUALITY, MOULDED RUBBER, 1/8" THICK, 4" HIGH, MOULDED TOP SET  
COVE. SOLID COLORS AS MANUFACTURED BY "BURKE RUBBER CO." OR  
EQUAL.  
ADHESIVE SHALL COMPLY WITH 2016 CAL GREEN BUILDING STANDARDS  
CODE, SEC 5.504.4.1
2. COMMERCIAL SHEET VINYL / RESILIENT FLOORING -  
ARMSTRONG CORLON OR EQUAL  
FLOORING SHALL BE SLIP RESISTANT. (0.5 MIN. COEFFICIENT OF  
FRICTION PER ASTM D-2047)  
80% OF NON-ABSORBENT FLOORING SHALL COMPLY WITH 2016 CAL  
GREEN STANDARDS CODE, SECTION 5.504.4.6.  
APPLICATION AND MAINTENANCE OF POLISHED-COATED FLOOR  
SURFACES IS BY OWNER.
- WALL BASE - 6" SELF COVED SHEET VINYL (SAME AS NOTE 1.1 ABOVE)
3. 1/2" VINYL WRAPPED TACKBOARD OVER 1/2" GYPSUM WALL BOARD.  
TACKBOARD FLAME SPREAD 85, SMOKE DENSITY 135.
4. FIBERGLASS REINFORCED POLYETHYLENE (FRP) PANELS OVER 1/2"  
GYPSUM WALL BOARD (OVER WATER RESISTANT GWB AT PLUMBING AND WET WALLS ONLY)  
FRP FLAME SPREAD 25, SMOKE DENSITY 180.
5. ADHESIVES SHALL BE WATER BASE, SOLVENT BASE NOT ACCEPTABLE. FURNISH  
AND APPLY PER MANUFACTURER'S WRITTEN INSTRUCTIONS.  
ADHESIVES SHALL COMPLY WITH 2016 CGBSC, SECTION 5.504.4.1
6. SEALANTS -  
ROOF & MODULE LINE - POLYURETHANE  
SIDING & TRIM - ACRYLIC LATEX  
SEALANTS SHALL COMPLY WITH 2016 CGBSC, SECTION 5.504.4.1
7. PAINT -  
EXTERIOR WOOD  
PRIMER.....ACRYLIC UNDERCOAT  
FINISH .....ACRYLIC LATEX
- METALS  
PRIMER.....RED OXIDE ALKYL  
FINISH .....ACRYLIC LATEX
- PAINTS AND COATINGS SHALL COMPLY WITH 2016 CGBSC, SECTION  
5.504.4.3
8. EXTERIOR SIDING -
- NOT USED
9. JOINTS, PENETRATIONS AND OTHER OPENINGS IN THE BUILDING ENVELOPE SHALL BE  
SEALED TO LIMIT INFILTRATION AND EXFILTRATION.  
SEALANT PAINTED TO MATCH FINISHES.
10. ENVIRONMENTAL QUALITY:  
ALL ADHESIVES, SEALANTS, CAULKS, PAINTS, COATINGS, CARPET SYSTEMS, CARPET CUSHIONS,  
COMPOSITE WOOD PRODUCTS, AND RESILIENT FLOORING SYSTEMS SHALL COMPLY WITH 2016  
CAL GREEN BUILDING STANDARDS CODE, REFERENCE TABLES 5.504.4.1, 5.504.4.2, 5.504.4.3, AND  
5.504.4.5.

DOORS:

1. HOLLOW METAL DOORS AND FRAMES- SIZES NOTED ON PLAN, 1 3/4" THICK 18 GA.  
FULL FLUSH DOOR IN 16 GA. METAL FRAME  
EXIT DOOR SHALL BE OPENABLE FROM THE INTERIOR WITHOUT A KEY OR SPECIAL  
KNOWLEDGE OR EFFORT.
2. CLOSERS FOR INTERIOR AND EXTERIOR DOORS SHALL BE SET FOR A MAXIMUM OPENING PRESSURE OF  
5 LBS. MAX. CLOSERS SHALL BE ADJUSTED SO THAT FROM AN OPEN POSITION OF 90 DEGREES, THE TIME  
REQUIRED TO MOVE THE DOOR TO A POSITION 12 DEGREES FROM THE LATCH IS 5 SECONDS MINIMUM.
3. DEADBOLTS NOT PERMITTED UNLESS OPERABLE WITH A SINGLE EFFORT USING  
LEVER HANDLE.
4. DOOR HANDLES & PULLS SHALL BE PLACED ON BOTH SIDES; LATCHES, LOOKS AND OTHER OPERATING  
DEVICES ON DOORS REQUIRED TO BE ACCESSIBLE SHALL NOT REQUIRE TIGHT GRASPING, TIGHT  
PINCHING, OR TWISTING OF THE WRIST TO OPERATE AND SHALL BE 34" MINIMUM AND 44 INCHES  
MAXIMUM ABOVE FINISHED FLOOR.
5. DOOR SWINGS CAN BE RIGHT OR LEFT HAND HINGE.
6. HARDWARE SHALL BE CENTERED BETWEEN 34" AND 44" ABOVE FINISHED FLOOR.  
- ALL DOORS TO CLASSROOMS, AND ANY ROOM WITH AN OCCUPANT LOAD OF 5 OR  
MORE PERSONS, SHALL BE EQUIPED WITH 'AB211' COMPLIANT HARDWARE.
7. CLASSROOM EXTERIOR DOOR HARDWARE:  
LOCKSET (LEVER MODEL): SCHLAGE ND60PD RHO (OR EQUAL)  
(TYP. UNLESS OTHERWISE NOTED)  
LOCKSET (PANIC DEVICE):
- EXTERIOR HINGES: HAGER BB1279 N.R.P. 4-1/2" x 4-1/2" OR EQUAL  
INTERIOR HINGES: HAGER 1279 N.R.P. 4-1/2" x 4-1/2" OR EQUAL  
CLOSER: NORTON 8501BF OR EQUAL  
THRESHOLD: PEMKO 271A OR EQUAL  
DOOR BOTTOM: PEMKO 216AV OR EQUAL  
WEATHERSTRIP: PEMKO 239AV OR EQUAL
8. RESTROOM EXTERIOR DOOR HARDWARE:  
LOCKSET: SCHLAGE D70PD RHO OR EQUAL  
HINGES: HAGER BB1279 N.R.P. 4-1/2" x 4-1/2" OR EQUAL  
CLOSER: NORTON 8501BF OR EQUAL  
THRESHOLD: PEMKO 271A OR EQUAL  
DOOR BOTTOM: PEMKO 216AV OR EQUAL  
WEATHERSTRIP: PEMKO 306A OR EQUAL

WINDOWS:

1. WINDOWS: FOR ALL CLIMATE ZONES - DOUBLE PANE, CLEAR,  
ALUM. FRAME W/ NFRC RATED U-VALUE = 0.65 MIN. / SHGC = 0.30 MIN. / VT = 0.50 MIN.  
IS REQUIRED (VINYL FRAME WINDOWS MAY BE USED AS LONG AS MINIMUM  
U-VALUE, SHGC, AND VT NOTED ABOVE ARE MET)
- A MINIMUM OF (1) OPERABLE WINDOW IN EACH ROOM OR SPACE SHALL COMPLY WITH SECTION 11B-309
- 11B-309 Operable Parts
- 11B-309.1 General.  
Operable parts shall comply with Section 11B-309
- 11B-309.2 Clear floor space.  
A clear floor or ground space complying with Section 11B-305 shall be provided.
- 11B-309.3 Height.  
Operable parts shall be placed within one or more of the reach ranges specified in Section 11B-308
- 11B-309.4 Operation  
Operable parts shall be operable with one hand and shall not require tight grasping, pinching,  
or twisting of the wrist. The force required to activate operable parts shall be 5 pounds maximum.

PLUMBING:

1. PLUMBING FIXTURE SCHEDULE:
- WATER CLOSET (WALL MOUNT): KOHLER "KINGSTON" (1.28 G.P.F.) K-4325 OR EQUAL  
W/ SLOAN ROYAL 111-1.28 FLUSH VALVE (1.28 G.P.F.) OR EQ.
- WATER CLOSET (FLOOR MOUNT): KOHLER "HIGHCLIFF ULTRA" (1.28 G.P.F.) K-96058-SSL OR EQUAL  
W/ SLOAN ROYAL 111-1.28 FLUSH VALVE (1.28 G.P.F.) OR EQ.
- SEAT: BEMIS 1955-SSC (O.F.L.C.) OR EQUAL
- URINALS: KOHLER "DEXTER" K-5452-ET (0.125 G.P.F.) OR EQUAL  
W/ SLOAN MODEL 186-0.125 FLUSH VALVE (0.125 G.P.F.) OR EQ.
- LAVATORIES: KOHLER "KINGSTON" K-2005 20" x 18" OR EQUAL
- FAUCET: T & S BRASS, B-2711-F05 (0.5 GPM) OR EQUAL
- OPTIONAL WATER HEATER: "AO SMITH", PEC-30, 30 GAL. ELECTRIC,  
15,359 INPUT RATE, (OR EQUAL)  
EXPOSED HOT WATER PIPES SHALL BE INSULATED.  
1" THICK INSULATION FOR PIPE 1" DIA OR LESS.  
1 1/2" THICK INSULATION FOR PIPE GREATER THAN 1" DIA.
- COLD WATER PIPING: TYPE L COPPER
- DRAIN, WASTE & VENT: ABS AND PVC PIPES, STRAPPED TO RESIST HORIZONTAL  
DISPLACEMENT DUE TO EARTHQUAKE MOTION PER TITLE  
24, PART 5, CALIFORNIA CODE OF REGULATIONS,  
CHAPTER 4, SEC. 401 (A)
2. ALL PLUMBING FIXTURES AND ACCESSORIES TO BE INSTALLED IN ACCORDANCE  
WITH ACCESSIBILITY REQUIREMENTS. (PER SECTION C.B.C. 11B DIVISION 6)  
FAUCET CONTROLS AND OPERATING MECHANISMS SHALL BE OPERABLE BY ONE  
HAND AND NOT REQUIRE TIGHT GRASPING, PINCHING, OR TWISTING OF THE WRIST.  
THE FORCE REQUIRED TO ACTIVATE CONTROLS SHALL BE NO GREATER THAN 5 LBS.  
LEVER OPERATED, PUSH TYPE, AND ELECTRONICALLY CONTROLLED MECHANISMS  
ARE EXAMPLES OF ACCEPTABLE DESIGNS. SELF CLOSING VALVES ARE ALLOWED  
IF THE FAUCET REMAINS OPEN FOR AT LEAST 10 SECONDS.
3. ALL TOILETS; FLOOR MOUNTED, OR WALL MOUNTED W/ HAND OPERATED FLUSH VALVE  
LOCATED 44 INCHES MAX. ABOVE FLOOR. WHEELCHAIR ACCESSIBLE TOILETS SHALL HAVE  
THE FLUSH VALVE ACTIVATOR ON THE OPEN SIDE.
4. RESTROOM PRIVACY PARTITIONS:  
DOORS HANDLES FOR ENAMELED STEEL PARTITIONS SHALL BE PLACED ON BOTH SIDES NEAR THE  
LATCH; SHALL PROVIDE A CLEAR WIDTH OF 34" FOR WHEELCHAIR ACCESSIBLE STALLS AND 24" WIDE  
FOR STANDARD STALLS. DOORS FOR ACCESSIBLE TOILETS SHALL BE SELF CLOSING, LATCHES, LOOKS  
AND OTHER OPERATING DEVICES ON DOORS REQUIRED TO BE ACCESSIBLE SHALL NOT REQUIRE  
TIGHT GRASPING, TIGHT PINCHING, OR TWISTING OF THE WRIST TO OPERATE AND SHALL BE 34"  
MINIMUM AND 44 INCHES MAXIMUM ABOVE FINISHED FLOOR.(TOILET PARTITIONS MATERIALS PER 2016  
CBC 803.1.1 - MIN. CLASS "C" RATING
5. RESTROOM DOOR SIGNAGE:  
THE DOOR LEADING INTO BOY'S FACILITY SHALL BE IDENTIFIED BY AN EQUILATERAL  
TRIANGLE 1/4" THICK WITH EDGES 12" LONG AND A VERTEX POINTING UPWARD. THE  
DOOR LEADING INTO GIRL'S FACILITY SHALL BE IDENTIFIED BY A CIRCLE 1/4" THICK  
AND 12" IN DIAMETER. UNISEX FACILITY SHALL BE IDENTIFIED BY A CIRCLE 1/4" THICK  
AND 12" IN DIAMETER WITH A 1/4" THICK TRIANGLE WITH THE VERTEX POINTING UPWARD  
SUPERIMPOSED ON THE CIRCLE & WITHIN THE 12" DIAMETER. THE GEOMETRIC  
SYMBOLS SHALL BE MOUNTED ON THE DOOR AT A HEIGHT PER DETAIL 5 SHEET A5 AND  
THEIR COLOR AND CONTRAST SHALL MEET THE IDENTIFICATION SIGNAGE FINISH  
REQUIREMENTS OF DETAIL 10 SHEET A5

ROOFING

1. METAL ROOF:  
PREFINISHED, UNPENETRATED INTERLOCKING, 26 GAGE MIN. GALVANIZED STEEL ROOF  
PANELS, MECH. CRIMPED STANDING SEAMS OVER SEAL-TITE #15 UNDERLAYMENT  
OVER 5/8" APA RATED, EXTERIOR GRADE PLYWOOD, OR ORIENTED STRAND BOARD  
CLASS "B" FIRE RATING). REFERENCE 2A1R FOR ATTACHMENT.

INSULATION

1. ALL INSULATION (INCLUDING PIPE INSULATION) SHALL COMPLY WITH CALIFORNIA  
QUALITY STANDARDS, CALIFORNIA BUILDING CODE SEC. 720 & 2603 FOR  
FOAM. MAX FLAME SPREAD: 25, MAX SMOKE DENSITY: 450
- ~~ROOF:~~ ALL CLIMATE ZONES - R-19 FIBERGLASS BATTS REQUIRED (MIN.)
- ~~WALLS:~~ ALL CLIMATE ZONES - R-13 FIBERGLASS BATTS REQUIRED (MIN.)
- ~~FLOOR:~~ ALL CLIMATE ZONES - 2" POLYISOCYANURATE RIGID INSULATION  
(R-6.4 PER INCH OR GREATER)

IDENTIFICATION

1. NOTE: THE MANUFACTURER SHALL PLACE TWO PERM. JENT METAL IDENTIFICATION TAG  
ON EACH MODULAR BUILDING MECHANICALLY FASTENED TO THE END WALL. THE TAG  
SHALL SHOW D.S.A. APPLICATION NUMBER, MANUFACTURER'S SERIAL NUMBER, PLANT  
INSPECTOR'S IDENTIFICATION MARK AND DESIGN FLOOR AND ROOF LIVE LOAD.  
PLACE ONE TAG ON EXTERIOR AND, ONE ON THE INTERIOR ABOVE CEILING LINE.



LUMBER NOTES

1. SAW LUMBER GRADED PER WEST COAST LUMBER INSPECTION BUREAU, RULE 17.
2. ALL FRAMING LUMBER SHALL BE DOUGLAS FIR #2.  
ALL BLOCKING SHALL BE DOUGLAS FIR #3.
3. LAG SCREWS AND SCREWS SHALL BE SCREWED AND NOT DRIVEN INTO PLACE.
4. LUMBER MAY BE REJECTED FOR BOXED HEART, EXCESSIVE WARP, TWIST, SPLIT,  
CHECK, FUNGUS, MOLD, OR ANY REASON PROVIDED BY GRADING RULES.
5. ALL FRAMING LUMBER SHALL HAVE A MAXIMUM MOISTURE CONTENT OF 19% AT THE  
TIME OF INSTALLATION AND SHALL BE AT 19% MAXIMUM MOISTURE CONTENT (VERIFIED  
BY THE CONTRACTOR) BEFORE BEING ENCLOSED BY INSULATION,  
GYPSUM BOARD, OR OTHER SURROUNDING MATERIALS.

BUILDING AND WALL PANELS:

1. ALL MODULES MAY BE BUILT OPPOSITE HAND FROM THE WAY THEY ARE SHOWN
2. SIDEWALL & ENDWALL ELEVATIONS DEPICT NON-BEARING  
WALLS NOT REQUIRED FOR THE RESISTANCE OF VERTICAL OR LATERAL LOADS.

IDENTIFICATION STAMP  
DIV. OF THE STATE ARCHITECT  
APP. 02-118017 INC.  
REVIEWED FOR  
SS ☐ FLS ☐ ACS ☐  
DATE: 04/10/2020

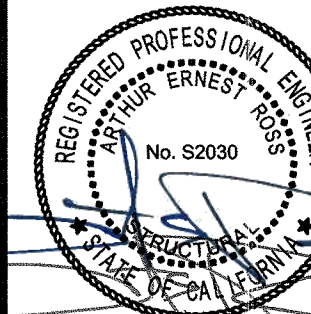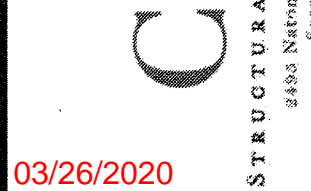

THESE DRAWINGS ARE PRELIMINARY  
AND NOT FOR CONSTRUCTION  
UNLESS STAMPED & SIGNED BY  
THE ENGINEER OF RECORD.

**ENVIROPLEX, INC.**  
4777 E. CARPENTER ROAD STOCKTON, CA 95215, (209) 466-8000  
CESAR CHAVEZ HIGH SCHOOL - ATHLETIC FACILITY  
STOCKTON UNIFIED SCHOOL DISTRICT  
2929 WINDFLOWER LANE STOCKTON, CA 95212

MATERIAL SPECIFICATIONS & NOTES


| REV / DATE: | BY: |
|-------------|-----|
|             |     |
|             |     |
JOB No.:  
DRAWN BY:  
DATE:


IDENTIFICATION STAMP  
DIVISION OF THE STATE ARCHITECT  
02-118094  
AC ☐ FLS ☐ ACS ☐  
DATE: 9-6-2018  
0016 - 2440

PRE-CHECK (PC) DOCUMENT  
Code: 2016-CBC  
A separate project application for  
construction is required.




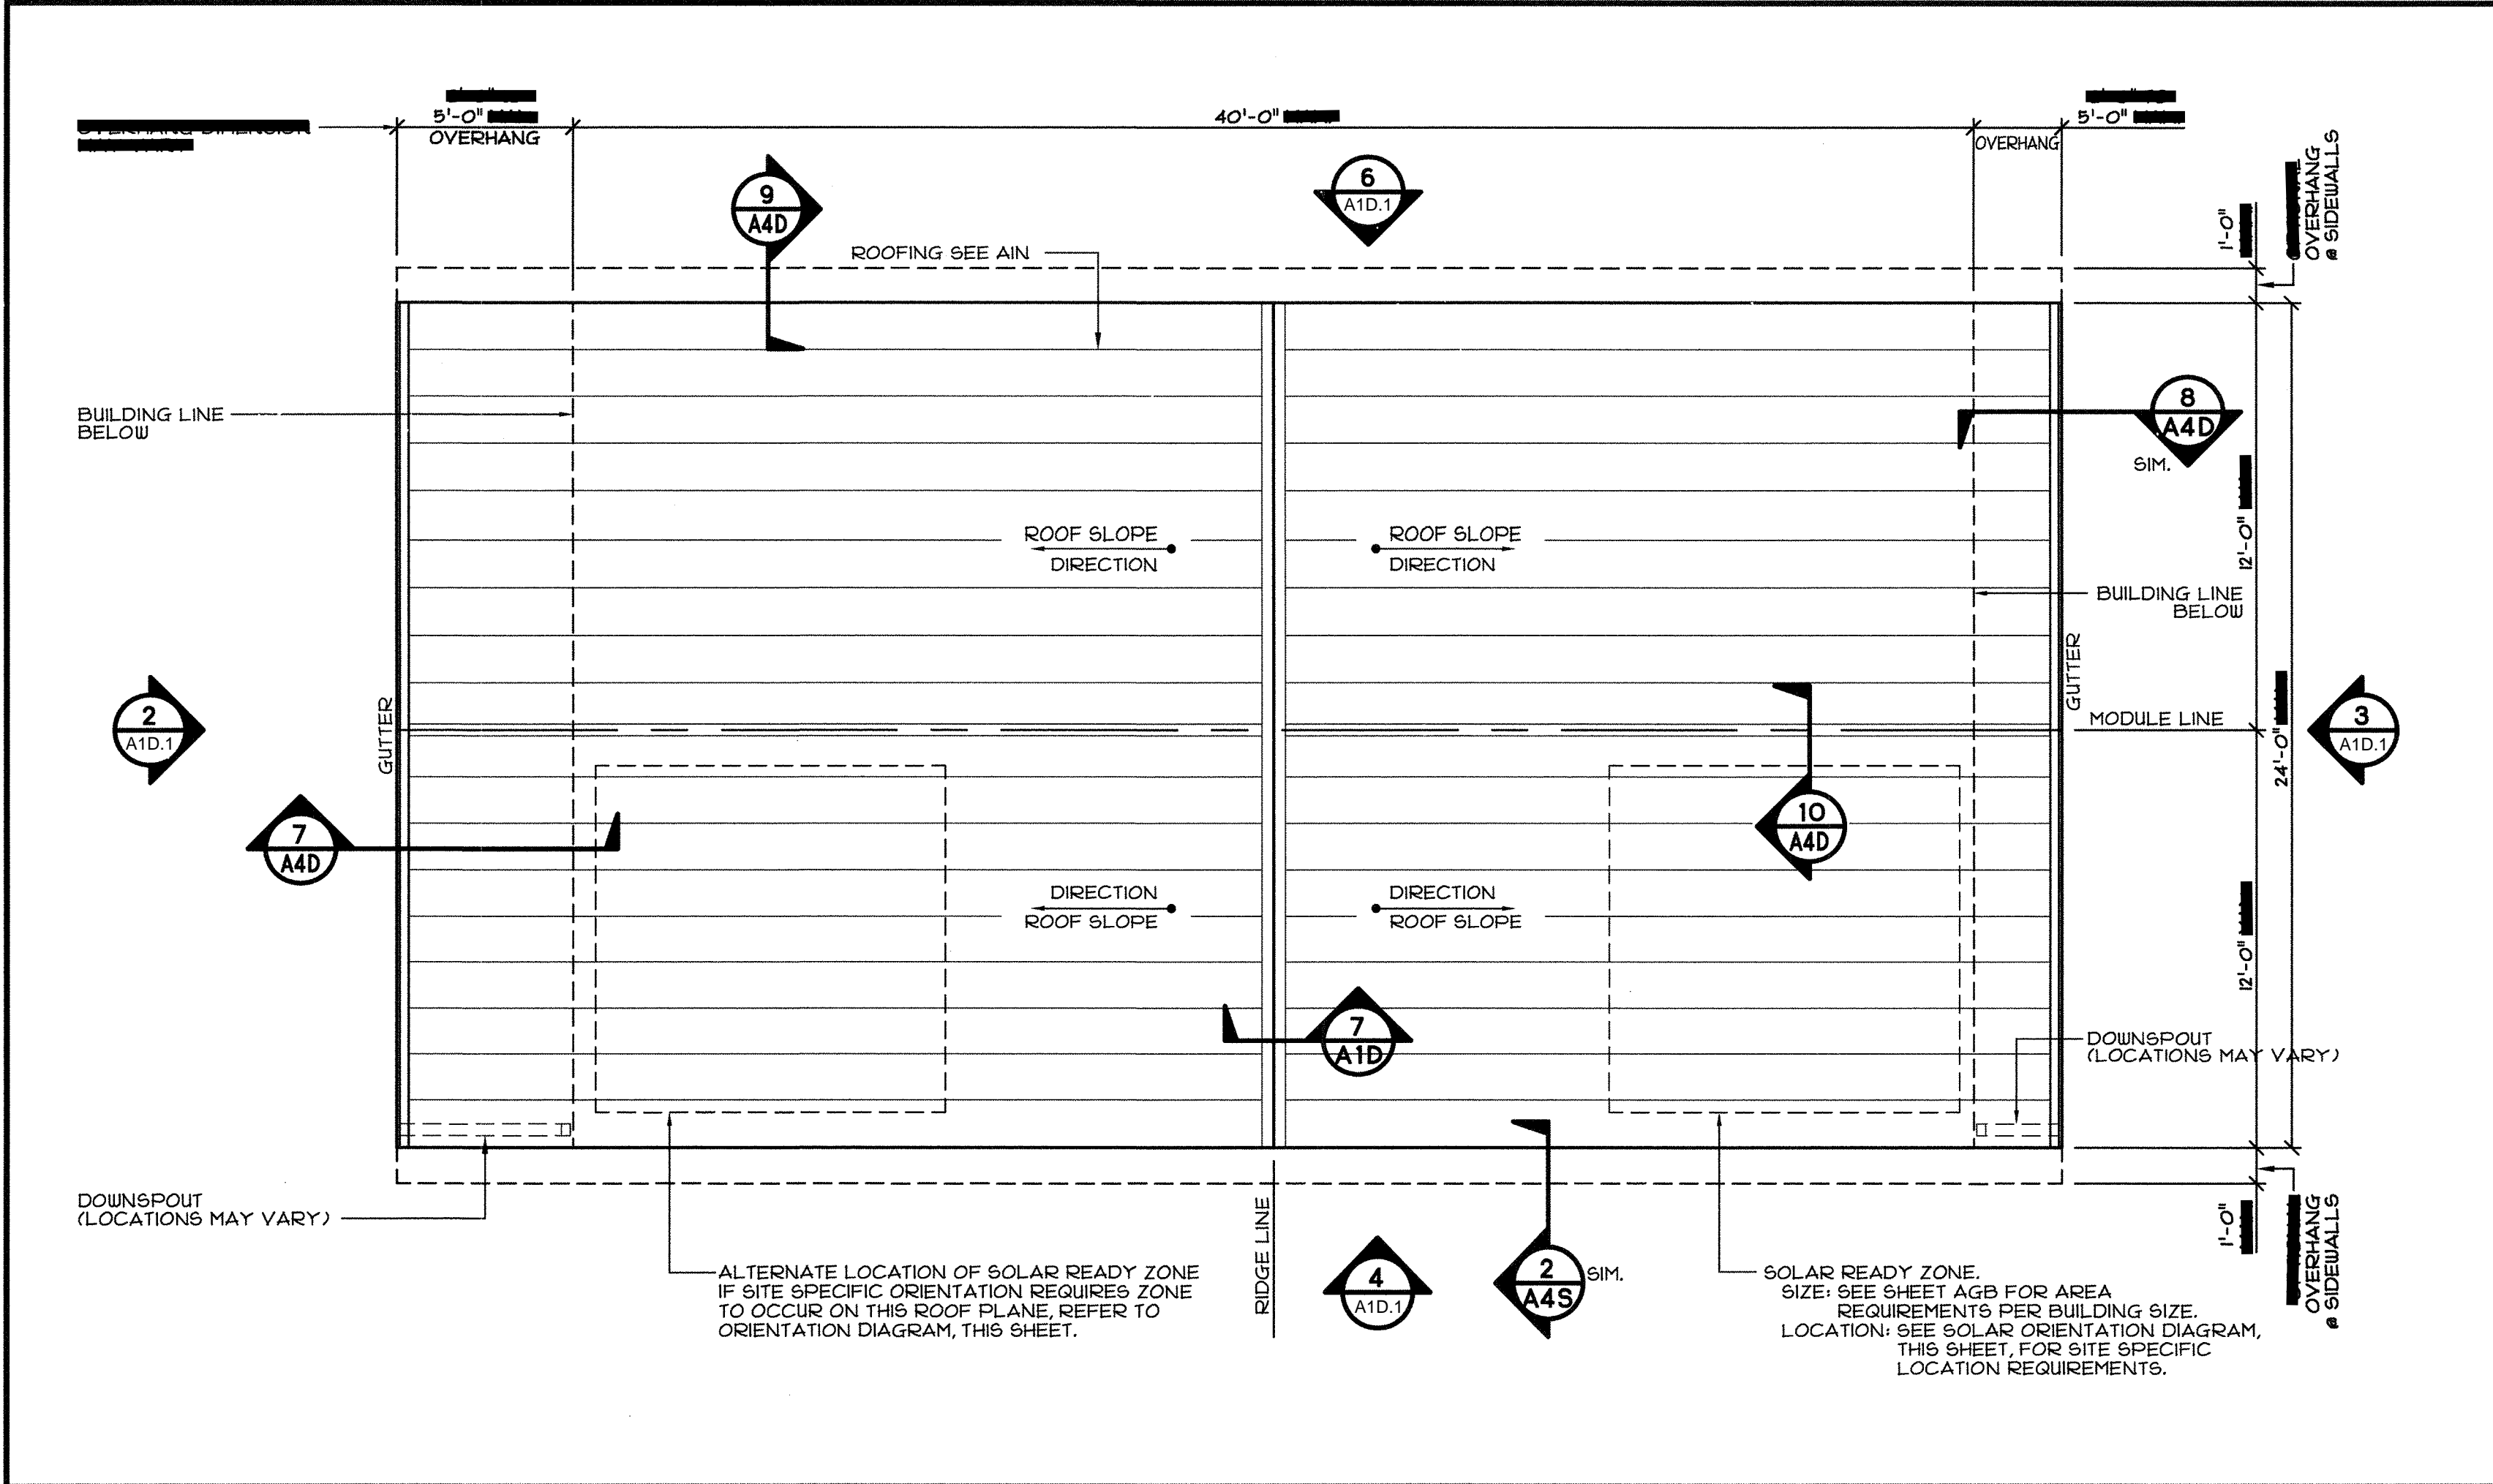


1 ROOF PLAN  
SCALE: 1/4"=1'-0"

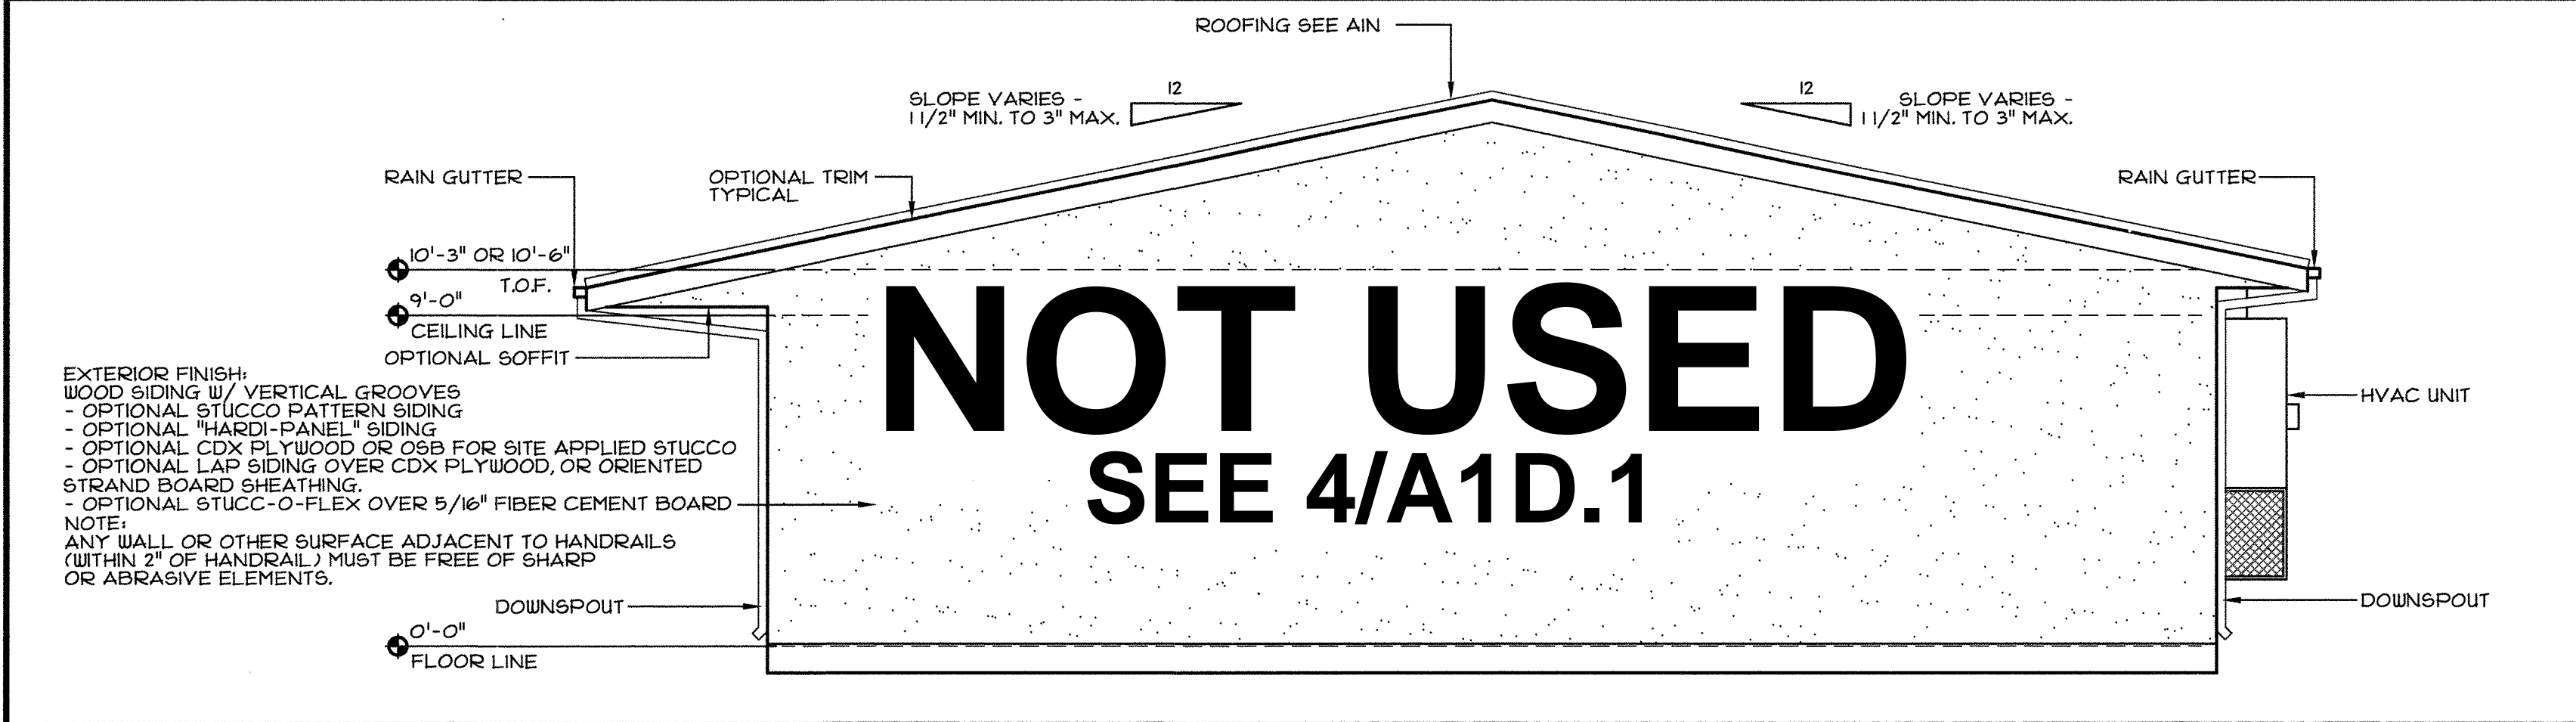


4 SIDE WALL EXTERIOR ELEVATION  
SCALE: 1/4"=1'-0"

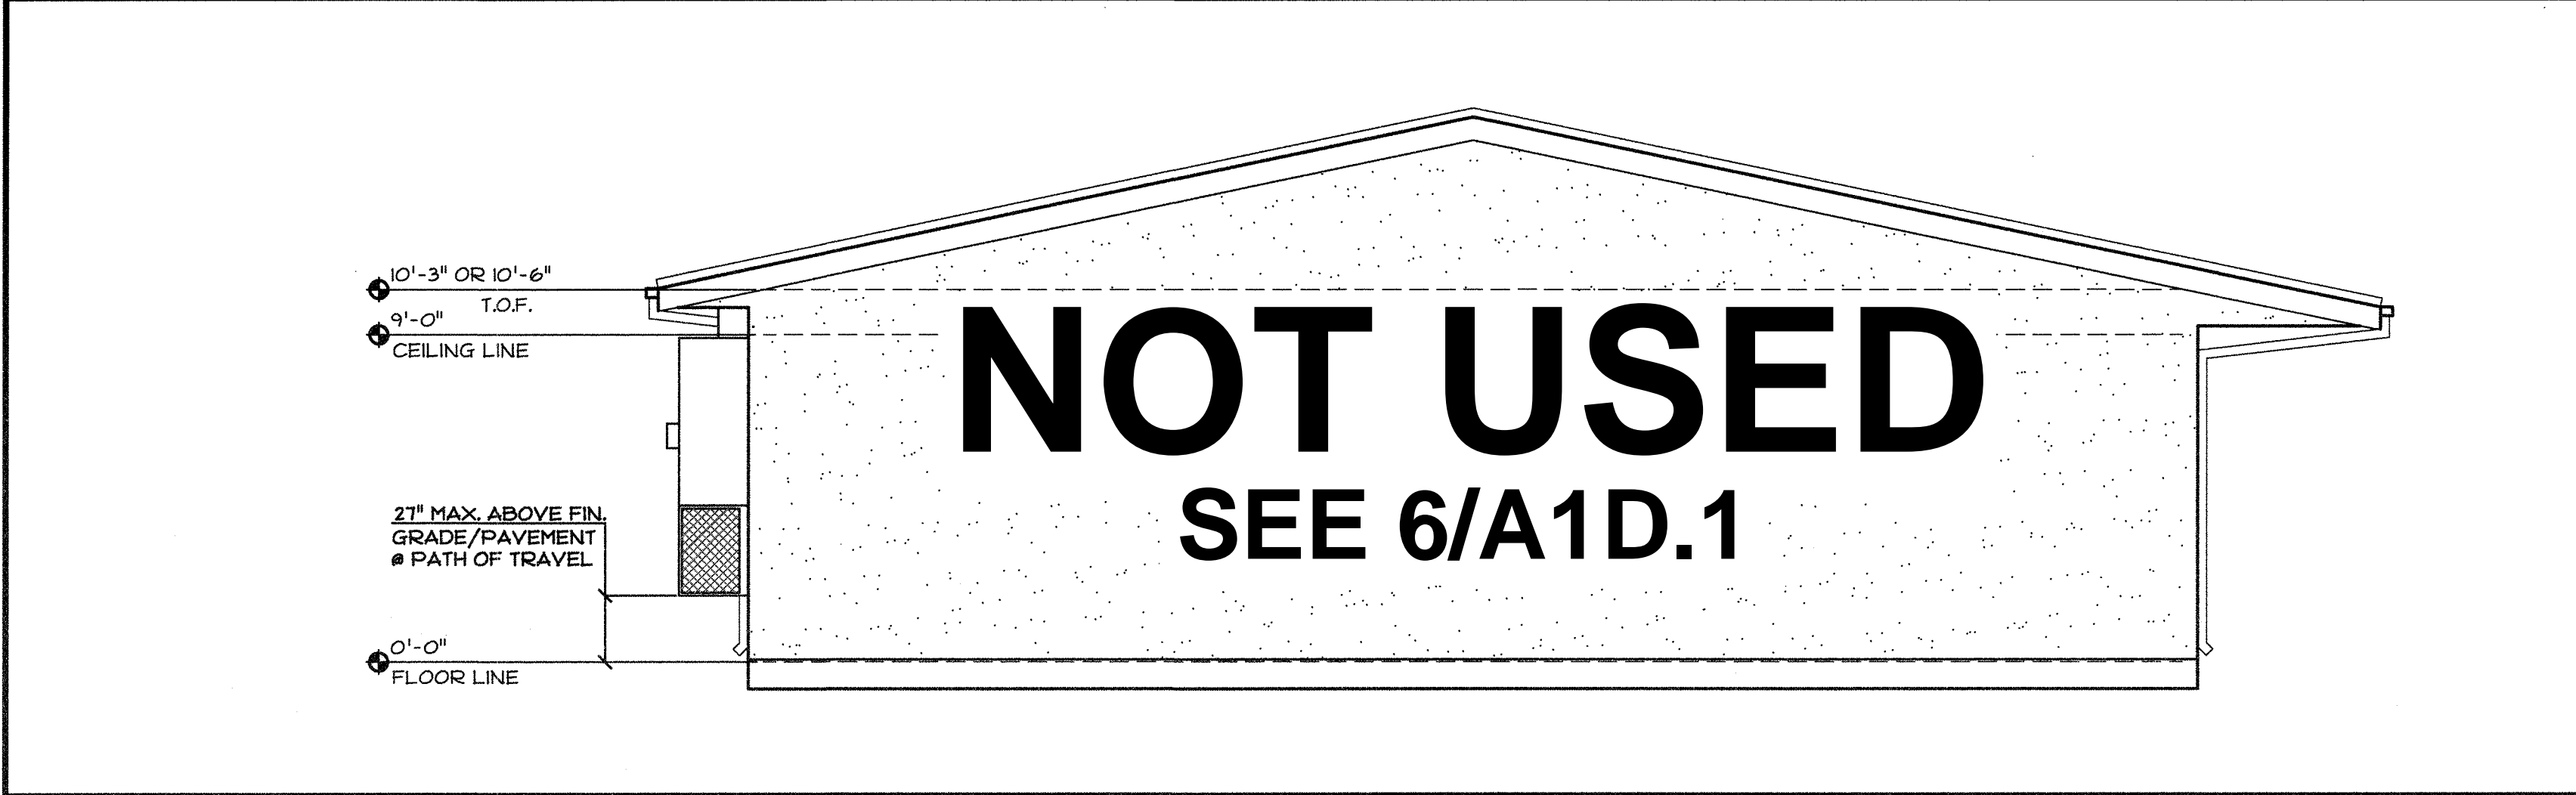


6 SIDE WALL EXTERIOR ELEVATION  
SCALE: 1/4"=1'-0"

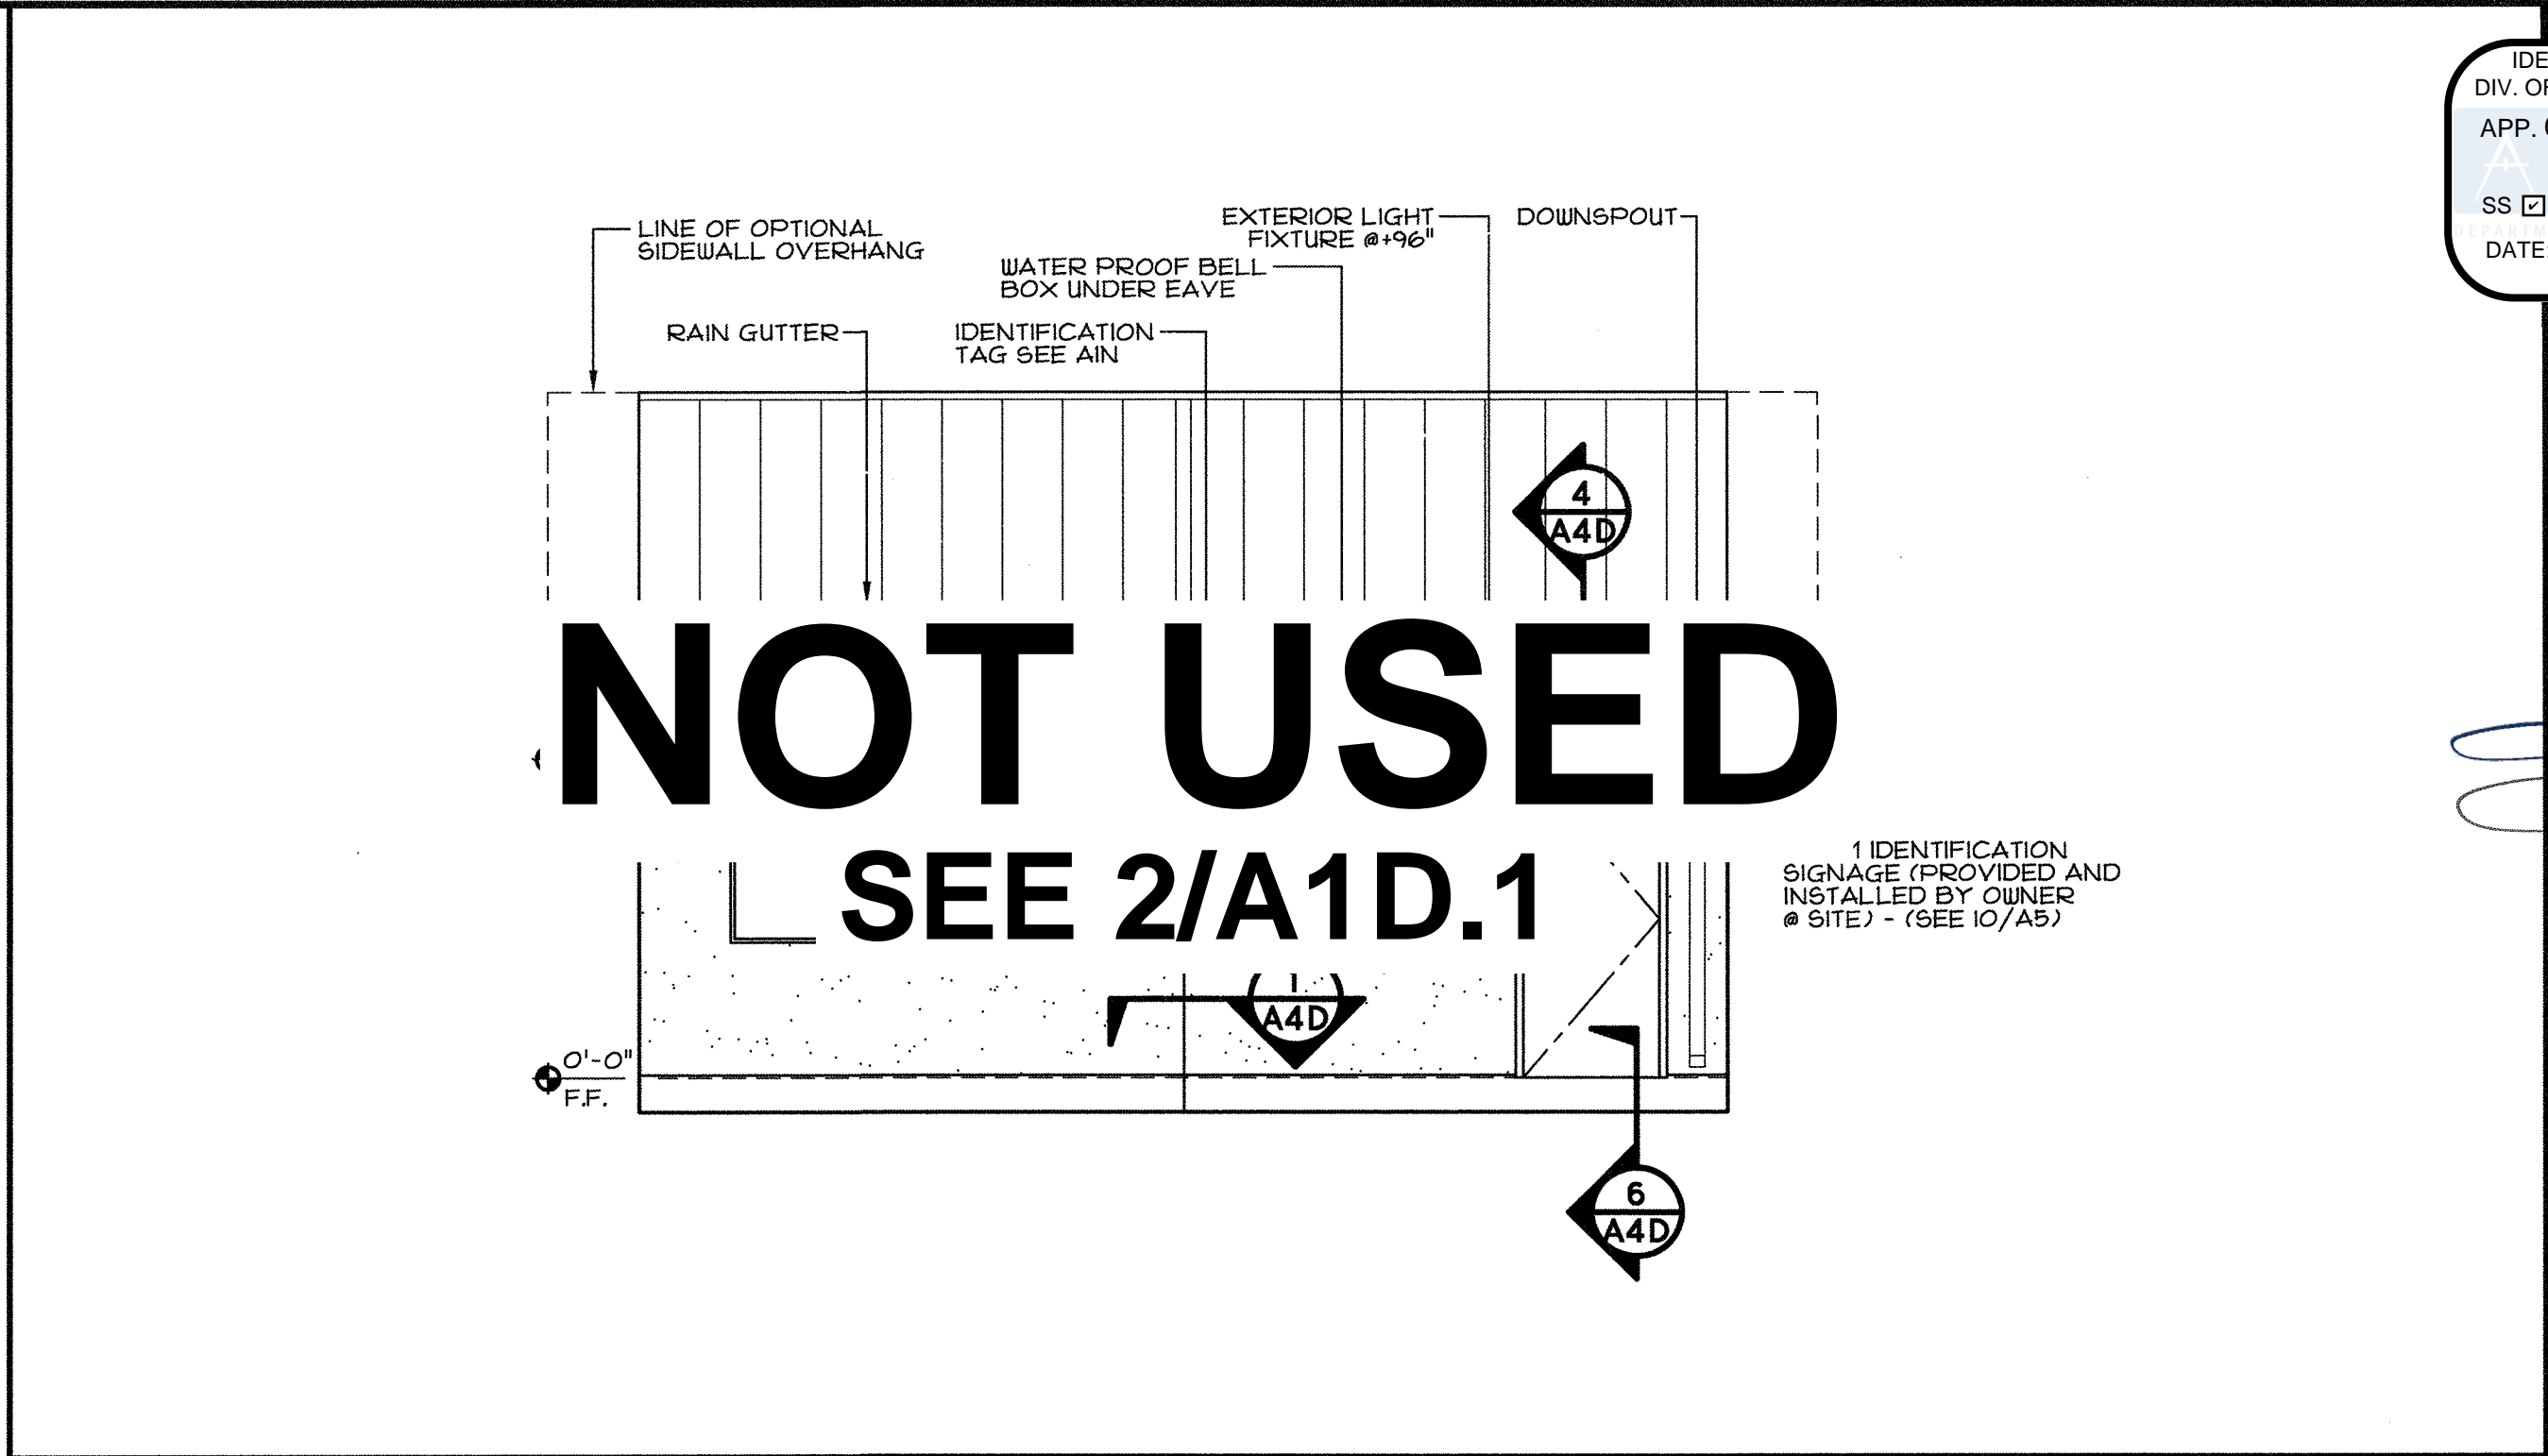

2 END WALL EXTERIOR ELEVATION  
SCALE: 1/4"=1'-0"

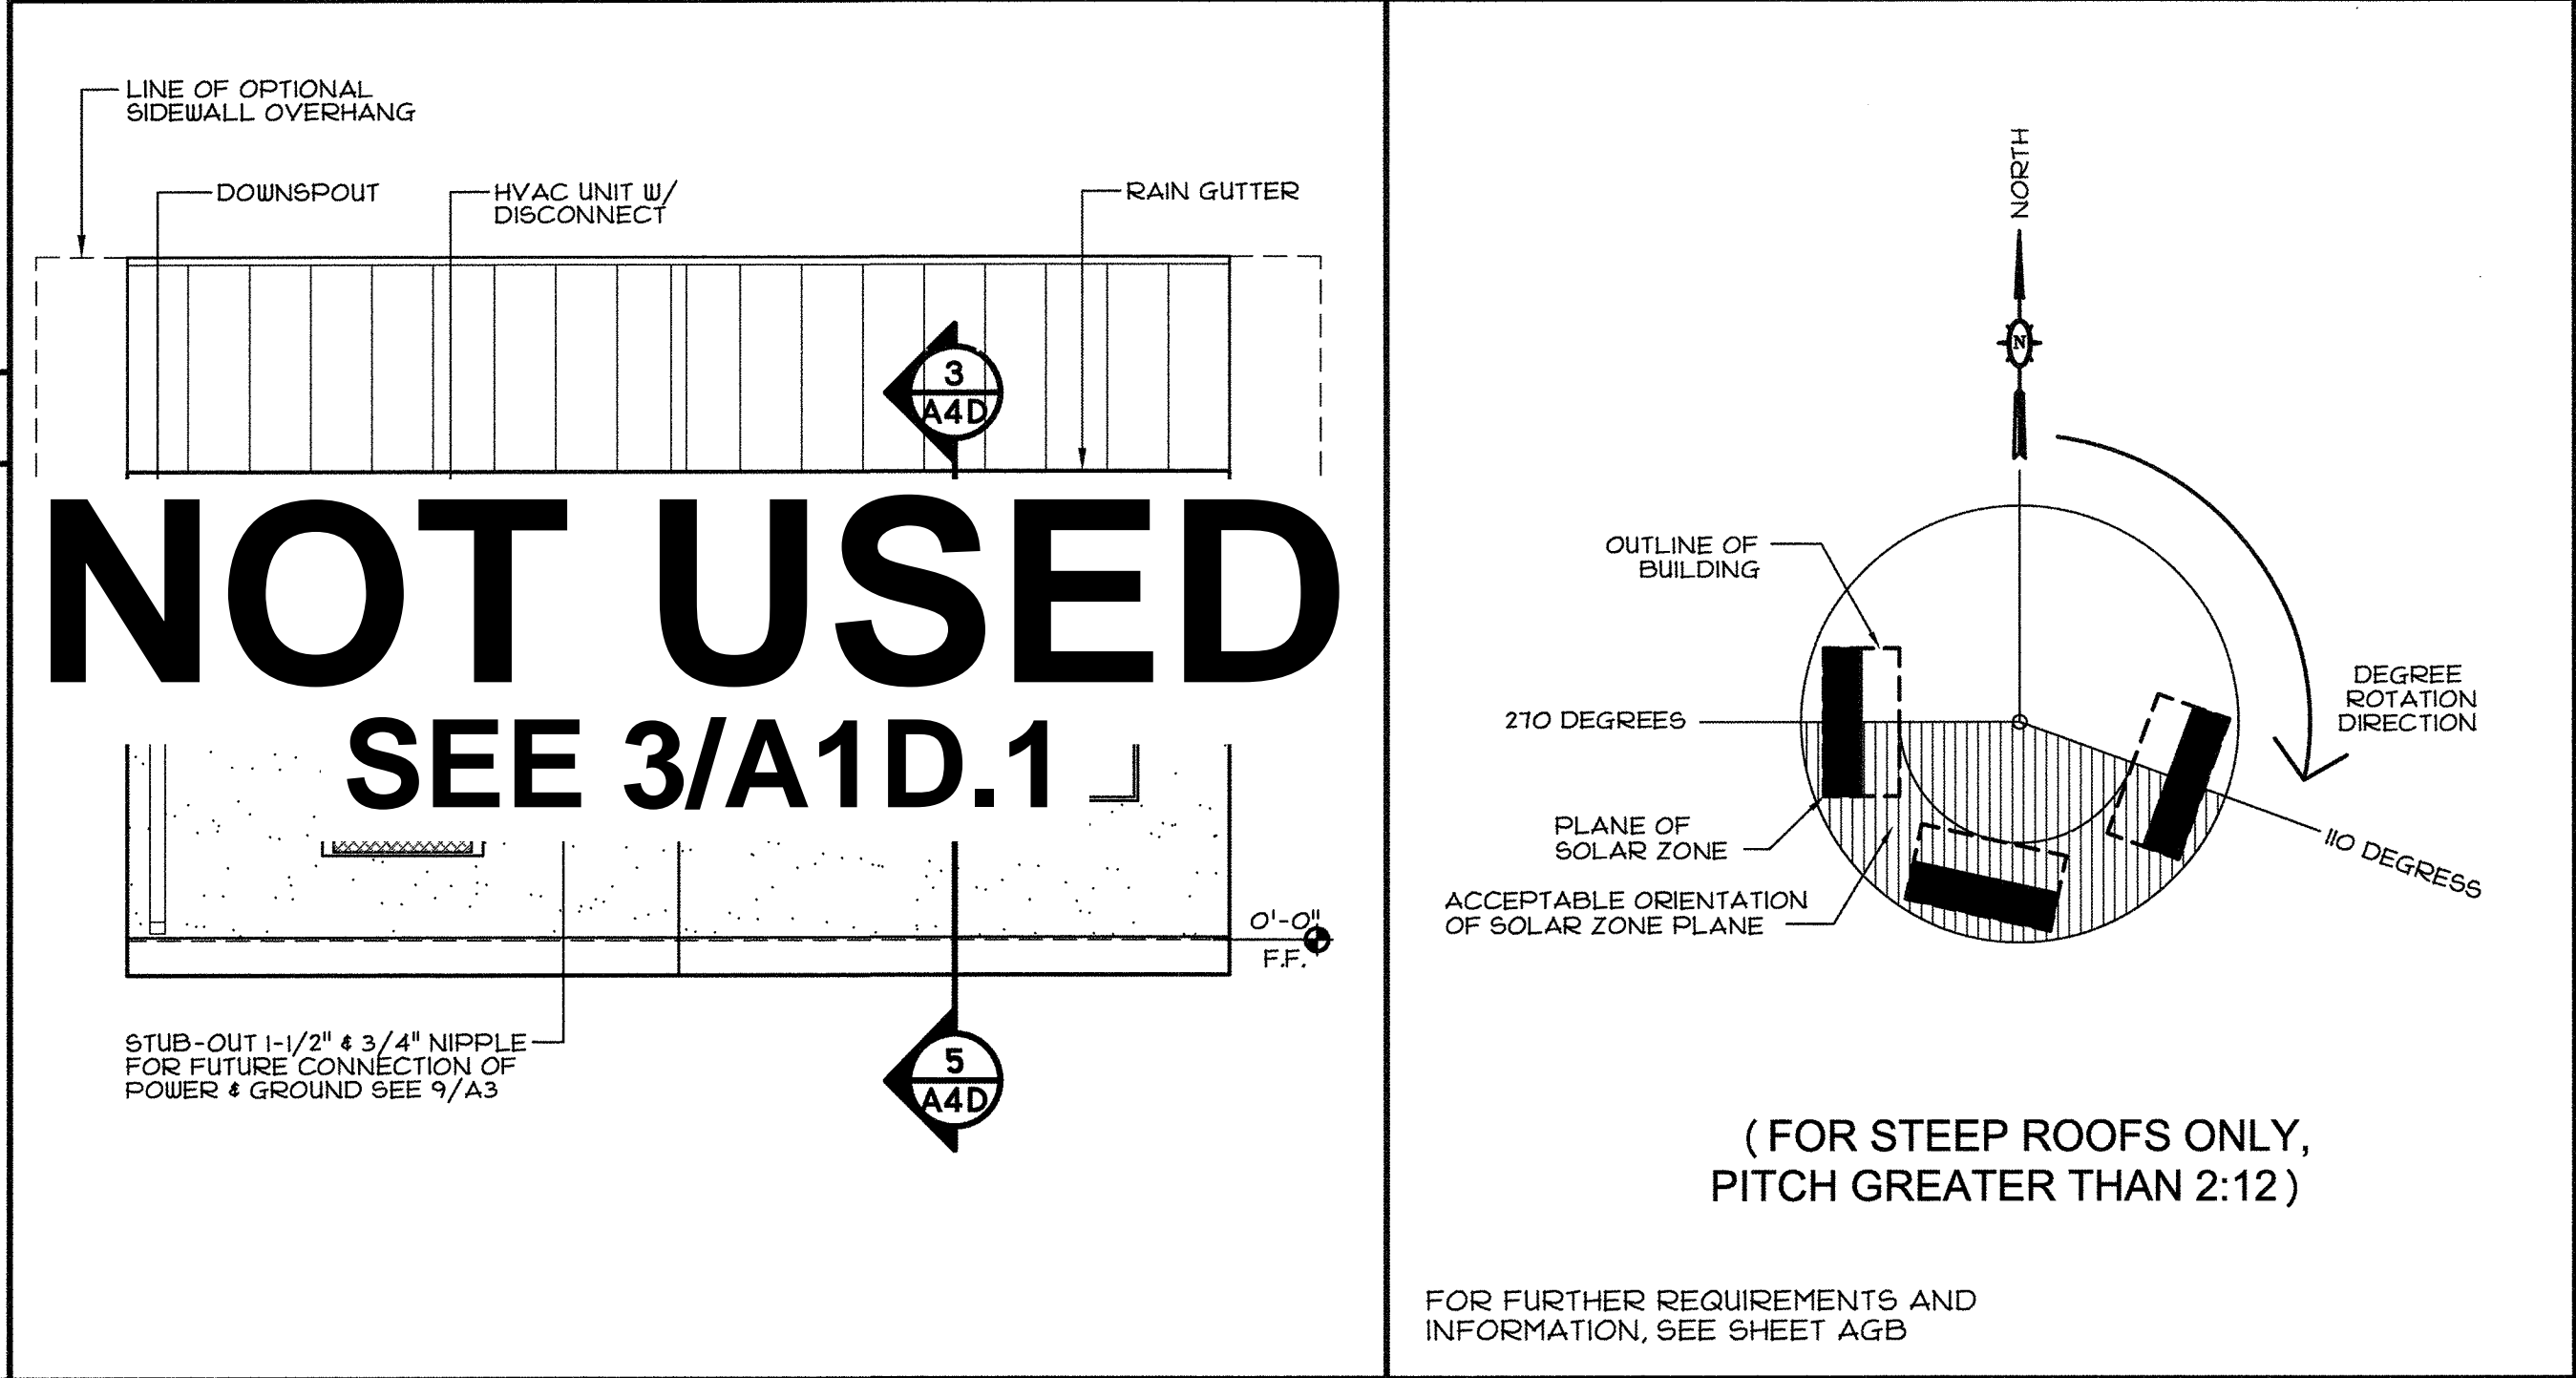

3 END WALL EXTERIOR ELEVATION  
SCALE: 1/4"=1'-0"

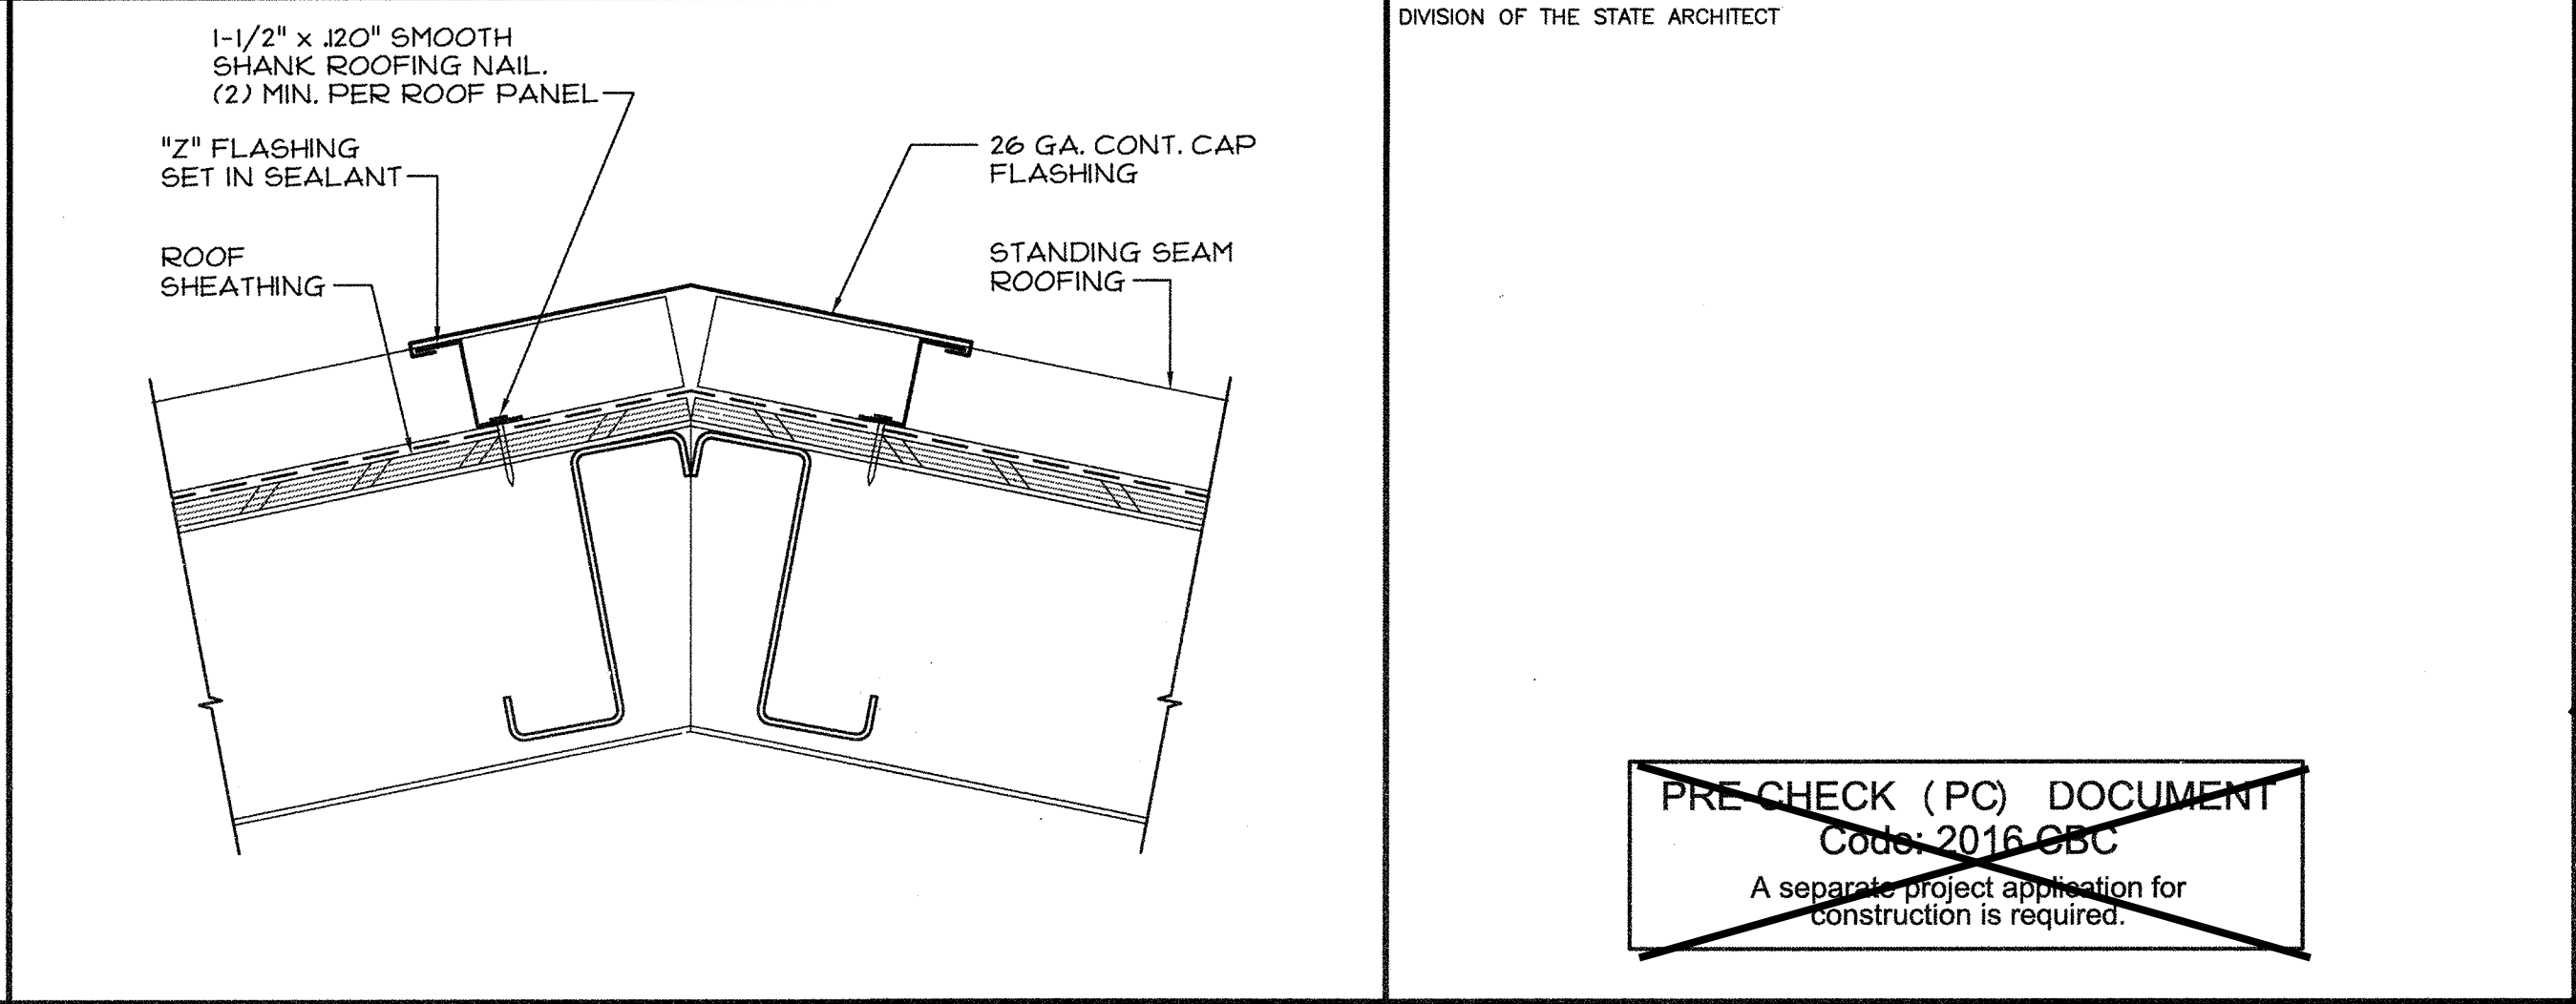

7 TYP. ROOF CAP DETAIL  
SCALE: 3/8"=1'-0"

IDENTIFICATION STAMP  
DIV. OF THE STATE ARCHITECT  
APP. 02-118017 INC.  
REVIEWED FOR  
SS ☐ FLS ☐ ACS ☐  
DATE: 04/10/2020

03/26/2020

REGISTERED PROFESSIONAL ENGINEER  
No. S2030  
STATE OF CALIFORNIA  
These drawings are preliminary  
and not for construction  
unless stamped & signed by  
the engineer of record.

ENVIROPLEX, INC.  
4777 E. CARPENTER ROAD STOCKTON, CA 95215, (209) 466-8000  
CESAR CHAVEZ HIGH SCHOOL - ATHLETIC FACILITY  
STOCKTON UNIFIED SCHOOL DISTRICT  
2929 WINDFLOWER LANE STOCKTON, CA 95212

VARIABLE PITCH ROOF PLAN,  
& EXTERIOR ELEVATIONS

REV / DATE: BY:

JOB No.:  
DRAWN BY:  
DATE:


IDENTIFICATION STAMP  
DIVISION OF THE STATE ARCHITECT  
02-118094  
ACCS FLS SS  
DATE 9-6-2018

PRE-CHECK (PC) DOCUMENT  
Code: 2016 OBC  
A separate project application for  
construction is required.

CONFIDENTIAL MATERIAL—THESE DOCUMENTS ARE THE PROPERTY OF AND ARE NOT TO BE REPRODUCED  
OR DISTRIBUTED WITHOUT FULL KNOWLEDGE AND WRITTEN CONSENT FROM ENVIROPLEX, INC.  
© COPYRIGHT ENVIROPLEX, INC. (ALL DRAWINGS PREPARED BY ENVIROPLEX, INC.)

A1D



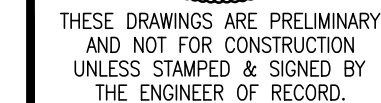



**ENVIROPLEX, INC.**  
 4777 E. CARPENTER ROAD STOCKTON, CA. 95215, (209) 466-8000  
**CESAR CHAVEZ HIGH SCHOOL - ATHLETIC FACILITY**  
 STOCKTON UNIFIED SCHOOL DISTRICT  
 2020 WINDEL COWER LANE STOCKTON CA 95212

## EXTERIOR ELEVATIONS


|             |            |     |
|-------------|------------|-----|
| REV / DATE: |            | BY: |
|             |            |     |
|             |            |     |
|             |            |     |
|             |            |     |
| JOB No.:    | 19-000     |     |
| DRAWN BY:   | RS         |     |
| DATE:       | 12/17/2019 |     |

CONFIDENTIAL MATERIAL—THESE DOCUMENTS ARE THE PROPERTY OF AND ARE NOT TO BE REPRODUCED OR DISTRIBUTED WITHOUT FULL KNOWLEDGE AND WRITTEN CONSENT FROM ENVIROPLEX, INC.  
© COPYRIGHT ENVIROPLEX, INC. (ALL DRAWINGS PREPARED BY ENVIROPLEX, INC.)


A1D.1

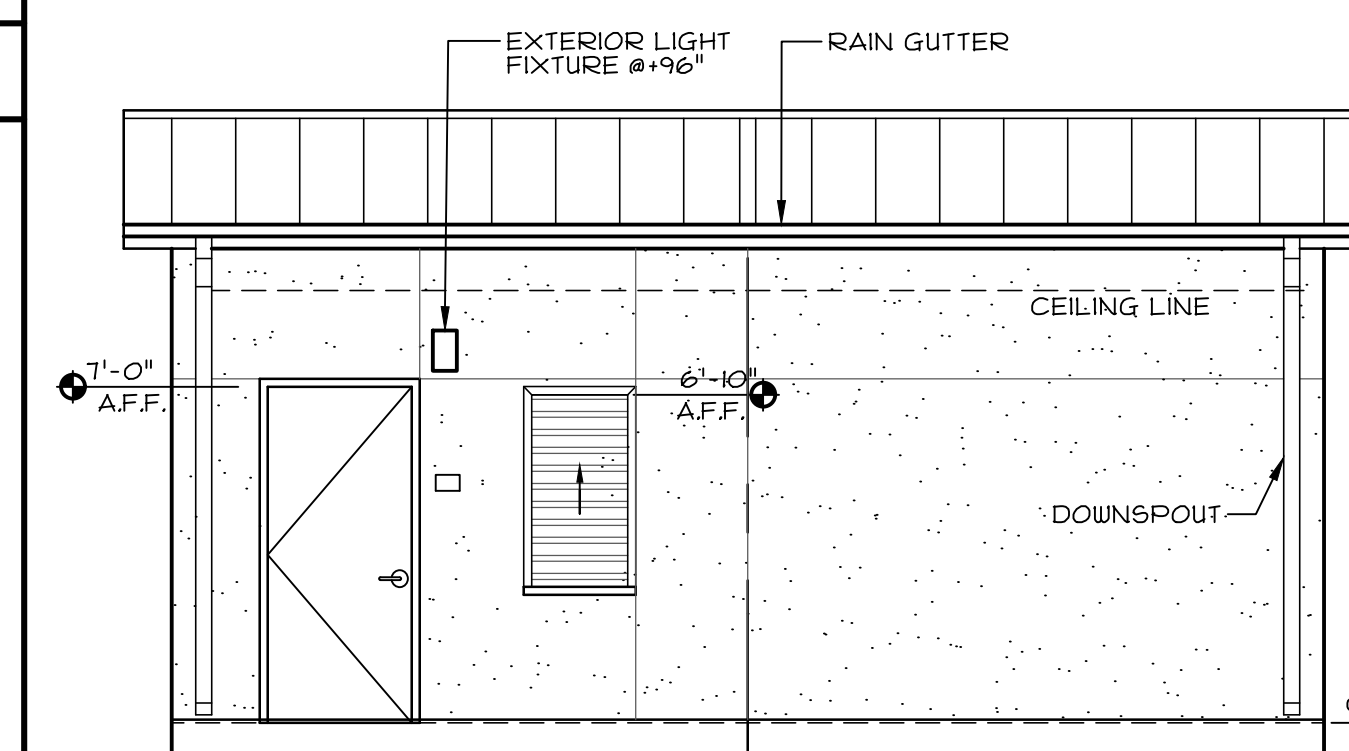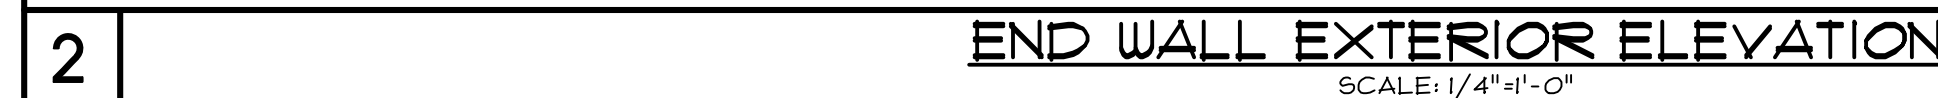

END WALL EXTERIOR ELEVATION  
SCALE: 1/4"=1'-0"

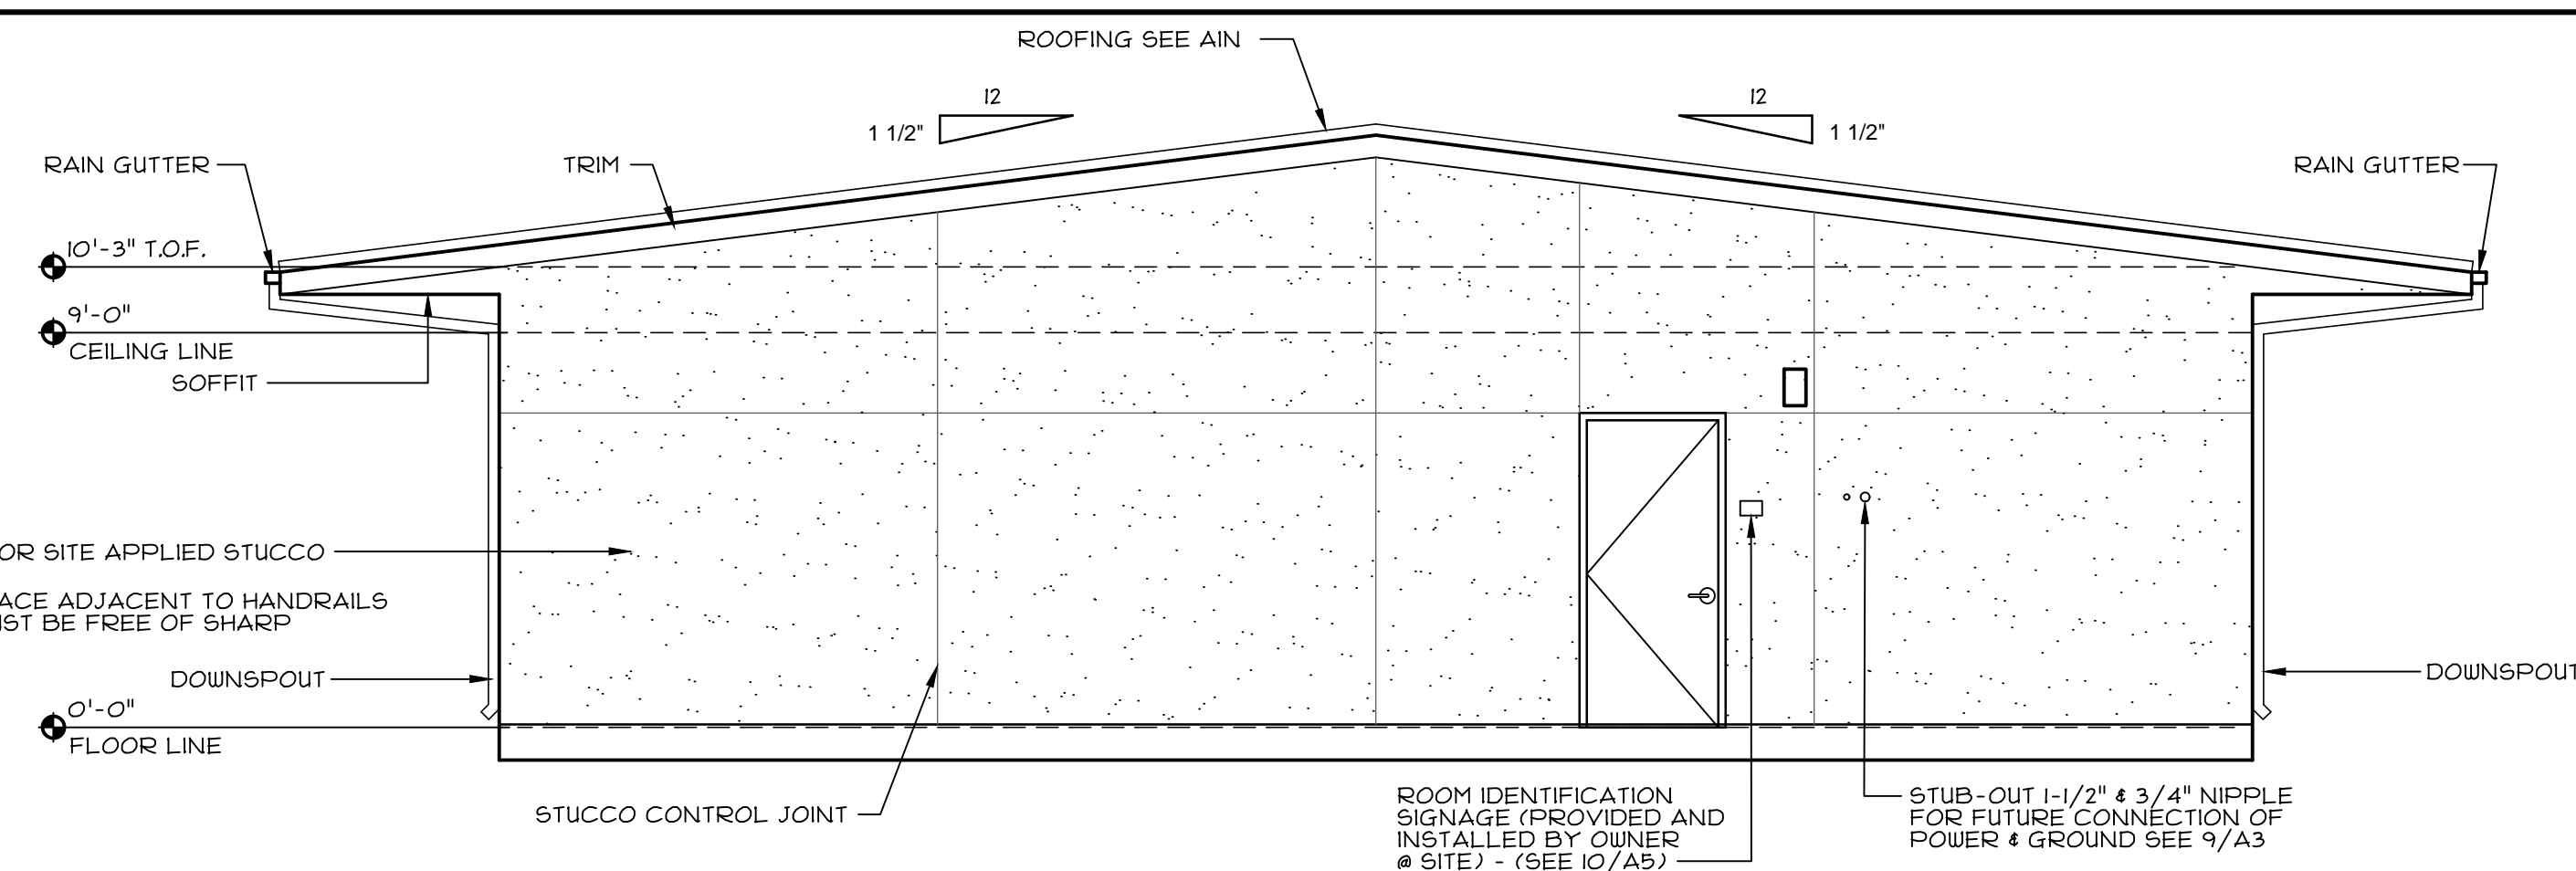


SIDE WALL EXTERIOR ELEVATION  
SCALE: 1/4"=1'-0"

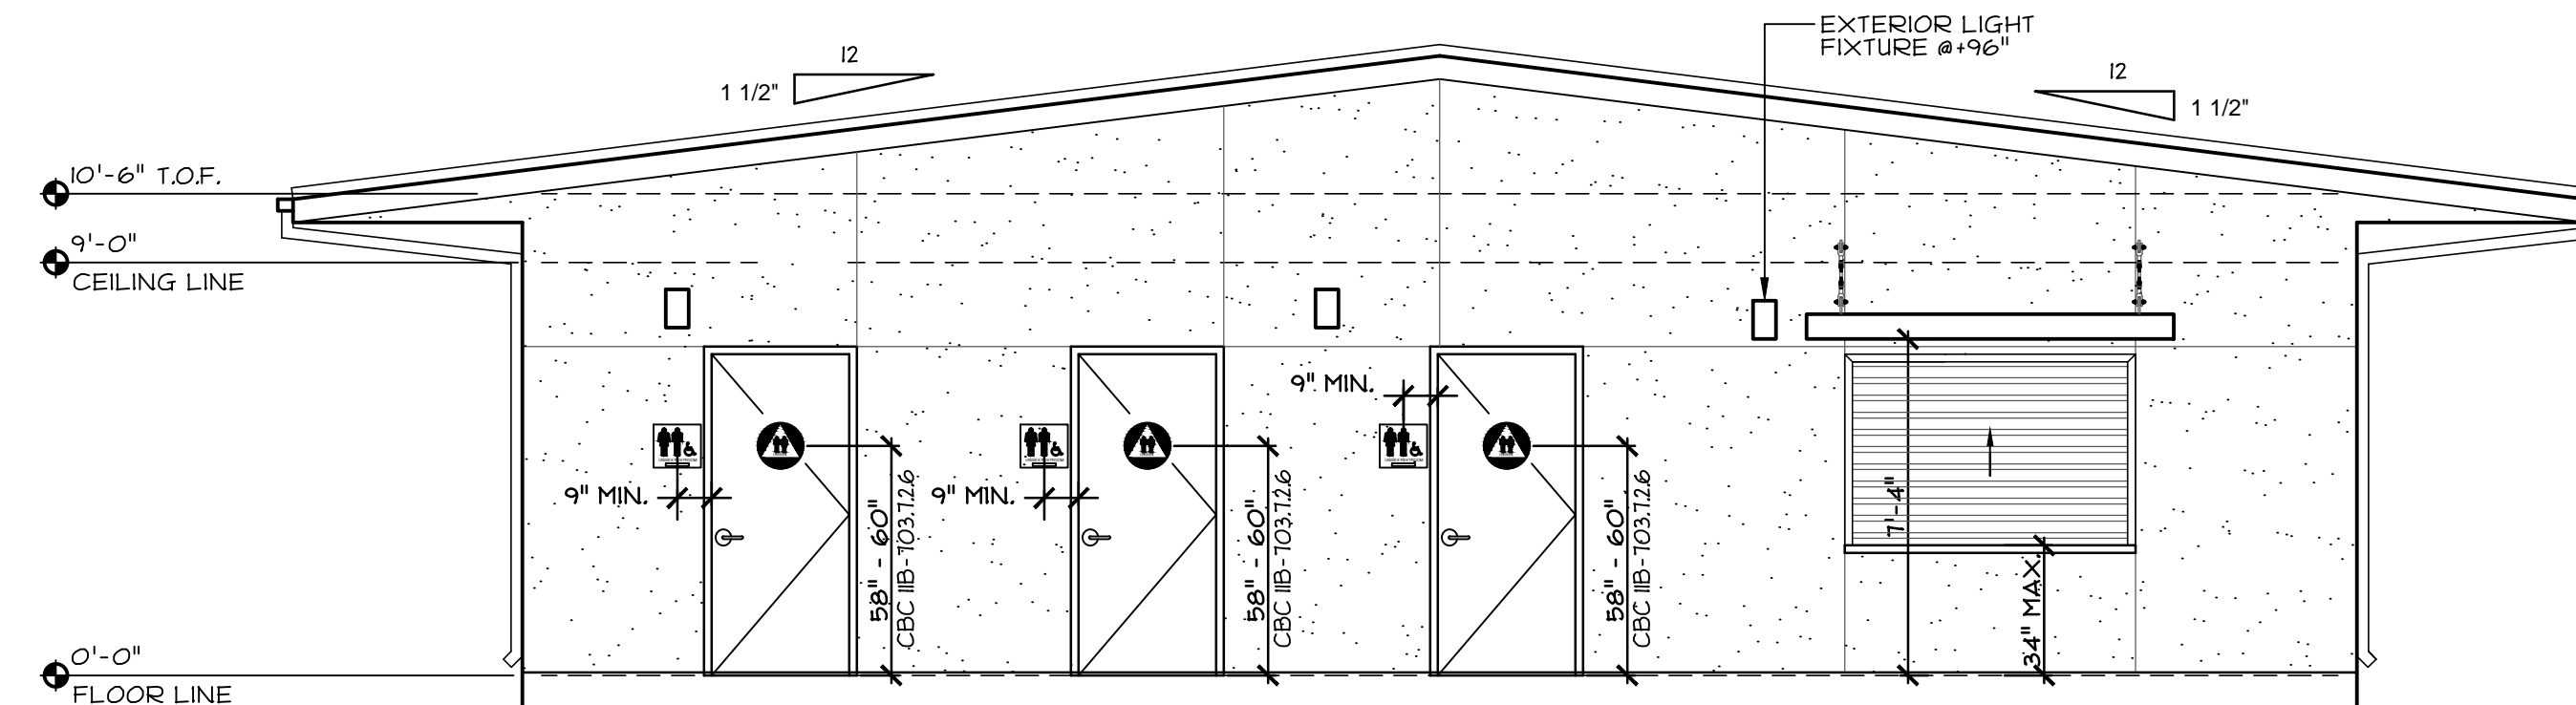


**SIDE WALL EXTERIOR ELEVATION**  
SCALE: 1/4"=1'-0"




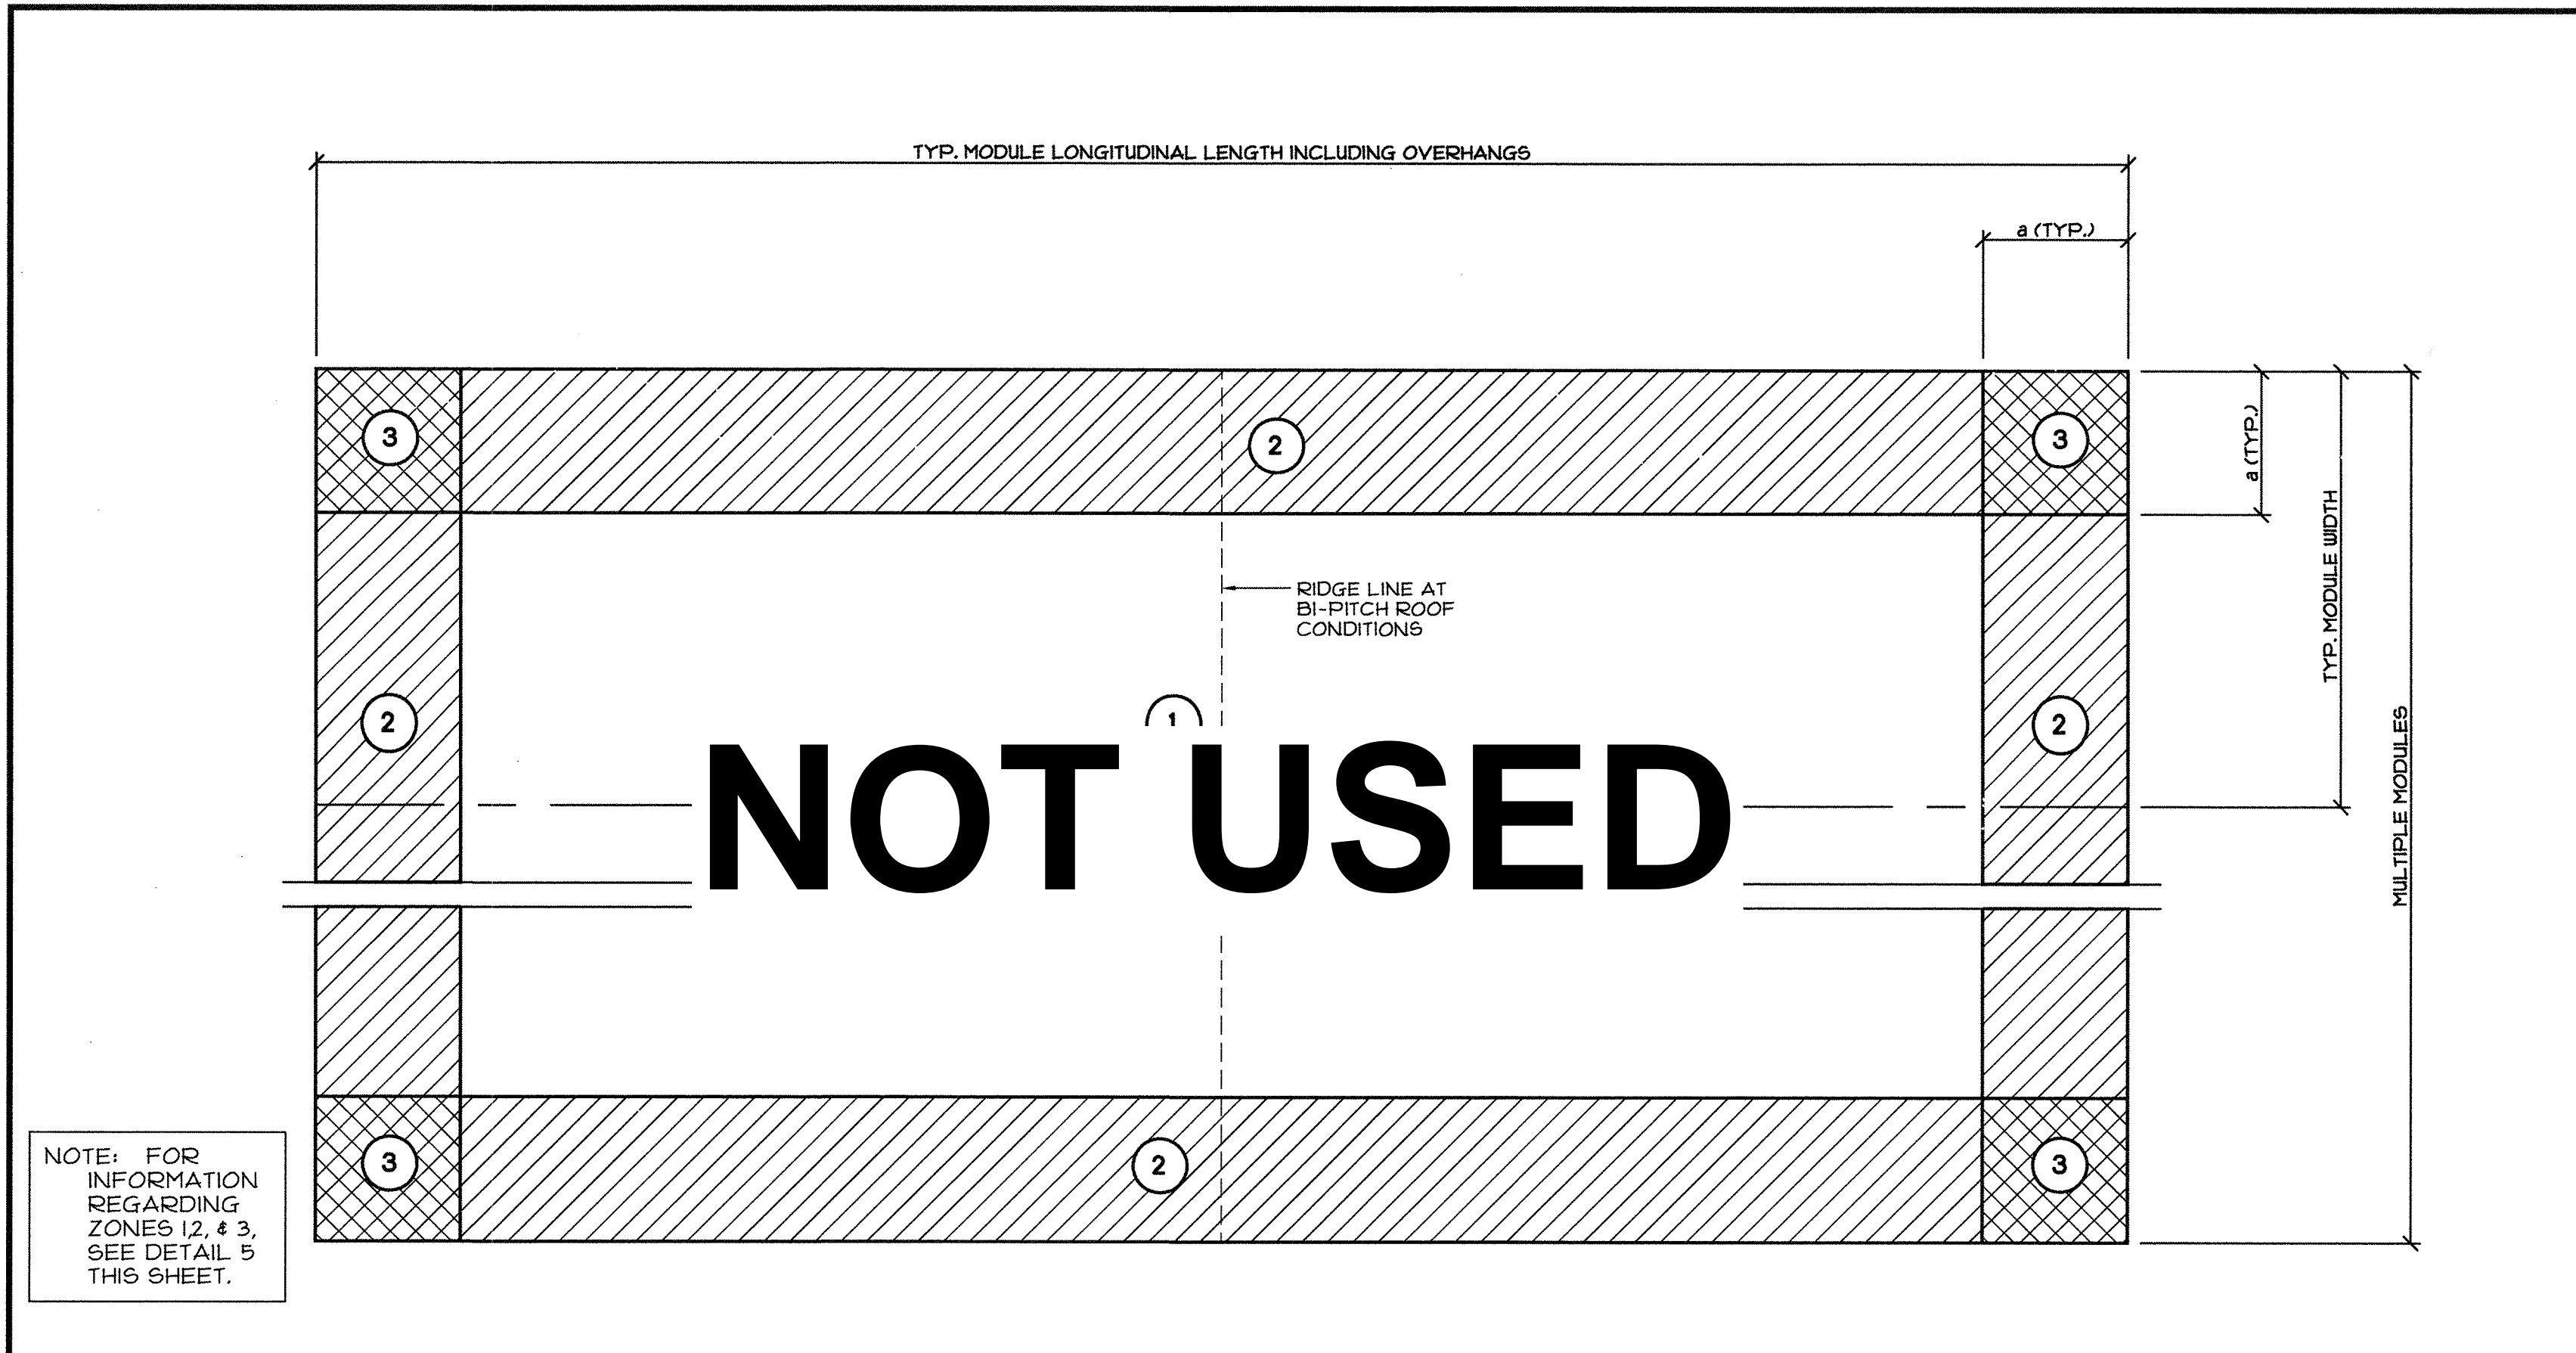

1A FOR PV DESIGNER REF. ONLY - GENERIC WIND PRESSURE MAP EXAMPLE "SHED" OR "BIPITCHED" ROOF

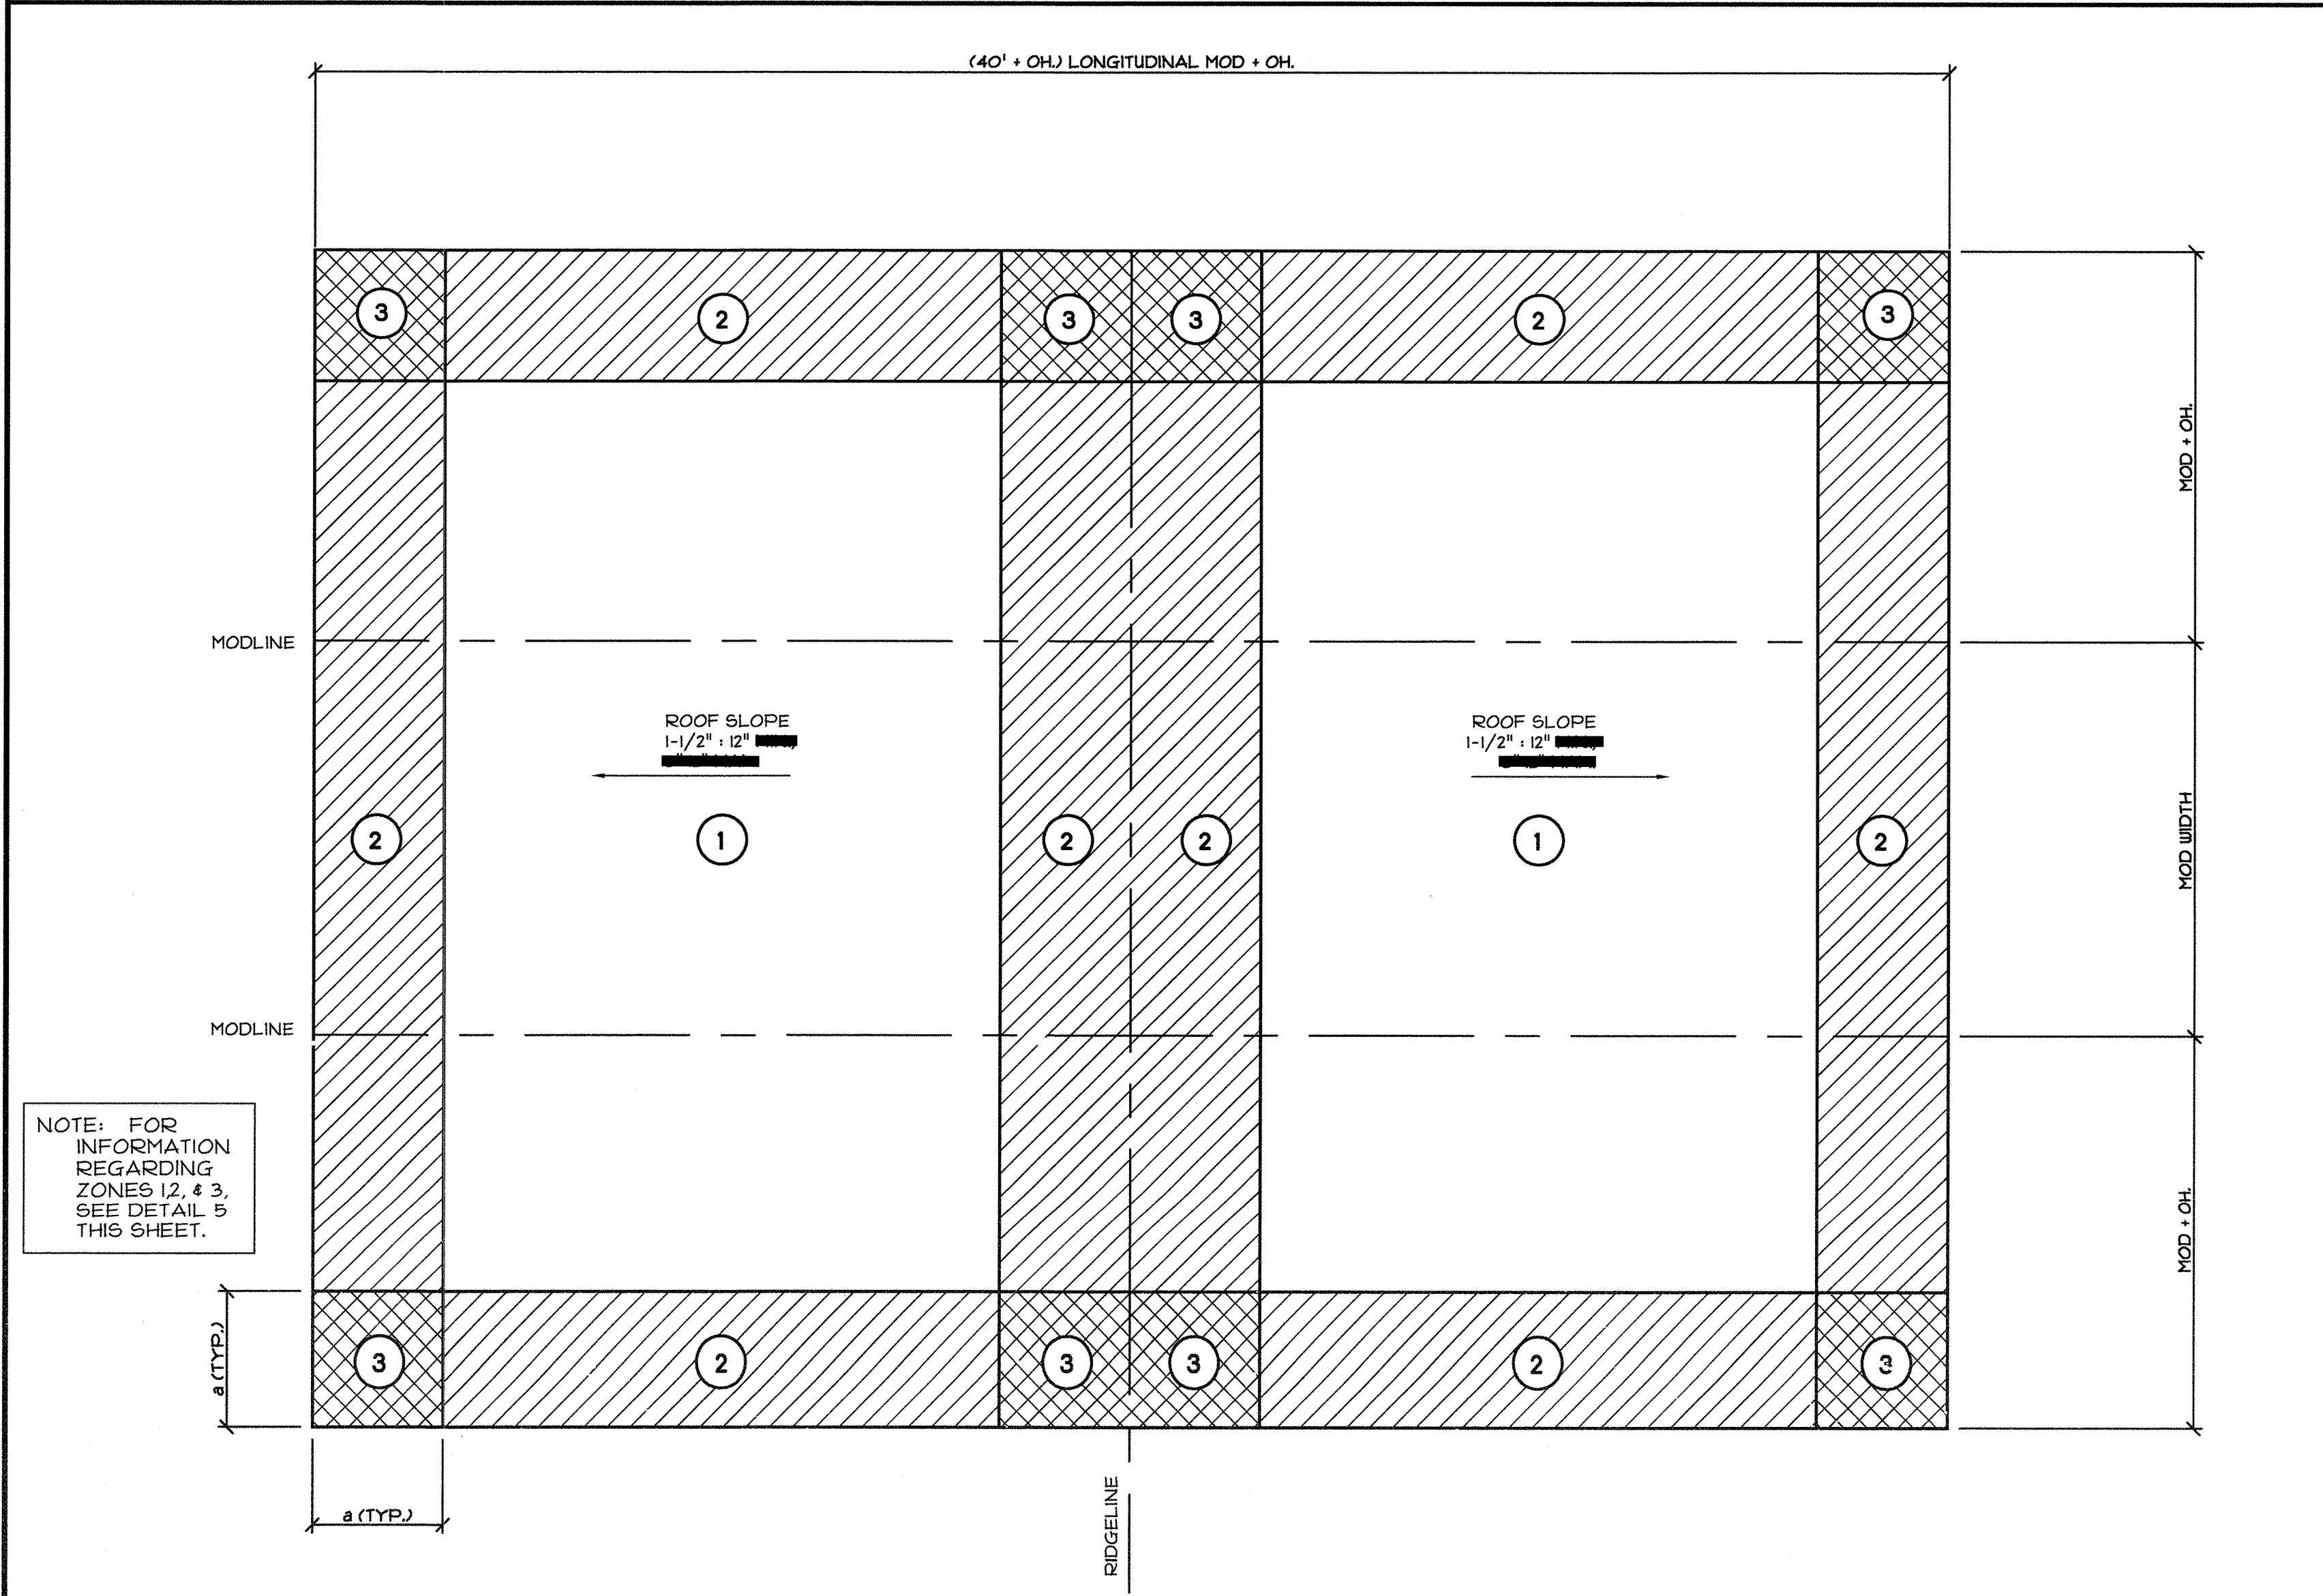

1B FOR PV DESIGNER REF. ONLY - GENERIC WIND PRESSURE MAP EXAMPLE "VARIABLE-PITCHED" ROOF

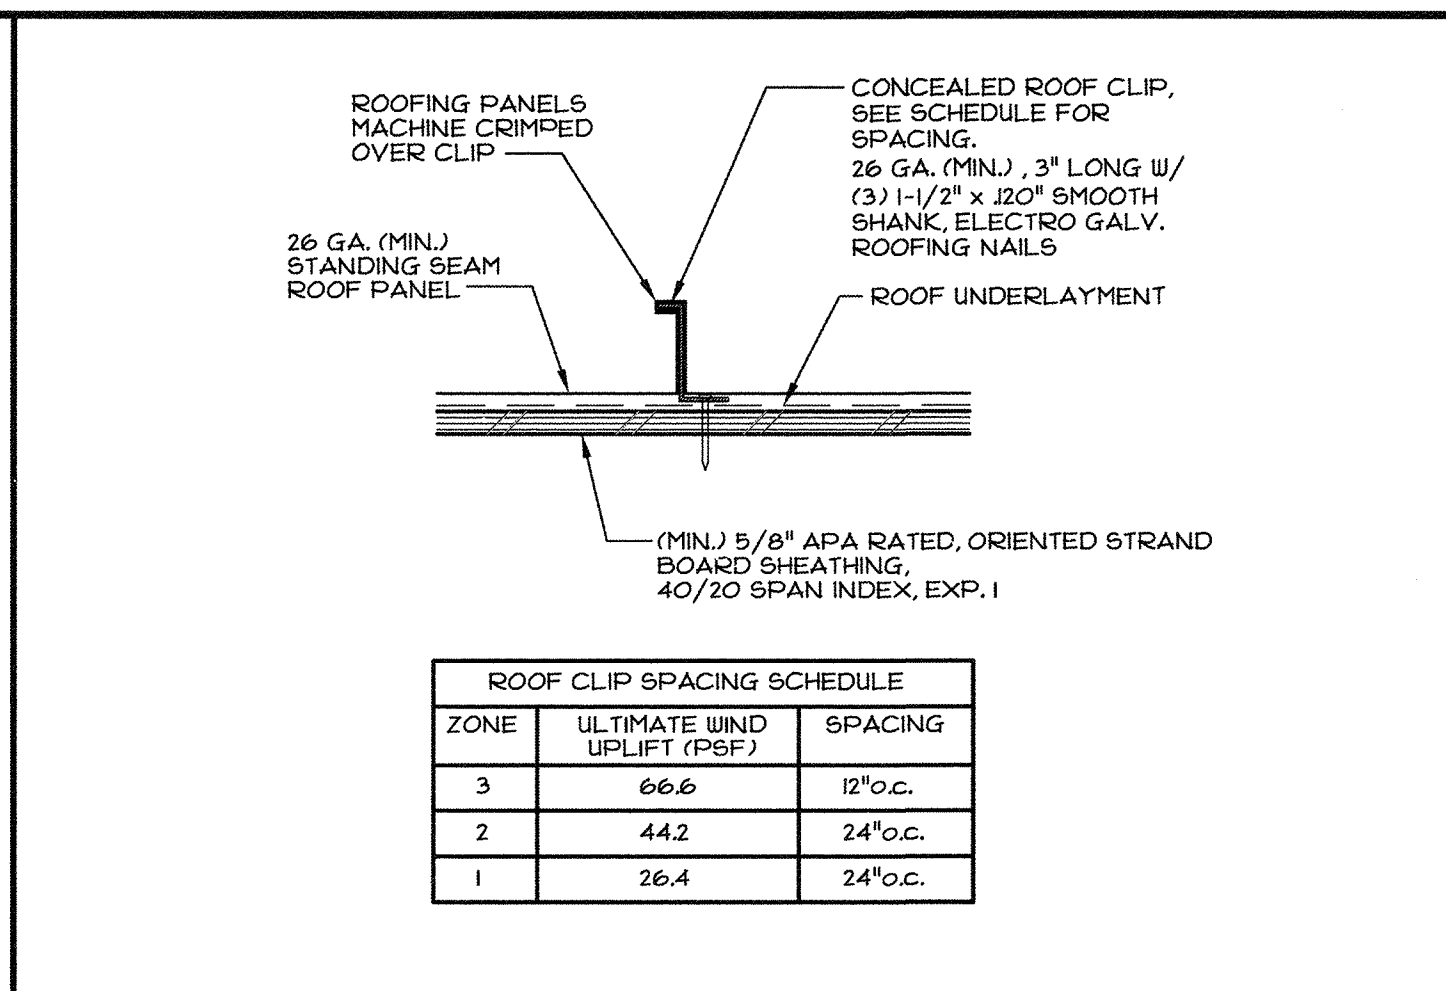


2 TYP. ROOFING ATTACHMENT  
SCALE: 3"=1'-0"

a = DIMENSION PER ASCE 7-10  
10% OF LEAST HORIZONTAL DIMENSION OR  
0.4h\*, WHICHEVER IS SMALLER, BUT NOT  
LESS THAN EITHER 4% OF LEAST HORIZONTAL  
DIMENSION OR 3'.

\*h = MEAN ROOF HEIGHT IN FEET, EXCEPT  
THAT EAVE HEIGHT SHALL BE USED FOR  
ANGLES < 10°

1 2 3 INDICATE DESIGN WIND PRESSURE  
ZONES PER ASCE 7-10 FIGURE 30.5-1, SEE  
SCHEDULE 2, THIS SHEET FOR WIND PRESSURES IN  
EACH ZONE.

5 NOTES

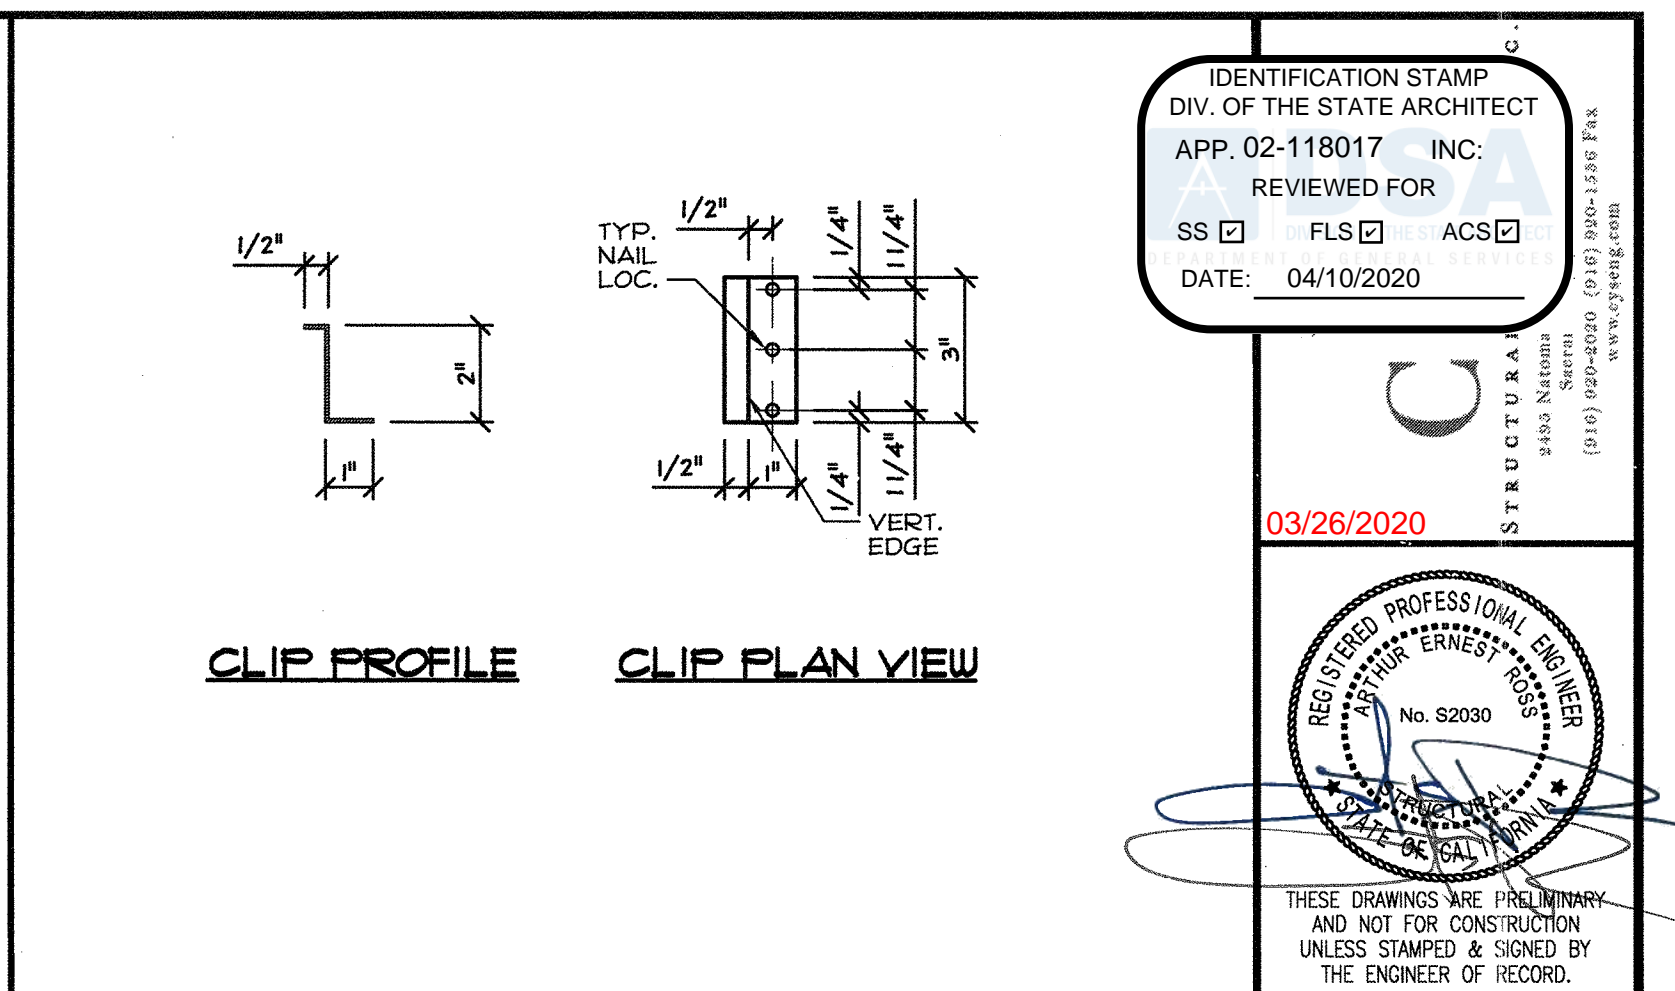

3 TYP. ROOFING CLIP  
SCALE: 3"=1'-0"

- The roof clip uplift capacity is derived from testing the set up to failure rather than calculations. The roof clip assembly test results are per Wallace Kuhl, WKA No. 11228.01. The average maximum test load for S-5 clips installed directly over roof clips was 540#. The average maximum test load for S-5 clips installed between roof clips was 520#. Therefore, allowable uplift per clip is 520#/(S.F.=3.0)=173#, 3 is the safety factor per DSA IR 16-8.
- The wind pressures for each site-specific project are to be determined by the PV designer based on the site-specific basic wind speed and wind exposure category.
- Roof clip type and spacing shown in detail 2 & 3/A1R is standard. The PV designer shall design the PV system within the capacity of the standard clip/spacing.
- Standard roof clip spacing shall be verified by the PV designer to be adequate for the PV design & site-specific project wind zone pressures.
- Refer to sheet AGB for solar ready requirements.

4 NOTES (FUTURE PV DESIGN)  
SCALE: 3"=1'-0"

DIVISION OF THE STATE ARCHITECT

PRE CHECK (PC) DOCUMENT  
Code: 2016 OBC  
A separate project application for construction is required.

IDENTIFICATION STAMP  
DIV. OF THE STATE ARCHITECT  
APP. 02-118017 INC.  
REVIEWED FOR  
SS ☐ FLS ☐ ACS ☐  
DATE: 04/10/2020

ENVIROPLEX, INC.  
4777 E. CARPENTER ROAD STOCKTON, CA 95215, (209) 466-8000  
CESAR CHAVEZ HIGH SCHOOL - ATHLETIC FACILITY  
STOCKTON UNIFIED SCHOOL DISTRICT  
2929 WINDFLOWER LANE STOCKTON, CA 95212

ROOFING ATTACHMENT

REV / DATE: BY:








JOB No.:  
DRAWN BY:  
DATE:

IDENTIFICATION STAMP  
DIV. OF THE STATE ARCHITECT  
APP. 02-118094  
AC 2016 FLS 2016 OBC  
DATE: 9-6-2016

CONFIDENTIAL MATERIAL—THESE DOCUMENTS ARE THE PROPERTY OF AND ARE NOT TO BE REPRODUCED OR DISTRIBUTED WITHOUT FULL KNOWLEDGE AND WRITTEN CONSENT FROM ENVIROPLEX, INC.  
© COPYRIGHT ENVIROPLEX, INC. (ALL DRAWINGS PREPARED BY ENVIROPLEX, INC.)

A1R



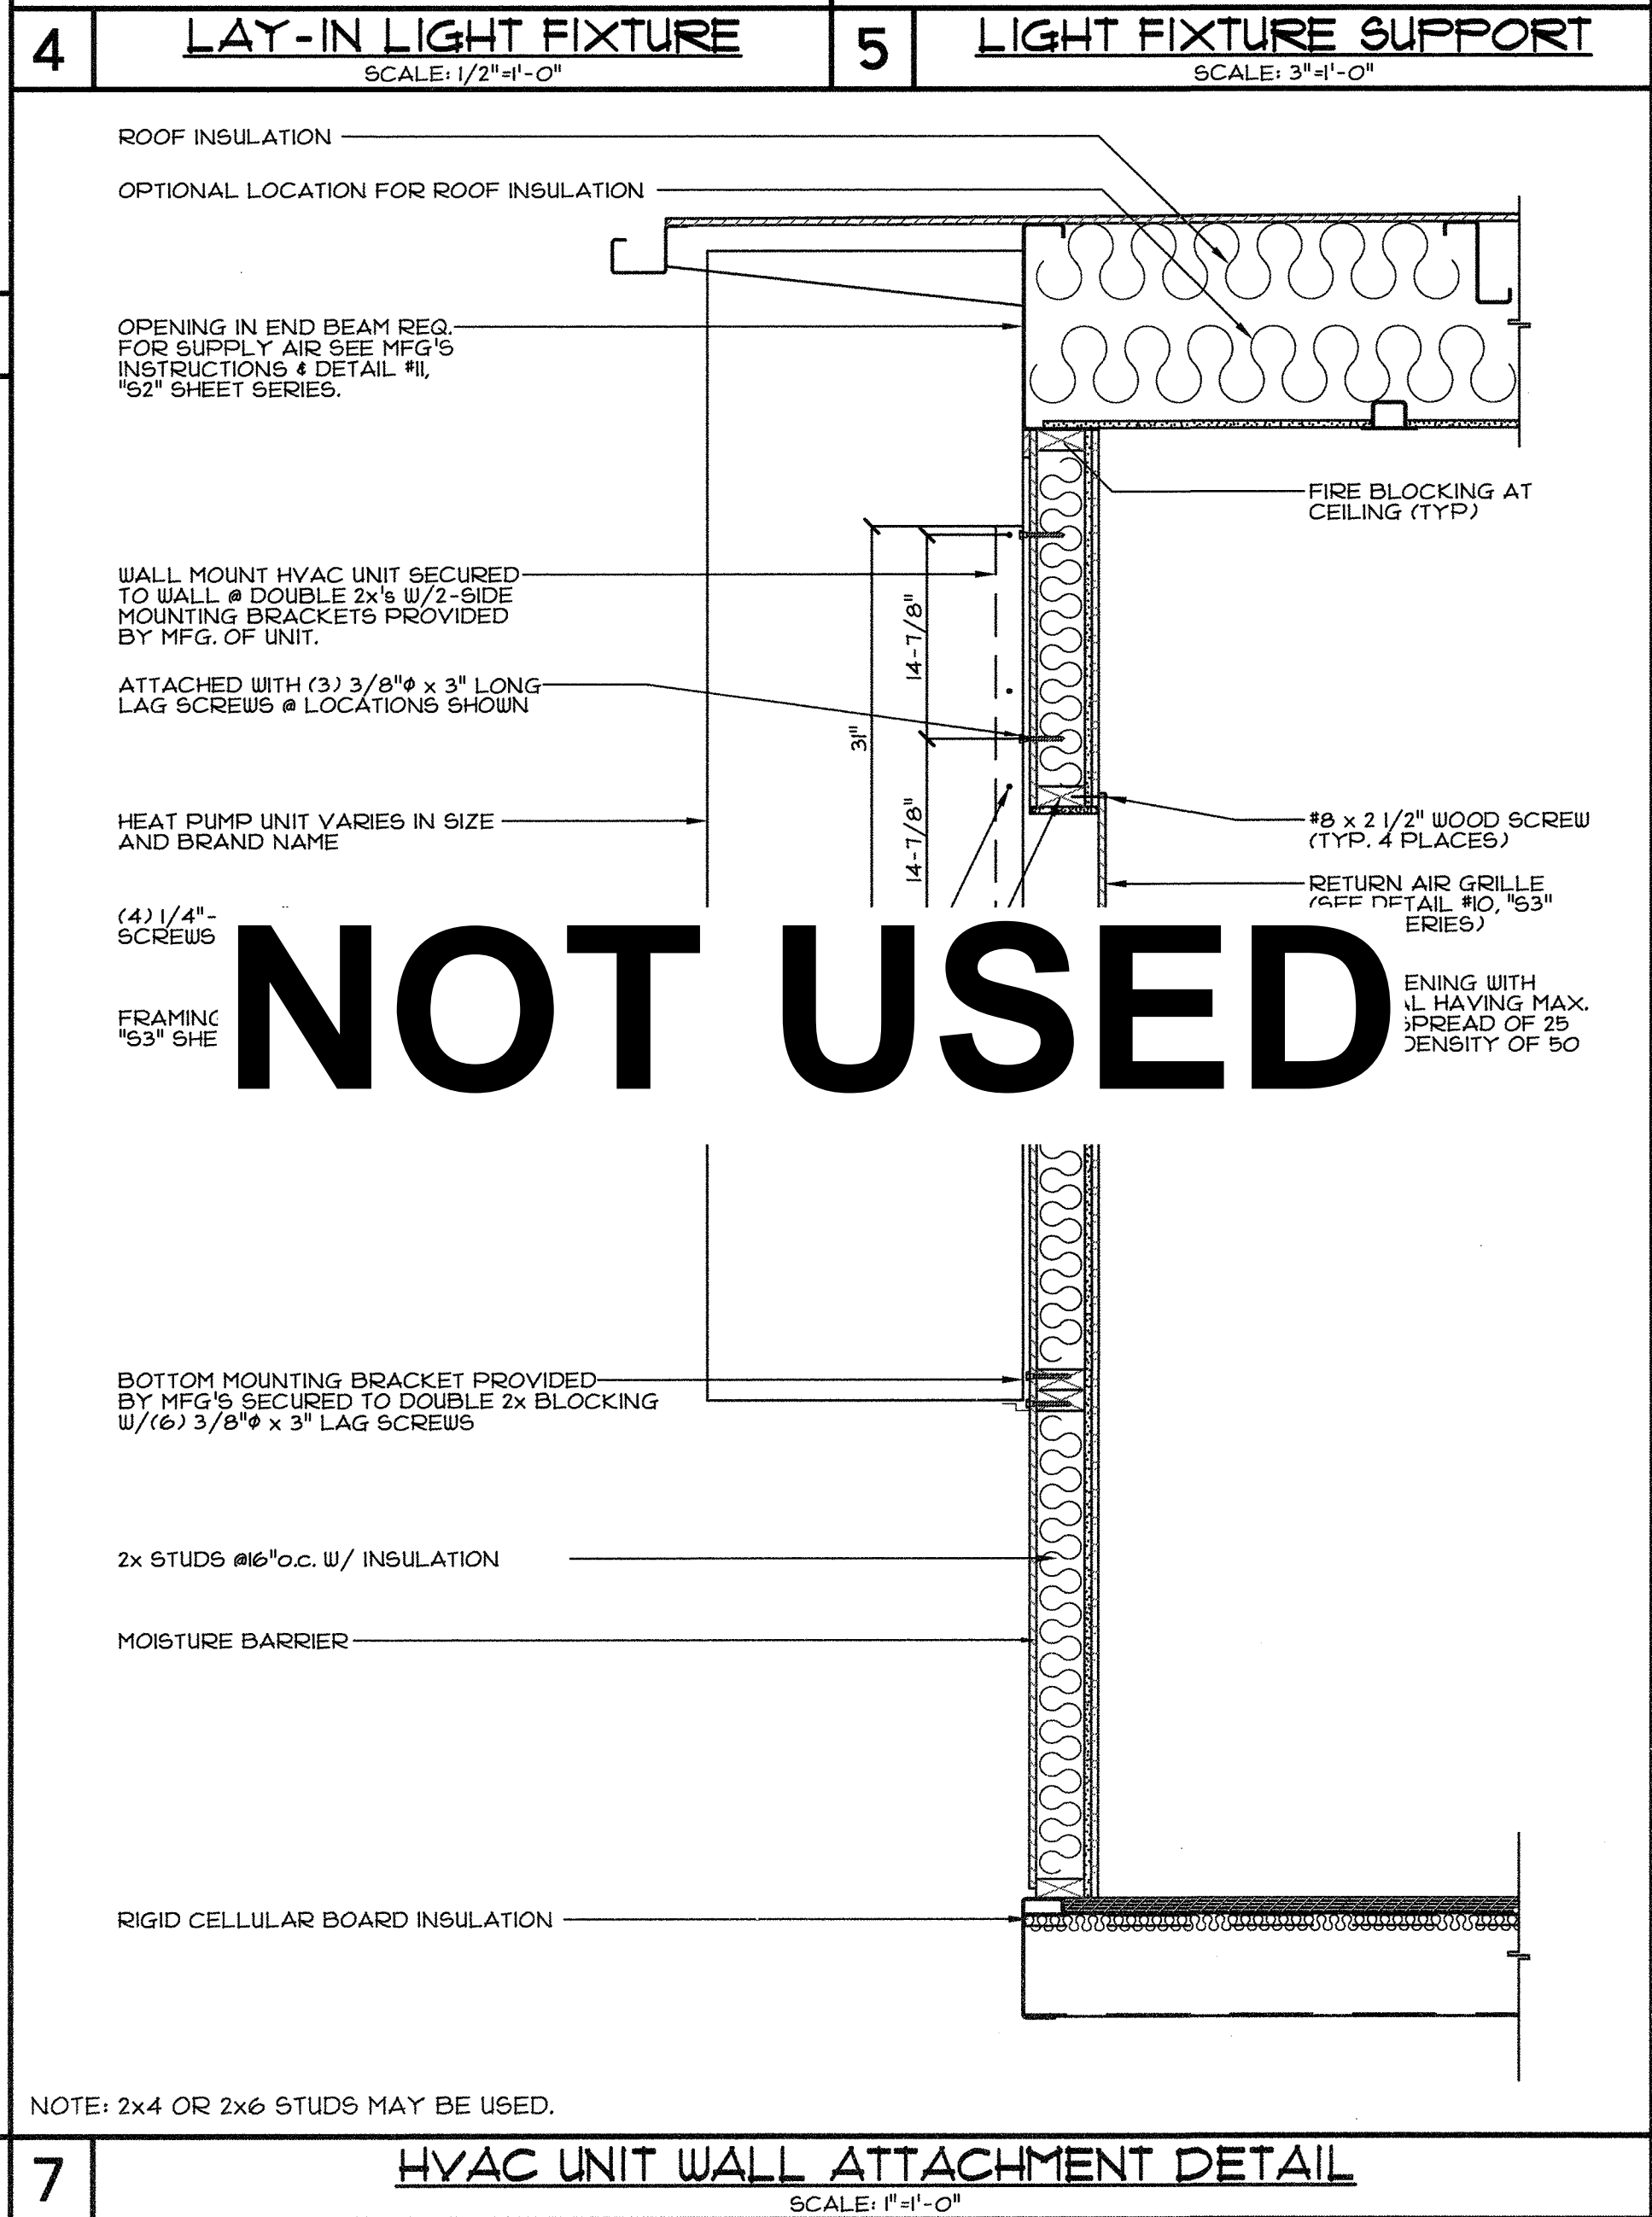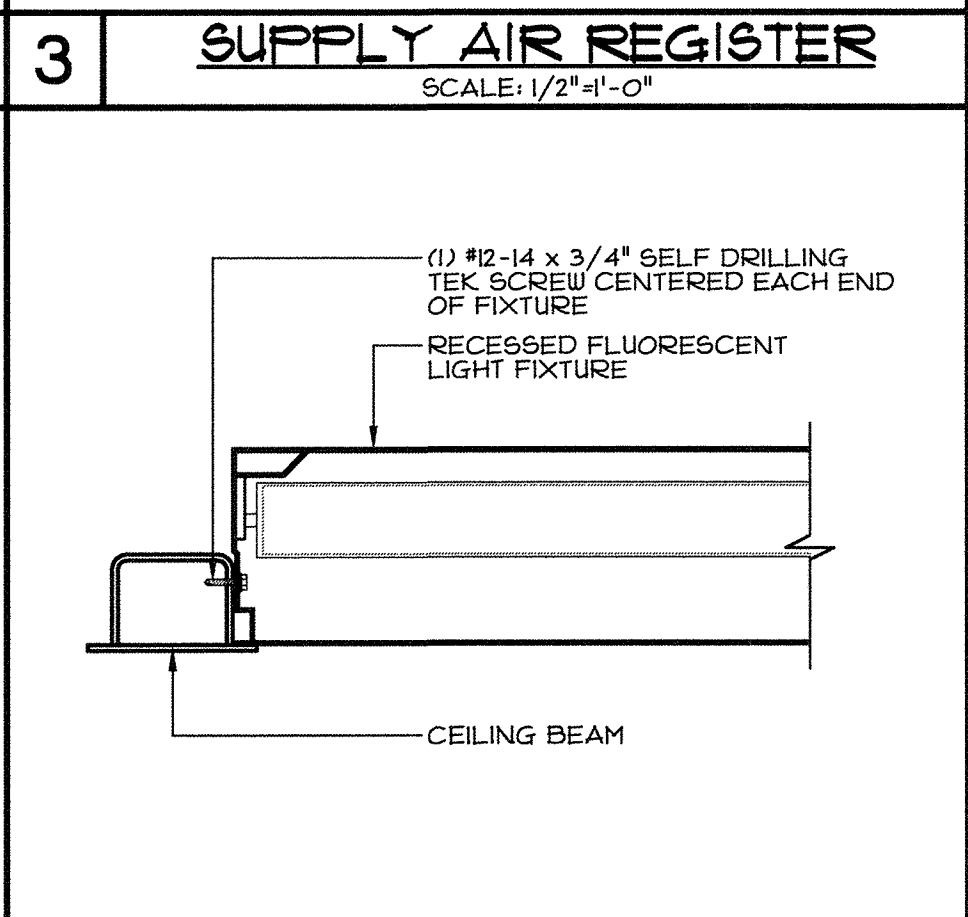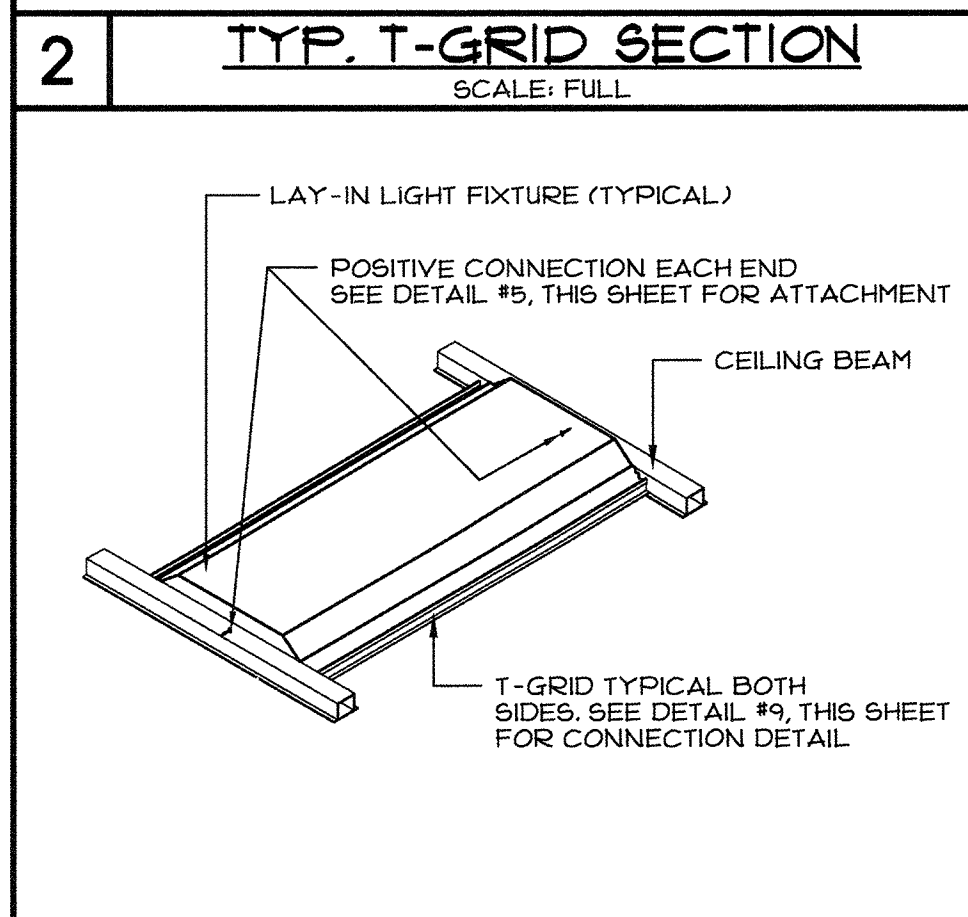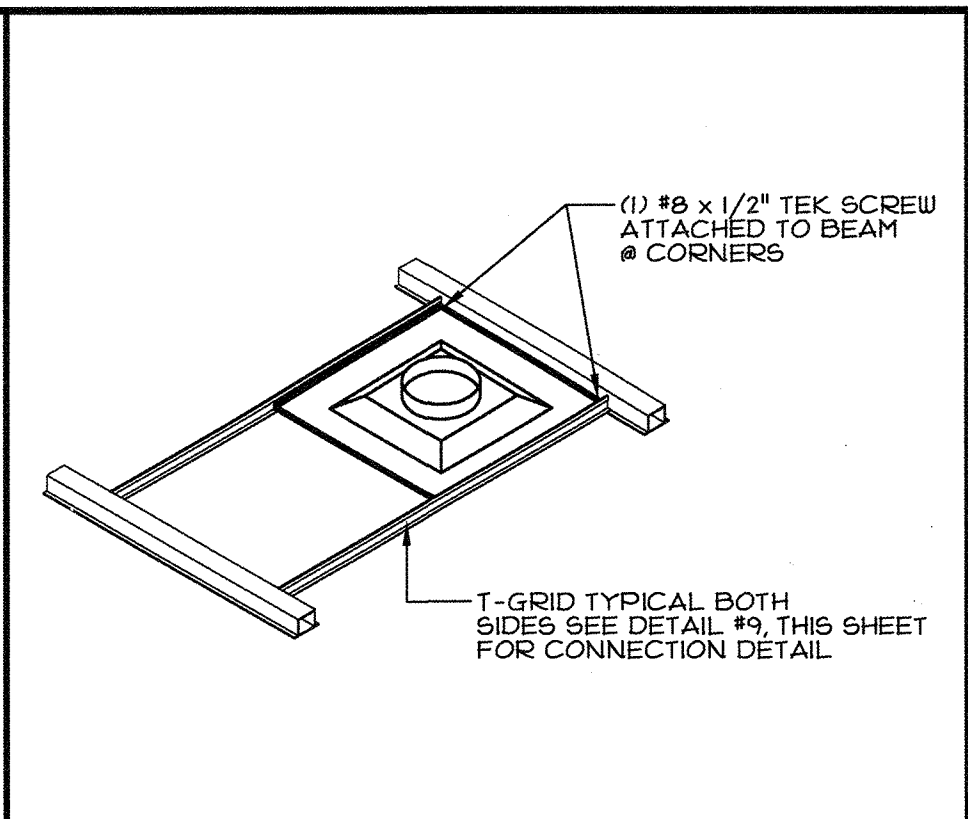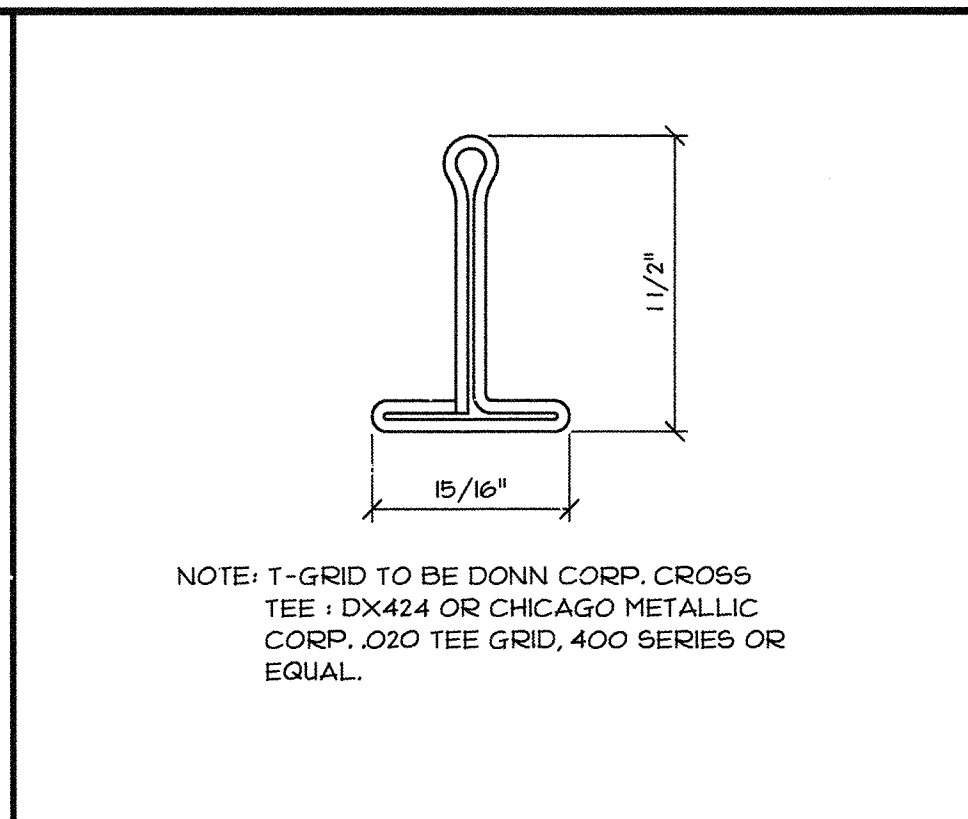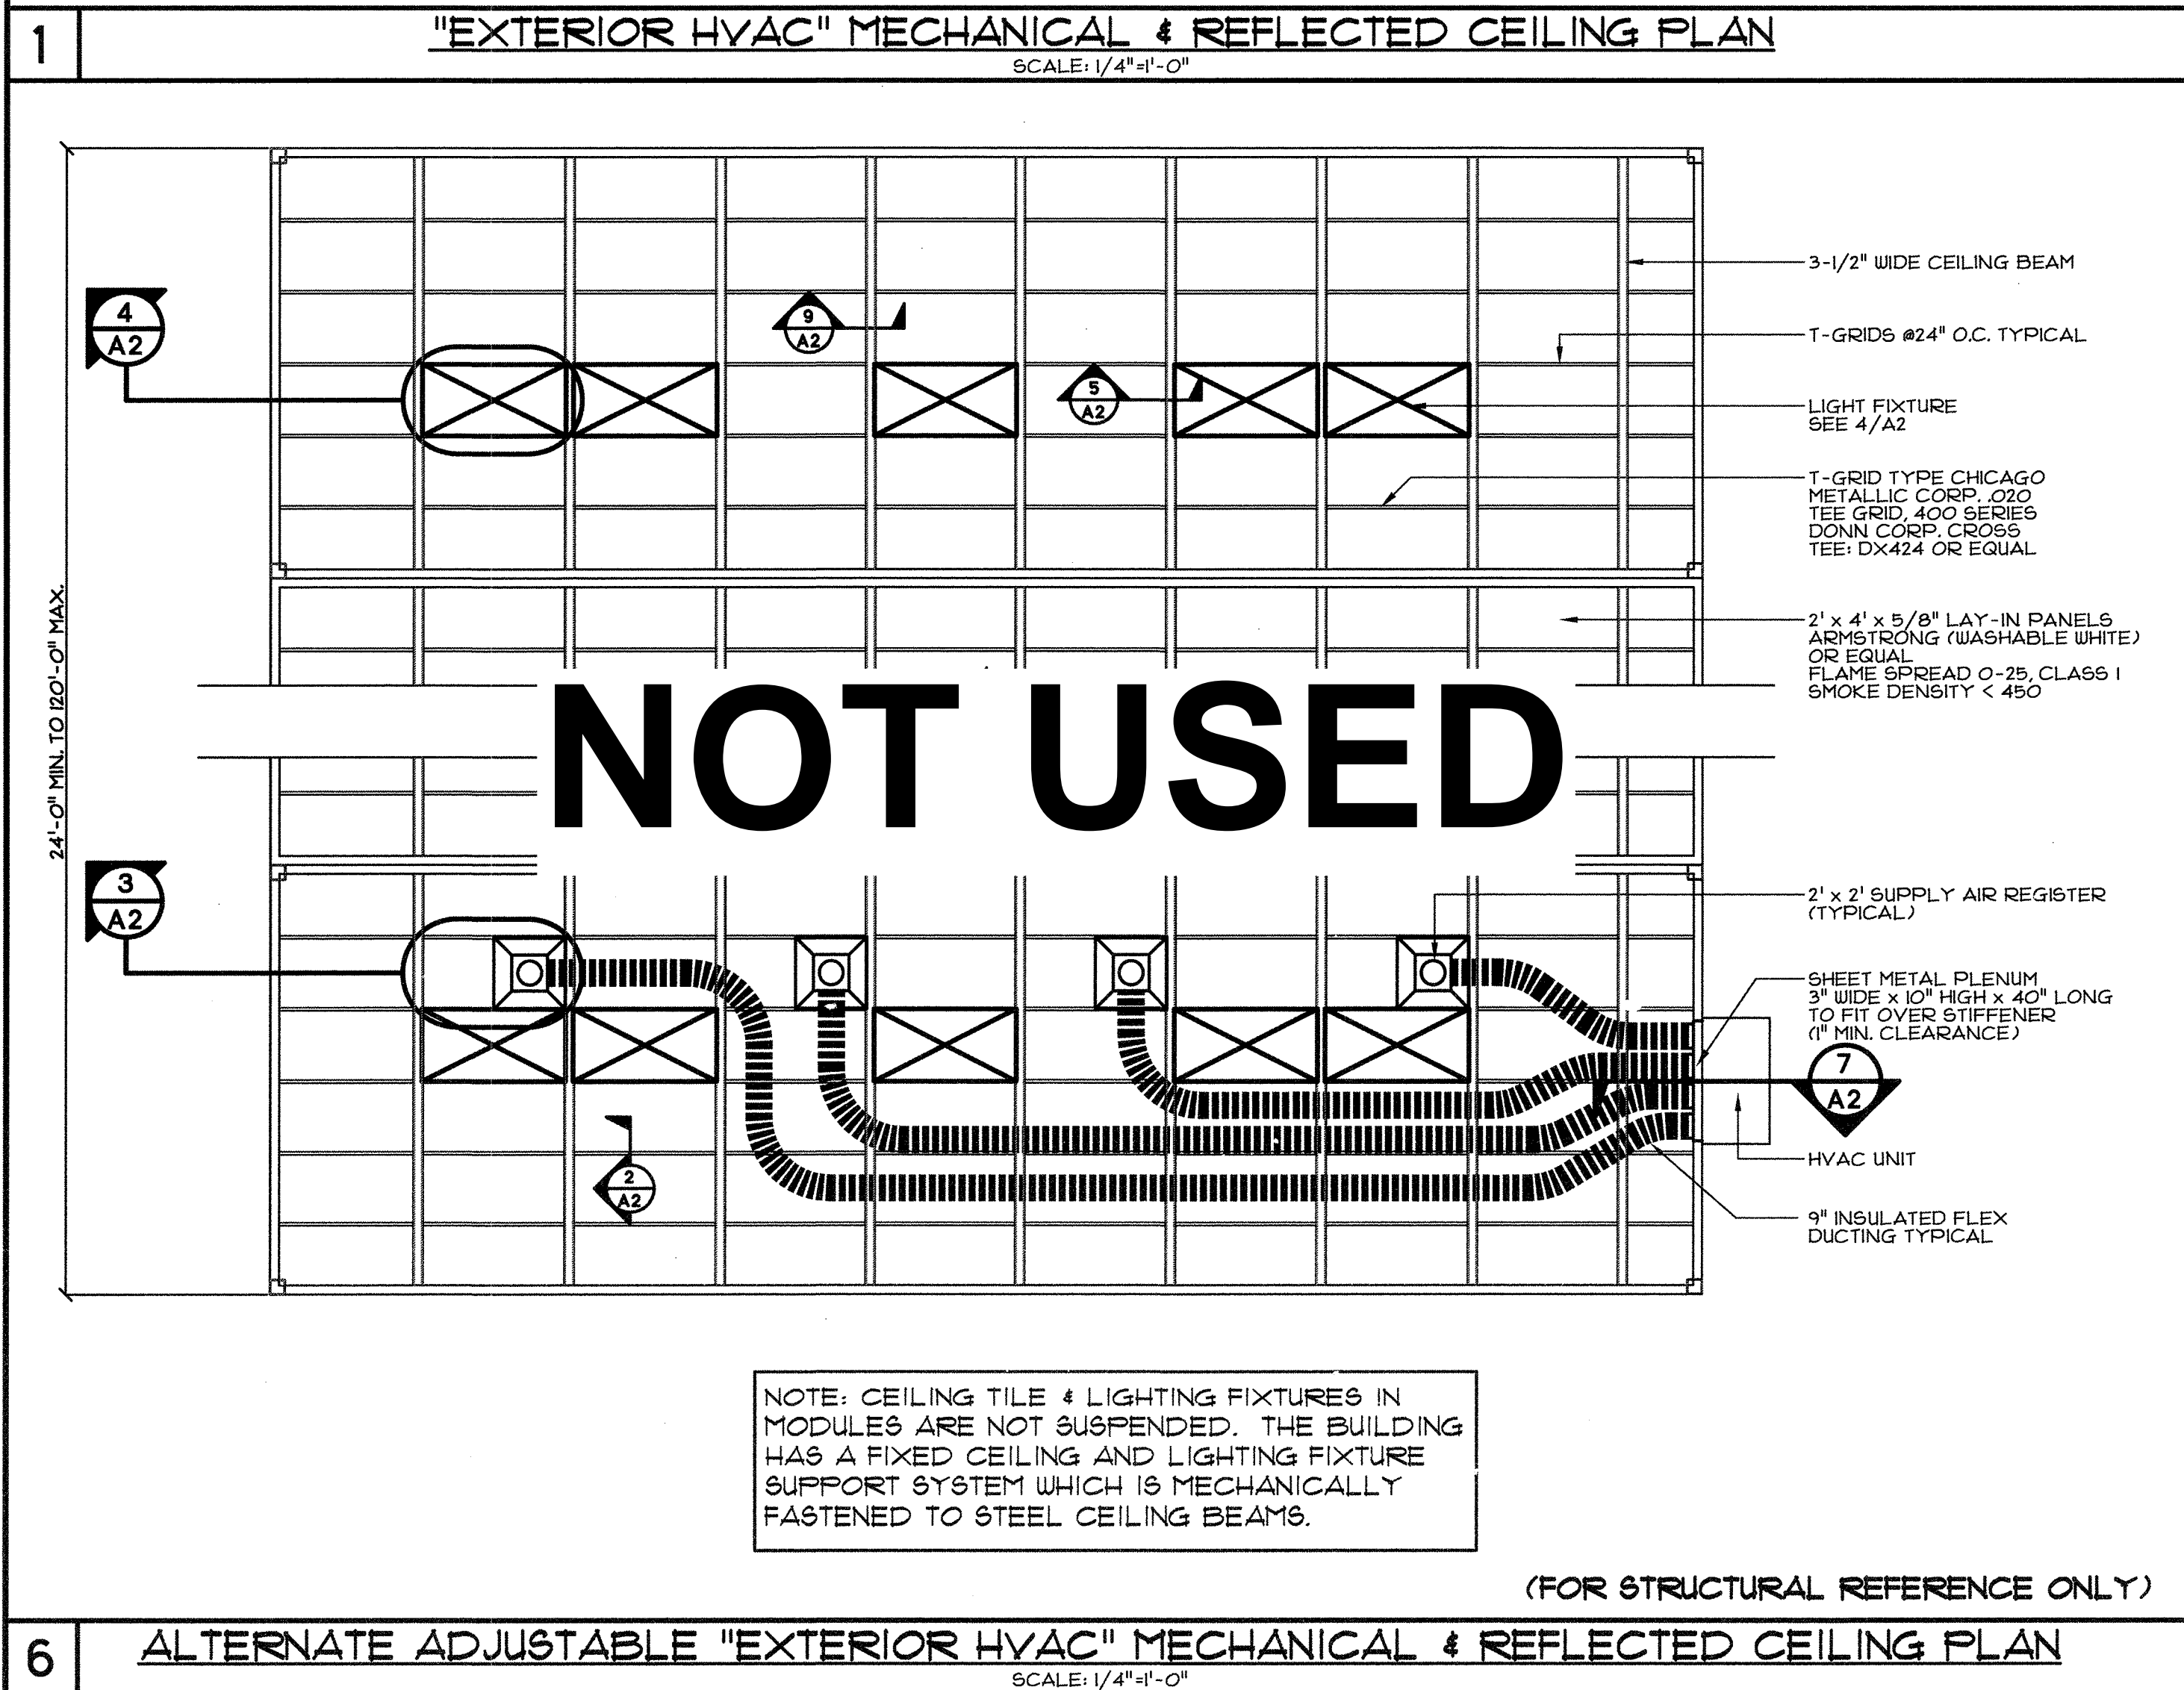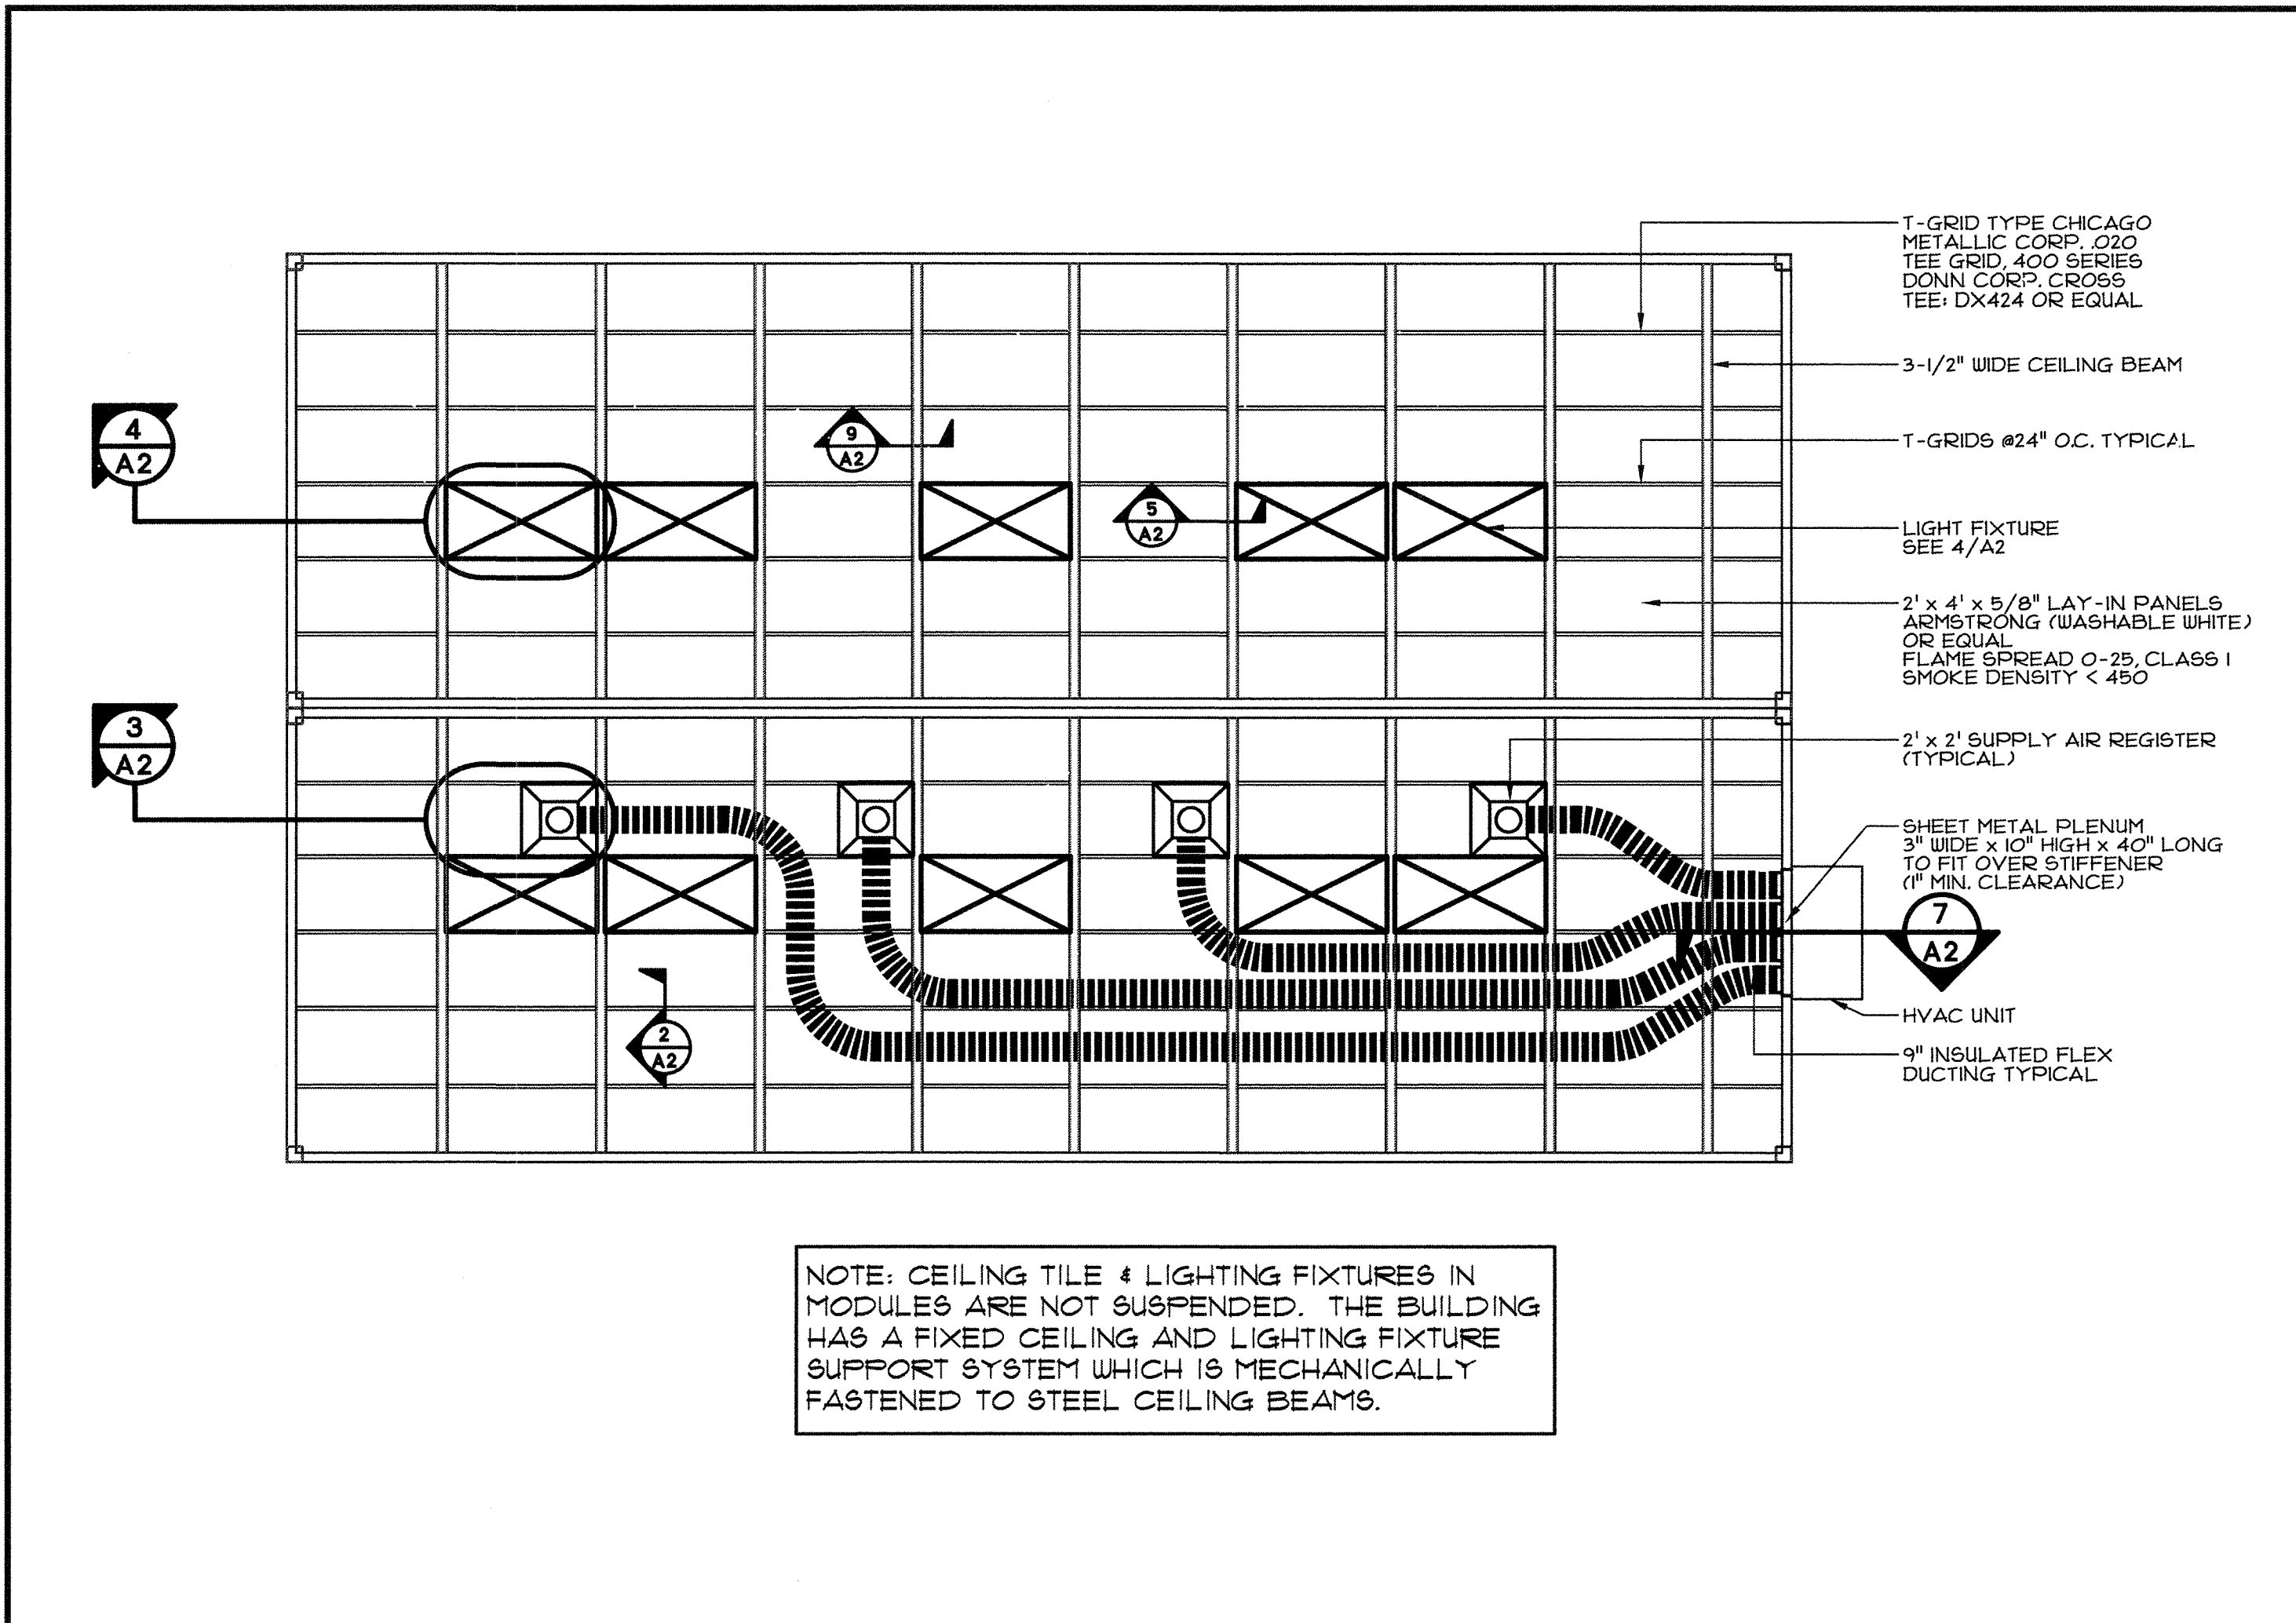

ANGLE PACKAGE WALL MOUNTED AIR TO AIR ELECTRIC HEAT PUMP UNIT SHALL BE INSTALLED IN ACCORDANCE WITH ARI STANDARDS 240-77. (U.L. LISTED) REFERENCE BRANDS: "BARD" S43H1-A, 3.5 TON, 10.5 EER, 3.2 COP (OR EQUAL)

WIRING AND INSTALLATION OF UNIT PER MANUFACTURER'S INSTRUCTIONS.

A) TWO SPEED DOOR BLOWER MOTOR TO REDUCE INDOOR NOISE LEVEL

B) AUX. HEAT - 5 KW HEAT STRIP

C) LOW TEMPERATURE OUTDOOR THERMOSTAT TO ASSIST CIRCUITING DURING THE HEATING MODE.

D) COOLING: 42000 BTUH, HEATING 37400 BTUH

E) WEIGHT: 510# MAX

AIR FILTERS:

MINIMUM EFFICIENCY REPORTING VALUE (MERV) OF 8 (CGBS 5.504.5.3)

AN APPROVED TYPE TESTED IN ACCORDANCE WITH TEST METHODS SFM-12-71-AS SHOWN IN PART 12, TITLE 24, CALIFORNIA CODE OF REGULATIONS. PREFORMED FILTERS HAVING COMBUSTIBLE FRAMING SHALL BE TESTED AS A COMPLETE ASSEMBLY. AIR FILTERS IN ALL OCCUPANCIES SHALL BE CLASS 2 OR BETTER. AS DEFINED IN THE TEST METHOD ABOVE. AIR FILTERS SHALL BE ACCESSIBLE FOR CLEANING OR REPLACEMENT.

2. CONTROLS: ( @ 48" MAXIMUM A.F.F. ) - ( TO TOP OF BOX ) THERMOSTAT: WHITE-ROGERS ( IF85-275 ) DIGITAL ( TAMPER PROOF ) SYSTEM SHALL BE INSTALLED WITH AN OCCUPANCY SENSOR FOR SHUT-OFF

3. DUCTS: MAY BE CLASS "1" OR "0" FACTORY MADE AIR DUCTS SHALL BE APPROVED FOR THE USE INTENDED OR SHALL CONFORM TO THE REQUIREMENTS OF U.L. STANDARDS NO. 6-1. EACH PORTION OF A FACTORY MADE AIR DUCT SYSTEM SHALL BE IDENTIFIED BY THE MANUFACTURER WITH A LABEL OR OTHER SUITABLE IDENTIFICATION INDICATING COMPLIANCE WITH UMC STANDARD NO. 6-1 AND ITS CLASS DESIGNATION. THESE DUCTS SHALL BE INSTALLED IN ACCORDANCE WITH THE TERMS OF THEIR LISTING. INSULATION APPLIED TO THE EXTERIOR SURFACE OF DUCTS LOCATED IN BUILDING SHALL HAVE A FLAME SPREAD RATING OF NOT MORE THAN 25 AND A SMOKE-DEVELOPED RATING OF NOT MORE 50 WHEN TESTED AS A COMPOSITE INSTALLATION INCLUDING INSULATION, FACING MATERIALS, TAPES AND ADHESIVE AS NORMALLY APPLIED. MATERIAL EXPOSED WITHIN DUCTS OR PLENUMS SHALL HAVE A FLAME SPREAD RATING OF NOT MORE THAN 25 AND A SMOKE DEVELOPED RATING OF NOT MORE THAN 50

AND INSULATION AS REQUIRED BY CALIFORNIA ENERGY CODE (CEC) 90.2.6.1

4. COMBINED UNITS SUPPLYING GREASE TRAP AND GCM REQUIRES DUCT SMOKE DETECTOR FOR AUTO SHUT-DOWN INTERCONNECT WITH THE ALARM SYSTEM C.M.C. ADDRESS ALL OCCUPIED ROOMS SERVED BY THE AIR HANDLING EQUIPMENT HAVE DIRECT ACCESS TO EXTERIOR VENTILATION THROUGH THE ROOF

5. COVERING OF DUCT OPENINGS AND PROTECTION OF MECHANICAL EQUIPMENT DURING CONSTRUCTION DURING ROUGH INSTALLATION, DURING SHIPMENT OF RELOCATABLE, STORAGE ON CONSTRUCTION SITE, AND UNTIL FINAL STARTUP, ALL DUCTS OPEN ENDS AND OTHER RELATED AIR DISTRIBUTION COMPONENT OPENINGS SHALL BE COVERED WITH TAPE, PLASTIC, SHEET METAL, OR OTHER METHODS TO REDUCE THE AMOUNT OF DUST OR DEBRIS WHICH MAY COLLECT IN THE SYSTEM (CGBS SEC. 5.504.3)



6. EACH SPACE SHALL BE DESIGNED TO HAVE NATURAL VENTILATION OR MECHANICAL VENTILATION THAT IS NOT LESS THAN THE LARGER OF CONDITIONED FLOOR AREA TIMES THE REQUIREMENTS IN THE CALIFORNIA ENERGY CODE TABLE 120.1-A OR 15 TIMES THE EXPECTED NUMBER OF OCCUPANTS.

7. MECHANICAL SYSTEM ACCEPTANCE REQUIREMENTS. THE FOLLOWING EQUIPMENT AND SYSTEMS SHALL BE CERTIFIED AS MEETING THE "ACCEPTANCE REQUIREMENTS FOR CODE COMPLIANCE" AS SPECIFIED BY THE REFERENCE NONRESIDENTIAL MANUAL APPENDIX NA7:

- OUTDOOR AIR VENTILATION SYSTEMS (NA7.5.1)

- CONSTANT VOLUME, SINGLE ZONE UNITARY A/C AND HEAT PUMP UNIT CONTROLS (NA7.5.2)

8. WHEN RESTROOM OPTIONS ARE USED, MECHANICAL EXHAUST SHALL BE PROVIDED PER 2016 C.M.C. TABLE 403.7.

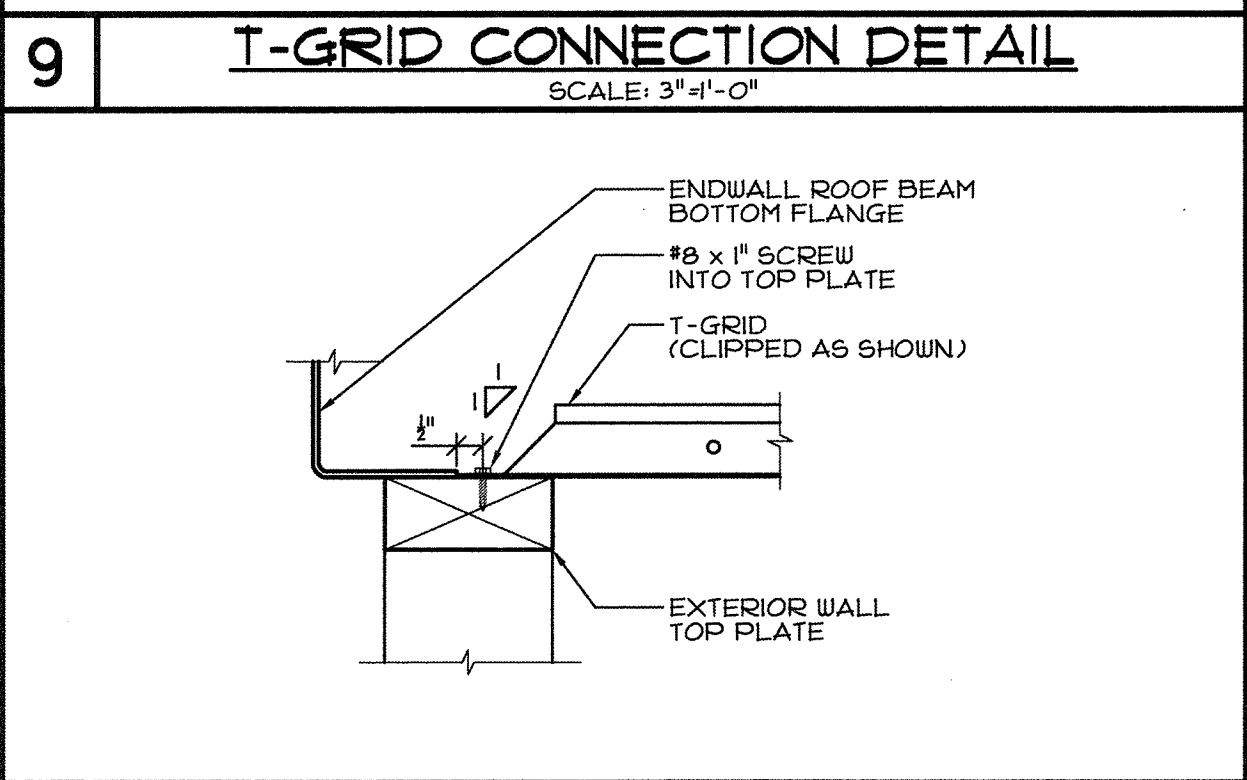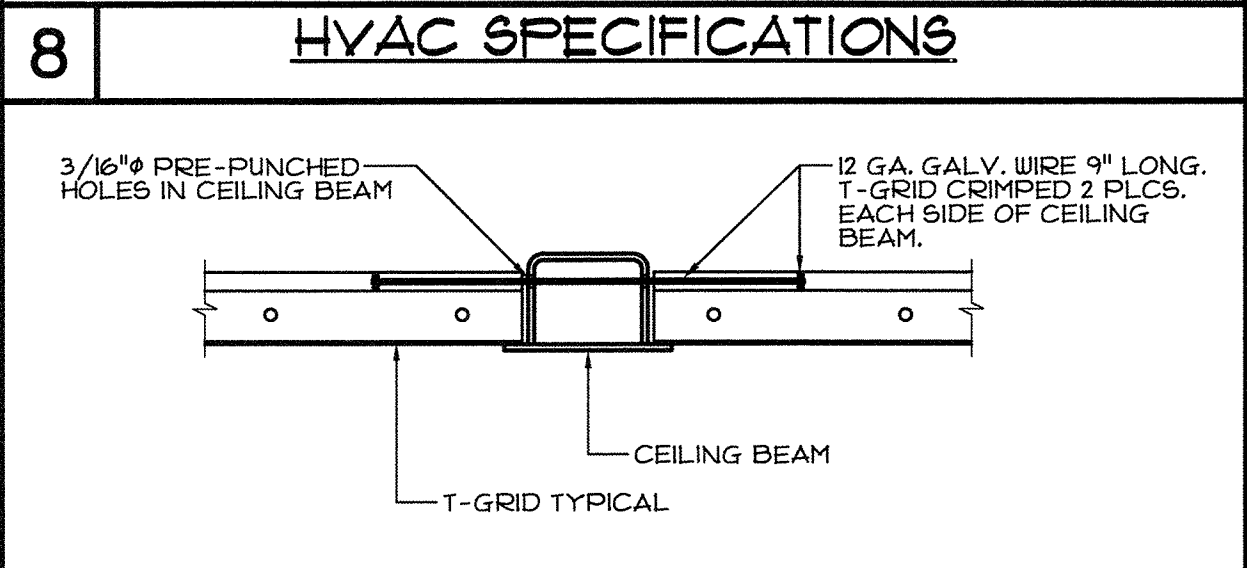

10 T-GRID CONNECTION DETAIL  
SCALE: 3/4"=1'-0"

DIVISION OF THE STATE ARCHITECT

PRE-CHECK (PC) DOCUMENT  
Code: 2016-CBC  
A separate project application for construction is required.

CONFIDENTIAL MATERIAL- THESE DOCUMENTS ARE THE PROPERTY OF AND ARE NOT TO BE REPRODUCED OR DISTRIBUTED WITHOUT FULL KNOWLEDGE AND WRITTEN CONSENT FROM ENVIROPLEX, INC.  
© COPYRIGHT ENVIROPLEX, INC. (ALL DRAWINGS PREPARED BY ENVIROPLEX, INC.)

IDENTIFICATION STAMP  
DIV. OF THE STATE ARCHITECT  
APP. 02-118017 INC.  
REVIEWED FOR  
SS ☐ FLS ☐ ACS ☐  
DATE: 04/10/2020

03/26/2020

REGISTERED PROFESSIONAL ENGINEER  
No. S2030  
EXPIRATION DATE: 03/26/2025  
www.cesarpdx.com

THESE DRAWINGS ARE PRELIMINARY  
AND NOT FOR CONSTRUCTION  
UNLESS SIGNED OR SEALED BY  
THE ENGINEER OF RECORD.

ENVIROPLEX, INC.  
4777 E. CARPENTER ROAD STOCKTON, CA. 95215, (209) 466-8000  
CESAR CHAVEZ HIGH SCHOOL - ATHLETIC FACILITY  
STOCKTON UNIFIED SCHOOL DISTRICT  
2929 WINDFLOWER LANE STOCKTON, CA 95212

"EXTERIOR HVAC UNIT"  
MECHANICAL & REFLECTED CEILING  
PLANS, HVAC WALL ATTACH,  
DETAILS, HVAC SPECIFICATIONS

REV / DATE: BY:


JOB No.:  
DRAWN BY:  
DATE:

IDENTIFICATION STAMP  
DIVISION OF THE STATE ARCHITECT  
02-118094  
AC 2016 FLS 2016 ACS 2016  
DATE 9-6-2018  
016 - 2440







A2

24x40 TO 120x40 P.C.



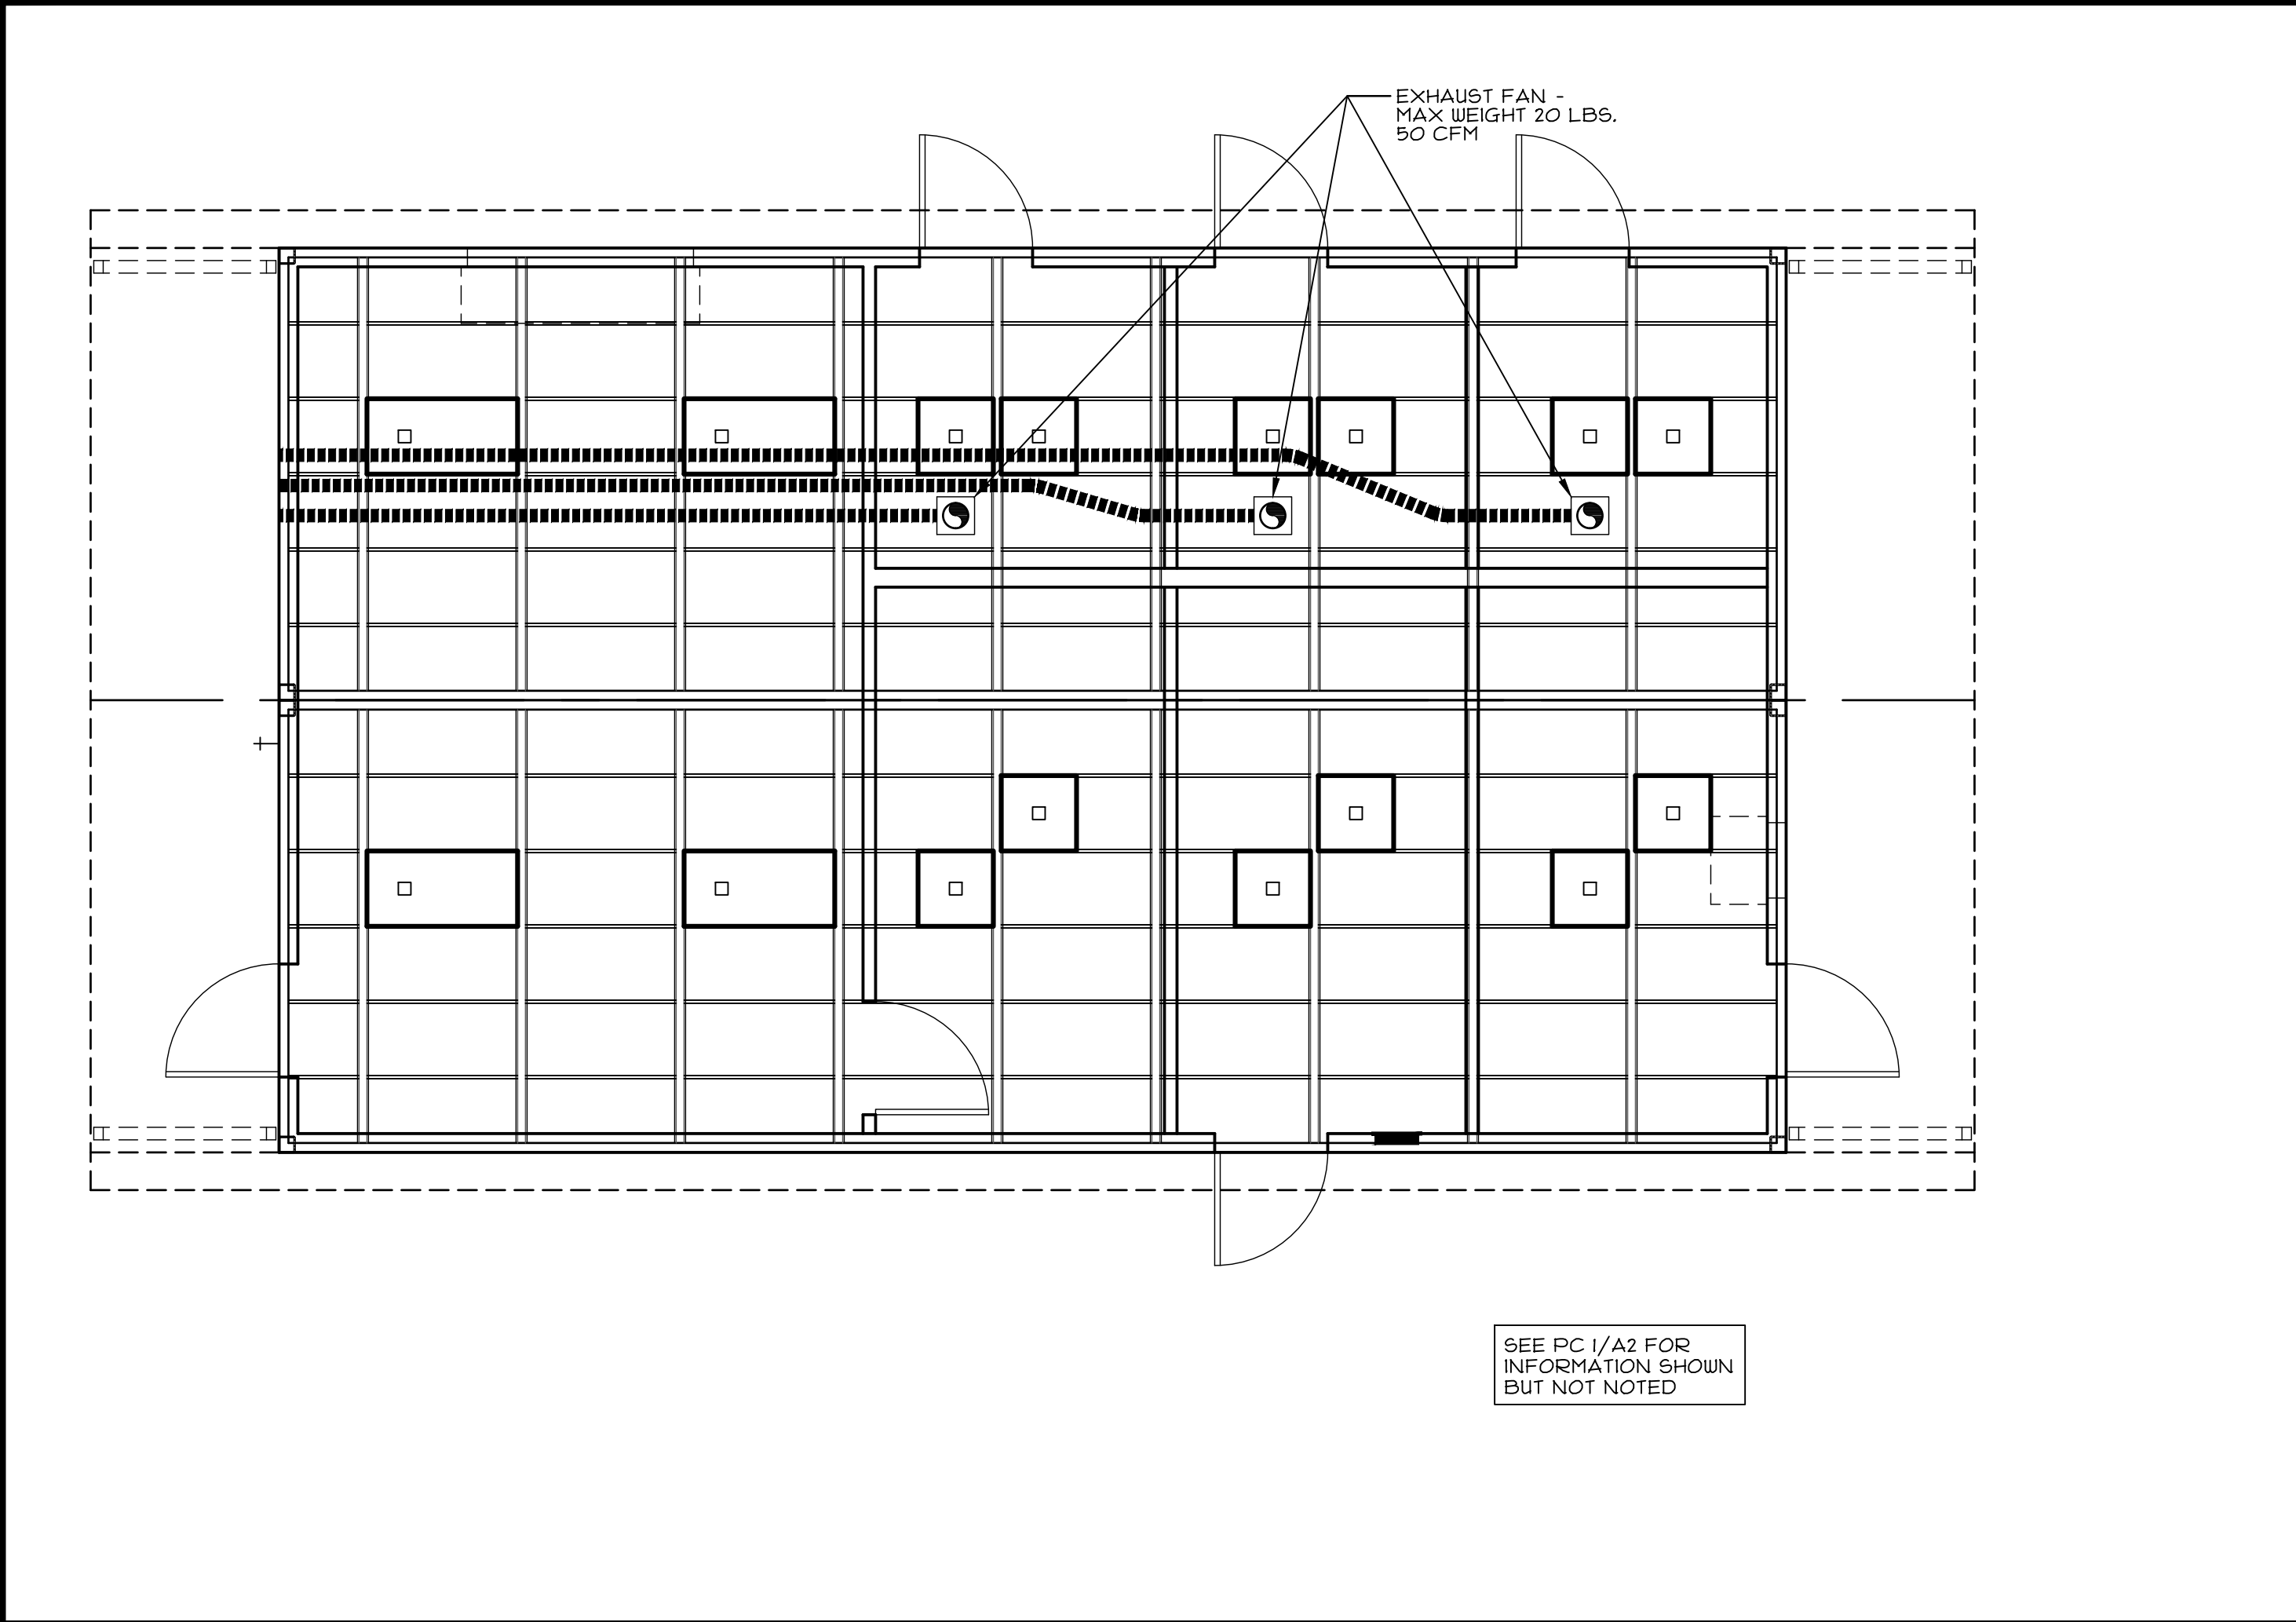

     1 "EXTERIOR HVAC" MECHANICAL & REFLECTED CEILING PLAN  
SCALE: 1/4"=1'-0"

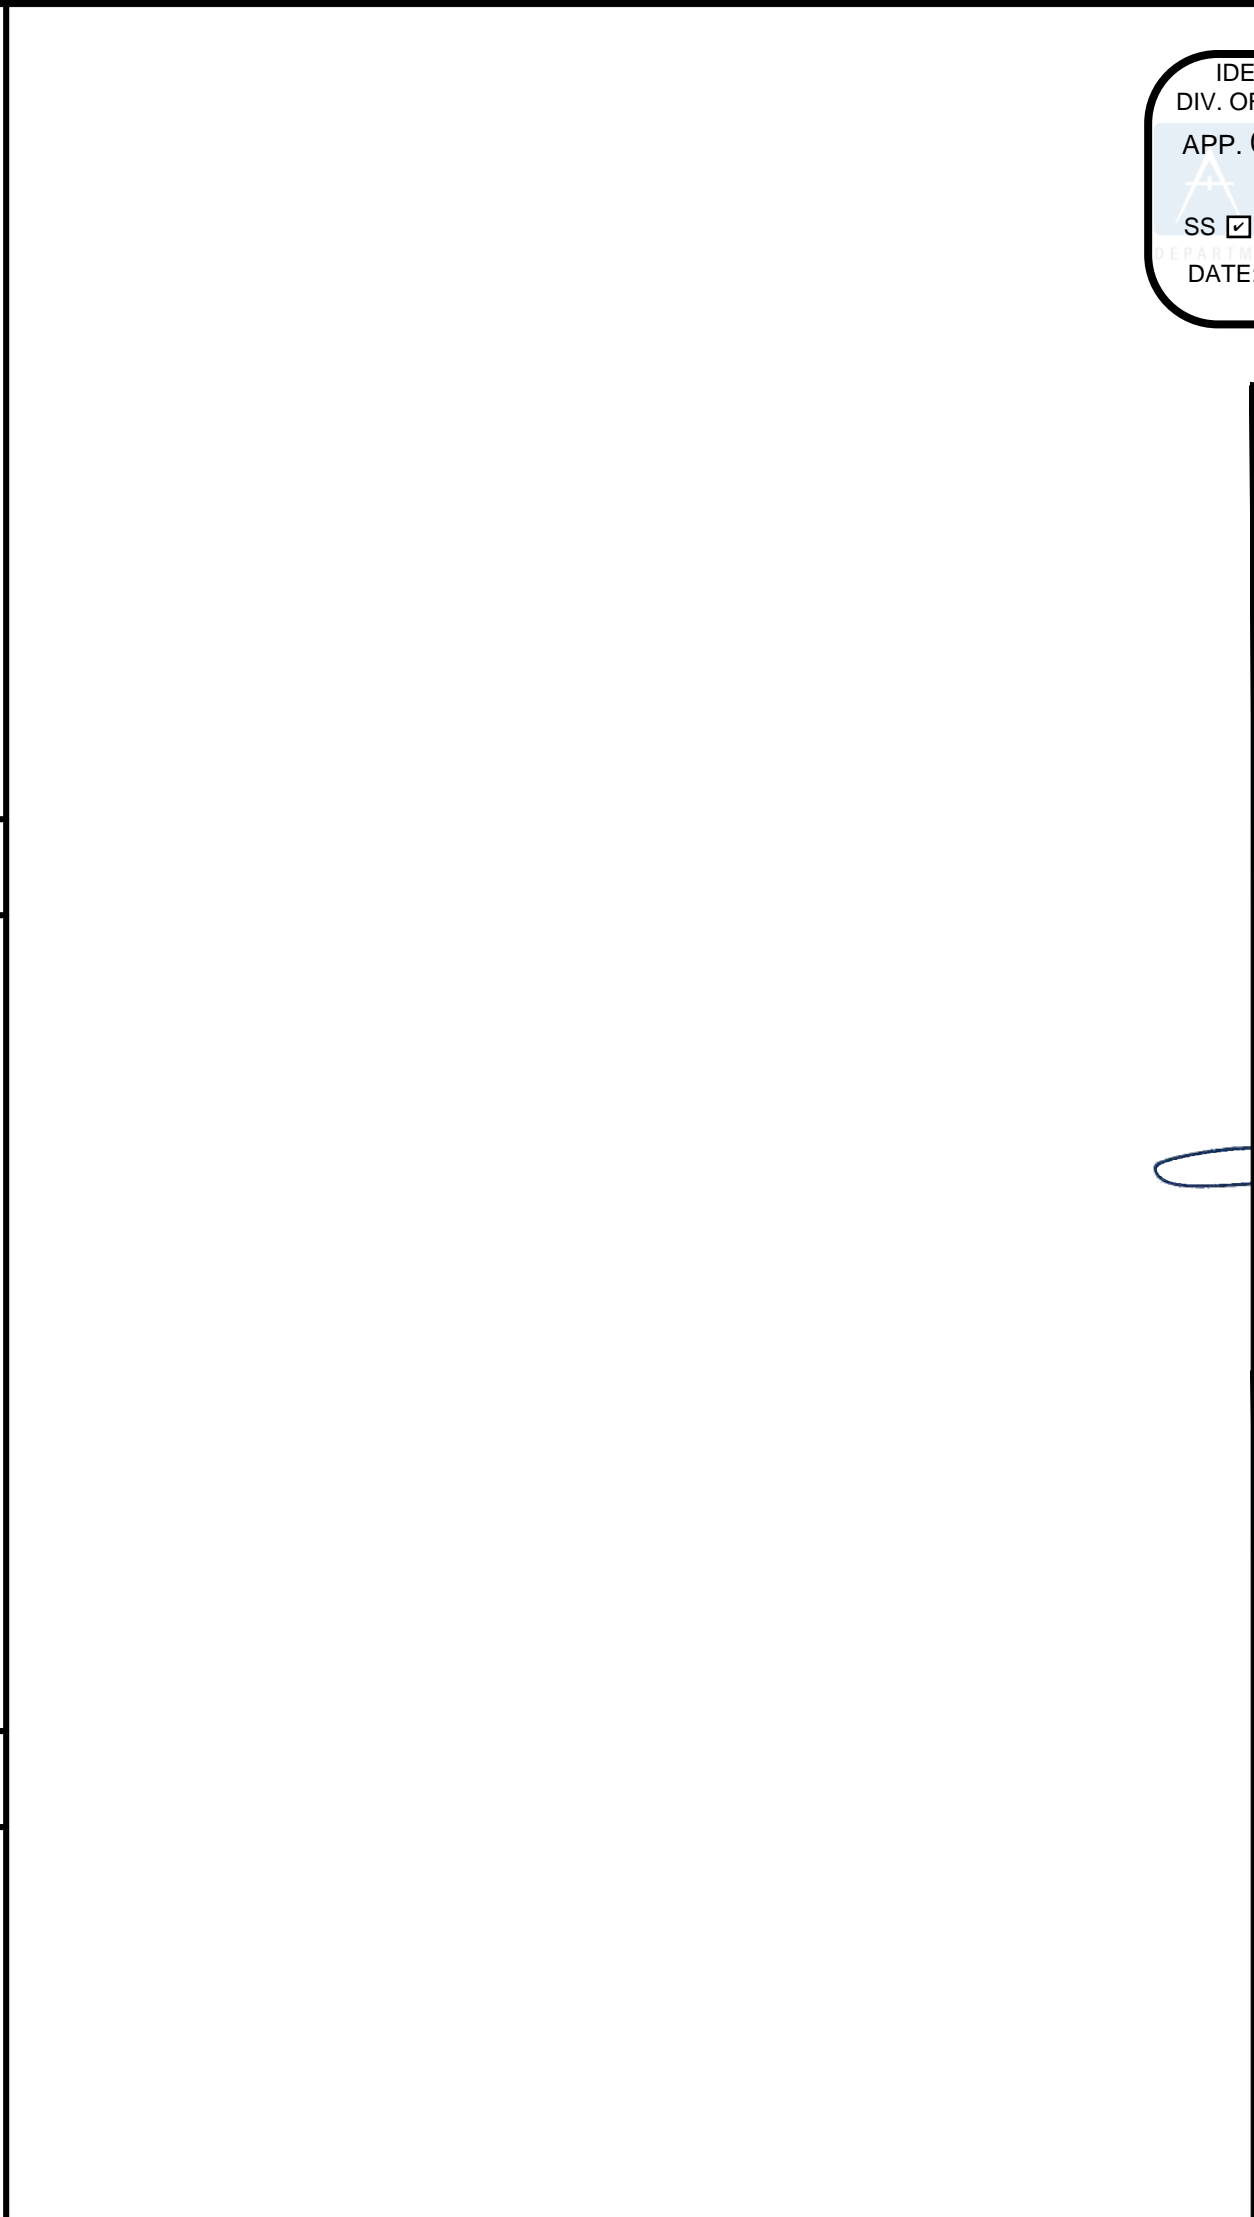

IDENTIFICATION STAMP  
DIV. OF THE STATE ARCHITECT  
APP. 02-118017 INC:  
REVIEWED FOR  
SS ☐ FLS ☐ ACS ☐  
DATE: 04/10/2020

CYS  
STRUCTURAL ENGINEERS INC.  
2400 N. Yuma Park Drive, Suite 600  
Sacramento, CA 95833  
(916) 486-0000  
www.cyseng.com

03/26/2020

REGISTERED PROFESSIONAL ENGINEER  
ERNEST J. YOUNG  
No. 52030  
STATE OF CALIFORNIA

THESE DRAWINGS ARE PRELIMINARY  
AND NOT FOR CONSTRUCTION  
UNLESS STAMPED & SIGNED BY  
THE ENGINEER OF RECORD.

ENVIROPLEX, INC.  
4777 E. CARPENTER ROAD STOCKTON, CA. 95215, (209) 466-8000  
CESAR CHAVEZ HIGH SCHOOL - ATHLETIC FACILITY  
STOCKTON UNIFIED SCHOOL DISTRICT  
2929 WINDFLOWER LANE STOCKTON, CA 95212

MECHANICAL &  
REFLECTED CEILING PLANS

|           |            |       |     |
|-----------|------------|-------|-----|
| REV       | /          | DATE: | BY: |
|           |            |       |     |
|           |            |       |     |
| JOB No.:  | 19-000     |       |     |
| DRAWN BY: | RS         |       |     |
| DATE:     | 12/17/2019 |       |     |

A2.1



CAL-GREEN MANDATORY MEASURES

- NOTE :  
ONLY APPLICABLE CAL-GREEN MANDATORY MEASURES TO THE ENVIROPLEX  
MODULAR BUILDING ARE LISTED BELOW. FOR A COMPLETE LIST OF MEASURES  
REQUIRED FOR THE ENTIRE CONSTRUCTION PROJECT, REFER TO DSA DOCUMENT  
GL-4.
1. WATER CLOSETS.  
THE EFFECTIVE FLUSH VOLUME OF ALL WATER CLOSETS SHALL NOT EXCEED 1.28  
GALLONS PER FLUSH. TANK-TYPE WATER CLOSETS SHALL BE CERTIFIED TO THE  
PERFORMANCE CRITERIA OF THE U.S. EPA WATERSENSE SPECIFICATION  
FOR TANK-TYPE TOILETS.
2. ~~INDOOR WATER USE:  
THE EFFECTIVE FLUSH VOLUME OF ALL WATER CLOSETS SHALL NOT EXCEED 1.28  
GALLONS PER FLUSH. TANK-TYPE WATER CLOSETS SHALL BE CERTIFIED TO THE  
PERFORMANCE CRITERIA OF THE U.S. EPA WATERSENSE SPECIFICATION  
FOR TANK-TYPE TOILETS.~~
3. INDOOR WATER USE:  
LAVATORY FAUCETS - 0.5 GPM  
KITCHEN FAUCETS - 2.2 GPM  
GRAVITY TANK WATER CLOSET - 1.28 GAL/FLUSH  
FLUSHOMETER TANK WATER CLOSET - 1.28 GAL/FLUSH  
FLUSHOMETER VALVE WATER CLOSET - 1.28 GAL/FLUSH
4. EXTERIOR DOOR PROTECTION.  
PRIMARY EXTERIOR ENTRIES SHALL BE COVERED TO PREVENT WATER INTRUSION BY  
USING NONABSORBENT FLOOR AND WALL FINISHES WITHIN AT LEAST 2 FEET AROUND  
AND PERPENDICULAR TO SUCH OPENINGS  
PLUS AT LEAST ONE OF THE FOLLOWING:  
1. AN INSTALLED AWNING AT LEAST 4 FEET IN DEPTH.  
2. THE DOOR IS PROTECTED BY A ROOF OVERHANG AT LEAST 4 FEET IN DEPTH.  
3. THE DOOR IS RECESSED AT LEAST 4 FEET.  
4. OTHER METHODS WHICH PROVIDE EQUIVALENT PROTECTION.
5. CONSTRUCTION WASTE MANAGEMENT:  
A MINIMUM OF 65% OF THE NONHAZARDOUS CONSTRUCTION AND DEMOLITION  
WASTE SHALL BE RECYCLED AND/OR SALVAGED FOR REUSE.  
  
CONSTRUCTION WASTE MANAGEMENT PLAN SHALL:  
1) IDENTIFY WASTE MATERIALS TO BE DIVERTED FROM DISPOSAL.  
2) DETERMINE OF WASTE MATERIALS WILL BE SORTED ON-SITE OR BULK  
MIXED.  
3) IDENTIFY DIVERSION FACILITIES WHERE COLLECTED WASTE MATERIAL  
WILL BE TAKEN.  
4) SPECIFY THE AMOUNT OF WASTE DIVERTED CALCULATED BY WEIGHT OR  
BY VOLUME.  
  
UTILIZE A WASTE MANAGEMENT COMPANY THAT CAN PROVIDE VERIFIABLE  
DOCUMENTATION THAT THE PERCENTAGE OF CONSTRUCTION AND DEMOLITION  
WASTE MATERIAL DIVERTED FROM THE LANDFILL.
6. COVERING OF DUCT OPENINGS AND PROTECTION OF MECHANICAL EQUIPMENT  
DURING CONSTRUCTION.  
AT THE TIME OF ROUGH INSTALLATION, OR DURING STORAGE ON THE CONSTRUCTION  
SITE AND UNTIL FINAL STARTUP OF THE HEATING, COOLING AND  
VENTILATING EQUIPMENT, ALL DUCT AND OTHER RELATED AIR DISTRIBUTION  
COMPONENT OPENINGS SHALL BE COVERED WITH TAPE,  
PLASTIC, SHEET METAL OR OTHER METHODS ACCEPTABLE TO THE ENFORCING  
AGENCY TO REDUCE THE AMOUNT OF DUST, WATER AND  
DEBRIS WHICH MAY COLLECT IN THE SYSTEM.
- ~~CARPET CUSHION  
ALL CARPET INSTALLED IN THE BUILDING INTERIOR SHALL MEET AT LEAST ONE OF THE  
TESTING AND PRODUCT REQUIREMENTS:  
1. CARPET AND RUG INSTITUTE'S GREEN LABEL PLUS PROGRAM.  
2. COMPLIANT WITH THE VOC-EMISSION LIMITS AND TESTING REQUIREMENTS  
SPECIFIED IN THE CALIFORNIA  
DEPARTMENT OF PUBLIC HEALTH STANDARD METHOD FOR THE TESTING AND  
EVALUATION OF VOLATILE ORGANIC  
CHEMICAL EMISSIONS FROM INDOOR SOURCES USING ENVIRONMENTAL CHAMBERS,  
VERSION 1.1, FEBRUARY 2010.  
(ALSO KNOWN AS CDPH STANDARD METHOD 0111 OR SPECIFICATION 01350).  
3. NSF/ANSI 140 AT THE GOLD LEVEL OR HIGHER.  
4. SCIENTIFIC CERTIFICATIONS SYSTEM SUSTAINABLE CHOICE; OR  
5. COMPLIANT WITH THE CALIFORNIA COLLABORATIVE FOR HIGH PERFORMANCE  
SCHOOLS (CA-CHPS) CRITERIA  
INTERPRETATION FOR ECR 12 DATED JULY 2012 AND LISTED IN THE CHPS HIGH  
PERFORMANCE PRODUCT DATABASE.~~
- ~~CARPET CUSHION  
ALL CARPET CUSHION INSTALLED IN THE BUILDING INTERIOR SHALL MEET THE  
REQUIREMENTS OF THE CARPET AND RUG INSTITUTE GREEN LABEL PROGRAM  
CARPET ADHESIVE.  
ALL CARPET ADHESIVE SHALL MEET THE REQUIREMENTS OF TABLE 5.504.4.5.~~
10. COMPOSITE WOOD PRODUCTS.  
HARDWOOD PLYWOOD, PARTICLEBOARD AND MEDIUM DENSITY FIBERBOARD  
COMPOSITE WOOD PRODUCTS USED ON THE INTERIOR OR EXTERIOR OF THE  
BUILDINGS SHALL MEET THE REQUIREMENTS FOR  
FORMALDEHYDE AS SPECIFIED IN ARB'S AIR TOXICS CONTROL MEASURE FOR  
COMPOSITE WOOD (17 CCR 93120 ET SEQ.).  
THOSE MATERIALS NOT EXEMPTED UNDER THE ATCM MUST MEET THE SPECIFIED  
EMISSION LIMITS, AS SHOWN IN TABLE  
5.504.4.5.

SOLAR READY REQUIREMENTS

- A) MINIMUM SOLAR ZONE AREA BASED ON TOTAL ROOF AREA (NON-SHADED CONDITIONS) :
- 1) THE SOLAR ZONE MUST HAVE A TOTAL AREA THAT IS NO LESS THAN 15 PERCENT OF THE  
TOTAL ROOF AREA AFTER SUBTRACTING ANY AREA OF THE ROOF THAT IS COVERED BY A  
SKYLIGHT.
- 2) THE TOTAL AREA OF THE SOLAR ZONE MAY BE COMPOSED OF MULTIPLE SUB-AREAS. NO  
DIMENSION OF A SUB-AREA CAN BE LESS THAN FIVE FEET, EACH SUB-AREA MUST BE AT  
LEAST 80 SQUARE FEET.
- B) SOLAR READY ROOF AREA REQUIREMENT PER BUILDING SIZE:
- | Building size | Roof Area |                             |            | minimum solar<br>zone area<br>required (sf) |
|---------------|-----------|-----------------------------|------------|---|
|               | area (sf) | potential<br>overhangs (sf) | total (sf) |   |
| 24 x 40       | 960       | 240                         | 1200       | 180   |
| 36 x 40       | 1440      | 360                         | 1800       | 270   |
| 48 x 40       | 1920      | 480                         | 2400       | 360   |
| 60 x 40       | 2400      | 600                         | 3000       | 450   |
| 72 x 40       | 2880      | 720                         | 3600       | 540   |
| 84 x 40       | 3360      | 840                         | 4200       | 630   |
| 96 x 40       | 3840      | 960                         | 4800       | 720   |
| 108 x 40      | 4320      | 1080                        | 5400       | 810   |
| 120 x 40      | 4800      | 1200                        | 6000       | 900   |
- C) MINIMUM SOLAR ZONE AREA BASED ON POTENTIAL SOLAR ZONE (SHADED CONDITIONS) :
- 1) THE MINIMUM REQUIRED SOLAR ZONE AREA MAY BE REDUCED IF THE BUILDING SITE IS  
SHADED BY OBJECTS THAT ARE NOT PART OF THE BUILDING ITSELF AND THERE IS NO  
UN-SHADED AREA THAT COULD ACCOMMODATE THE FULL SOLAR ZONE.
- 2) THE POTENTIAL SOLAR ZONE IS DEFINED AS THE TOTAL AREA ON ROOF, OVERHANG,  
ROOF OR OVERHANG OF A STRUCTURE WITHIN 250 FEET OF THE BUILDING, OR ON A  
COVERED PARKING STRUCTURE INSTALLED WITH THE BUILDING THAT HAS ANNUAL  
SOLAR ACCESS OF 70 PERCENT OR GREATER.
- 3) IF THE POTENTIAL SOLAR ZONE IS SMALLER THAN 15 PERCENT OF THE ROOF AREA OF  
THE BUILDING EXCLUDING ANY SKYLIGHTS, THEN THE SOLAR ZONE CAN BE REDUCED TO  
HALF THE AREA OF THE POTENTIAL SOLAR ZONE. IF THE ROOF IS SHADED SUCH THAT  
THERE IS NO POTENTIAL SOLAR ZONE AREA, THEN NO SOLAR ZONE IS REQUIRED.
- D) SOLAR ZONE ORIENTATION:
- 1) IF THE SOLAR ZONE IS LOCATED ON A STEEP-SLOPED ROOF WITH A RATIO OF RISE TO  
RUN OF GREATER THAN 2:12, THEN THE ROOF MUST BE ORIENTED BETWEEN 110  
DEGREES AND 270 DEGREES OF TRUE NORTH.
- 2) IF A SOLAR ZONE IS LOCATED ON A LOW-SLOPED ROOF WITH A RATIO OF RISE TO RUN  
LESS THAN 2:12, THE ORIENTATION REQUIREMENTS DO NOT APPLY.
- 3) OBSTRUCTIONS SUCH AS VENTS, CHIMNEYS, ARCHITECTURAL FEATURES, OR ROOF  
MOUNTED EQUIPMENT CANNOT BE LOCATED IN THE SOLAR ZONE. THIS REQUIREMENT IS  
IN PLACE SO THE SOLAR ZONE REMAINS CLEAR AND OPEN FOR THE FUTURE  
INSTALLATION OF A SOLAR ENERGY SYSTEM.
- E) ALTERNATIVE SOLAR ZONE LOCATION:
- 1) THE SOLAR ZONE CAN BE LOCATED AT ANY OF THE FOLLOWING LOCATIONS: ROOF OF  
ANOTHER STRUCTURE LOCATED WITHIN 250 FEET OF THE PRIMARY BUILDING,  
OVERHANG OF ANOTHER STRUCTURE WITHIN 250 FEET OF THE PRIMARY BUILDING, OR  
COVERED PARKING INSTALLED WITH THE BUILDING PROJECT.
- F) SOLAR PANELS ARE NOT TO EXCEED 4.0 PSF AND ARE NOT TO OCCUR ON BUILDING  
OVERHANGS. SOLAR PANELS MUST BE INACCESSIBLE PER CBC 1607A.12.5. ~~AND 1607.12.5.~~

IDENTIFICATION STAMP  
DIV. OF THE STATE ARCHITECT  
APP. 02-118017 INC.  
REVIEWED FOR  
SS ☐ FLS ☐ ACS ☐  
DATE: 04/10/2020

03/26/2020

THESE DRAWINGS ARE PRELIMINARY  
AND NOT FOR CONSTRUCTION  
UNLESS STAMPED & SIGNED BY  
THE ENGINEER OF RECORD.

ENVIROPLEX, INC.  
4777 E. CARPENTER ROAD STOCKTON, CA 95215, (209) 466-8000  
CESAR CHAVEZ HIGH SCHOOL - ATHLETIC FACILITY  
STOCKTON UNIFIED SCHOOL DISTRICT  
2929 WINDFLOWER LANE STOCKTON, CA 95212

GREEN BUILDING STANDARDS  
AND SOLAR READY REQUIREMENTS

REV / DATE: BY:  
JOB No.:  
DRAWN BY:  
DATE:

IDENTIFICATION STAMP  
DIVISION OF THE STATE ARCHITECT  
APP. 02-118094  
AC ☐ FLS ☐ ACS ☐  
DATE: 9-6-2018  
2016 - 20400

AGB

CONFIDENTIAL MATERIAL--THESE DOCUMENTS ARE THE PROPERTY OF AND ARE NOT TO BE REPRODUCED  
OR DISTRIBUTED WITHOUT FULL KNOWLEDGE AND WRITTEN CONSENT FROM ENVIROPLEX, INC.  
© COPYRIGHT ENVIROPLEX, INC. (ALL DRAWINGS PREPARED BY ENVIROPLEX, INC.)

APPROVED  
DIVISION OF STATE ARCHITECT  
HIGH PERFORMANCE SECTION  
APP. # 02-118094 DATE: 8-30-18

PRE-CHECK (PC) DOCUMENT  
Code: 2016 CBC  
A separate project application for  
construction is required.



Project Name: Standard 24x40 PC - 2016 code
Project Address: C2 14 (reference city - Palmdale)
Compliance Scope: New/Complete
A. PROJECT GENERAL INFORMATION
1. Project Location (city) (reference city - Palmdale)
2. CA Zip Code
3. Climate Zone
4. Total Unconditioned Floor Area
5. Total of Stories (Excludes Above Grade)
6. Total # of Dwelling Units
7. Total # of Dwelling Units
B. COMPLIANCE RESULTS FOR PERFORMANCE COMPONENTS (Annual TDV Energy Use, kWh/ft²-yr)
BUILDING COMPLETES
1. Energy Component
2. Standard Design (TDV)
3. Proposed Design (TDV)
4. Compliance Margin (TDV)
5. Percent Better Than Standard

CA Building Energy Efficiency Standards- 2016 Nonresidential Compliance
Report Version: NRC-PRF-01-6-07112018-6302
Report Generated on: 2018-07-13 11:09:54

Project Name: Standard 24x40 PC - 2016 code
Project Address: C2 14 (reference city - Palmdale)
Compliance Scope: New/Complete
G. COMPLIANCE PATH & CERTIFICATE OF COMPLIANCE SUMMARY
The following building components are only eligible for prescriptive compliance. Indicate which are relevant to the project.
The following building components may have mandatory requirements per Part 6. Indicate which are relevant to the project.

CA Building Energy Efficiency Standards- 2016 Nonresidential Compliance
Report Version: NRC-PRF-01-6-07112018-6302
Report Generated on: 2018-07-13 11:09:54

Project Name: Standard 24x40 PC - 2016 code
Project Address: C2 14 (reference city - Palmdale)
Compliance Scope: New/Complete
H. CERTIFICATE OF INSTALLATION, CERTIFICATE OF ACCEPTANCE & CERTIFICATE OF VERIFICATION SUMMARY (NRC/NCA/NRCV)
Documentation Author to indicate which Certificates must be submitted for the features to be recognized for compliance.
Building Component
Compliance Forms (Required for submittal)
Pres
Fail

I. ENVELOPE GENERAL INFORMATION (See NRC-PRF-ENV-DETAILS for more information)
1. Total Unconditioned Floor Area
2. Total Unconditioned Floor Area
3. Addition Unconditioned Floor Area
4. Addition Unconditioned Floor Area
5. Total Gross Surface Area
6. Total Penetration Area
7. Windows to Wall Ratio

CA Building Energy Efficiency Standards- 2016 Nonresidential Compliance
Report Version: NRC-PRF-01-6-07112018-6302
Report Generated on: 2018-07-13 11:09:54

Project Name: Standard 24x40 PC - 2016 code
Project Address: C2 14 (reference city - Palmdale)
Compliance Scope: New/Complete
C. PRIORITY PLAN CHECK/ INSPECTION ITEMS (In order of highest to lowest TDV energy savings)
1st Interior Fans: Check envelope and mechanical
2nd Interior Lighting: Check lighting
3rd Heat Rejection: Check envelope and mechanical
4th Pumps & Misc.: Check mechanical
5th Domestic Hot Water: Check mechanical
6th Space Cooling: Check envelope and mechanical
7th Space Heating: Check envelope and mechanical

D. EXCEPTIONAL CONDITIONS
The building does not include service water heating. Verify that service water heating is not required and is not included in the design.
E. HERB VERIFICATION
This section does not apply.
F. ADDITIONAL REMARKS
None Provided

CA Building Energy Efficiency Standards- 2016 Nonresidential Compliance
Report Version: NRC-PRF-01-6-07112018-6302
Report Generated on: 2018-07-13 11:09:54

Project Name: Standard 24x40 PC - 2016 code
Project Address: C2 14 (reference city - Palmdale)
Compliance Scope: New/Complete
I. CERTIFICATE OF INSTALLATION, CERTIFICATE OF ACCEPTANCE & CERTIFICATE OF VERIFICATION SUMMARY (NRC/NCA/NRCV)
Documentation Author to indicate which Certificates must be submitted for the features to be recognized for compliance.
Building Component
Compliance Forms (Required for submittal)
Pres
Fail

CA Building Energy Efficiency Standards- 2016 Nonresidential Compliance
Report Version: NRC-PRF-01-6-07112018-6302
Report Generated on: 2018-07-13 11:09:54

Project Name: Standard 24x40 PC - 2016 code
Project Address: C2 14 (reference city - Palmdale)
Compliance Scope: New/Complete
J. PENETRATION ASSEMBLY SUMMARY
1. Penetration Assembly Name / Tag or ID
2. Penetration Type / Product Type / Frame Type
3. Certification Method
4. Assembly Method
5. Area (ft²)
6. Overall U-Factor
7. Overall R-Value
8. Overall VT
9. Confirmed

K. OPAQUE SURFACE ASSEMBLY SUMMARY
1. Surface Name
2. Surface Type
3. Area (ft²)
4. Framing Type
5. Overall U-Factor
6. Overall R-Value
7. U-Factor / R-Factor / C-Factor
8. Confirmed

L. ROOFING PRODUCT SUMMARY
1. Product Type
2. Product Details (NRCV)
3. Agent Role / Reflectance
4. Thermal Emittance
5. SRI
6. Cool Roof Credit
7. Roofing Product Description
8. Confirmed

CA Building Energy Efficiency Standards- 2016 Nonresidential Compliance
Report Version: NRC-PRF-01-6-07112018-6302
Report Generated on: 2018-07-13 11:09:54

Project Name: Standard 24x40 PC - 2016 code
Project Address: C2 14 (reference city - Palmdale)
Compliance Scope: New/Complete
G. COMPLIANCE PATH & CERTIFICATE OF COMPLIANCE SUMMARY
Identify which building components use the performance or prescriptive path for compliance.
Building Component
Compliance Path
Compliance Forms (Required for submittal)
Location of Mandatory Notes on Plans

CA Building Energy Efficiency Standards- 2016 Nonresidential Compliance
Report Version: NRC-PRF-01-6-07112018-6302
Report Generated on: 2018-07-13 11:09:54

Project Name: Standard 24x40 PC - 2016 code
Project Address: C2 14 (reference city - Palmdale)
Compliance Scope: New/Complete
H. CERTIFICATE OF INSTALLATION, CERTIFICATE OF ACCEPTANCE & CERTIFICATE OF VERIFICATION SUMMARY (NRC/NCA/NRCV)
Documentation Author to indicate which Certificates must be submitted for the features to be recognized for compliance.
Building Component
Compliance Forms (Required for submittal)
Pres
Fail

CA Building Energy Efficiency Standards- 2016 Nonresidential Compliance
Report Version: NRC-PRF-01-6-07112018-6302
Report Generated on: 2018-07-13 11:09:54

Project Name: Standard 24x40 PC - 2016 code
Project Address: C2 14 (reference city - Palmdale)
Compliance Scope: New/Complete
M. HVAC SYSTEM SUMMARY (See NRC-PRF-MECH-DETAILS for more information)
1. Equipment Name
2. Equipment Type
3. System Type (Single or Complex)
4. Qty
5. Total Heating Output (Btu/h)
6. Supply Heat Source (T/F/N)
7. Supply Heat Output (Btu/h)
8. Total Cooling Output (Btu/h)
9. Efficiency
10. Acceptance Testing Required (Y/N)
11. Confirmed

N. ECONOMIZER & FAN SYSTEMS SUMMARY
1. Equipment Name
2. Outside Air
3. Supply Fan
4. Return Fan
5. Economizer Type (if present)
6. Confirmed

CA Building Energy Efficiency Standards- 2016 Nonresidential Compliance
Report Version: NRC-PRF-01-6-07112018-6302
Report Generated on: 2018-07-13 11:09:54

Performance Runs and Orientation Table
PC Design Review Information
Title 24, Part 6, Energy
Date of Title 24 Report: 7/12/2018
Model Name and Option: 24x40 PC
Total Floor Area: 960
HVAC System Type: SPVHP
Climate Zone (Reference City)
Azimuth (Front Orientation)
TDV- Proposed Design
TDV- Standard Design
Compliance Margin

Performance Runs and Orientation Table
PC Design Review Information
Title 24, Part 6, Energy Code
Date of Title 24 Report: 7/13/2018
Model Name and Option: 120x40 PC
Total Floor Area: 4800
HVAC System Type: SPVHP
Climate Zone (Reference City)
Azimuth (Front Orientation)
TDV- Proposed Design
TDV- Standard Design
Compliance Margin

ENVIROPLEX, INC.
4777 E. CARPENTER ROAD STOCKTON, CA 95215, (209) 468-8000
CESAR CHAVEZ HIGH SCHOOL - ATHLETIC FACILITY
STOCKTON UNIFIED SCHOOL DISTRICT
2929 WINDFLOWER LANE STOCKTON, CA 95212
ENERGY COMPLIANCE
CLIMATE ZONES 1-16
REV / DATE:
BY:
JOB No.:
DRAWN BY:
DATE:
IDENTIFICATION STAMP
DIVISION OF THE STATE ARCHITECT
APP. 02-116094
DATE: 9-6-2018
EN1



Project Name: Standard 24x40 PC - 2016 code
Project Address: C2 14 (reference city - Palmdale)
Compliance Scope: New/Complete
Q. EQUIPMENT CONTROLS
R. SYSTEM DISTRIBUTION SUMMARY
S. INDOOR CONDITIONED LIGHTING GENERAL INFO

Project Name: Standard 24x40 PC - 2016 code
Project Address: C2 14 (reference city - Palmdale)
Compliance Scope: New/Complete
R. INDOOR CONDITIONED LIGHTING SCHEDULE
S1. COVERED PROCESS SUMMARY - ENCLOSED PARKING GARAGES
S2. COVERED PROCESS SUMMARY - COMMERCIAL KITCHENS
S3. COVERED PROCESS SUMMARY - COMPUTER ROOMS
S4. COVERED PROCESS SUMMARY - LABORATORY EXHAUSTS
T. UNMET LOAD HOURS
U. ENERGY USE SUMMARY

Project Name: Standard 24x40 PC - 2016 code
Project Address: C2 14 (reference city - Palmdale)
Compliance Scope: New/Complete
U. ENERGY USE SUMMARY

Project Name: Standard 24x40 PC - 2016 code
Project Address: C2 14 (reference city - Palmdale)
Compliance Scope: New/Complete
DOCUMENTATION AUTHORITY'S DECLARATION STATEMENT
RESPONSIBLE PERSON'S DECLARATION STATEMENT

Project Name: Standard 24x40 PC - 2016 code
Project Address: C2 14 (reference city - Palmdale)
Compliance Scope: New/Complete
NRCC-PRF-ENV-DETAILS -SECTION START-
A. OPAQUE SURFACE ASSEMBLY DETAILS
B. OVERHANG DETAILS
C. OPAQUE DOOR SUMMARY

Project Name: Standard 24x40 PC - 2016 code
Project Address: C2 14 (reference city - Palmdale)
Compliance Scope: New/Complete
NRCC-PRF-MCH-DETAILS -SECTION START-
A. MECHANICAL VENTILATION AND REHAT
B. ZONAL SYSTEM AND TERMINAL UNIT SUMMARY
C. EXHAUST FAN SUMMARY
D. DHW EQUIPMENT SUMMARY

Project Name: Standard 24x40 PC - 2016 code
Project Address: C2 14 (reference city - Palmdale)
Compliance Scope: New/Complete
H. MULTI-FAMILY CENTRAL DHW SYSTEM DETAILS
I. SOLAR HOT WATER HEATING SUMMARY
J. MECHANICAL HVAC ACCEPTANCE TESTS & NORMS
K. EVAPORATIVE COOLER SUMMARY



Project Name: Standard 24x40 PC - 2016 code
Project Address: C2 14 (reference city - Palmdale)
Compliance Scope: New/Complete
NRCC-PRF-LTI-DETAILS -SECTION START-
A. INDOOR CONDITIONED LIGHTING CONTROL CREDITS
B. INDOOR CONDITIONED LIGHTING MANDATORY LIGHTING CONTROLS
C. TAILORED METHOD CONDITIONED LIGHTING POWER ALLOWANCE SUMMARY AND CHECKLIST
D. GENERAL LIGHTING POWER
E. GENERAL LIGHTING FROM SPECIAL FUNCTION AREAS

Project Name: Standard 24x40 PC - 2016 code
Project Address: C2 14 (reference city - Palmdale)
Compliance Scope: New/Complete
F. ROOM CAVITY RATIO
G. ADDITIONAL "USE IT OR LOSE IT"

CA Building Energy Efficiency Standards - 2016 Nonresidential Compliance
Report Version: NRCC-PRF-02-6-07132018-5302
Report Generated on: 2018-07-13 11:29:54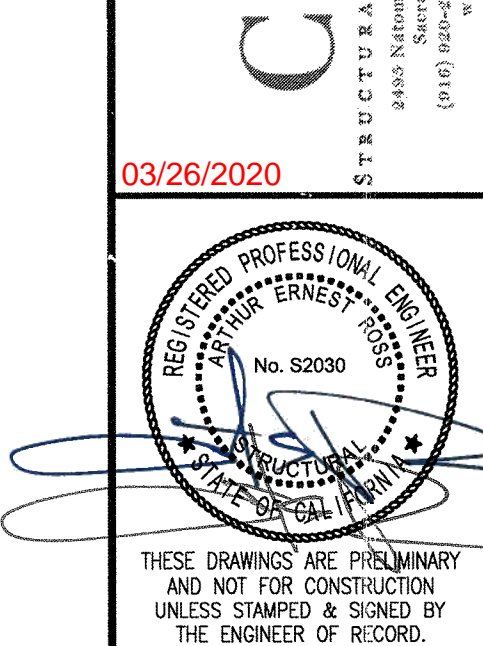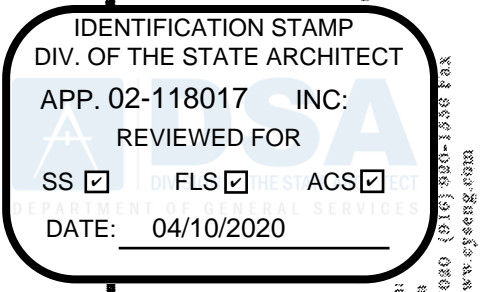

ENVIROPLEX, INC.
4777 E. CARPENTER ROAD STOCKTON, CA. 95215, (209) 466-8000
CESAR CHAVEZ HIGH SCHOOL - ATHLETIC FACILITY
STOCKTON UNIFIED SCHOOL DISTRICT
2929 WINDFLOWER LANE STOCKTON, CA 95212

ENERGY COMPLIANCE
CLIMATE ZONES 1-16

REV / DATE:
BY:
JOB No.:
DRAWN BY:
DATE:
IDENTIFICATION STAMP DIVISION OF THE STATE ARCHITECT APP. 02-118017 INC. DATE: 9-6-2018

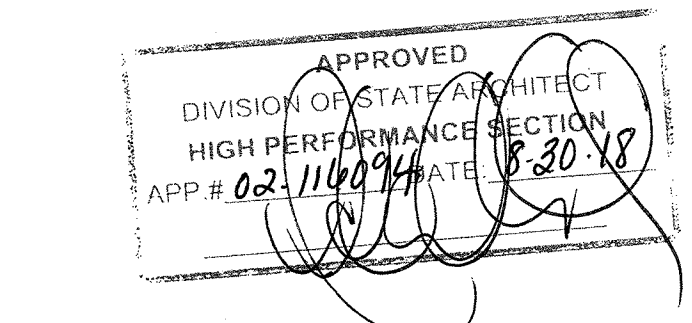

PRE-CHECK (PC) DOCUMENT
Code: 2016-03C
A separate project application for construction is required.

CONFIDENTIAL MATERIAL- THESE DOCUMENTS ARE THE PROPERTY OF AND ARE NOT TO BE REPRODUCED OR DISTRIBUTED WITHOUT FULL KNOWLEDGE AND WRITTEN CONSENT FROM ENVIROPLEX, INC.
© COPYRIGHT ENVIROPLEX, INC. (ALL DRAWINGS PREPARED BY ENVIROPLEX, INC.)



CA Building Energy Efficiency Standards- 2016 Nonresidential Compliance      Report Version: NRCC-PDF-01-E-07112018-6302      Report Generated at: 2018-07-12 11:28:54

STATE OF CALIFORNIA  
**Indoor Lighting**  
NRC-174 (Revised 10/18)

CALIFORNIA ENERGY COMMISSION

NRC-174  
Page 4 of 4  
7/15/2018

---

**CERTIFICATE OF COMPLIANCE**

Project Name: Standard 24400 FC

Project Address: CZ 14

Report Pages: 1

Date Prepared: 7/15/2018

---

**N. ADDITIONAL LIGHTING ALLOWANCE: TAILORED WALL DISPLAY**

*This Section Does Not Apply*

---

**O. ADDITIONAL LIGHTING ALLOWANCE: TAILORED FLOOR AND TASK LIGHTING**

*This Section Does Not Apply*

---

**P. ADDITIONAL LIGHTING ALLOWANCE: TAILORED ORNAMENTAL/SPECIAL EFFECTS**

*This Section Does Not Apply*

---

**Q. ADDITIONAL LIGHTING ALLOWANCE: TAILORED VERY VALUABLE MERCHANDISE**

*This Section Does Not Apply*

---

**R. POWER ADJUSTMENT: LIGHTING CONTROL CREDIT (PAF)**

*Table instructions: Please complete the table for all areas included in Table 1 or Table 1.4 as using a PAF credit described in §140.6(a)(2).*

| Conditioned Spaces |   |    |    |    |     |     |    |                               |                        |                    |                                   |   |    |  |    |    |  |   |  |
|--------------------|---|----|----|----|-----|-----|----|-------------------------------|------------------------|--------------------|-----------------------------------|---|----|--|----|----|--|---|--|
| Area Description   | 01  |    | 02 |    |     |     | 03 |                               | 04                     |                    | 05                                |   | 06 |  | 07 |    |  |   |  |
|                    | PAF per §140.6(a)(2)                          |    |    |    |     |     |    |                               |                        |                    |                                   | Luminaires Controlled for PAF Credit                      |    |  |    |    |  | Control Credit<br>Power Adjustment<br>(Watts) |  |
|                    | (*Can be used in conjunction with other PAFs) |    |    |    |     |     |    |                               |                        |                    |                                   |   |    |  |    |    |  |   |  |
|                    | 1   | 2A | 2B | 2C | 3A* | 3B* | 4* | Luminaire Name<br>or Item Tag | Watts per<br>Luminaire | # of<br>Luminaires | Lighting<br>Controlled<br>(Watts) |   |    |  |    |    |  |   |  |
| Classroom          |   |    |    |    |     |     |    |                               | A                      | 88                 | 10                                | 880   |    |  |    | 55 |  |   |  |
|                    |   |                    |   |    |    |    |     |     |    |                               |                        |                    |                                   | <b>Total Power Adjustment (Watts) CONDITIONED SPACES:</b> |    |  |    |    |  |   |  |
|                    |   |    |    |    |     |     |    |                               |                        |                    |                                   |   |    |  |    |    |  | 08  |  |
|                    |   |    |    |    |     |     |    |                               |                        |                    |                                   |   |    |  |    |    |  | 88  |  |

---

**S. RATED POWER REDUCTION COMPLIANCE BY SPACE**

*This Section Does Not Apply*

---

CA Building Energy Efficiency Standards - 2018 floor-to-ceiling Compliance <http://www.energy.ca.gov/59604/2018standards>

March 2018

| <b>STATE OF CALIFORNIA</b>  |                                  | CALIFORNIA ENERGY CONSERVATION<br>Title 24, Part 6, Chapter 3.2  |  |
|---|----------------------------------|--|--|
| <b>Indoor Lighting</b><br><small>HSCA-1.1 (Revised 1/18)</small>  |                                  |  |  |
| <b>CERTIFICATE OF COMPLIANCE</b>  |                                  | <b>NRC-LT-14</b>   |  |
| Project Name: Standard 3404G PC   |                                  | Page 5 of 7  |  |
| Project Address: CE 34  |                                  | 7/15/2018  |  |
| <b>T. DECLARATION OF REQUIRED CERTIFICATES OF INSTALLATION</b>  |                                  |  |  |
| Table Instructions: Selections have been made based on information provided in previous tables of this document. If any selection needs to be changed, please explain why in Table E. Additional Remarks. These documents must be provided to the building inspector during construction and can be found online at <a href="http://www.energy.ca.gov/PDF/Evaluation/PDF-EPS-2014-2016-CEC-3404G-PDF-Evaluation-Forms.html">http://www.energy.ca.gov/PDF/Evaluation/PDF-EPS-2014-2016-CEC-3404G-PDF-Evaluation-Forms.html</a> . |                                  |  |  |
| YES   | NO                               | Form/Title   | Field Inspector<br>Pass Fail                         |
| <input checked="" type="radio"/>  | <input type="radio"/>            | NRCA-LT-01-E : Must be submitted for all buildings.  | <input type="checkbox"/><br><input type="checkbox"/> |
| <input checked="" type="radio"/>  | <input type="radio"/>            | NRCA-LT-02-E : Must be submitted for a lighting control system, or for an Energy Management Control System (EMCS), to be recognized for compliance.  | <input type="checkbox"/><br><input type="checkbox"/> |
| <input type="radio"/>   | <input checked="" type="radio"/> | NRCA-LT-03-E : Must be submitted for a line-voltage track lighting integral current limiter, or for a supplementary overcurrent protection panel used to energize only line-voltage track lighting, to be recognized for compliance. | <input type="checkbox"/><br><input type="checkbox"/> |
| <input type="radio"/>   | <input checked="" type="radio"/> | NRCA-LT-04-E : Must be submitted for two Intelluctra systems serving an auditorium, a convention center, a conference room, a multipurpose room, or a theater to be recognized for compliance.                                       | <input type="checkbox"/><br><input type="checkbox"/> |
| <input checked="" type="radio"/>  | <input type="radio"/>            | NRCA-LT-05-E : Must be submitted for a Power Adjustment Factor (PAF) to be recognized for compliance.  | <input type="checkbox"/><br><input type="checkbox"/> |
| <input type="radio"/>   | <input checked="" type="radio"/> | NRCA-LT-06-E : Must be submitted for additional wattage installed in a video conferencing studio to be recognized for compliance.  | <input type="checkbox"/><br><input type="checkbox"/> |

| STATE OF CALIFORNIA<br><b>Indoor Lighting</b><br>LSC-001's Section 0180  |  | CALIFORNIA ENERGY COMMISSION<br>NREL-CA<br>Page 6 of 7<br>7/13/2018  |  |
|--|--|--|--|
| <b>CERTIFICATE OF COMPLIANCE</b><br>Project Name: Standard 24x40 PK<br>Project Address: CZ 14  |  | Report Page:<br>Date Prepared:   |  |
| <b>DOCUMENTATION AUTHORITY'S DECLARATION STATEMENT</b><br>Documentation Authority Name: Luis Esquivel<br>Company: Enviroplex, Inc.<br>Address: 4777 E. Carpenter Road<br>City/State/Zip: Stockton, CA 95215  |  | Documented Author Signature: [Signature]<br>Signature Date: 7/16/2018<br>CEA/HENS Certification Identification (if applicable):<br>Phone: (209) 468-8000 |  |
| <b>RESPONSIBLE PERSON'S DECLARATION STATEMENT</b><br>I certify the following under penalty of perjury, under the laws of the State of California:<br>1. The information provided on this Certificate of Compliance is true and correct.<br>2. I am eligible under Division 3 of the Business and Professions Code to accept responsibility for the building design or system design identified on this Certificate of Compliance (responsible design).<br>3. The energy features and performance specifications, materials, components, and manufactured devices for the building design or system design identified on this Certificate of Compliance conform to the requirements of Title 24, Part 1 and Part 6 of the California Code of Regulations.<br>4. The building design features or system design features identified on this Certificate of Compliance are consistent with the information provided on other applicable compliance documents, worksheets, calculations, plans and specifications submitted to the enforcement agency for approval with this building permit application.<br>5. I will ensure that a completed signed copy of this Certificate of Compliance shall be made available with the building permit(s) issued for the building, and made available to the enforcement agency for all applicable inspections. I understand that a completed signed copy of this Certificate of Compliance is required to be included with the documentation the builder provides to the building owner at occupancy. |  |  |  |
| Responsible Designer Name: Luis Esquivel<br>Company: Enviroplex, Inc.<br>Address: 4777 E. Carpenter Road<br>City/State/Zip: Stockton, CA 95215   |  | Responsible Designer Signature: [Signature]<br>Date Signed: 7/16/2018<br>License: 640587<br>Phone: (209) 468-8000  |  |

STRUCTURAL  
6482 N. Belmont  
(910) 844-2141  
W

03/26/2020

REGISTERED PROFESSIONAL ENGINEER  
"ERNEST" ROSS  
No. S2030  
STATE OF TEXAS  
THESE DRAWINGS ARE PRELIMINARY  
AND NOT FOR CONSTRUCTION  
UNLESS STAMPED & SIGNED BY  
THE ENGINEER OF RECORD.

**ENVIROPLEX, INC.**  
 4777 E. CARPENTER ROAD STOCKTON, CA 95215, (209) 466-8000  
 PEEBLES CHAVEZ HIGH SCHOOL - ATHLETIC FACILITY  
 STOCKTON UNIFIED SCHOOL DISTRICT  
 2929 WINDFLOWER LANE STOCKTON, CA 95212

**ENERGY COMPLIANCE  
CLIMATE ZONES 1-16**

|             |     |
|-------------|-----|
| REV / DATE: | BY: |
|             |     |
|             |     |
| JOB No.:    |     |
| DRAWN BY:   |     |
| DATE:       |     |

**IDENTIFICATION STAMP**

**DIVISION OF THE STATE ARCHITECT**

**02-11094**

AC *W* FLS — SS *681*

DATE: **9-6-2018**

APPROVED  
DIVISION OF STATE ARCHITECT  
HIGH PERFORMANCE SECTION  
APP.# 02-116094 DATE: 8/30/8

~~PRE CHECK (PC) DOCUMENT~~  
~~Code: 2016 CBC~~  
~~A separate project application for construction is required.~~



STATE OF CALIFORNIA
Outdoor Lighting
CERTIFICATE OF COMPLIANCE
Project Name: Standard 24x40 PC
Project Address: CZ 14
Report Page: Page 1 of 6
Date Prepared: 8/28/2018

A. GENERAL INFORMATION
01 Project Location (city) (reference city - Palmdale)
02 Climate Zone 14
03 Outdoor Lighting Zone per Table 24, Part 1 130-134 or as designated by Authority Having Jurisdiction (AHJ):
04 Total Illuminated Landscape Area (ft²) 0

B. PROJECT SCOPE
Table Instructions: Include any outdoor lighting systems that are within the scope of the permit application and are demonstrating compliance using the prescriptive path outlined in §160.7 or §161.0(b)(2) for alterations.
My project consists of:
01 New Lighting System
02 Must Comply with Allowances from §160.7
03 Altered Lighting System
04 Is your alteration increasing the connected lighting load (watts)? Yes No

C. COMPLIANCE RESULTS
Table Instructions: If any cell on this table says "DOES NOT COMPLY" or "COMPLIES with Exceptional Conditions" refer to Table 2, for guidance.
Calculation of Total Allowed Lighting Power (Watts) §160.7 or §161.0(b)(2)
Compliance Results

STATE OF CALIFORNIA
Outdoor Lighting
CERTIFICATE OF COMPLIANCE
Project Name: Standard 24x40 PC
Project Address: CZ 14
Report Page: Page 2 of 6
Date Prepared: 8/28/2018

D. EXCEPTIONAL CONDITIONS
This table is auto-filled with uneditable comments because of selections made or data entered in tables throughout the form.
No exceptional conditions apply to this project.

E. ADDITIONAL REMARKS
This table includes remarks made by the permit applicant to the Authority Having Jurisdiction.

F. OUTDOOR LIGHTING FIXTURE SCHEDULE
This Section Does Not Apply

G. OUTDOOR LIGHTING FIXTURE SCHEDULE
Table Instructions: For new or altered lighting systems demonstrating compliance with §160.7 (if Table 1 has been expanded for input), include all luminaires being installed and any existing luminaires remaining or being moved within the space covered by the permit application in the Table below. For altered lighting systems using the Existing Power method per §161.0(b)(2), if Table 1 has been expanded for input, include only new luminaires being installed and replacement luminaires being installed as part of the project scope (i.e., do not include existing luminaires remaining or existing luminaires being moved).

STATE OF CALIFORNIA
Outdoor Lighting
CERTIFICATE OF COMPLIANCE
Project Name: Standard 24x40 PC
Project Address: CZ 14
Report Page: Page 1 of 6
Date Prepared: 8/28/2018

H. OUTDOOR LIGHTING CONTROLS
Table Instructions: Complete this table demonstrating compliance with controls requirements for all new or altered luminaires installed as part of the permit application. For alteration projects, luminaires which are existing to remain (ie untouched) and luminaires which are removed and reinstalled (twing only) do not need to be included in this table even if they are within the space covered by the permit application.
When an option having a "1" is selected, the notes section of this table must be completed. The lighting controls section of the Compliance Summary Table on the first page will show "DOES NOT COMPLY" if the notes are left blank. For each requirement in columns 02 through 07, do not leave the field blank, instead select N/A or Exempt\* from the dropdown list to indicate not applicable or an exemption.

I. LIGHTING POWER ALLOWANCE (per §160.7)
Table Instructions: Please complete this table for areas using the allowance calculations per §160.7. General Hardship Allowance is per Table 160.7(d) while "Use it or lose it" Allowance are per Table 160.7(e). Indicate which allowances are being used to expand sections for user input. Luminaires that qualify for one of the "Use it or lose it" allowances shall not qualify for another "Use it or lose it" allowance.

STATE OF CALIFORNIA
Outdoor Lighting
CERTIFICATE OF COMPLIANCE
Project Name: Standard 24x40 PC
Project Address: CZ 14
Report Page: Page 4 of 6
Date Prepared: 8/28/2018

Table Instructions: Please complete this table for areas using the wattage allowance per application from Table 160.7-B.
01 Area Description
02 Application per Table 160.7-B
03 CALCULATED ALLOWANCE (Watts)
04 # of Locations
05 Allowance per Location (Watts)
06 Extra Allowance (Watts)
07 Luminaires Name or Item Tag
08 Watts per Luminaire
09 # of Luminaires
10 Design Watts
11 Additional Allowance (Watts)

\* FOOTNOTES: Primary entrance applications are only available for senior care facilities, police stations, hospitals, fire stations, and emergency vehicle facilities.
\* The Allowance per Location for ATMs is 250W for the first ATM and 70W for each additional per Table 160.7-B.

K. LIGHTING ALLOWANCE: SALES FRONTAGE
This Section Does Not Apply

L. LIGHTING ALLOWANCE: ORNAMENTAL
This Section Does Not Apply

M. LIGHTING ALLOWANCE: PER SPECIFIC AREA
This Section Does Not Apply

N. EXISTING CONDITIONS POWER ALLOWANCE (alterations only)
This Section Does Not Apply

STATE OF CALIFORNIA
Outdoor Lighting
CERTIFICATE OF COMPLIANCE
Project Name: Standard 24x40 PC
Project Address: CZ 14
Report Page: Page 5 of 6
Date Prepared: 8/28/2018

O. DECLARATION OF REQUIRED CERTIFICATES OF INSTALLATION
Table Instructions: Selections have been made based on information provided in previous tables of this document. If any selection needs to be changed, please explain why in Table E, Additional Remarks. These documents must be provided to the building inspector during construction and can be found online at: https://www.enviroplex.com/2018publications/CIC-200-2018-018/owner/signatures/NOI/

P. DECLARATION OF REQUIRED CERTIFICATES OF ACCEPTANCE
Table Instructions: Selections have been made based on information provided in previous tables of this document. If any selection needs to be changed, please explain why in Table E, Additional Remarks. These documents must be provided to the building inspector during construction and must be completed through an Acceptance Test Technician Certification Provider (ATTCPP). For more information visit: https://www.enviroplex.com/2018publications/ATTCPP/

STATE OF CALIFORNIA
Outdoor Lighting
CERTIFICATE OF COMPLIANCE
Project Name: Standard 24x40 PC
Project Address: CZ 14
Report Page: Page 6 of 6
Date Prepared: 8/28/2018

DOCUMENTATION AUTHOR'S DECLARATION STATEMENT
Documentation Author Name: Luis Esquivel
Documentation Author Signature: Luis Esquivel
Company: Enviroplex, Inc.
Signature Date: 8/28/2018
Address: 4777 E. Carpenter Road
CEA/HERS Certification Identification (if applicable):
City/State/Zip: Stockton, CA 95215
Phone: (209) 466-8000

RESPONSIBLE PERSON'S DECLARATION STATEMENT
I certify the following under penalty of perjury, under the laws of the State of California:
1. The information provided on this Certificate of Compliance is true and correct.
2. I am eligible under Division 3 of the Business and Professions Code to accept responsibility for the building design or system design identified on this Certificate of Compliance (responsible designer).
3. The energy features and performance specifications, materials, components, and manufactured devices for the building design or system design identified on this Certificate of Compliance conform to the requirements of Title 24, Part 1 and Part 6 of the California Code of Regulations.
4. The building design features or system design features identified on this Certificate of Compliance are consistent with the information provided on other applicable compliance documents, worksheets, calculations, plans and specifications submitted to the enforcement agency for approval with this building permit application.
5. I will ensure that a completed signed copy of this Certificate of Compliance shall be made available with the building permit(s) issued for the building, and made available to the enforcement agency for all applicable inspections. I understand that a completed signed copy of this Certificate of Compliance is required to be included with the documentation the builder provides to the building owner at occupancy.

ENVELOPE MANDATORY MEASURES: NONRESIDENTIAL ENV-MM
Project Name: Standard 24x40 PC
Date: 8/28/2018

DESCRIPTION
Building Envelope Measures:
§110.8(a) Installed Insulating material shall have been certified by the manufacturer to comply with the California Quality Standards for Insulating material, Title 20 Chapter 4, Article 3.
§110.8(b) All Insulating Materials shall be installed in compliance with the terms spread rating and smoke density requirements of Sections 2602 and 707 of Title 24, Part 2.
§110.8(c) Heated slab floors shall be insulated according to the requirements in Table 110.8-A.
§110.8(d) All Exterior Joints and openings in the building that are observable sources of air leakage shall be caulked, gasketed, weatherstripped or otherwise sealed.
§110.8(e) Manufactured fenestration products and exterior doors shall have air infiltration rates not exceeding 0.3 cfm/ft² of window area, 0.3 cfm/ft² of door area for residential doors, 0.3 cfm/ft² of door area for nonresidential single doors (swing and sliding), and 1.0 cfm/ft² for nonresidential double doors (swing and sliding).
§110.8(f) Fenestration U-factor shall be rated in accordance with NFRC 100, or the applicable default U-factor.
§110.8(g) Fenestration SHGC shall be rated in accordance with NFRC 200, or NFRC 100 for site-built fenestration, or the applicable default SHGC.
§110.8(h) Site Constructed Doors, Windows and Skylights shall be caulked between the unit and the building, and shall be weatherstripped (except for unit and glass doors and fire doors).
§120.7(a) The opaque portions of the roof/calling that separate conditioned spaces from unconditioned spaces or ambient air shall meet the applicable U-factor requirements as follows:
Metal Buildings- The weighted average U-factor of the roof assembly shall not exceed 0.098.
Wood Framed and Others- The weighted average U-factor of the roof assembly shall not exceed 0.075.
The opaque portions of walls that separate conditioned spaces from unconditioned spaces or ambient air shall meet the applicable U-factor as follows:
Metal Building- The weighted average U-factor of the wall assembly shall not exceed 0.113.
Metal Framed- The weighted average U-factor of the wall assembly shall not exceed 0.151.
Light Mass Walls- A 6 inch or greater Hollow Core Concrete Masonry Unit shall have a U-factor not to exceed 0.440.
Heavy Mass Walls- An 8 inch or greater Hollow Core Concrete Masonry Unit shall have a U-factor not to exceed 0.490.
Wood Framed and Others- The weighted average U-factor of the wall assembly shall not exceed 0.110.
Spendrel Panels and Opaque Curtain Wall- The weighted average U-factor of the spendrel panels and opaque curtain wall assembly shall not exceed 0.280.
Demising Walls- The opaque portions of framed demising walls shall meet the requirements of Item A or B below:
A. Wood framed walls shall be insulated to meet a U-factor not greater than 0.099.
B. Metal Framed walls shall be insulated to meet a U-factor not greater than 0.151.
The opaque portions of floors and roofs that separate conditioned spaces from unconditioned spaces or ambient air shall meet the applicable U-factor requirements as follows:
§120.7(c) Raised Mass Floors- Shall have a minimum of 3 inches of lightweight concrete over a metal deck or the weighted average U-factor of the floor assembly shall not exceed 0.269.
Other Floors- The weighted average U-factor of the floor assembly shall not exceed 0.071.

CA Building Energy Efficiency Standards - 2018 Nonresidential Compliance: http://www.energy.ca.gov/2018standards
September 2017

CA Building Energy Efficiency Standards - 2018 Nonresidential Compliance: http://www.energy.ca.gov/2018standards
September 2017

CONFIDENTIAL MATERIAL—THESE DOCUMENTS ARE THE PROPERTY OF AND ARE NOT TO BE REPRODUCED OR DISTRIBUTED WITHOUT FULL KNOWLEDGE AND WRITTEN CONSENT FROM ENVIROPLEX, INC.
© COPYRIGHT ENVIROPLEX, INC. (ALL DRAWINGS PREPARED BY ENVIROPLEX, INC.)

IDENTIFICATION STAMP
DIV. OF THE STATE ARCHITECT
APP. 02-118017 INC.
REVIEWED FOR
SS FLS ACS
DATE: 04/10/2020

03/26/2020

REGISTERED PROFESSIONAL ENGINEER
STRUCTURAL
No. 52030

THESE DRAWINGS ARE PRELIMINARY
AND NOT FOR CONSTRUCTION
UNLESS STAMPED & SIGNED BY
THE ENGINEER OF RECORD.

ENVIROPLEX, INC.
4777 E. CARPENTER ROAD STOCKTON, CA 95215, (209) 466-8000
CESAR CHAVEZ HIGH SCHOOL - ATHLETIC FACILITY
STOCKTON UNIFIED SCHOOL DISTRICT
2929 WINDFLOWER LANE STOCKTON, CA 95212

ENERGY COMPLIANCE
CLIMATE ZONES 1-16

REV / DATE: BY:

JOB No.:
DRAWN BY:
DATE:

IDENTIFICATION STAMP
DIVISION OF THE STATE ARCHITECT
APP # 02-118017 DATE 8/30/18

PRE-CHECK (PC) DOCUMENT
Code: 2016 CBC
A separate project application for construction is required.

02-118094
ACCS FLS SS
DATE: 9-6-2018


EN4

24x40 TO 20x40 P.C.








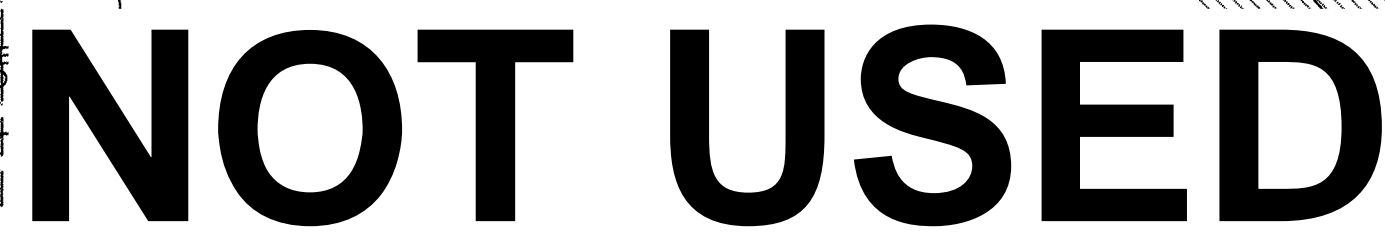

**LIGHTING PLAN**  
SCALE: 1/4" = 1'-0"

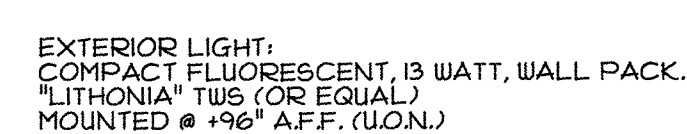

## LIGHTING LEGEND

1. LIGHTING FIXTURE:  
2' x 4' LED RECESSED TROFFER TYPE FIXTURES,  
W/W LOW VOLTAGE DIMMING CONTROL SIGNAL, MAXIMUM 6000 LUMENS, MAX 50W,  
"LITHONIA" 2GTL (OR EQUAL) .
2. DAYLIGHT CONTROL PHOTOCELL:  
ON/OFF AND AUTOMATIC DIMMING CONTROL, CEILING MOUNT, LOW VOLTAGE.  
"tLIGHT" nCM ADC OR nCM ADCX (OR EQUAL) .
3. LIGHT SWITCHES:  
ON/OFF & ON/OFF PLUS DIMMING, PUSH BUTTON, LOW VOLTAGE.  
"tLIGHT" nCM ADC OR nCM ADCX (OR EQUAL) .
4. OCCUPANCY SENSOR:  
LOW VOLTAGE, WALL MOUNT OR CEILING MOUNT.
5. RELAY CONTROL PANEL:  
RELAY DIMMING PANEL, NEMA 1 PLENUM RATED, SURFACE MOUNTED.  
W/ 30A RELAYS, LOW VOLTAGE DIMMING OUTPUTS, PHOTOCELL  
OUTPUTS, DRY CONTACT INPUTS, AND OPTIONAL VOLTAGE  
BARRIER FOR EM CIRCUITS.  
"ACUITY BRANDS" (OR EQUAL)
6. ILLUMINATED EXIT SIGNS:  
IF REQUIRED BY CODE, SHALL BE PROVIDED IN COMPLIANCE  
W/ C.B.C. 1013.
7. MEANS OF EGRESS ILLUMINATION:  
WHERE (2) OR MORE EXITS ARE REQUIRED, SUCH EXITS  
SHALL HAVE INTERIOR AND EXTERIOR LANDINGS  
ILLUMINATED BY FIXTURES CAPABLE OF AUTOMATIC  
EMERGENCY POWER OF NOT LESS THAN 90 MINUTES.  
(INCLUDES AISLES, UNENCLOSED STAIRWAYS, CORRIDORS,  
EXTERIOR EGRESS COMPONENTS AT OTHER THAN LEVEL  
OF DISCHARGE, LABS, SHOPS, AND WINDOWLESS AREAS  
WITH STUDENT OCCUPANCY) .  
SWITCHING OF EGRESS LIGHTING SHALL NOT BE ACCESSIBLE  
TO UNAUTHORIZED PERSONNEL PER C.B.C. 1008.
8. SKYLIGHTS ( IF OPTION IS INCLUDED IN SITE SPECIFIC PROJECT ) : GENERAL LIGHTING  
FIXTURES PLACED IN THE PRIMARY DAYLTZ ZONE OF SKYLIGHTS SHALL BE CONTROLLED IN  
RESPONSE TO AVAILABLE DAYLIGHTING.  
REFER TO SHEET A5.1 FOR SKYLIGHT FRAMING AND DETAILS.
9. ACCESSIBLE, INDEPENDENT SWITCHING OR A CONTROL DEVICE SHALL BE INCLUDED  
FOR ALL AREAS ENCLOSED BY CEILING HEIGHT PARTITIONS.
10. ALL OUTDOOR LIGHTING SHALL BE CONTROLLED BY A PHOTOCELL OR OUTDOOR  
ASTRONOMICAL TIME SWITCH CONTROL.
11. FOR NON-POLE MOUNTED LUMINAIRES OVER 30 WATTS EACH:  
OUTDOOR LIGHTING WHERE BOTTOM OF LUMINAIRE IS MOUNTED 24 FEET OR LESS ABOVE  
THE GROUND SHALL BE CONTROLLED BY MOTION SENSORS OR OTHER CONTROLS CAPABLE  
OF REDUCING THE LIGHTING POWER OF EACH LUMINAIRE BY 40 TO 80% IN RESPONSE  
TO THE AREA BEING VACATED.

## LIGHTING SPECIFICATIONS

DIVISION OF THE STATE ARCHITECT

~~PRE-CHECK (PC) DOCUMENT~~  
~~Code: 2016 CBC~~  
~~A separate project application for~~  
~~construction is required.~~

IDENTIFICATION STAMP  
DIV. OF THE STATE ARCHITECT  
APP. 02-118017 INC:  
REVIEWED FOR  
SS ☒ FLS ☒ ACS ☒  
DATE: 04/10/2020

03/26/2020



THESE DRAWINGS ARE PRELIMINARY  
AND NOT FOR CONSTRUCTION  
UNLESS STAMPED & SIGNED BY  
THE ENGINEER OF RECORD.

**ENVIROPLEX, INC.**  
 4777 E. CARPENTER ROAD STOCKTON, CA. 95215, (209) 466-8000  
**CESAR CHAVEZ HIGH SCHOOL - ATHLETIC FACILITY**  
 STOCKTON UNIFIED SCHOOL DISTRICT  
 2929 WINDEL OWEY LANE STOCKTON CA 95212

## LIGHTING PLAN & NOTES

|             |     |
|-------------|-----|
| REV / DATE: | BY: |
|             |     |
|             |     |
|           |  |
|-----------|--|
| JOB No.:  |  |
| DRAWN BY: |  |

|                      |  |
|----------------------|--|
| DATE:                |  |
| IDENTIFICATION STAND |  |


IDENTIFICATION STAMP  
DIVISION OF THE STATE ARCHITECT

02-115094

AC 911 FLS 12 SS 12  
DATE 9-6-2018  
2018 - 24x40

### A3.1



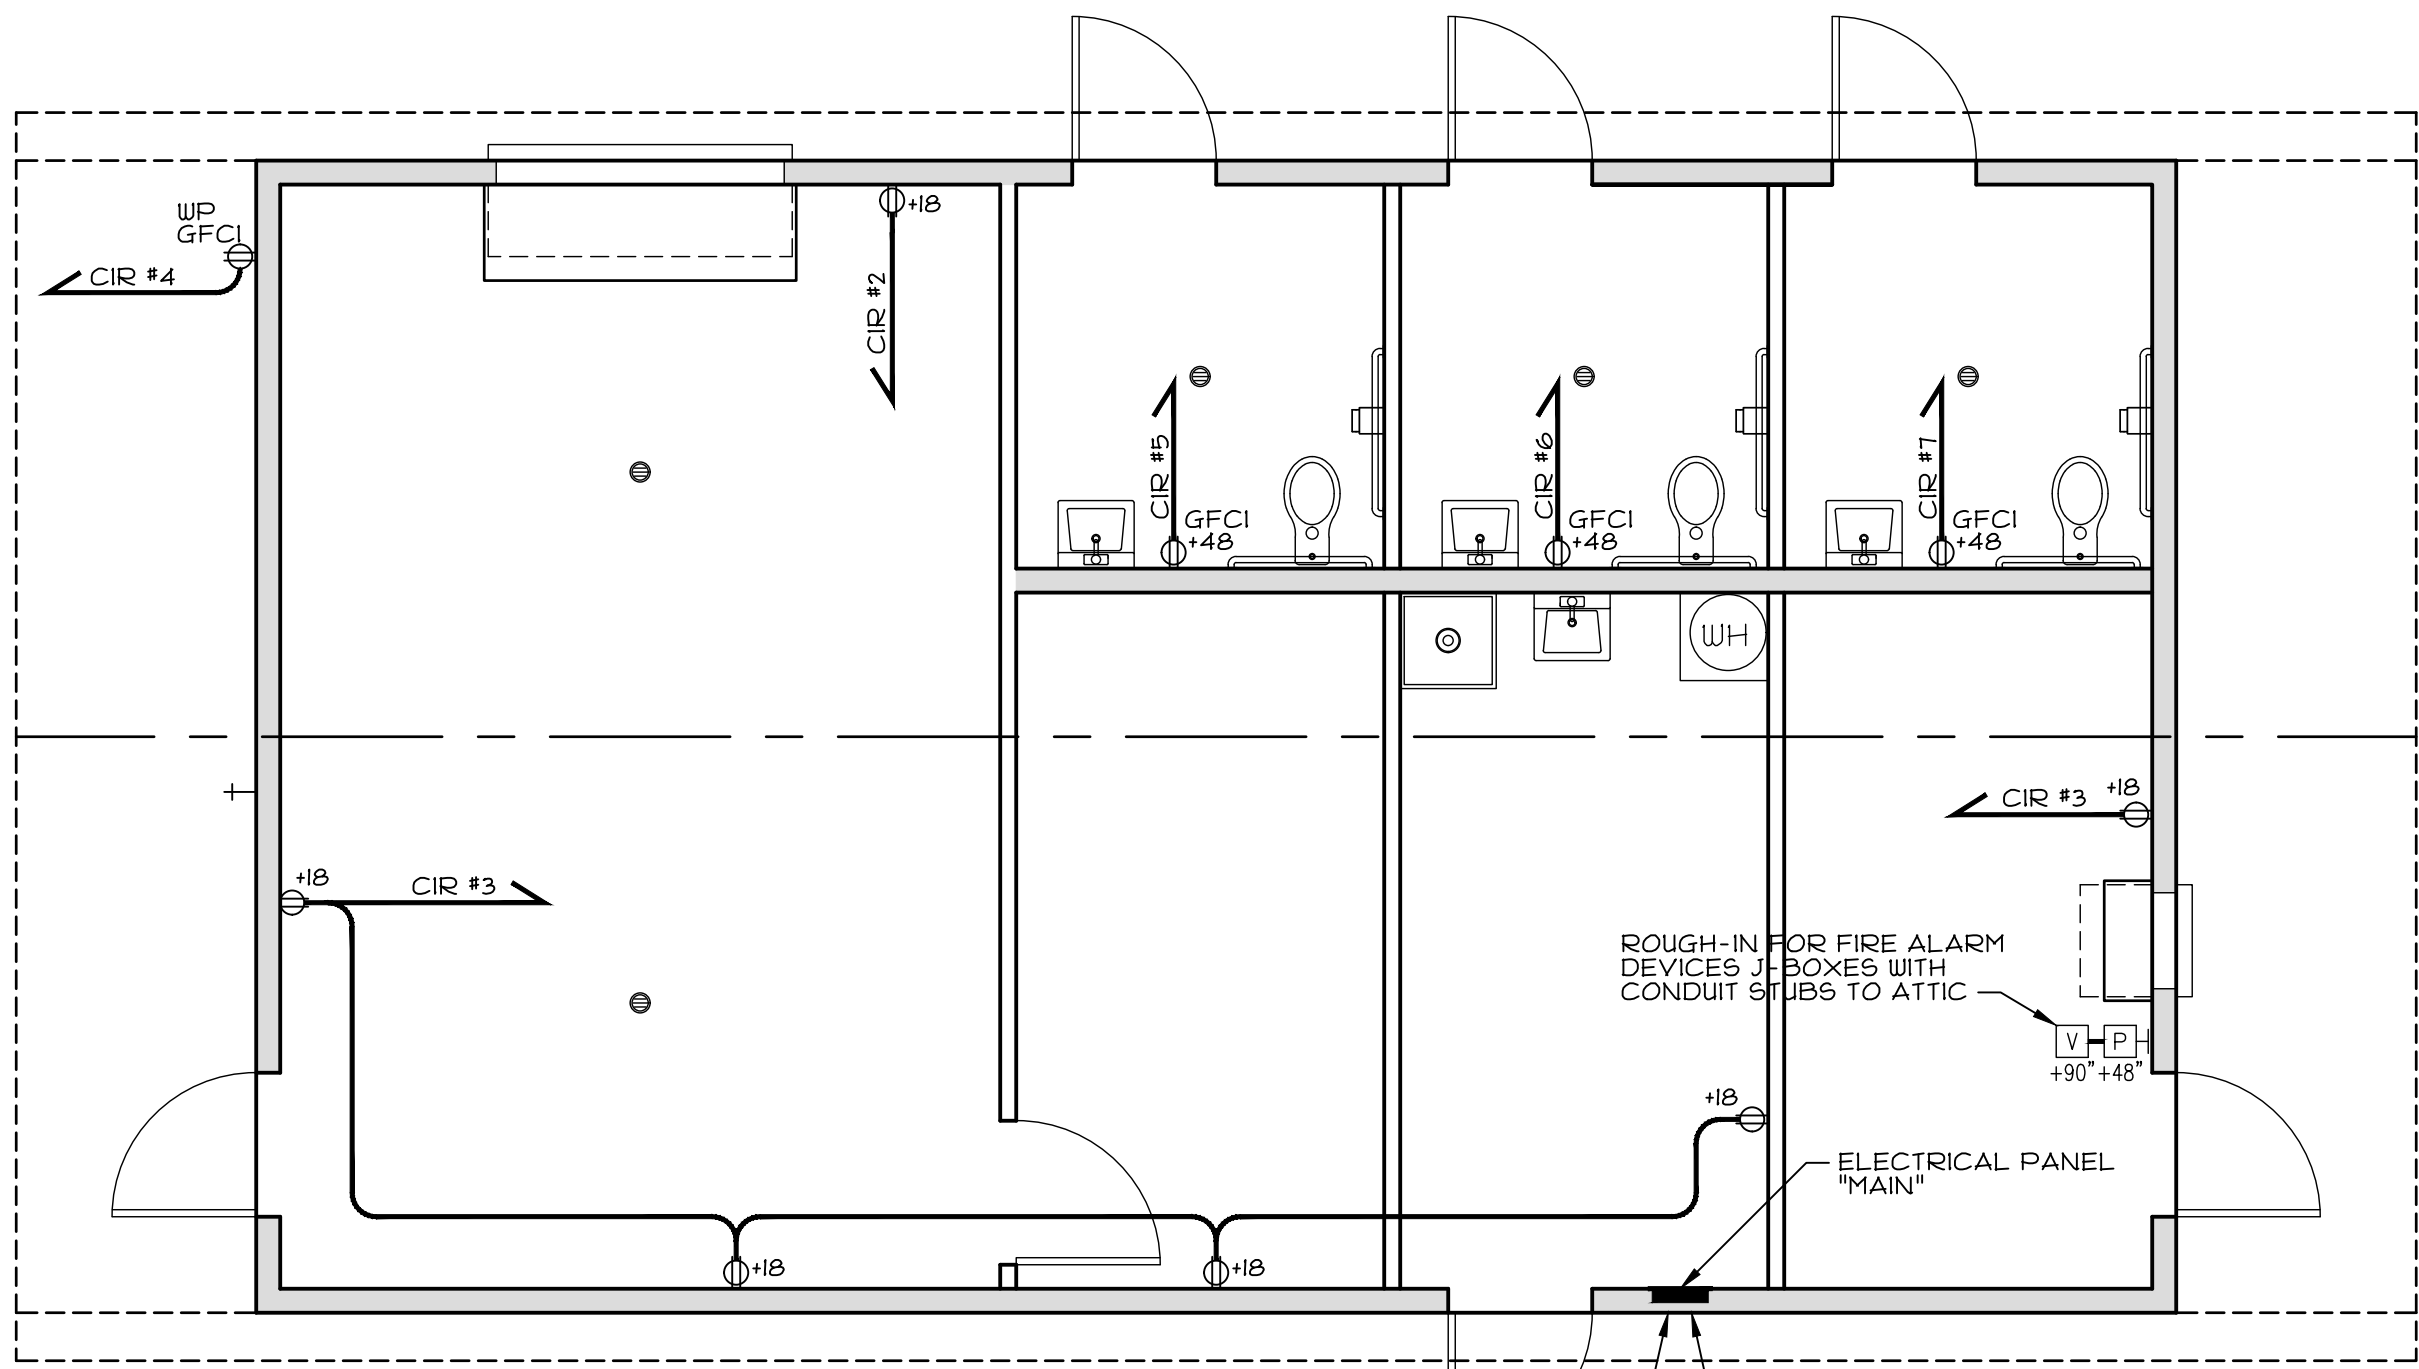


PROVIDE 1-1/2" & 3/4" NIPPLE FROM PANEL TO EXTERIOR FOR FUTURE CONNECTION OF POWER & GROUND. SEE DETAIL 6/A3

FUTURE SOLAR: THE STUD BAY ADJACENT TO ELECTRICAL PANEL SHALL BE THE DESIGNATED LOCATION OF INVERTERS, METERING EQUIPMENT, AND PATHWAY ROUTE THROUGH ROOF FOR CONDUIT.

NOTE:  
SEE SHEET A3 FOR LEGEND  
AND SPECIFICATIONS

### ELECTRICAL POWER & SIGNAL PLAN

SCALE: 1/4"=1'-0"

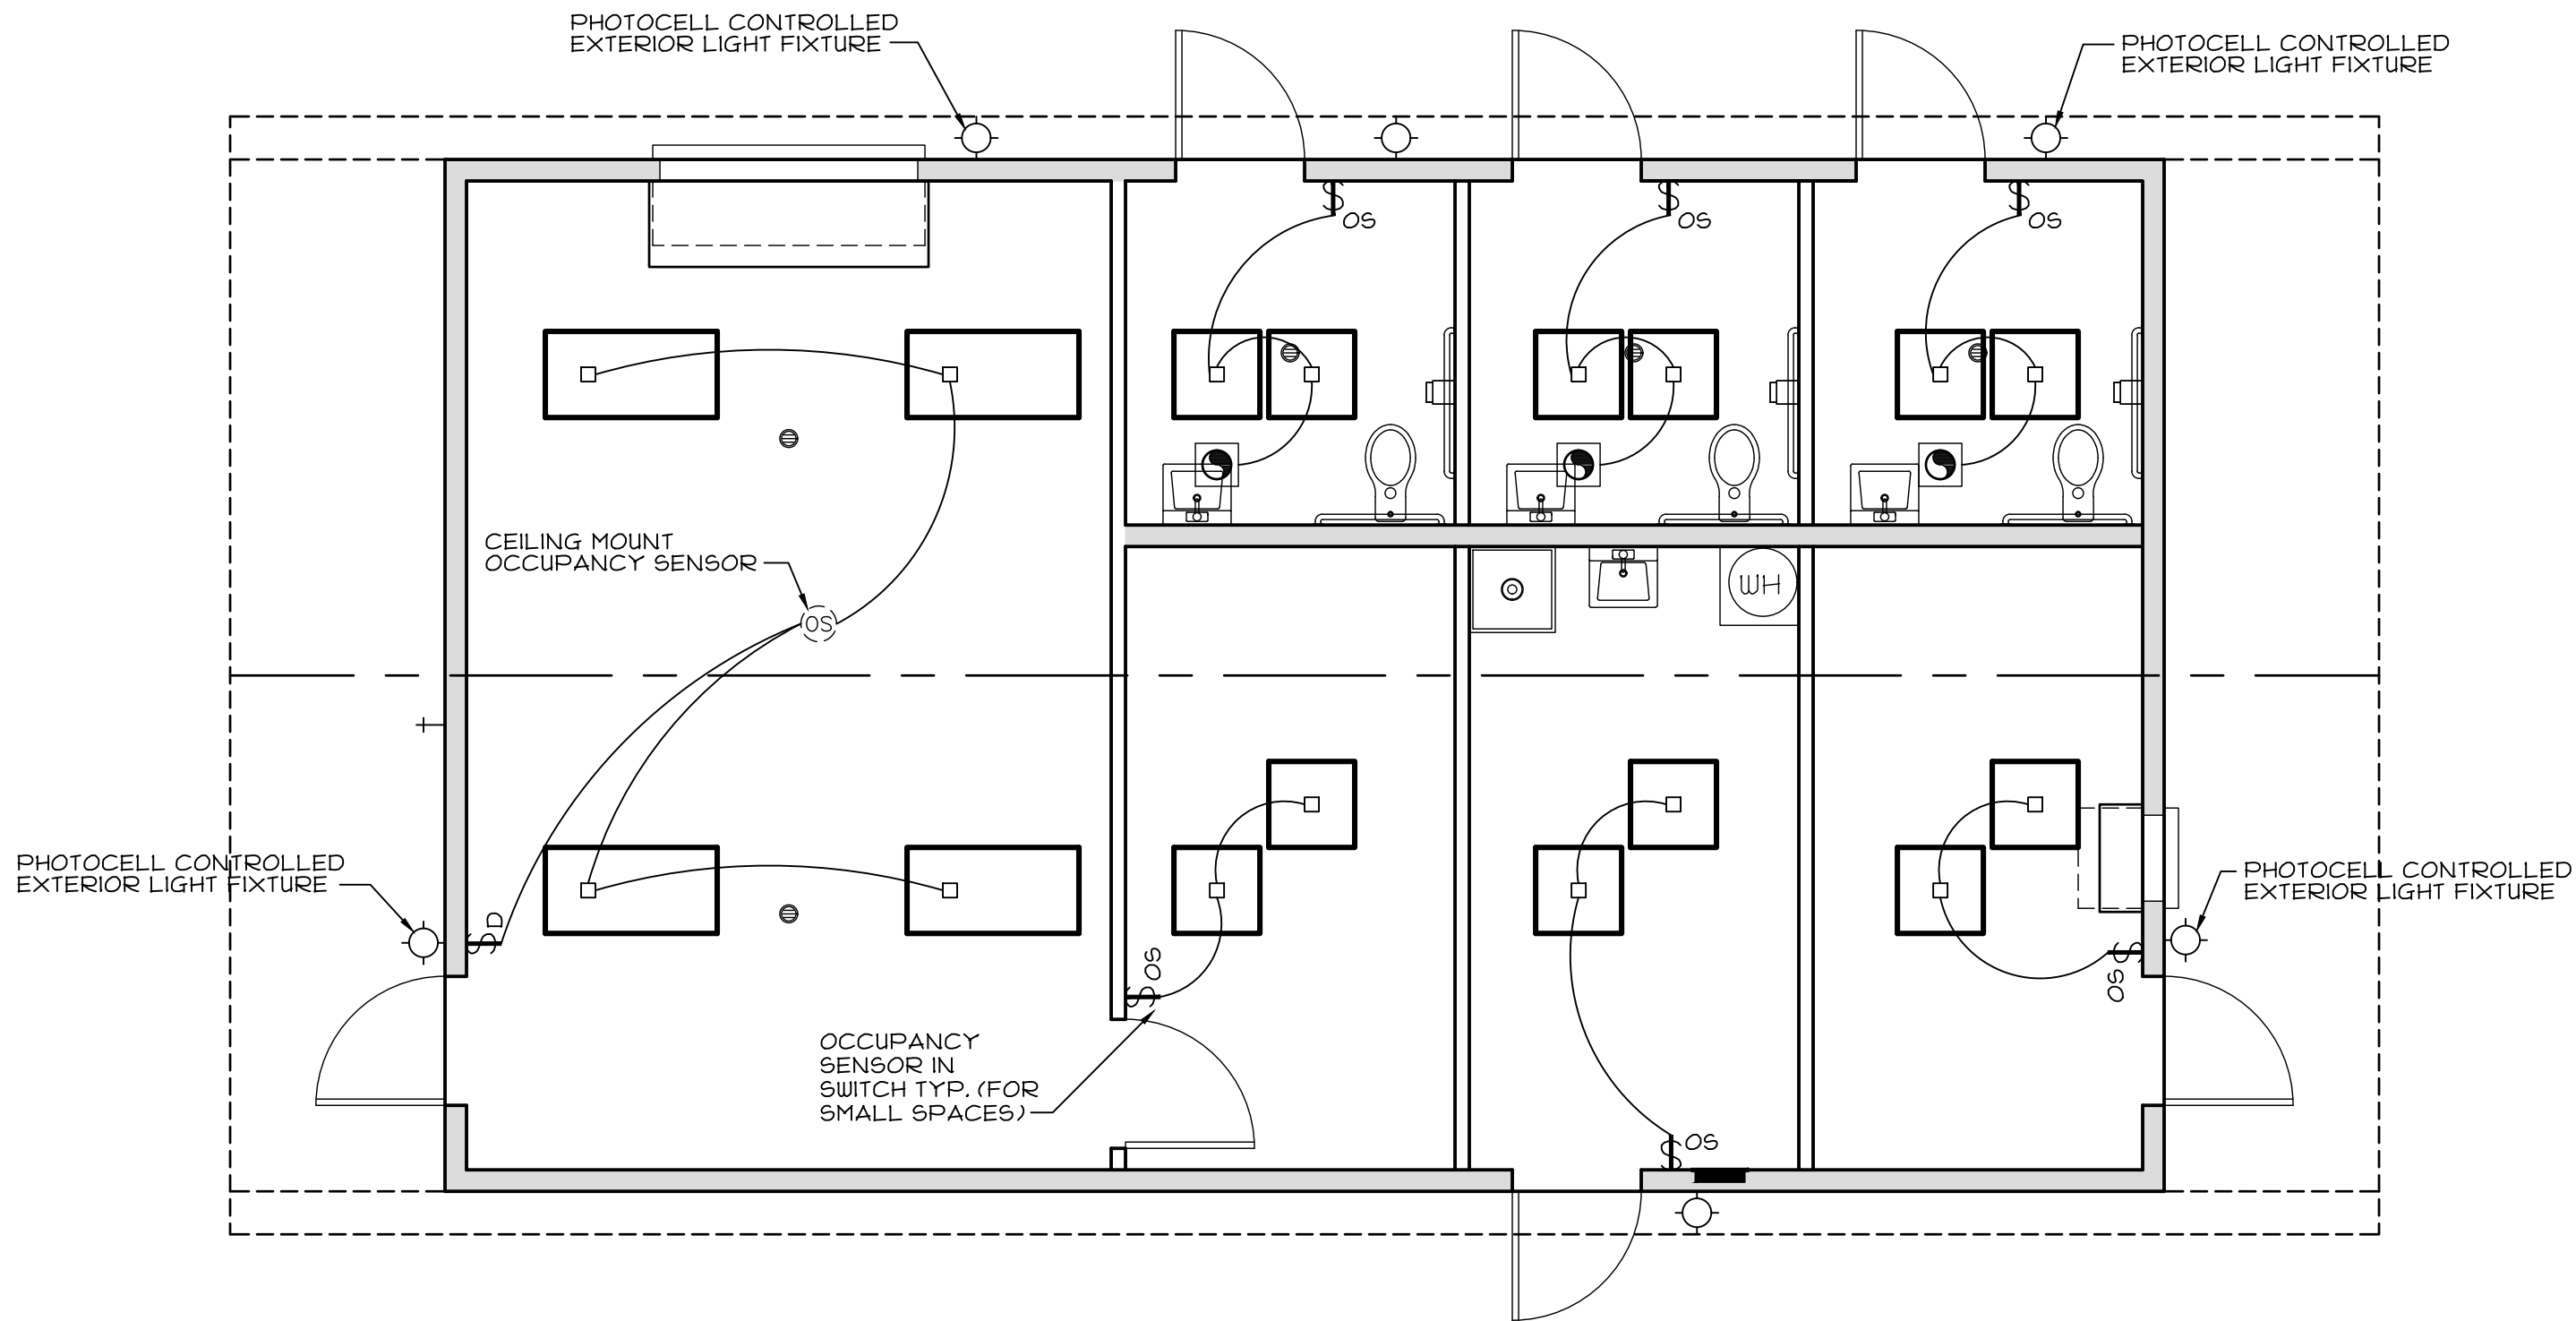

NOTE:  
SEE SHEET A3.1 FOR LEGEND  
AND SPECIFICATIONS

### LIGHTING PLAN

SCALE: 1/4"=1'-0"

PANEL SCHEDULE: "MAIN"  
MOUNTING: FLUSH INT. (NEMA 1)  
PANEL: 125 AMP RATED  
MAIN BREAKER: 125A

VOLTS: 208/120  
PHASE: 1φ  
WIRE: 3W

| DESCRIPTION     | LOAD | BRKR | MAIN 125A |   | BRKR | LOAD | DESCRIPTION              |
|-----------------|------|------|-----------|---|------|------|--------------------------|
|                 |      |      | A         | B |      |      |                          |
| LIGHTING & FANS | 599  | 20   | 1         | ♦ | 2    | 20   | 360 OUTLETS              |
| OUTLETS         | 720  | 20   | 3         | ♦ | 4    | 20   | 180 WP GFCI              |
| GFCI OUTLET     | 180  | 20   | 5         | ♦ | 6    | 20   | 180 GFCI OUTLET          |
| GFCI OUTLET     | 180  | 20   | 7         | ♦ | 8    | 20   | 184 LIGHTING EXT.        |
|                 |      |      | 9         | ♦ | 10   |      |                          |
|                 |      |      | 11        | ♦ | 12   |      |                          |
|                 |      |      | 13        | ♦ | 14   |      |                          |
|                 |      |      | 15        | ♦ | 16   |      |                          |
|                 |      |      | 17        | ♦ | 18   |      |                          |
|                 |      |      | 19        | ♦ | 20   |      |                          |
|                 |      |      | 21        | ♦ | 22   |      |                          |
|                 |      |      | 23        | ♦ | 24   |      |                          |
|                 |      |      |           |   |      |      | FOR FUTURE SOLAR ELEC. * |

LEG A: 1319 W  
LEG B: 1194 W

\* RESERVED SPACE SHALL BE PERMANENTLY MARKED.

TOTAL: 2513 W  
AMPS: 12.1

\* RESERVED SPACE FOR FUTURE SOLAR ELECTRIC SHALL BE PERMANENTLY MARKED.

### TYPICAL PANEL SCHEDULE

IDENTIFICATION STAMP  
DIV. OF THE STATE ARCHITECT  
APP. 02-118017 INC.  
REVIEWED FOR  
SS ☐ FLS ☐ ACS ☐  
DATE: 04/10/2020

CYS  
STRUCTURAL ENGINEERS INC.  
2400 N. Yuma Park Drive, Suite 600  
Sacramento, CA 95833  
(916) 486-0000 Fax  
www.cyseng.com

03/26/2020

REGISTERED PROFESSIONAL ENGINEER  
ERNEST  
No. 52030  
STATE OF CALIFORNIA

THESE DRAWINGS ARE PRELIMINARY  
AND NOT FOR CONSTRUCTION  
UNLESS STAMPED & SIGNED BY  
THE ENGINEER OF RECORD.

ENVIROPLEX, INC.  
4777 E. CARPENTER ROAD STOCKTON, CA. 95215, (209) 466-8000  
CESAR CHAVEZ HIGH SCHOOL - ATHLETIC FACILITY  
STOCKTON UNIFIED SCHOOL DISTRICT  
2929 WINDFLOWER LANE STOCKTON, CA 95212


ELECTRICAL POWER  
& SIGNAL PLAN,  
LIGHTING PLAN

REV / DATE: BY:  
JOB No.: 19-000  
DRAWN BY: RS  
DATE: 12/17/2019


CONFIDENTIAL MATERIAL- THESE DOCUMENTS ARE THE PROPERTY OF AND ARE NOT TO BE REPRODUCED OR DISTRIBUTED WITHOUT FULL KNOWLEDGE AND WRITTEN CONSENT FROM ENVIROPLEX, INC.  
© COPYRIGHT ENVIROPLEX, INC. (ALL DRAWINGS PREPARED BY ENVIROPLEX, INC.)

A3.2



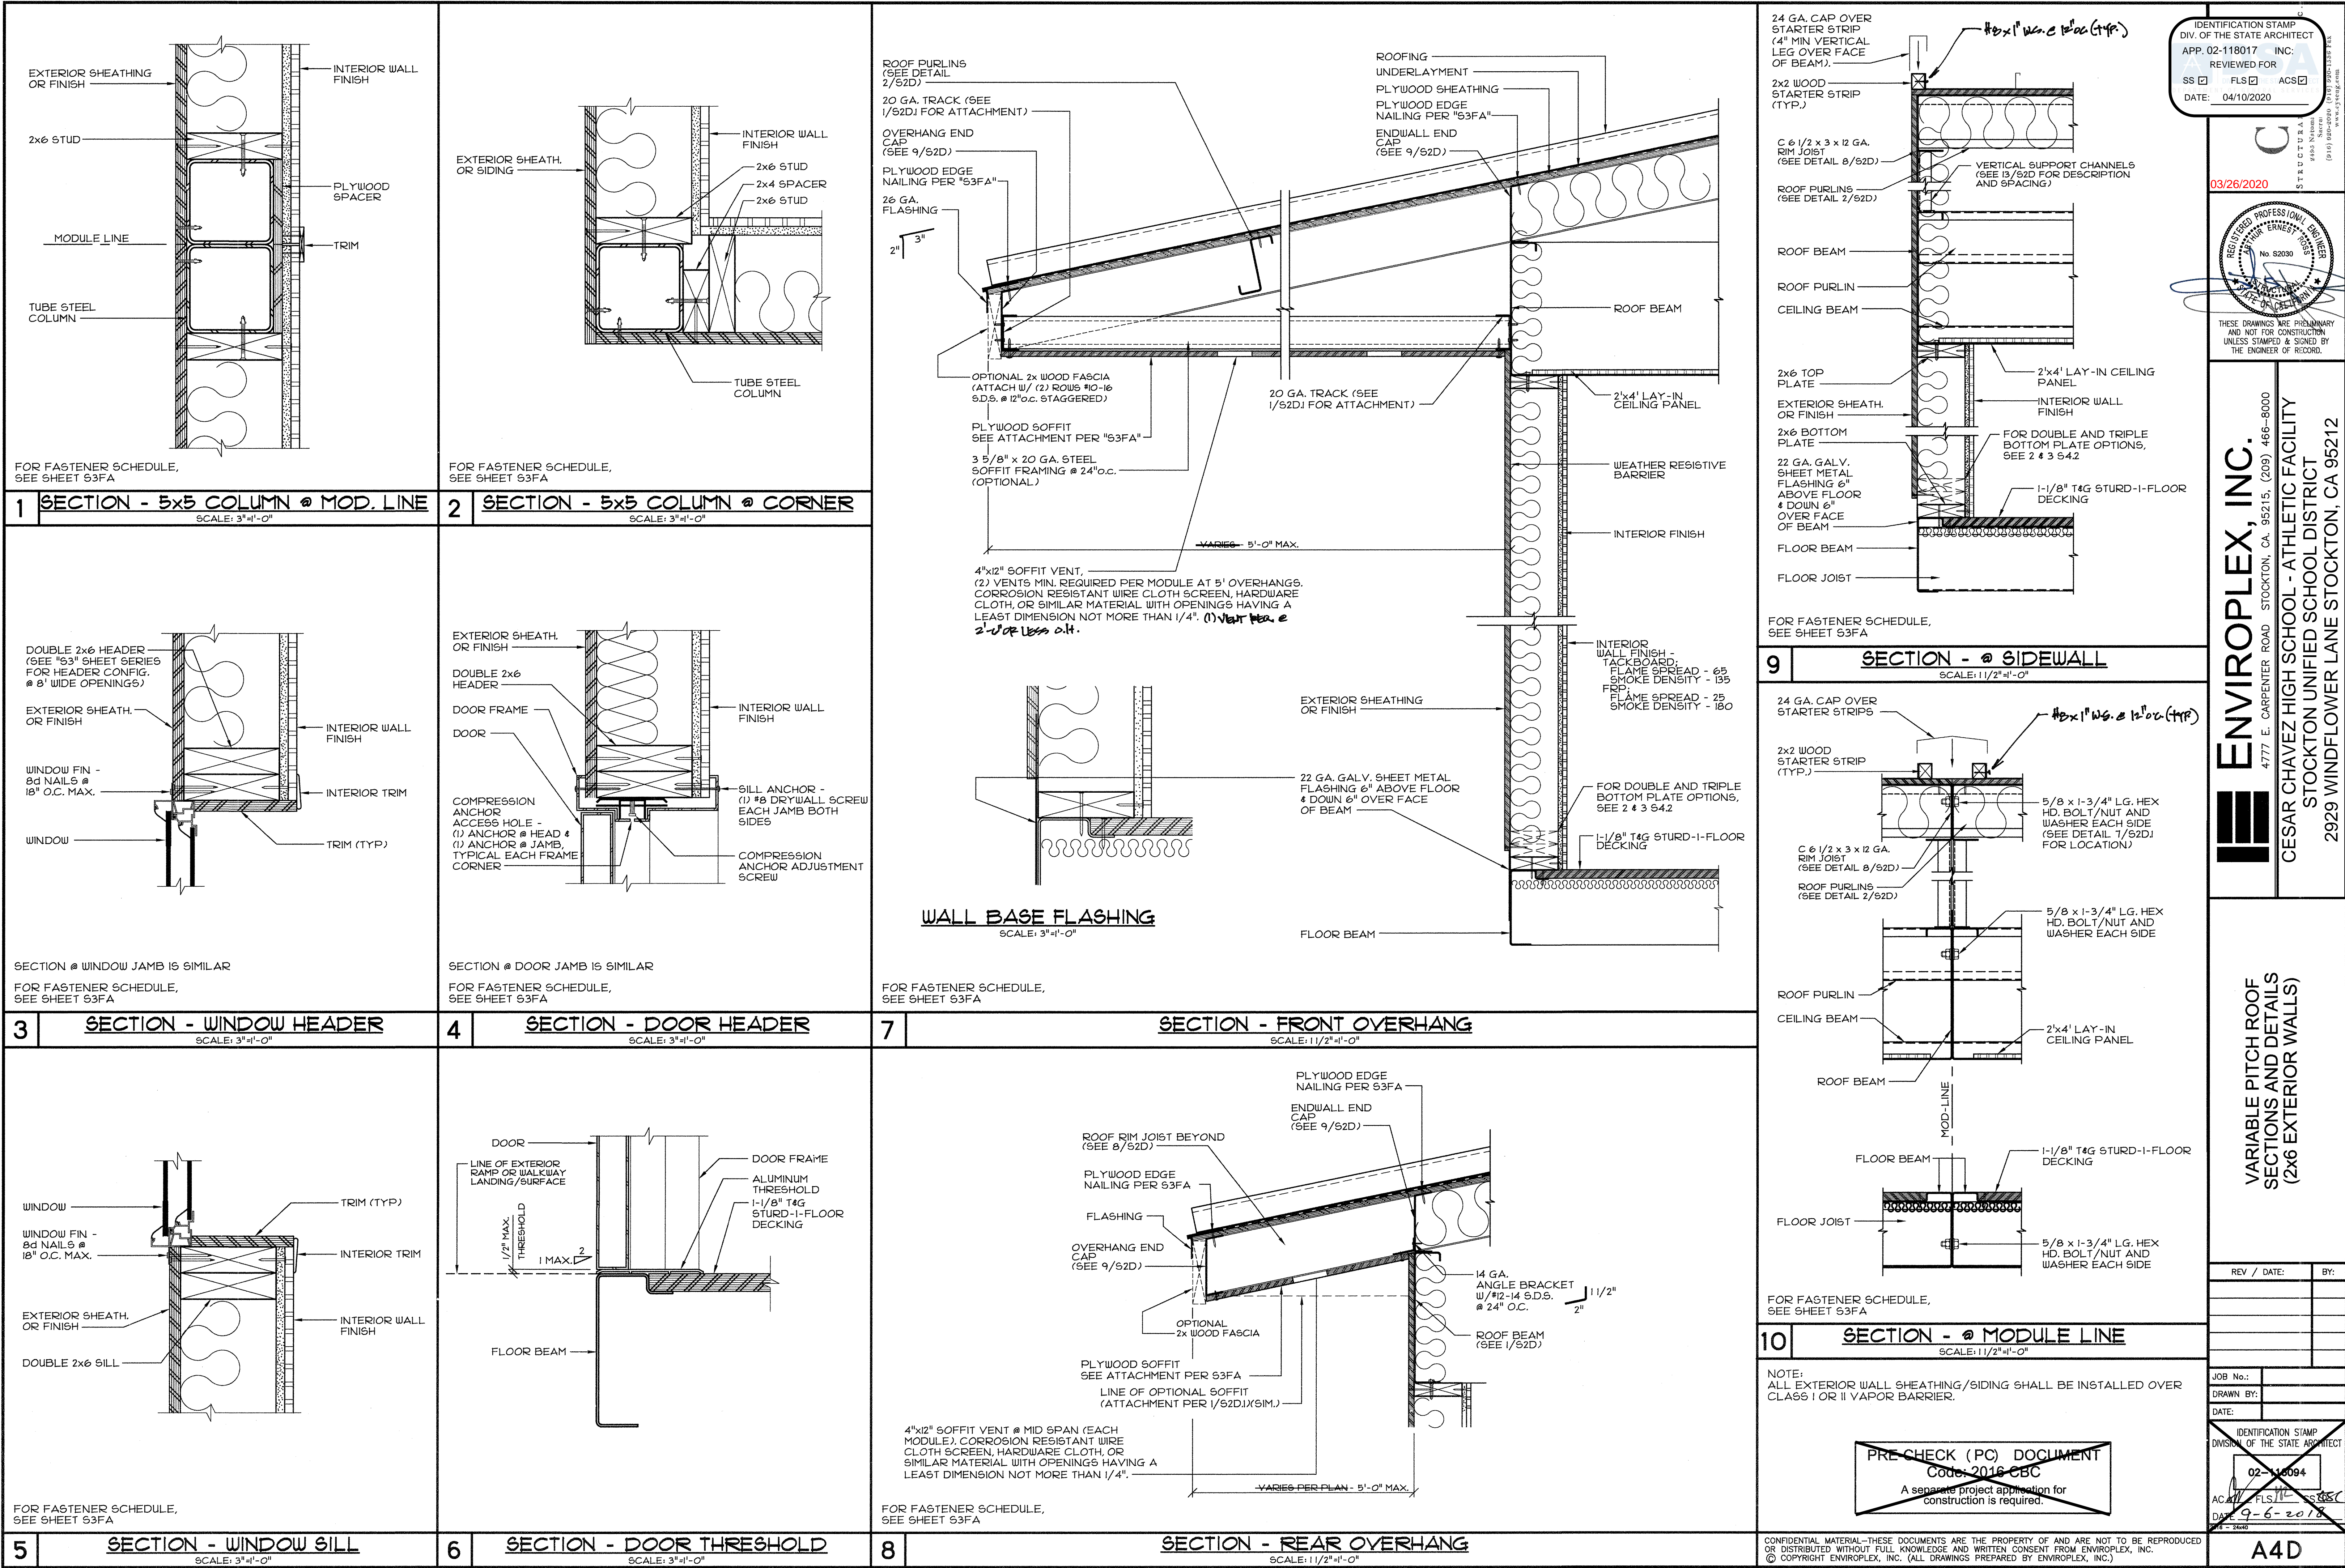



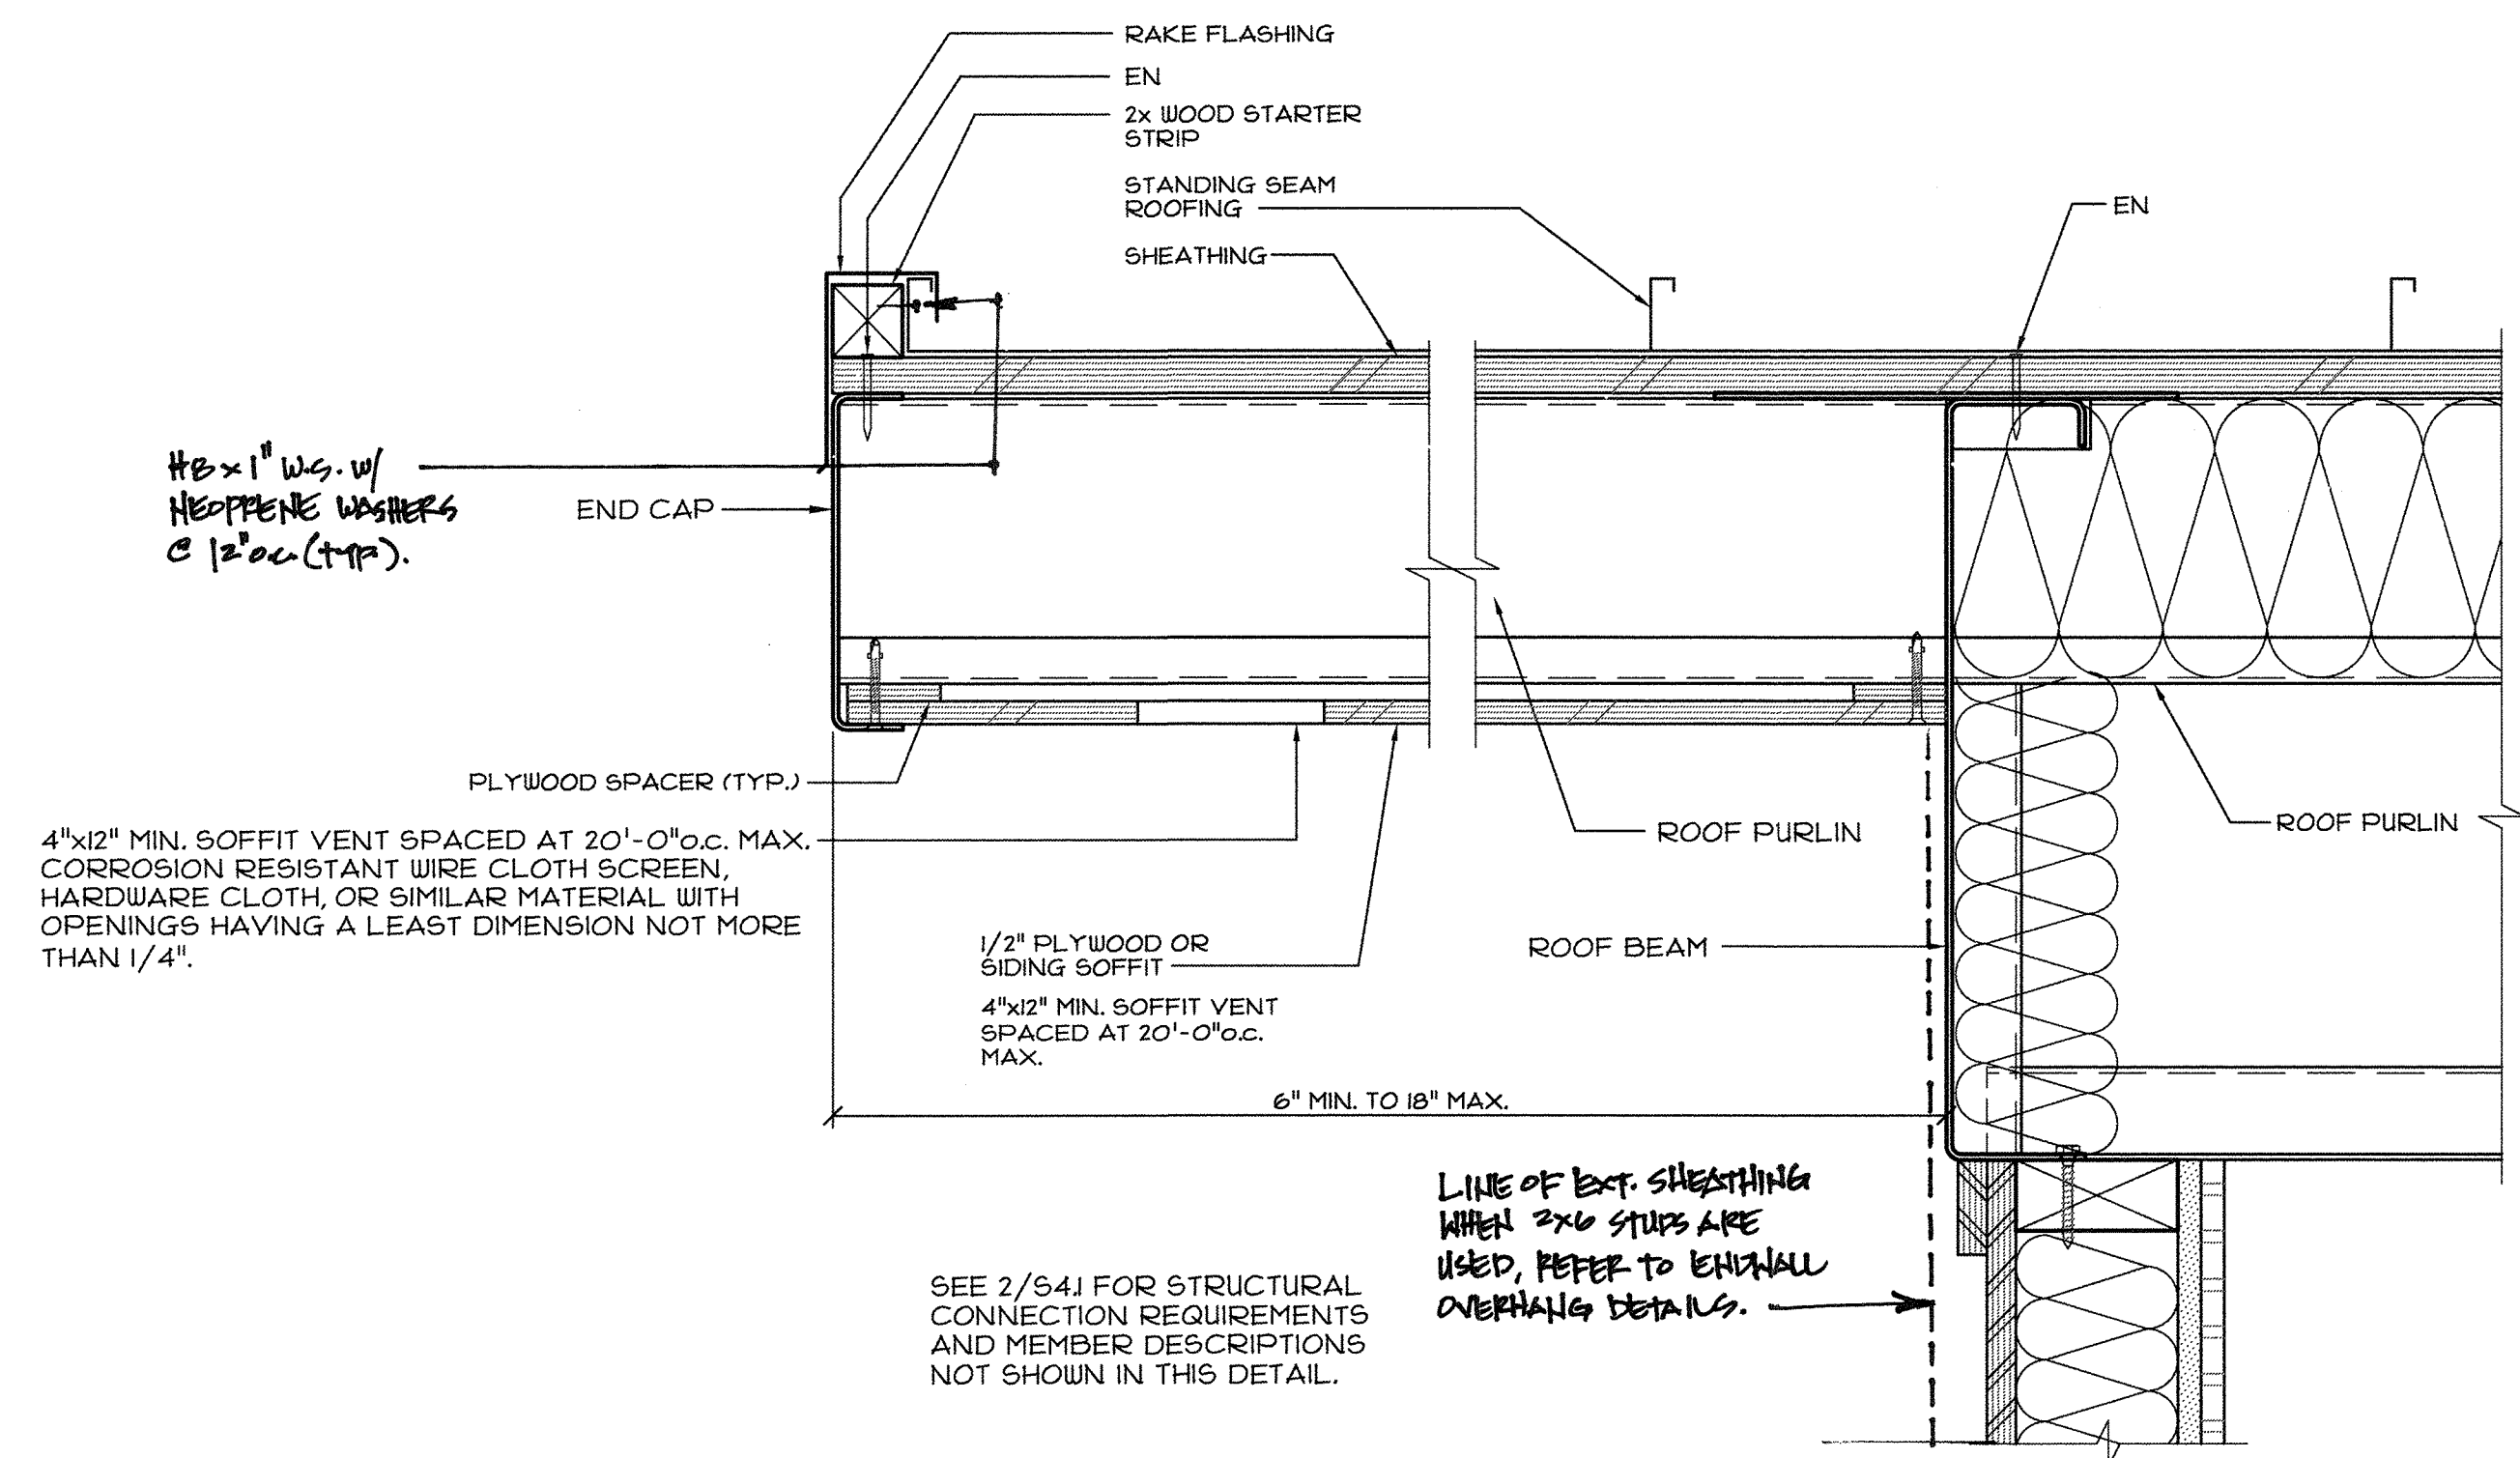

2

### TYPICAL SIDEWALL OVERHANG DETAIL

SCALE: 3"=1'-0"


NOTE:  
ALL EXTERIOR WALL SHEATHING/SIDING SHALL BE INSTALLED OVER  
CLASS I OR II VAPOR BARRIER.

~~PRE CHECK (PC) DOCUMENT~~  
~~Code: 2016 CBC~~  
~~A separate project application for construction is required.~~


CONFIDENTIAL MATERIAL--THESE DOCUMENTS ARE THE PROPERTY OF AND ARE NOT TO BE REPRODUCED OR DISTRIBUTED WITHOUT FULL KNOWLEDGE AND WRITTEN CONSENT FROM ENVIROPLEX, INC.  
© COPYRIGHT ENVIROPLEX, INC. (ALL DRAWINGS PREPARED BY ENVIROPLEX, INC.)

|   |  |  |  |
|---|--|--|--|
| <p><b>IDENTIFICATION STAMP</b></p> <p>DIV. OF THE STATE ARCHITECT</p> <p>APP. 02-118017 INC.</p> <p>REVIEWED FOR:</p> <p>SS <input checked="" type="checkbox"/> FLS <input checked="" type="checkbox"/> ACS <input checked="" type="checkbox"/></p> <p>DATE: 04/10/2020</p> |  |  <p style="text-align: right;"><b>STRUCTURAL</b></p> <p style="text-align: right;">Jesse Nelson<br/>Seal Number<br/>(916) 966-2600<br/>www.jenr.com</p> |  |
|   |  | <p><b>03/26/2020</b></p>   |  |
| <p><b>OPTIONAL SIDEWALL OVERHANG<br/>DETAIL</b></p>   |  | <p><b>CESAR CHAVEZ HIGH SCHOOL - ATHLETIC FACILITY</b></p> <p><b>STOCKTON UNIFIED SCHOOL DISTRICT</b></p> <p><b>2929 WINDFLOWER LANE STOCKTON, CA 95212</b></p>  |  |
| <p><b>ENVIROPLEX, INC.</b></p> <p>4777 E. CARPENTER ROAD STOCKTON, CA. 95215, (209) 466-8000</p>  |  | <p><b>REGISTERED PROFESSIONAL ENGINEER</b></p> <p><b>JEFFERY ERNEST ROGERS</b></p> <p>No. S2030</p> <p>STATE OF CALIFORNIA</p>   |  |
| <p>THESE DRAWINGS ARE PRELIMINARY<br/>AND NOT FOR CONSTRUCTION<br/>UNLESS STAMPED &amp; SIGNED BY<br/>THE ENGINEER OF RECORD.</p>   |  |  |  |
| <p><b>OPTIONAL SIDEWALL OVERHANG<br/>DETAIL</b></p>   |  | <p><b>ENVIROPLEX, INC.</b></p> <p>4777 E. CARPENTER ROAD STOCKTON, CA. 95215, (209) 466-8000</p>   |  |
| <p><b>OPTIONAL SIDEWALL OVERHANG<br/>DETAIL</b></p>   |  | <p><b>CESAR CHAVEZ HIGH SCHOOL - ATHLETIC FACILITY</b></p> <p><b>STOCKTON UNIFIED SCHOOL DISTRICT</b></p> <p><b>2929 WINDFLOWER LANE STOCKTON, CA 95212</b></p>  |  |
| <p><b>OPTIONAL SIDEWALL OVERHANG<br/>DETAIL</b></p>   |  | <p><b>REGISTERED PROFESSIONAL ENGINEER</b></p> <p><b>JEFFERY ERNEST ROGERS</b></p> <p>No. S2030</p> <p>STATE OF CALIFORNIA</p>   |  |
| <p>THESE DRAWINGS ARE PRELIMINARY<br/>AND NOT FOR CONSTRUCTION<br/>UNLESS STAMPED &amp; SIGNED BY<br/>THE ENGINEER OF RECORD.</p>   |  |  |  |
| <p><b>OPTIONAL SIDEWALL OVERHANG<br/>DETAIL</b></p>   |  | <p><b>ENVIROPLEX, INC.</b></p> <p>4777 E. CARPENTER ROAD STOCKTON, CA. 95215, (209) 466-8000</p>   |  |
| <p><b>OPTIONAL SIDEWALL OVERHANG<br/>DETAIL</b></p>   |  | <p><b>CESAR CHAVEZ HIGH SCHOOL - ATHLETIC FACILITY</b></p> <p><b>STOCKTON UNIFIED SCHOOL DISTRICT</b></p> <p><b>2929 WINDFLOWER LANE STOCKTON, CA 95212</b></p>  |  |
| <p><b>OPTIONAL SIDEWALL OVERHANG<br/>DETAIL</b></p>   |  | <p><b>REGISTERED PROFESSIONAL ENGINEER</b></p> <p><b>JEFFERY ERNEST ROGERS</b></p> <p>No. S2030</p> <p>STATE OF CALIFORNIA</p>   |  |
| <p>THESE DRAWINGS ARE PRELIMINARY<br/>AND NOT FOR CONSTRUCTION<br/>UNLESS STAMPED &amp; SIGNED BY<br/>THE ENGINEER OF RECORD.</p>   |  |  |  |
| <p><b>OPTIONAL SIDEWALL OVERHANG<br/>DETAIL</b></p>   |  | <p><b>ENVIROPLEX, INC.</b></p> <p>4777 E. CARPENTER ROAD STOCKTON, CA. 95215, (209) 466-8000</p>   |  |
| <p><b>OPTIONAL SIDEWALL OVERHANG<br/>DETAIL</b></p>   |  | <p><b>CESAR CHAVEZ HIGH SCHOOL - ATHLETIC FACILITY</b></p> <p><b>STOCKTON UNIFIED SCHOOL DISTRICT</b></p> <p><b>2929 WINDFLOWER LANE STOCKTON, CA 95212</b></p>  |  |





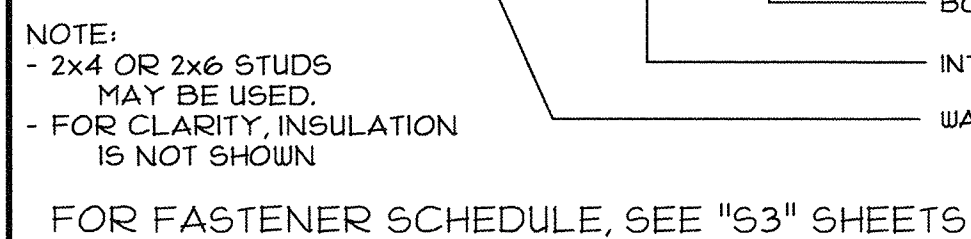


SCALE: 3"=1'-0"

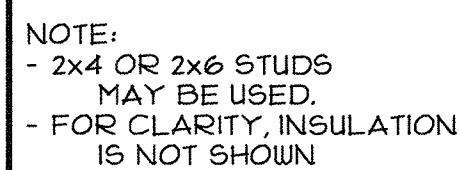


SCALE:  $3^{\text{II}} = |^{\text{I}} - 0^{\text{II}}$

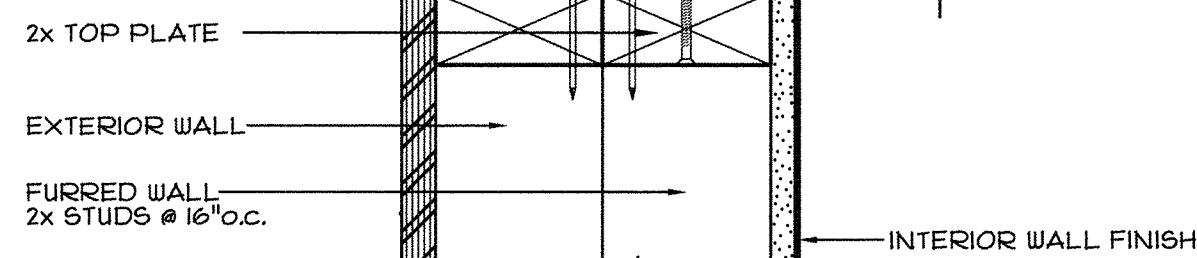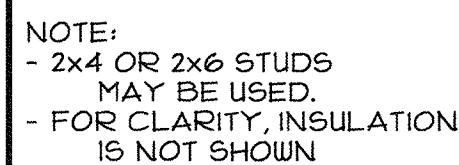


SCALE: 3"=1'-0"

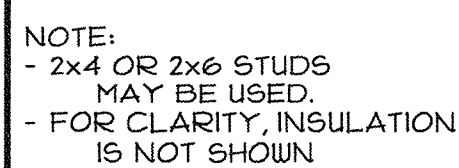


SCALE: 3<sup>III</sup>=1<sup>I</sup>-0<sup>II</sup>

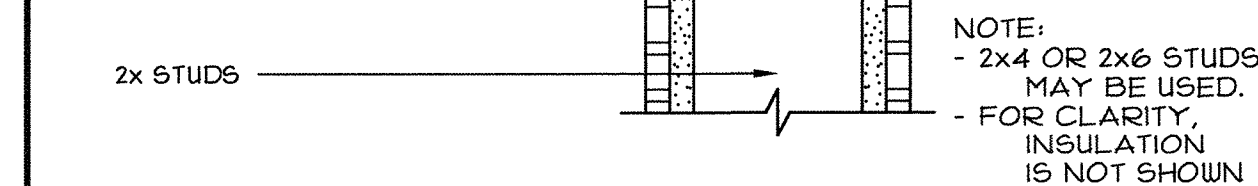


SCALE: 3"=1'-0"

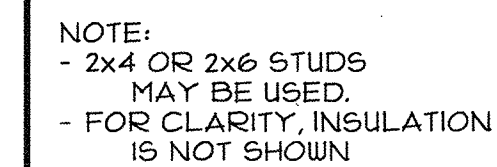


SCALE:  $3'' = 1' - 0''$

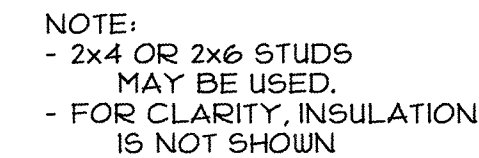



SCALE: 3"=1'-0"

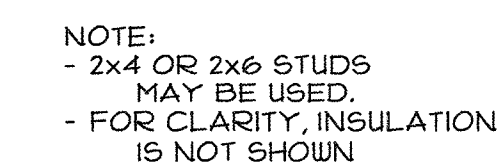


SCALE: 3"=1'-0"

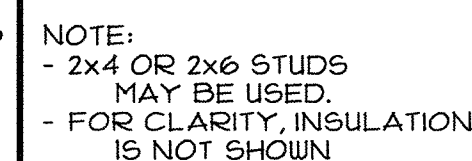



SCALE: 3"=1'-0"

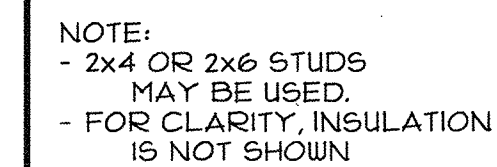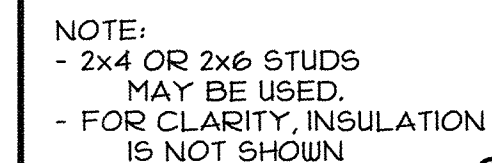
$$\Xi: 3^{\text{III}} = |^1 - O^{\text{II}}$$


SCALE: 3"=1'-0"

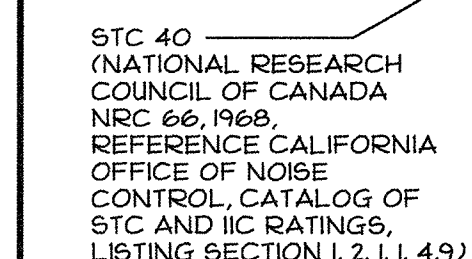

SCALE: 3"=1'-0"

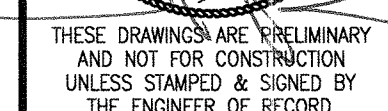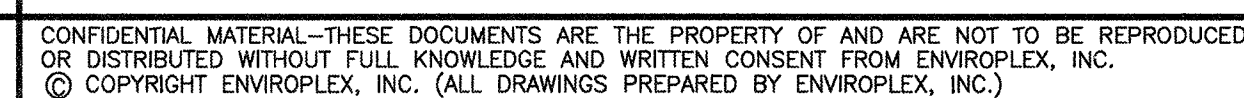

## INTERIOR WALL CONNECTION DETAILS

|           |  |
|-----------|--|
| JOB No.:  |  |
| DRAWN BY: |  |
| DATE:     |  |

A4H



4x E  
2x S  
TOP

**NOT**

2x S

**USED**

1 UPPER CABINET BLOCKING DETAIL  
SCALE: 1 1/2" = 1'-0"

**NOT  
USED**

2 BASE CABINET BLOCKING DETAIL  
SCALE: 1 1/2"=1'-0"

NOTE:  
GRAB BAR SHALL BE CAPABLE  
OF SUPPORTING A VERTICAL OR  
HORIZONTAL 250 POUND LOAD

## 3 GRAB BAR BLOCKING DETAIL

SCALE: 3" = 1'-0"

PANIC BAR ATTACHED TO DOOR
 

## 4 PANIC HARDWARE DETAIL

SCALE: 1 1/2" = 1'-0"

A5

# NOT USED

6 HANDRAIL VERTICAL TO CONC.  
SCALE:  $1\frac{1}{2}" = 1'-0"$

BRACKET EACH END OF SCREEN

16" MAX.

**NOT**

1/4"  $\phi$  x 4  
(TYP. 4 F)

2x6 BLO.  
STUDS W/  
EACH EN

2x STUD

**USED**

|   |   |
|---|---|
| 7 | <b>PROJECTOR SCREEN BLOCKING</b><br>SCALE: 1 1/2" = 1'-0" |
|---|---|

## 8 MARKERBOARD BLOCKING



# NOT USED

EXTERIOR II  
FINISH

|   |  |
|---|--|
| 9 | <u>D.F. TO WALL ATTACHMENT</u><br>SCALE: NTS |
|---|--|

CONFIDENTIAL MATERIAL—THESE DOCUMENTS ARE THE PROPERTY OF AND ARE NOT TO BE REPRODUCED OR DISTRIBUTED WITHOUT FULL KNOWLEDGE AND WRITTEN CONSENT FROM ENVIROPLEX, INC.  
© COPYRIGHT ENVIROPLEX, INC. (ALL DRAWINGS PREPARED BY ENVIROPLEX, INC.)

3"

2'-2"

3"

#12 x 2-1/2" WOOD SCREWS,  
(1) EACH CORNER

22-1/2"

#12 x 2-1/2" WOOD SCREWS  
@ 6" O.C. INTO 2x4  
FLAT BLOCKING  
(ON 4 SIDES)

Technical drawing of a window frame assembly. The drawing shows a cross-section of the frame with dimensions and fastener specifications. The top horizontal dimension is 2'-2" (2 feet 2 inches). The left and right vertical dimensions are 3" (3 inches). The bottom horizontal dimension is 22-1/2" (22 and a half inches). The drawing indicates the use of #12 x 2-1/2" wood screws, one at each corner, and #12 x 2-1/2" wood screws at 6" O.C. (on center) into 2x4 flat blocking on all four sides.

11 INTERIOR UNDERFLOOR ACCESS  
SCALE: 1 1/2" = 1'-0"



**NOT  
USED**

12 ACCESSIBLE CASEWORK @ SINK  
SCALE: 1/2"=1'-0"

NOTE:  
NO SHARP OR ABRASIVE  
SURFACES UNDER SINKS/LAVATORIES  
OR COUNTERS.

13 COUNTERTOP SUPPORT BRACKET  
SCALE: 1 1/2" = 1'-0"

**NOT USED**

14 TALL CABINET BLOCKING DETAIL  
SCALE: 1 1/2" = 1'-0"

1.5 m

|    |   |
|----|---|
| 10 | <u>TYP. ROOM IDENTIFICATION SIGNAGE</u> |
|----|---|

DIVISION OF THE STATE ARCHITECT

PRE CHECK (PC) DOCUMENT

~~PRE-CHECK (FC) DOCUMENT~~  
~~Code: 2016 CBC~~  
~~A general project application for~~

A separate project application for construction is required.



CONFIDENTIAL MATERIAL--THESE DOCUMENTS ARE THE PROPERTY OF AND ARE NOT TO BE REPRODUCED OR DISTRIBUTED WITHOUT FULL KNOWLEDGE AND WRITTEN CONSENT FROM ENVIROPLEX, INC.

© COPYRIGHT ENVIROPLEX, INC. (ALL DRAWINGS PREPARED BY ENVIROPLEX, INC.)








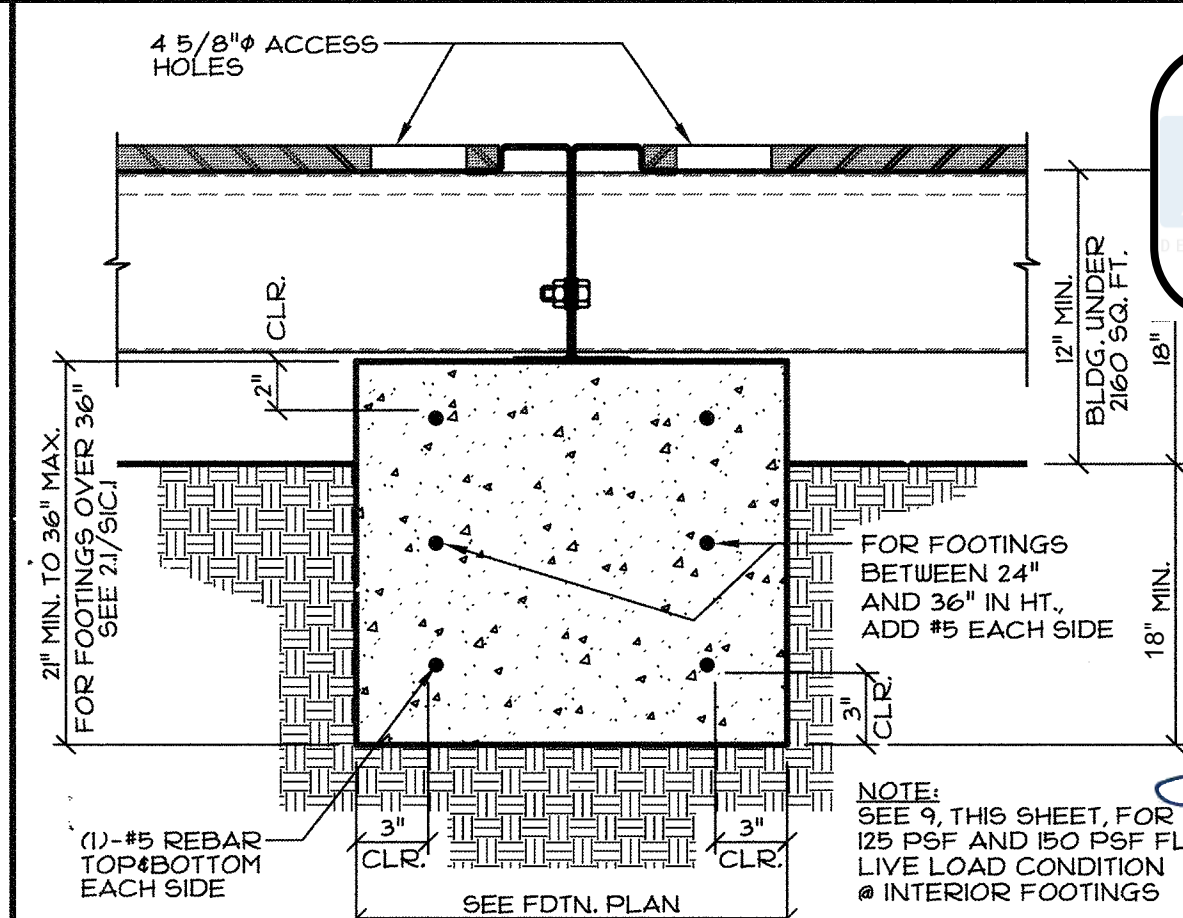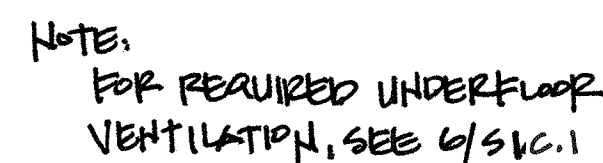

IDENTIFICATION STAMP  
DIV. OF THE STATE ARCHITECT  
APP. 02-118017 INC:  
REVIEWED FOR  
SS ☒ FLS ☒ ACS ☒  
DATE: 04/10/2020

03/26/2020

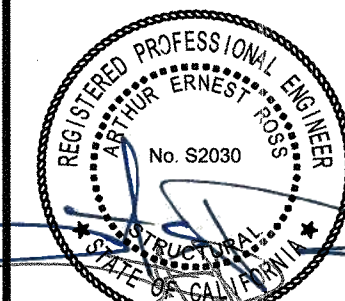

THESE DRAWINGS ARE PRELIMINARY  
AND NOT FOR CONSTRUCTION  
UNLESS STAMPED & SIGNED BY  
THE ENGINEER OF RECORD

**ENVIROPLEX, INC.**  
 4777 E. CARPENTER ROAD STOCKTON, CA. 95215, (209) 466-8000  
 CESAR CHAVEZ HIGH SCHOOL - ATHLETIC FACILITY  
 STOCKTON UNIFIED SCHOOL DISTRICT  
 STOCKTON, CALIF. 95215

CONCRETE FOUNDATION PLAN,  
FOOTING DETAILS & NOTES

|             |     |
|-------------|-----|
| REV / DATE: | BY: |
|-------------|-----|

|  |  |
|--|--|
|  |  |
|  |  |
|  |  |

|           |  |
|-----------|--|
| JOB No.:  |  |
| DRAWN BY: |  |
| DATE:     |  |

IDENTIFICATION STAMP  
DIVISION OF THE STATE ARCHIVES

~~02-118094~~

AC        FLS        SS 08  
DATE 9-6-2018  
2018 - 24x40


LOW SEISMIC

S1C

\_\_\_\_\_

24'x40' TO 120'x40' P.C.

|   |   |
|---|---|
| 3 | <p>INTERIOR FOOTING - <del>50</del> 65 PSF</p> <p>SCALE: 1-1/2" = 1'-0"</p> |
|---|---|

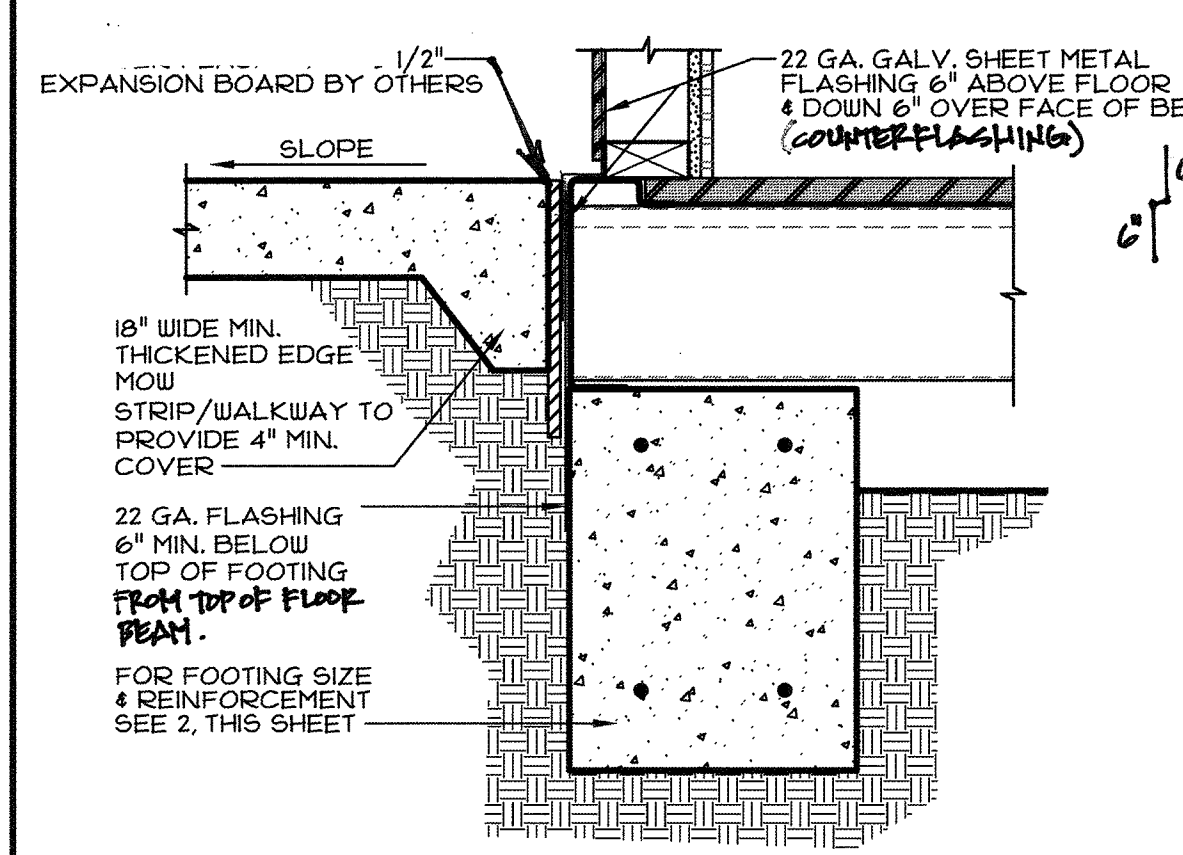

|  |  |   |   |
|--|--|---|---|
|  |  | 7 | <b><u>PERIMETER FLASHING DETAIL</u></b><br>SCALE:                      1-1/2"=1'-0" |
|--|--|---|---|

| ALLOWABLE BEARING (psf) | MODULE CONFIGURATION               | FOOTING WIDTH "B" (Inches)             |                          |        |
|-------------------------|------------------------------------|--|--------------------------|--------|
|                         |                                    | CLAS9ROOM<br>(50 psf +<br>50 = 10 psf) | 25psf                    | 150psf |
| 1500                    | STD BI-PITCH, STD 6HED - NO STUCCO | 12                                     | <input type="checkbox"/> | 18     |
|                         | ALL ROOF OPTIONS - NO STUCCO       | 12                                     | <input type="checkbox"/> | 18     |
|                         | ALL ROOF OPTIONS - STUCCO          | 12                                     | <input type="checkbox"/> | 18     |

|    |                            |
|----|----------------------------|
| 13 | "B" FOOTING WIDTH SCHEDULE |
|----|----------------------------|

NOTES:

1. ALLOWABLE SOIL BEARING PRESSURE IS 2,000 P.S.F. (DL+LL) & 2,667 (DL+LL+LATERAL) PER WALLACE KUHL & ASSOCIATES GEOTECHNICAL ENGINEERING REPORT PROJ # 12435.01P DATED SEPTEMBER 11, 2019
2. CONCRETE FOR FOOTINGS SHALL HAVE A MINIMUM STRENGTH  $f'_c = 3,000$  P.S.I., PER 1905A.19 MADE WITH 1" MAX ASTM C-33 AGGREGATES PER ACI 318-14 SECTION 26.4.12 AND IN ACCORDANCE WITH CBC SECTION 1903A.4.5
3. MIX DESIGN SHALL BE PER ACI 318-14 SECTION 26.4.3.1
4. REINFORCING BARS SHALL BE A615, GRADE 60 MIN.
5. VENTILATION TO MEET REQUIREMENTS PER IR 16-1.16. PROVIDE MINIMUM 1 SQ. FT. OF NET FREE VENT SPACE PER 150 SQ. FT. (PROVIDE 2" MINIMUM CLEARANCE)
6. NOT USED.
7. TESTING OF REINFORCING BARS USED IN SINGLE STORY BUILDINGS MAY BE WAIVED PROVIDED CERTIFIED MILL TEST REPORTS ARE PROVIDED FOR EACH SHIPMENT OF SUCH REINFORCEMENT (CBC 1913A.0).
8. CONCRETE MIX SHALL HAVE A MAXIMUM 0.50 WATER CEMENT RATIO.
9. ADD WATER REDUCING ADMIXTURE IN COMPLIANCE WITH ASTM C494 TYPE A.
10. CEMENTITIOUS FLY ASH OR SLAG MAY REPLACE A MAX. OF 20% OF CEMENT BY WEIGHT.

FOR USE:

- 1) 20 PSF ROOF LIVE LOAD W/ ~~50, 65, 125 & 150~~ psf FLOOR LL
- 2) ALL ROOF OPTIONS.
- 3) ALL EXTERIOR FINISH OPTIONS.

~~PRE CHECK (PC) DOCUMENT~~  
~~Code: 2016 CBC~~  
~~A separate project application for construction is required.~~

4 5/8" ACCESS HOLES

12" MIN. BLK. UNDER 260 SQ. FT.

18" MIN. PA DG OVER

12" MIN.

16" MIN. TO 36" MAX. FOR FOOTINGS OVER 36" SEE 3/15/01

12" MIN. 1/2" REBAR TOP, BOTTOM, MID-HEIGHT EACH SIDE, AND MID-WIDTH

3" CLR.

3" CLR.

SEE FDTN. PLAN




NOT USED

|    |   |  |
|----|---|--|
| 5A | 5 |  |
| 8  |   |  |

|    |               |
|----|---------------|
| 11 | GENERAL NOTES |
|----|---------------|






CONFIDENTIAL MATERIAL-THESE DOCUMENTS ARE THE PROPERTY OF AND ARE NOT TO BE REPRODUCED OR DISTRIBUTED WITHOUT FULL KNOWLEDGE AND WRITTEN CONSENT FROM ENVIROPLEX, INC.  
© COPYRIGHT ENVIROPLEX, INC. (ALL DRAWINGS PREPARED BY ENVIROPLEX, INC.)



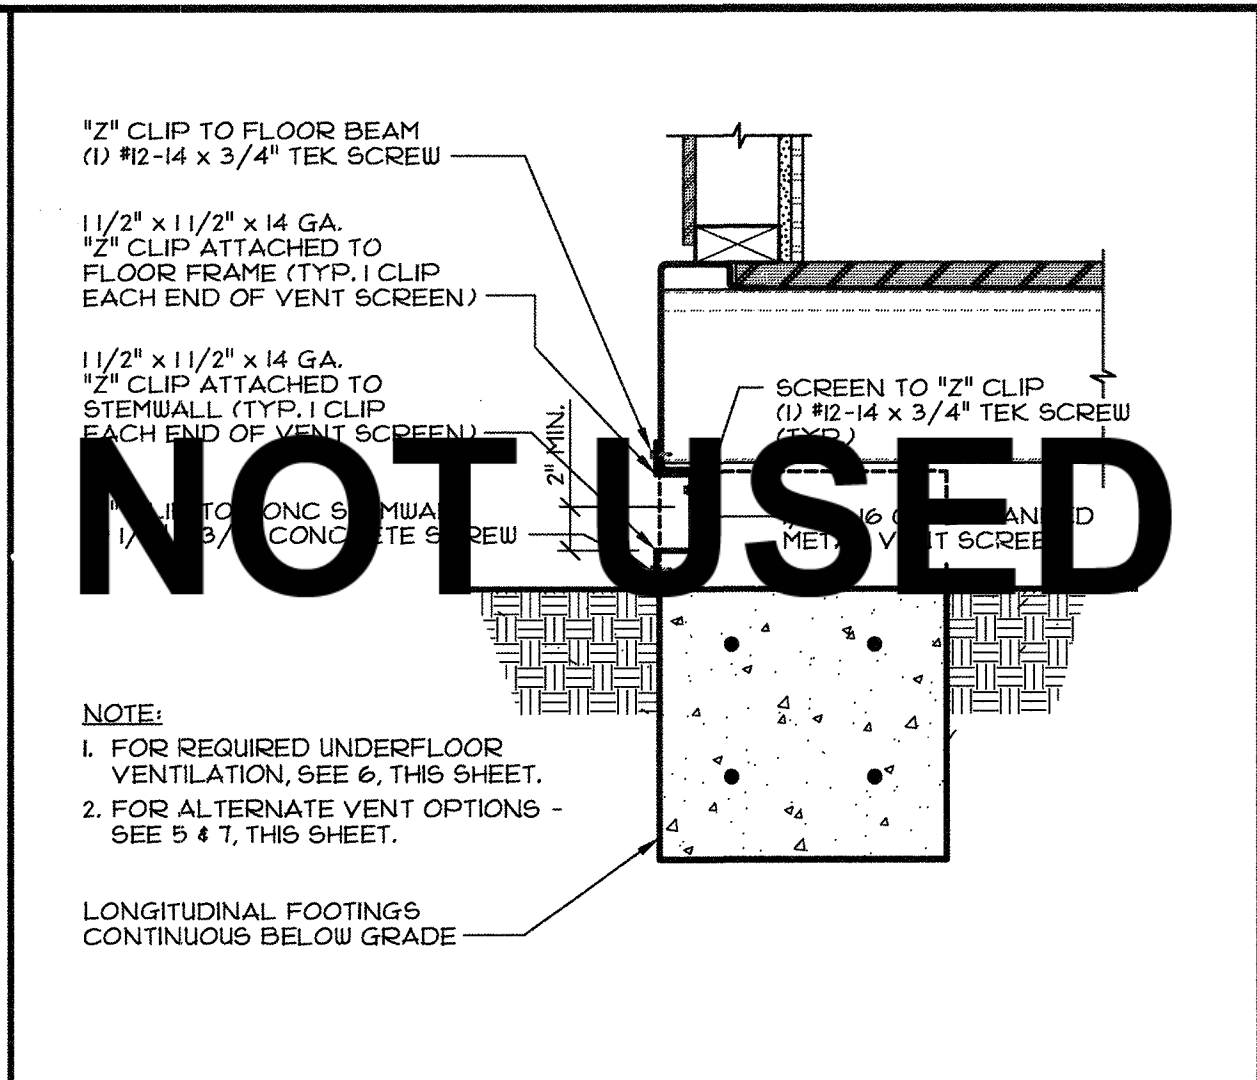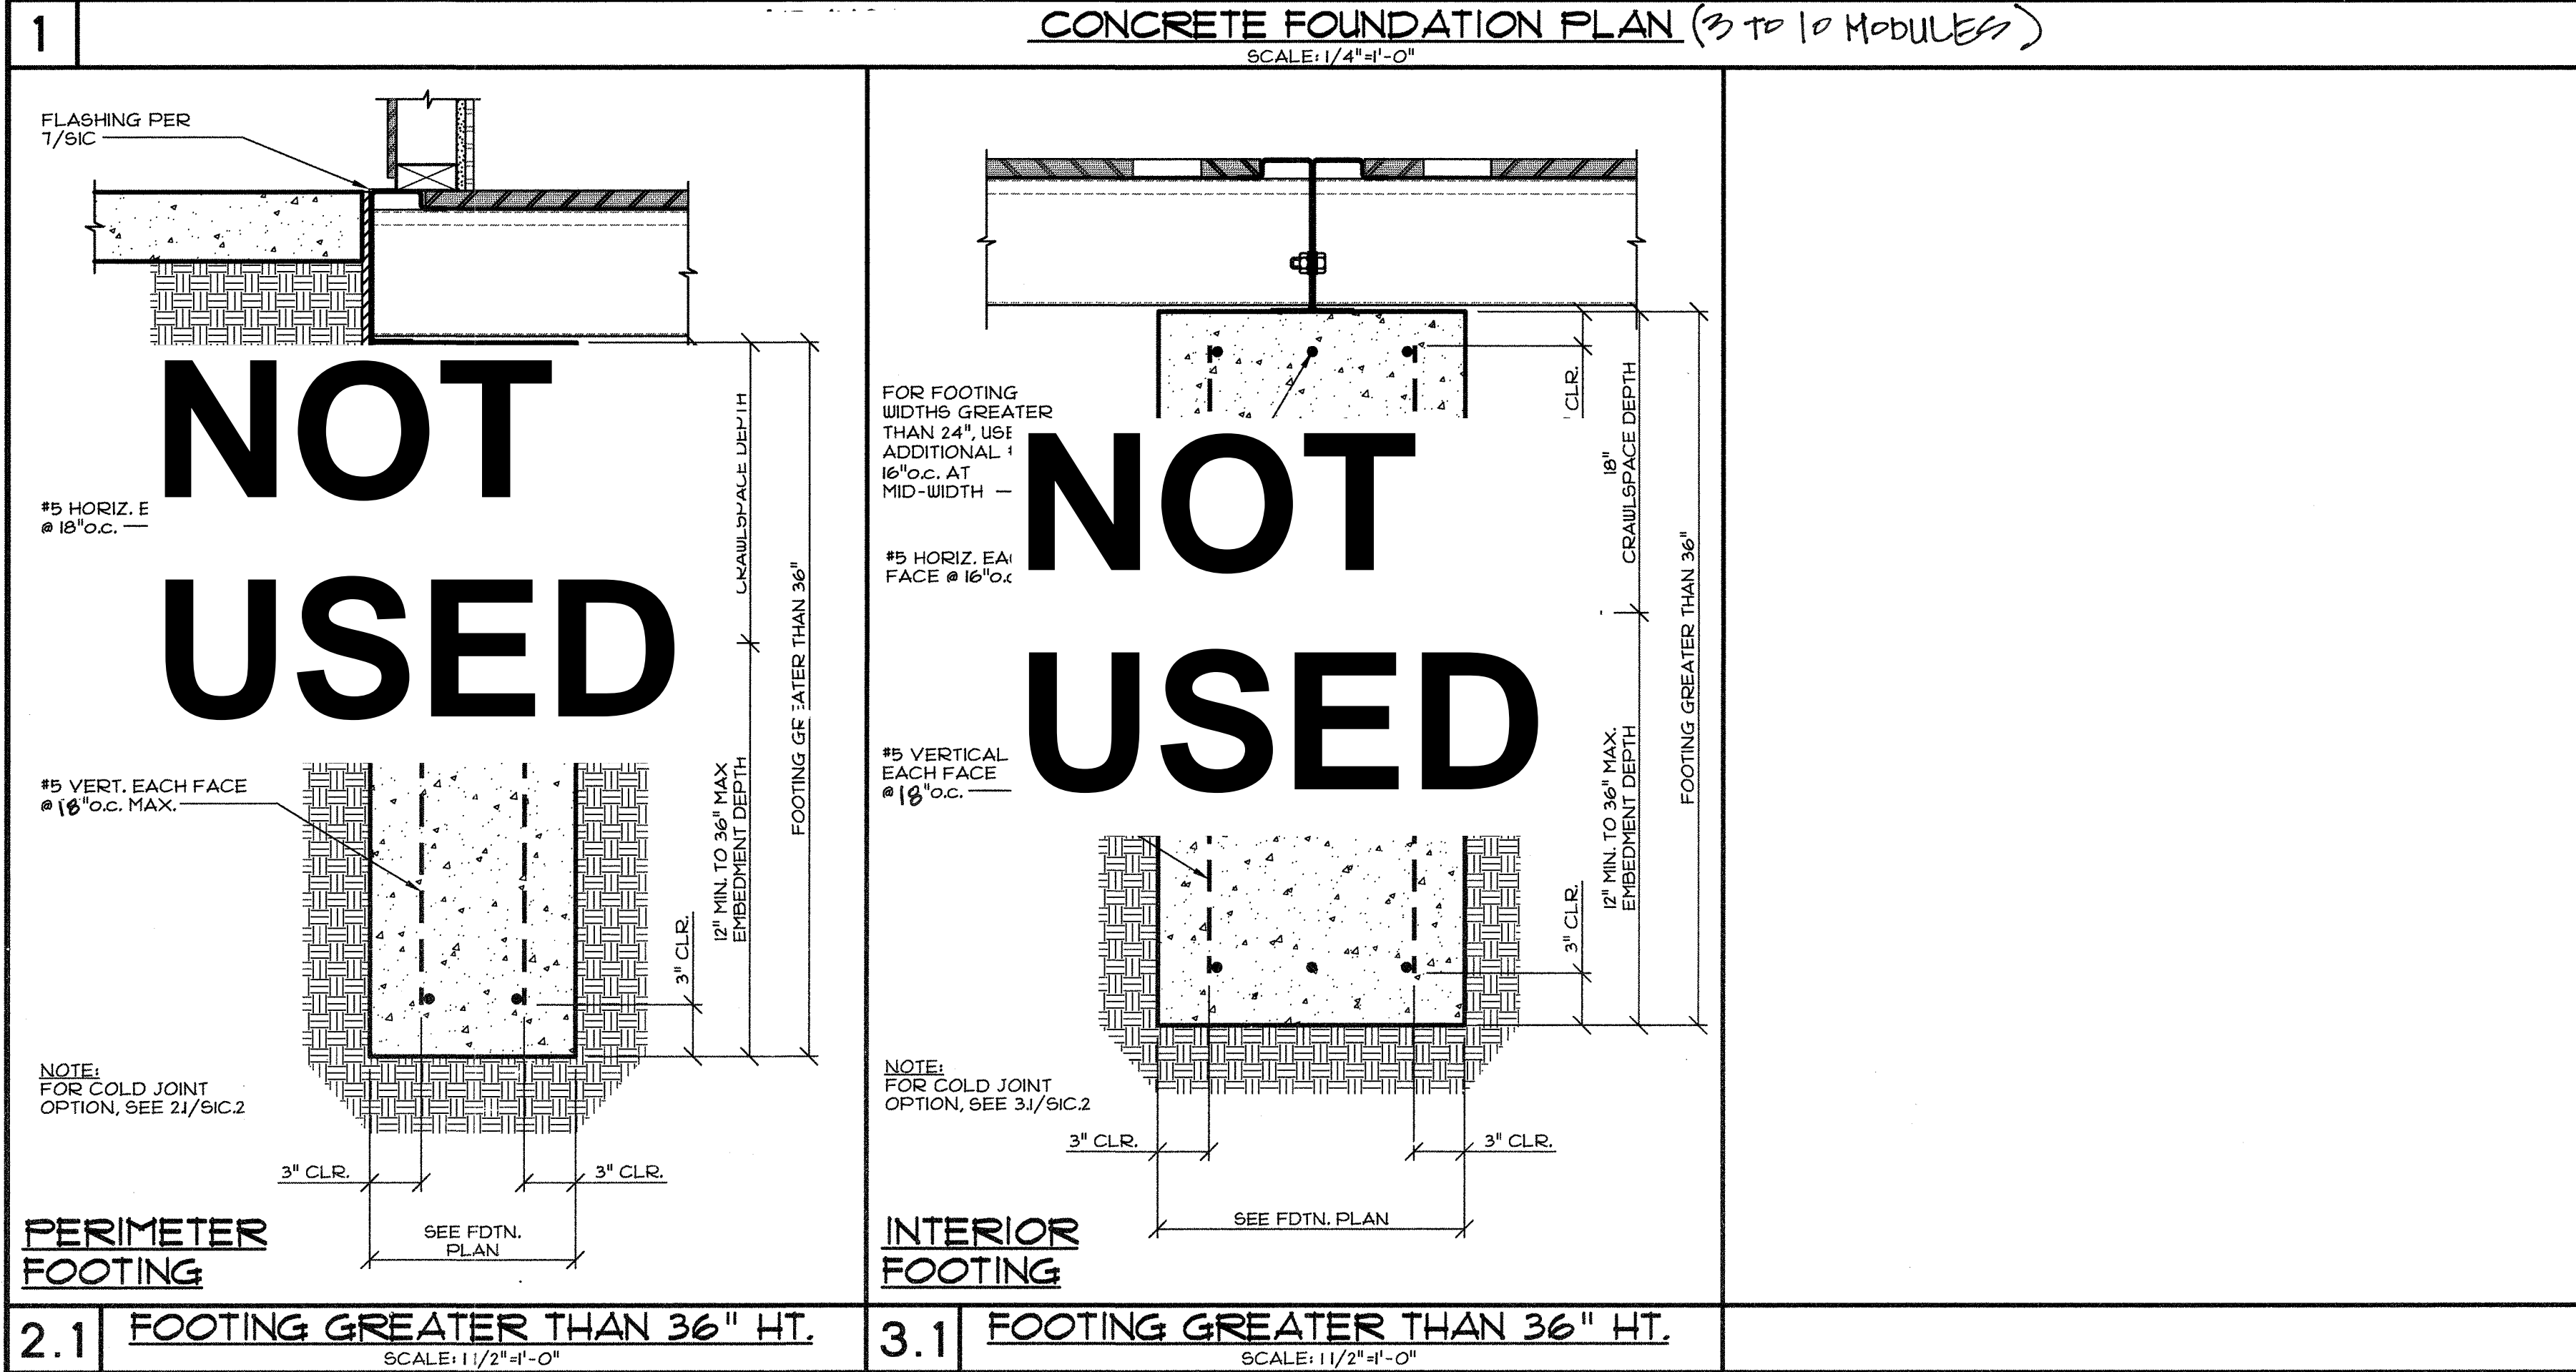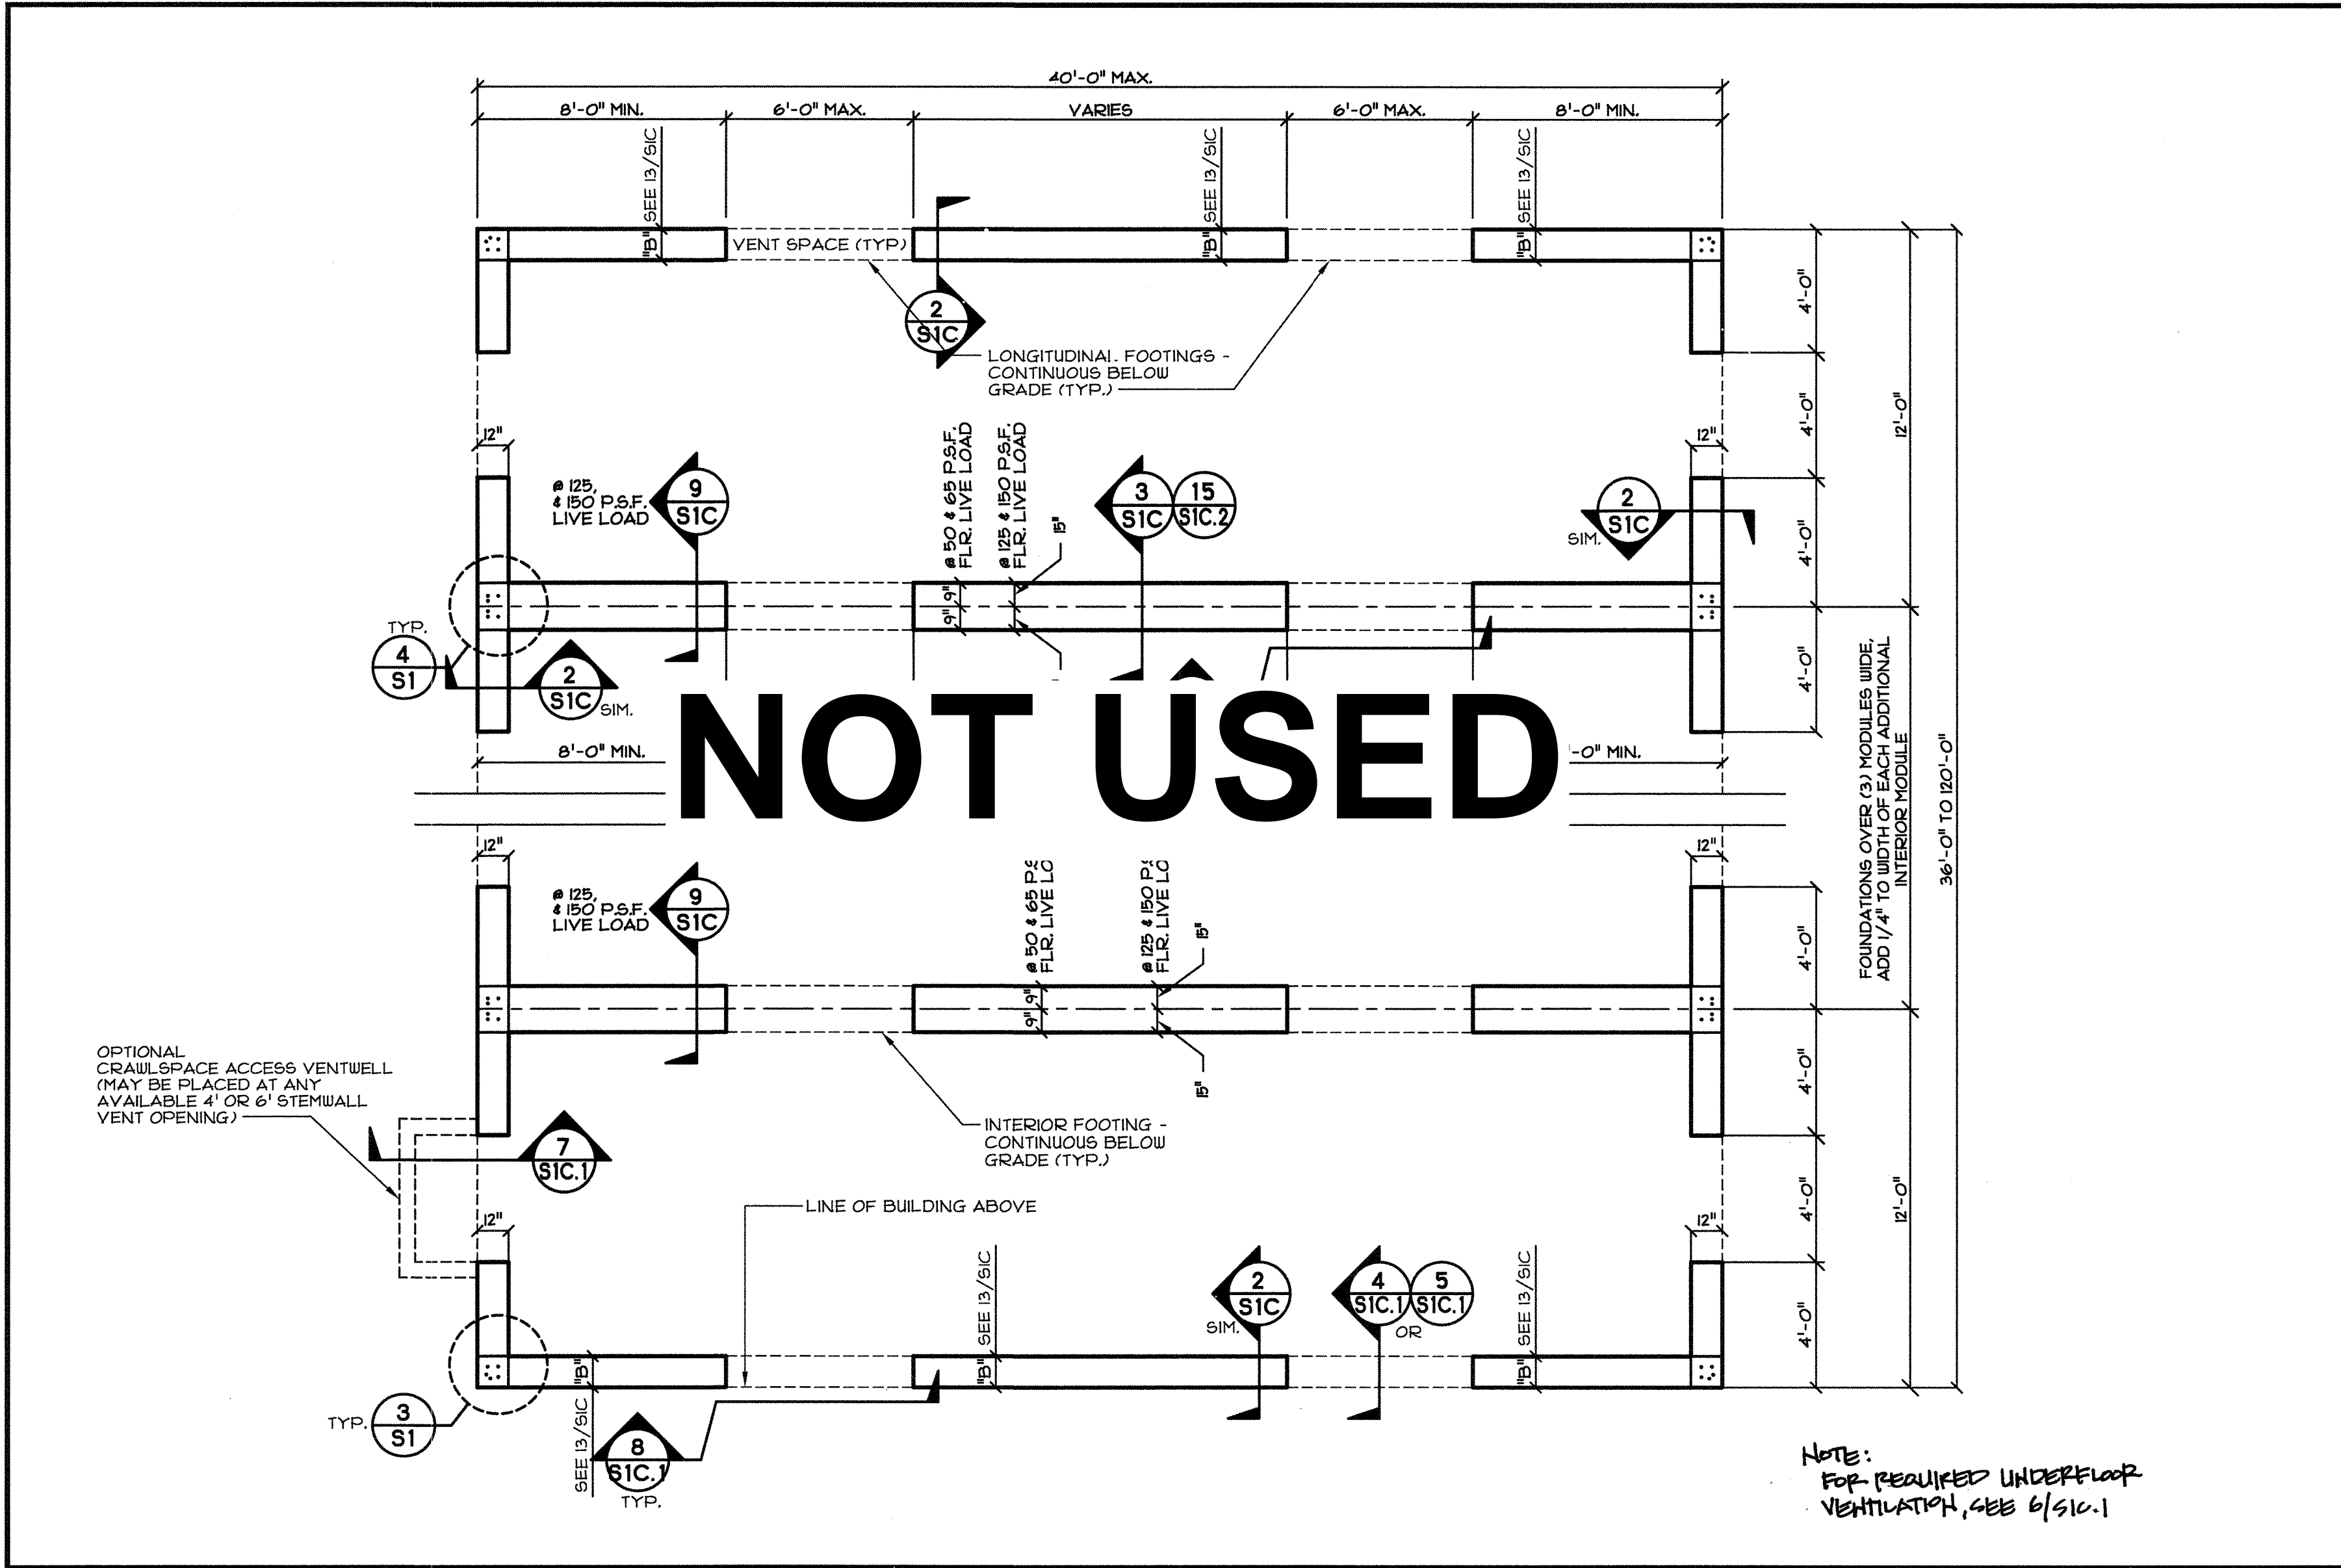

|                                      |      |      |      |      |      |      |      |      |      |
|--------------------------------------|------|------|------|------|------|------|------|------|------|
| NO. OF MODULES                       | 2    | 3    | 4    | 5    | 6    | 7    | 8    | 9    | 10   |
| EFFECTIVE NET AIR FLOW AREA (SQ/FT.) | 6.40 | 9.60 | 12.8 | 16.0 | 19.2 | 22.4 | 25.6 | 28.8 | 32.0 |

NOTE:  
1) THE ACTUAL LOCATIONS AND SIZES OF UNDER FLOOR VENTILATION OPENINGS SHALL BE SHOWN ON THE FOUNDATION PLAN, OR FLOOR PLAN OF THE SITE SPECIFIC PROJECT.  
2) VENTILATION OPENINGS SHALL BE FULLY COVERED WITH HARDWARE CLOTH OF 0.035 WIRE OR HEAVIER, EXTRUDED LOAD BEARING VENTS, OR CAST IRON GRILLES OR GRATINGS. THE LEAST DIMENSION IN THE VENT COVERING SHALL NOT BE GREATER THAN 1/4".

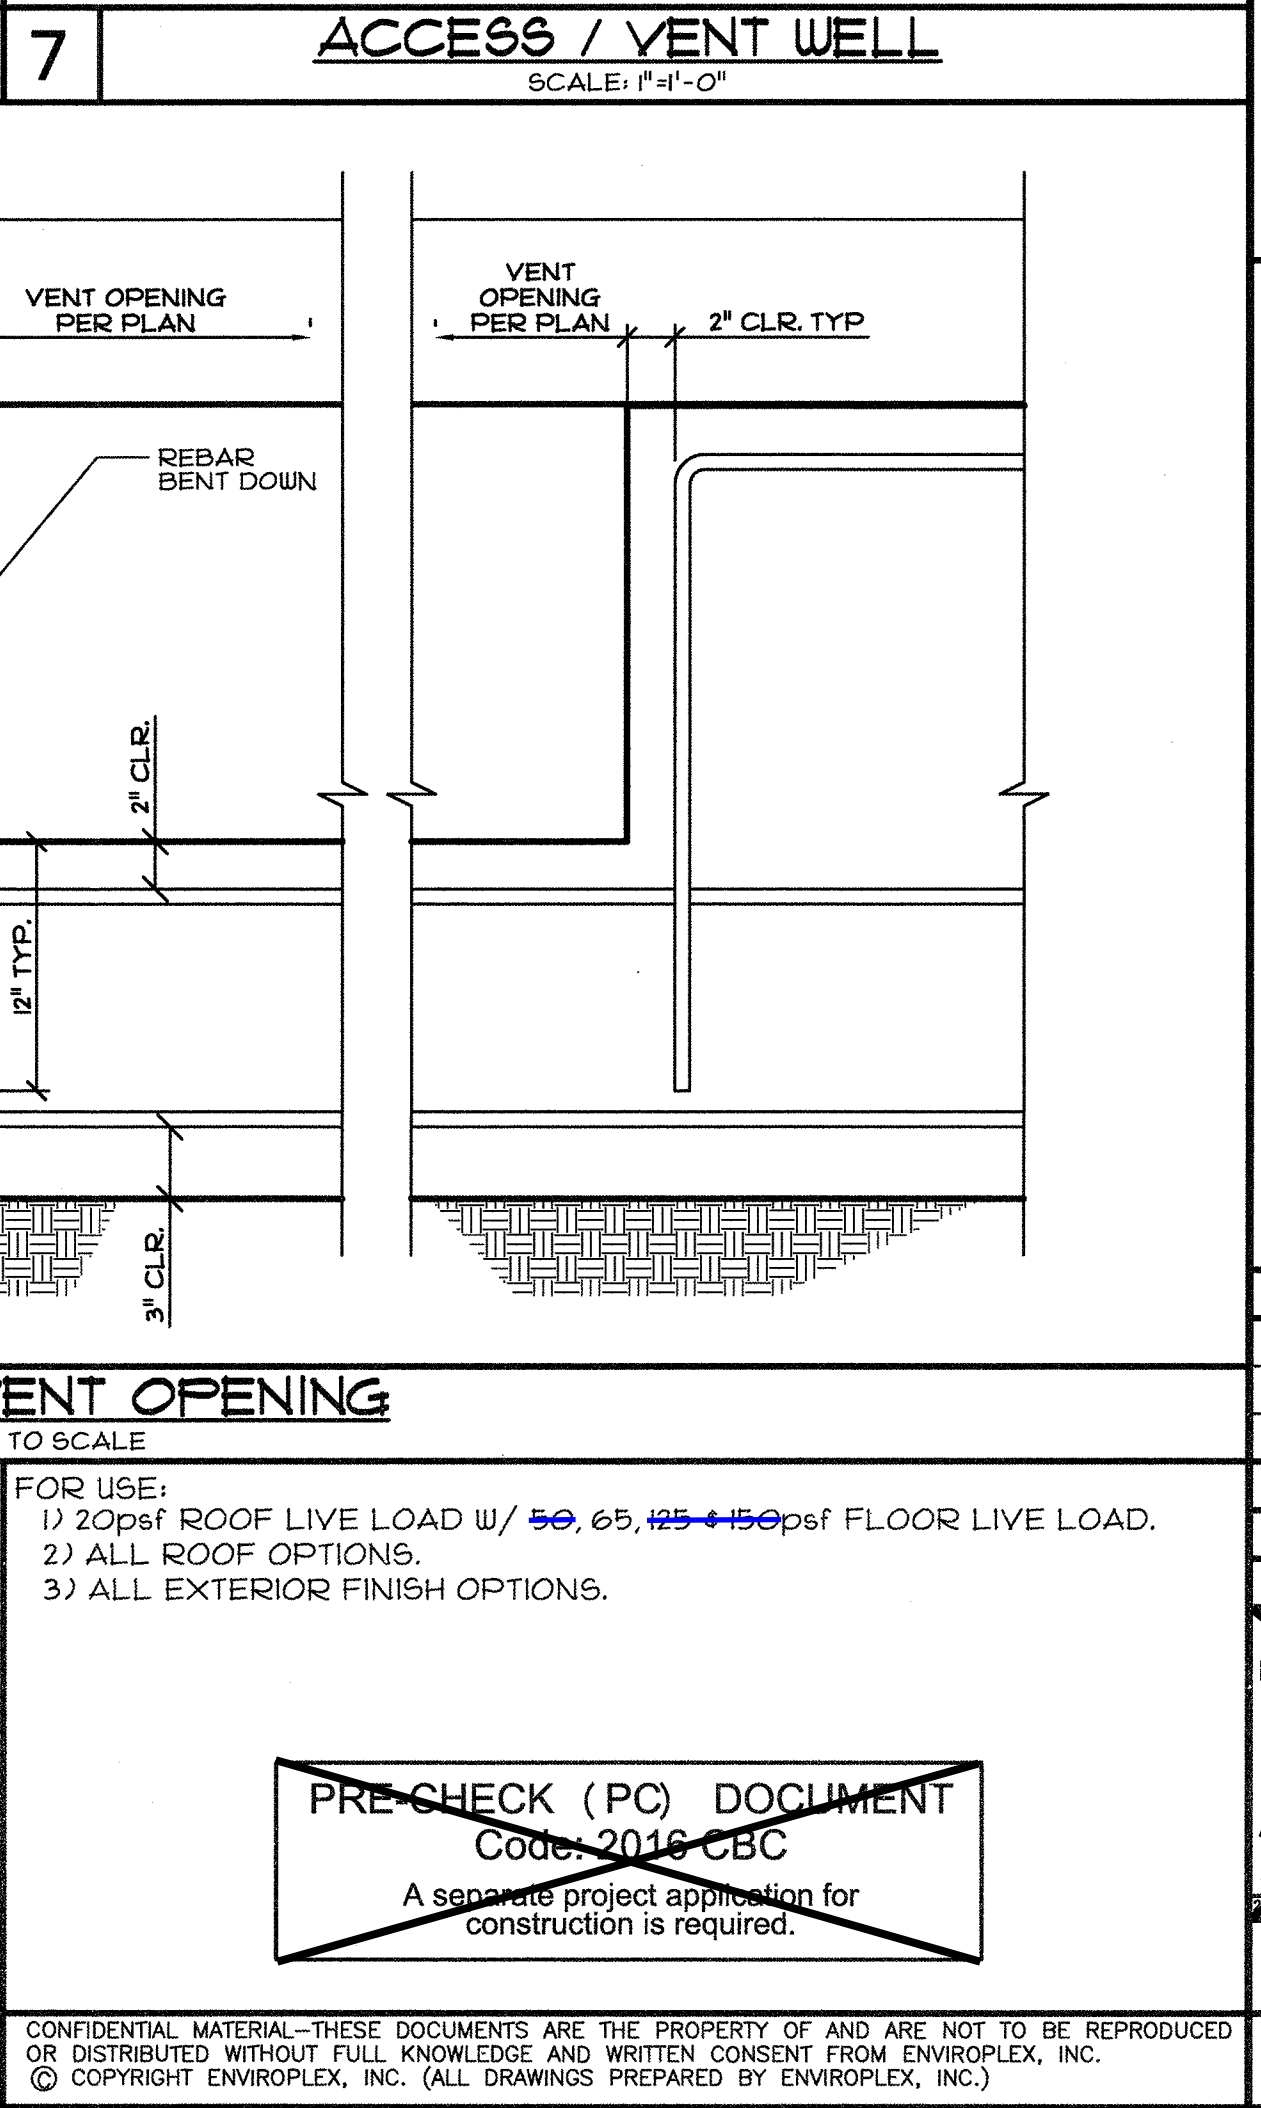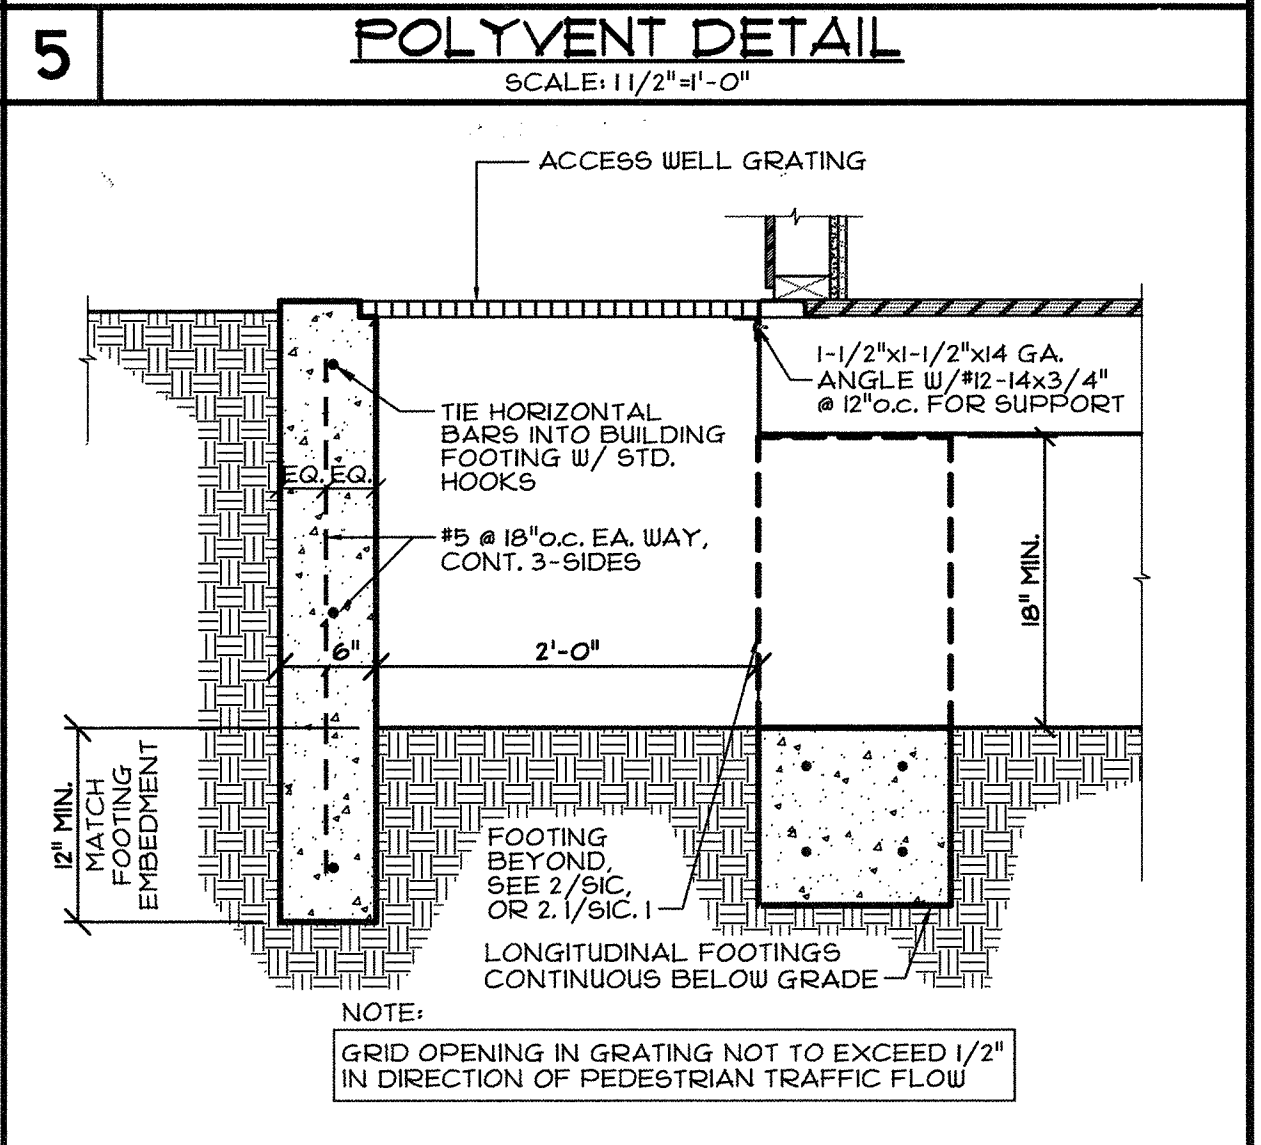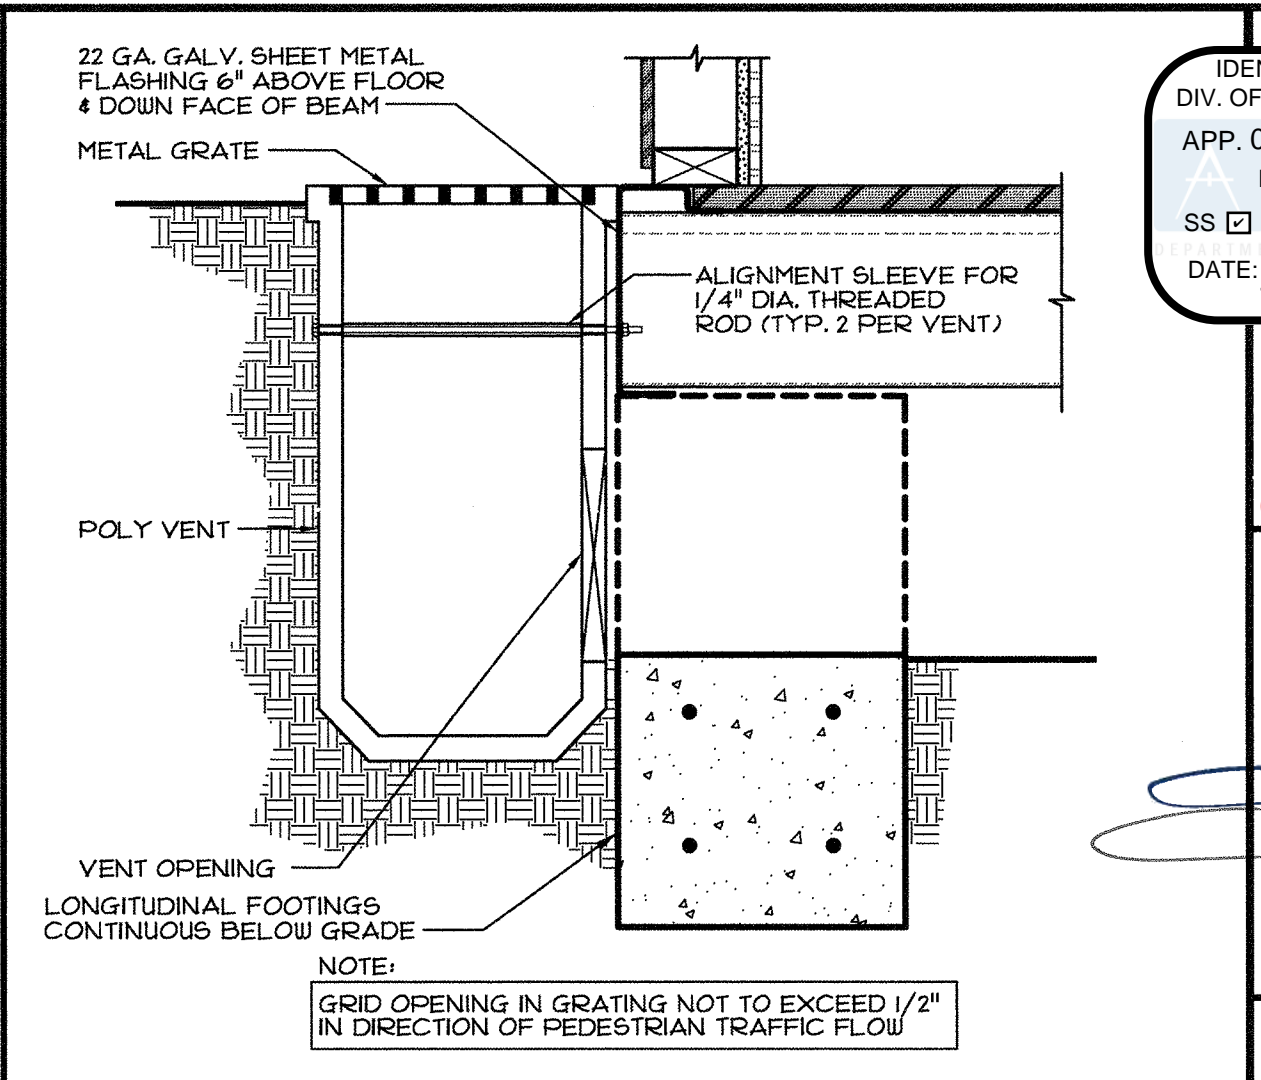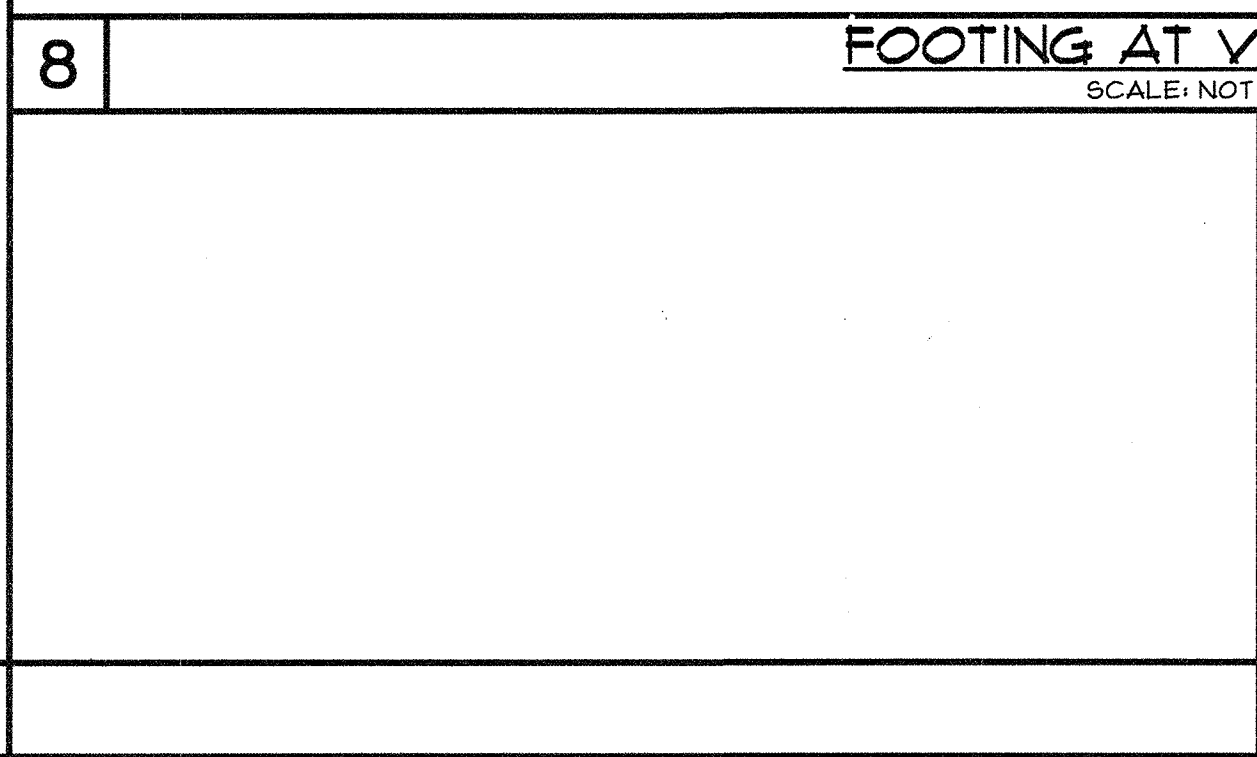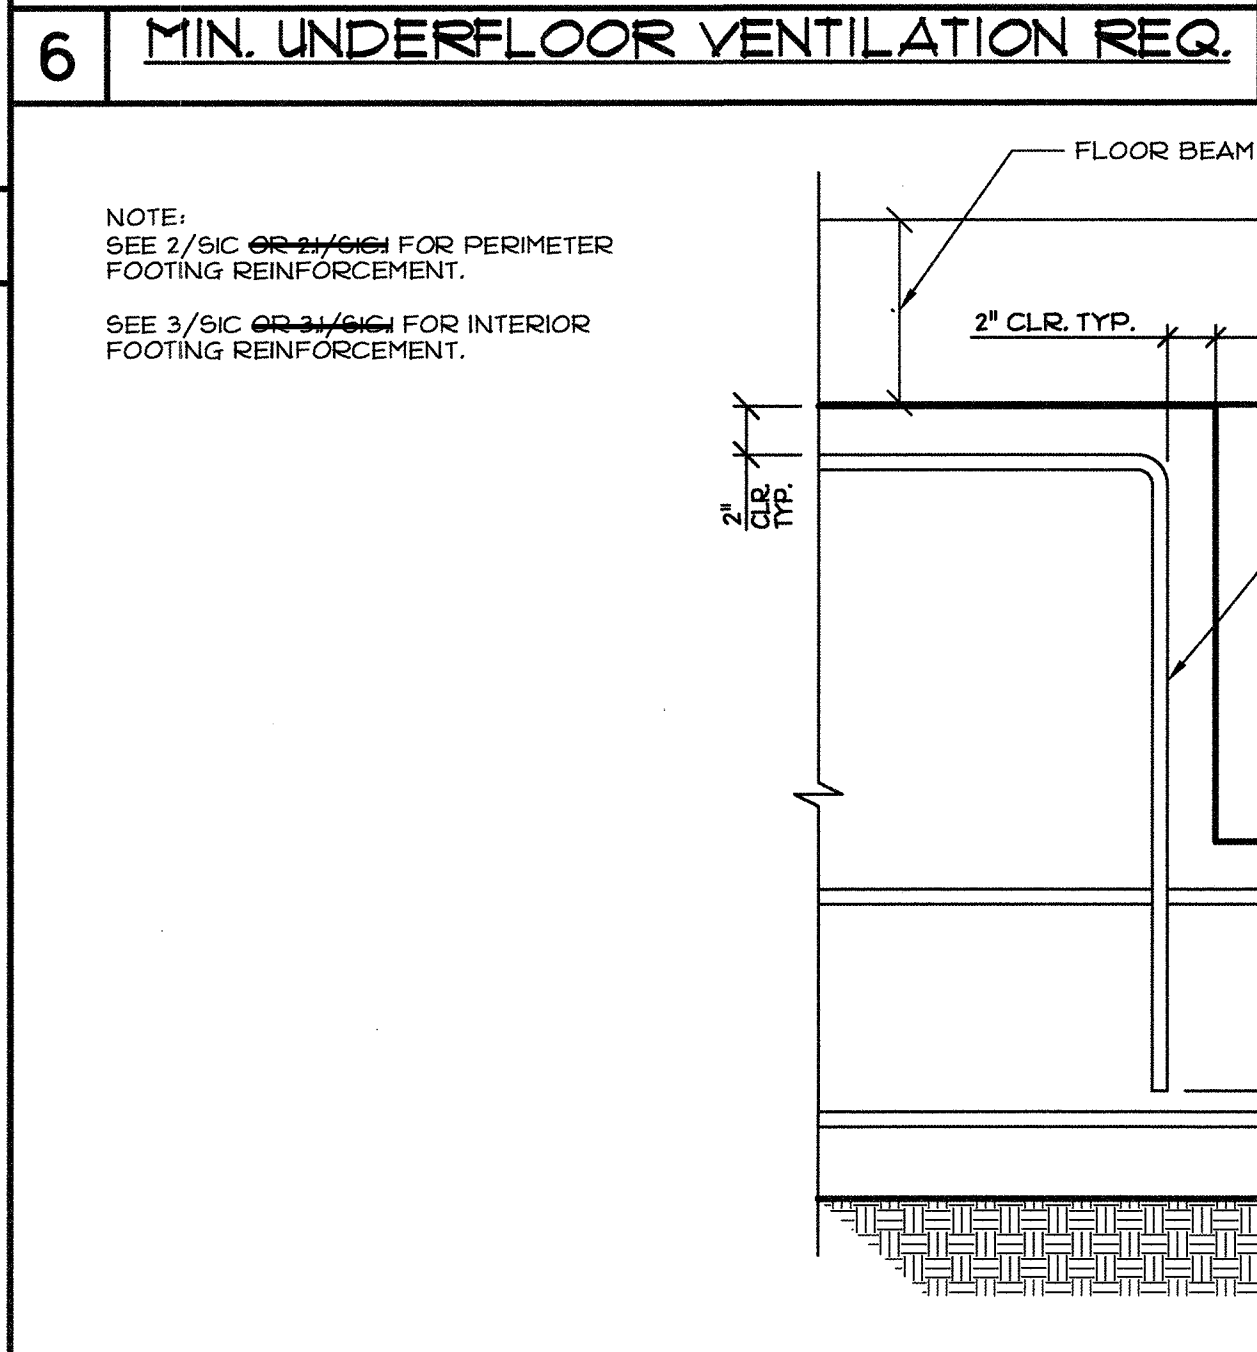

IDENTIFICATION STAMP  
DIV. OF THE STATE ARCHITECT  
APP. 02-118017 INC.  
REVIEWED FOR  
SS ☐ FLS ☐ ACS ☐  
DATE: 04/10/2020

03/26/2020

REGISTERED PROFESSIONAL ENGINEER  
No. S2030  
ENVIROPLEX, INC.

THESE DRAWINGS ARE PRELIMINARY  
AND NOT FOR CONSTRUCTION  
UNLESS STAMPED & SIGNED BY  
THE ENGINEER OF RECORD.

**ENVIROPLEX, INC.**  
4777 E. CARPENTER ROAD STOCKTON, CA 95215, (209) 466-8000  
CESAR CHAVEZ HIGH SCHOOL - ATHLETIC FACILITY  
STOCKTON UNIFIED SCHOOL DISTRICT  
2929 WINDFLOWER LANE STOCKTON, CA 95212

VARIABLE FOUNDATION PLAN,  
& ALTERNATE FOOTING DETAILS  
(WOOD FLOORS)

REV / DATE: BY:

JOB No.:  
DRAWN BY:  
DATE:

IDENTIFICATION STAMP  
DIVISION OF THE STATE ARCHITECT  
02-118094  
AC. FLS. S. SEC.  
DATE: 9-6-2018  
18-2040


LOW SEISMIC

SIC.1

PRE-CHECK (PC) DOCUMENT  
Code: 2016 CBC  
A separate project application for  
construction is required.

CONFIDENTIAL MATERIAL - THESE DOCUMENTS ARE THE PROPERTY OF AND ARE NOT TO BE REPRODUCED  
OR DISTRIBUTED WITHOUT FULL KNOWLEDGE AND WRITTEN CONSENT FROM ENVIROPLEX, INC.  
© COPYRIGHT ENVIROPLEX, INC. (ALL DRAWINGS PREPARED BY ENVIROPLEX, INC.)



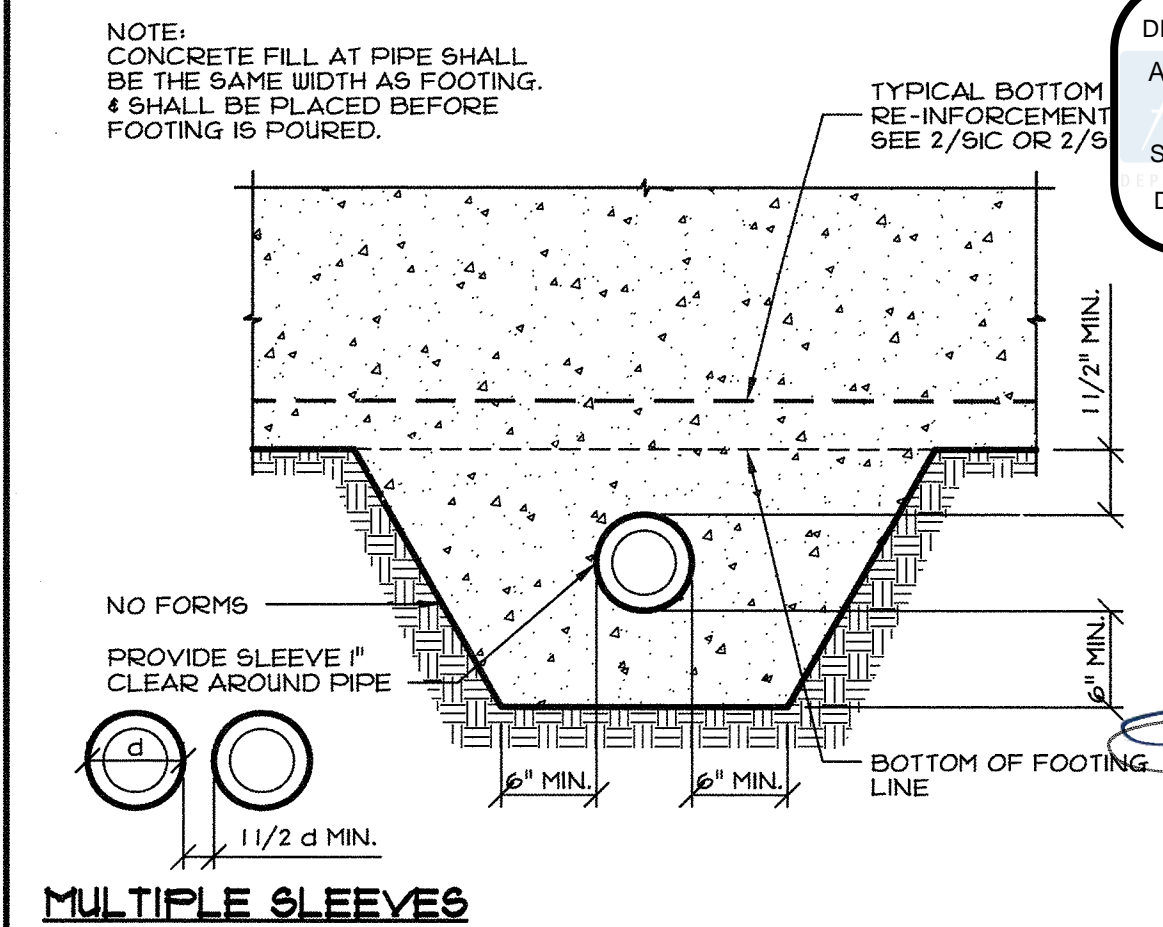

IDENTIFICATION STAMP  
DIV. OF THE STATE ARCHITECT  
APP. 02-118017 INC:  
REVIEWED FOR  
SIS ☒ FLS ☒ ACS ☒  
DATE: 04/10/2020  
C  
STRUCTURA  
2405 Natdom  
Sacra  
(916) 960-6080 (717) 940-1336 Fax  
www.cyeeging.com  
03/26/2020

A circular professional engineer seal for Arthur Ernest Ross, No. S2030, State of California. The seal features the text "REGISTERED PROFESSIONAL ENGINEER" around the top, "ARTHUR ERNEST ROSS" in the center, and "No. S2030" below the name. The words "STRUCTURAL" and "STATE OF CALIFORNIA" are at the bottom. A signature is written across the seal.

THESE DRAWINGS ARE PRELIMINARY  
AND NOT FOR CONSTRUCTION  
UNLESS STAMPED & SIGNED BY  
THE ENGINEER OF RECORD.

**ENVIROPLEX, INC.**  
 4777 E. CARPENTER ROAD STOCKTON, CA 95215, (209) 466-9000

MISCELLANEOUS  
FOOTING DETAILS  
(WOOD FLOORS)

|             |     |
|-------------|-----|
| REV / DATE: | BY: |
|             |     |
|             |     |
| No.:        |     |
| OWN BY:     |     |
|             |     |

IDENTIFICATION STAMP  
OF THE STATE ARCHITECT

02-116094

FLS — SS *SSC*  
9-6-2018

## S1C.2

6 PIPE BELOW BOTTOM OF FOOTING:  
SCALE: 1"=1'-0"

PLATE DIM. PER 3/51  
 (3) 1/2"

AP MIN.

FOOTING  
 + PER.

4" MIN.

4" MIN.

NOT USED

END  
 PER. PLAN

REINFORCEMENT  
 PER 3/51 FOR  
 EA. PLATE

FULL FOOT  
 WIDTH +  
 PLAN

10 EMBED WELD PLATES c SEISMIC GAP

NOTE: 1. DETAIL FOR USE WITH 50, 65, 125, 4150 PSF FLOOR LL.

16" MIN. TO 36" MAX.

16" MIN.

260 5/8" F.T.

30" L.L.

WHEN 30" 3"

12" MIN.

30" L.L.

3" CLR.

3" CLR.

42" MAX.

MIN. FOOTING WIDTH PER PLAN

MIN. FOOTING WIDTH PER PLAN

**NOT USED**

15 INTERIOR FOOTING @ SEISMIC GAP  
SCALE: 1 1/2" = 1'-0"

FOR USE:  
1) 20 psf ROOF LIVE LOAD W/ ~~50, 65, 125~~ 150 psf FLOOR LL.  
2) ALL ROOF OPTIONS.  
3) ALL EXTERIOR FINISH OPTIONS.

CONFIDENTIAL MATERIAL--THESE DOCUMENTS ARE THE PROPERTY OF AND ARE NOT TO BE REPRODUCED OR DISTRIBUTED WITHOUT FULL KNOWLEDGE AND WRITTEN CONSENT FROM ENVIROPLEX, INC.  
© COPYRIGHT ENVIROPLEX, INC. (ALL DRAWINGS PREPARED BY ENVIROPLEX, INC.)

**PIPE THROUGH FOOTING:**  
SCALE: 1"=1'-0"

---

---

---

### BENCH PROXIMITY TO FOOD

SCALE: 1 1/2" = 1'-0"

|   |  |
|---|--|
| 9 |  |
|---|--|

---

14 PROXIMITY OF NEW TO EXIST. FOOT

SCALE: 1/2 = 1-0

15 INTERIOR FOOTING @ SEISMIC GAP  
SCALE: 1 1/2" = 1'-0"

FOR USE:

|   |  |
|---|--|
| 2 |  |
|---|--|

[illegible]

# LISTED

(PROVIDE OVER 36 HOURS)

|     |   |
|-----|---|
| 2.1 | <u>HORIZONTAL COLD JOINT</u><br>SCALE: 1 1/2" = 1'-0" |
|-----|---|

SECRETARY OF THE ARMY

|   |  |
|---|--|
| 3 |  |
|---|--|

---

# USED

# USE

### 3.1 HORIZONTAL COLD JOINT

SCALE 1/2 = 10

BAR BEND DIAMETER "D"  
D=6d, EXCEPT FOR STIRRUPS  
AND TIES, USE D=4d PER #3, #4, #5

135° HOOK

COVER PER  
DETAILS

4d OR 2 1/2"

90° HOOK

12 2

12d UNLESS NOTED

# 11 TYP. REINFORCING BAR BENDS




















|    |  |
|----|--|
| 12 |  |
|----|--|

wincc\2016 - 24nd0 - 51C-2.rure 7/6/2018 2:12:22 PM














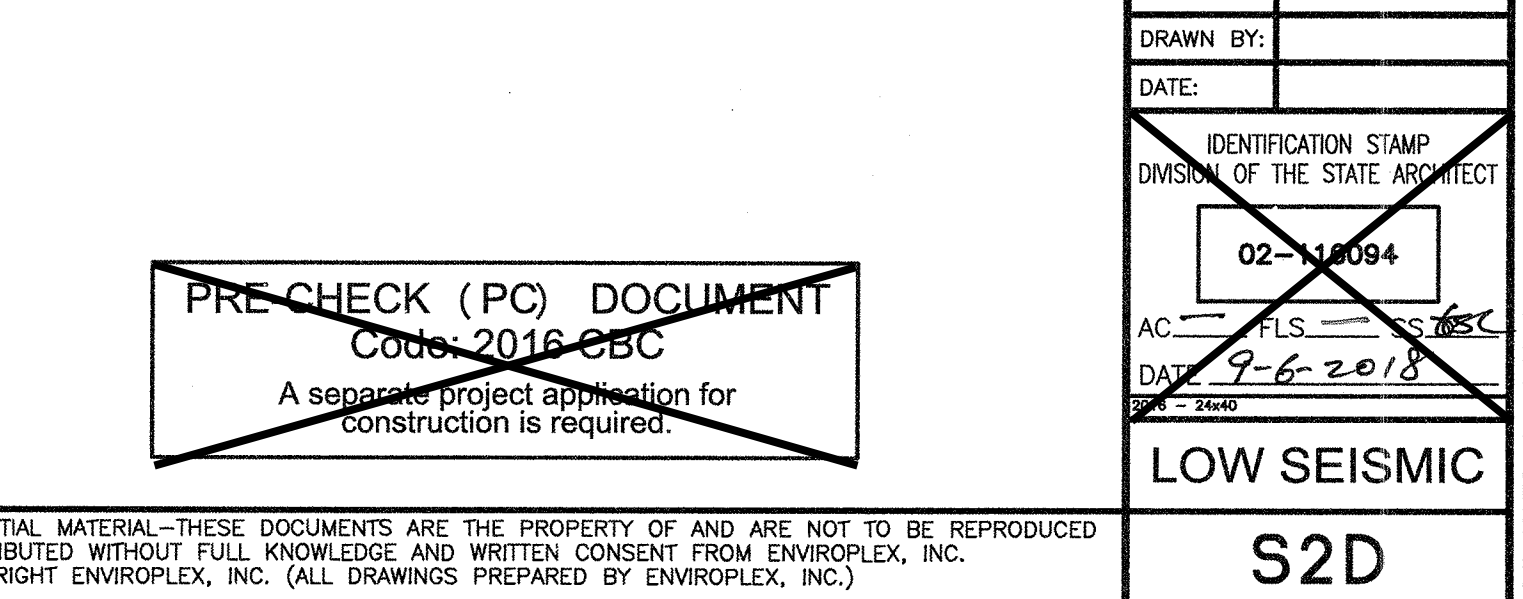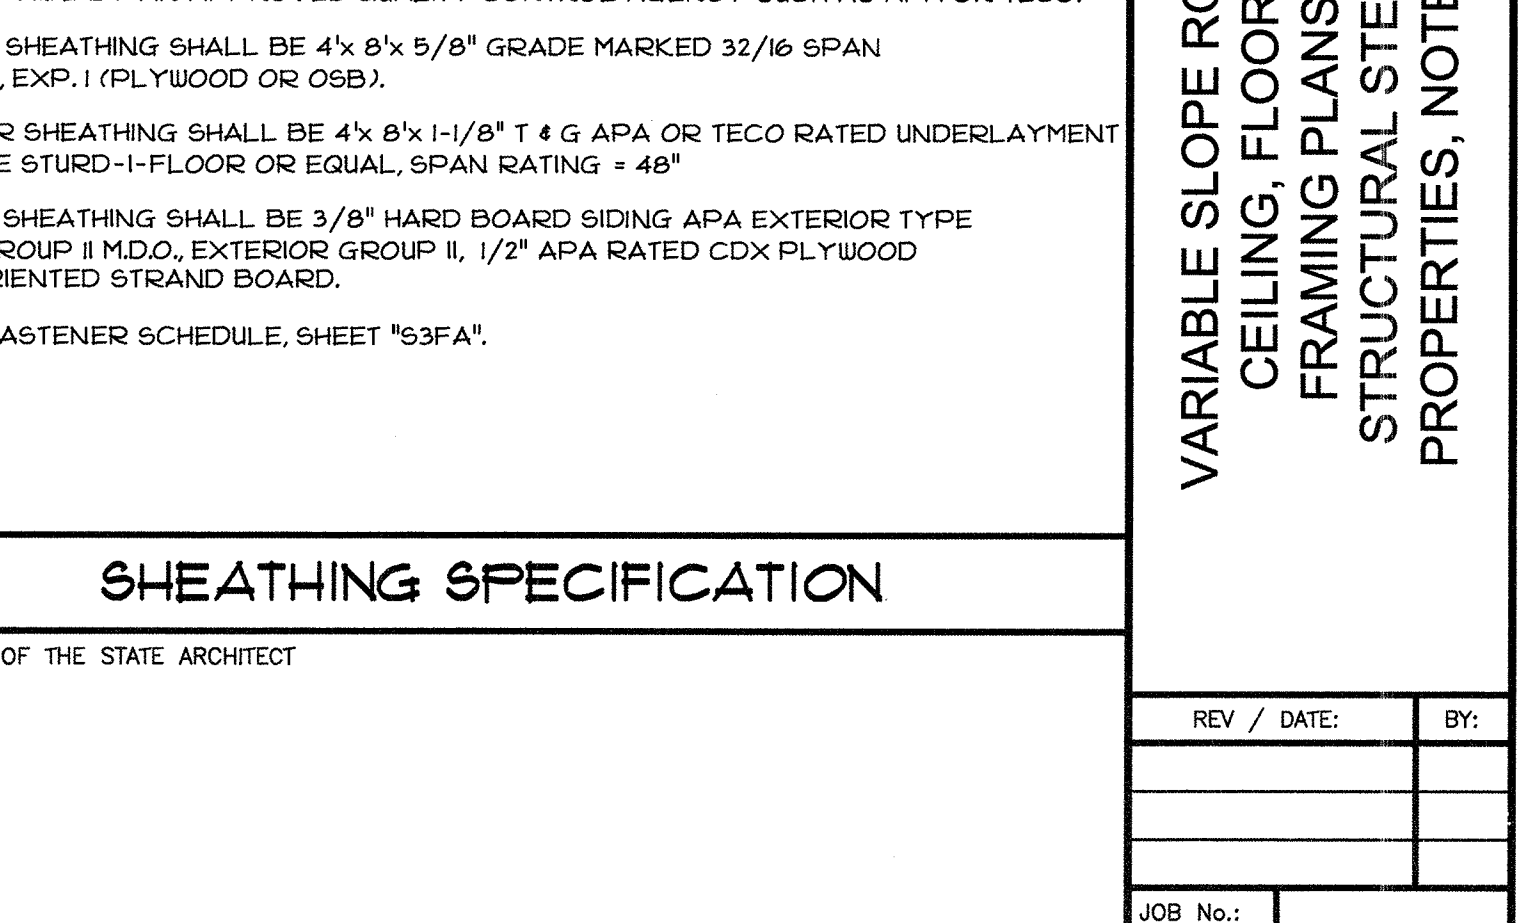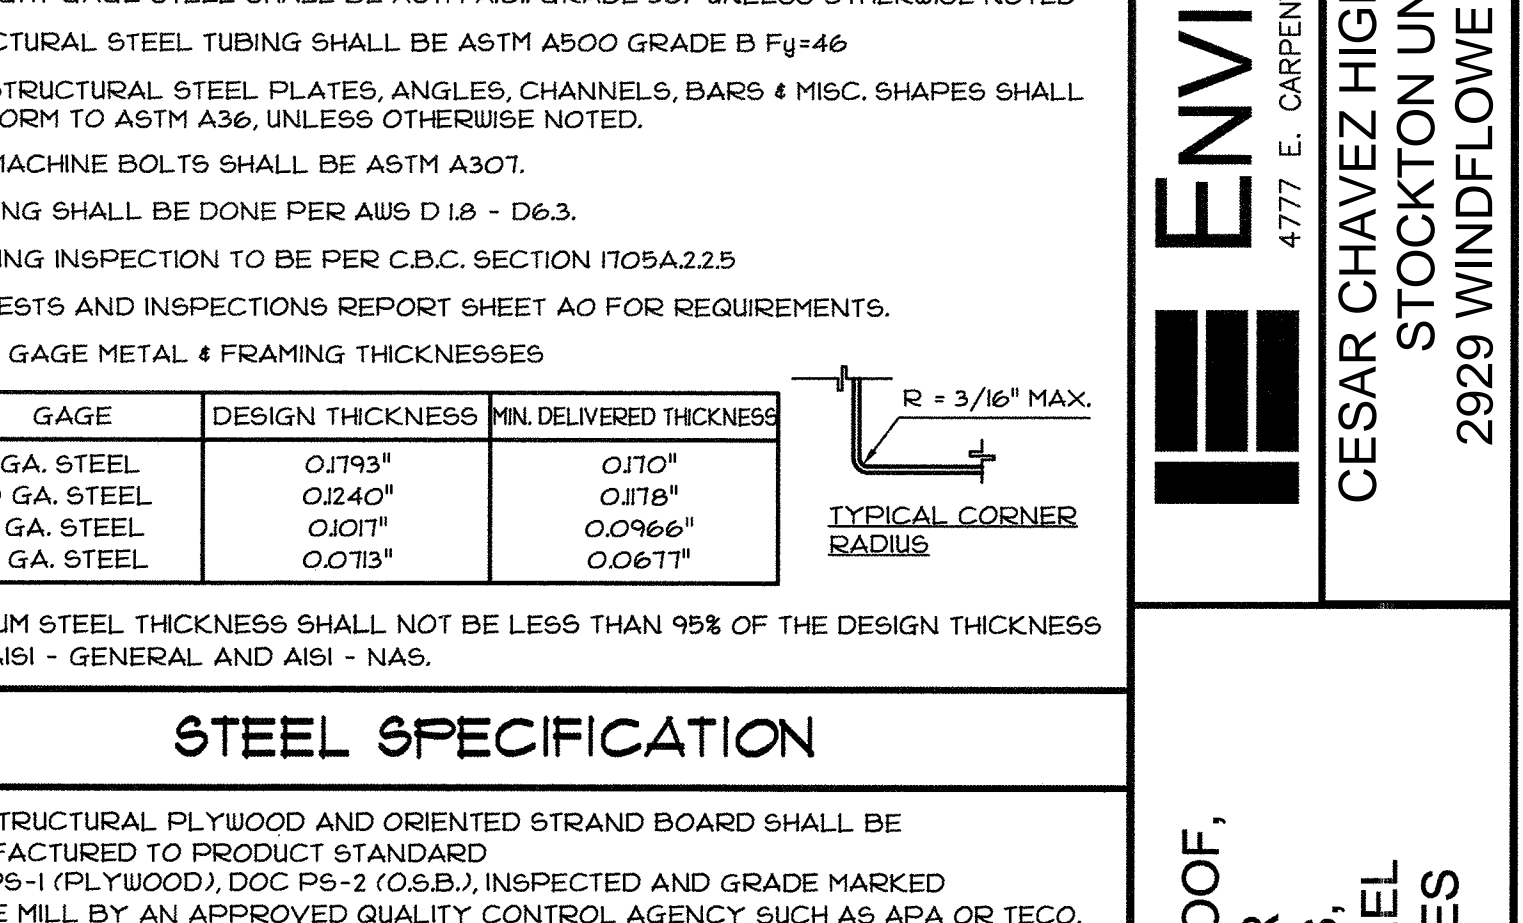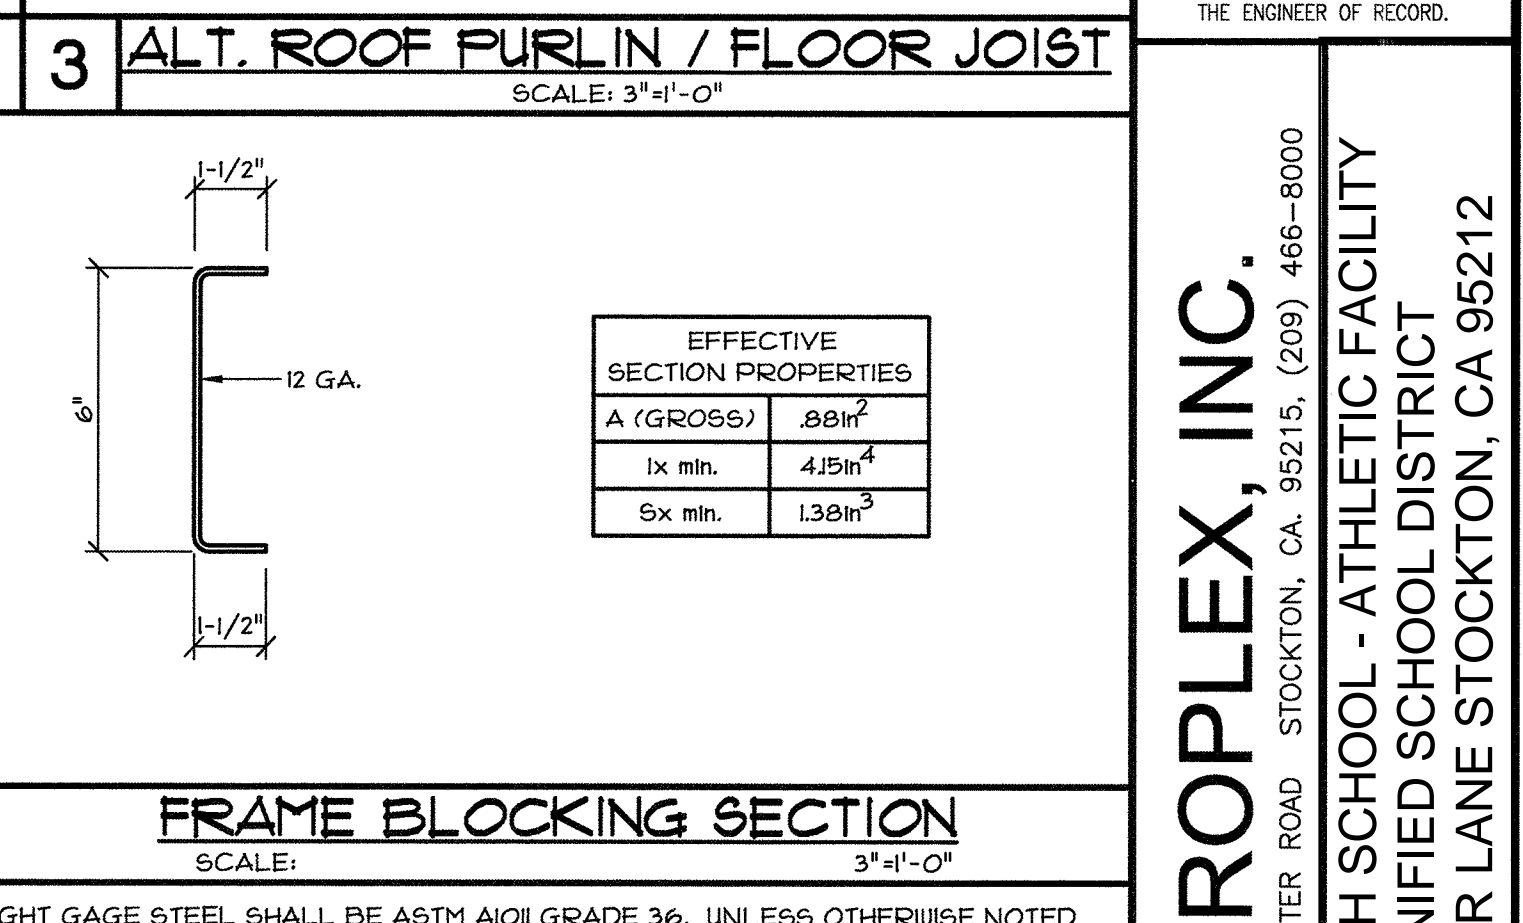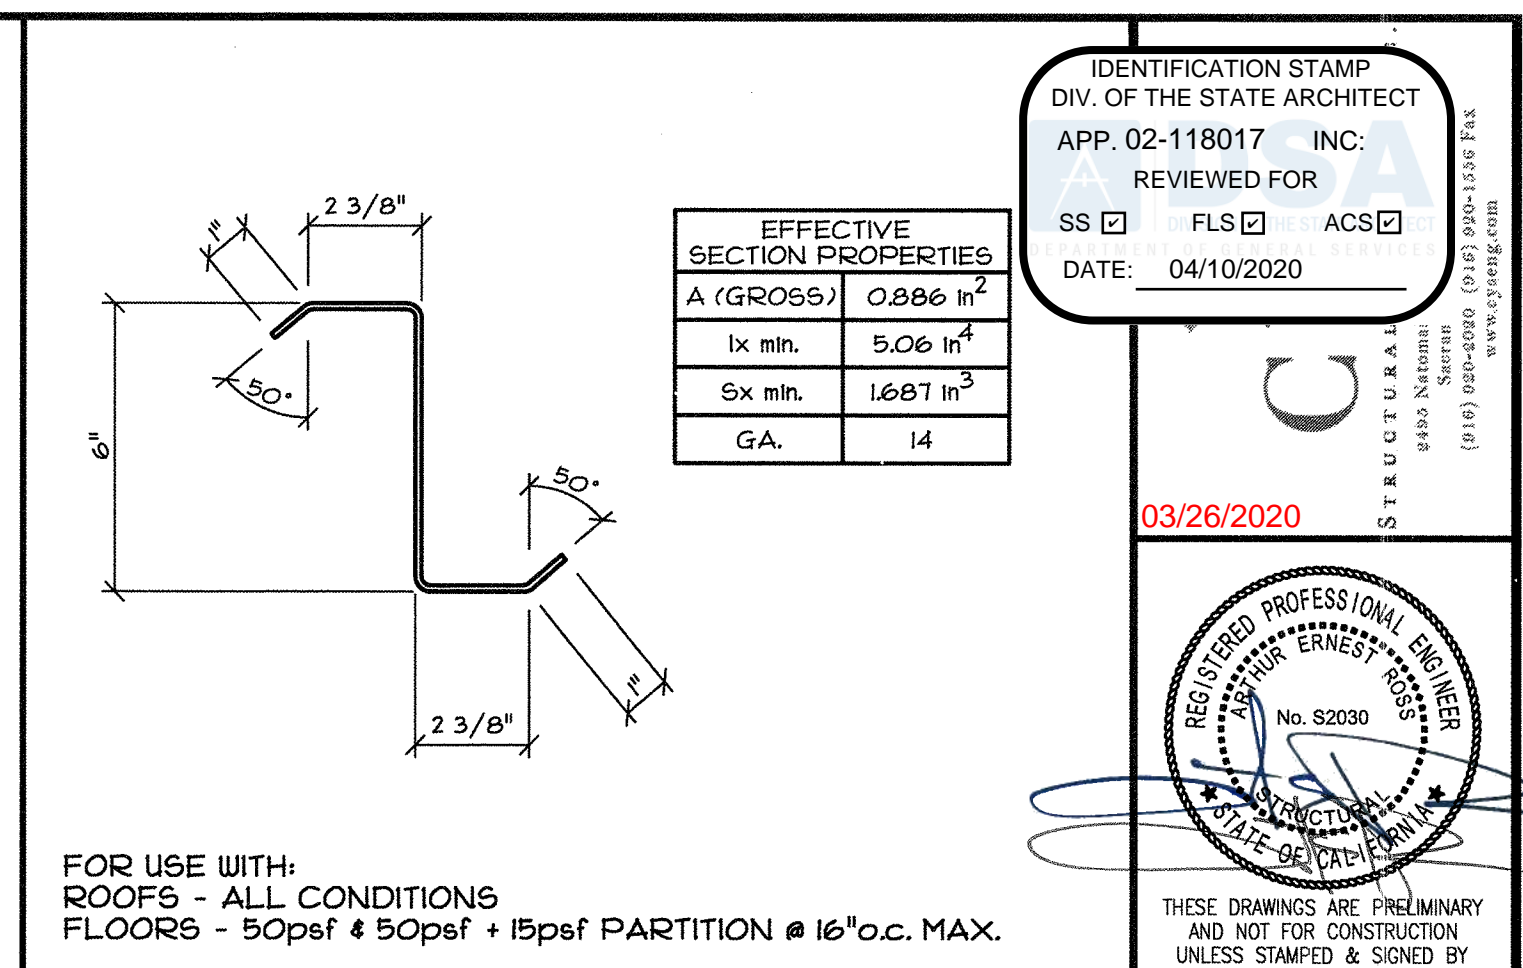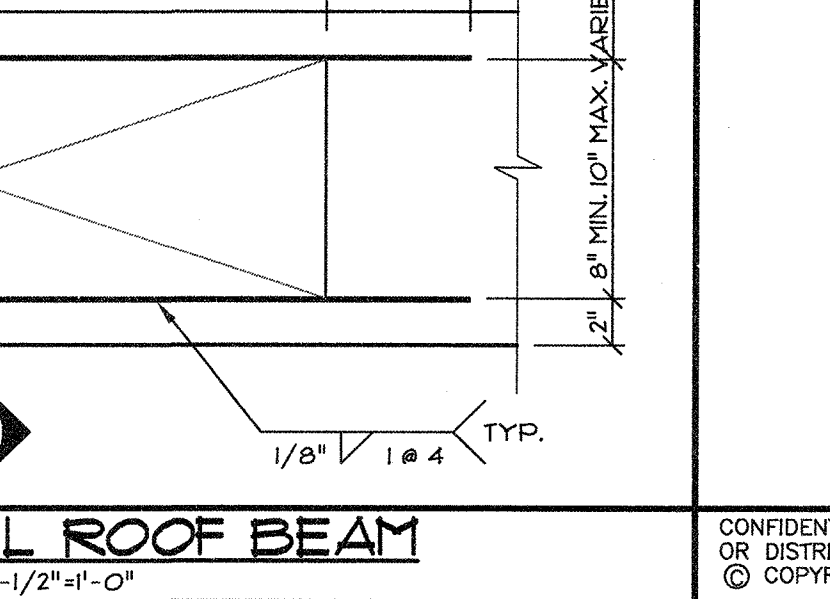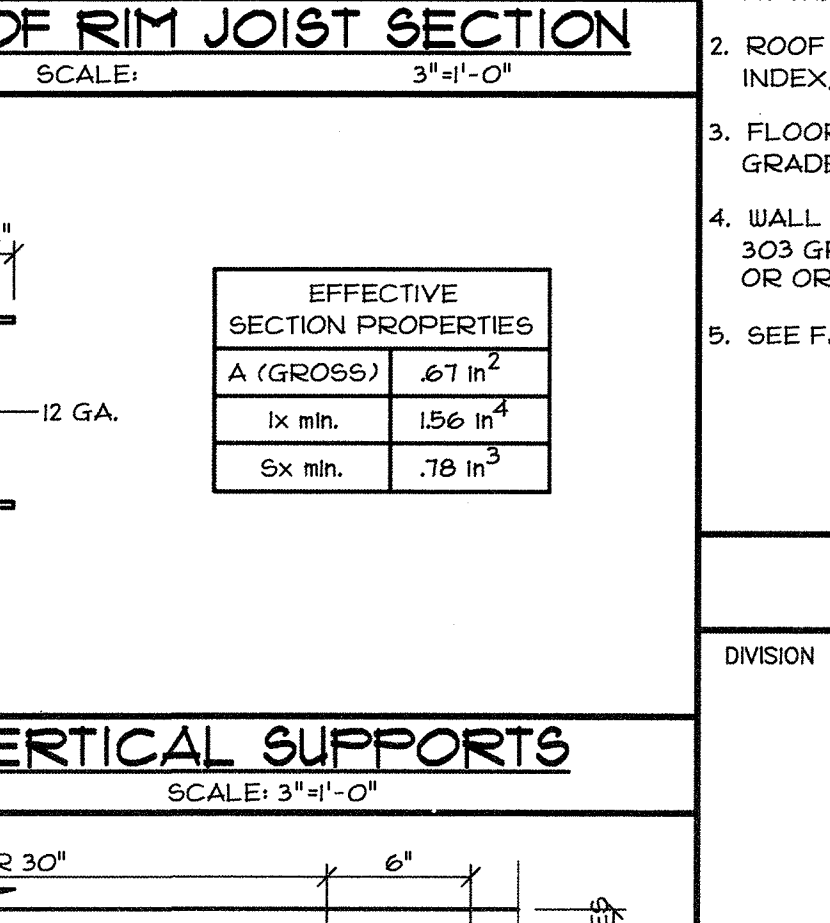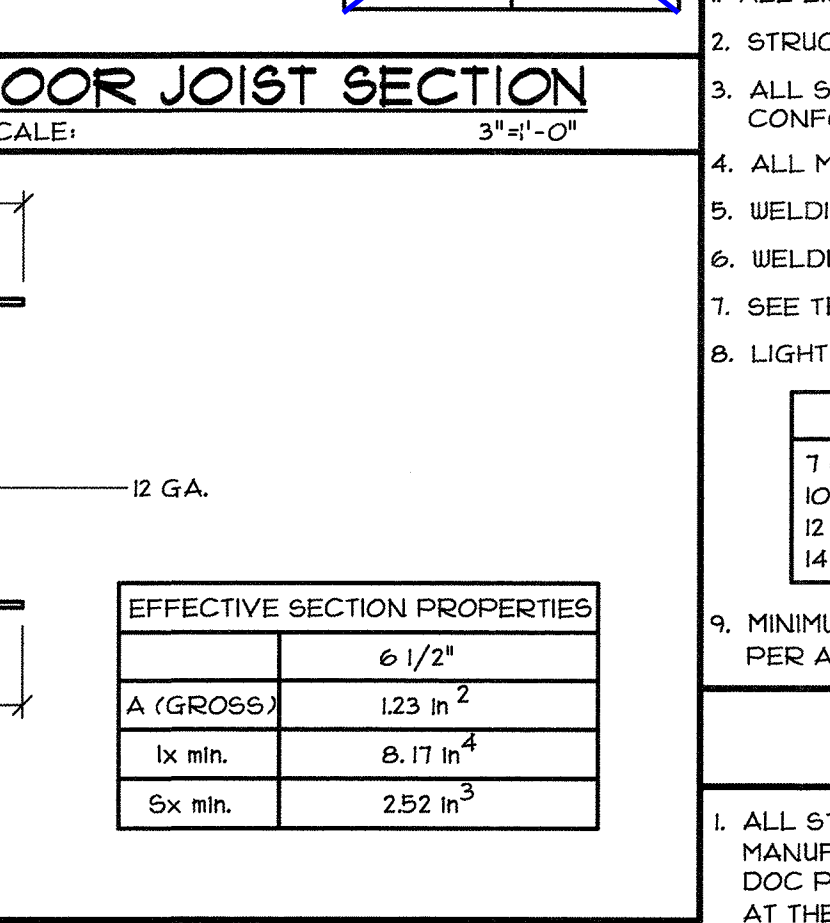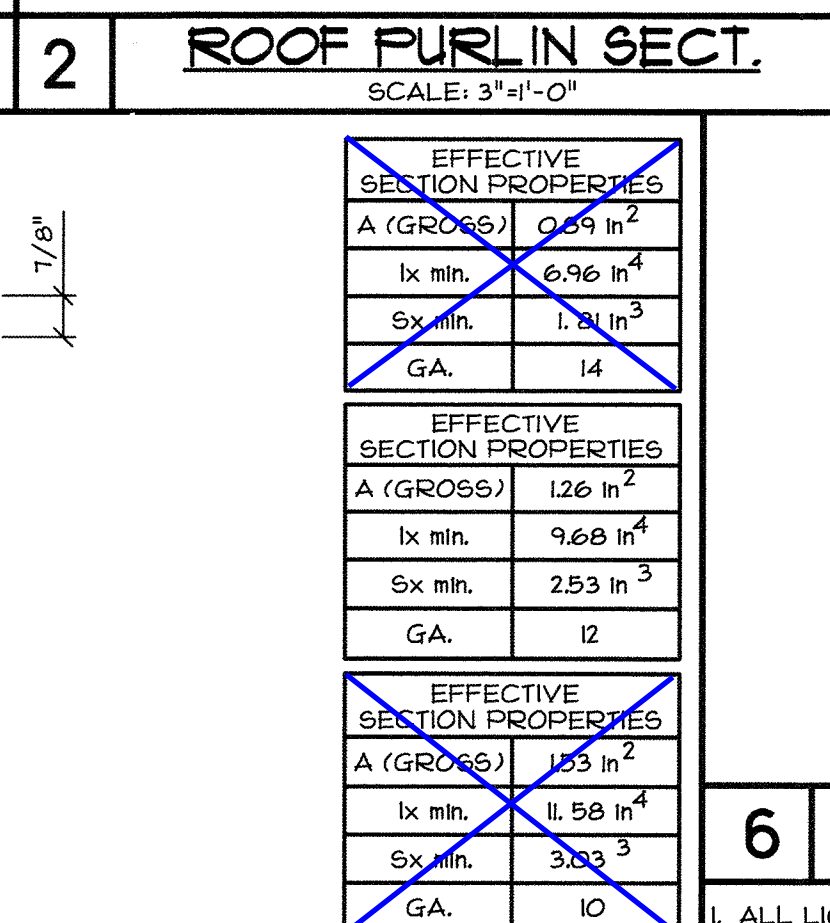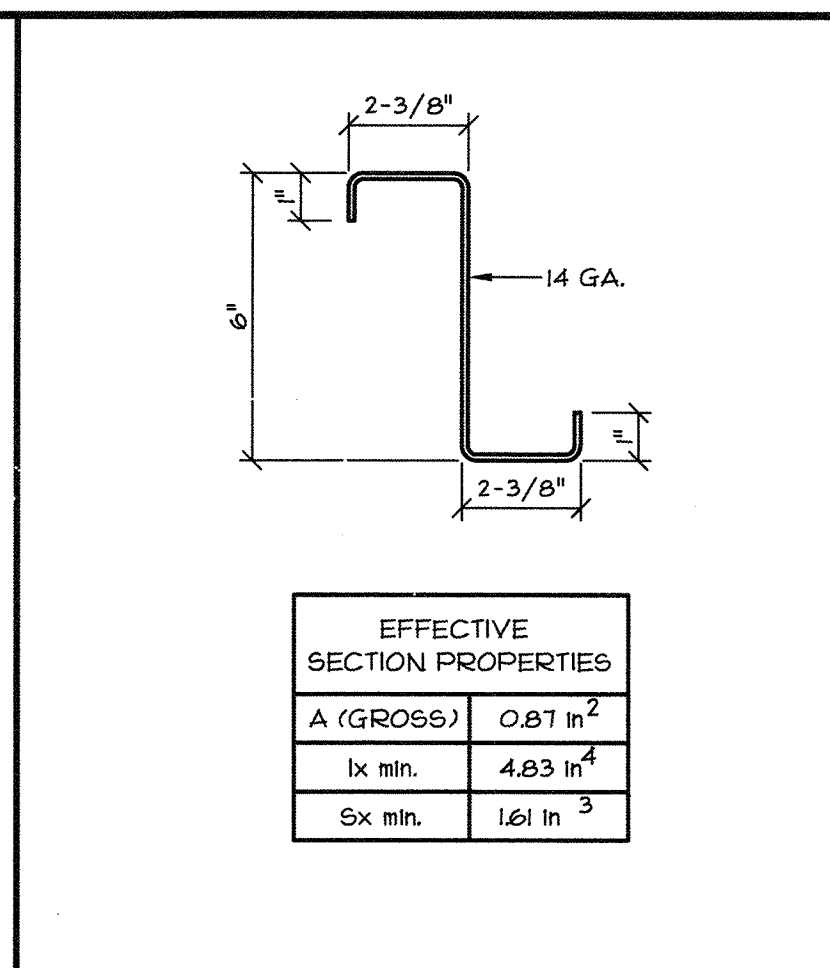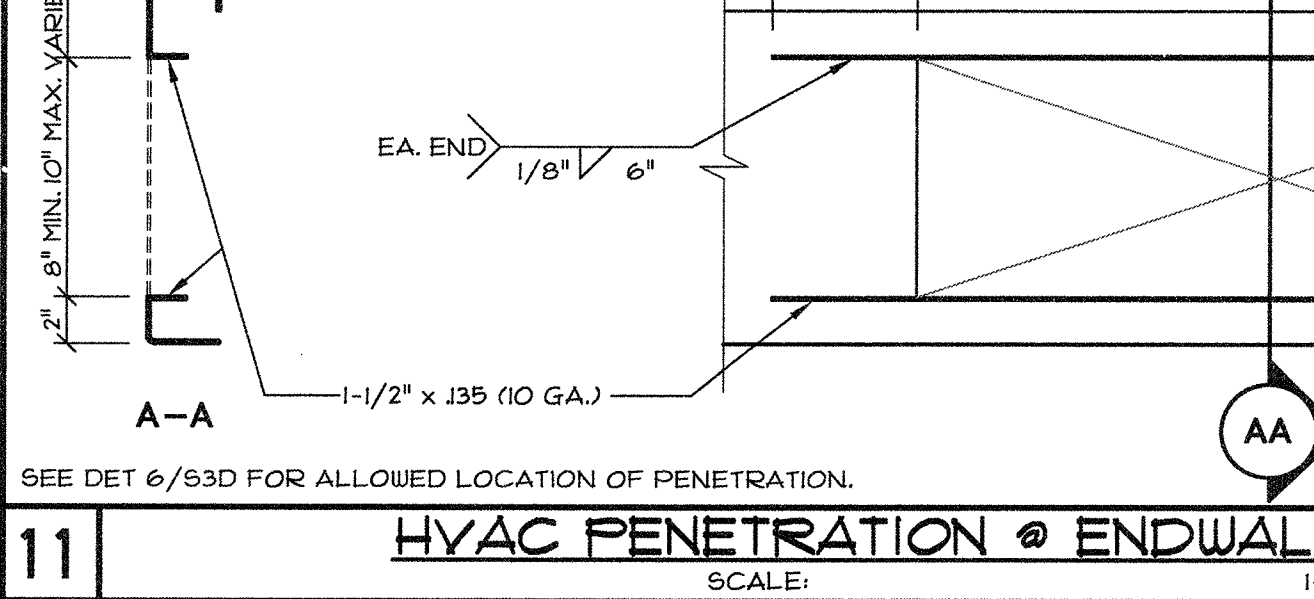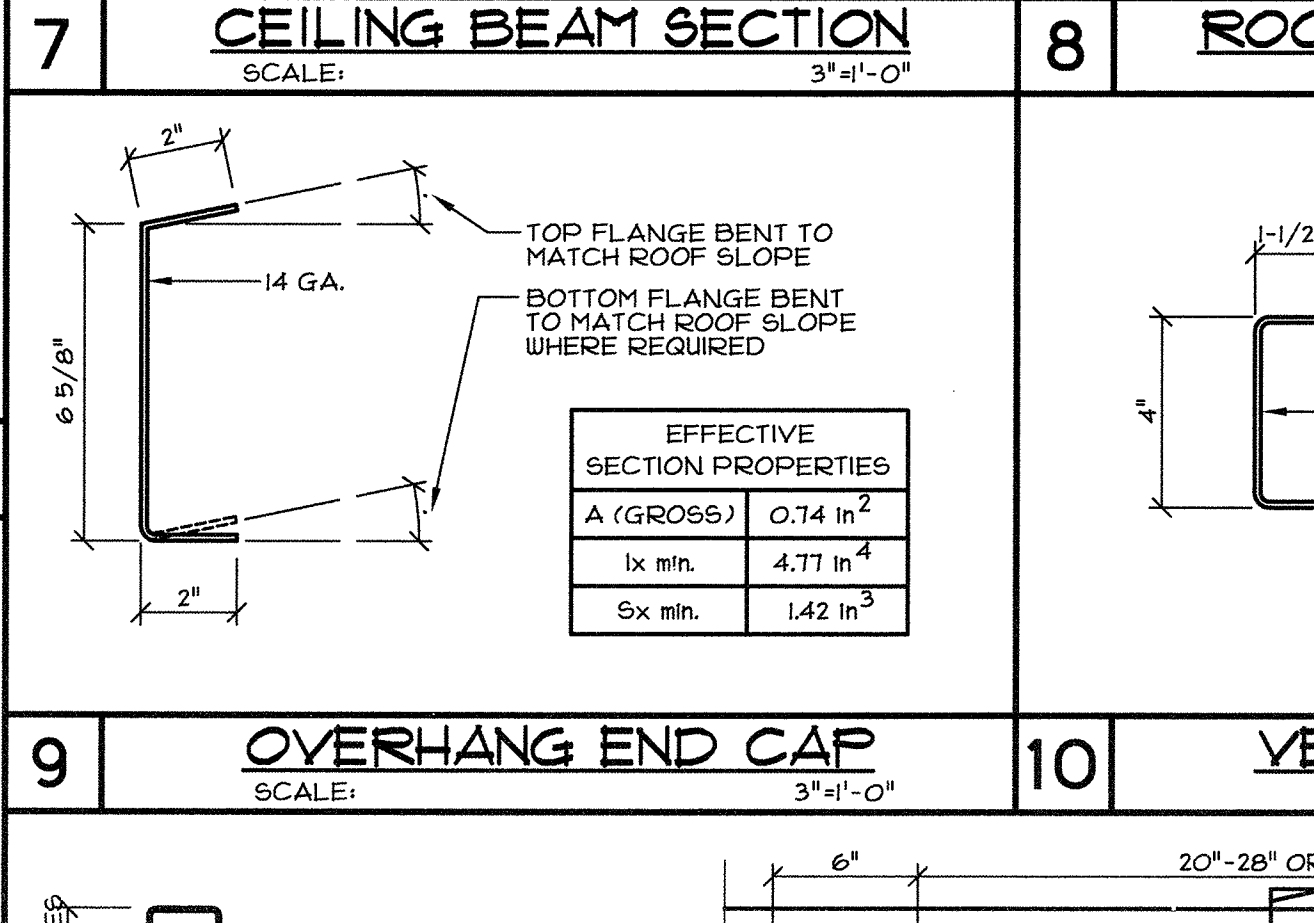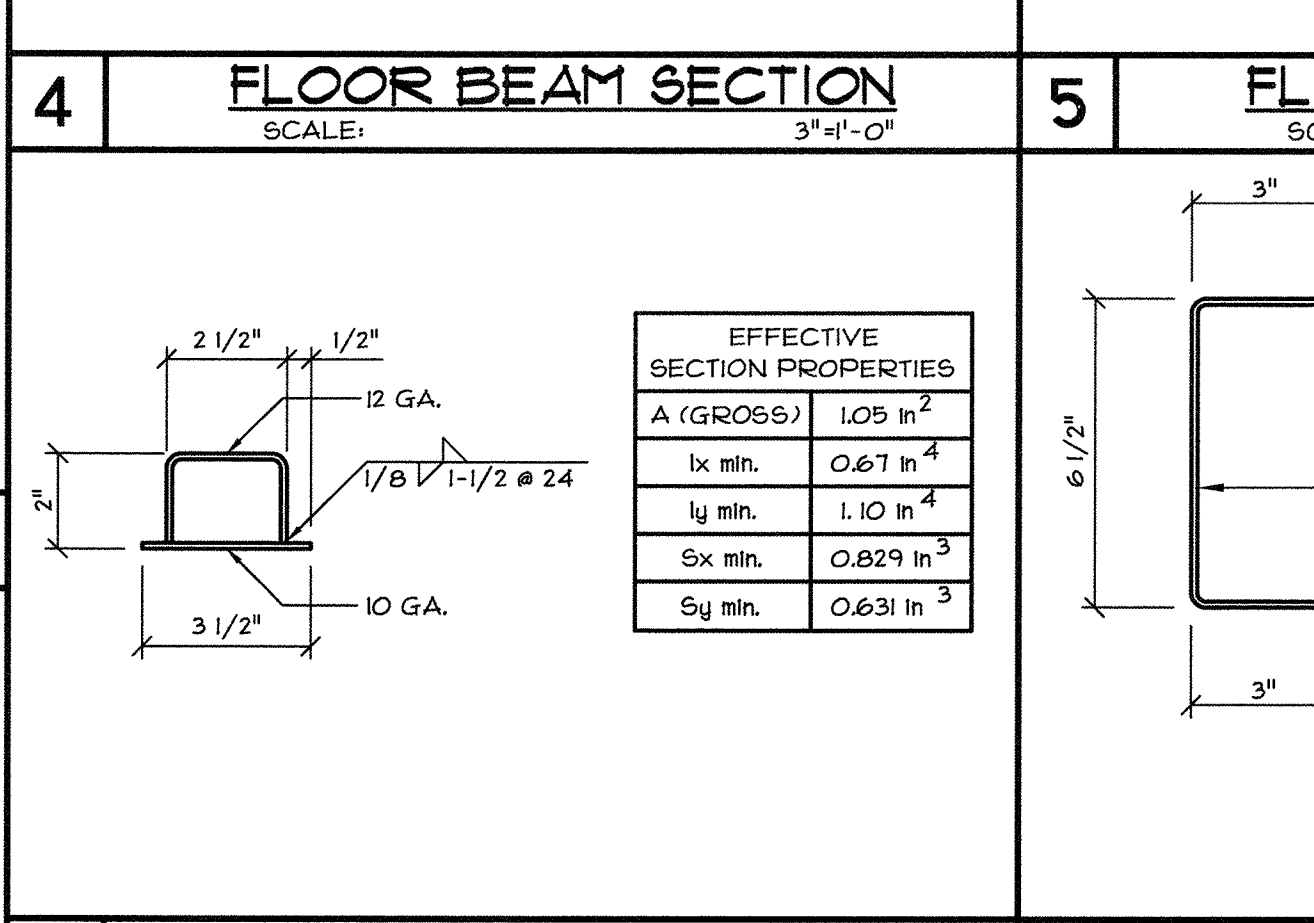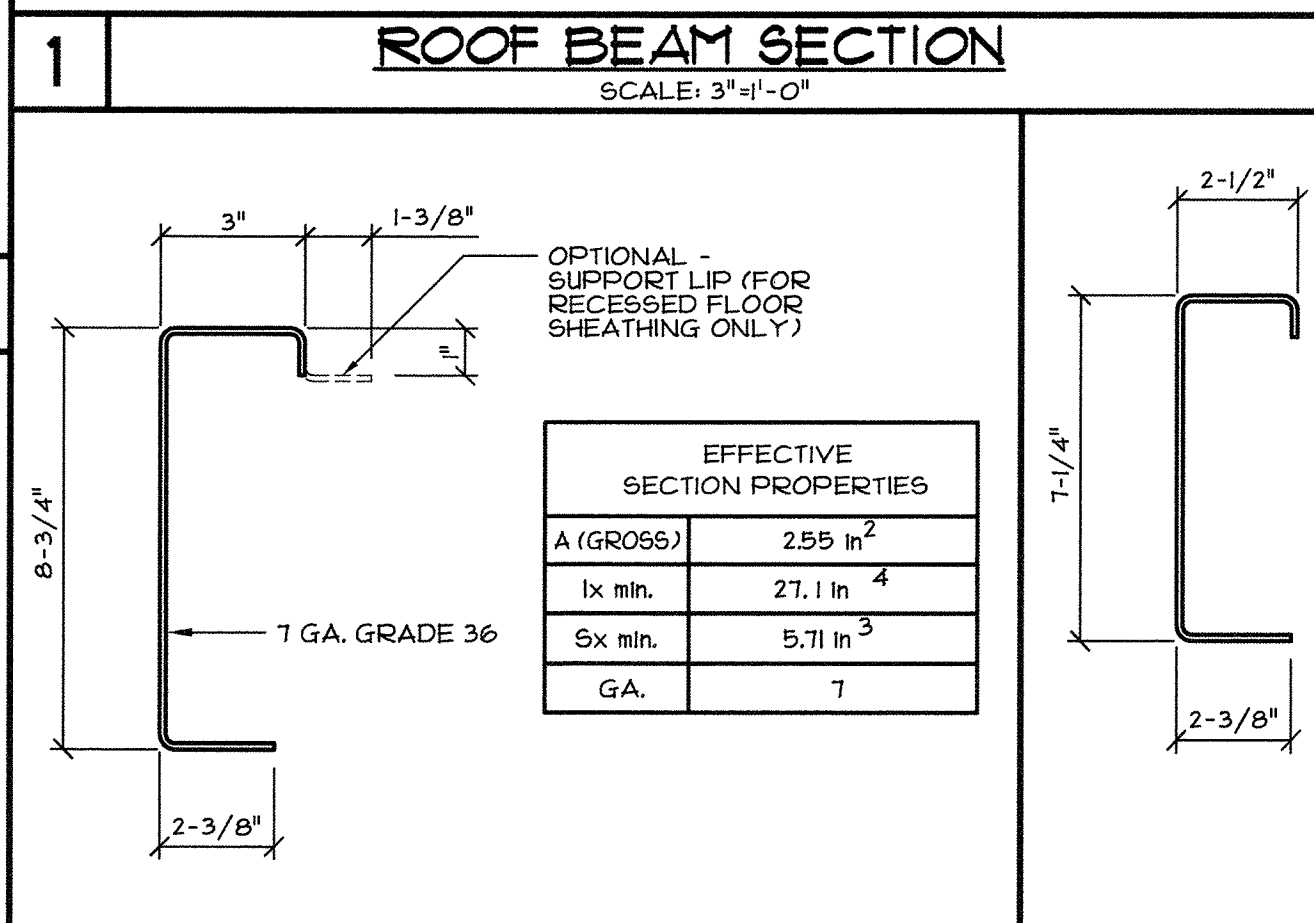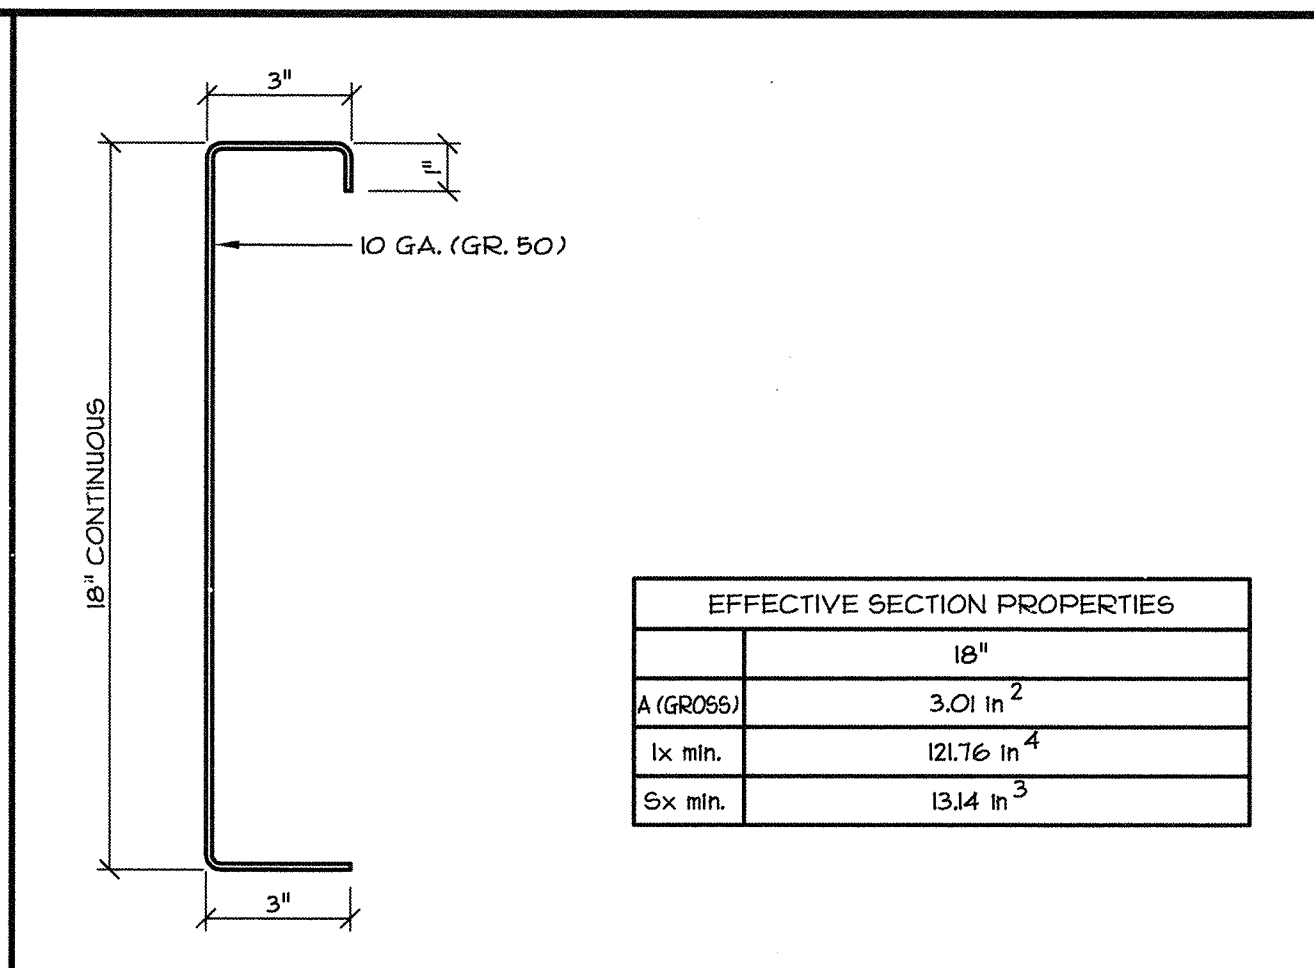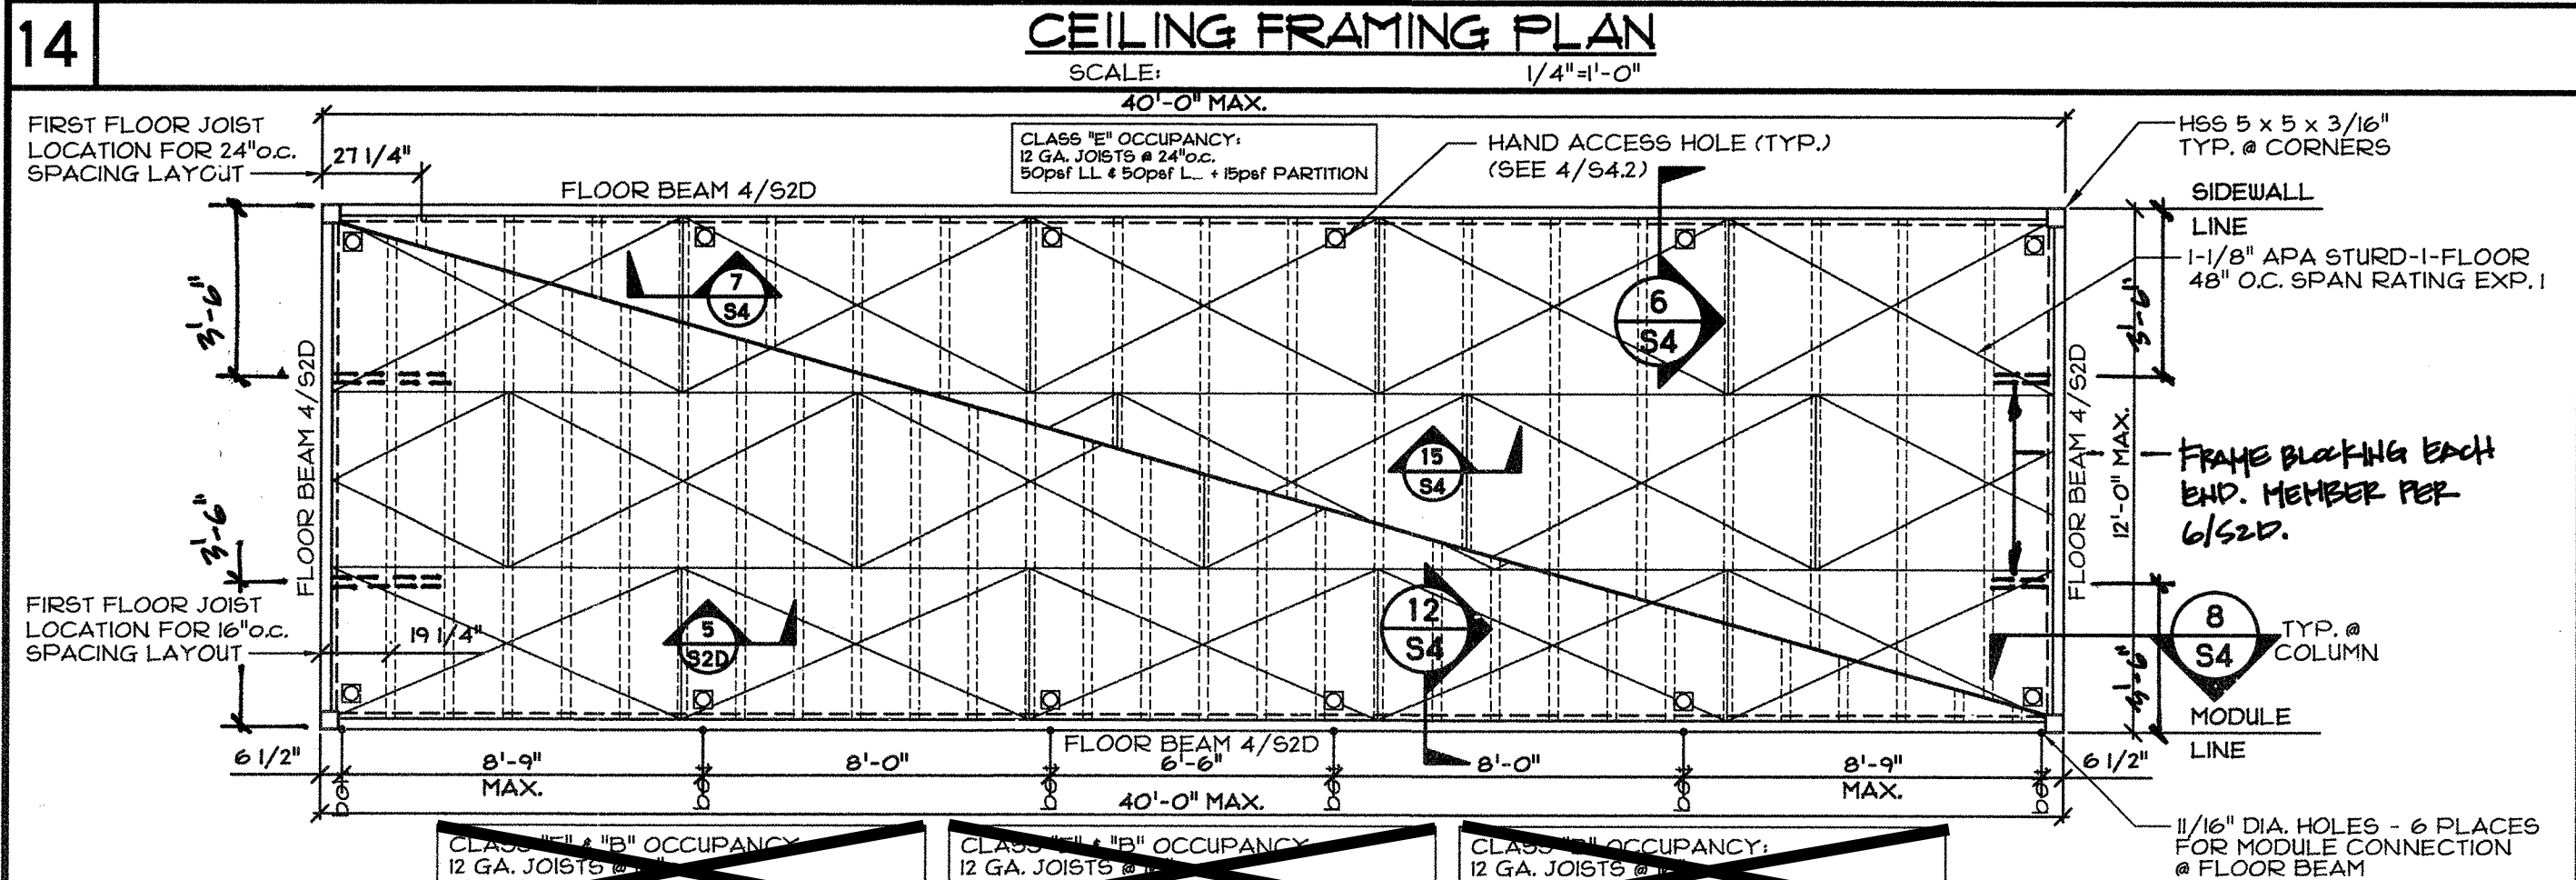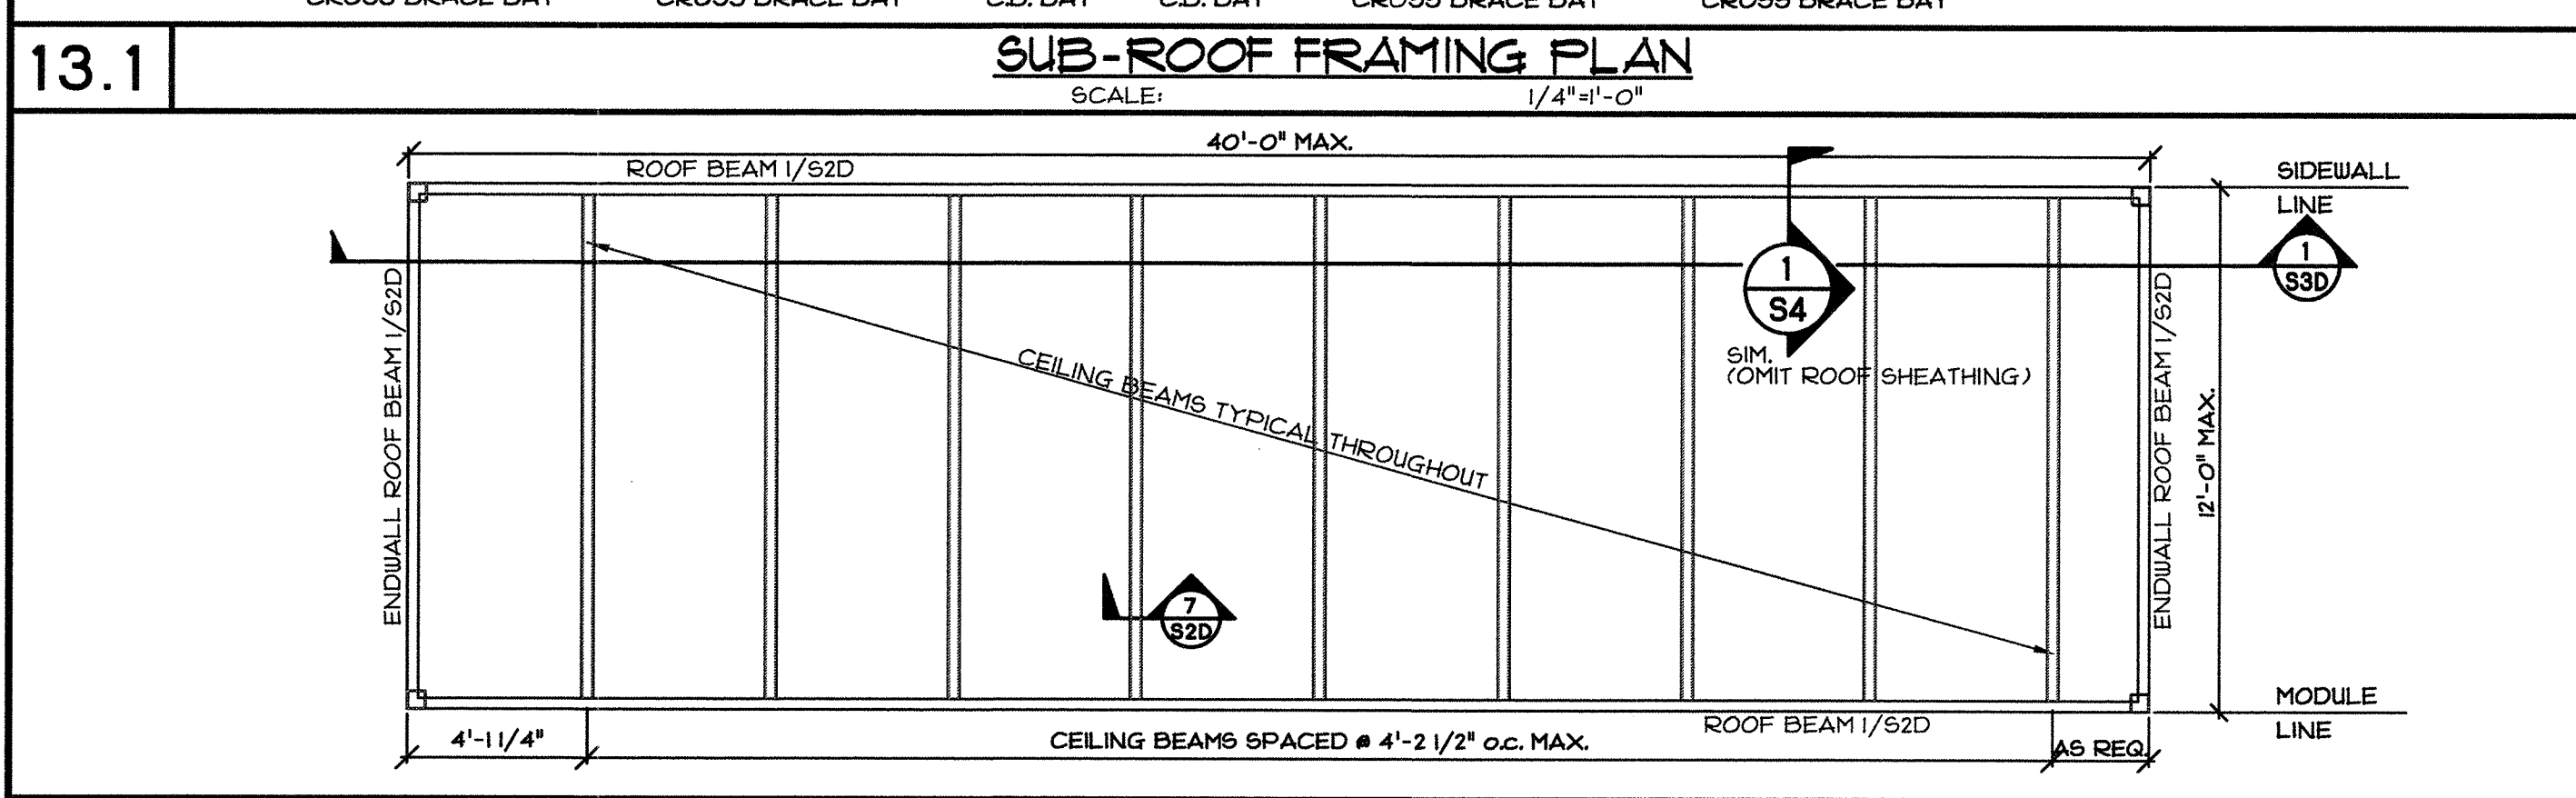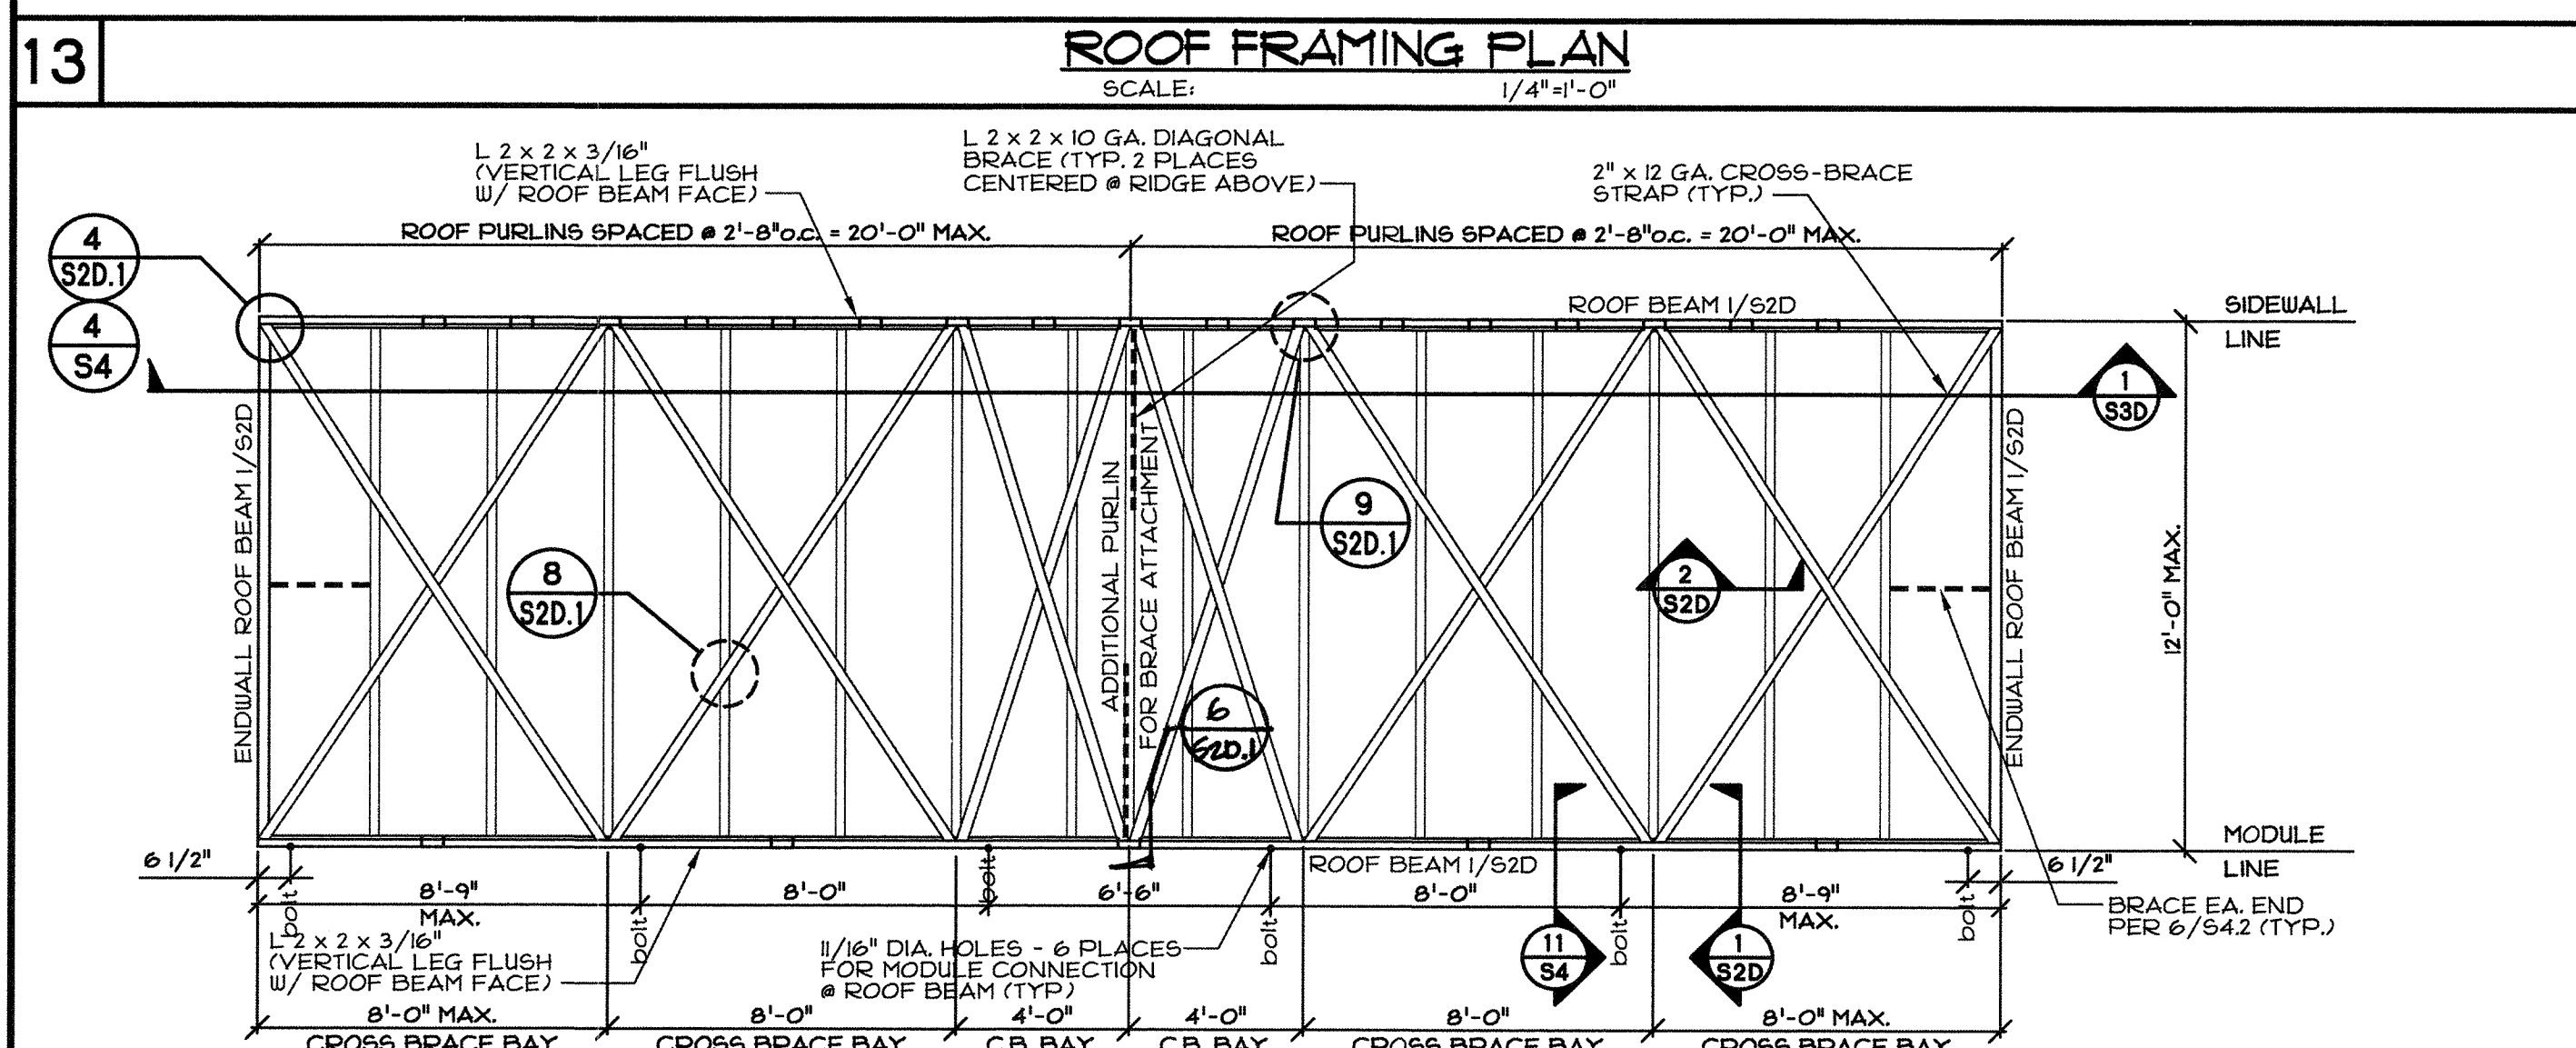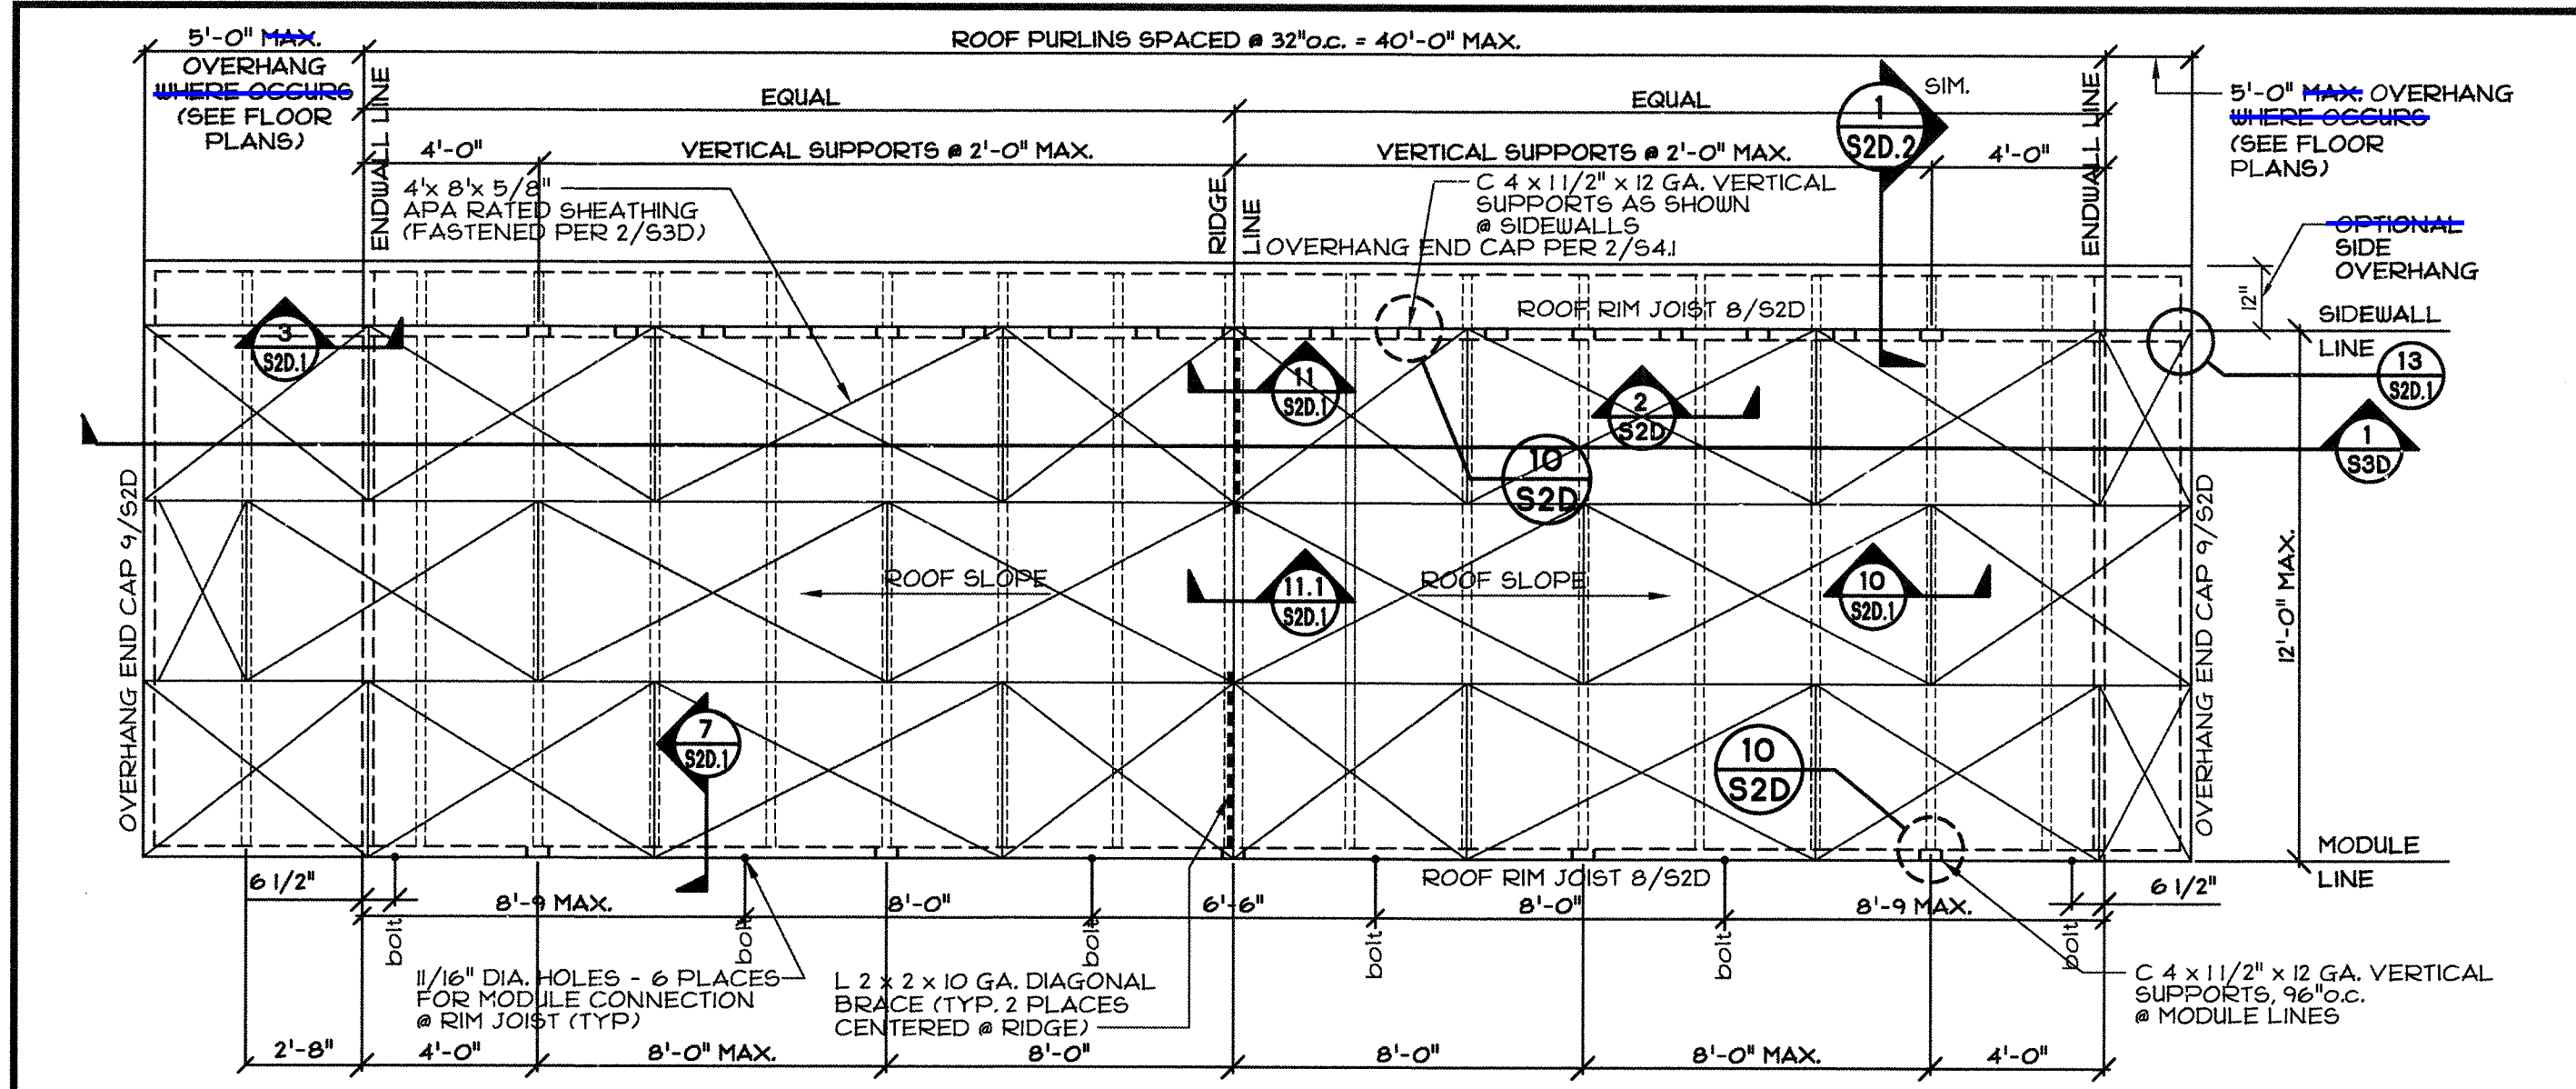



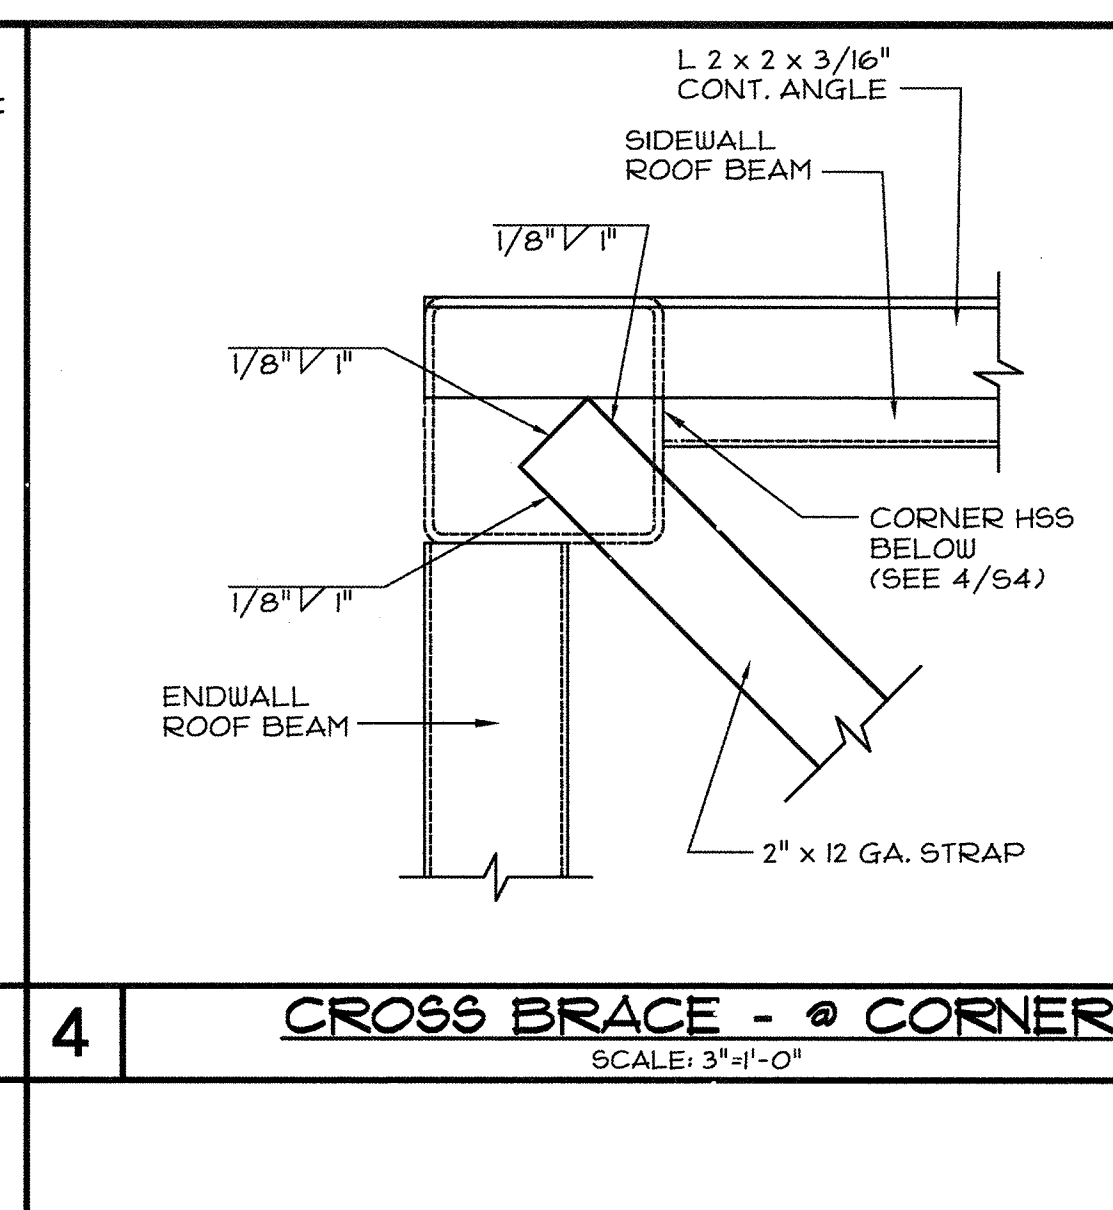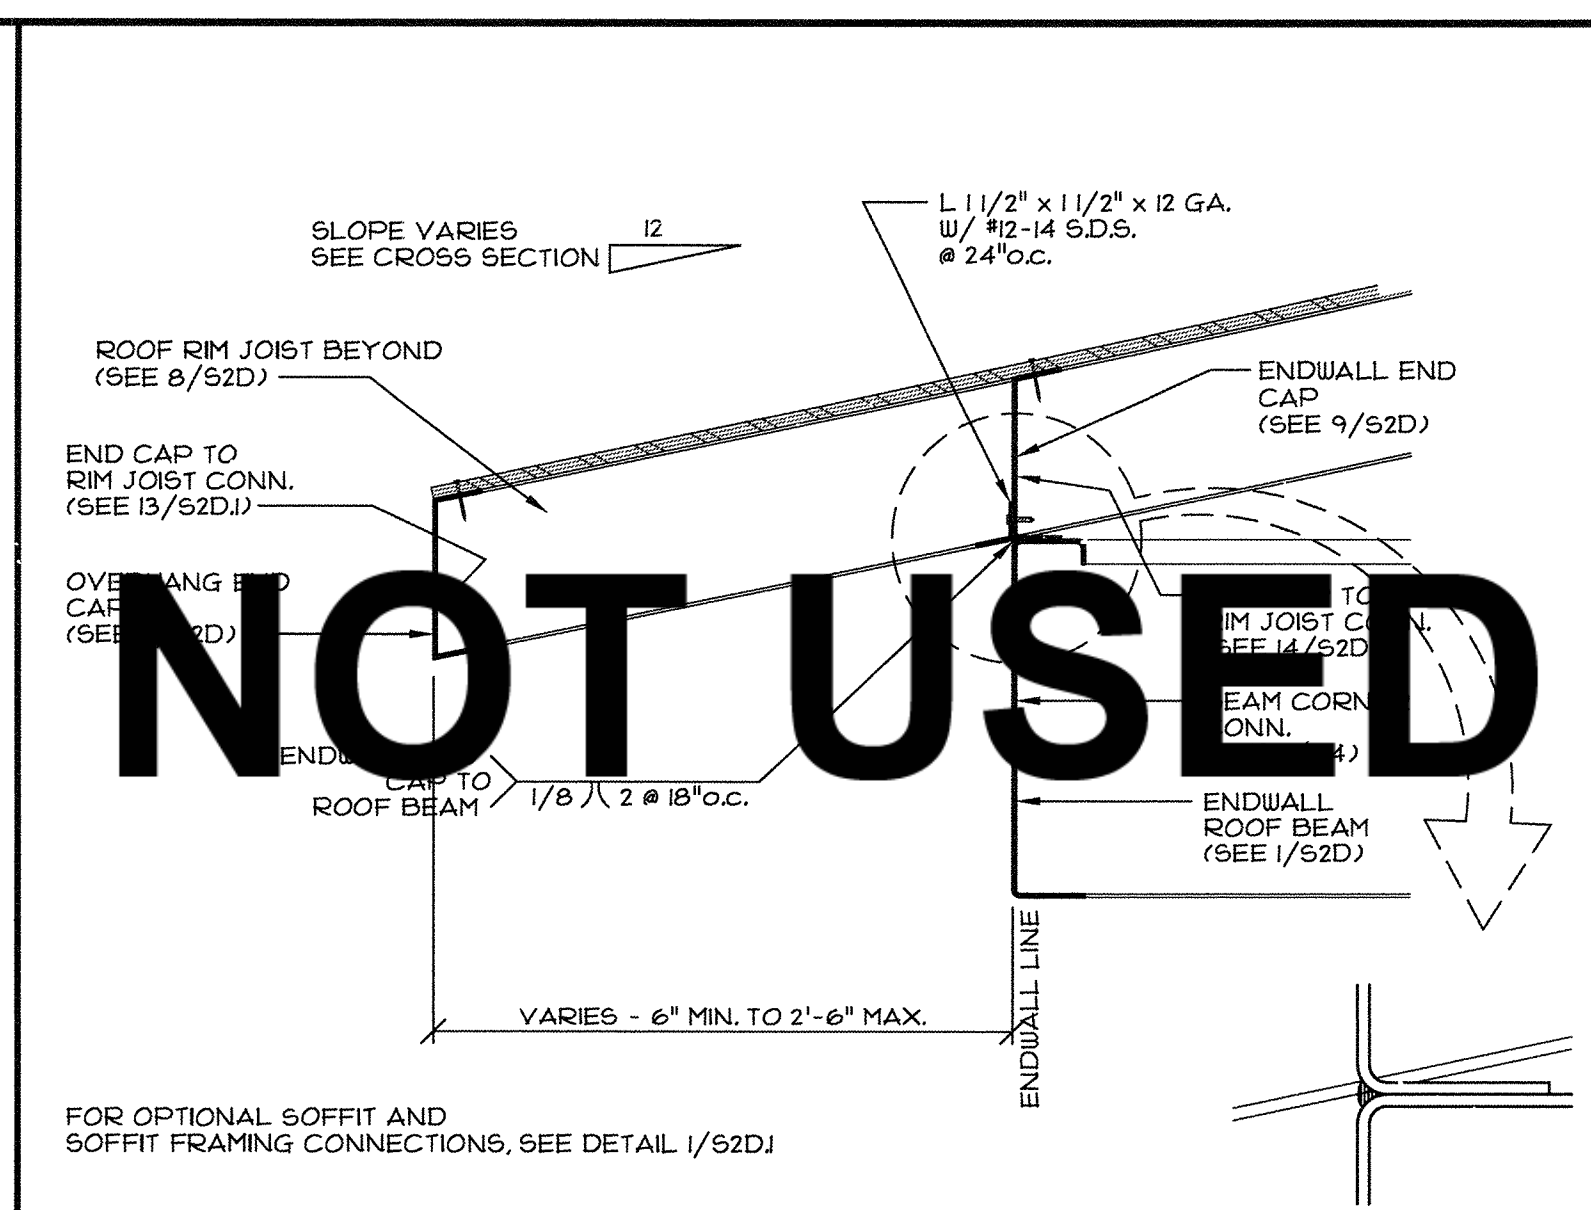


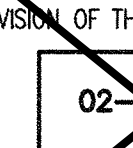
VE SECTION - 2'-6" OVERHANG  
SCALE: 1 1/2"=1'-0"

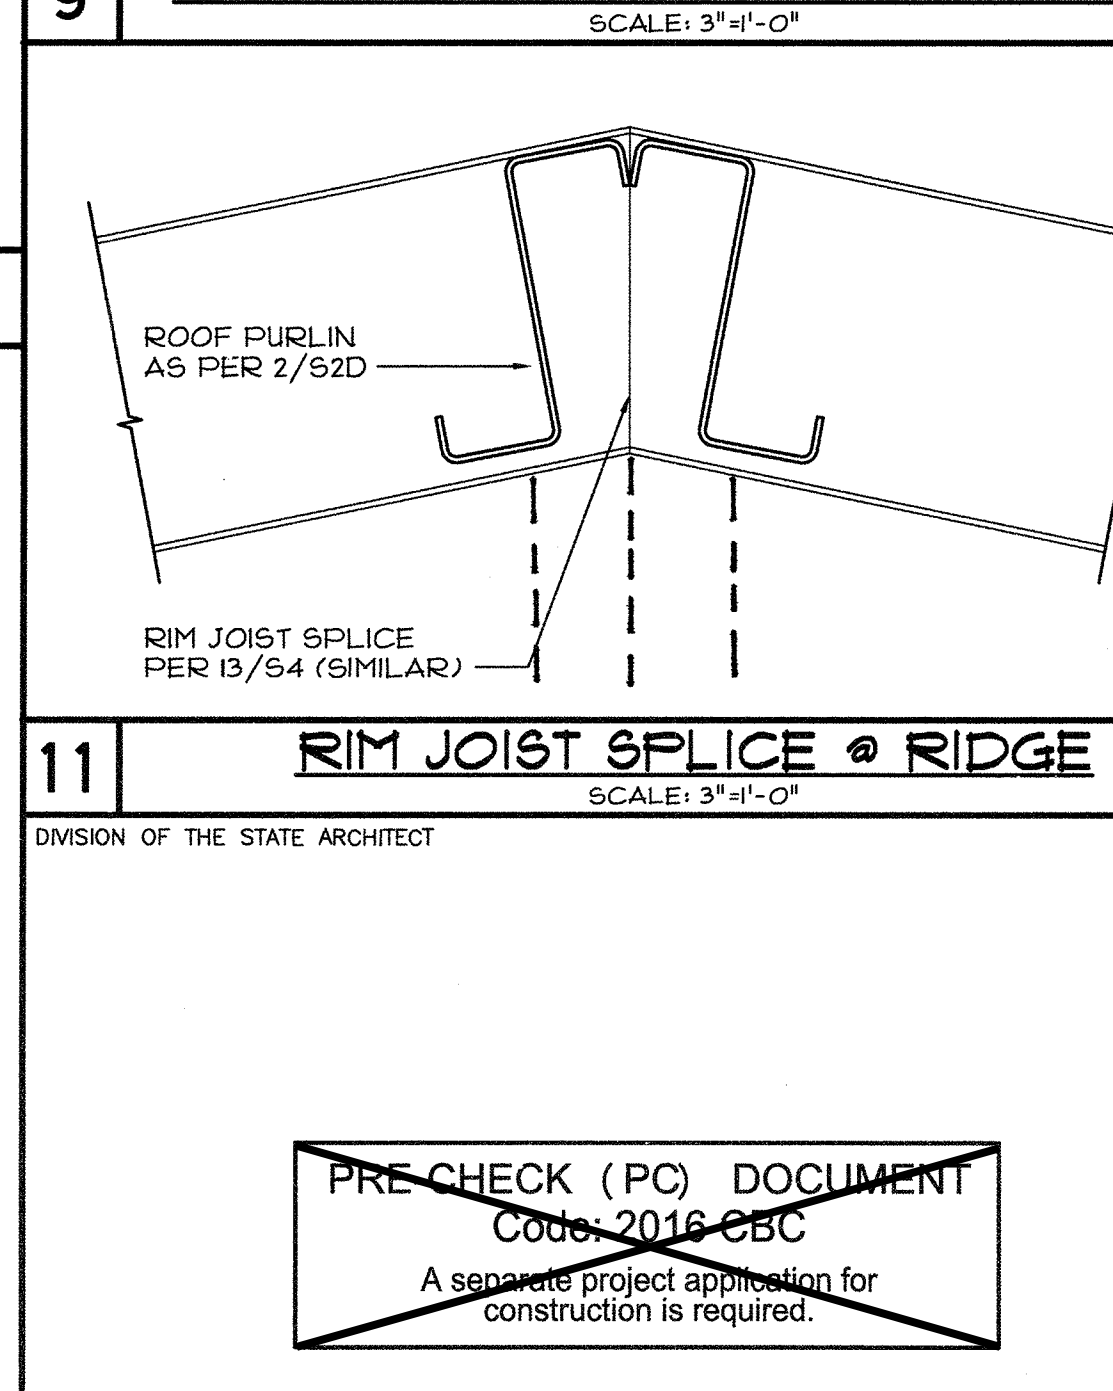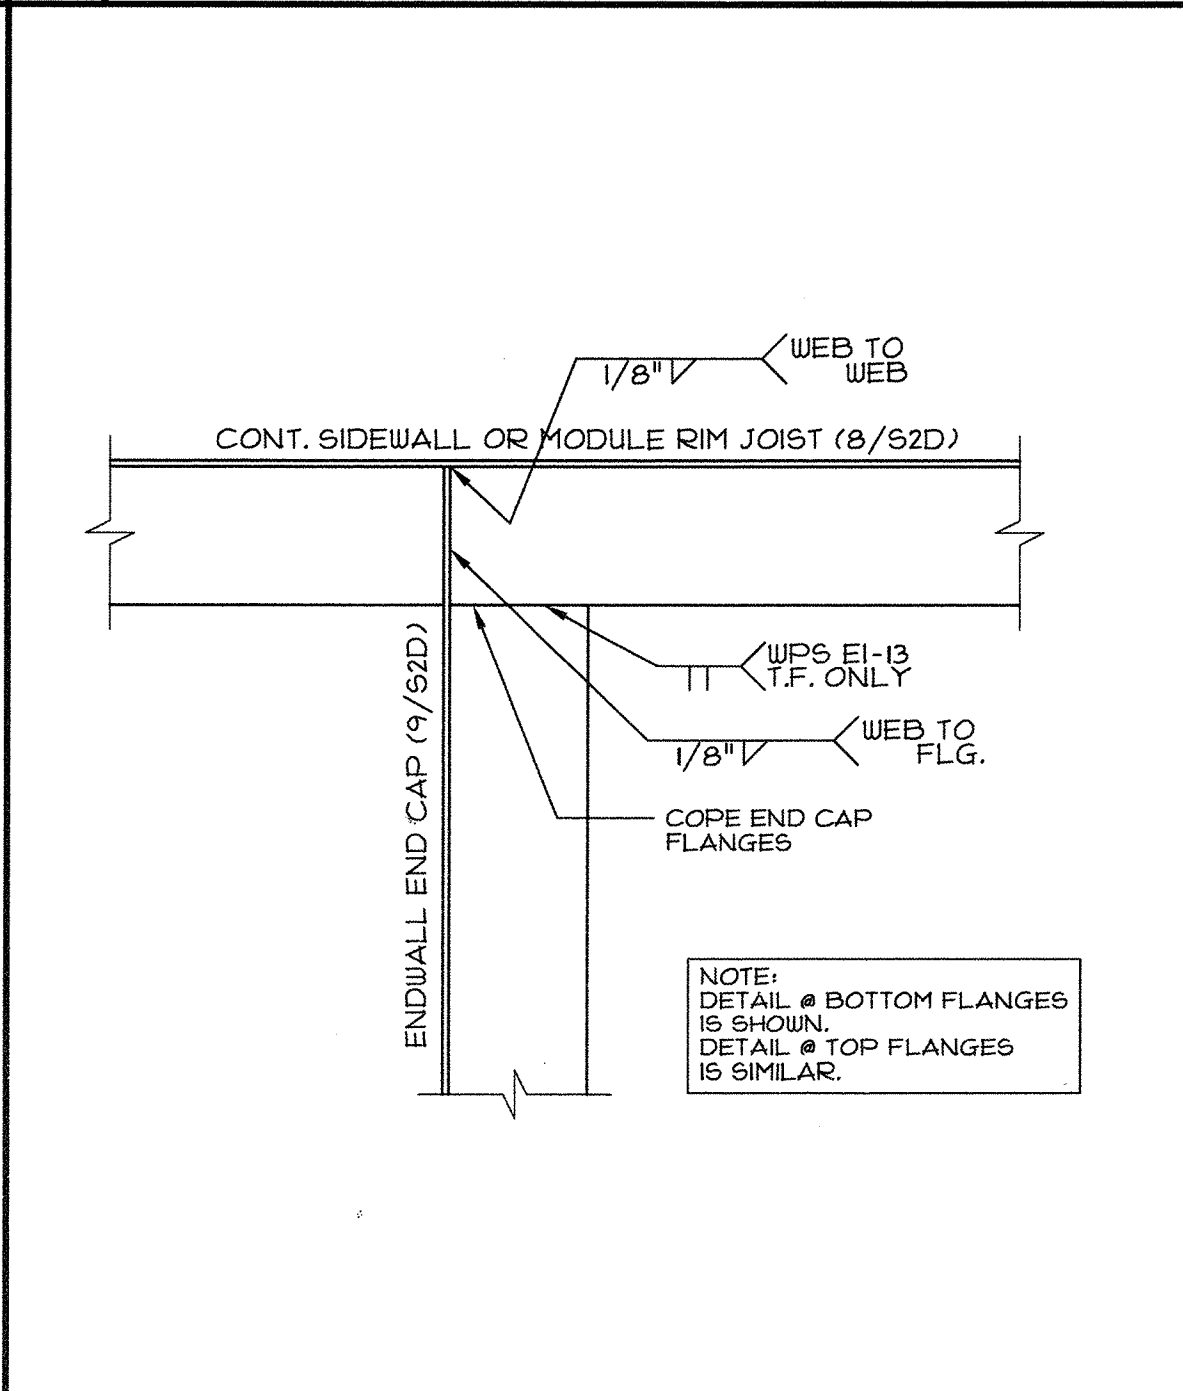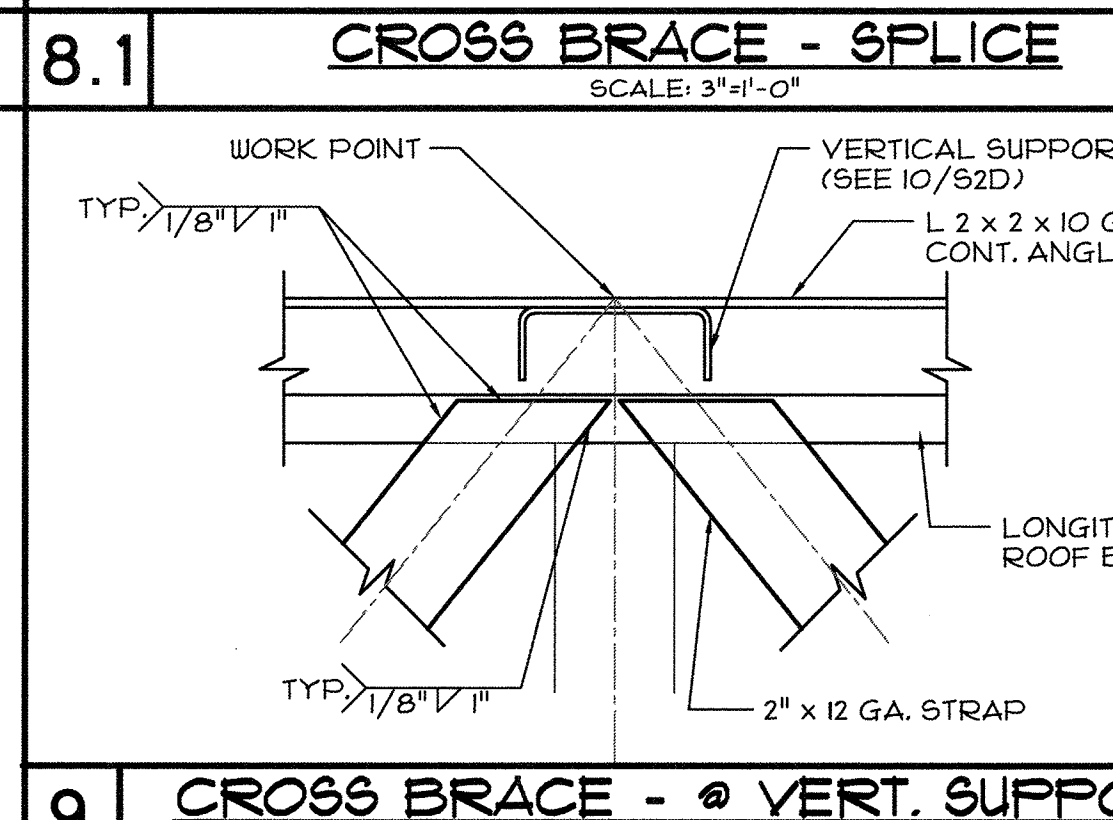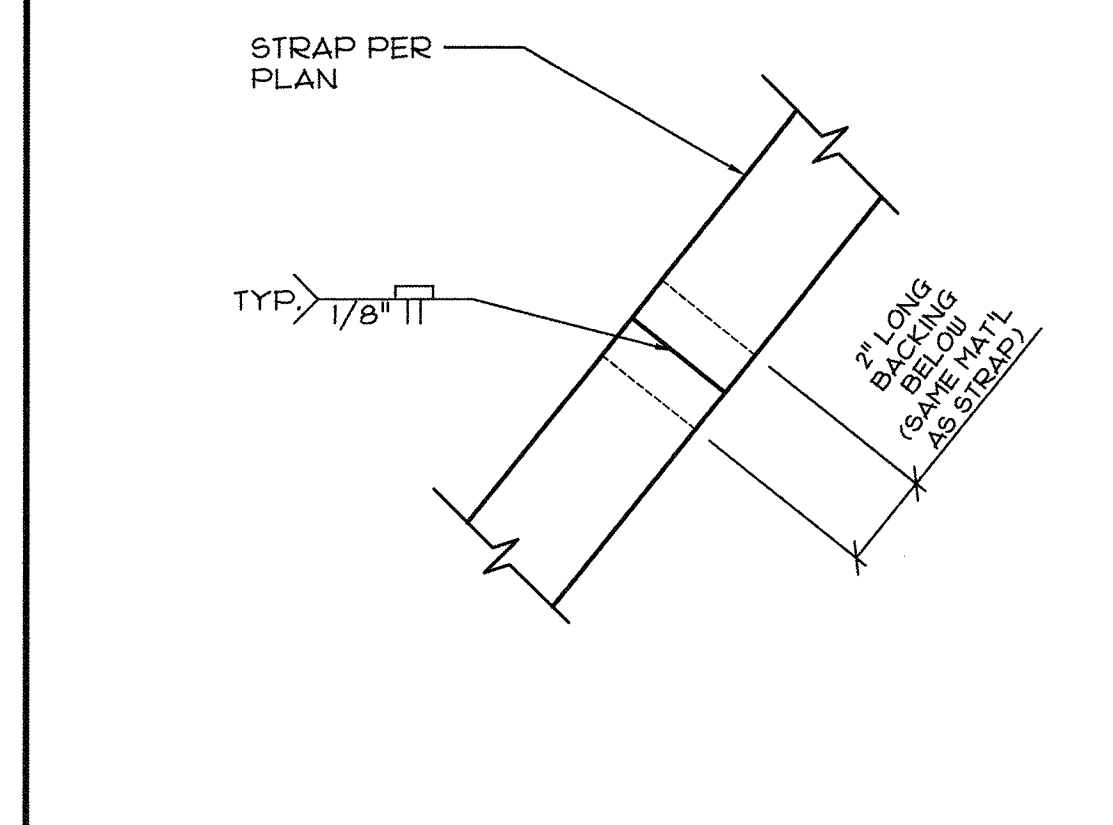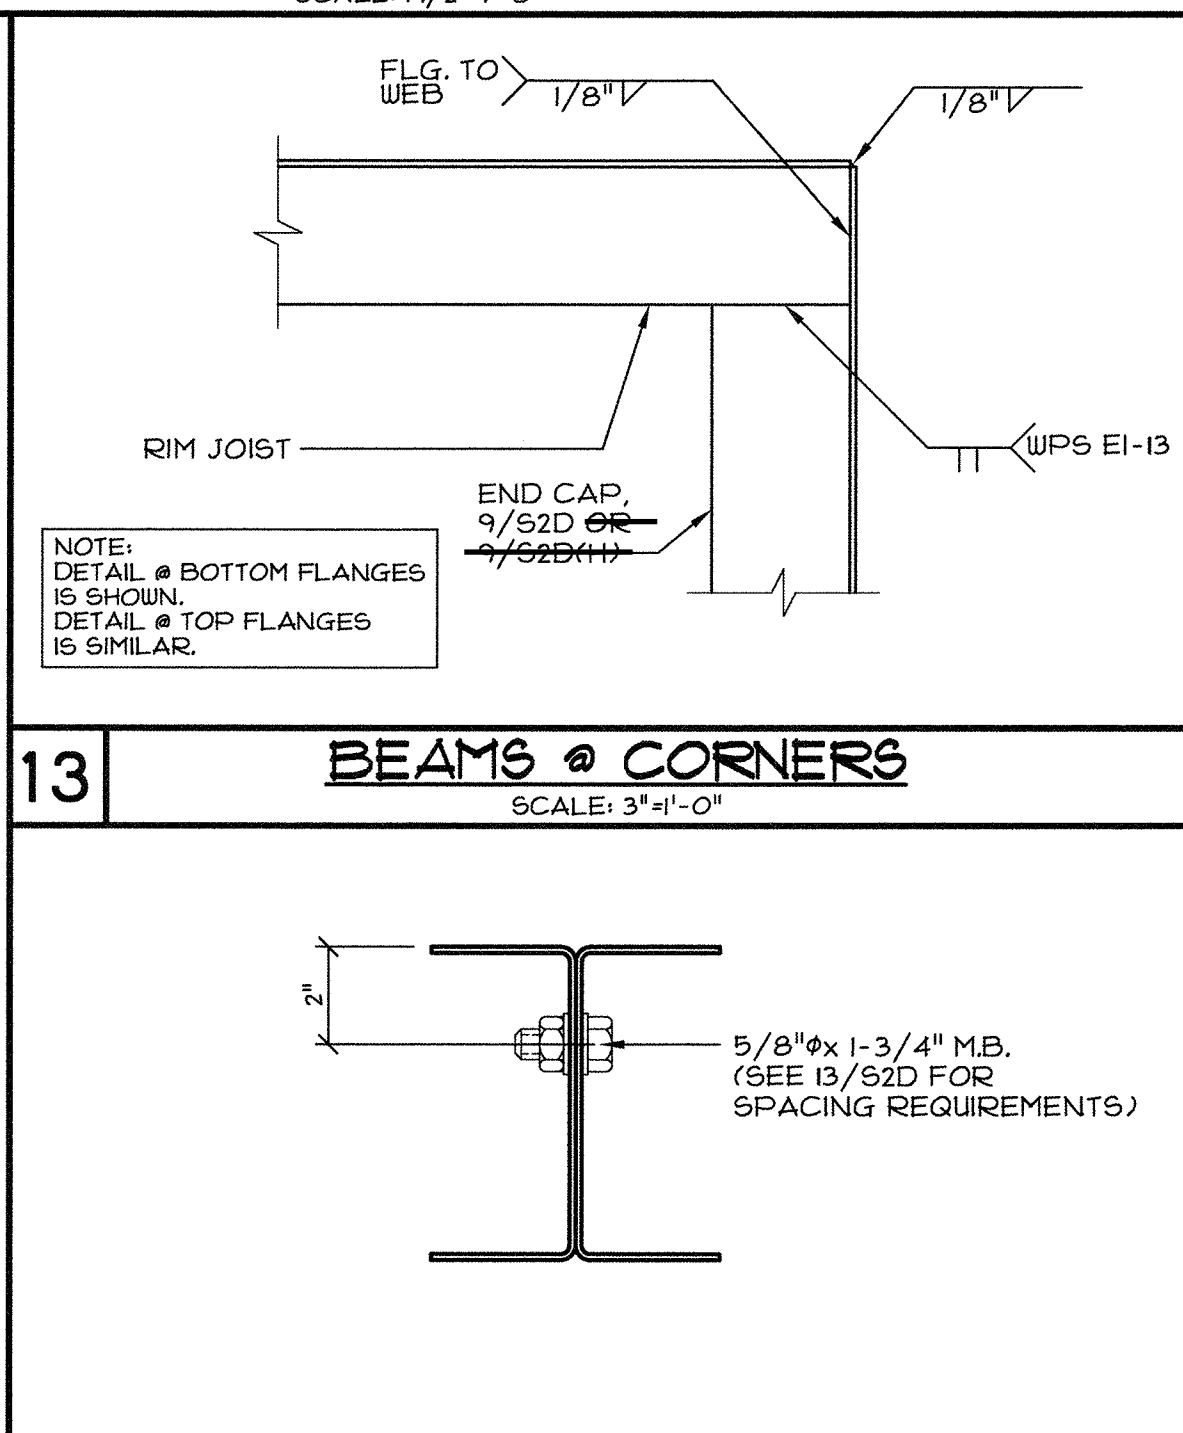

|  |  |             |  |     |
|--|--|-------------|--|-----|
|   |  | REV / DATE: |  | BY: |
|  |  |             |  |     |
|  |  |             |  |     |
|  |  |             |  |     |
| JOB No.:   |  |             |  |     |
| DRAWN BY:  |  |             |  |     |
| DATE:  |  |             |  |     |
| <div style="text-align: center;">             IDENTIFICATION STAMP<br/>             DIVISION OF THE STATE ARCHITECT<br/> <div style="border: 1px solid black; padding: 5px; margin: 10px auto; width: 150px; text-align: center;">02-M-0094</div> </div> |  |             |  |     |
| AC _____ FLS. _____ PG. <u>68</u><br>DATE <u>9-6-2018</u><br>Title _____   |  |             |  |     |

**ENVIROPLEX, INC.**  
 4777 E. CARPENTER ROAD STOCKTON, CA. 95215, (209) 468-8000  
 CESAR CHAVEZ HIGH SCHOOL - ATHLETIC FACILITY  
 STOCKTON UNIFIED SCHOOL DISTRICT  
 2929 WINDFLOWER LANE STOCKTON, CA 95212

## VARIABLE SLOPE ROOF STRUCTURAL DETAILS

|  |     |
|--|-----|
| REV / DATE:  | BY: |
|  |     |
|  |     |
|  |     |
|  |     |
| JOB No.:   |     |
| DRAWN BY:  |     |
| DATE:  |     |
| <div style="text-align: center;">  <p>IDENTIFICATION STAMP<br/>DIVISION OF THE STATE ARCHITECT</p> <p>02-16094</p> </div> |     |
| AC. <u>  </u> FLS. <u>  </u> SS <u>68</u>  |     |
| DATE <u>9-6-2018</u>   |     |





CONFIDENTIAL MATERIAL—THESE DOCUMENTS ARE THE PROPERTY OF AND ARE NOT TO BE REPRODUCED OR DISTRIBUTED WITHOUT FULL KNOWLEDGE AND WRITTEN CONSENT FROM ENVIROPLEX, INC.  
© COPYRIGHT ENVIROPLEX, INC. (ALL DRAWINGS PREPARED BY ENVIROPLEX, INC.)





24'x40' TO 120'x40' P.C



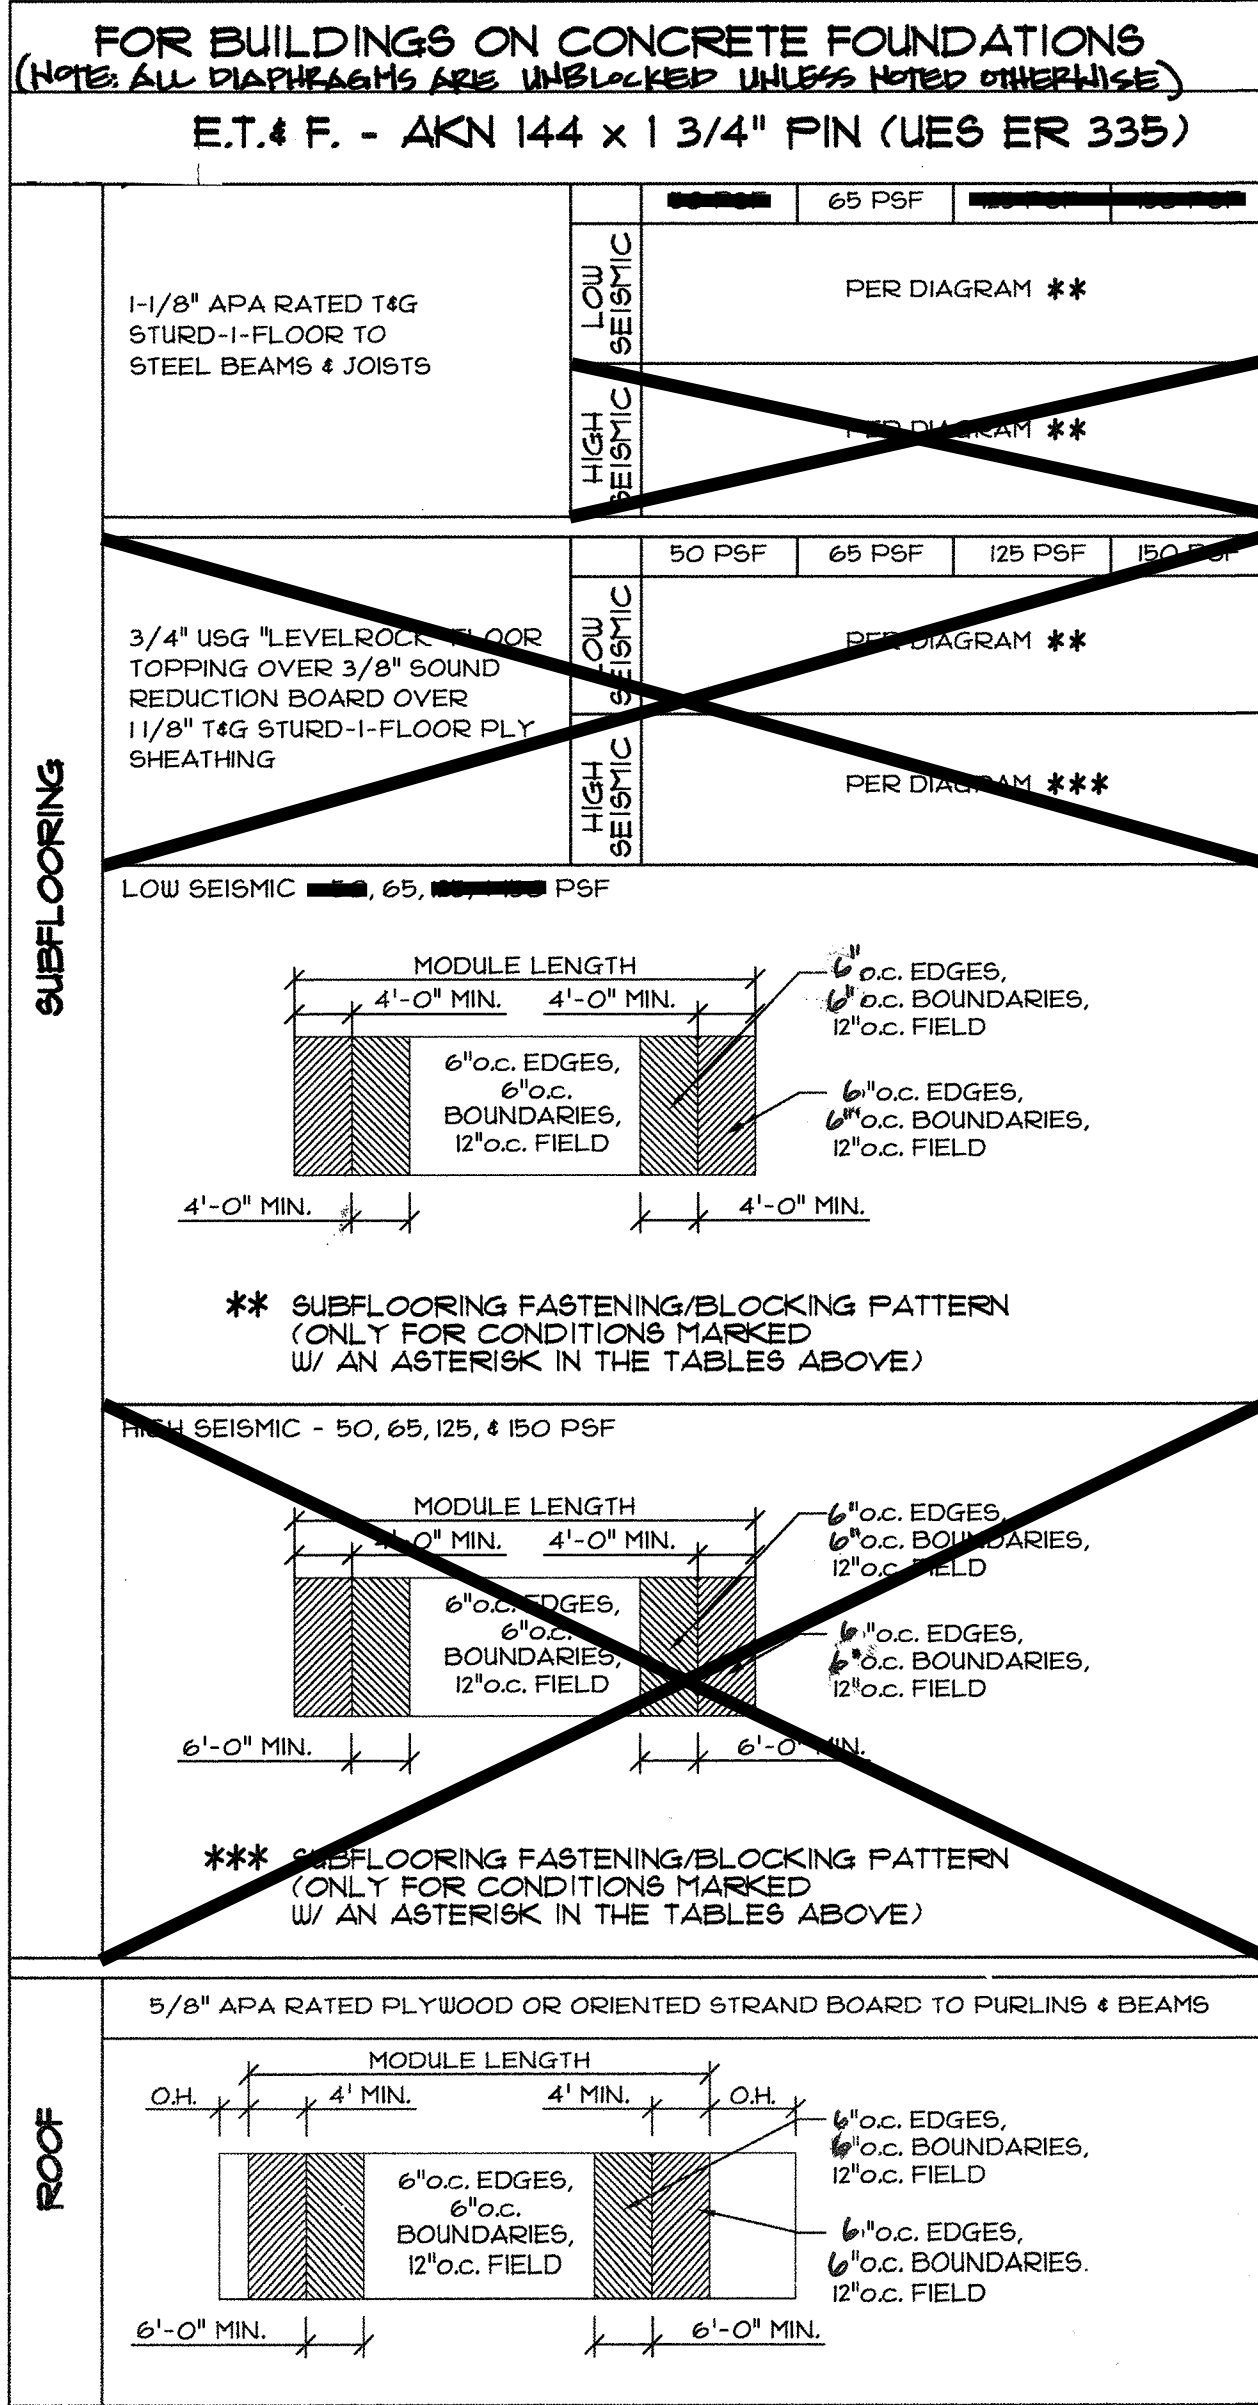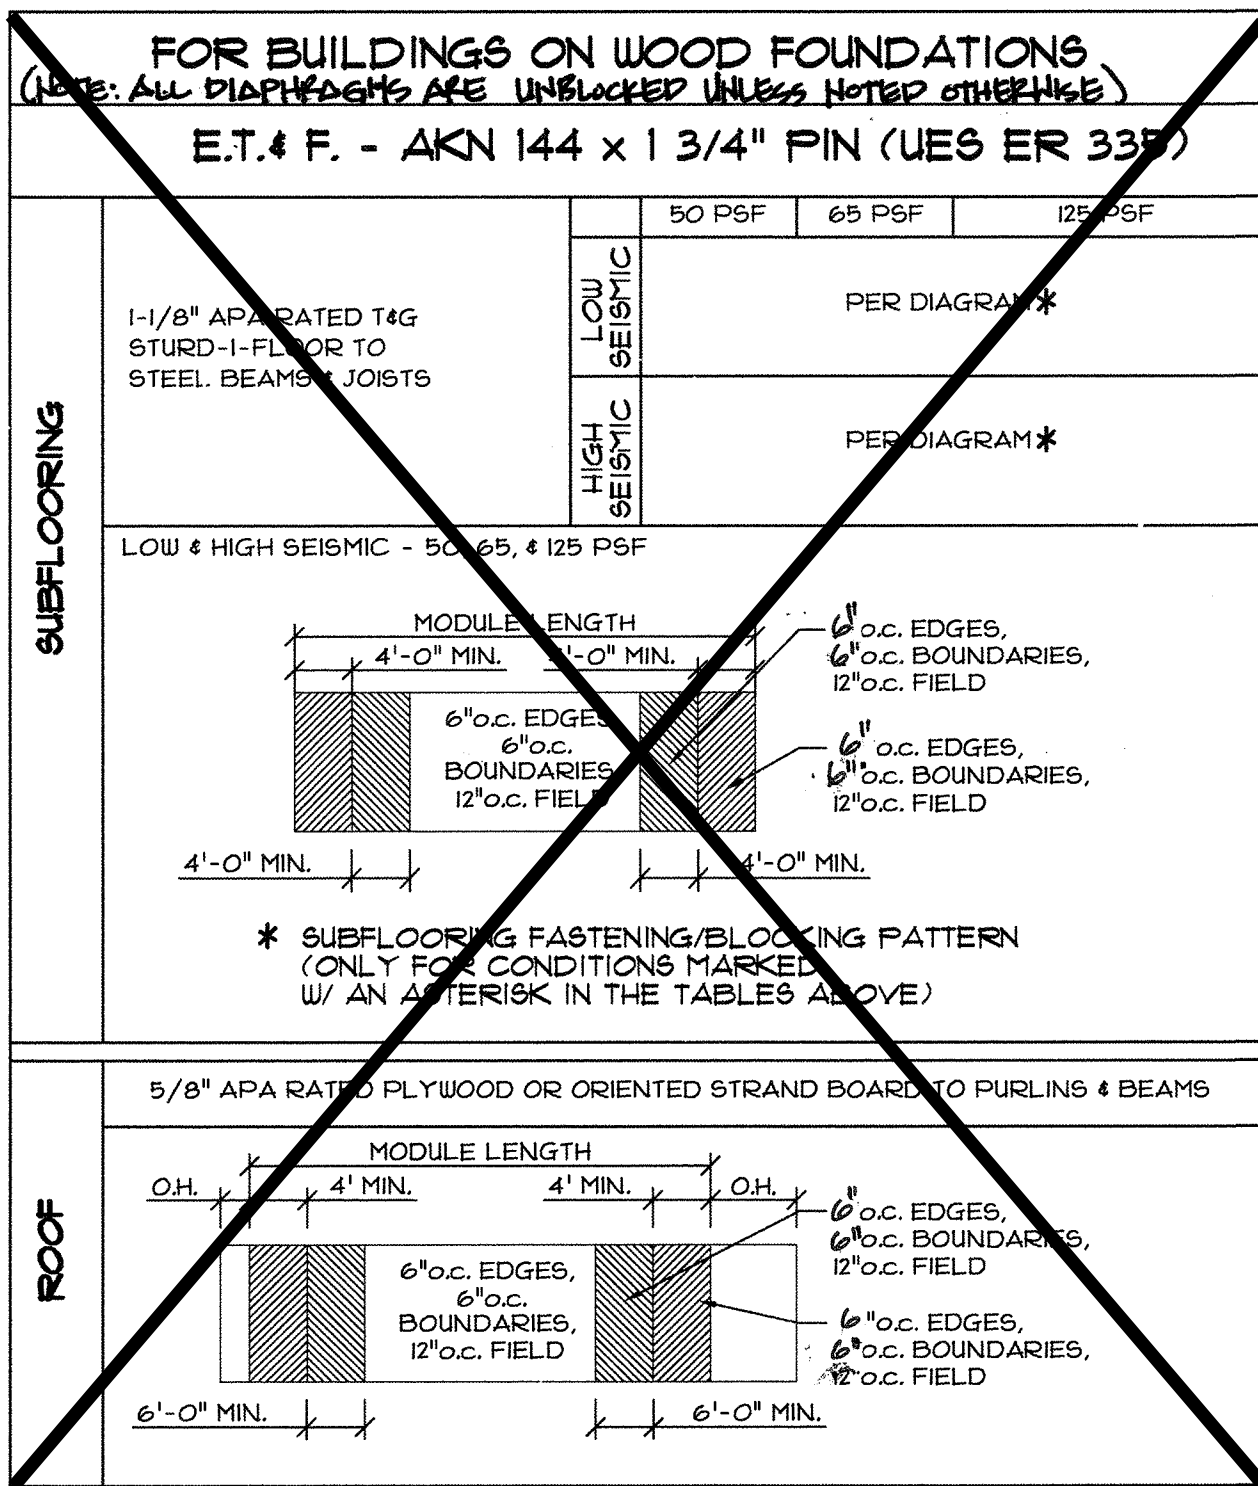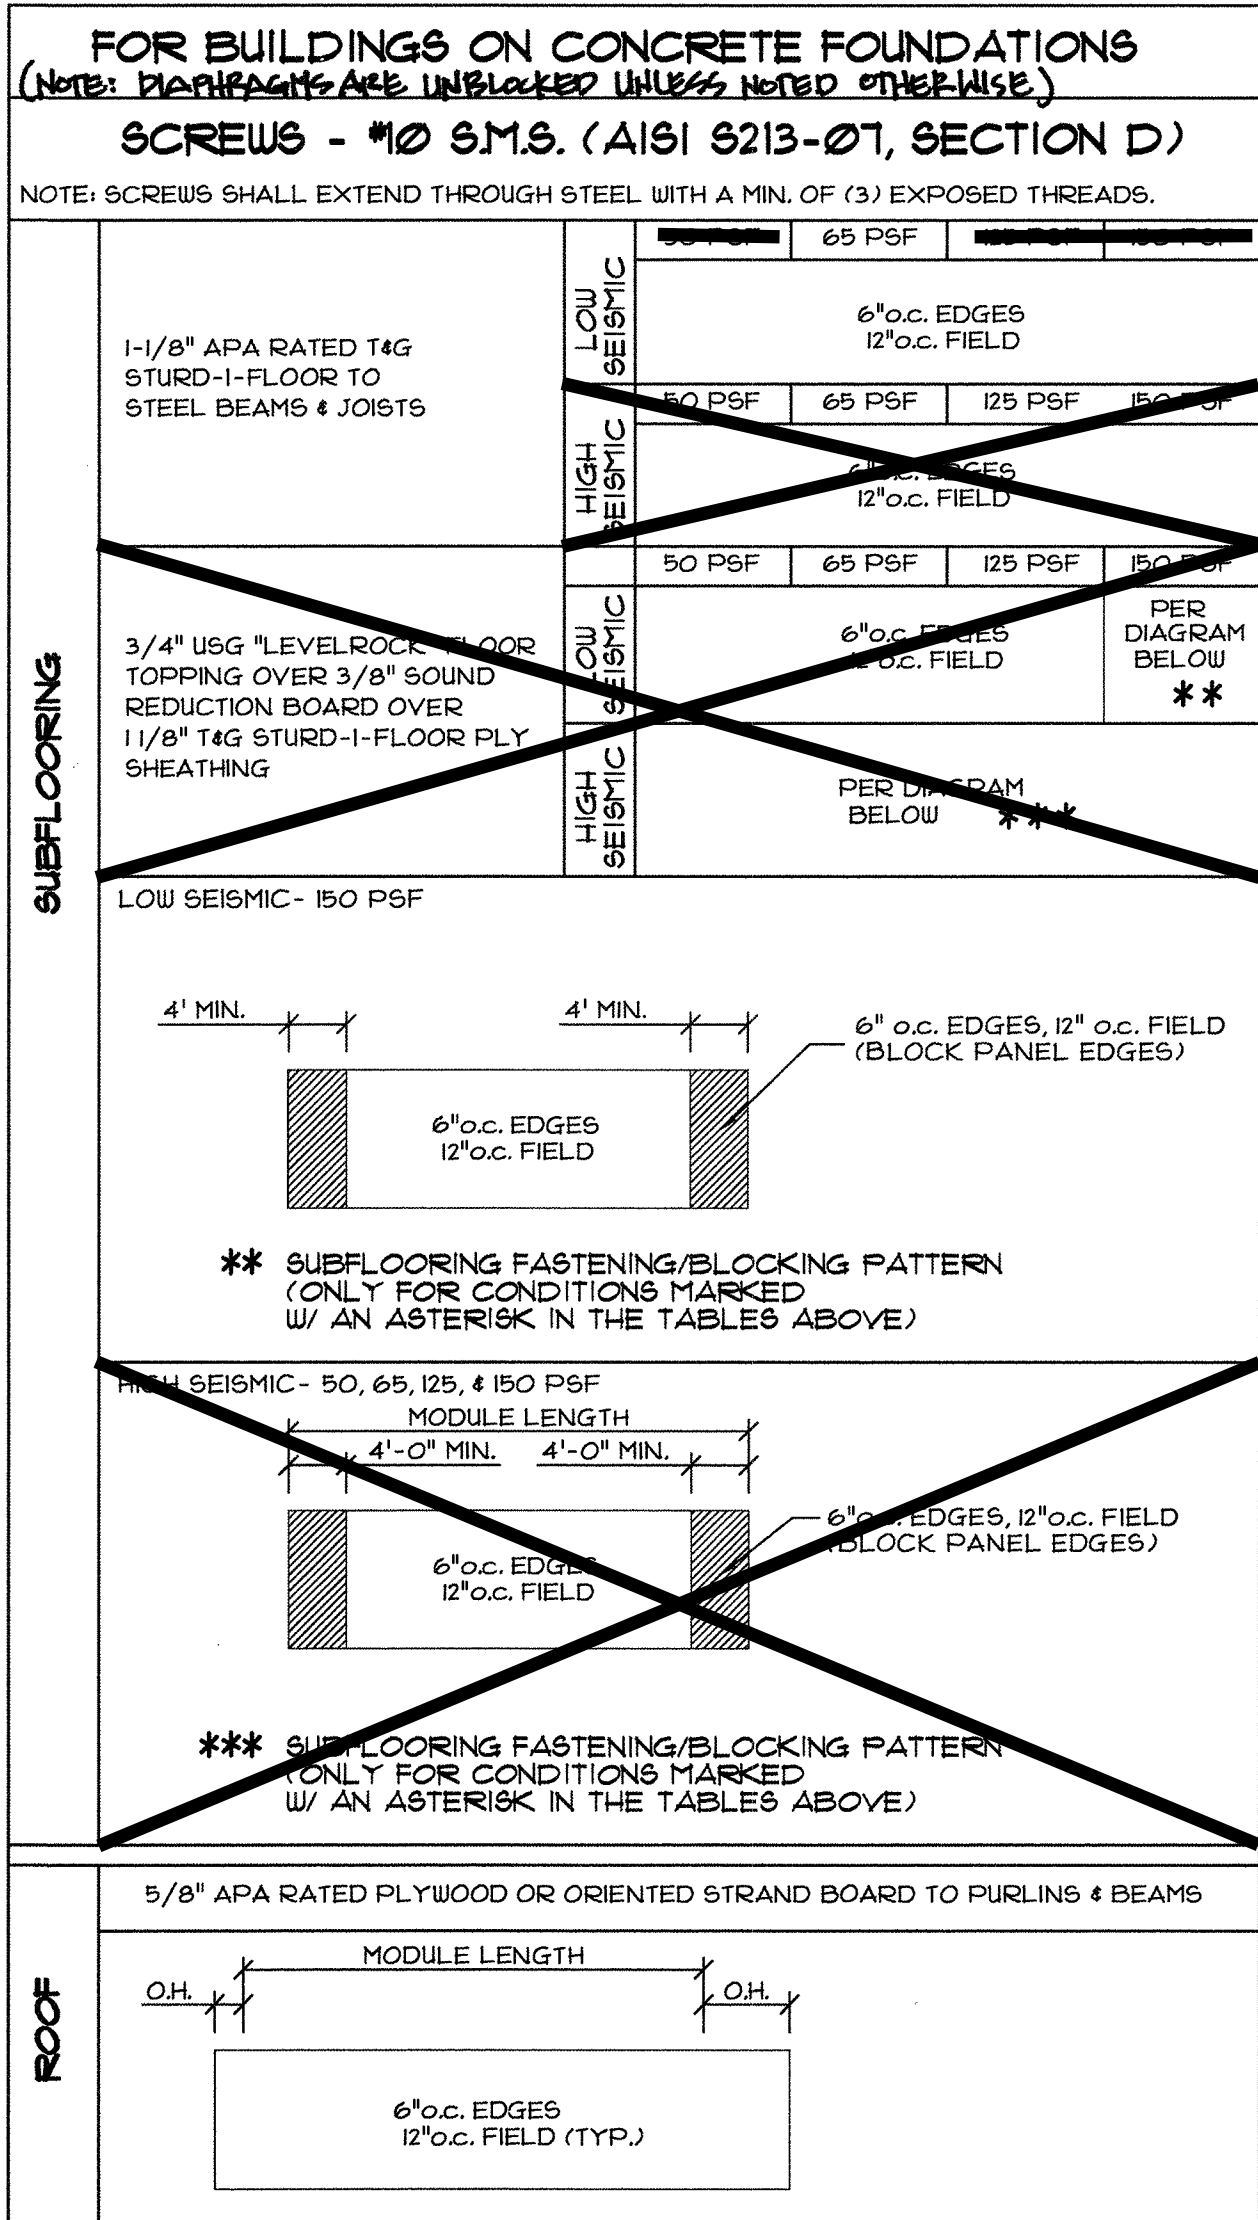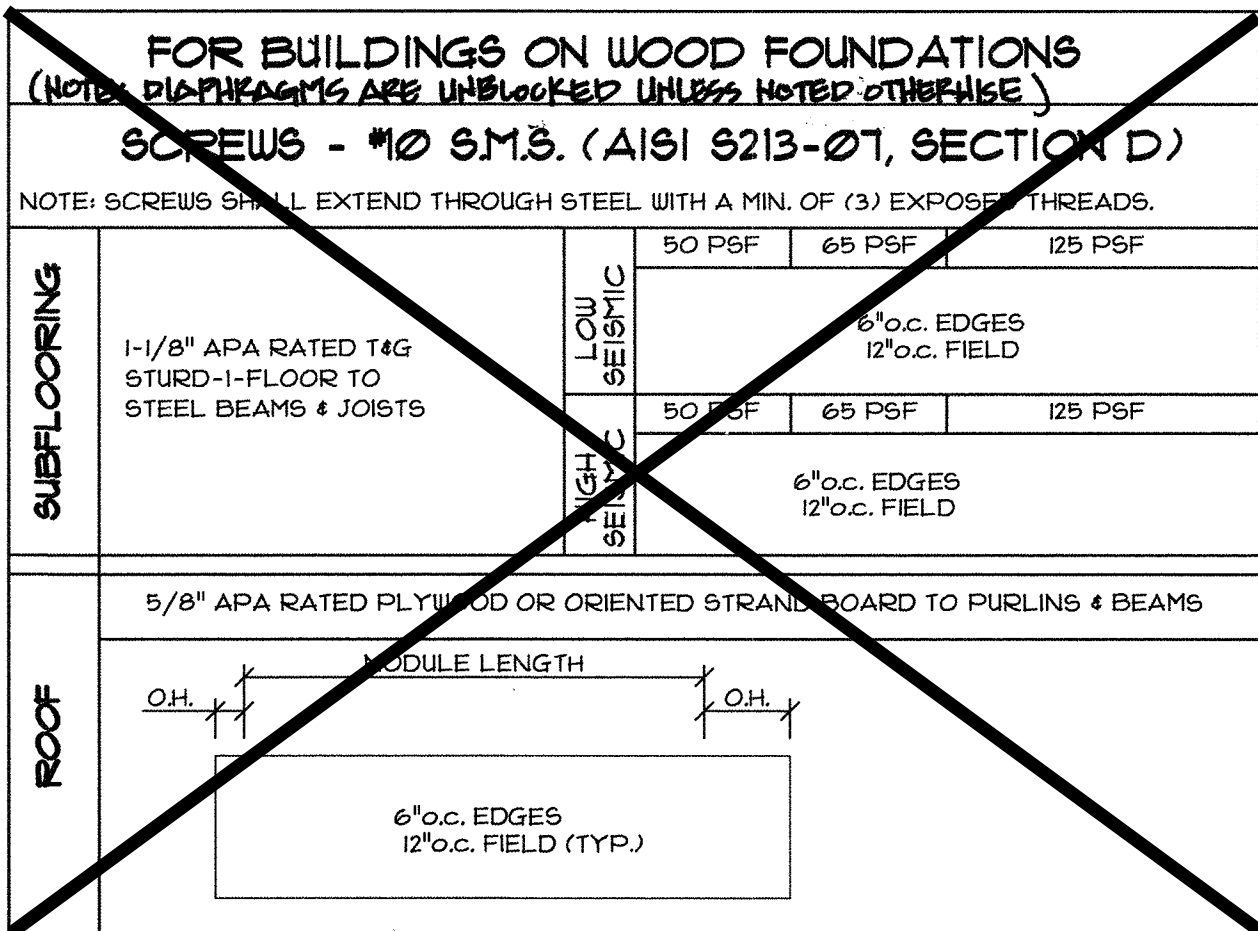

- WALL TO FRAME FASTENING:**
- WALL PANEL TOP PLATE TO PERIMETER ROOF BEAM. (1) 1/4" x 2 1/2" LAG SCREWS FROM ROOF BEAM BOT. FLANGE INTO TOP PLATE # 15" o.c. MAX.
  - WALL PANEL BOTTOM PLATE TO PERIMETER FLOOR BEAM. 1/4"-20 TEK5/4 SCREWS # 16" o.c. FROM BOT. PLATE INTO FLOOR BEAM TOP FLANGE
  - WALL PANEL SIDE STUDS TO HSS CORNER COLUMNS. #12-24 x 2 1/2" S.D.S. # 16" o.c. FROM SIDE STUD INTO STEEL CORNER COLUMN.
  - TOP AND BOTTOM PLATE TO STUDS AND KING STUDS. (3) 135 x 3 1/4" LONG MACHINE NAIL STUDS AND KING STUDS
  - DOUBLE STUDS, TRIMMERS, SILLS. 135 x 3 1/4" LONG MACHINE NAILS # 8" o.c. AND CRIPPLES STICH NAILED
  - CRIPPLES, TRIMMERS END NAILED. (3) 135 x 3 1/4" LONG MACHINE NAIL EA. END TO PLATES AND SILLS.
  - CRIPPLES, TRIMMERS. (3) 135 x 3 1/4" LONG MACHINE NAIL NAILED TO HEADERS.
  - ALL HANGERS, STRAPS, CLIPS, ETC. NAILED AS PER MANUFACTURERS SPECS.
  - FASTENING CONDITIONS NOT ADDRESSED ABOVE. TABLE 2304.10.1, 2016 C.B.C.

- SHEATHING NAILING & NOTES:**
- DO NOT CRUSH SHEATHING FACE PLY (OUTER VENEER LAYER) BY OVER DRIVING SCREWS, MACHINE, OR HAND NAIL.
  - UNDER DRIVEN NAILS SHALL BE CORRECTED BY HAND SET.
  - REMOVE AND REPLACE NAILS DRIVEN THAT MISS FRAMING OR SUPPORT.
  - ALL CORRECTIVE NAILING SHALL BE DONE BY HAND NAILING.
  - H.D.G. = HOT DIPPED GALVANIZED WITH MINIMUM COATING OF 1 OZ PER SQ. FT. OF ZINC. OR MECHANICALLY GALVANIZED PER ASTM F-1667.
  - FOR BLOCKED DIAPHRAGMS, BLOCK PANEL EDGES PER 11/54.1
  - MINIMUM SHEATHING PANEL WIDTH SHALL BE 24" PER AISI 5213, D3.2

|                                     |  |
|-------------------------------------|--|
| <b>SIDING</b>                       |  |
| EXTERIOR SIDING                     | INTO 2x4 OR 2x6 WOOD STUDS;<br>13" x 2 1/2" # 6" o.c. PANEL EDGES, 12" o.c. IN FIELD.<br>(H.D.G. OR MECH. GALV. NAILS, PER ASTM F-1667). |
| <b>GYP. WALLBOARD</b>               |  |
| 1/2" GYP. BOARD TO 2x4 OR 2x6 STUDS | 121 x 11/2" COATED NAILS # 8" o.c. EDGES, 8" o.c. IN FIELD.  |
| <b>OVERHANG SOFFIT</b>              |  |
| 1/2" APA RATED SHEATHING            | #8 x 1" S.M.S. # 12" o.c. EDGES, 12" o.c. IN FIELD (PRE-PUNCHED HOLES IN STEEL.)   |

PRE-CHECK (PC) DOCUMENT  
Code: 2018 CBC  
A separate project application for construction is required.

CONFIDENTIAL MATERIAL—THESE DOCUMENTS ARE THE PROPERTY OF AND ARE NOT TO BE REPRODUCED OR DISTRIBUTED WITHOUT FULL KNOWLEDGE AND WRITTEN CONSENT FROM ENVIROPLEX, INC.  
© COPYRIGHT ENVIROPLEX, INC. (ALL DRAWINGS PREPARED BY ENVIROPLEX, INC.)

IDENTIFICATION STAMP  
DIV. OF THE STATE ARCHITECT  
APP. 02-118017 INC.  
REVIEWED FOR  
SS ☐ FLS ☐ ACS ☐  
DATE: 04/10/2020

03/26/2020  
REGISTERED PROFESSIONAL ENGINEER  
No. S2020  
THESE DRAWINGS ARE PRELIMINARY  
AND NOT FOR CONSTRUCTION  
UNLESS STAMPED & SIGNED BY  
THE ENGINEER OF RECORD.


**ENVIROPLEX, INC.**  
4777 E. CARPENTER ROAD STOCKTON, CA. 95215, (209) 466-8000  
CESAR CHAVEZ HIGH SCHOOL - ATHLETIC FACILITY  
STOCKTON UNIFIED SCHOOL DISTRICT  
2929 WINDFLOWER LANE STOCKTON, CA 95212

**FASTENING SCHEDULE & NOTES**


REV / DATE: BY:  
JOB No.:  
DRAWN BY:  
DATE:  
IDENTIFICATION STAMP  
DIVISION OF THE STATE ARCHITECT  
PC-02-118017  
02-118017  
AC: FLS: 9-6-2018  
DATE: 9-6-2018

**S3FA**




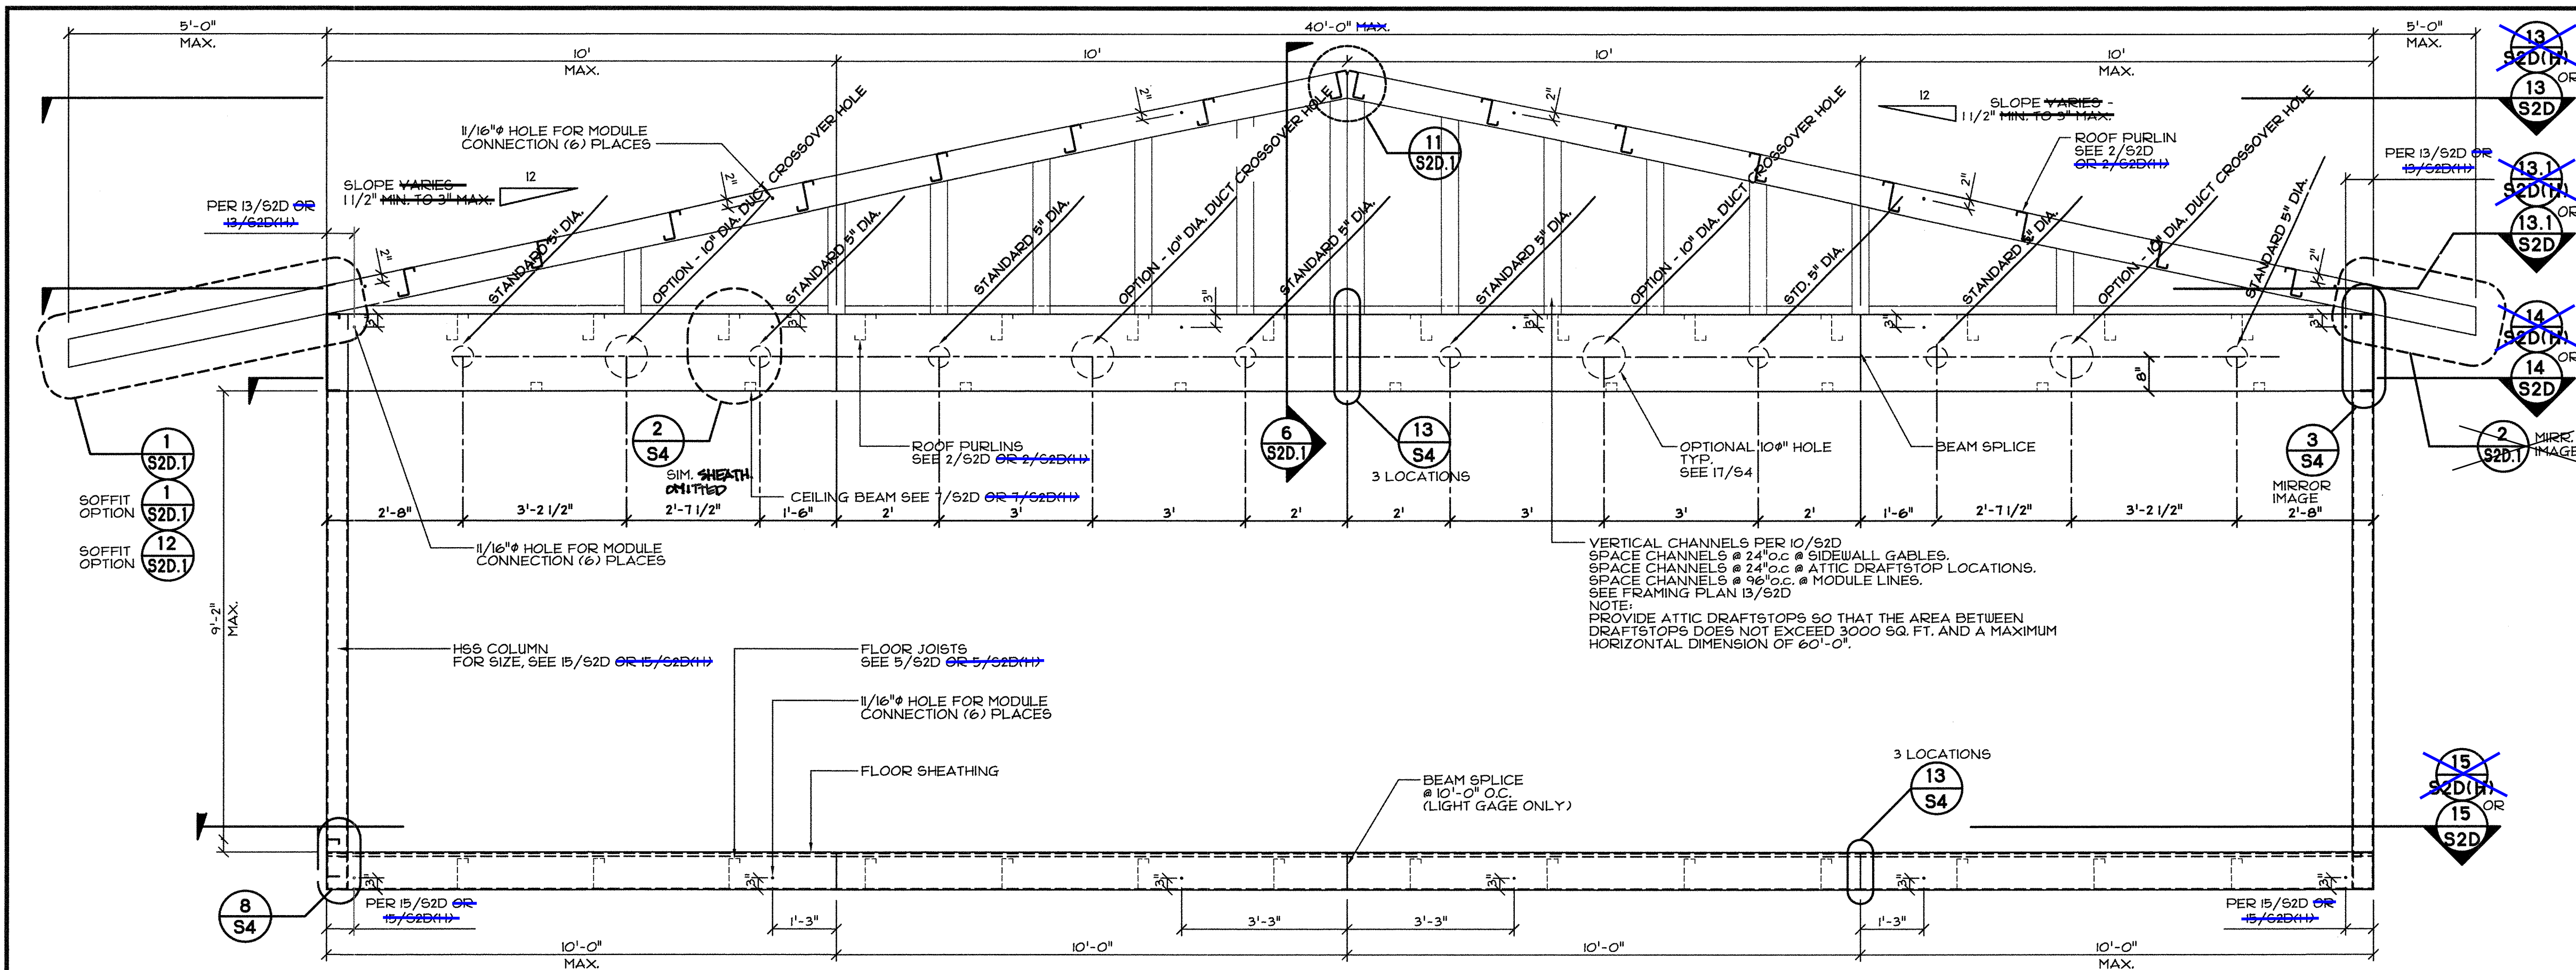


1 TYPICAL LONGITUDINAL FRAME SECTION - VARIABLE SLOPE ROOF  
SCALE: 1/2"=1'-0"

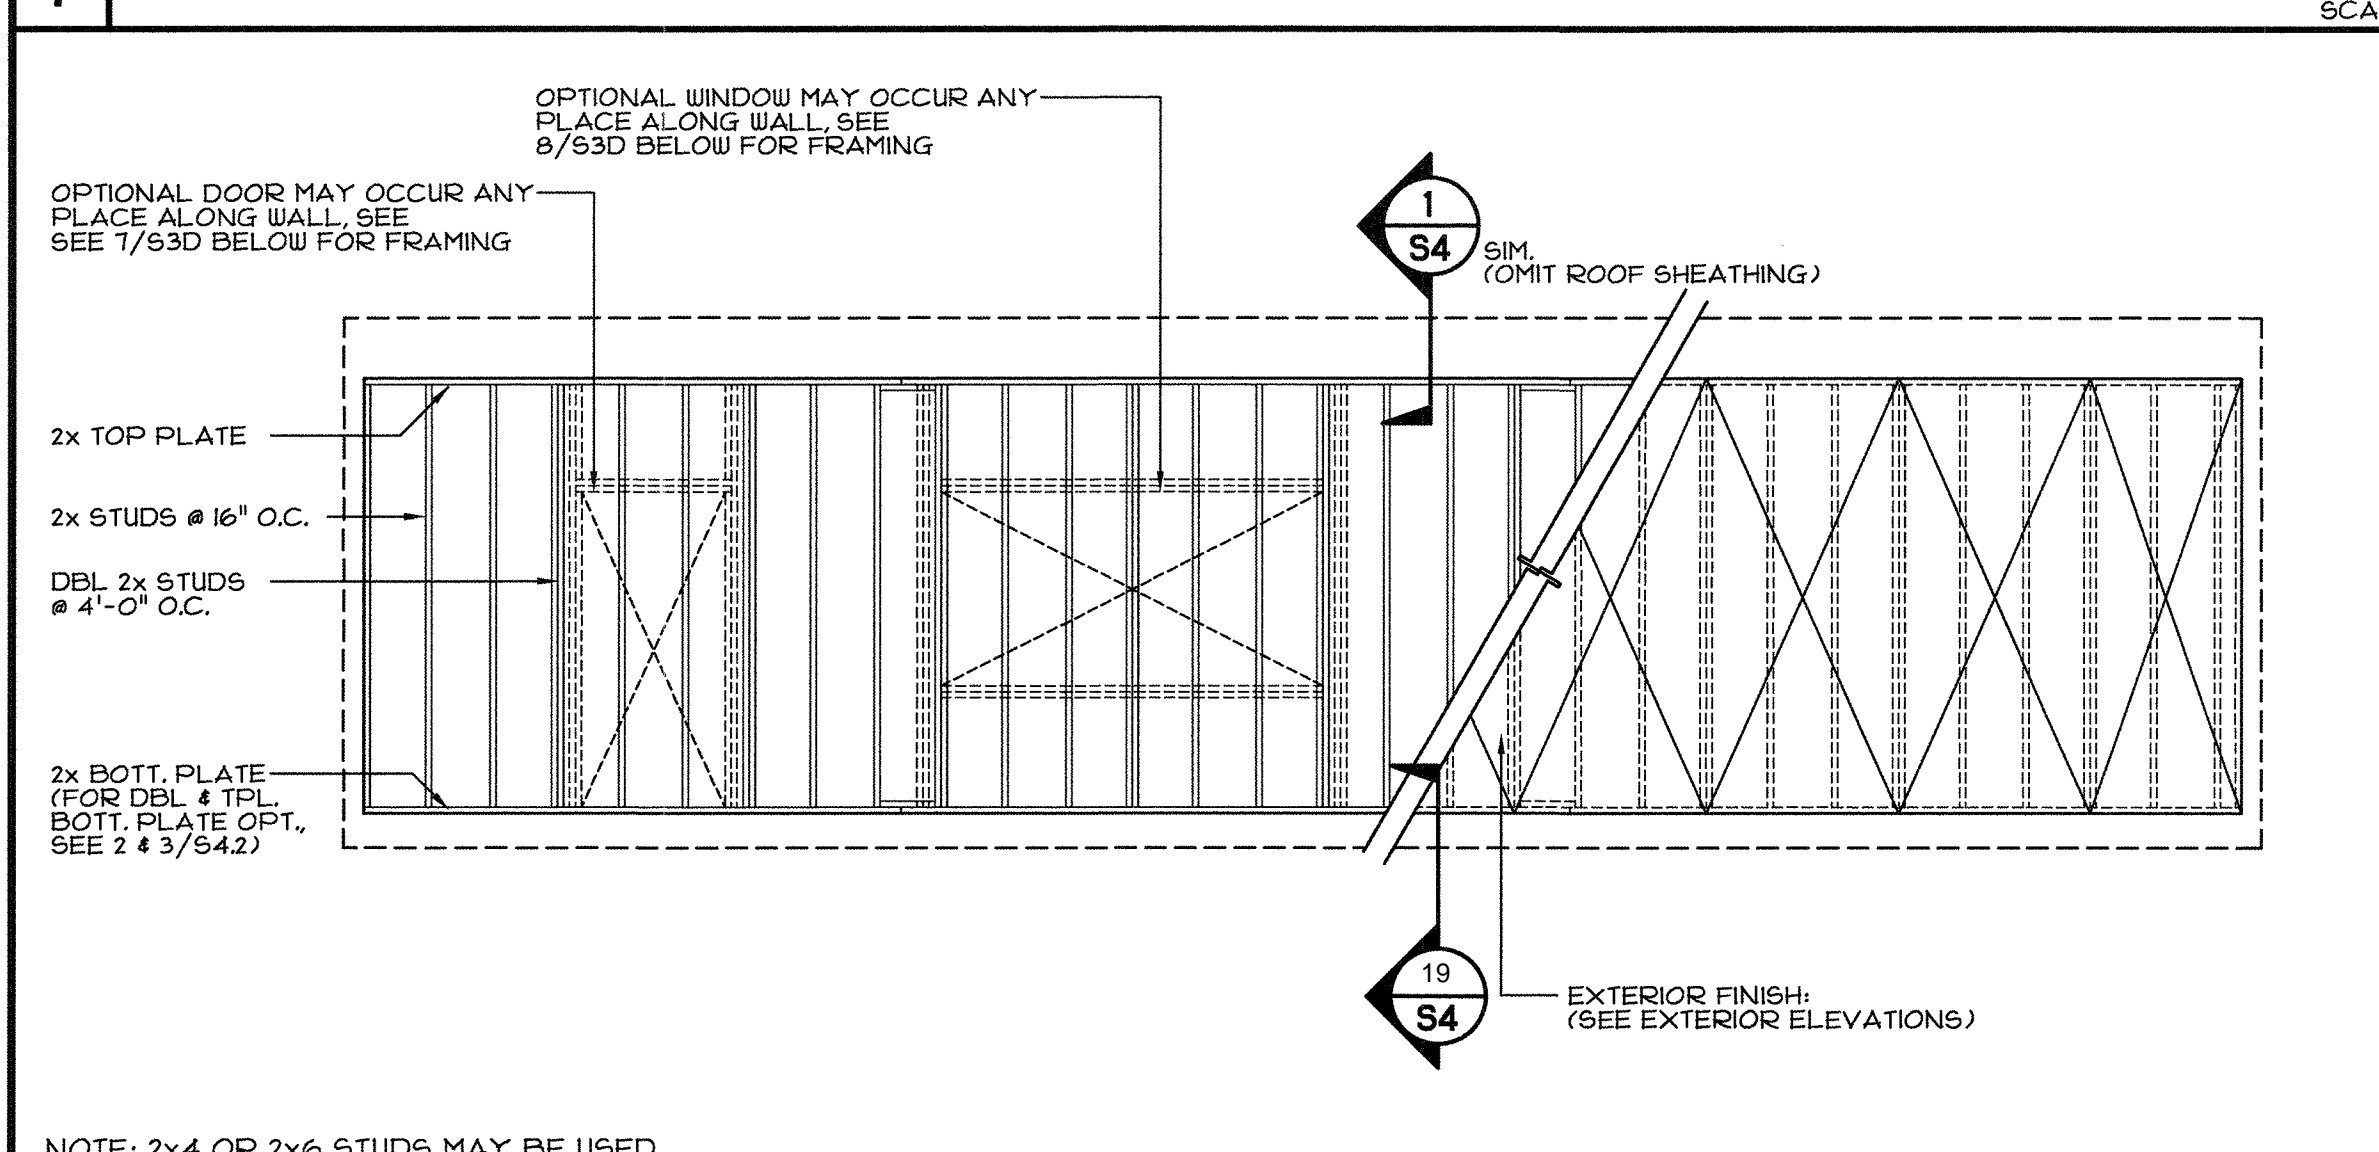


3 TYPICAL SIDEWALL FRAMING ELEVATION  
SCALE: 1/4"=1'-0"

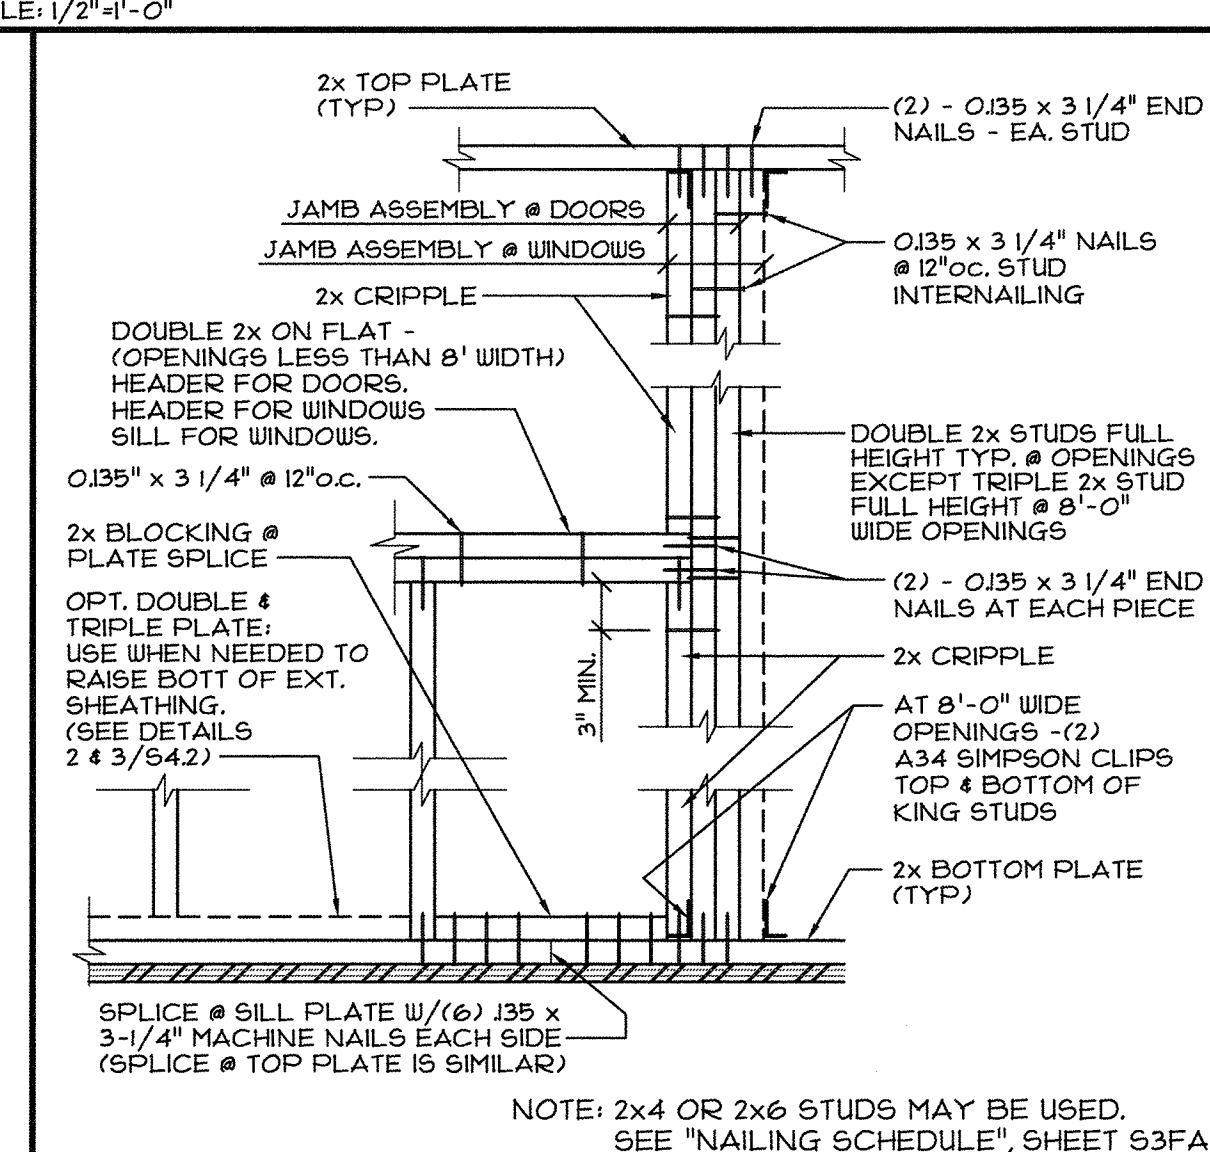


4 STUD NAILING DETAIL  
SCALE: 1"=1'-0"

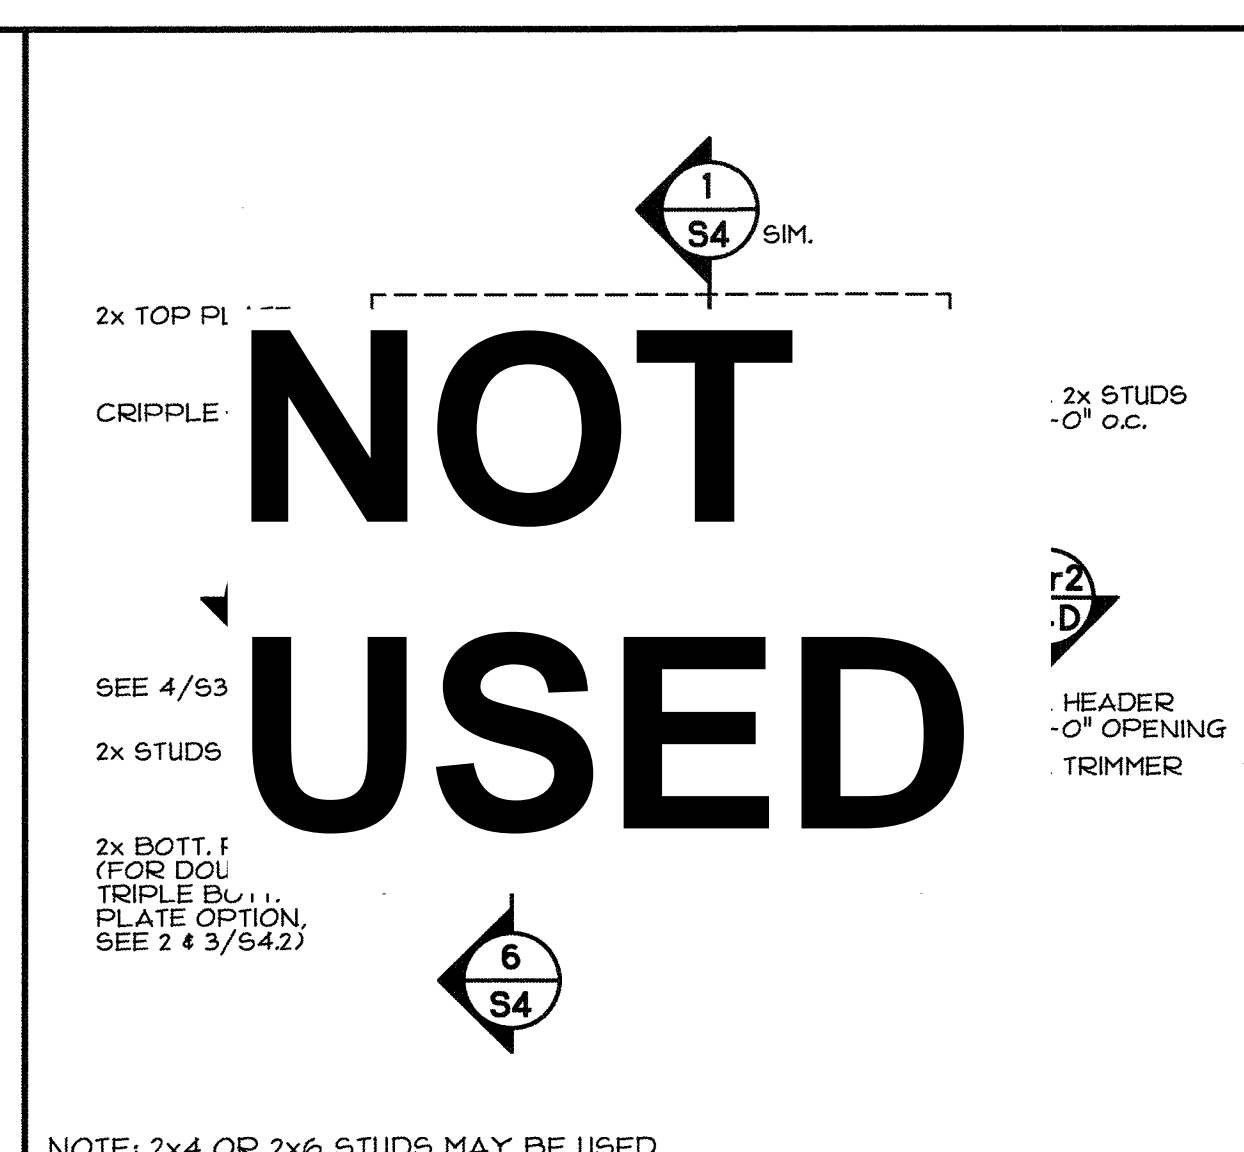


5 WALL FRAMING - INTERIOR HVAC  
SCALE: 1/4"=1'-0"

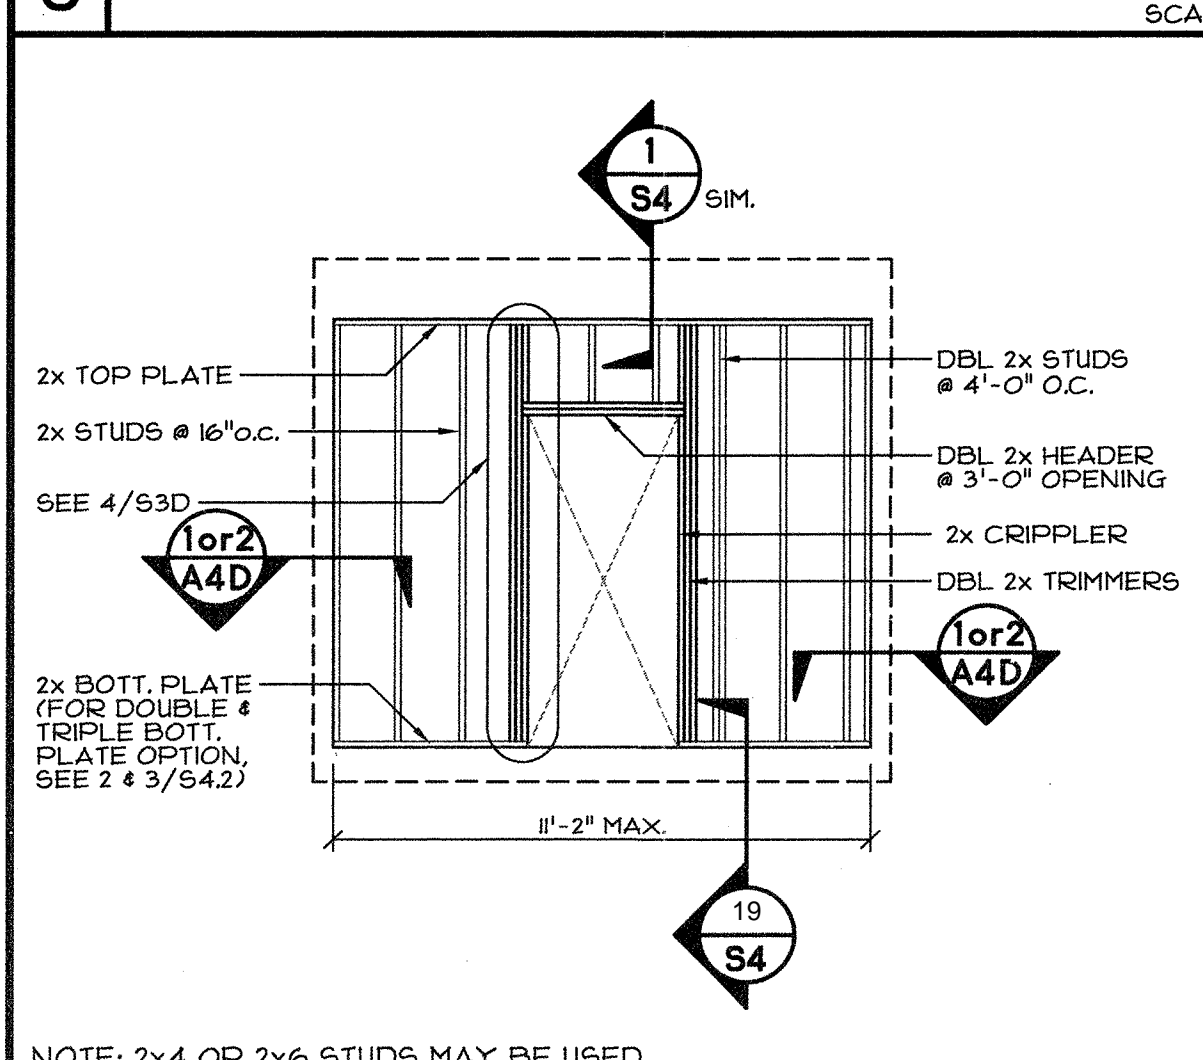


7 WALL FRAMING - EXTERIOR DOOR  
SCALE: 1/4"=1'-0"

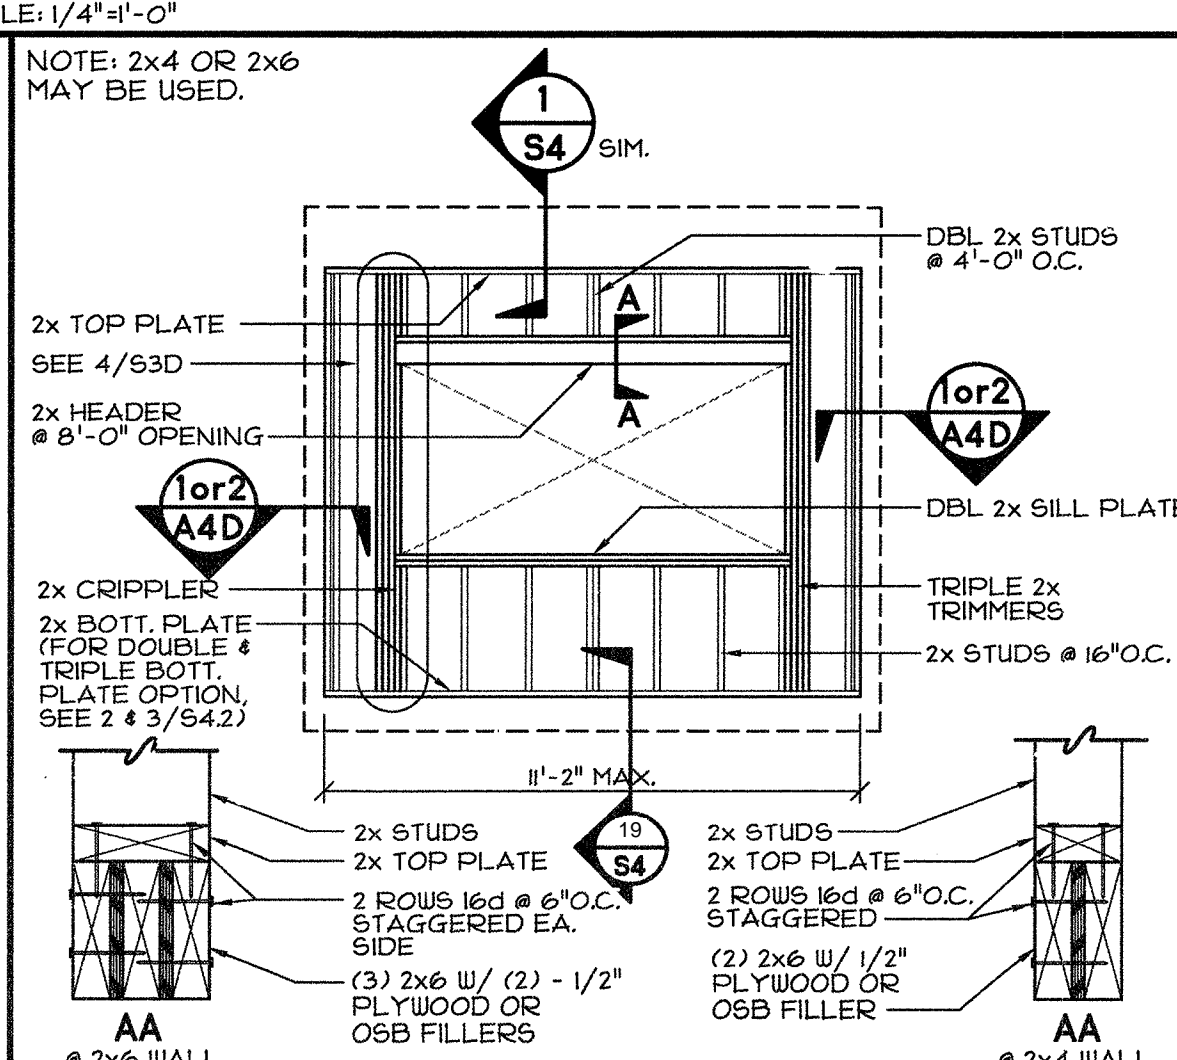

8 WALL FRAMING - EXTERIOR WINDOW  
SCALE: 1/4"=1'-0"

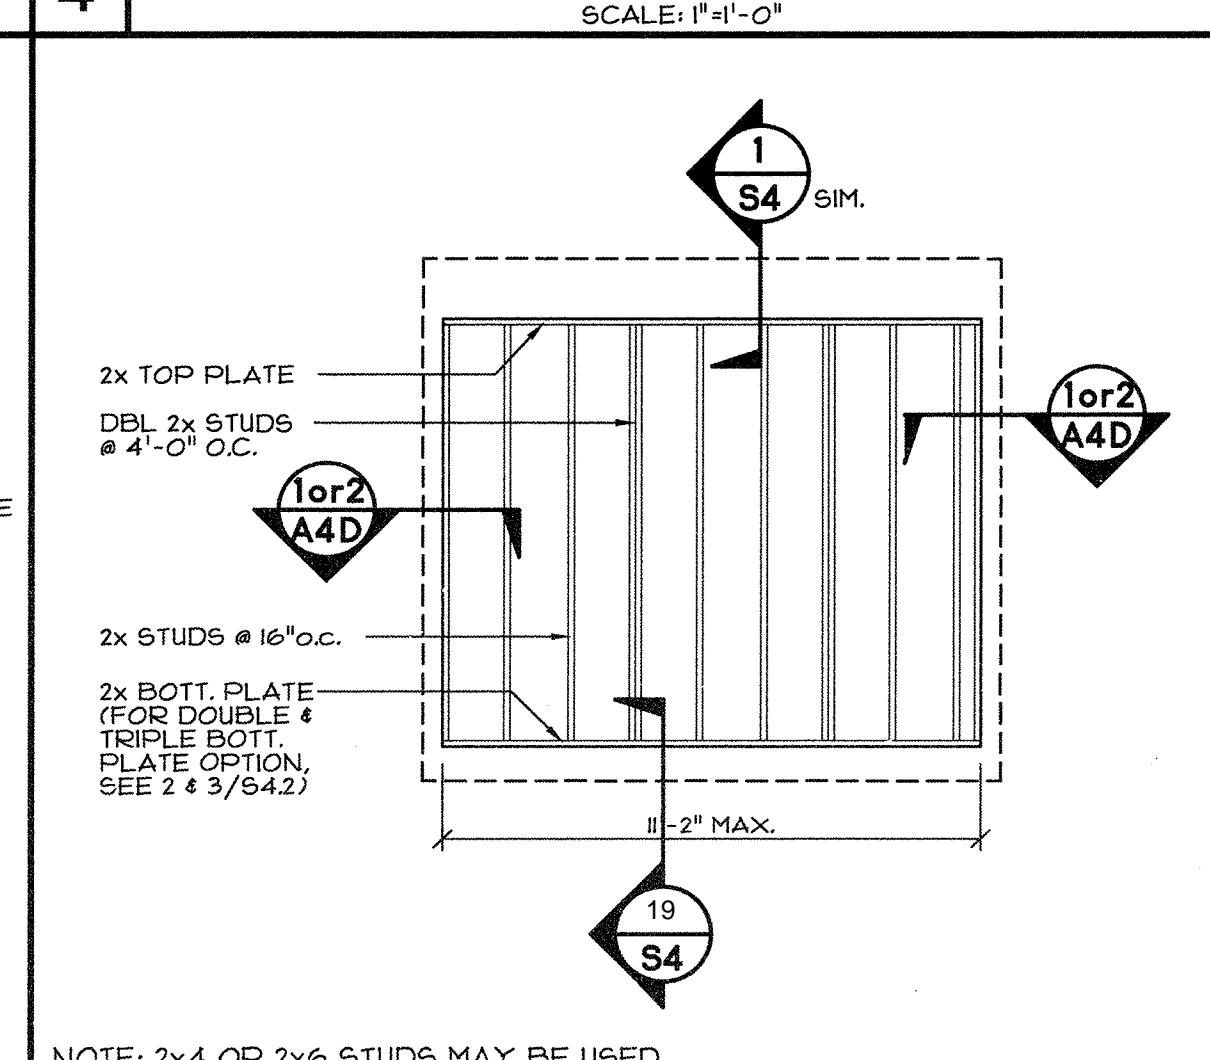

9 WALL FRAMING - TYP. 12'-0" WALL  
SCALE: 1/4"=1'-0"

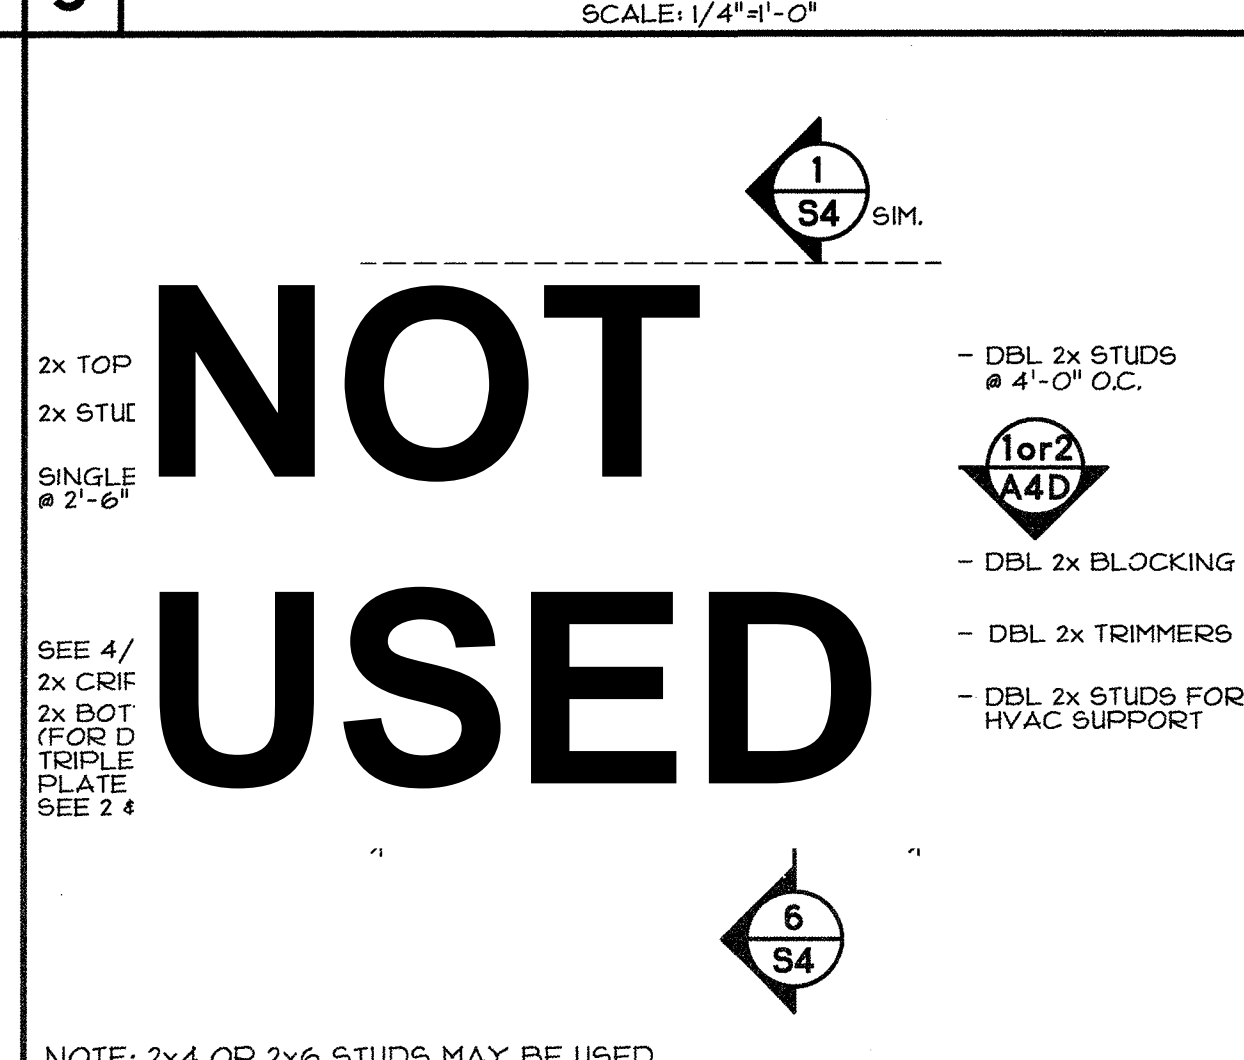

10 WALL FRAMING - EXTERIOR HVAC  
SCALE: 1/4"=1'-0"

IDENTIFICATION STAMP  
DIV. OF THE STATE ARCHITECT  
APP. 02-118017 INC.  
REVIEWED FOR  
SS ☐ FLS ☐ ACS ☐  
DATE: 04/10/2020

03/26/2020

REGISTERED PROFESSIONAL ENGINEER  
JAMES E. ROSS  
No. S2030  
STATE OF CALIFORNIA  
EXPIRATION DATE 03/31/2025  
THESE DRAWINGS ARE PRELIMINARY  
AND NOT FOR CONSTRUCTION  
UNLESS STAMPED & SIGNED BY  
THE ENGINEER OF RECORD.

**ENVIROPLEX, INC.**  
4777 E. CARPENTER ROAD STOCKTON, CA. 95215, (209) 468-8000  
CESAR CHAVEZ HIGH SCHOOL - ATHLETIC FACILITY  
STOCKTON UNIFIED SCHOOL DISTRICT  
2929 WINDFLOWER LANE STOCKTON, CA 95212

VARIABLE SLOPE ROOF  
LONGITUDINAL BUILDING SECTION,  
WALL FRAMING ELEVATIONS, END  
FRAME ELEVATION

REV / DATE: BY:

JOB No.:  
DRAWN BY:  
DATE:


IDENTIFICATION STAMP  
DIVISION OF THE STATE ARCHITECT  
02-118094  
AC ☐ FLS ☐ SS ☒  
DATE: 9-6-2018  
2018 - 2020

PRE-CHECK (PC) DOCUMENT  
Code: 2016 CBC  
A separate project application for  
construction is required.


CONFIDENTIAL MATERIAL - THESE DOCUMENTS ARE THE PROPERTY OF AND ARE NOT TO BE REPRODUCED  
OR DISTRIBUTED WITHOUT FULL KNOWLEDGE AND WRITTEN CONSENT FROM ENVIROPLEX, INC.  
© COPYRIGHT ENVIROPLEX, INC. (ALL DRAWINGS PREPARED BY ENVIROPLEX, INC.)

S3D




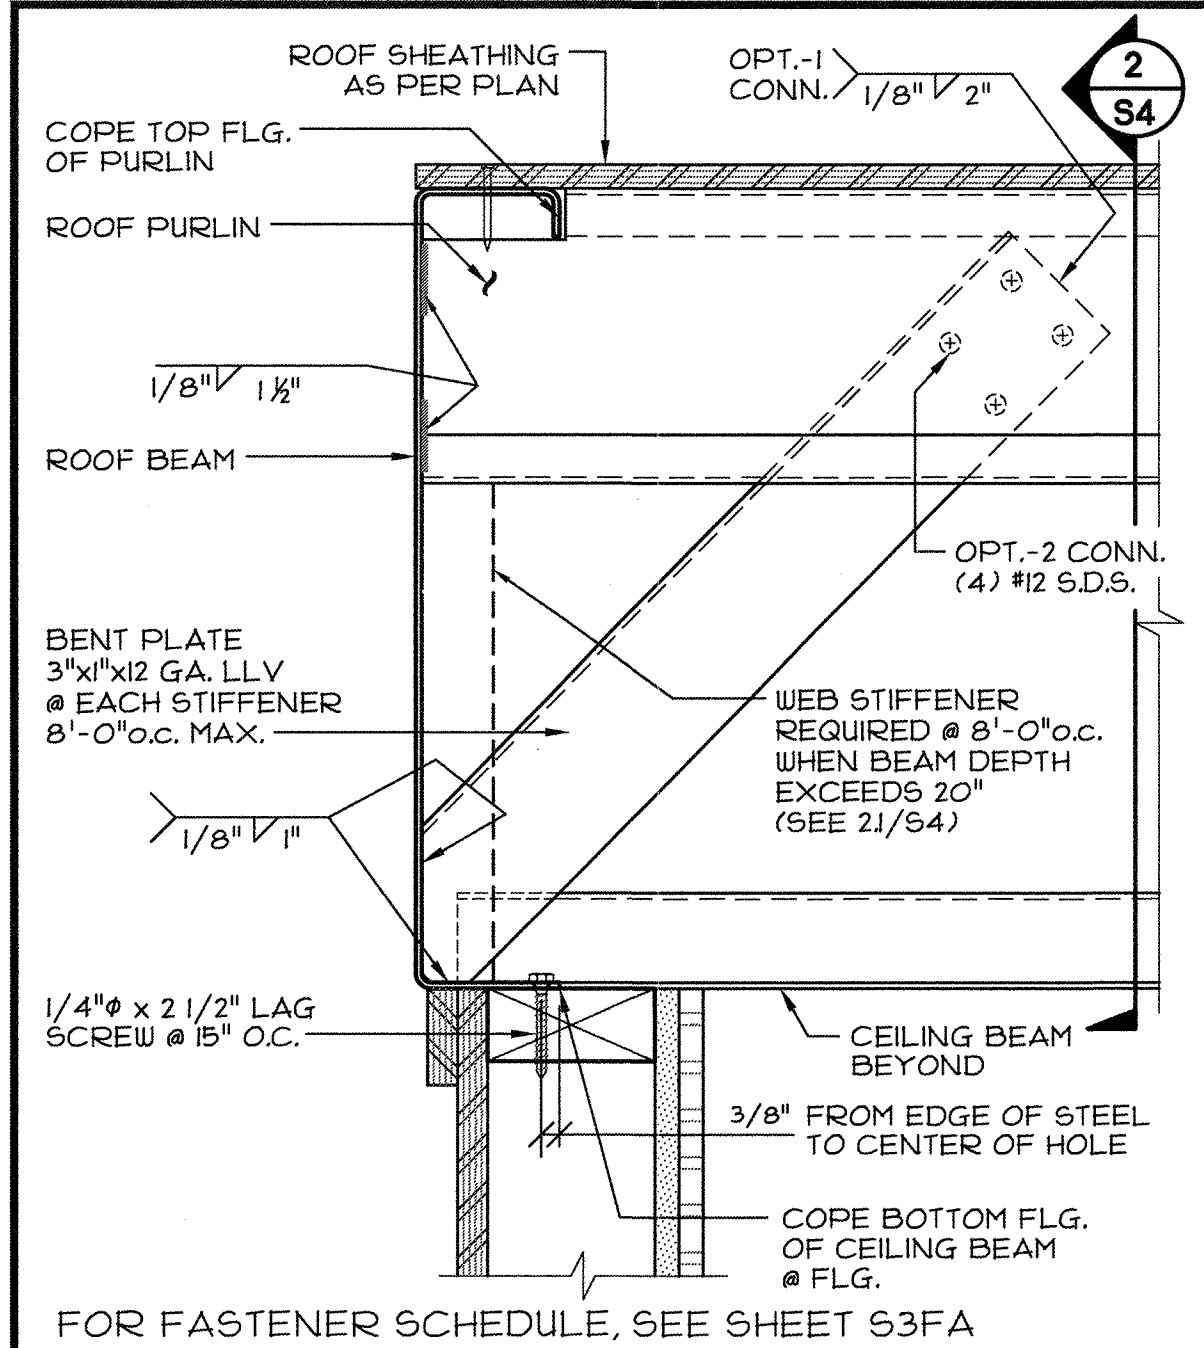


1 ROOF BEAM SECTION @ PURLIN  
SCALE: 3/4"=1'-0"

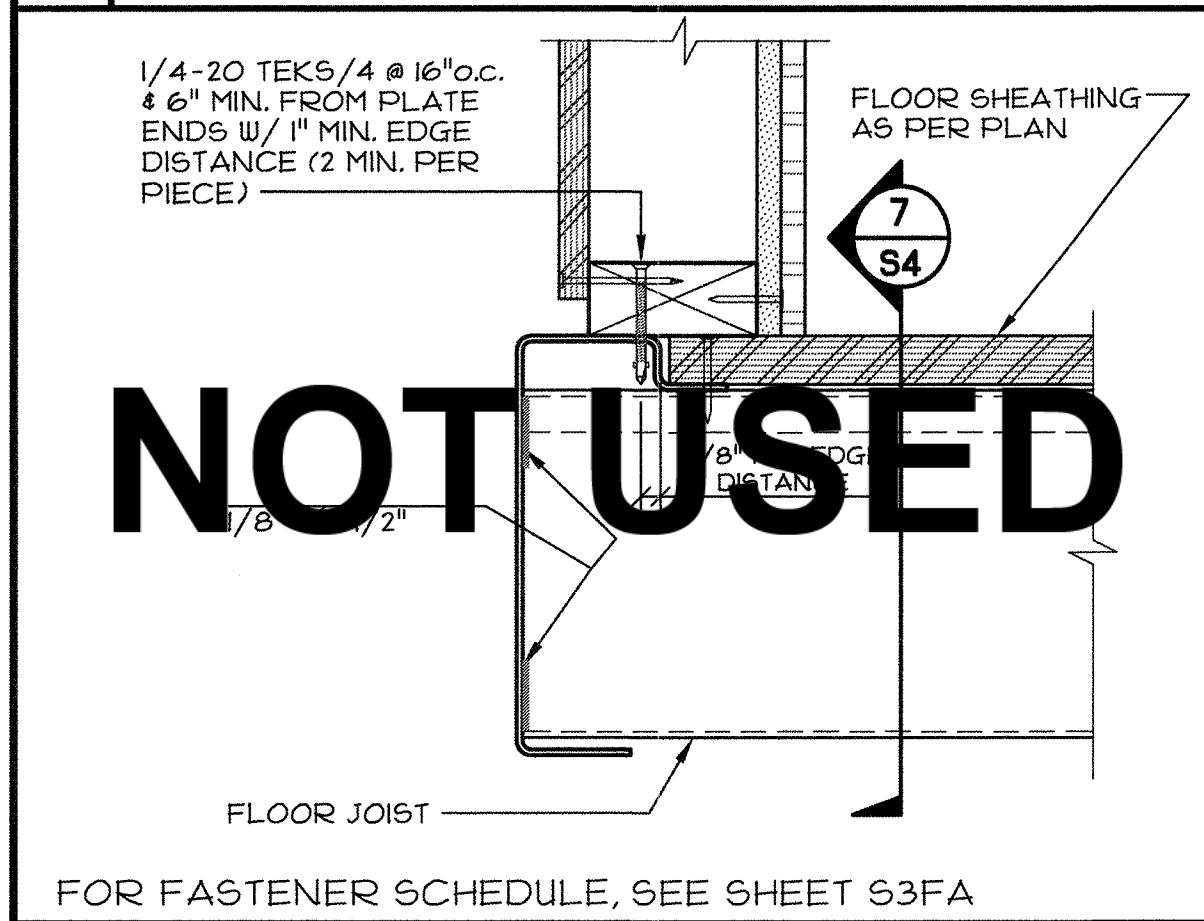


6 FLOOR BEAM @ JOIST CONNECTION  
SCALE: 3/4"=1'-0"

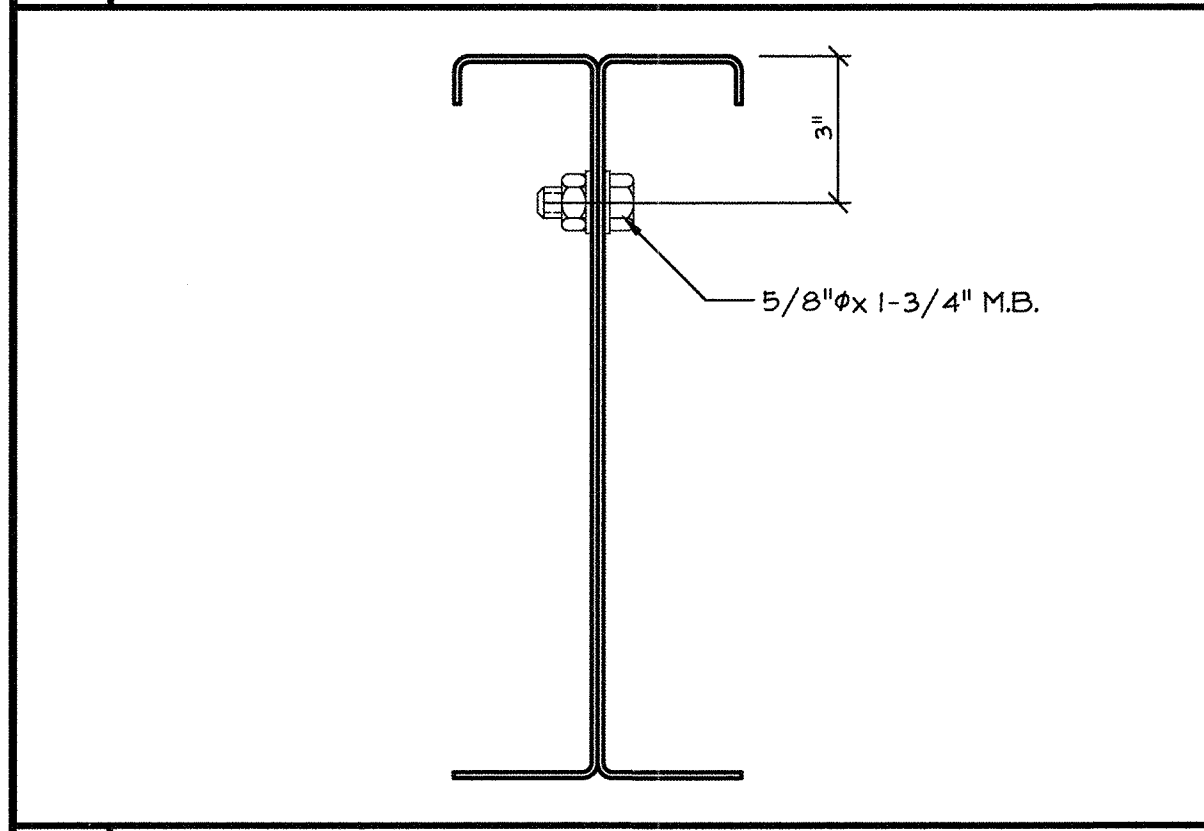


11 ROOF BEAM CONNECTION @ MOD LINE  
SCALE: 3/4"=1'-0"

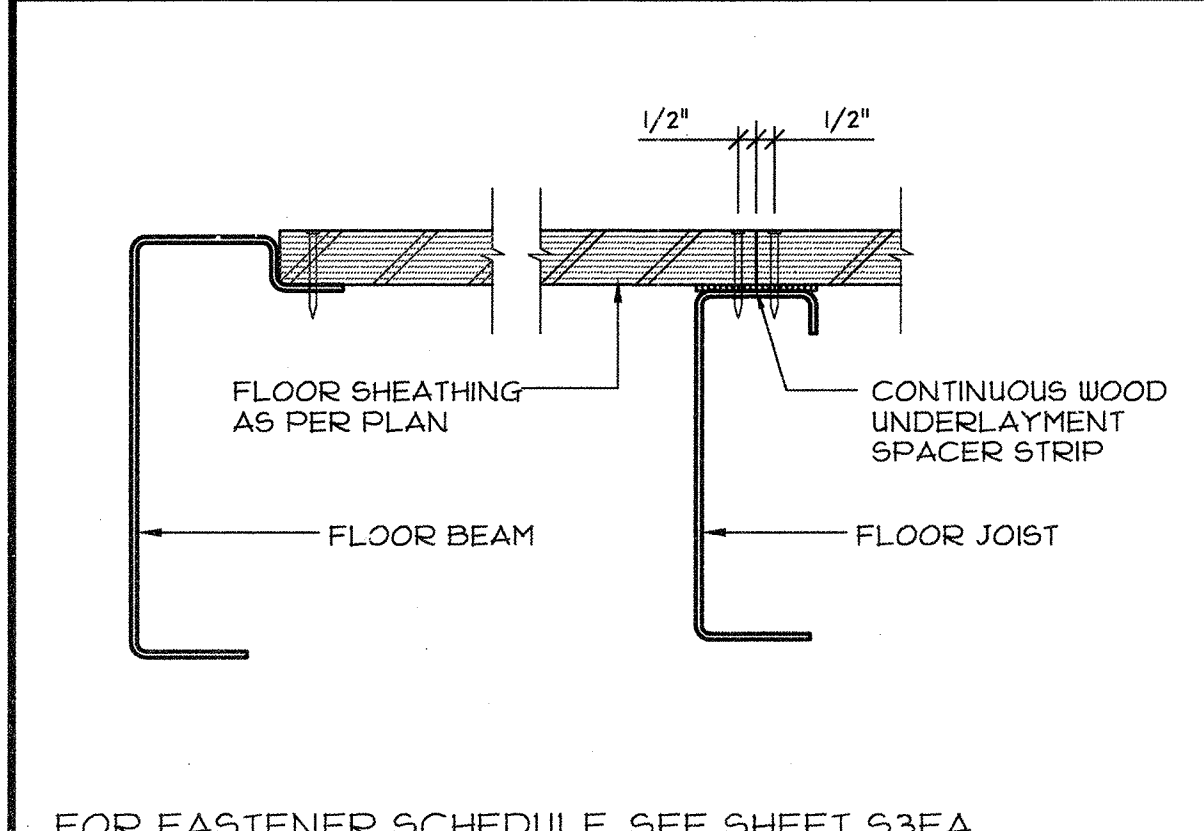


15 FLOOR SHEATHING ATTACHMENT  
SCALE: 3/4"=1'-0"

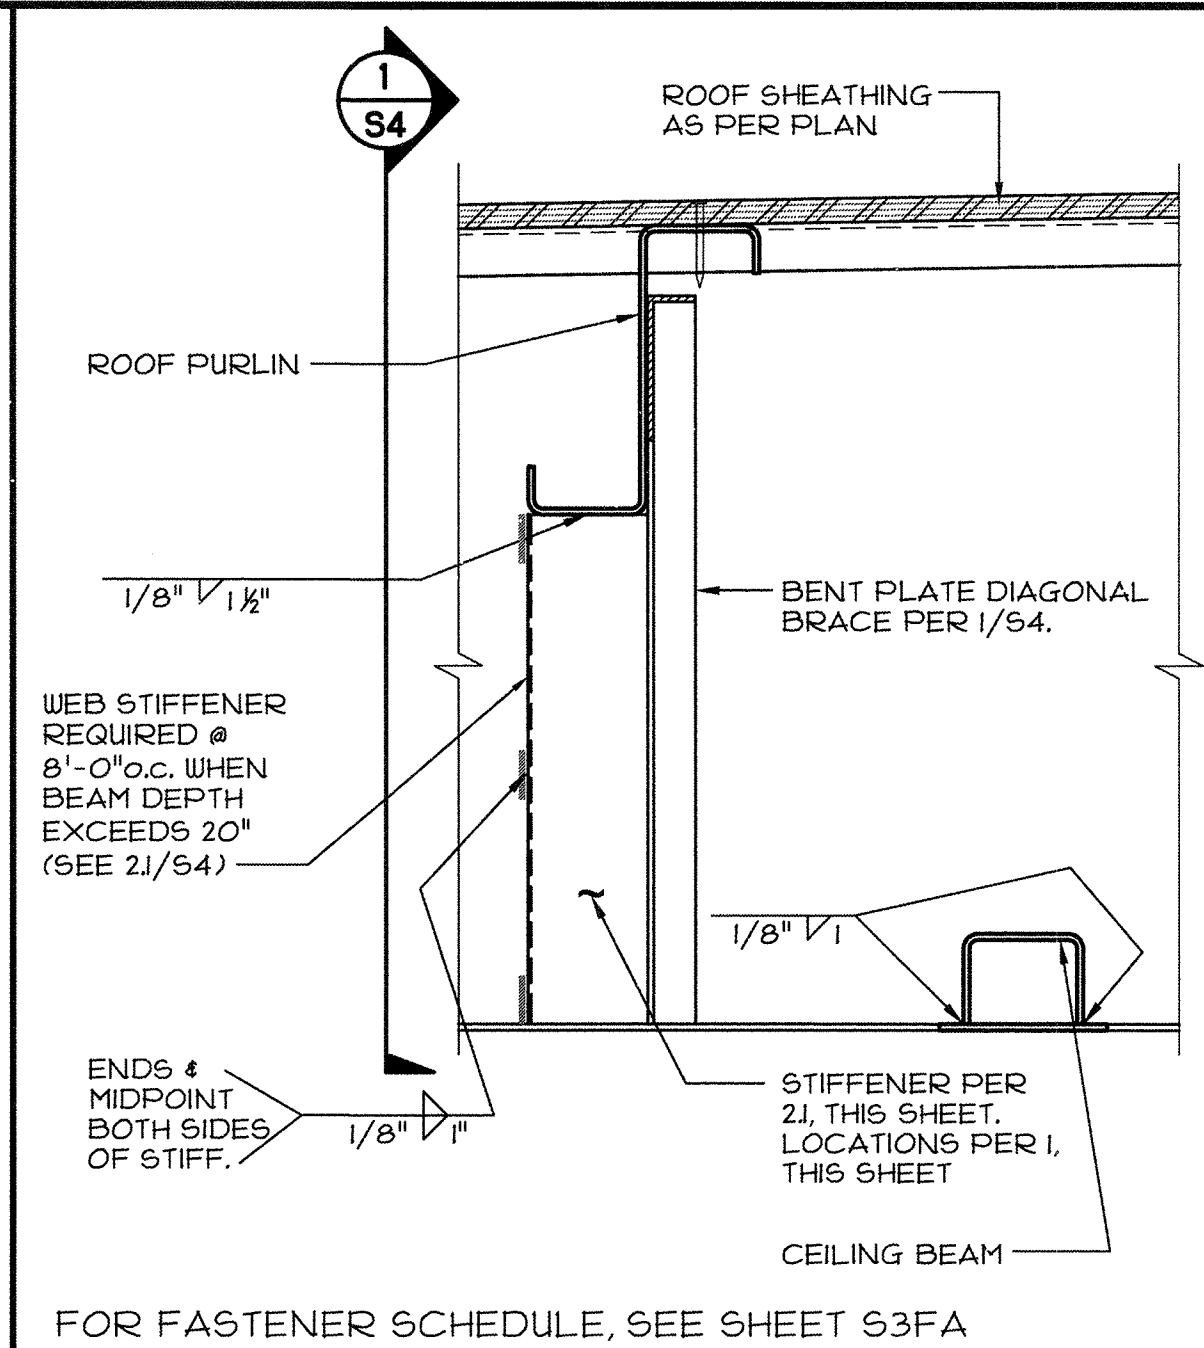


2 PURLIN TO STIFFENER AT BEAM  
SCALE: 3/4"=1'-0"

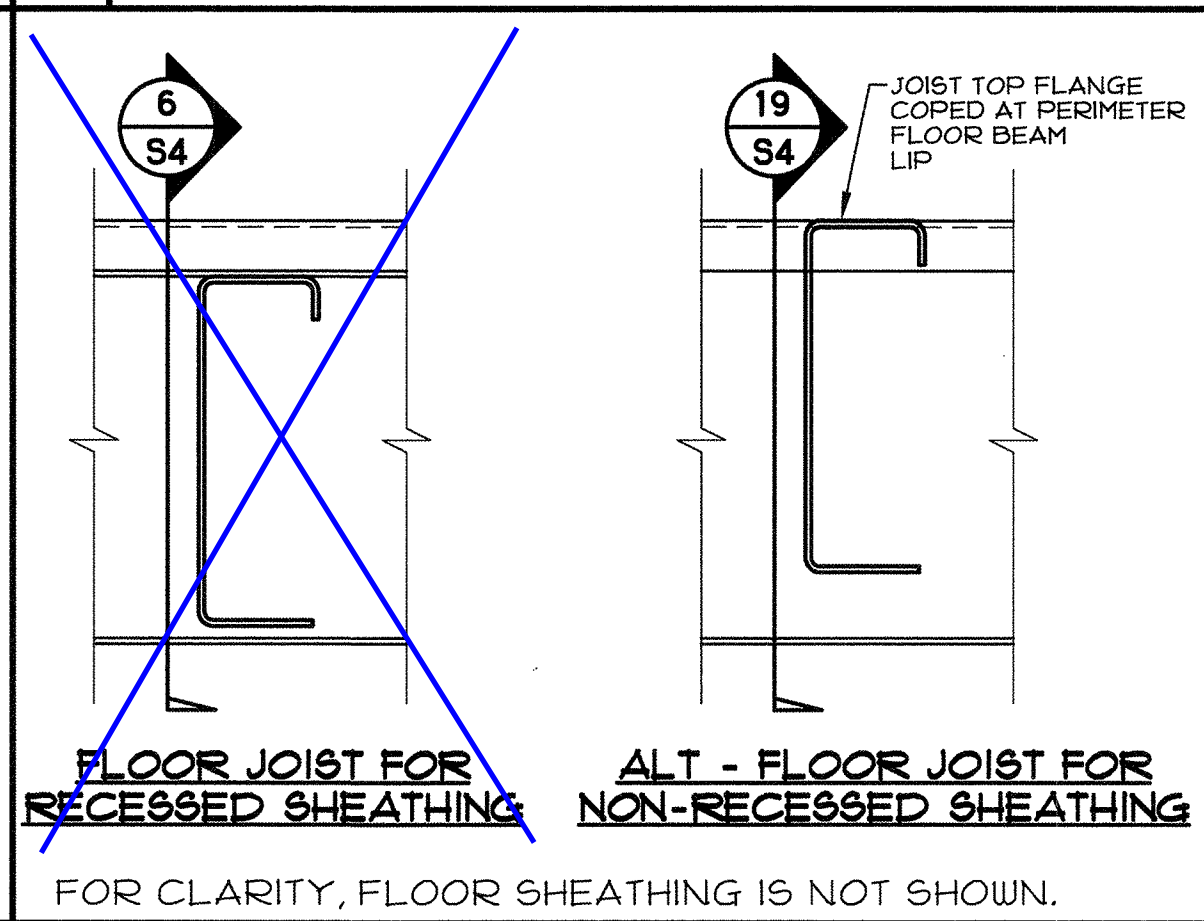


7 JOIST TO BEAM CONNECTION  
SCALE: 3/4"=1'-0"

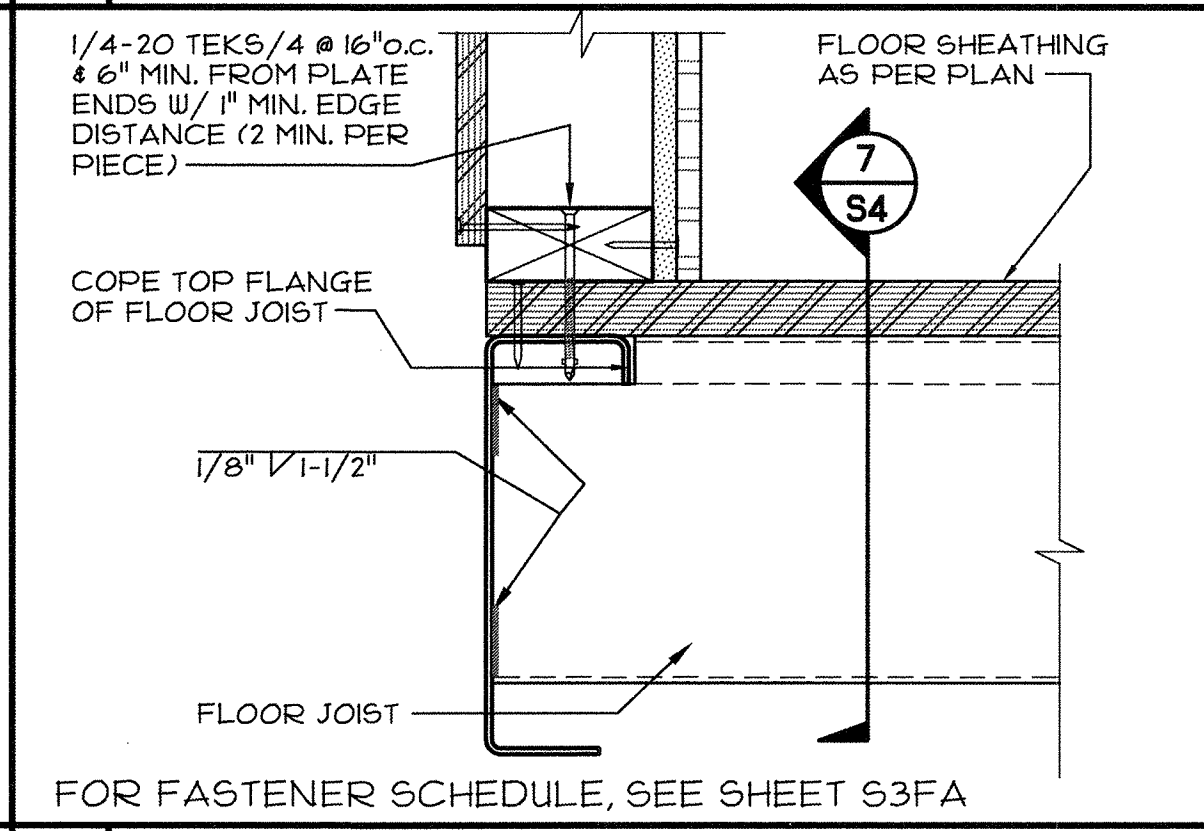


19 ALT. FLOOR BEAM @ JOIST CONN.  
SCALE: 3/4"=1'-0"

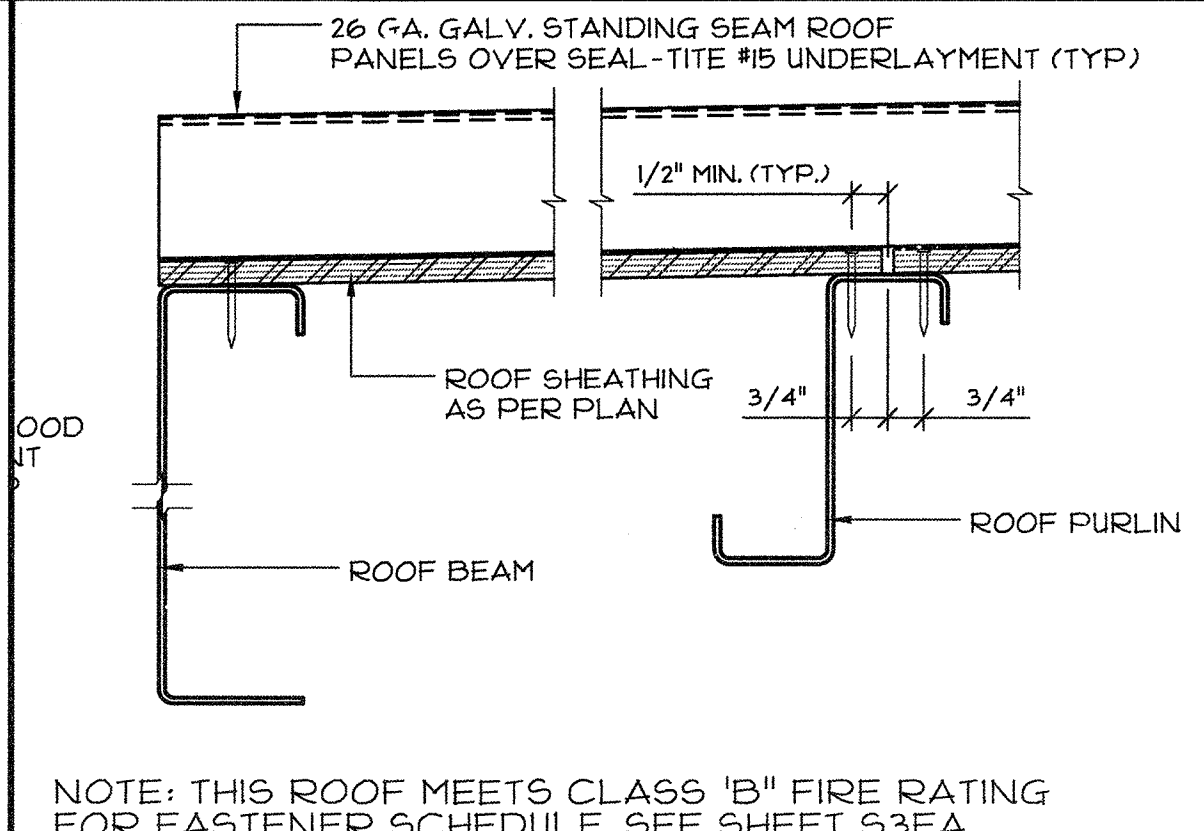


16 ROOF SHEATHING ATTACHMENT  
SCALE: 3/4"=1'-0"

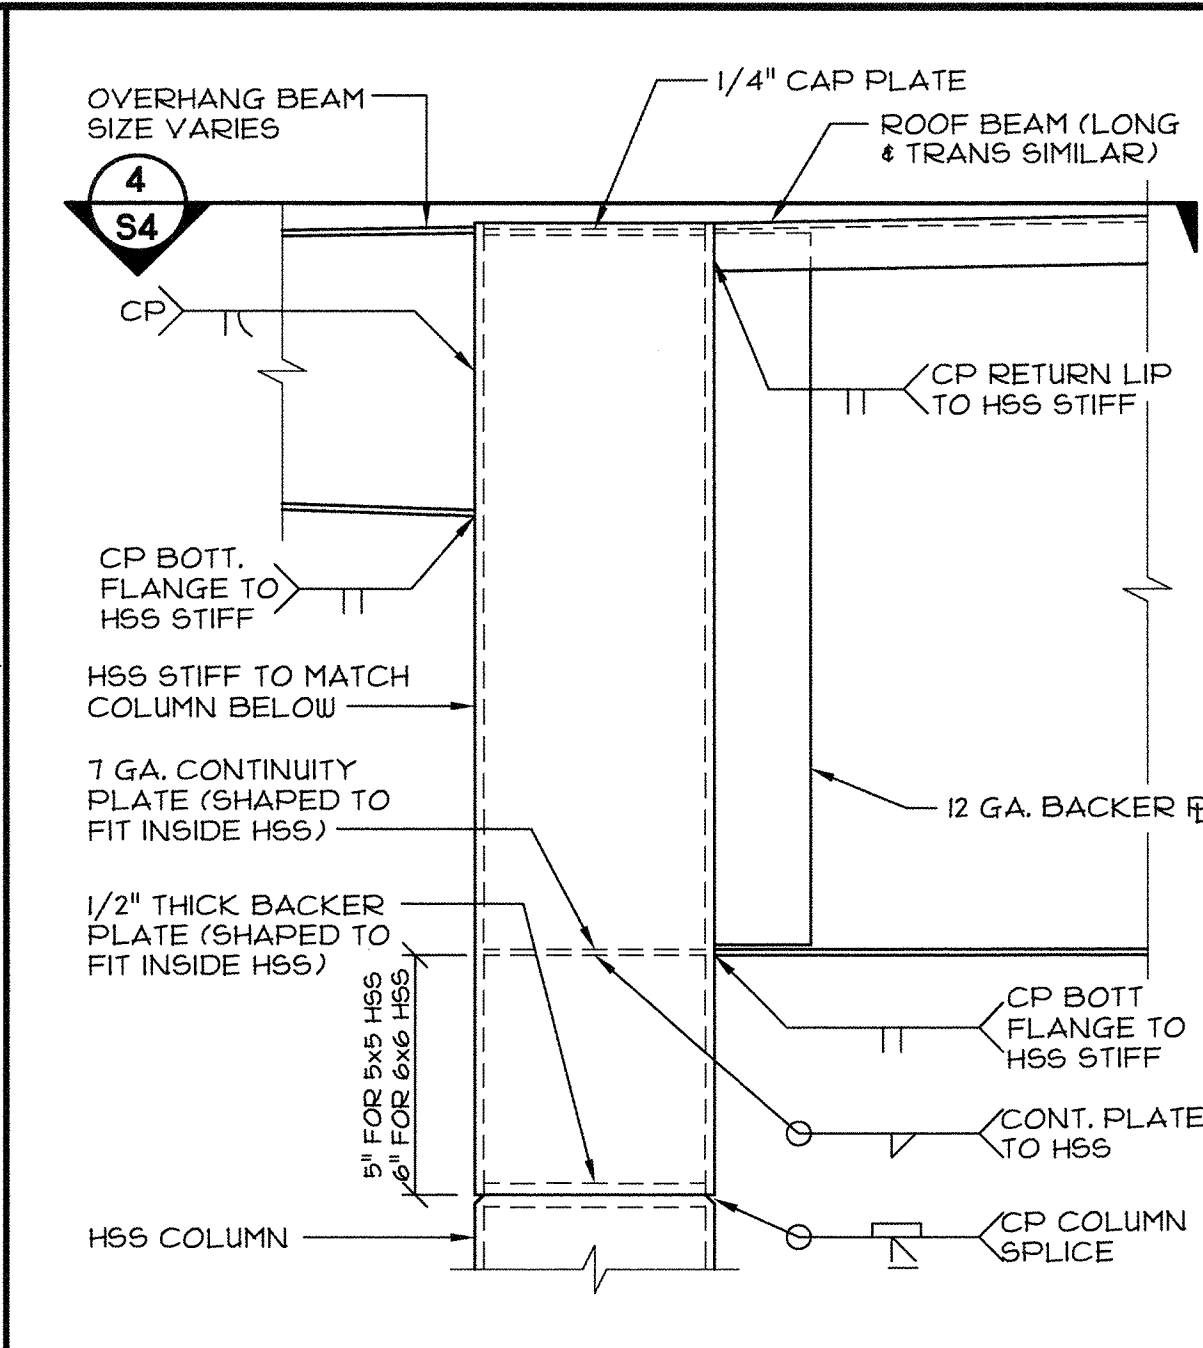


3 ROOF BEAM @ CORNER - SECTION  
SCALE: 3/4"=1'-0"

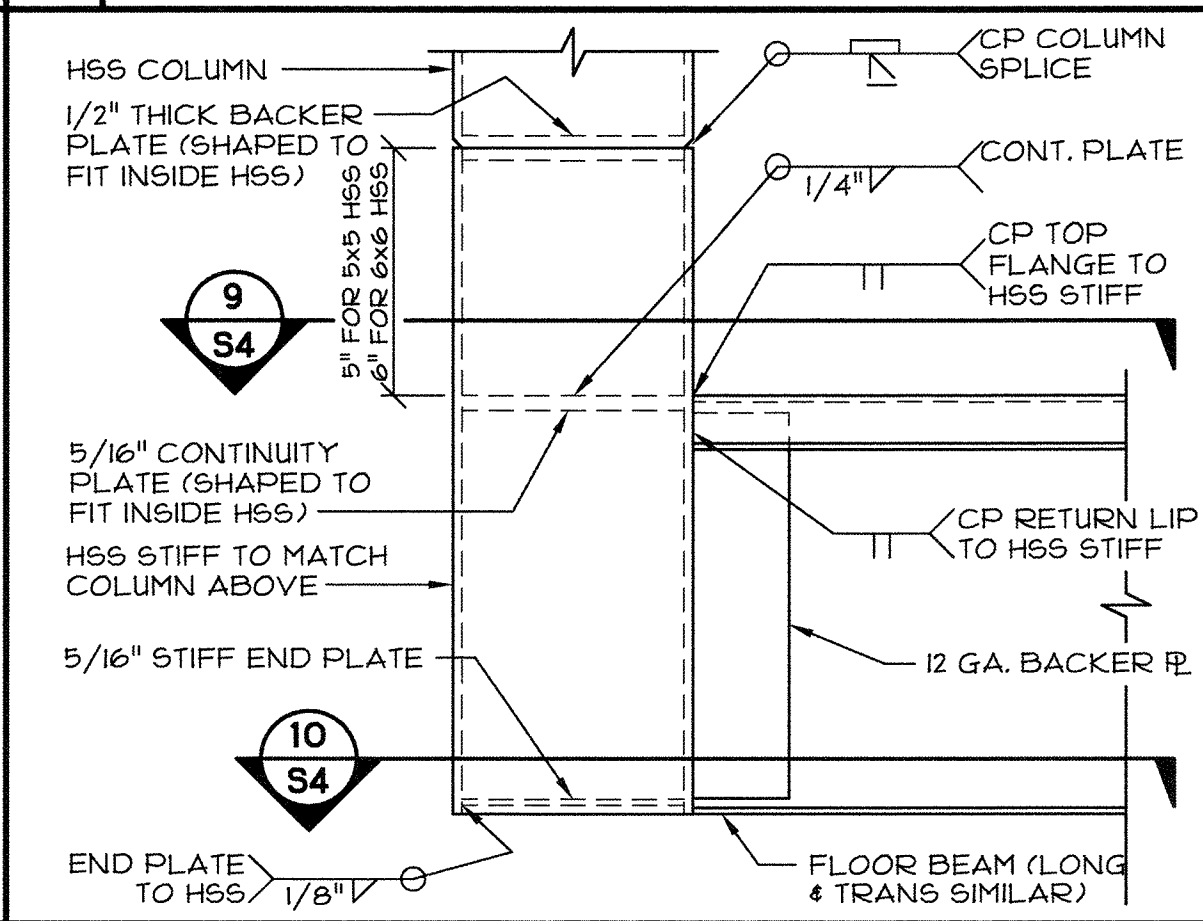


8 FLOOR BEAM @ CORNER - SECTION  
SCALE: 3/4"=1'-0"

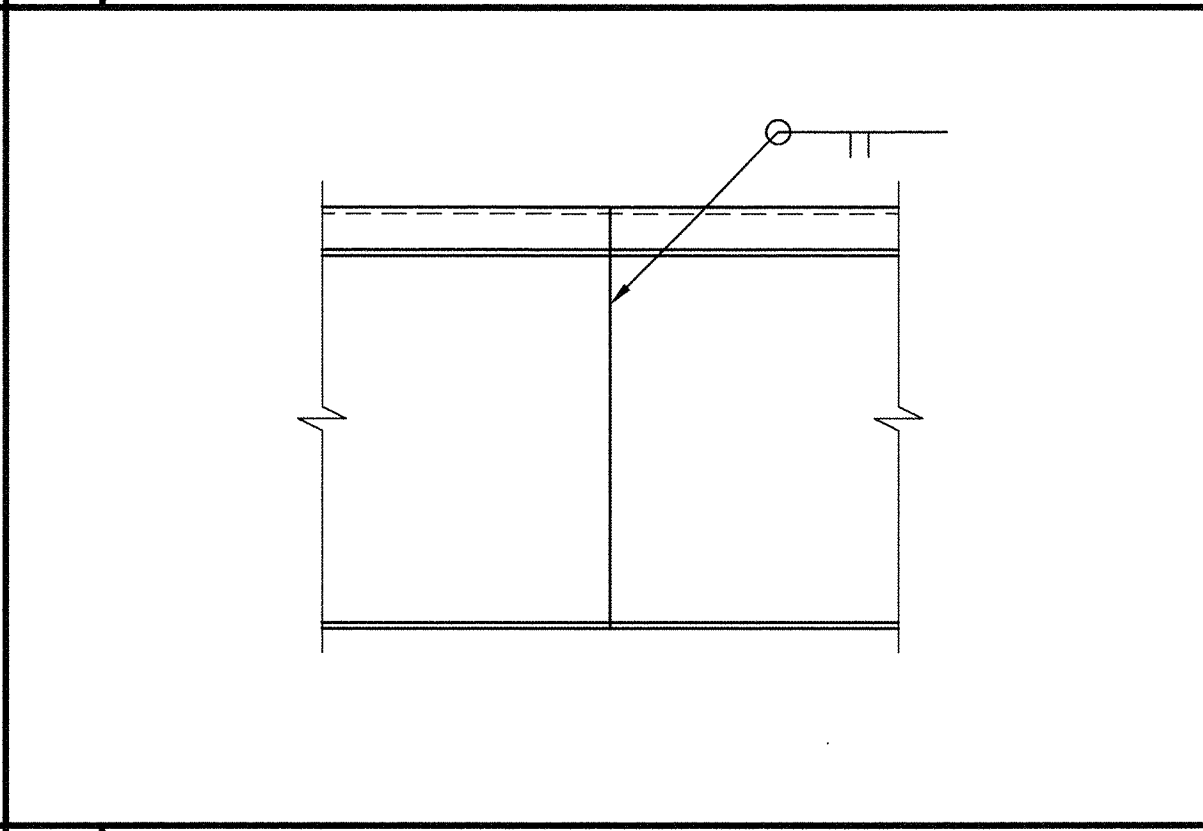


13 BEAM SPLICE DETAIL  
SCALE: 3/4"=1'-0"

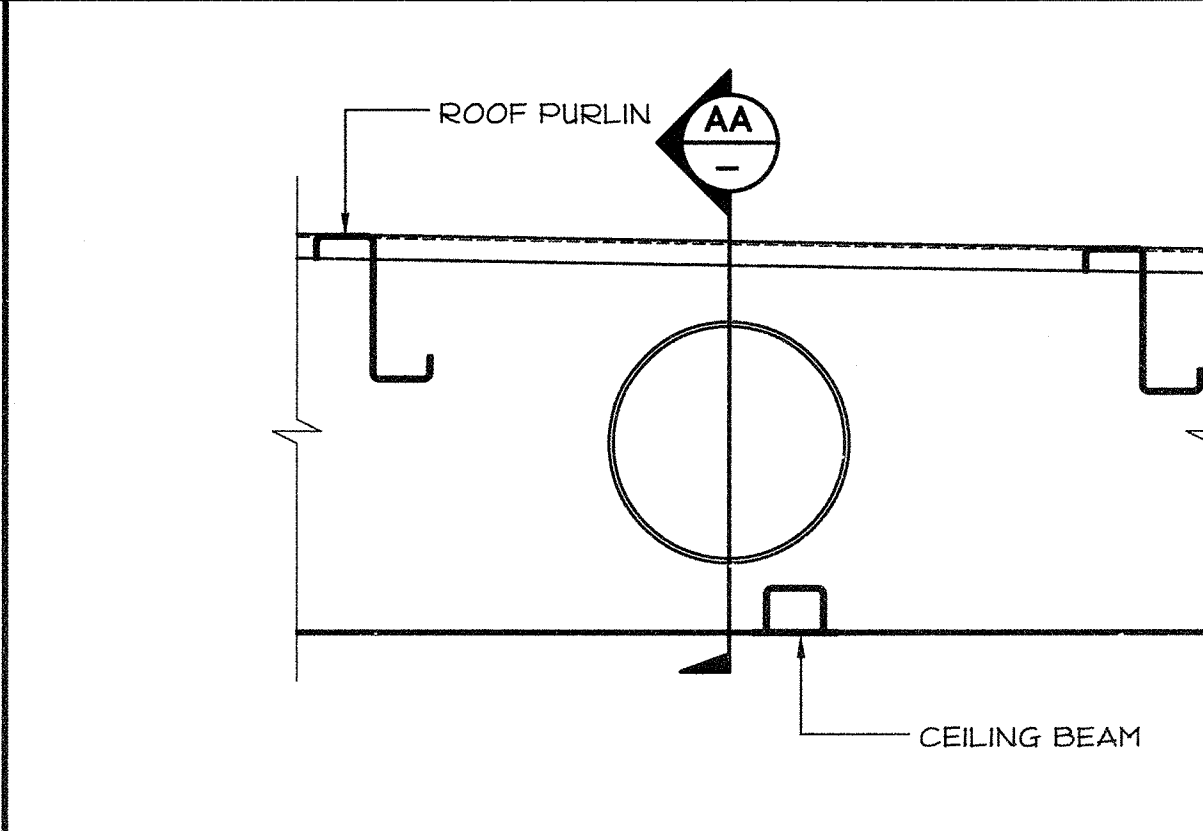


17 10" ROOF BEAM PENETRATION @ MOD-LINE  
SCALE: 1-1/2"=1'-0"

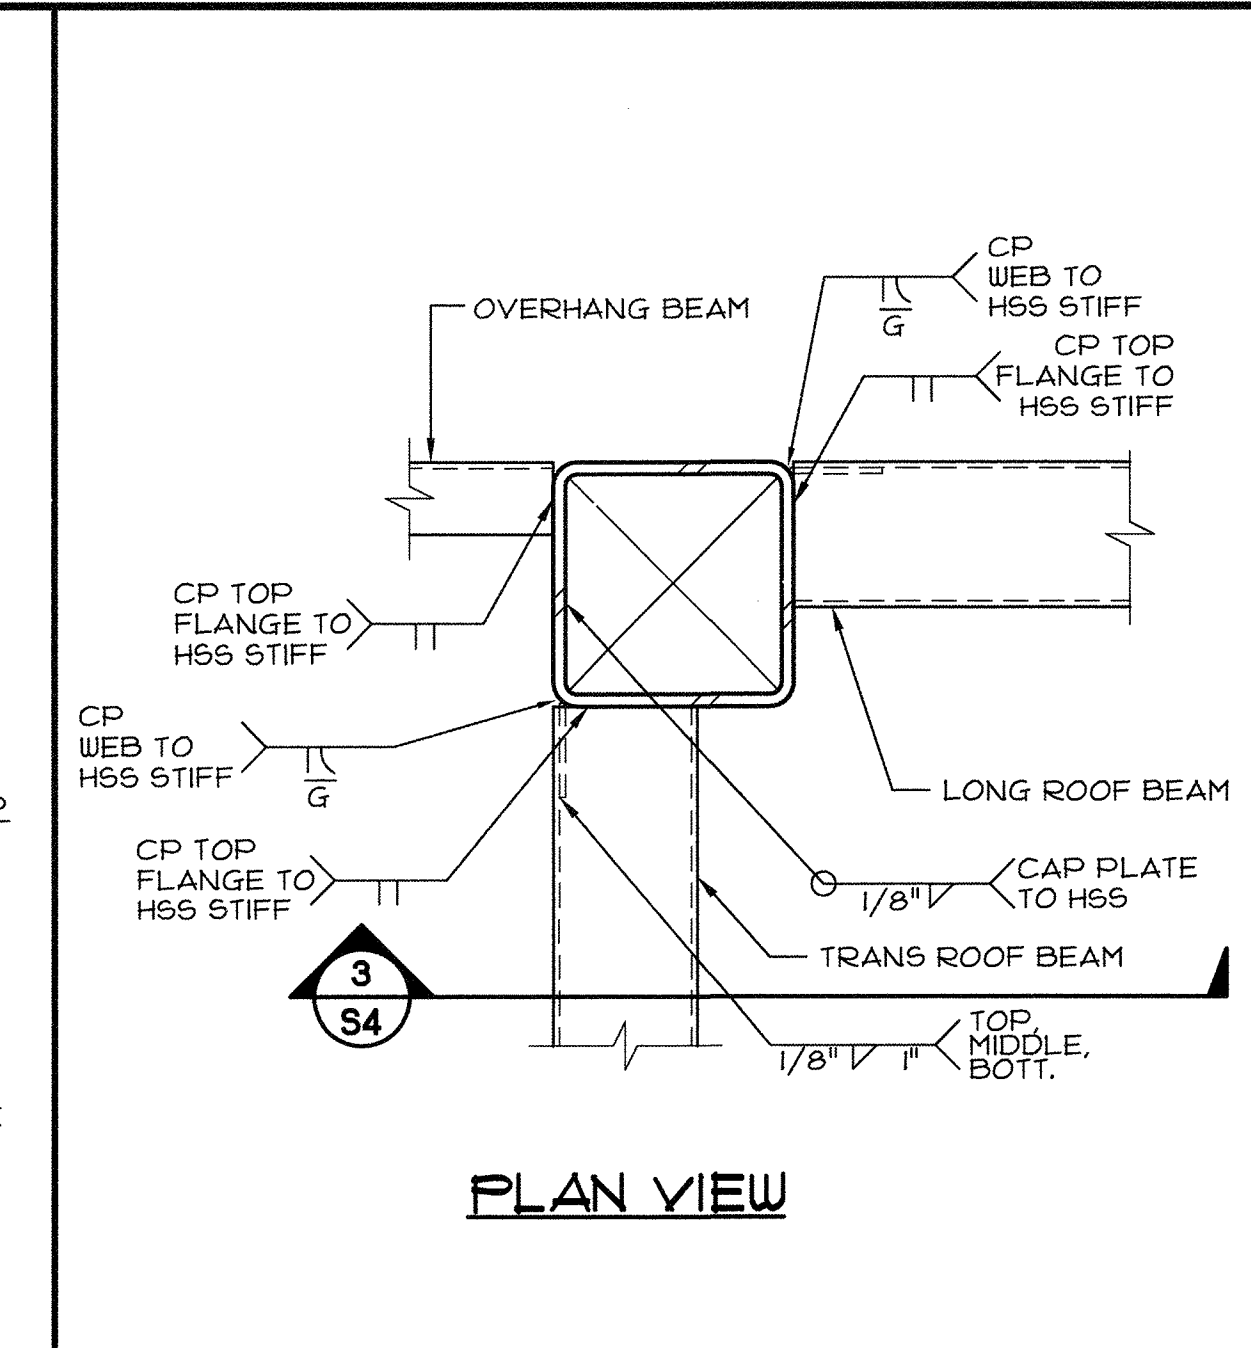


4 ROOF BEAM @ CORNER  
SCALE: 3/4"=1'-0"

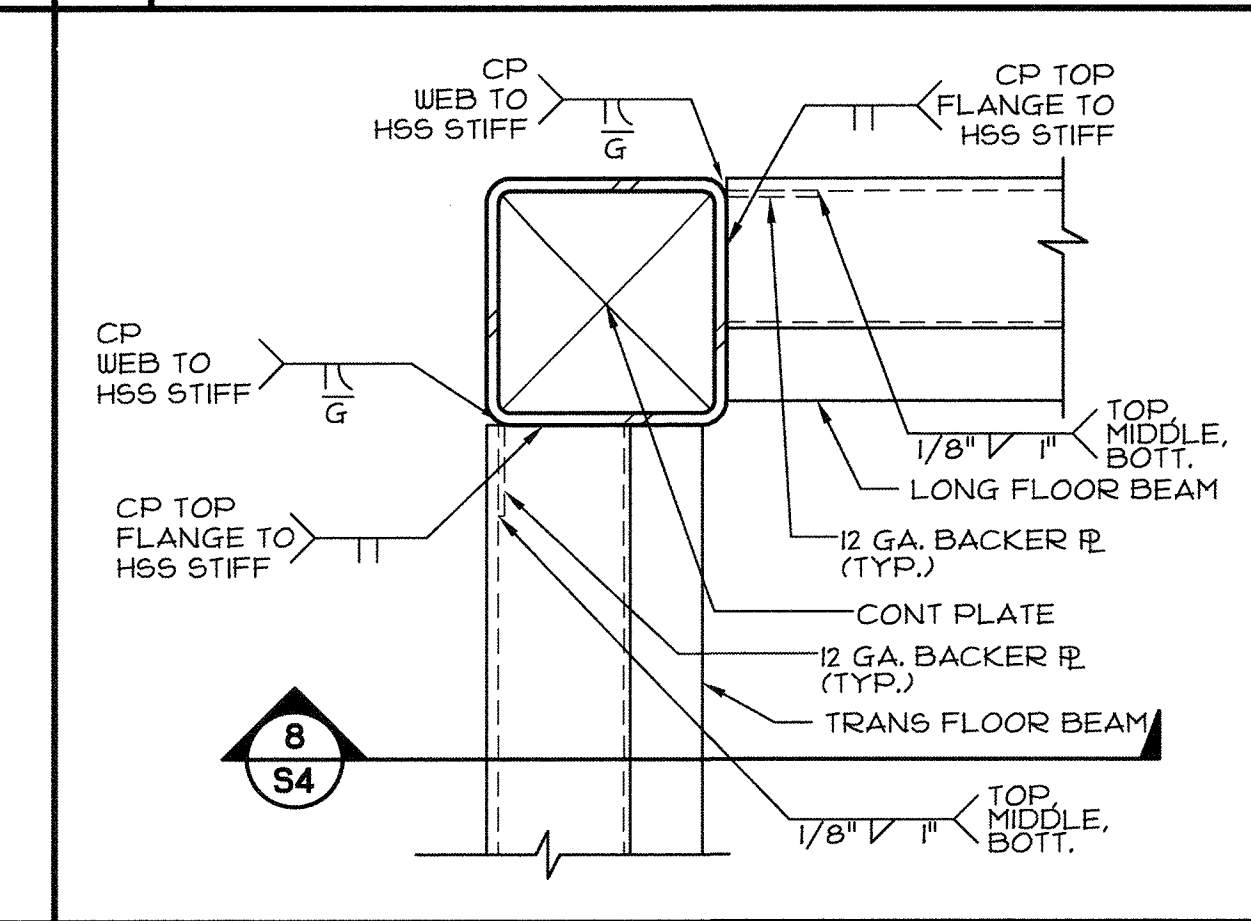


9 FLOOR BEAM TOP FLANGE  
SCALE: 3/4"=1'-0"

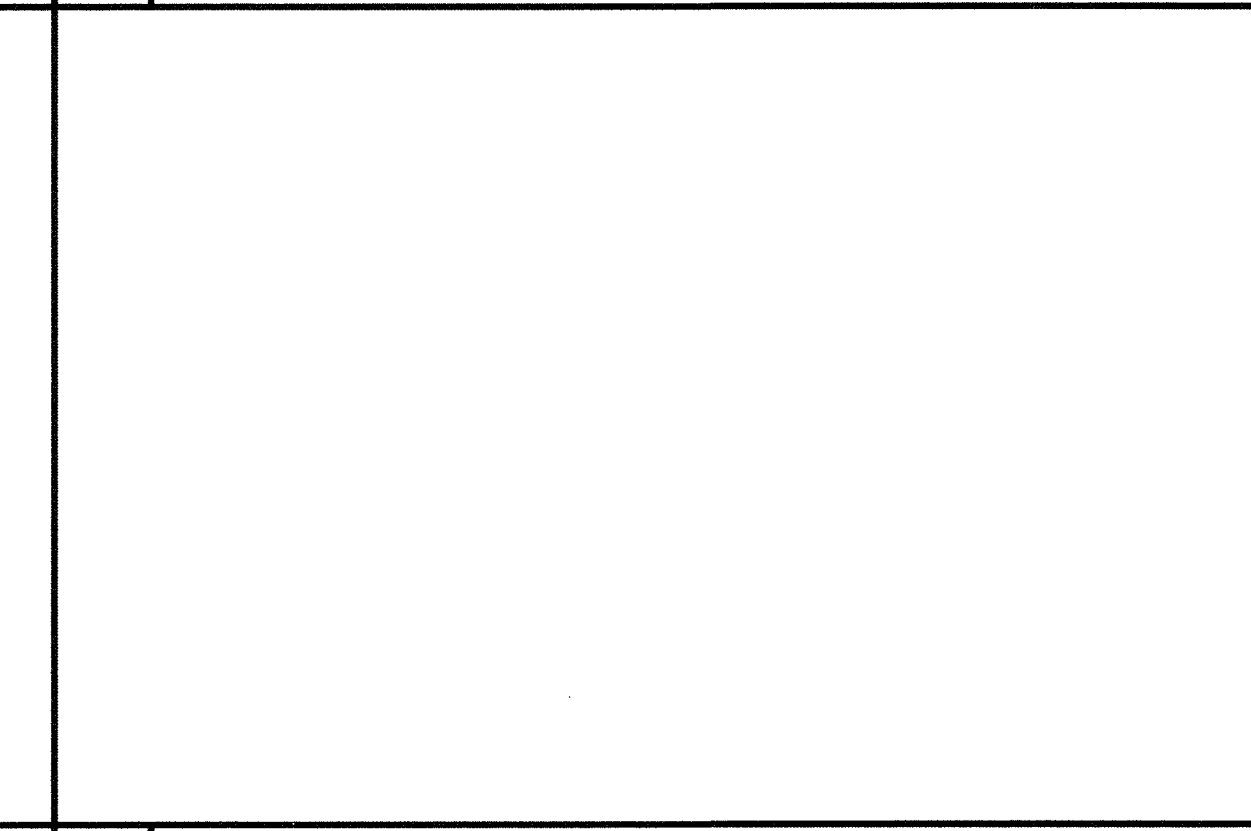


10 FLOOR BEAM BOTTOM FLANGE  
SCALE: 3/4"=1'-0"

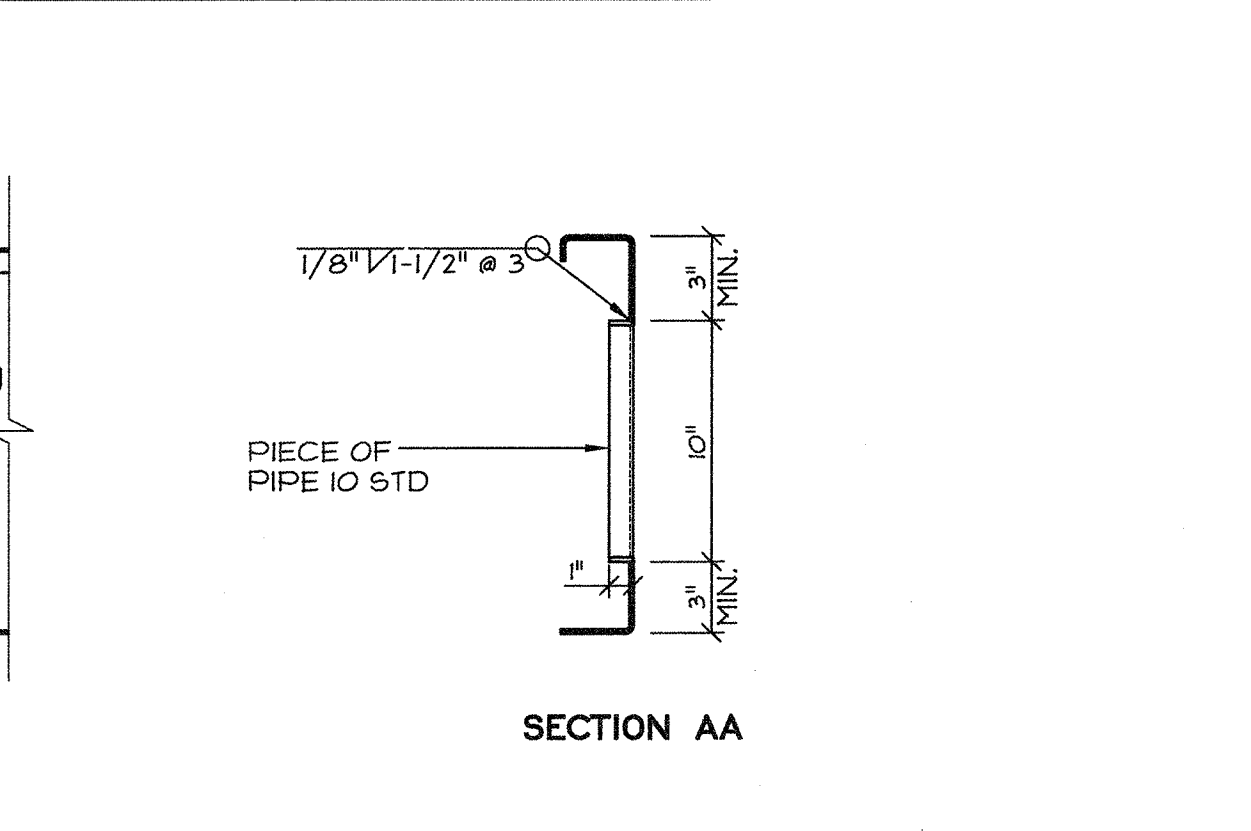


18 FLOOR JOIST PENETRATION  
SCALE: 3/4"=1'-0"

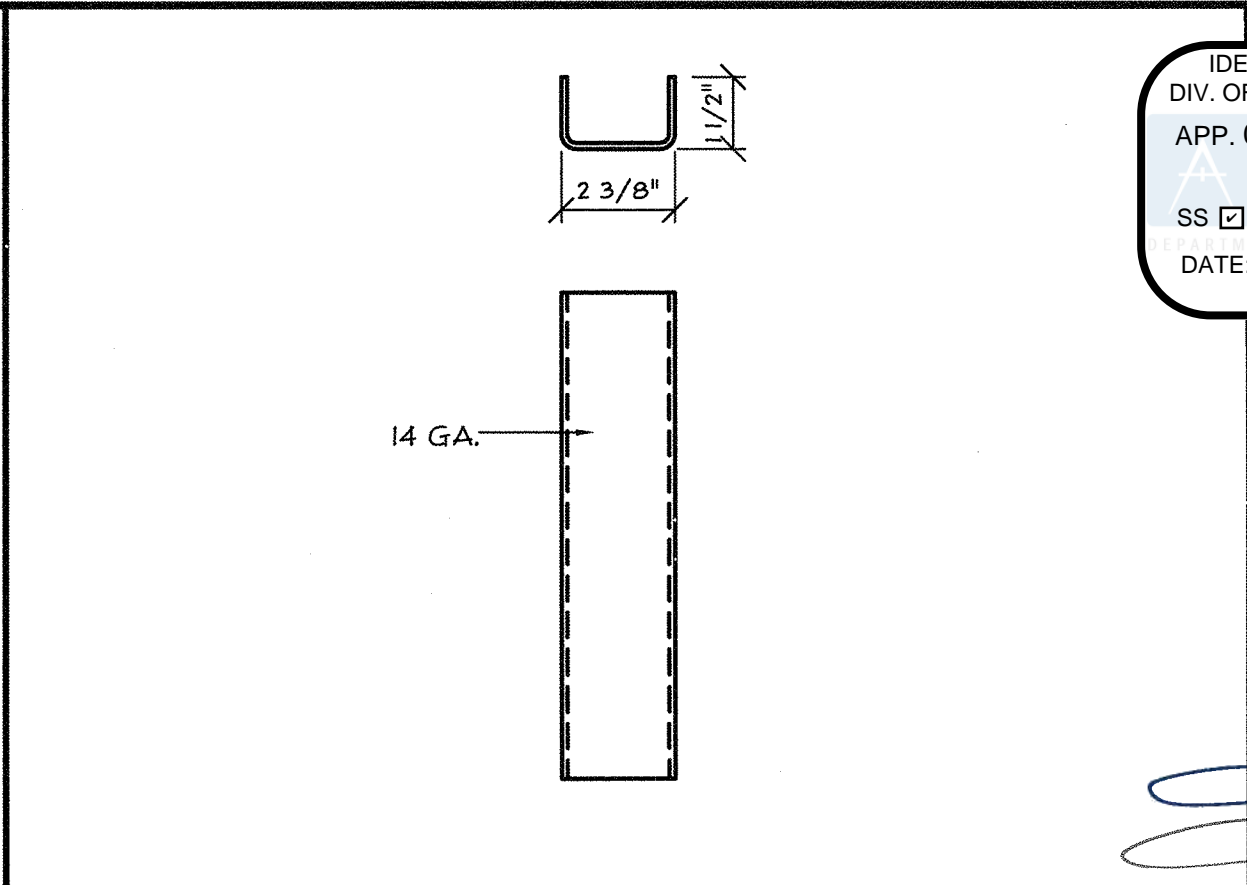


2.1 ROOF BEAM STIFF  
SCALE: 3/4"=1'-0"

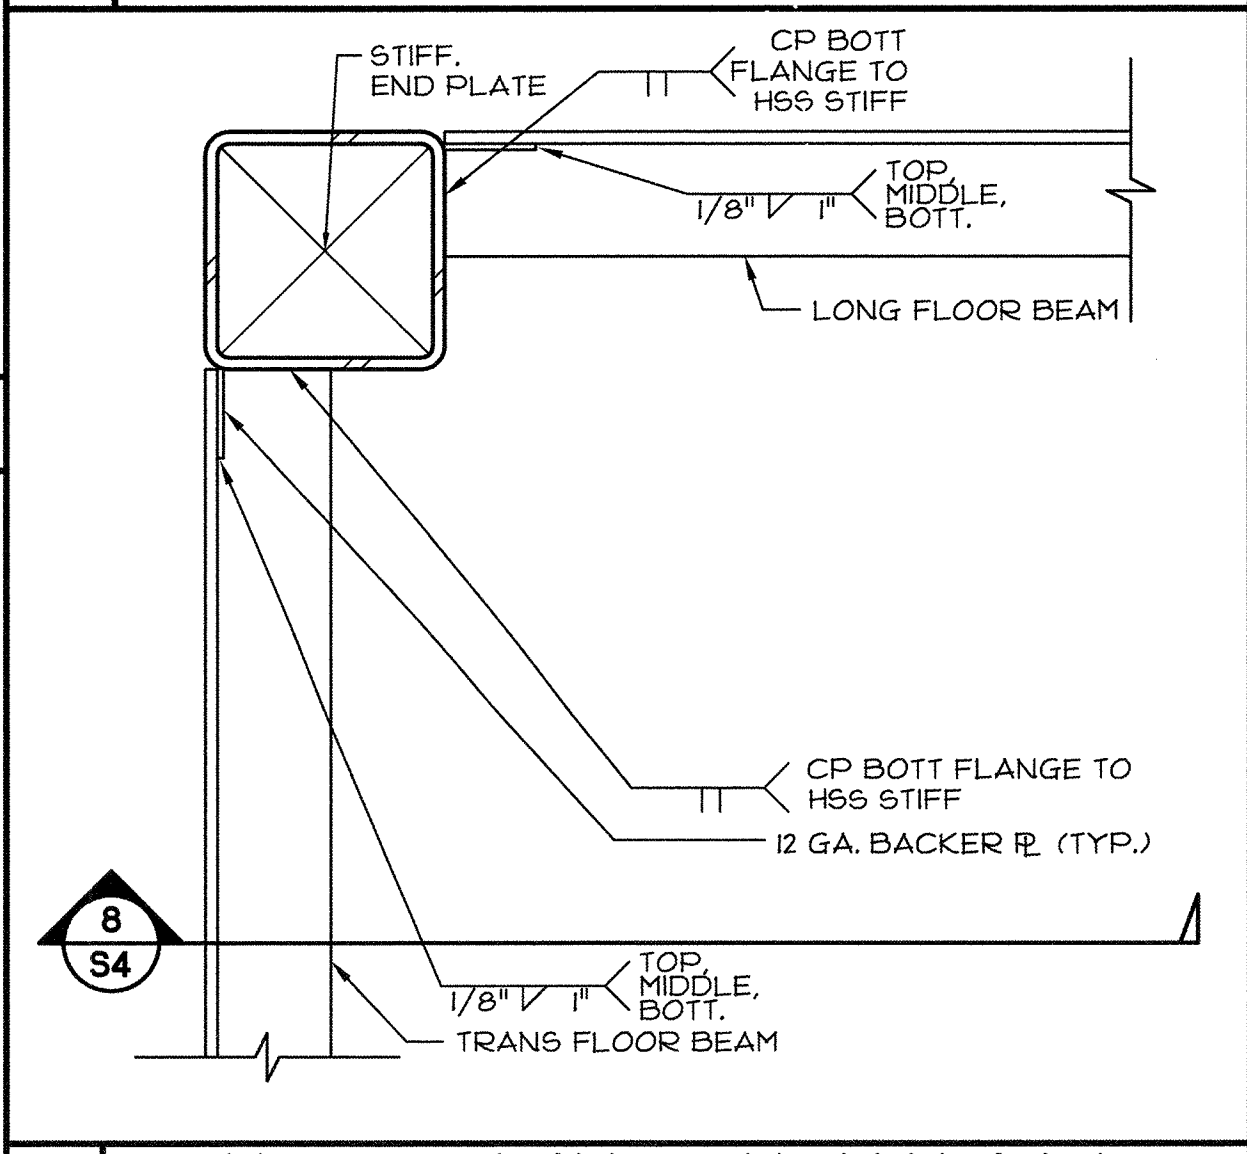


10 FLOOR BEAM BOTTOM FLANGE  
SCALE: 3/4"=1'-0"

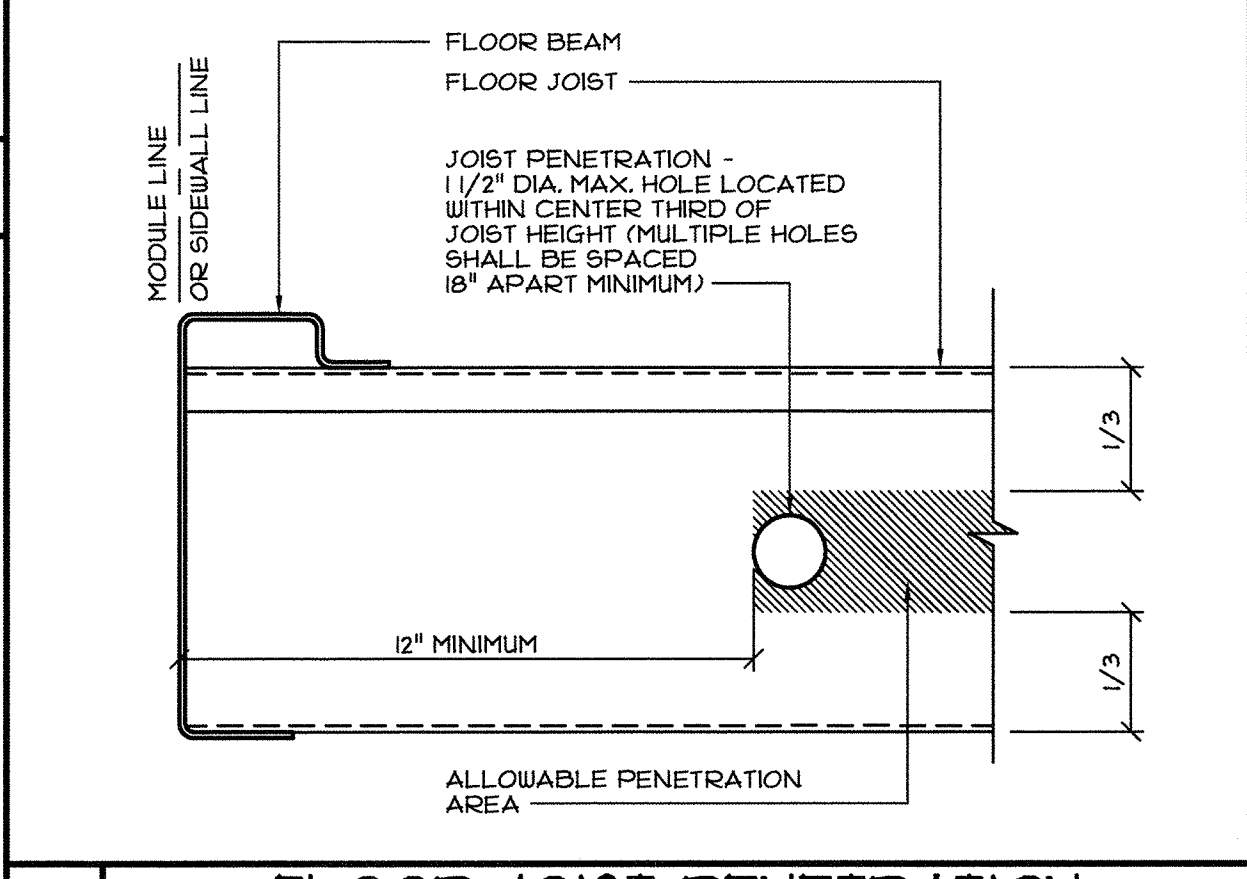

18 FLOOR JOIST PENETRATION  
SCALE: 3/4"=1'-0"

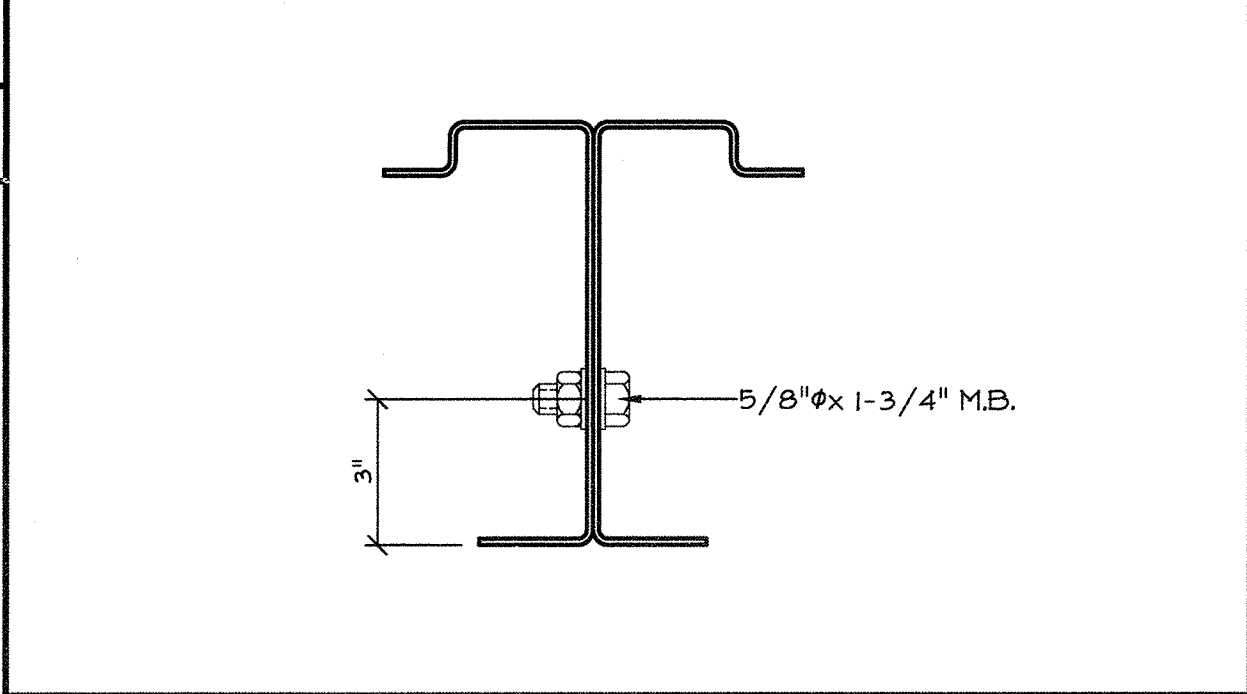

12 FLR BEAM CONNECTION @ MOD LINE  
SCALE: 3/4"=1'-0"

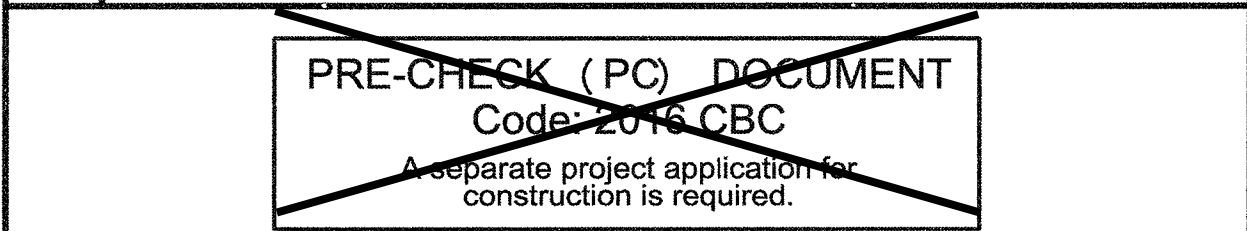

12 PRE-CHECK (PC) DOCUMENT  
Code: 2016 CBC

IDENTIFICATION STAMP  
DIV. OF THE STATE ARCHITECT  
APP. 02-118017 INC.  
REVIEWED FOR  
SS ☐ FLS ☐ ACS ☐  
DATE: 04/10/2020

03/26/2020

REGISTERED PROFESSIONAL ENGINEER  
No. 52030  
STATE OF CALIFORNIA

THESE DRAWINGS ARE PRELIMINARY  
AND NOT FOR CONSTRUCTION  
UNLESS STAMPED & SIGNED BY  
THE ENGINEER OF RECORD.

ENVIROPLEX, INC.  
4777 E. CARPENTER ROAD STOCKTON, CA 95215, (209) 466-8000  
CESAR CHAVEZ HIGH SCHOOL - ATHLETIC FACILITY  
STOCKTON UNIFIED SCHOOL DISTRICT  
2929 WINDFLOWER LANE STOCKTON, CA 95212

STRUCTURAL CONNECTION DETAILS

REV / DATE: BY:

JOB No.:  
DRAWN BY:  
DATE:



IDENTIFICATION STAMP  
DIVISION OF THE STATE ARCHITECT  
02-07-16084  
AC ☐ FLS ☒ ACS ☒  
DATE: 9-6-2018

S4









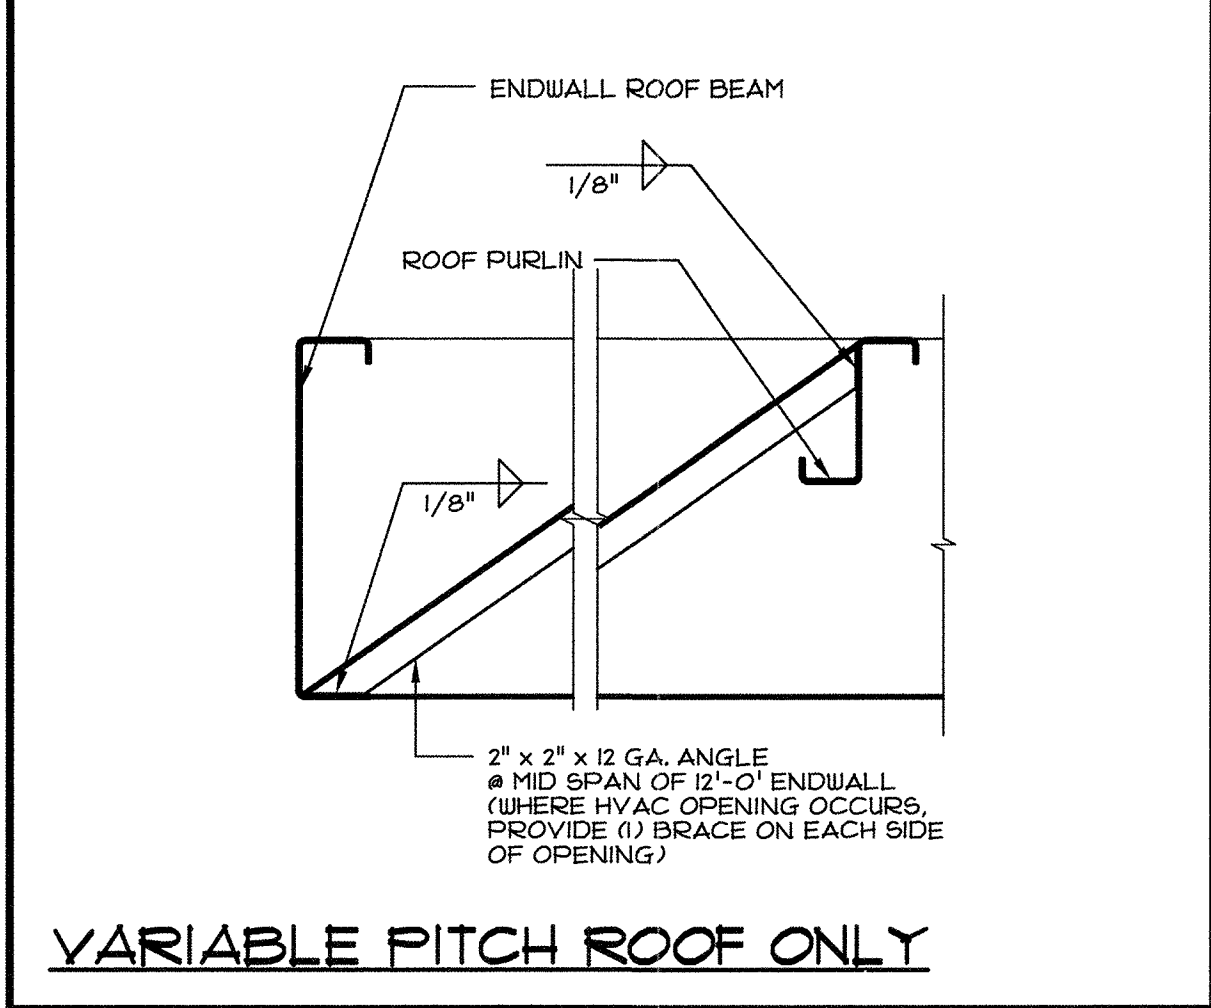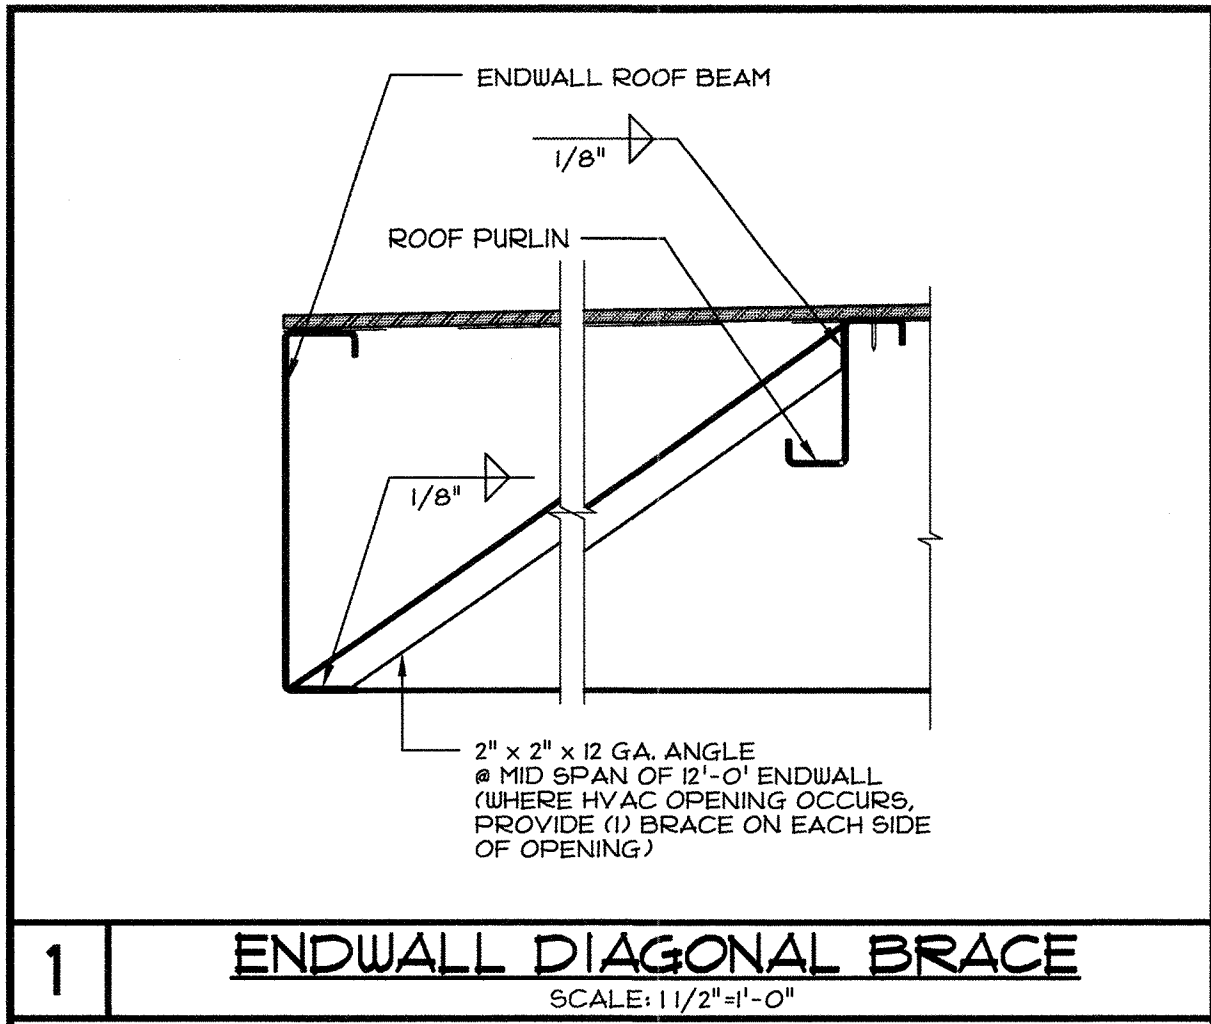


1 ENDWALL DIAGONAL BRACE  
SCALE: 1 1/2"=1'-0"

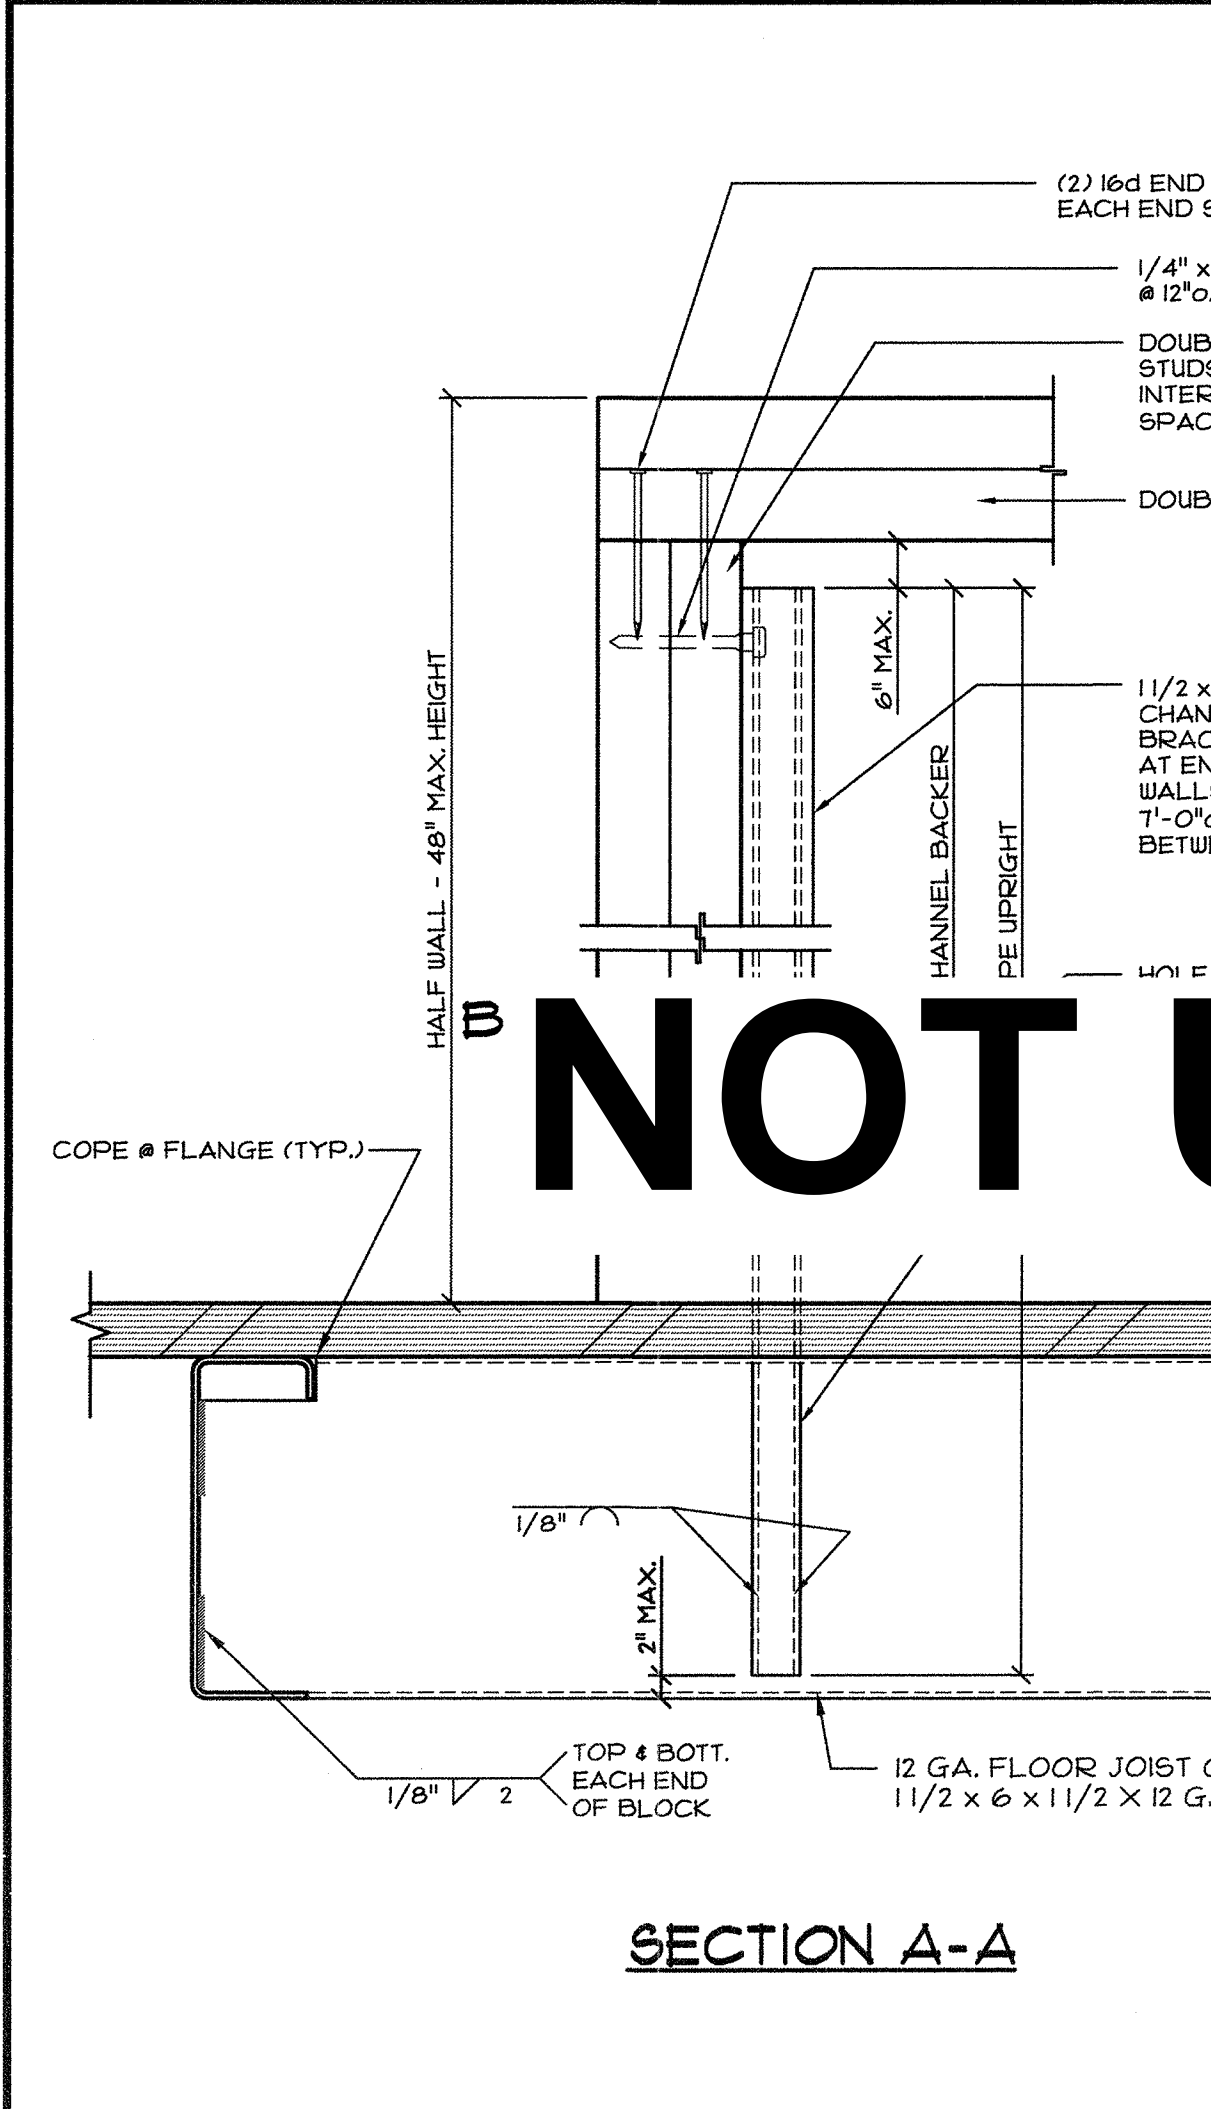


2 DOUBLE BOTTOM PLATE OPTION  
SCALE: 3"=1'-0"

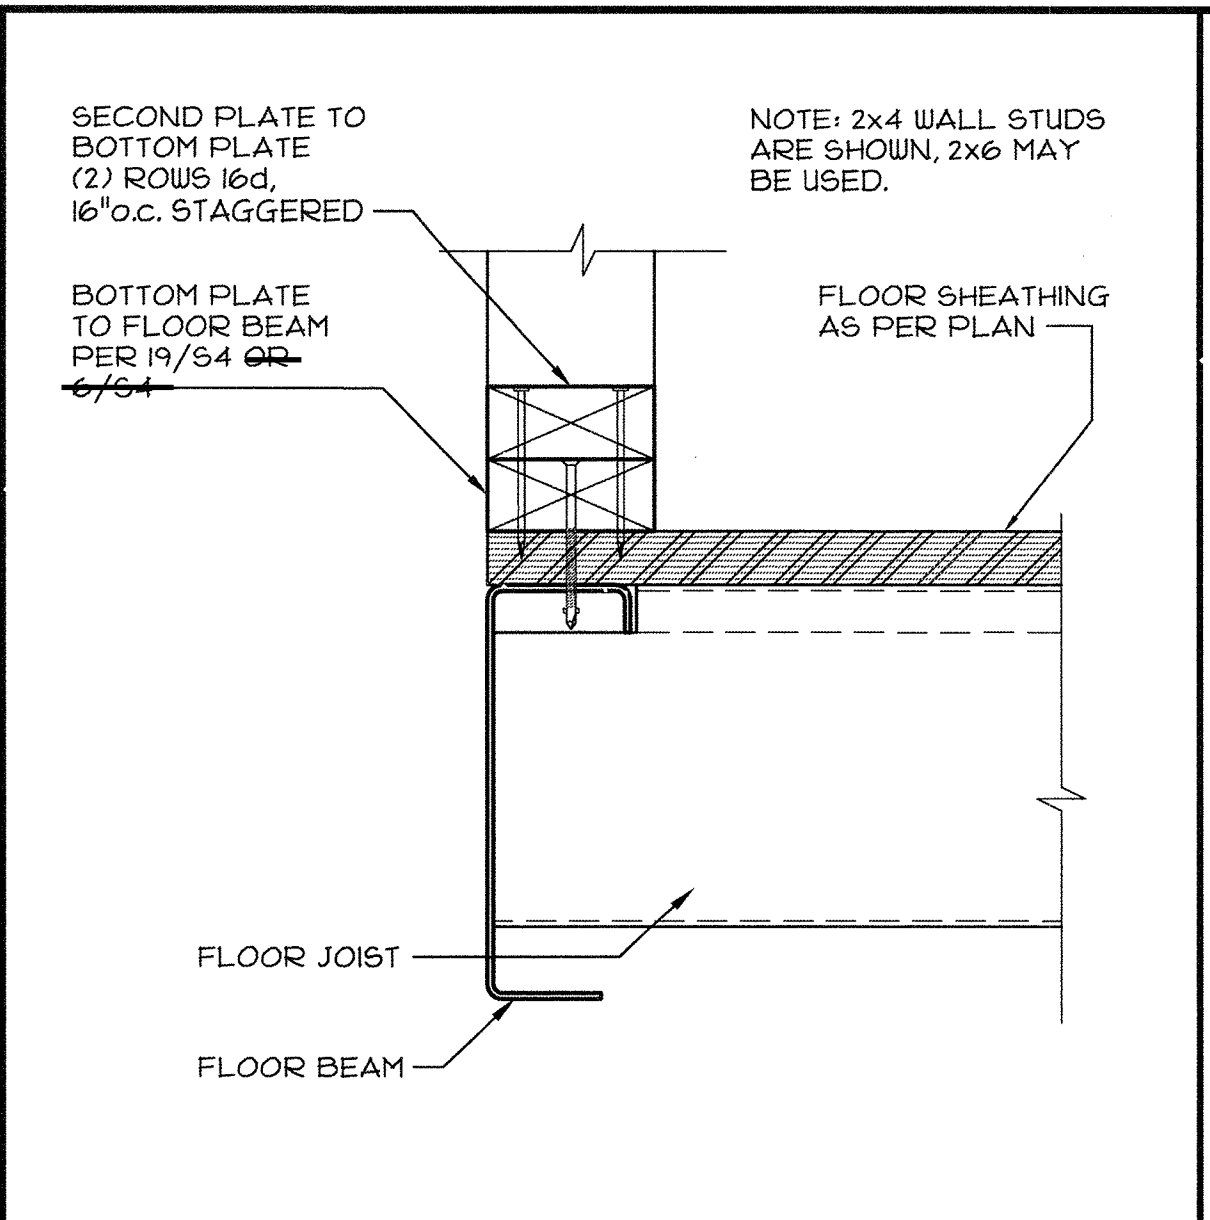


3 TRIPLE BOTTOM PLATE OPTION  
SCALE: 3"=1'-0"

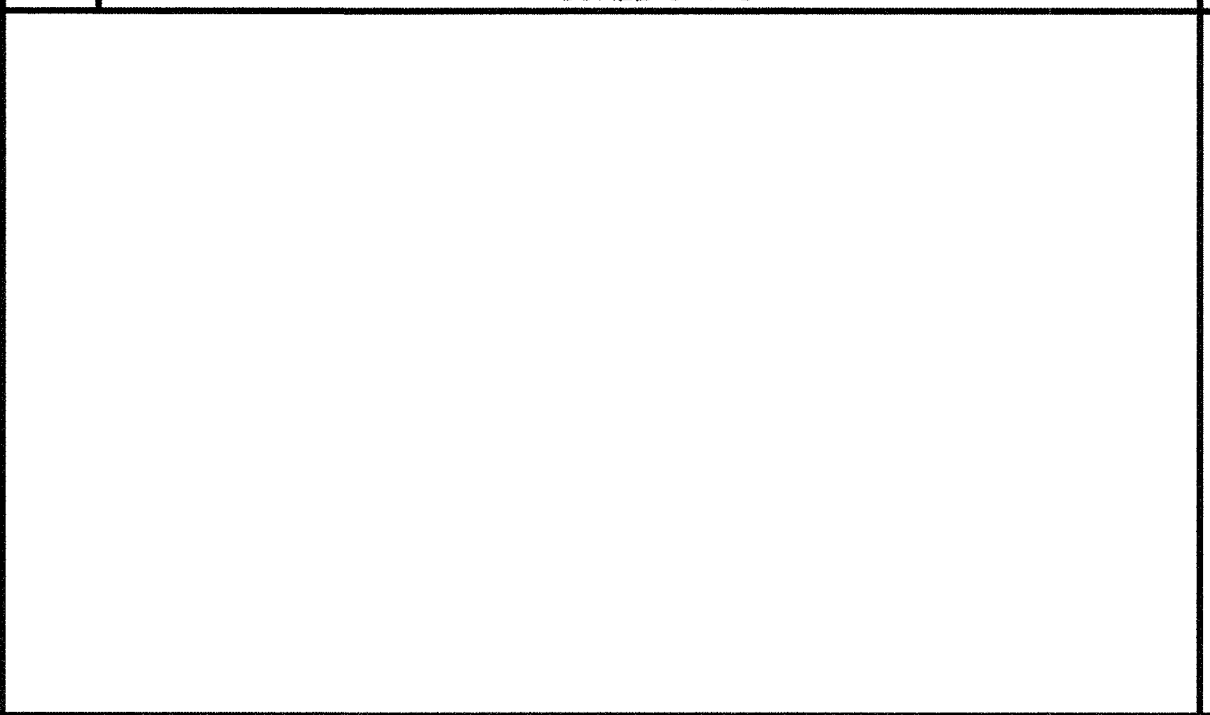


4 HAND ACCESS HOLE - PLYWOOD  
SCALE: 3"=1'-0"

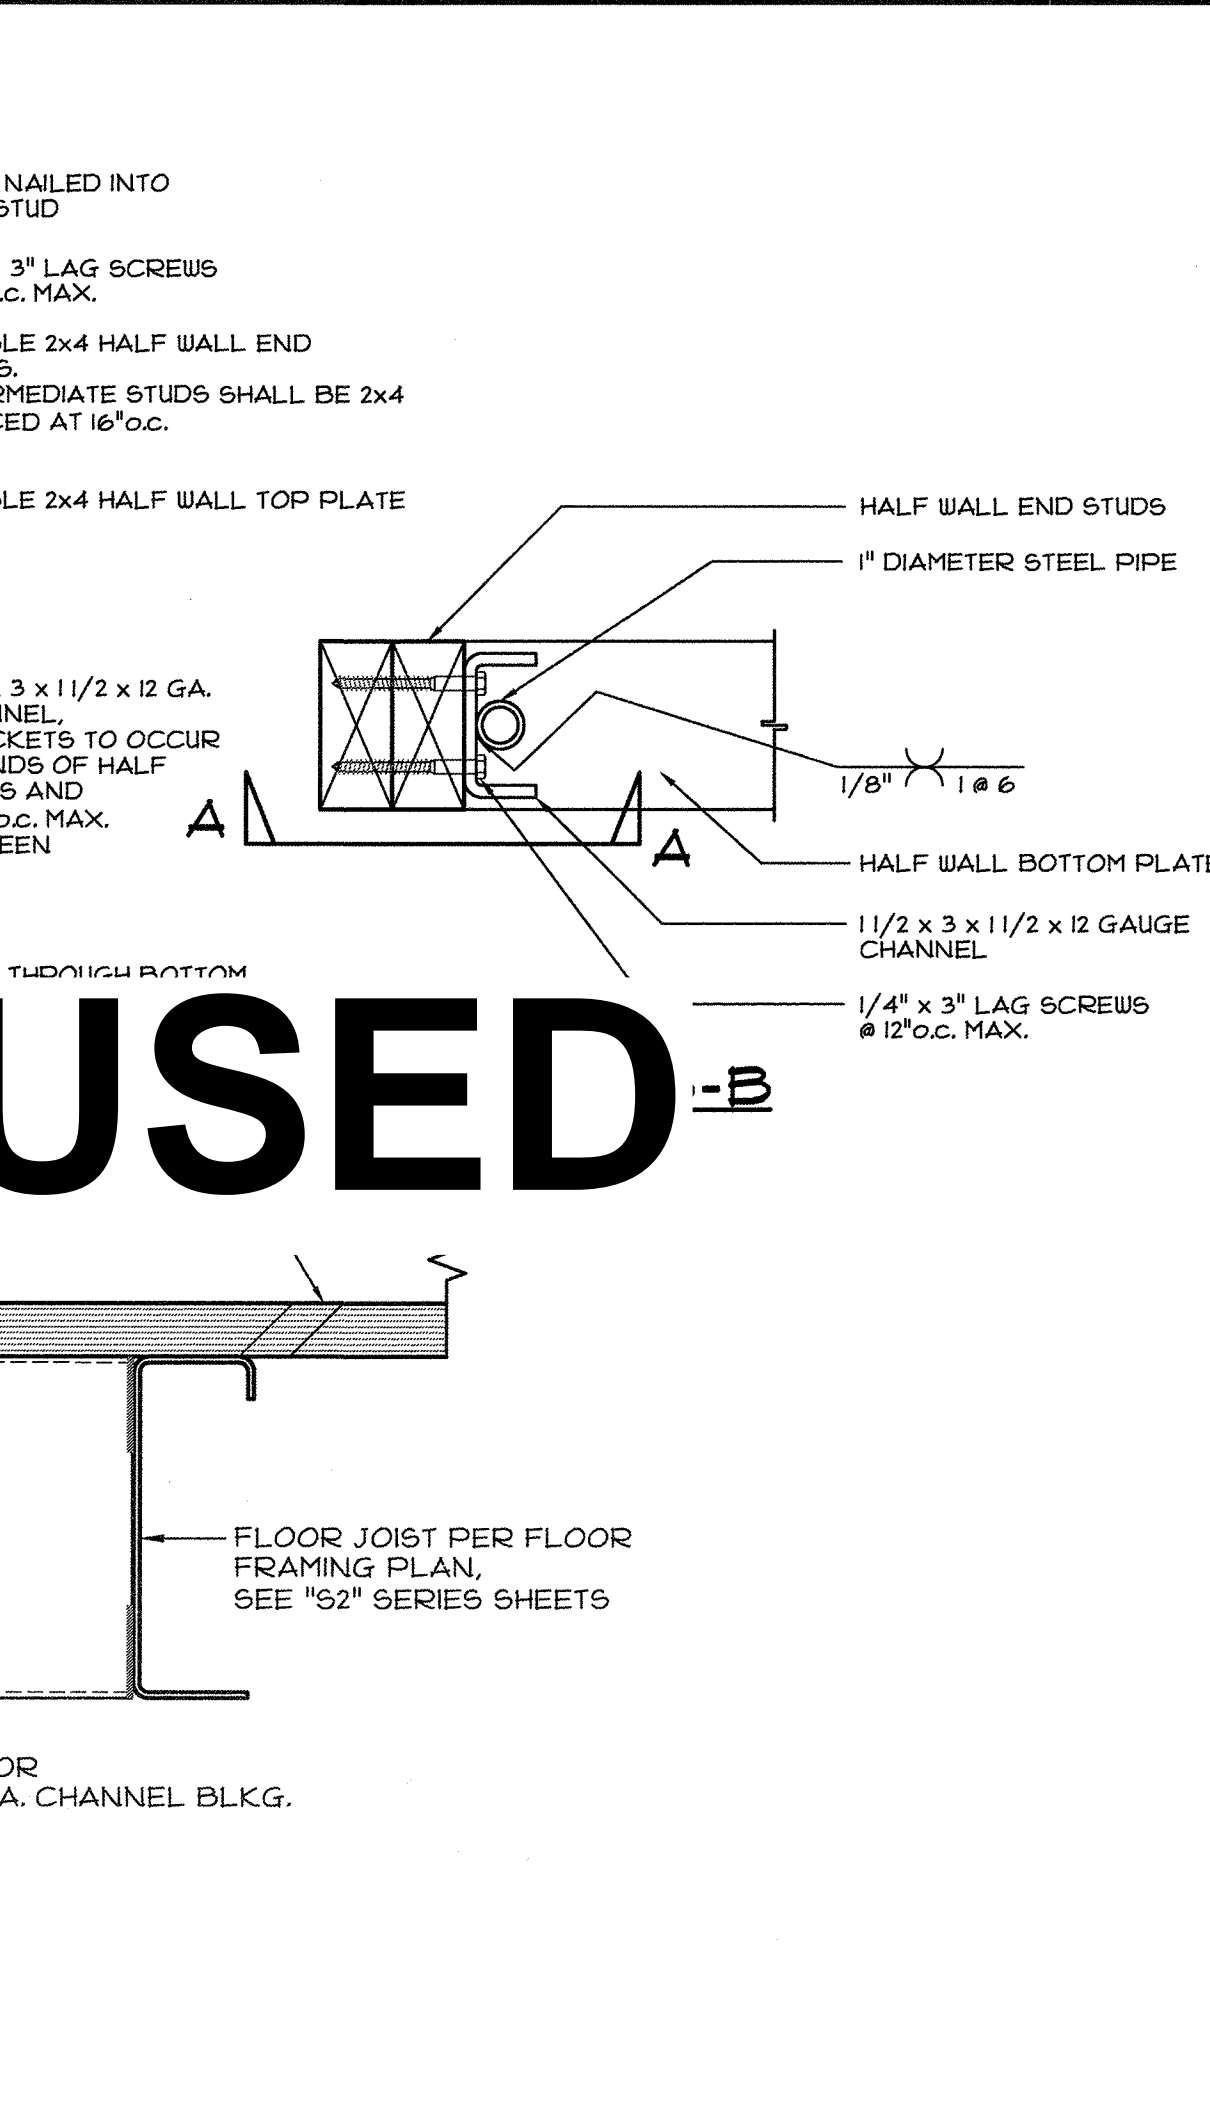


5 HAND ACCESS HOLE - CONCRETE  
SCALE: 3"=1'-0"

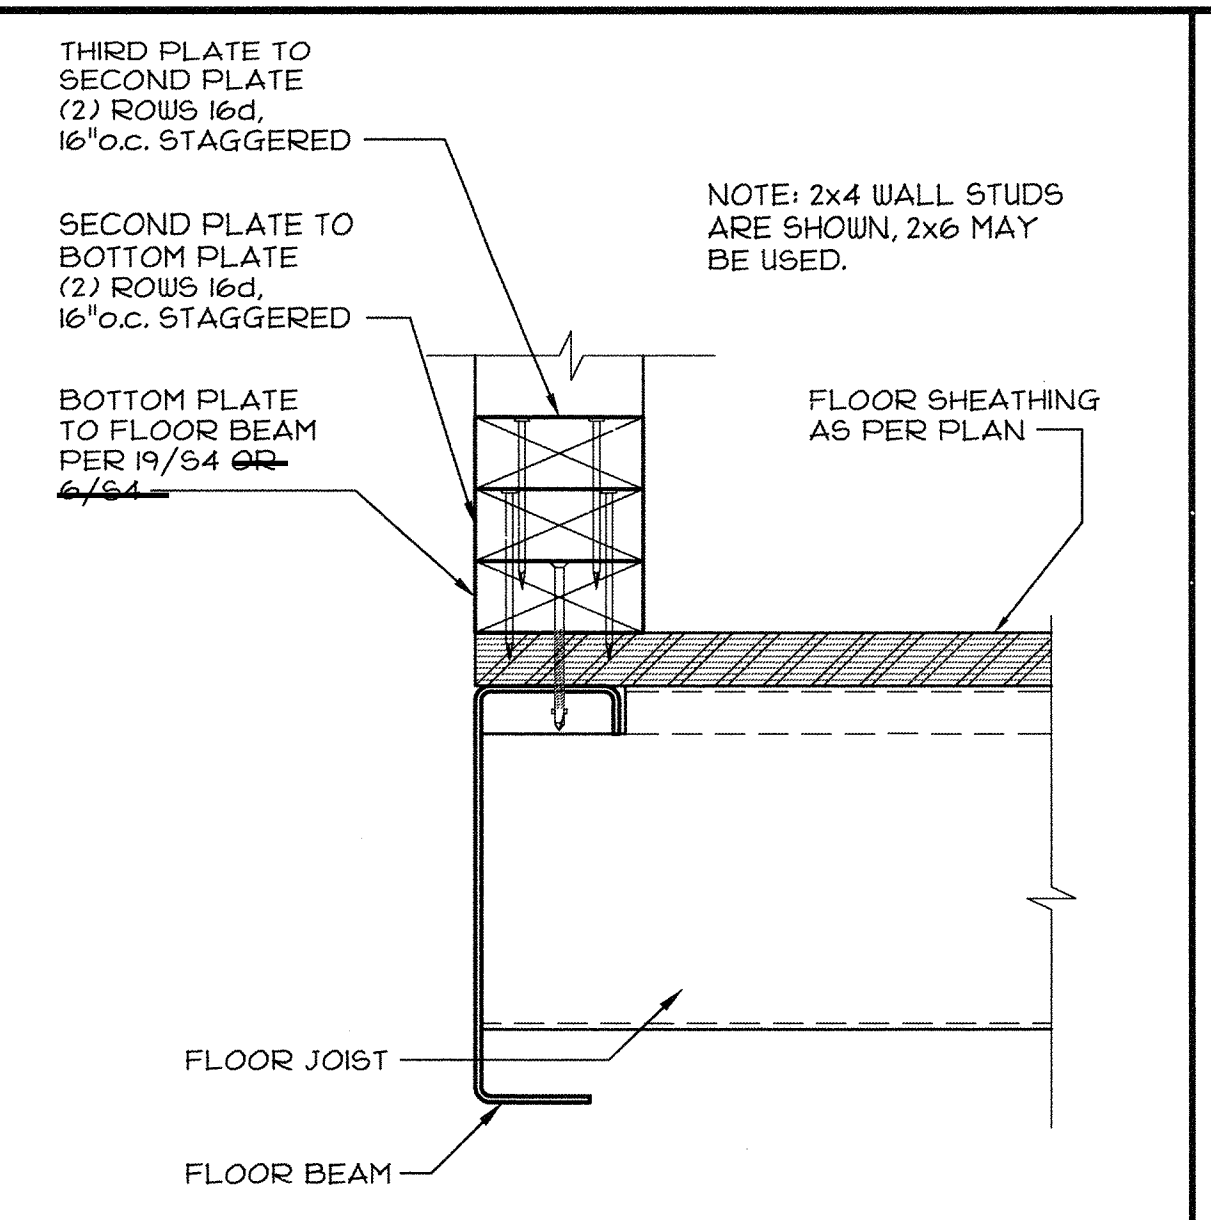


6 ENDWALL DIAGONAL BRACE  
SCALE: 1 1/2"=1'-0"

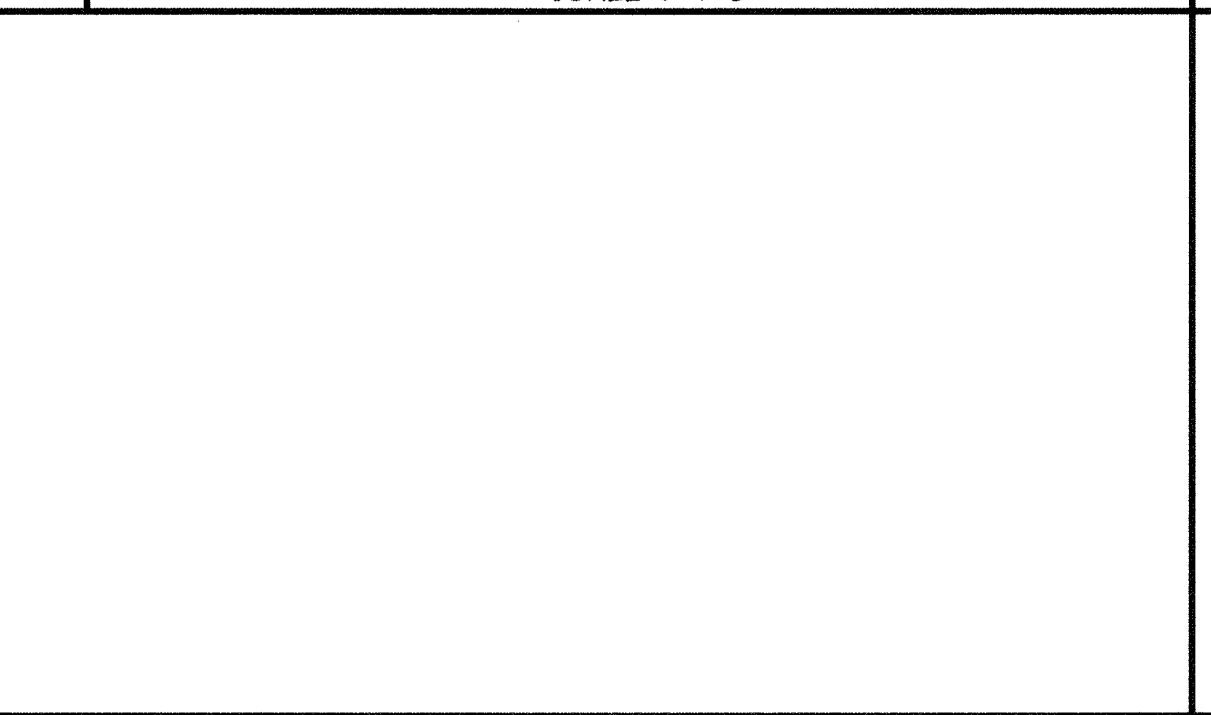


7 HALF WALL STABILIZER BRACKET - PLYWOOD FLOORS  
SCALE: 3"=1'-0"

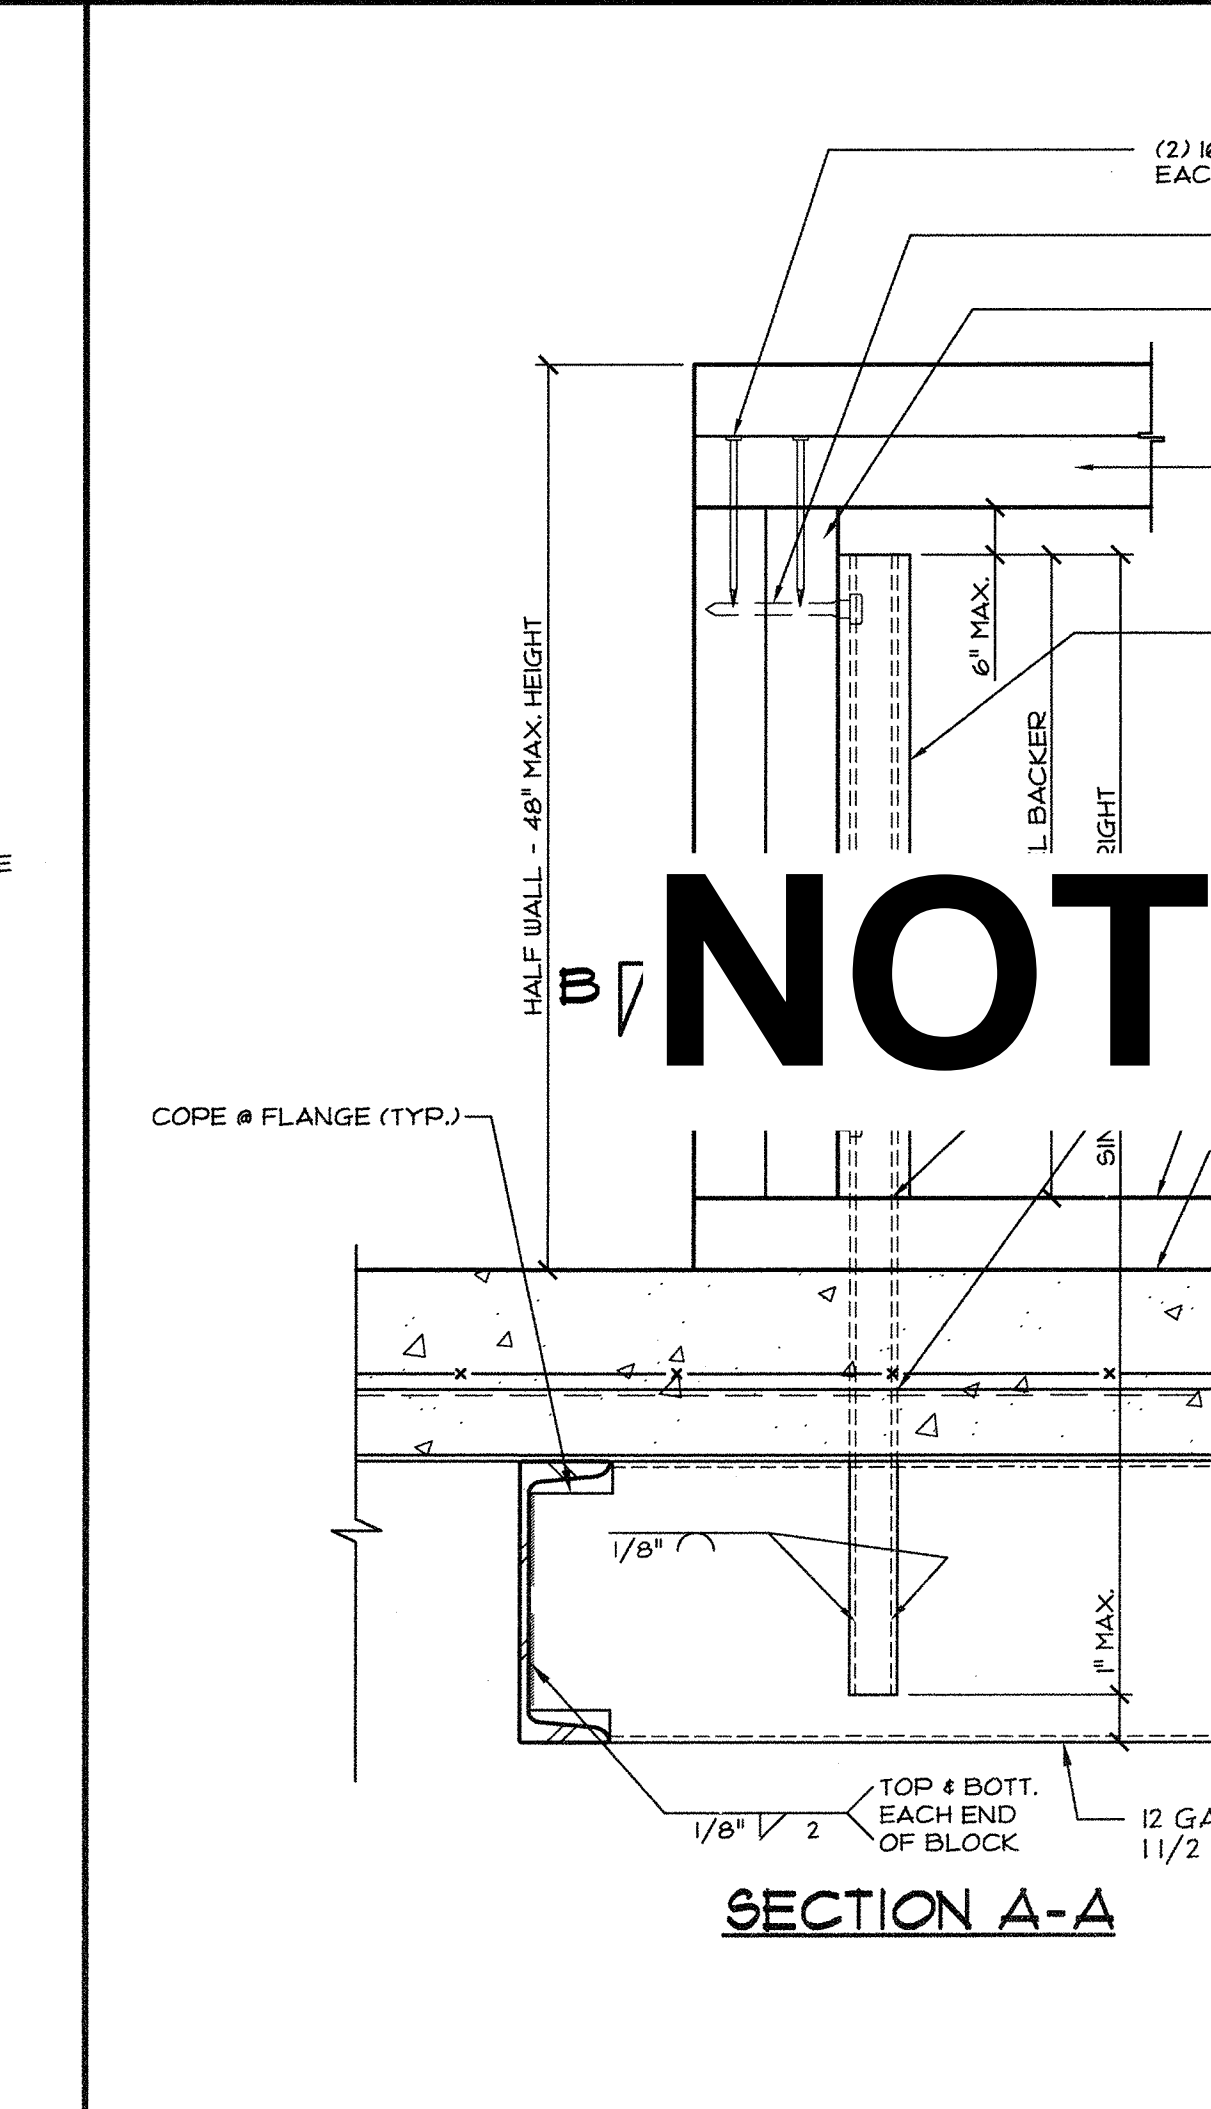


8 HALF WALL STABILIZER BRACKET - CONCRETE FLOORS  
SCALE: 3"=1'-0"

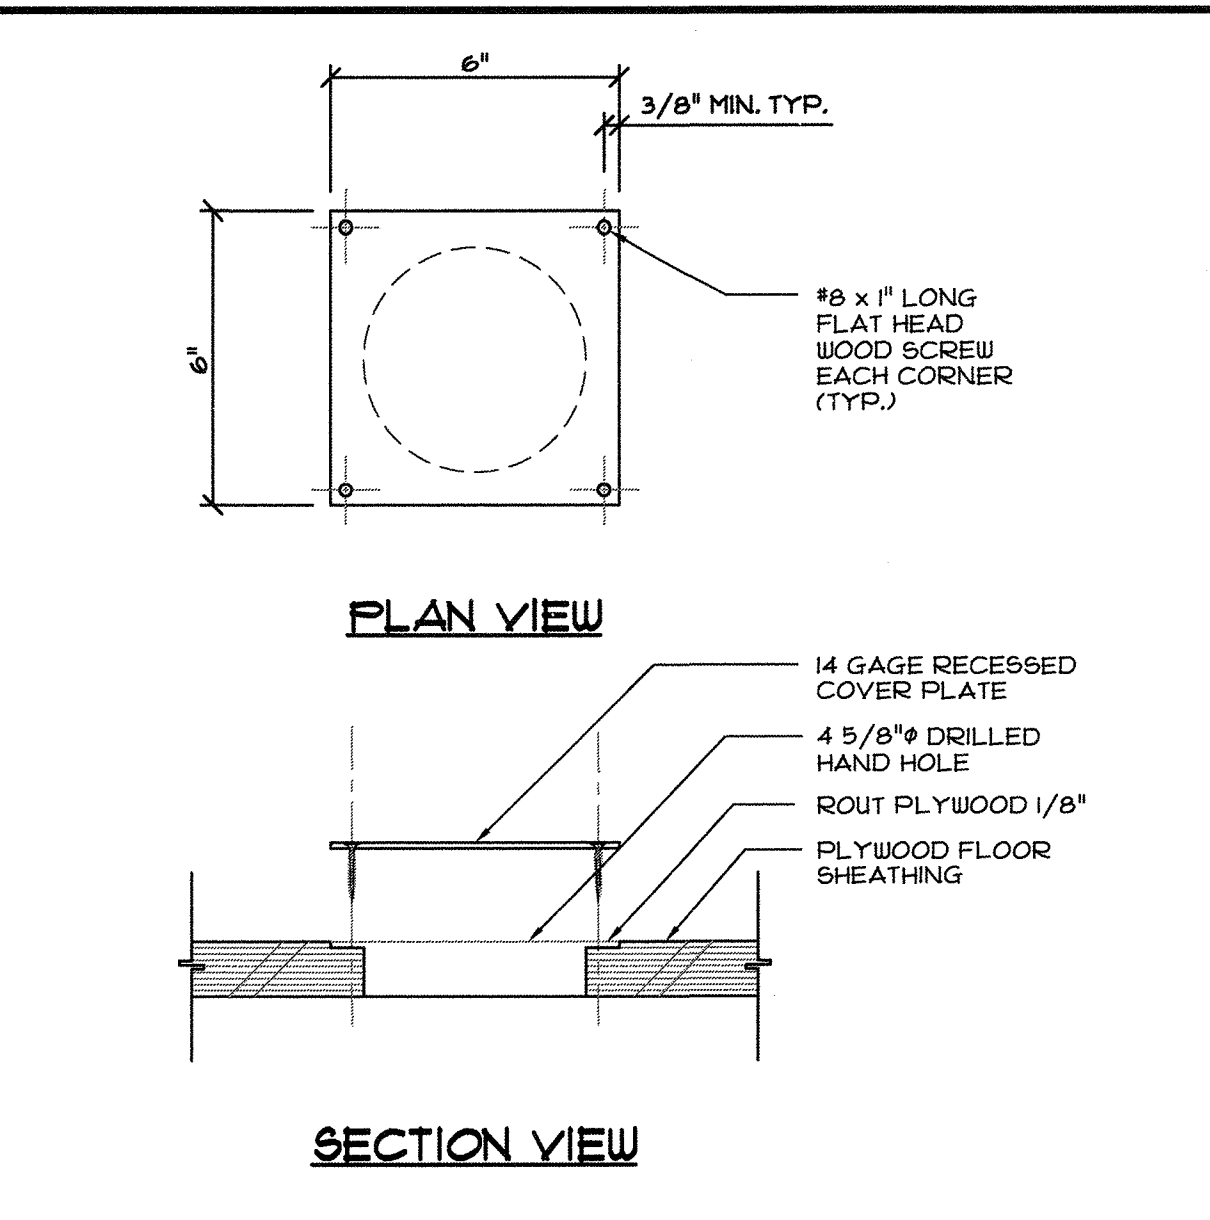


9 HALF WALL STABILIZER BRACKET - PLYWOOD FLOORS  
SCALE: 3"=1'-0"

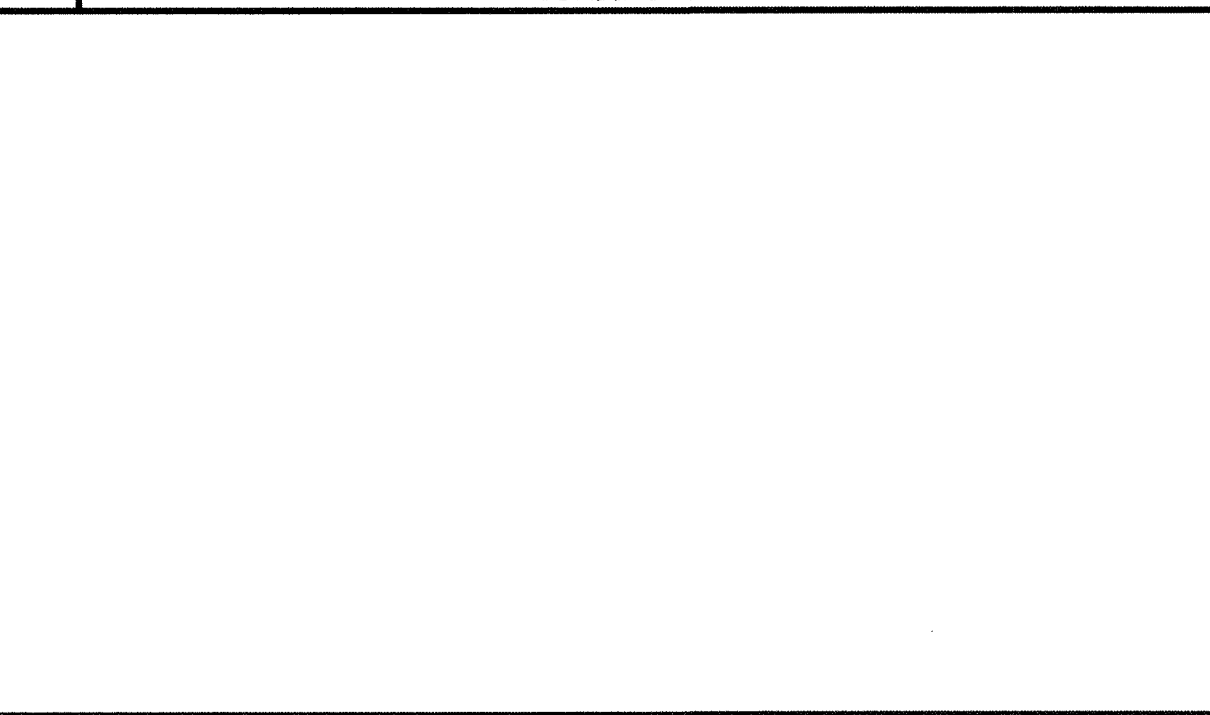

10 HALF WALL STABILIZER BRACKET - CONCRETE FLOORS  
SCALE: 3"=1'-0"

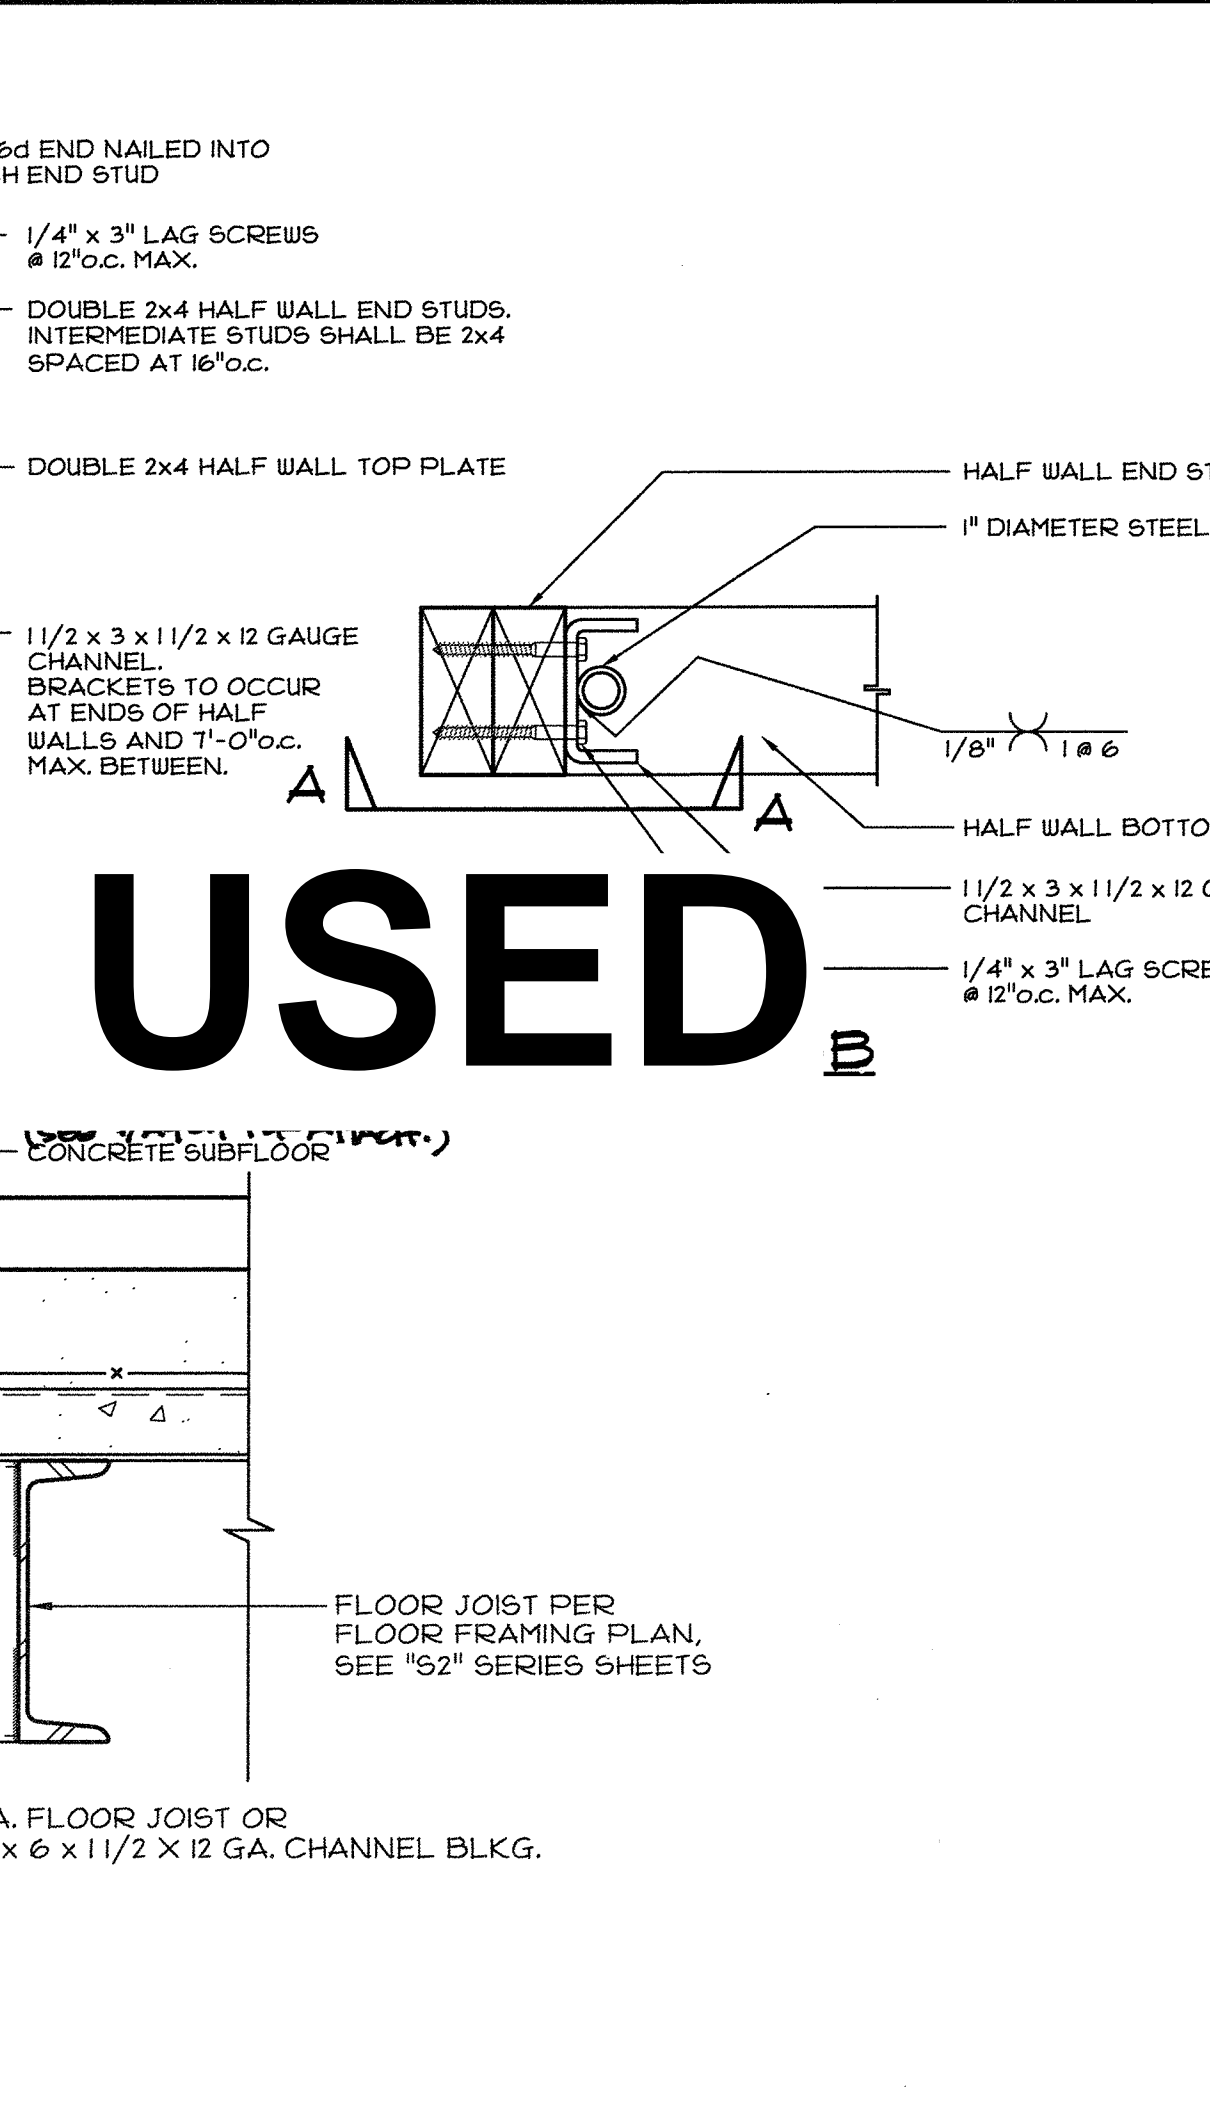


11 HALF WALL STABILIZER BRACKET - PLYWOOD FLOORS  
SCALE: 3"=1'-0"

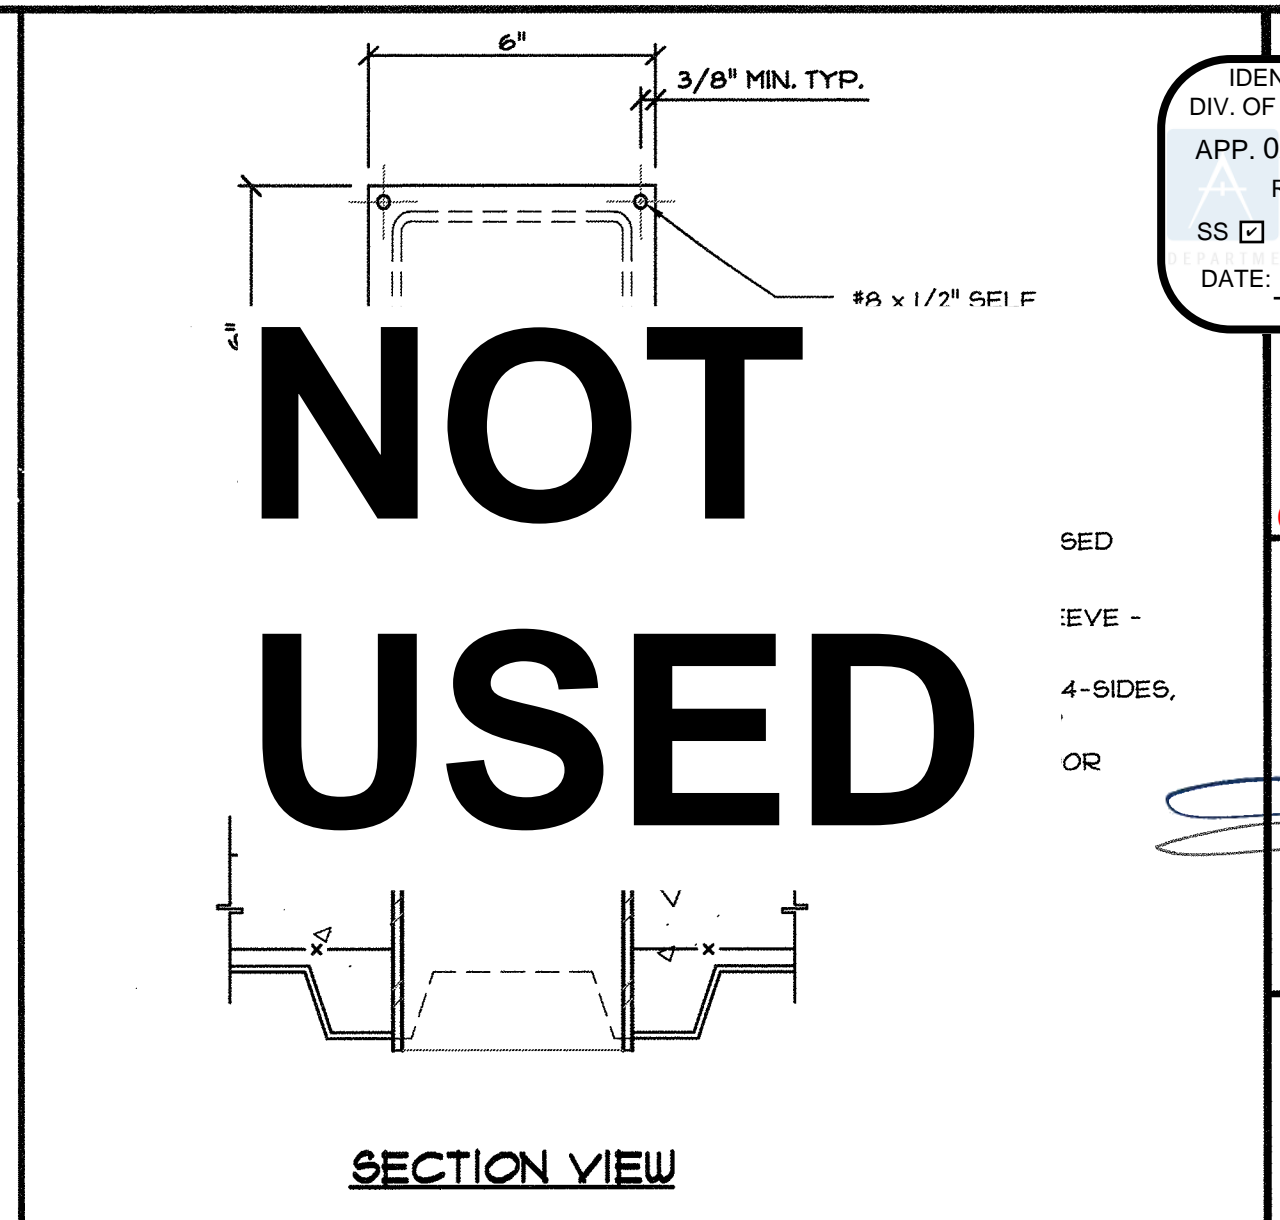

12 HALF WALL STABILIZER BRACKET - CONCRETE FLOORS  
SCALE: 3"=1'-0"



13 HALF WALL STABILIZER BRACKET - PLYWOOD FLOORS  
SCALE: 3"=1'-0"

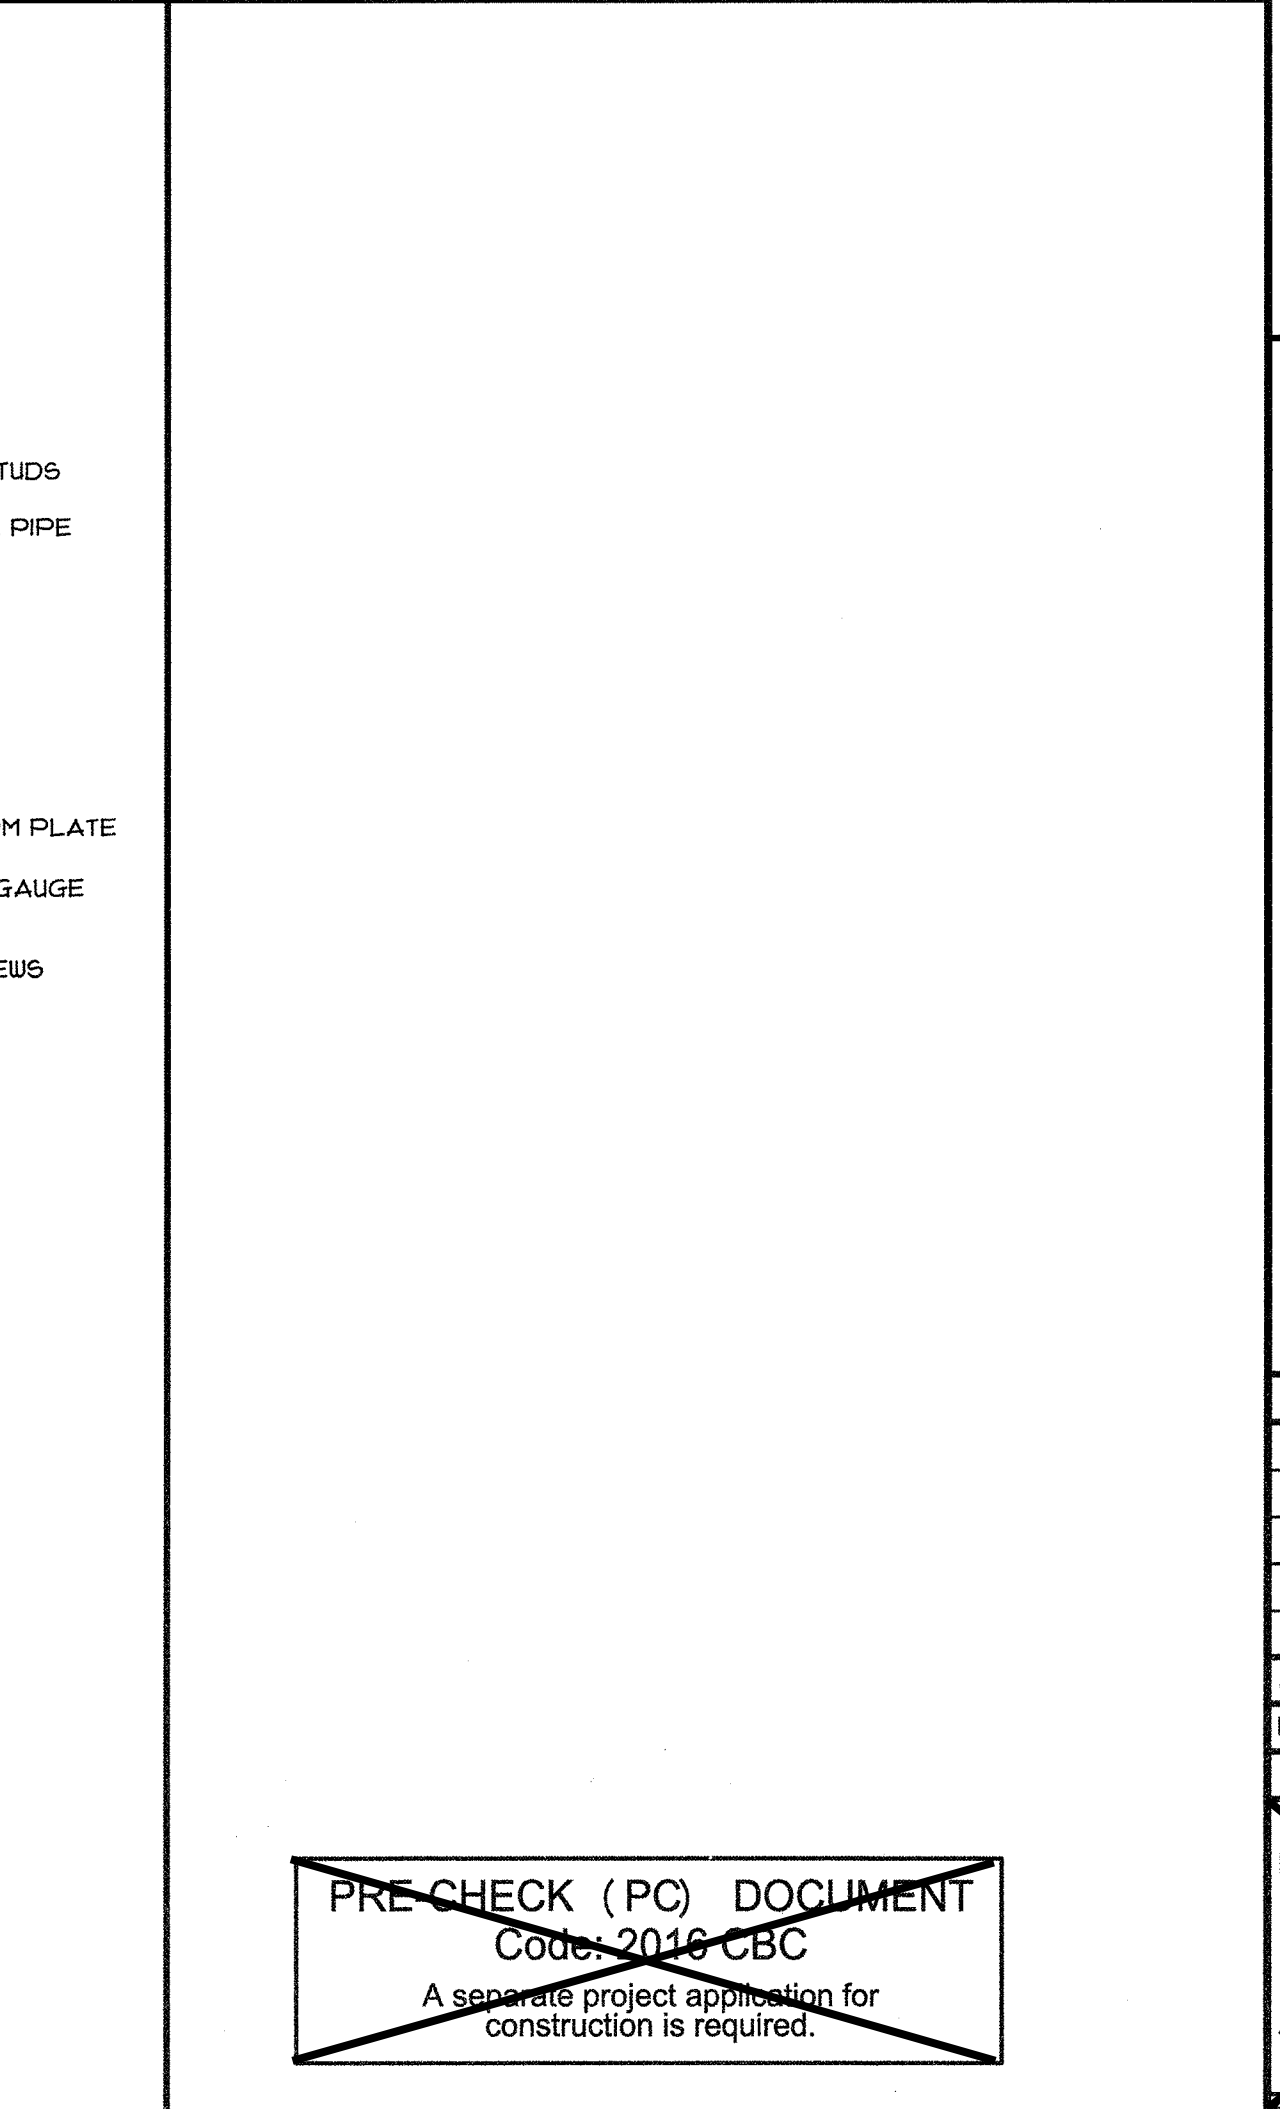

14 HALF WALL STABILIZER BRACKET - CONCRETE FLOORS  
SCALE: 3"=1'-0"

IDENTIFICATION STAMP  
DIV. OF THE STATE ARCHITECT  
APP. 02-118017 INC.  
REVIEWED FOR  
SS ☐ FLS ☐ ACS ☐  
DATE: 04/10/2020

03/26/2020

REGISTERED PROFESSIONAL ENGINEER  
ENVIROPLEX, INC.  
No. 82030  
STATE OF CALIFORNIA  
THESE DRAWINGS ARE PRELIMINARY  
AND NOT FOR CONSTRUCTION  
UNLESS STAMPED & SIGNED BY  
THE ENGINEER OF RECORD.

ENVIROPLEX, INC.  
4777 E. CARPENTER ROAD STOCKTON, CA. 95215, (209) 468-8000  
CESAR CHAVEZ HIGH SCHOOL - ATHLETIC FACILITY  
STOCKTON UNIFIED SCHOOL DISTRICT  
2929 WINDFLOWER LANE STOCKTON, CA 95212

ALTERNATE STRUCTURAL  
DETAILS







REVISION DATE: BY:  
JOB No.:  
DRAWN BY:  
DATE:  
IDENTIFICATION STAMP  
DIVISION OF THE STATE ARCHITECT  
02-118094  
AC ☐ FLS ☐ SS ☐  
DATE 9-6-2018  
R001 - 2018

PRE-CHECK (PC) DOCUMENT  
Code: 2016-CBC  
A separate project application for  
construction is required.

CONFIDENTIAL MATERIAL—THESE DOCUMENTS ARE THE PROPERTY OF AND ARE NOT TO BE REPRODUCED  
OR DISTRIBUTED WITHOUT FULL KNOWLEDGE AND WRITTEN CONSENT FROM ENVIROPLEX, INC.  
© COPYRIGHT ENVIROPLEX, INC. (ALL DRAWINGS PREPARED BY ENVIROPLEX, INC.)

S4.2



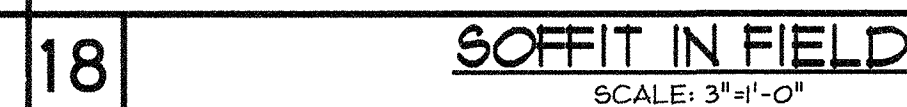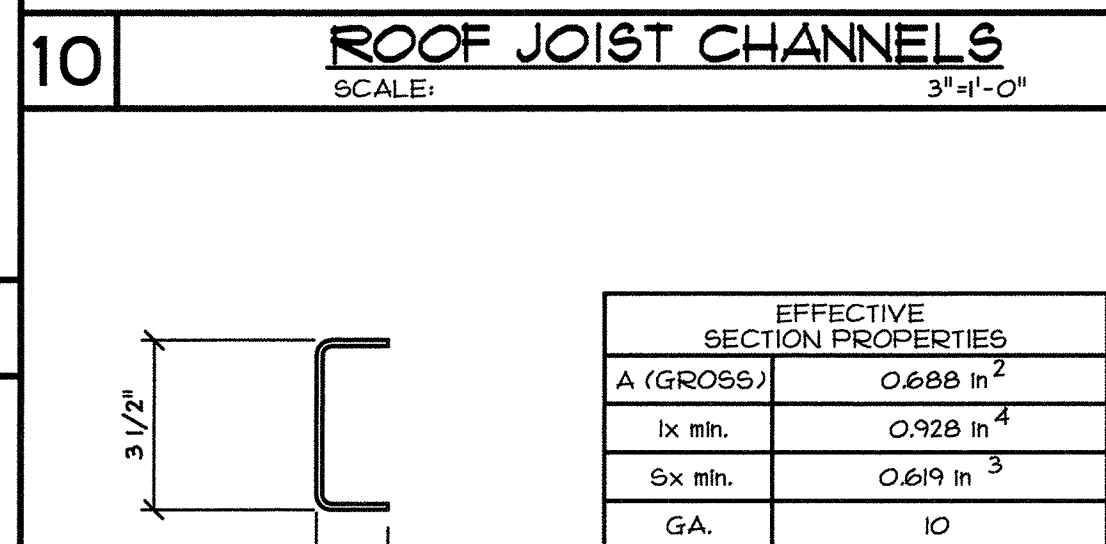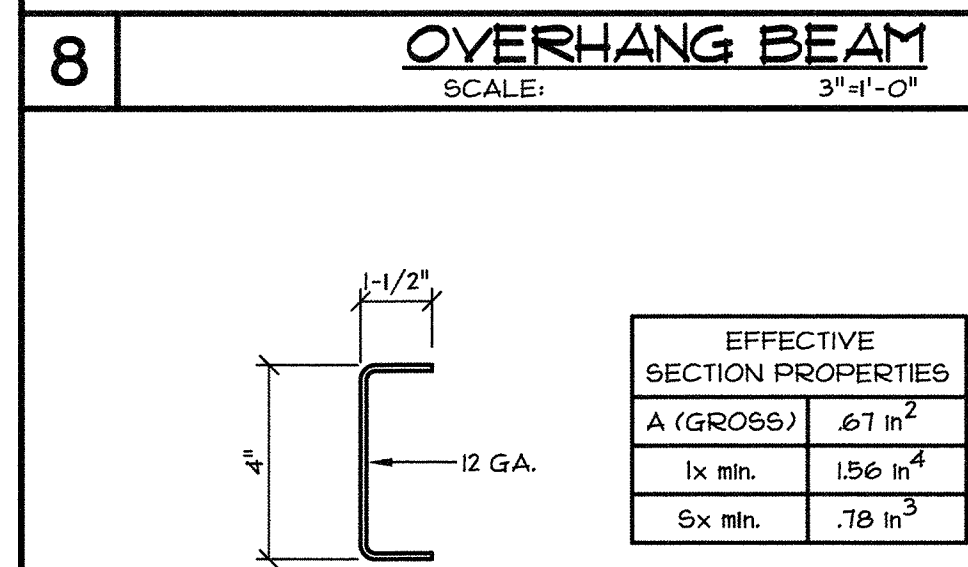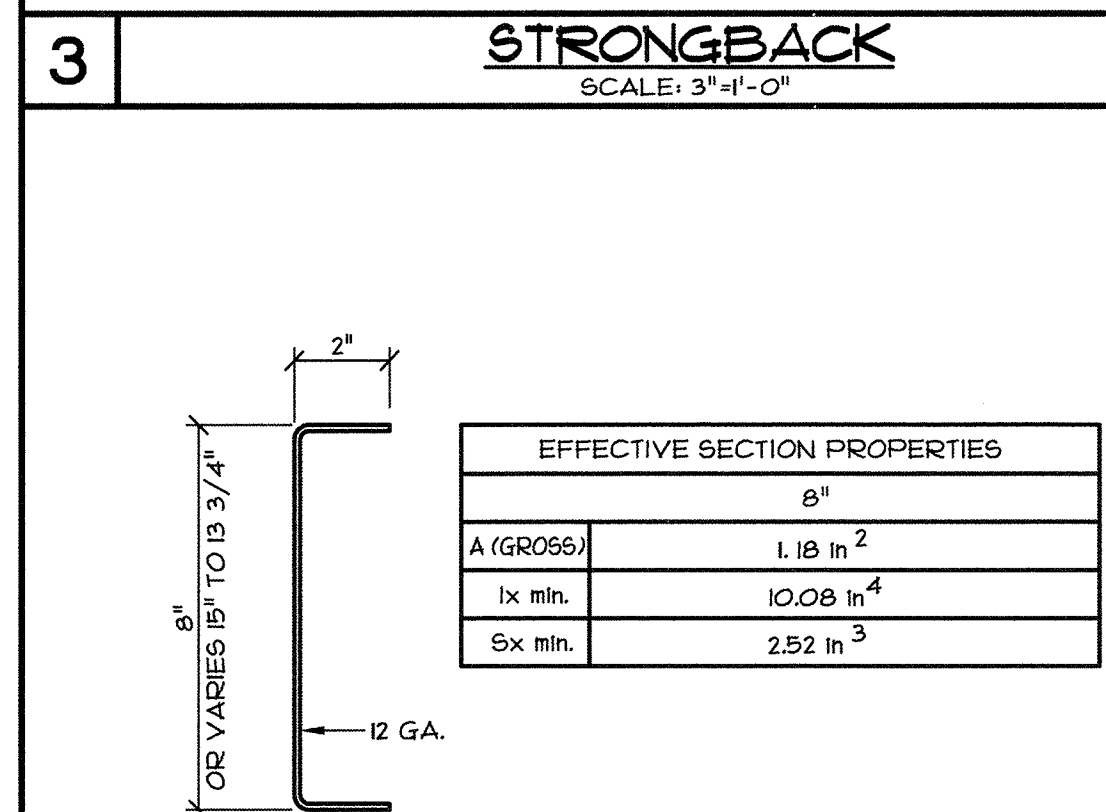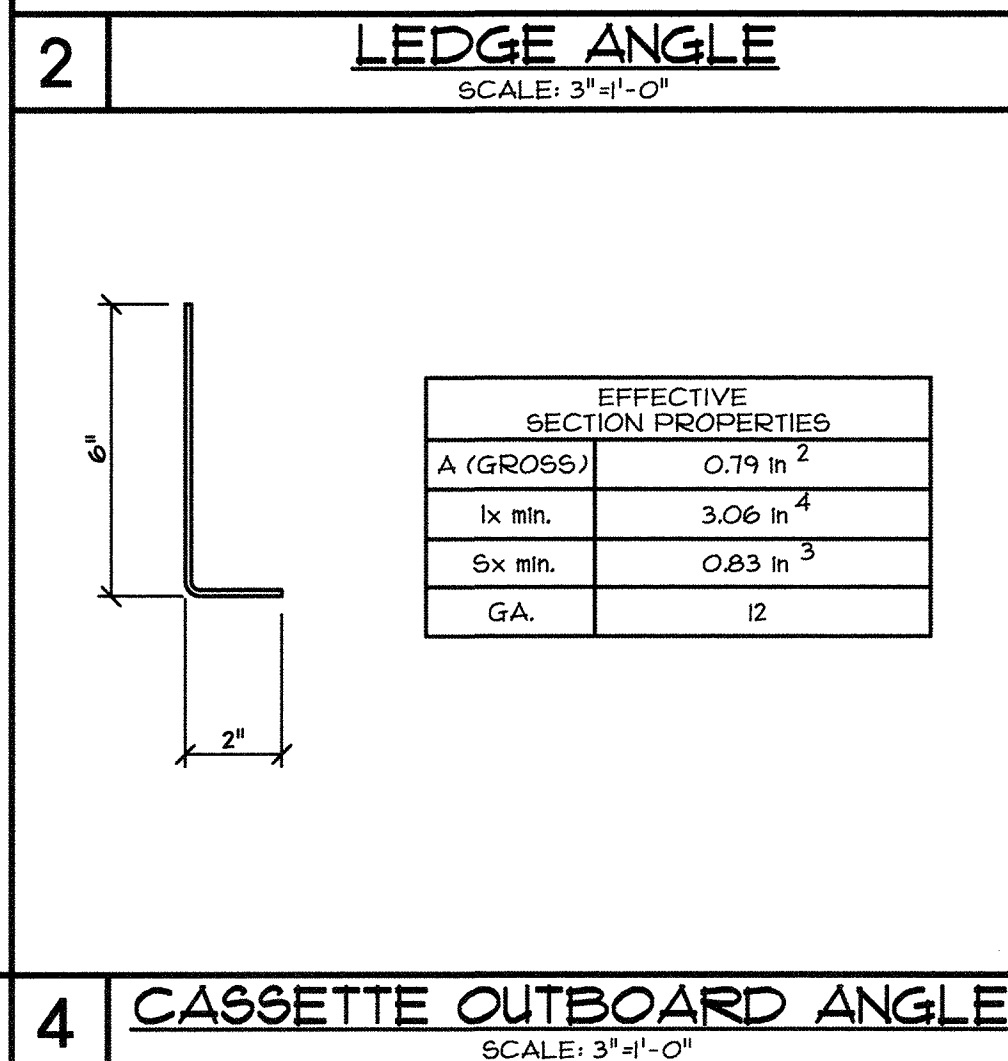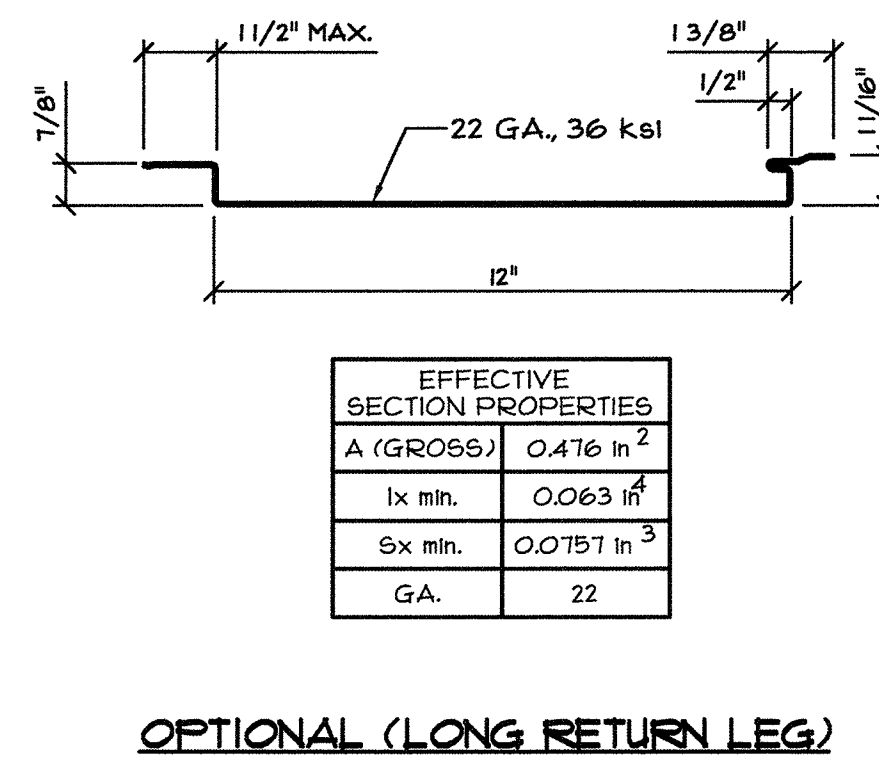

CONFIDENTIAL MATERIAL-THESE DOCUMENTS ARE THE PROPERTY OF AND ARE NOT TO BE REPRODUCED OR DISTRIBUTED WITHOUT FULL KNOWLEDGE AND WRITTEN CONSENT FROM ENVIROPLEX, INC.  
© COPYRIGHT ENVIROPLEX, INC. (ALL DRAWINGS PREPARED BY ENVIROPLEX, INC.)

THESE DRAWINGS ARE PRELIMINARY  
AND NOT FOR CONSTRUCTION  
UNLESS STAMPED & SIGNED BY  
THE ENGINEER OF RECORD.

**ENVIROPLEX, INC.**  
 4777 E. CARPENTER ROAD STOCKTON, CA. 95215, (209) 466-8000

---

**CESAR CHAVEZ HIGH SCHOOL - ATHLETIC FACILITY**  
**STOCKTON UNIFIED SCHOOL DISTRICT**  
 2929 WINDFLOWER LANE STOCKTON, CA 95212

---

**METAL SOFFIT PANELS,  
REMOVABLE CASSETTE  
(M. LARA EDITION)**

|             |     |
|-------------|-----|
| REV / DATE: | BY: |
|             |     |
|             |     |
|             |     |
|             |     |


An identification stamp from the Division of the State Archivist. It features a rectangular box with the number "02-116094" inside. Below the box, the text "AC" and "FLS" are followed by a line and the number "68". The date "DATE 9-6-2018" is stamped below that. A large "X" is drawn over the entire stamp area.

### S4.3







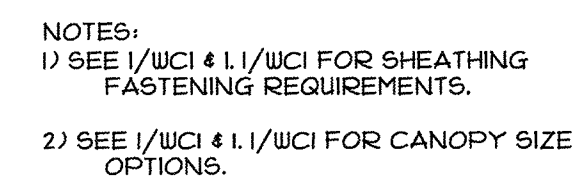




|   |   |
|---|---|
| 1 | PLAN VIEW - TYPICAL SHEATHING LAYOUT<br>SCALE: 3/8"=1'-0" |
|---|---|

SCALE: 3/8"=1'-0"

~~PRE-CHECK (PC) DOCUMENT~~  
~~Code: 2016 CBC~~  
~~A separate project application for construction is required.~~

CONFIDENTIAL MATERIAL—THESE DOCUMENTS ARE THE PROPERTY OF AND ARE NOT TO BE REPRODUCED OR DISTRIBUTED WITHOUT FULL KNOWLEDGE AND WRITTEN CONSENT FROM ENVIROPLEX, INC.  
© COPYRIGHT ENVIROPLEX, INC. (ALL DRAWINGS PREPARED BY ENVIROPLEX, INC.)
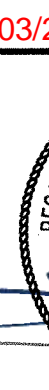
|   |   |
|---|---|
| IDENTIFICATION STAMP<br>DIV. OF THE STATE ARCHITECT<br>APP. 02-118017 INC. _____<br>REVIEWED FOR _____<br>SS <input type="checkbox"/> FLS <input type="checkbox"/> ACS <input type="checkbox"/><br>DATE: 04/10/2020   |   |
| <div style="text-align: center;"> <br/> <b>03/26/2020</b> </div> <div style="text-align: center;"> <br/>         THESE DRAWINGS ARE PRELIMINARY<br/>         AND NOT FOR CONSTRUCTION<br/>         UNLESS STAMPED &amp; SIGNED BY<br/>         THE ENGINEER OF RECORD.       </div> | <div style="text-align: center;"> <br/> <b>ENVIROPLEX, INC.</b><br/>         4777 E. CARPENTER ROAD STOCKTON, CA. 95215, (209) 466-8000       </div> <div style="text-align: center;"> <b>CESAR CHAVEZ HIGH SCHOOL - ATHLETIC FACILITY</b><br/> <b>STOCKTON UNIFIED SCHOOL DISTRICT</b><br/> <b>2929 WINDFLOWER LANE STOCKTON, CA 95212</b> </div> |
| <b>CANOPY FRAMING &amp; CONNECTION DETAILS</b>  |   |
| REV / DATE: _____<br>_____<br>_____<br>_____  | BY: _____<br>_____<br>_____<br>_____  |
| JOB No.: _____<br>DRAWN BY: _____<br>DATE: _____  |   |
| IDENTIFICATION STAMP<br>DIVISION OF THE STATE ARCHITECT<br><div style="border: 1px solid black; padding: 5px; display: inline-block;"> <b>02-118094</b> </div><br>AC _____ FLS _____ CS <u>68</u><br>DATE: <u>9-6-2018</u><br>2006 - 24430  |   |